



SFD1808-0008

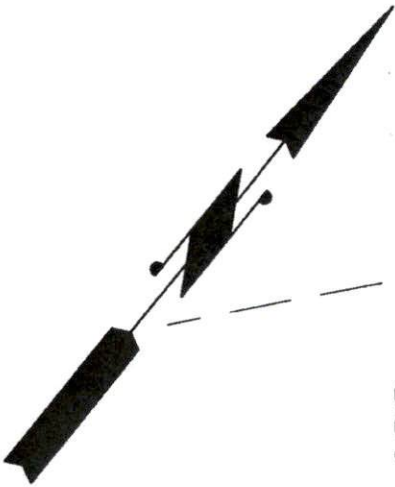

N50°42'23"E

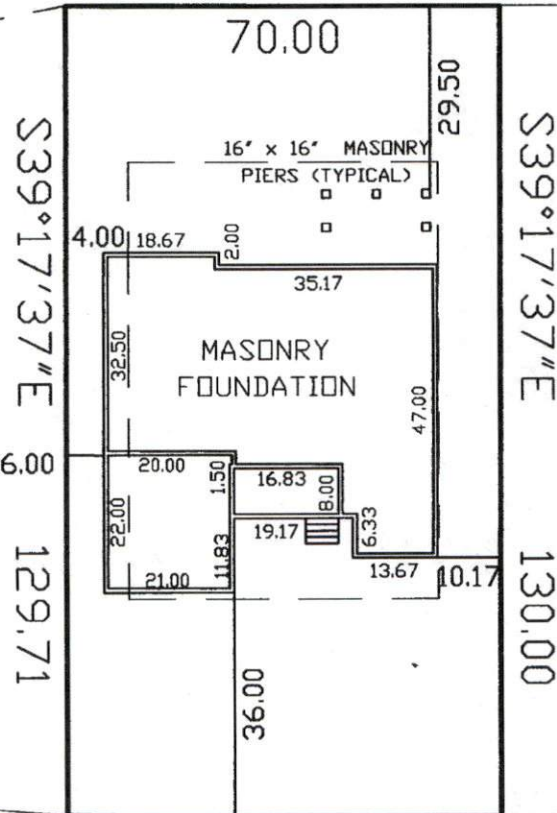

OPEN SPACE

1092



L=10.96' N50°42'23"E  
R=205.00 59.05

EDUCATION DRIVE  
(50' R/W)

THIS IS AN AS-BUILT SURVEY ONLY. THIS SURVEY DOES NOT NECESSARILY MEET G.S. 47-30 AS AMENDED NOR WAS IT INTENDED TO.

*Charlie T. Carpenter*  
3/15/19


Charlie T. Carpenter, P.L.S.

Professional Land Surveyor

1940 Juniper Church Road  
Four Oaks, NC 27524

(919) 320-5281

plschuck30@yahoo.com

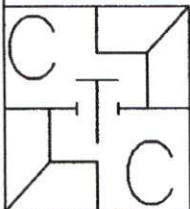

FOUNDATION SURVEY FOR:

WYNN CONSTRUCTION

PIN 0505-86-1984.000

PARCEL ID 01053525 0100 36

LOT 1093 ANDERSON CREEK CLUB S/D

PB 2016 PG 327

3/15/19

1"=30'

164 EDUCATION DRIVE  
SPRING LAKE, NC 28390