


**FEMA FLOOD HAZARD STATEMENT**  
 The lot shown on this plat is not located within the FEMA 100 year Flood Hazard Area as shown on FEMA map No. 3720066000J Effective date: 10/3/2006

**Note:**  
 Foundation Location based upon nails set in concrete footing for brick masons on October 29th, 2018. As-built dimensions of foundation confirmed on this date.

39

**Impervious Surface Limit:**  
 5,817 SF per lot

- LEGEND:**
- Subject Boundary Line
  - - - - - Adjoining Boundary Line
  - - - - - R/W Right-of-Way Line
  - - - - - C/L Centerline
  - - - - - Easement Line
  - - - - - MBL Minimum Building Line
  - △ CP Calculated Point
  - Existing Iron Stake

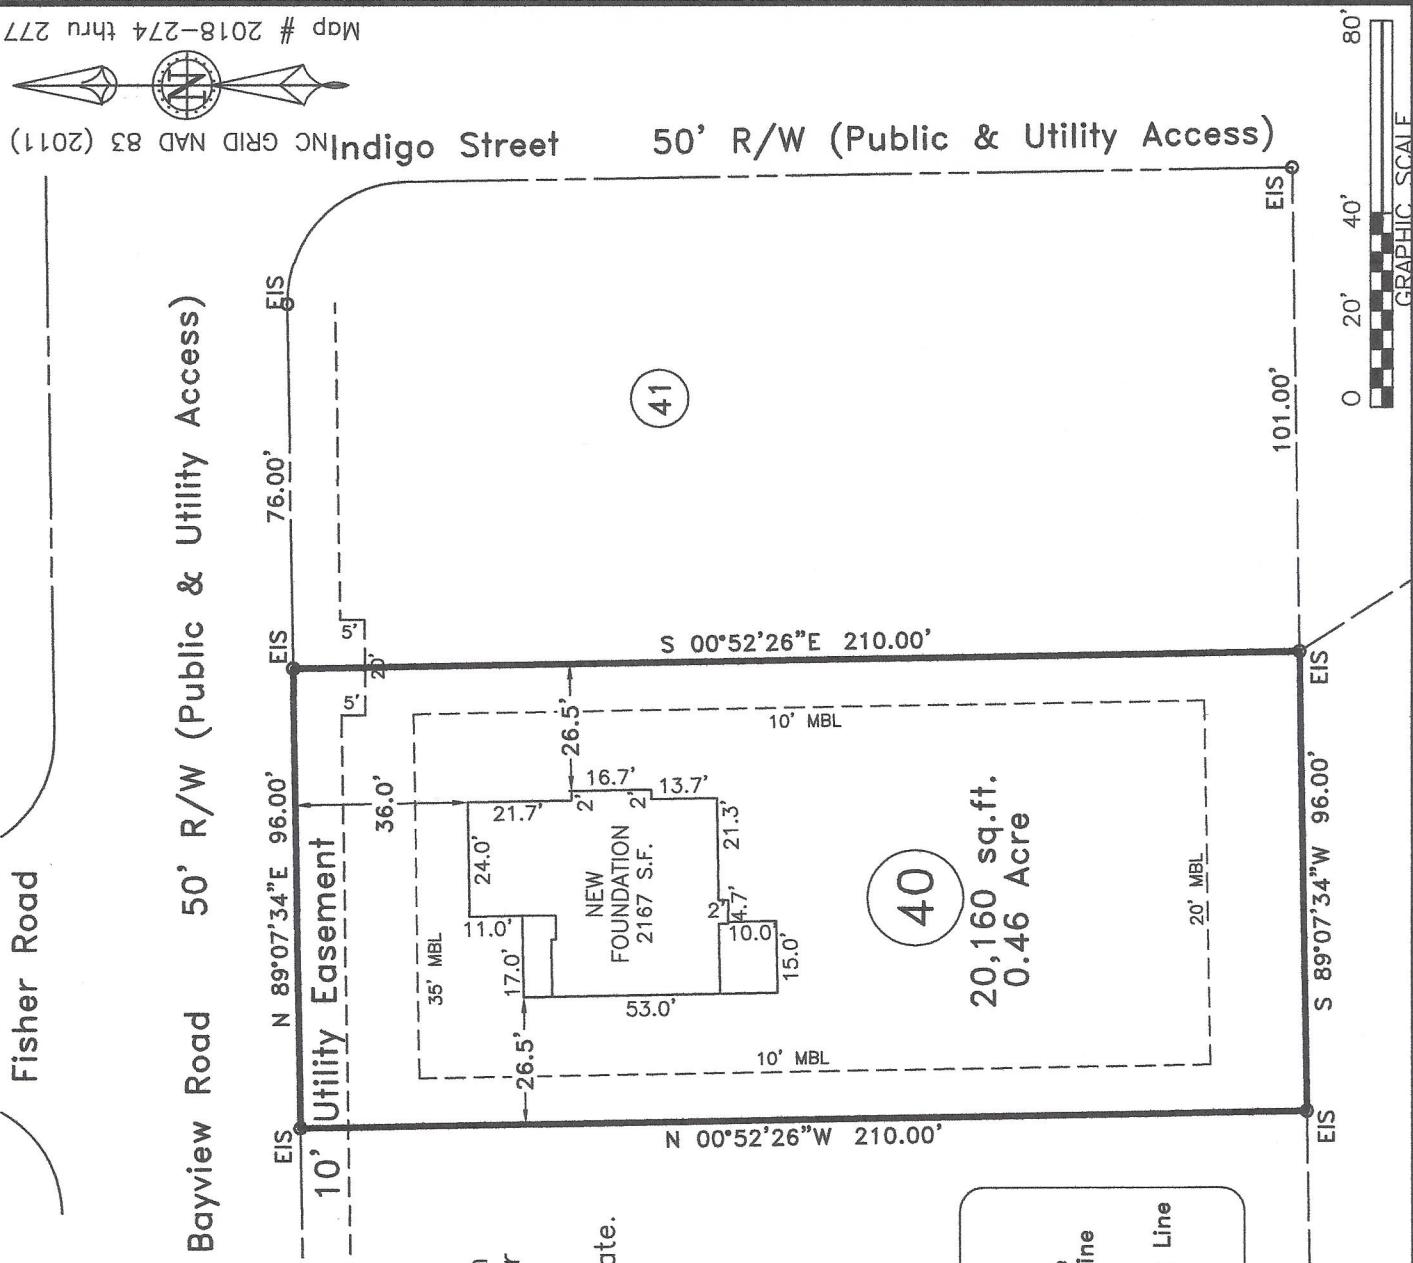

**FOUNDATION SURVEY**  
 ~ 99 Bayview Road, Lillington ~  
 Lot 40, South Creek Subdivision  
 Map # 2018-274 thru 277

Survey For  
**Signature Home Builders Inc.**

Neill's Creek Twp. Harnett Co.  
 Scale: 1" = 40' Date: 11/9/2018

Surveyed & Mapped By  
**STREAMLINE LAND SURVEYING, Inc.**  
 NC FIRM C-1898  
 870 NC 55 W, Coats, N.C. 27521  
 Phone: 910-897-7715

I hereby certify that the survey represented hereon was actually made under my supervision in accord with The Standards of Practice for Land Surveying in North Carolina (21 NCAC 56.1600); that the ratio of precision meets Class A standards; and there were no encroachments across surveyed property lines unless otherwise shown hereon.



NOT FOR RECORDATION