


**VICINITY MAP**  
Not To Scale

PB 2018, PG 299-300

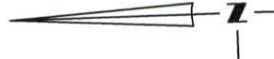


FLATWORK CALCULATION	
DESCRIPTION	AREA (S.F.)
LOT AREA TO B/C	26,911
HOUSE	2,154
DRIVE TO R/W	741
DRIVE APRON	262
PATIO	0
LEAD WALK	70
PUBLIC WALK	0
TOTAL PROPOSED	2,965
*TOTAL ALLOWED	5,000
*PB 2018, PG 299	
SOD/SEEDING	
TYPE	S.F.
SOD	6,351
SEED & STRAW	11,331


SETBACKS: (PB 2018, PG 299)

FRONT - 35' FROM R/W  
REAR - 25'  
SIDE - 10'  
CORNER LOT SIDE - 20'

(62)

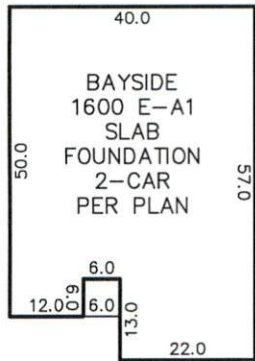

INSET  
N.T.S.

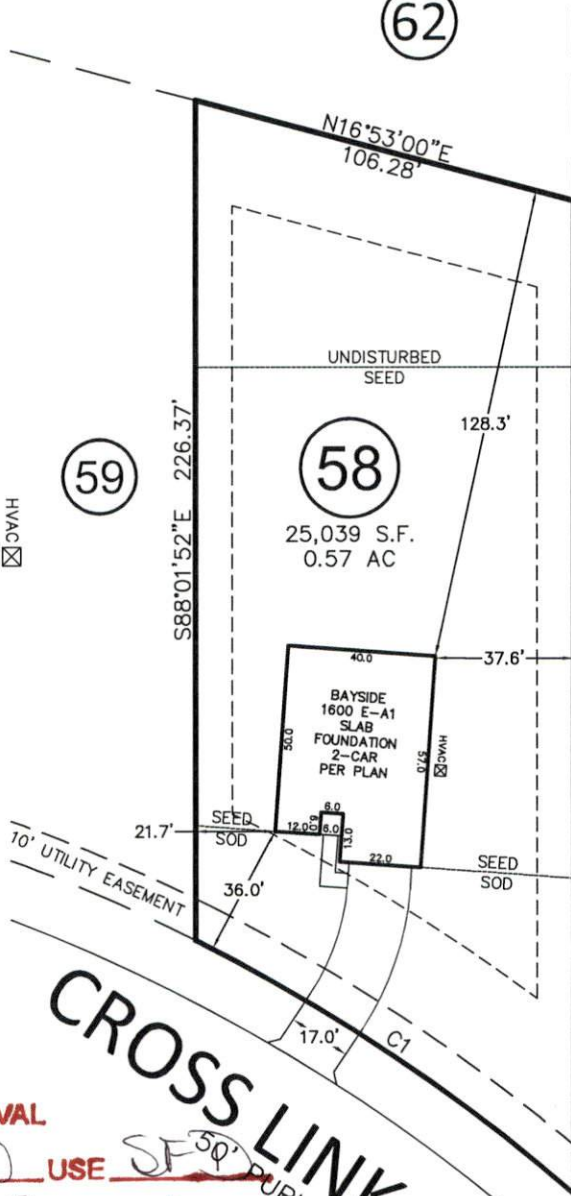

N/F  
DAVID W &  
LINDA D CHANDLER  
D.B. 3085, PG. 100

N/F  
OWEN R MARTY  
D.B. 1471, PG. 523

*Revised*  
**SITE PLAN APPROVAL**

**DISTRICT** BA30 **USE** SF

**#BEDROOMS** 3

4.26.19 *dyahsm*  
**ZONING ADMINISTRATOR**

**CROSS LINK DRIVE**  
PUBLIC R/W

REVISIONS	
REV. #	DATE
1	4/25/19
COMMENT MOVED HOUSE LEFT 10'	

THIS DRAWING DOES NOT  
REFLECT AS-BUILT INFORMATION

CURVE	RADIUS	ARC LENGTH	CH LENGTH	CH BEARING
C1	485.06'	123.83'	123.49'	N35°43'31"E