

SHEET

HOMES

COVER

H&H HOMES

NOINEERED BY:

WILMINGTON

REVISION LIST - STRUCTURAL:

WILMINGTON

1.) COMBINED WILMINGTON AND WILMINGTON II PLANS, (2-18)

2.) ADDED BRICK OPTION ON SECOND FLOOR, (2-18)

3.) CALLED OUT SERIES/SPACING OF I-JOISTS ON BASEMENT. (2-18)

WILMINGTON **REVISION LIST - ARCHITECTURAL:**

1.) STAIR TREADS CHANGED TO 10" (6-14)

2.) REPLACED CASUAL DINING FLUSH MOUT FIXTURE WITH (2) CAN LIGHTS (9-14)

3.) ADDED WATER TABLE OVER GARAGE DOOR (1-15)

4.) ADDED OPTION FOR (2) 8-0 7-0 GARAGE DOORS (1-15)

5) ADDRD OPTION FOR 12-0 DEEP COVERED PORCH, CHANGED ROOF FROM SHED TO GABLE (1-15)

6.) ADDED THIS COVER SHEET (9-14-17). COPIED INFORMATION ABOVE FROM H&H COVER SHEET (9-17)

7.) SHOWED DROPPED CEILING UNDER STAIRS AT 8'-6" TO ACCOMMODATE FLUSH MOUNT LIGHT (9-17)

8.) INCREASED DEPTH OF WALL BETWEEN MASTER TUB AND SHOWER BY 6" (9-17)

9.) MOVED LVP TO COAT CLOSET OFF OF FOYER (9-17)

10.) CHANGED FLUSH MOUNT LIGHT OVER KITCHEN ISLAND TO PENDANT LIGHT AND ADDED SWITCH AT STAIR WALL (9-17)

11.) ADDED SWITCH TO FAMILY ROOM LIGHT AT STAIR WALL (9-17)

12.) ADDED EXTERIOR WALL MOUNT LIGHTS AT OPT. GARAGE PEDESTRIAN DOORS (9-17)

13.) ADDED LIGHT SWITCH TO MEDIA ROOM OUTSIDE OF DOOR IN HALLWAY (9-17)

14.) MOVED SWITCHES FOR FAN, TUB AND SHOWER LIGHT IN MASTER BATH (9-17)

15.) UPDATED CUTSHEETS TO NEW FORMAT (9-17)

16.) COMBINED WILMINGTON AND WILMINGTON-II (BASEMENT). (2-18)

17.) ADDED ALL BRICK OPTION (A, B AND C ELEVATIONS). (2-18)

18.) ADDED THREE CAR GARAGE OPTION. (2-18)

19.) UPDATED/ ADDED CUTSHEETS. (2-18)

20.) ADDED GOURMET KITCHEN OPTION. (2-18) 21.) CHANGED FIREPLACE FROM 36" TO 32" (3-19)


24.)

29.)

rrents/Projects/H&H Homes/Wilmington/Wilmington_NC/Wilmington_GO/Wilmington_2-14-18.dwg, 3/20/2019 10:48:47 AM

ATE: 2-14-18

RAWN BY: WG

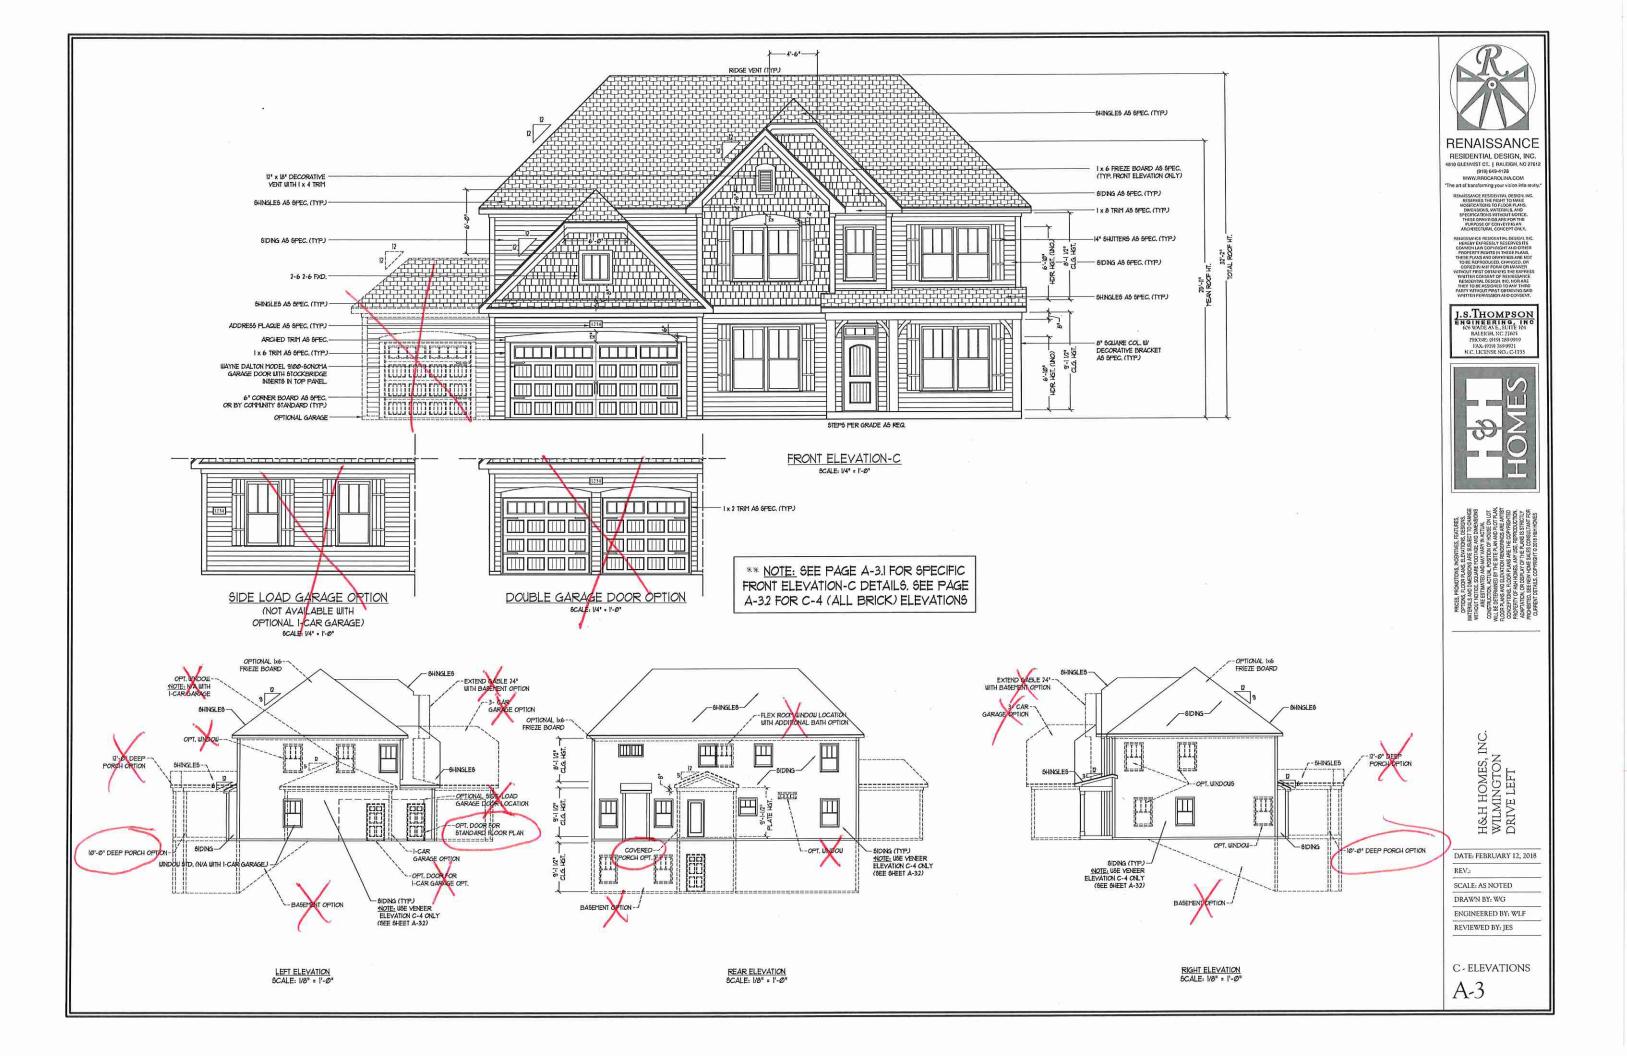





RENAISSANCE RESIDENTIAL DESIGN, INC.

4810 GLENMIST CT. | RALEIGH, NC 276-(919) 649-4128 WWW.RRDCAROLINA.COM "The art of wansforming your vision into reali

J.S.THOMPSON ENGINEERING, INC 600 WADE AVE, SUITE 104 RALEIGH, NC 17605 PHONE (191) 7899921 PA. (1919) 789921 N.C. LICENSE NO. C.1733



H&H HOMES, INC. WILMINGTON DRIVE LEFT

DATE: FEBRUARY 12, 2018 REV.:

SCALE: AS NOTED

DRAWN BY: WG

ENGINEERED BY: WLF REVIEWED BY: JES

C - ELEVATION OPTIONS

A - 3.1

SQUARE FOOTAGE

|at FLOOR: 1283 SQ. FT.
2nd FLOOR: 1582 SQ. FT.
TOTAL: 2865 SQ. FT.
FRONT PORCH: 125 SQ. FT.
STD. REAR PATIO: 110 SQ. FT.
GARAGE: 428 SQ. FT.

SQUARE FOOTAGE (OPTIONS)

UNFINISHED BASEMENT:	1300 SQ FT
161 FLOOR (W/ BASEMENT):	1308 SQ FT
2nd FLOOR (W/ BASEMENT).	1607 SQ FT
1st FLOOR (ALL BRICK):	1336 SQ FT
2ND FLOOR (ALL BRICK):	1643 SQ FT
GARAGE (ALL BRICK):	449 SQ FT
I-CAR GARAGE:	240 SQ FT
I-CAR GARAGE (ALL BRICK):	258 SQ FT
3-CAR GARAGE:	601 SQ. FT
3-CAR GARAGE (ALL BRICK):	633 SQ FT
UNFINISHED BASEMENT (ALL BRICK):	1358 SQ. FT
161 FLOOR (ALL BRICK W/ BASEMENT):	1361 SQ. FT
2nd FLOOR (ALL BRICK W/ BASEMENT):	1668 SQ. FT
REAR PORCH (IØ-Ø DEEP):	110 SQ FT
REAR PORCH (12-Ø DEEP);	132 SQ. FT
OPT. PATIO/ DECK: (IØ-Ø DEEP):	120 SQ FT
OPT. PATIO/ DECK: (12-Ø DEEP):	144 SQ FT

OPTION


(NOT AVAILABLE WITH

OPTIONAL ONE-CAR GARAGE)

*NOTE: ALL EXTERIOR WALLS AND ATTIC WALLS ARE TO BE 2×6 % 16" O.C. (UNO), 2×4 % 16" O.C. EXTERIOR WALLS MAY BE CONSTRUCTED IN LIEU OF 2×6 WALLS (UNO), ALL INTERIOR LOAD BEARING WALLS ARE TO BE 2×4 % 16" O.C. (UNO) AND NON-LOAD BEARING INTERIOR WALLS ARE TO BE 2×4 % 24" O.C. (UNO).

2x6 WALL

• SHADED WALLS ARE TO BE 2 x 6 @ 16" O.C. (LOAD BEARING) OR 2 x 6 @ 24" O.C. (NON-LOAD BEARING) REGARDLESS OF EXTERIOR WALL CONDITION

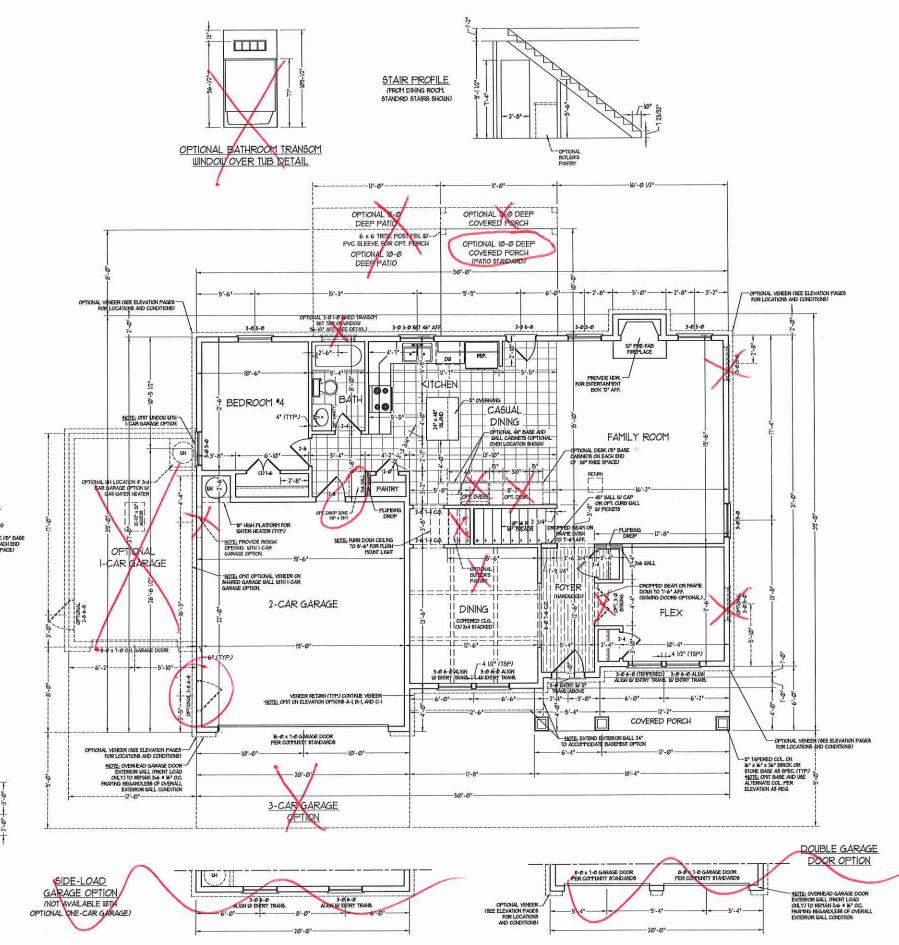



RENAISSANCE

RESIDENTIAL DESIGN, INC. 4810 GLENMIST CT. | RALEIGH, NC 27612 (919) 649-4128 WWW.RRDCAROLEVA.COM

he art of transforming your vision into realty."

PENNISANCE RESIDENTIAL CESSON, INC.
RESERVES THE RIGHT TO MAKE
MODIFICATIONS TO FLOOR PLAYS,
DWESSIONS, WHERALS, AND
SPECIFICATIONS WITHOUT NOTICE.
THESE DRAWINGS ARE FOR THE
PURPOSE OF CONVENING AN

MEMBERS OF THE SERVICE OF THE SERVIC

J.S.THOMPSON ENGINEERING, INC (665 WADE AVE, SUITE 164 (ALEIGH, NC 27605 PHONE: (919) 789-9919 FAX (910) 789-9921 NC. LICENSE NO. 6-C1733



HOUT WOIDE, SOURHE YOUNG HE RIBERT TO CHANGE BESTIMETED MAN WHY HE NICTURA. BESTIMETED MAN WHY HE NICTURA. MESTIMETED MAN HE NICTURA CHANGE OF THE NICTURA MESTIMETED MAN HE NICTURA CHANGE OF THE NICTURA FOR THE NICTURA CHANGE AND HE NICTURA OF THE NICTURA CHANGE AND HE NICTURA MESTIMETED SET OF THE NIC

H&H HOMES, INC. WILMINGTON DRIVE LEFT

DATE: FEBRUARY 12, 2018


SCALE: 1/4"=1'0" DRAWN BY: WG

DRAWN BY: WG ENGINEERED BY: WLF

REVIEWED BY: JES

FIRST FLOOR PLAN

A-5

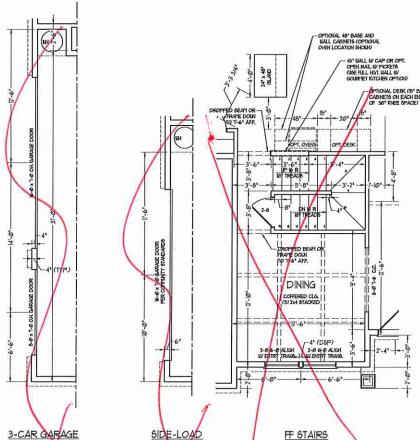


GARAGE OPTION

(NOT AVAILABLE WITH

OPTIONAL ONE-CAR GARAGE)

W/ BASEMENT OPTION

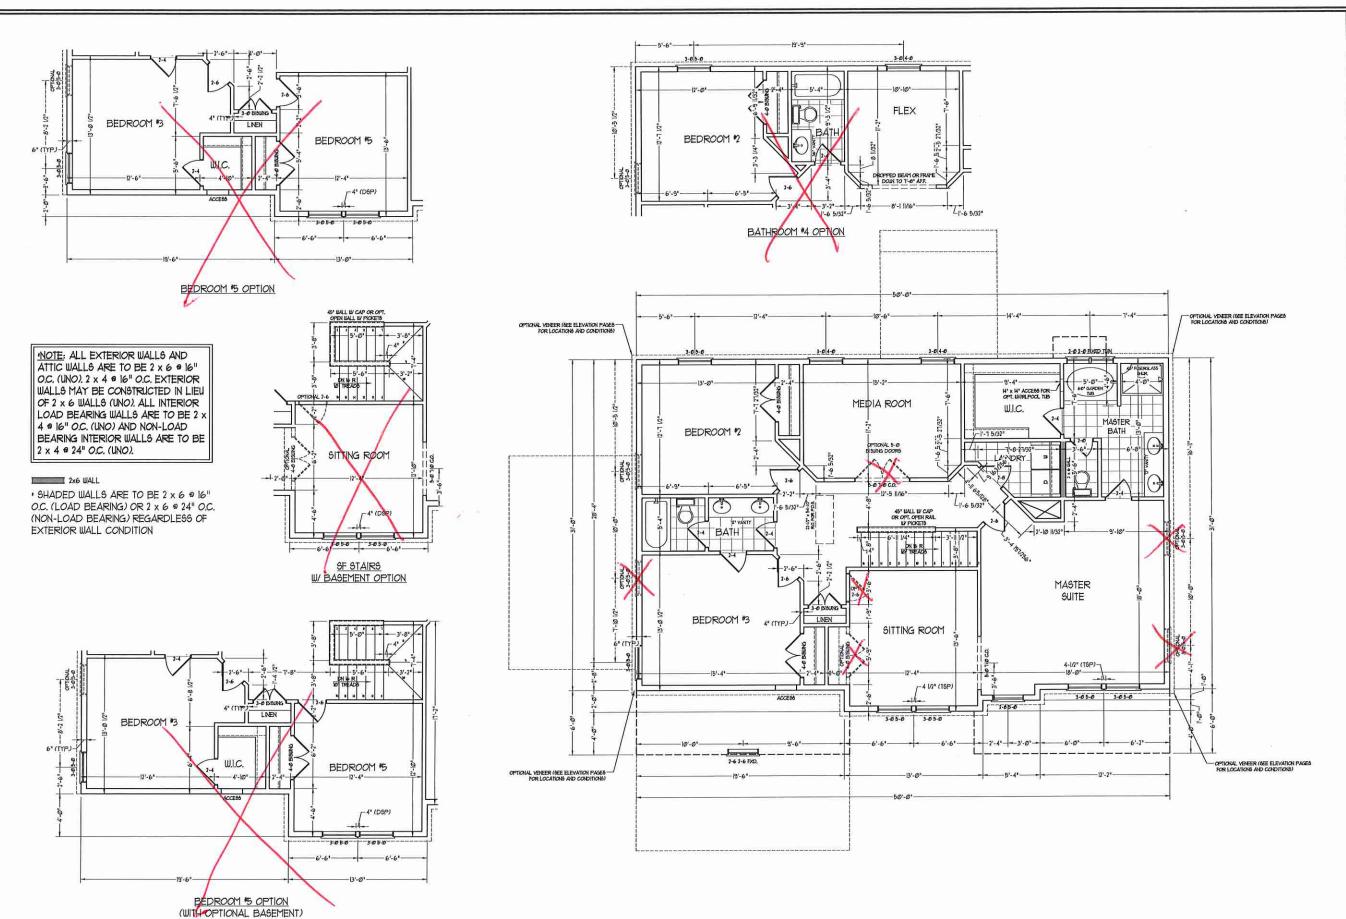



RENAISSANCE

RESIDENTIAL DESIGN, INC. 4810 GLENMIST CT. | PALEIGH, NC 276 (919) 649-4128 YWW.RRDCAROLINA.COM The art of transforming your vision into real

J.S.THOMPSON ENGINEERING, INC



H&H HOMES, II WILMINGTON DRIVE LEFT

DATE: FEBRUARY 12, 2018

REV.:


SCALE: 1/4"-1'-0" DRAWN BY: WG

ENGINEERED BY: WLF

REVIEWED BY: JES

SECOND FLOOR PLAN

A-6

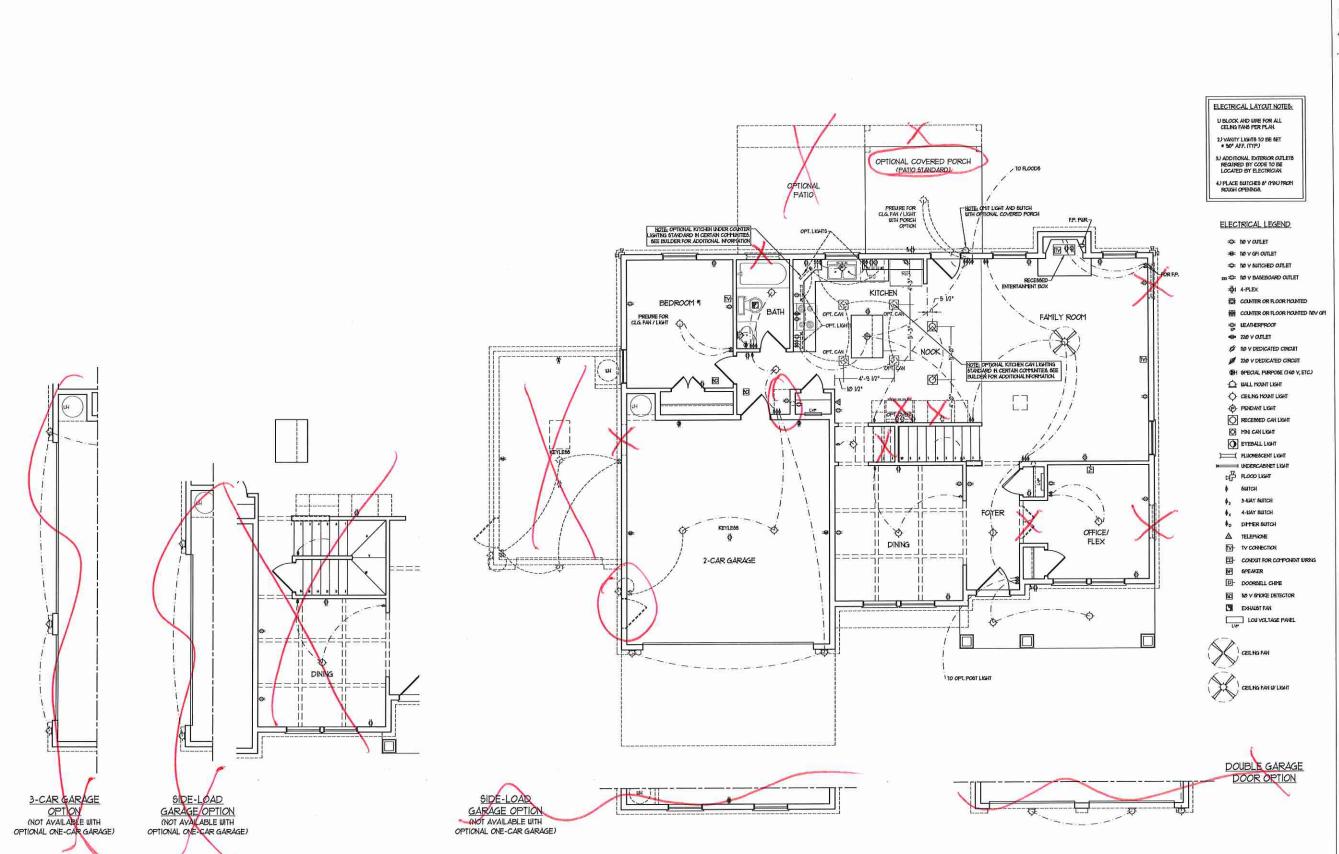



RENAISSANCE RESIDENTIAL DESIGN, INC.

4810 GLENMIST CT. | RALEIGH, NC 27812 (919) 649-4128 WWW.RRDCAROLINA.COM "The art of kansforming your vision into realty

J.S.THOMPSON ENGINEERING, INC (66 WADE AVE., SUITE 104 RALEIGH, NC 27605 PHONE: (919) 7589991 FAX. (919) 7689911 N.C. LICENSE NO. C-1733



H&H HOMES, INC. WILMINGTON DRIVE LEFT

DATE: FEBRUARY 12, 2018

REV.:


SCALE: 1/4"=1'-0"

DRAWN BY: WG ENGINEERED BY: WLF

REVIEWED BY: JES FIRST FLOOR ELECTRICAL

PLAN

E-1

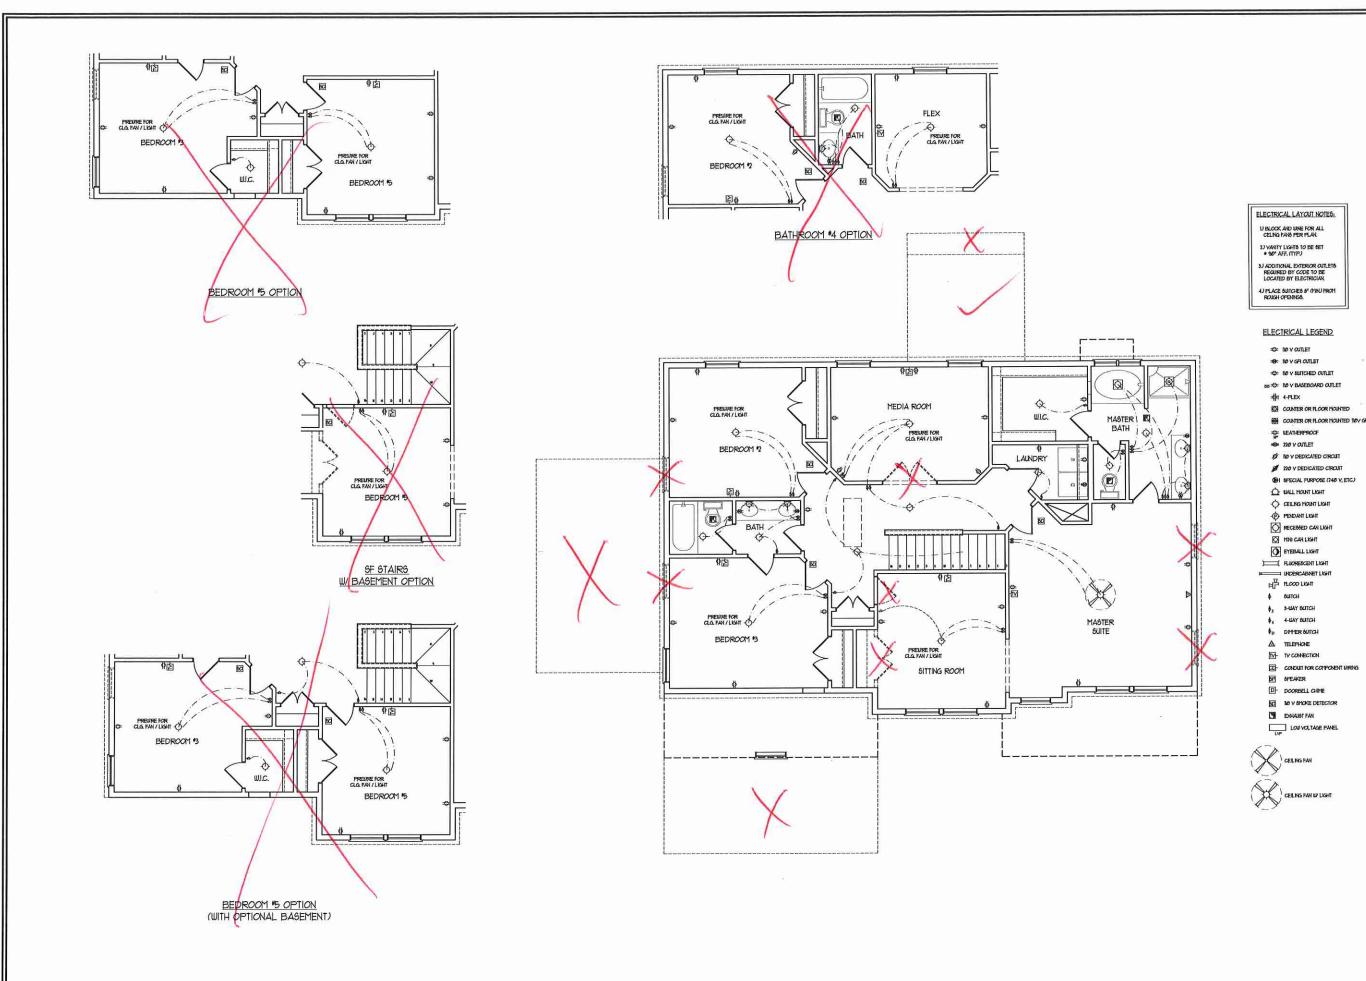



RENAISSANCE

RESIDENTIAL DESIGN, INC.
4810 GLEMMIST CT. | RALEIGH, NO 27612
(919) 649-4128
WWW.RRDCAROLINA.COM
"The art of transforming your vision into reality."

I.S.THOMPSON ENGINEERING, INC (66 WADE AVE., SUITE ING RALEIGH, NC 27605 FHONE: 6199 7889919 FAX. 6199 7889921 N.C. LICENSE NO.: C-1733



H&H HOMES, IN WILMINGTON DRIVE LEFT

DATE: FEBRUARY 12, 2018

REV.:

SCALE: 1/4"-1'-0" DRAWN BY: WG

ENGINEERED BY: WLF

REVIEWED BY: JES

SECOND FLOOR ELECTRICAL

PLAN E-2

10/0-MPH WND ZONE NOTES FOR LESS THAN 30' MEAN ROOF HEIGHT:

U BIGNEER'S SEAL APPLIES ONLY TO STRUCTURAL CONFORDITS ENGINEER'S SEA DOES NOT CERTIFY DIMENSIONAL ACCURAC ARCHITECTURAL LAYOUT NOUDING ROOF

ARCHIECTRAL LATION INCLEASE NEXT
10 STRUCTURAL DESIGN FOR NORTH CARCUM
20 STRUCTURAL CODE, 200 EDITION
20 STRUCTURAL CODE
20 STRUCTU

5) EXTENSIVELLE PERSONED FOR 160 1974
16) WALL CLADINS PERSONED FOR 141 1976
16) WALL CLADINS PERSONED FOR 141 1976
17) ROOF CLADINS PERSONED FOR 160 1976
170 TO DIE AND 160 1976 (FOORTING AND 160 1976)
170 TO DIE AND 160 1976 (FOORTING AND 160 1976)
170 TO DIE AND 160 1976 (

NFORMATION

9) DERRY EFFCIDICY COMPLIANCE AND
NISLATION VALUES OF THE BUILDING TO BE N
ACCORDANCE WITH CHAPTER II OF THE NORC,

200 EDITION

10) RETER TO NOTES AND DETAIL SHEETS
FOR ADDITIONAL STRUCTURAL INFORMATION.

30-MPH WIND ZONE NOTES FOR LESS THAN 30' MEAN ROOF HEIGHT

U DIGNERNÓ GEAL AFFLEÓ CALY TO STRICTURAL COMPONDITÓ, DIGNERNÓ GEAL DOES NOT CERTET O TESSICANAL ACCURACY OR ACCATECINAL LAYOUT NOU ROCE STSTEM! 2) STRICTURAL DESCRI FER NORTH CAPICIAN RESIDENTIAL CODE 100 EDITION THIS MECCAL COMBERATION TO CHAPTER 45 (NORTH UND ZORE) FOR BO 1PH 14003) 3) BULDERS IS O PROVIDE TRANSM

100 EDITION.
4) FOUNDATION ANCHORAGE TO COMPLY
WITH GESTION 4804 OF THE NORTH CAROLINA
RESDERTINAL CODE, 100 EDITION.
5) MEAN ROOF HEIGHT IS LESS THAN 30


HEET.


6) IUALL CLADDING DESIGNED FOR 46.1
PSF (POSITIVE AND NEGATIVE).
1) ROOF CLADDING DESIGNED FOR 35.6
PSF (POSITIVE AND NEGATIVE) FOR ROOF PITCHES TAZ TO 12/12 AND SAT PSF (POSITIVE AND REGATIVE) FOR ROOF PITCHES 225/12 TO

NO. 16' OBB MEATING IS PROJUSED ON ALL EXTEROR BULLA.

B) THE 'OBB MEATING IS PROJUSED ON ALL EXTEROR BULLA.

B) UALLS 10 DE ERACED IN ACCORDANCE UNIT HECKING RESPUBLICAL COCE, 200 EDITION ONDERSY THEORYCO COPE, 200 EDITION INDERSY THEORYCO COPE, 200 EDITION NUMBER OF THE DUILDING 10 DE NACCORDANCE UNIT CAMPETER II OF THE NACCORDANCE UNIT CAMPETER II OF THE NCRC, 200 EDITION.

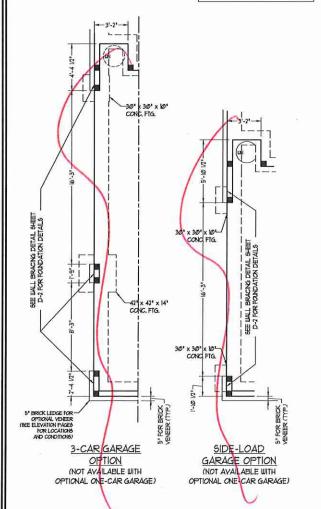

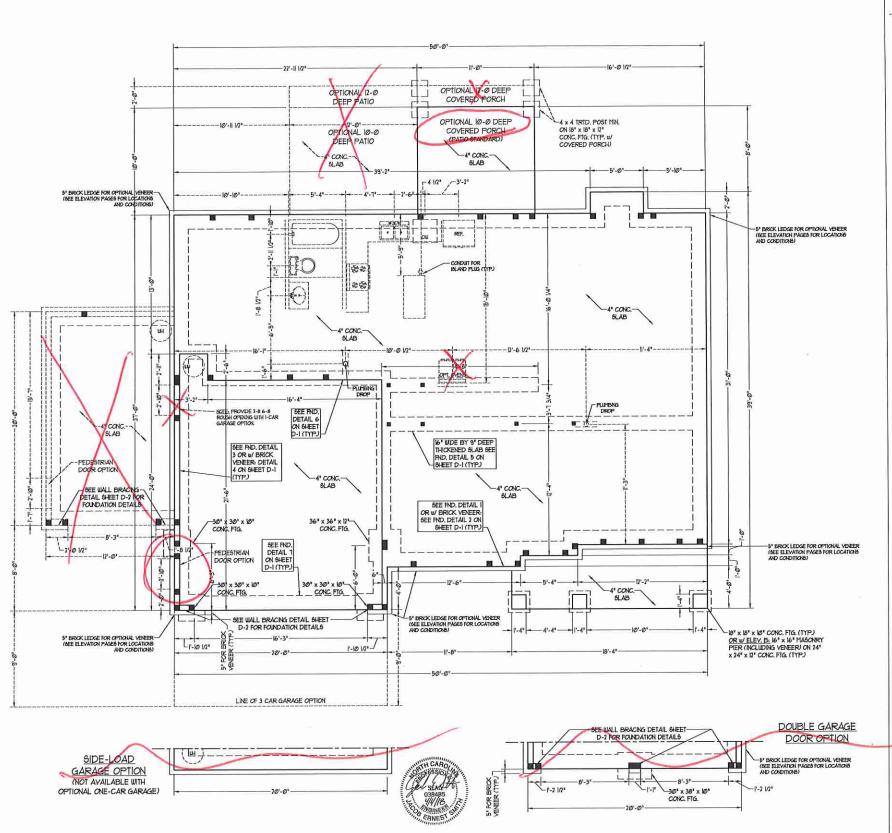



RENAISSANCE

RESIDENTIAL DESIGN, INC. 4810 GLENMIST CT. | RALEIGH, NC 27612 (919) 649-4128 WWW.RRDCAROLINA.COM "The art of transforming your vision into re sity.

606 WADE AVE., SUITÉ 104 RALEIGH, NC 27605 PHONE: (919) 789-9919 FAX: (919) 789-9921 N.C. LICENSE NO.: C-1733



INC. H&H HOMES, IN WILMINGTON DRIVE LEFT

DATE: FEBRUARY 12, 2018 REV.:

SCALE: 1/4"=1'-0"

DRAWN BY. WG

ENGINEERED BY: WLF REVIEWED BY: JES

MONO SLAB FOUNDATION **PLAN**

STRUCTURAL NOTES: ALL FRAMING LUMBER TO BE 2 SFF (UNO), ALL TREATED LUMBER TO BE 72 SYP (UNO) ALL LOAD BEARING HEADERS TO BE (2) 2 x 6 ALL BEAMS ARE TO BE SUPPORTED WITH (2) JACK STUDS EA END (UNO), WINDOW AND DOOR HEADERS TO BE SUPPORTED W/ (I) JACK STUD AND (I) KING STUD EA END (UNO) STUDS EA. SIDE OF EXTERIOR WINDOW AND DOOR HEADERS W/ CLEAR OPENINGS LESS THAN 6'-0" AND (3) KING STUDS EA SIDE OF HEADERS W/ CLEAR OPENINGS GREATER THAY FOR HIGH WIND ZONES, ALL EXTERIOR WALLS TO BE SHEATHED WITH THE O'DE SHEATHING WITH JOINTS BLOCKED AND SECURED WITH 8d NAUS AT 3" O.C. ALONG EDGES AND 6" O.C. N FOR HIGH WIND ZONES, SECURE ALL EXTERIOR WALL SHEATHING PANELS TO DOUBLE TOP FLATES, BANDS, JOISTS, AND GIRDERS WITH (2) PAVELS SHALL EXTEND 12" BEYOND CONSTRUCTION JOINTS AND SHALL OVERLAP GIRDERS AND DOUBLE SILL PLATES THEIR RALL DEPTH. SQUARES DENOTE POINT LOADS WHICH REGUIRE SOLID BLOCKING TO GIRDER OR FOUNDATION. ALL SQUARES TO BE (2) STUDS ALL 4 x 4 POSTS SHALL BE ANCHORED TO SLASS W SMPSON ABUAY POST BASES (OR EQUAL) AND 6 x 6 POSTS W ABU66 POST BASES (OR EQUAL) (UNO). ALL 4 x 4 AND 6 x 6 POSTS TO BE INSTALLED WITH 100 LB CAPACITY UPLET CONNECTORS AT TOP (UNO.) FOR FIBERGLASS, ALUMINUM, OR COLUMN ENG ANGLES TO COLUMNS W/ V4" THROUGH BOLTS W/ NUTS AND WASHERS, LOCATE ANGLES ON OPPOSITE SIDES OF COLUMN. THROUGH BOLTS MUST BE INSTALLED PRIOR TO SETTING COLUMN. 7. REFER TO NOTES AND DETAIL SHEETS FOR ADDITIONAL STRUCTURAL INFORMATION NOTE: TEP DENOTES TRIPLE STUD POCKET FILL BETWEEN HEADERS SOLID W KING STUDS. STRAFI HEADERS TOGETHER w/ (2) \$' LONG SIMPSON CSIG BOTTOM ON THE INSIDE FACE OF THE HEADERS

3-CAR GARAGE

OPTION (NOT AVAILABLE WITH SIDE-LOAD

GARAGE OPTION

(NOT AVAILABLE WITH

OPTIONAL ONE-GAR GARAGE)

NOTE: ALL EXTERIOR WALLS AND ATTIC WALLS ARE TO BE 2 x 6 @ 16" O.C. (UNO), 2 x 4 @ 16" O.C. EXTERIOR WALLS MAY BE CONSTRUCTED IN LIEU OF 2 x 6 WALLS (UNO). ALL INTERIOR L 5 x 3 1/2 x 5/16 LLY LOAD BEARING WALLS ARE TO BE 2 x 4 @ 16" O.C. (UNO) AND NON-LOAD BEARING INTERIOR WALLS ARE TO BE NOTES: L LINTEL SCHEDULE APPLIES TO ALL OPENINGS IN BRICK VENEER (UNO), SEE ARCH DUGS, FOR SIZE AND LOCATION OF 2 x 4 @ 24" O.C. (UNO). (LLV) = LOKG LEG YERTICAL
LENGTH = CLEAR OFDING
ETBED ALL ANGLE IRONG MIN 4" EACH
SIDE INTO YEREER TO PROVIDE BEARNING
FOR ALL HEADERS 8"-0" AND GREATER
IN LENGTH, ATTACH STEEL ANGLE TO
HEADER W VI" LAG SCREUS 8 2" O.C.

ROOF TRUSSES — ENG. BY OTHERS FOR ELEY C

GARAGE OPNON

OPTIONAL ONE-CAR GARAGE

LINTEL SCHEDULE FOR

8 AND GREATER L 6 x 4 x 5/6 LLV

(LLV) + LONG LEG VERTICAL

FOR ALL BRICK SUPPORT • ROOF LINES,

FASTEN A 5" x 3 1/2" x 5/16" STEEL ANGLE FASTEN A 5" x 3 1/2" x 5/1/6" 8 TEEL ANGLE TO 2 x 1/2 B LOCKINS INSTALLED BETWEEN WALL STUDS W 1/2" LAG SCREWS 12" O.C. STAGGERED AND N ACCORDANCE TO SECTION R103.122 OF THE NORTH CAROLINA RESIDENTIAL CODE, 20/2

PRECAST REINFORCED CONCRETE

LINTELS ENGINEERED BY OTHERS MAY BE USED IN LIEU OF STEEL LINTELS.

(I) | 3/4" x IA" LSL FLUSH

FF STAIRS

W/ BASEMENT OPTION

SIZE OF LINTEL

L 3 1/2 x 3 1/2 x 1/4


LENGTH (FT.)

UP TO 4 FT.

BRACED WALL DESIGN RECTANGLE A RECTANGLE B SIDE IA (FRONT LOAD)
METHOD: C5-WSP/FF TOTAL REQUIRED LENGTH: 112' TOTAL REQUIRED LENGTH: 456 TOTAL PROVIDED LENGTH: 1135' TOTAL PROVIDED LENGTH: 6" SIDE ZB METHOD: C5-U5P TOTAL REQUIRED LENGTH: 456' TOTAL REQUIRED LENGTH: 112' TOTAL PROVIDED LENGTH: 2458' TOTAL PROVIDED LENGTH: 12' SIDE 3B / SIDE 4A CAMILATIVE METHOD: C5-IIISPIGB TOTAL REQUIRED LENGTH: 2183' TOTAL PROVIDED LENGTH: 272' SIDE 3A METHOD: CS-USP TOTAL REQUIRED LENGTH: 1864'
TOTAL PROVIDED LENGTH: 20.41' SIDE 4A (SIDE LOAD)
METHOD: C5-WSP/FF SIDE 4B METHOD: CS-USP

BRACED WALL DESIGN NOTES:

- BRACED WALL DESIGN PER SECTION R60230 OF THE SIMPLIFIED WALL BRACING CRITERIA EFFECTIVE SEPTEMBER I
- CS-USP REFERS TO "CONTINUOUS SHEATHING WOOD CS-USP REFERS TO "COMINIOUS SHEATHING - UCCO."
 STRICTURAL PANELS" CONTRACTOR 16 TO INSTALL TIG! OSB
 ON ALL EXTERIOR WALLS ATTACHED W BO NAILS SPACED 6"
 OC. ALONS PANEL ECOSES AND 18" OC. IN THE FIELD.
 GB REFERS TO "GYPS
- 1/3" (MIN) GYPSUM WALL BOARD WHERE NOTED ON THE FLANS. FASTEN GB WITH I 1/4" SCREWS OR 1 5/8" NAILS SPACED TO OC. ALONG PANEL EDGES AND IN THE FIELD INCLUDING TOP AND
- BOTTON PLATES, BRACE WALL DESIGN APPLIES IN WIND ZONES UP TO 100 MPH. FOR HIGH WIND ZONES, BRACE WALLS ARE TO BE CONSTRUCTED IN ACCORDANCE WITH CHAPTER 45 OF THE KORE, 200 EDITION, SEE NOTES AND DETAIL SHEETS FOR ADDITIONAL BRACED

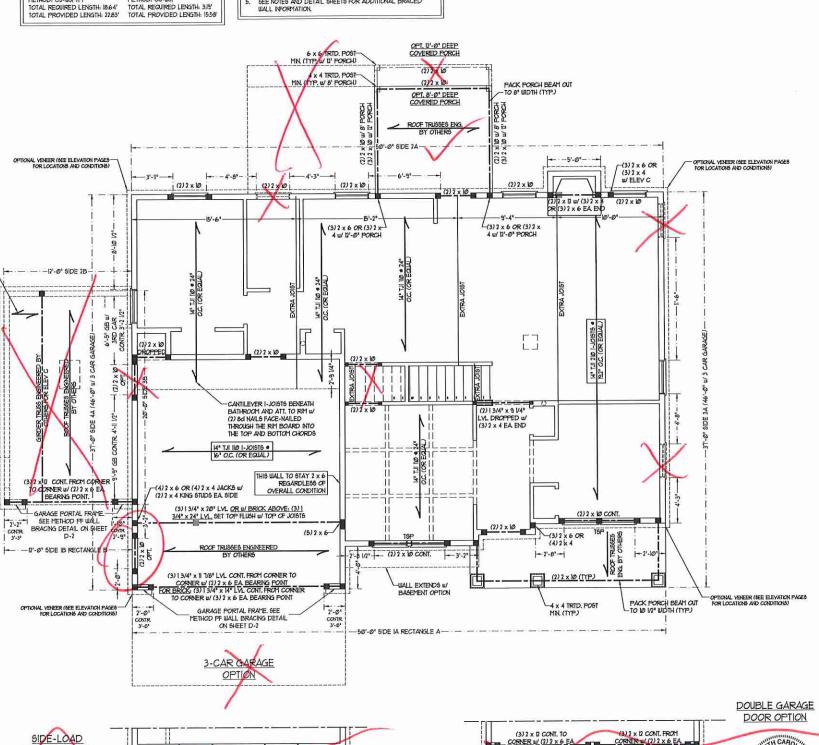

CORNER W (2) 2 x 6 FA BRG POINT.

FILL BETWEEN HEADERS SOLID W KING METHOD FF WALL BRACING DETAIL

ARAGE PORTAL FRAME, SEE

ON SHEET D-2

1-4"

STUDS, STRAP HDRS, TOGETHER II/ (2) 5' LONG SIMPSON CSIG COIL STRAPS INSTALLED TOP AND BOTTOM ON INSIDE FACE OF HDRS.

CORNER W (2) 2 x 6 EA.



RENAISSANCE

RESIDENTIAL DESIGN, INC. IB TO GLENMIST CT. | RALEIGH, NC 2761 (919) 649-4128 YVWY,RRDCAROLINA.COM The art of transforming your vision into re all

J.S.THOMPSON ENGINEERING, INC 606 WADE AVE. SUITE IOU RALEIGH, NC 27605 PHONE, (1919) 789-9919 FAX. (019) 789-9921



H&H HOMES, II WILMINGTON DRIVE LEFT


DATE: FEBRUARY 12, 2018 REV.

SCALE: 1/4"=1'-0"

DRAWN BY: WG ENGINEERED BY: WLF

REVIEWED BY: JES

SECOND FLOOR FRAMING PLAN

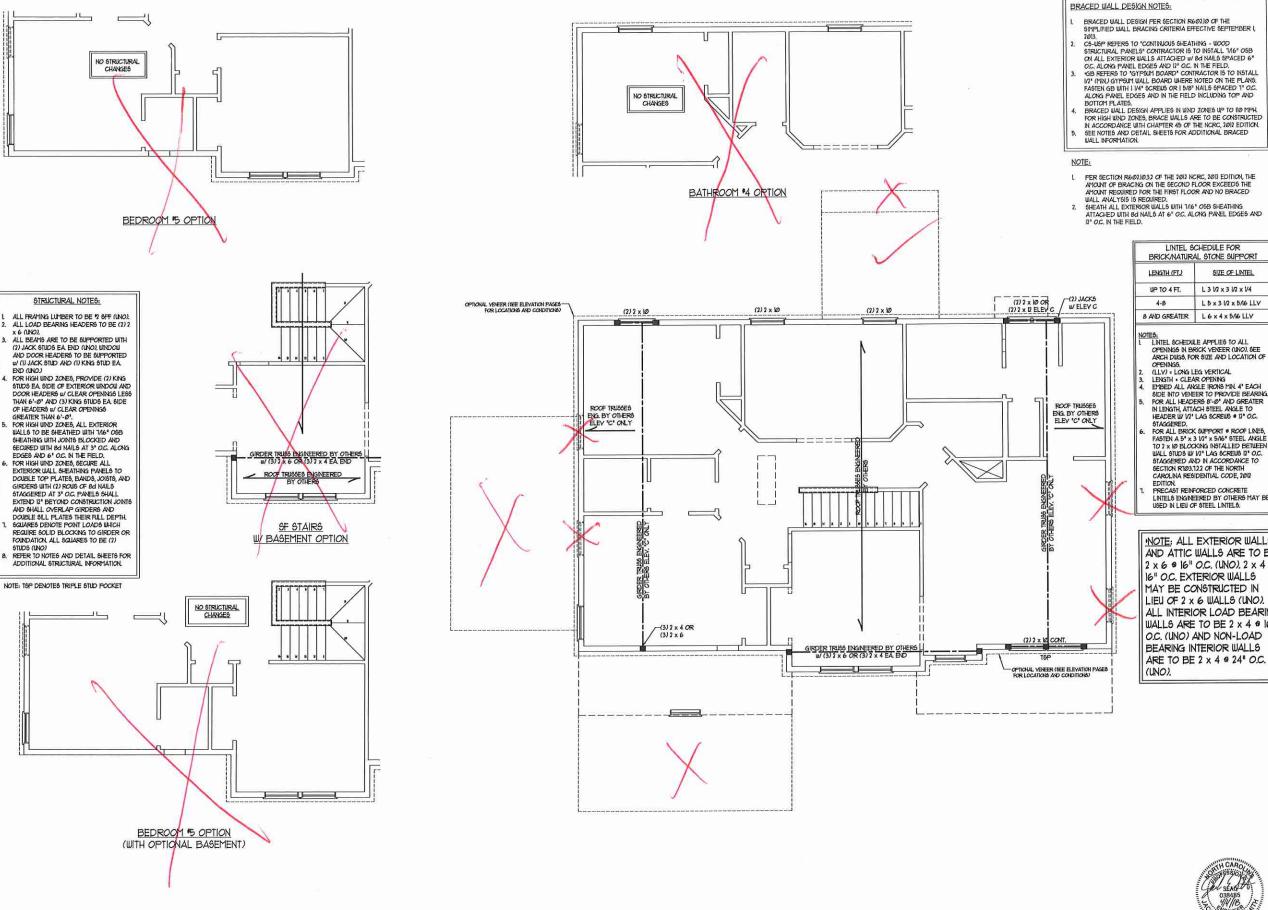



- BRACED WALL DESIGN FER SECTION REØILIØ OF THE SIMPLIFIED WALL BRACING CRITERIA EFFECTIVE SEPTEMBER I,

	CHEDULE FOR AL STONE SUPPORT
LENGTH (FT.)	SIZE OF LINTEL
UP TO 4 FT.	L 3 V2 x 3 V2 x V4
4-8	L 5 x 3 l/2 x 5/16 LLV
8 AND GREATER	L 6 x 4 x 5/16 LLV

- LINTEL SCHEDULE APPLIES TO ALL OPENINGS IN BRICK VENEER (UNO), SEE ARCH DUGS, FOR SIZE AND LOCATION OF

- HEADER W 1/1" LAG SCREUG 11" O.C.
 STAGGERED.
 FOR ALL BRICK SUPPORT ROOF LINES,
 FASTEN A 5" × 3 10" × 5/6" STEEL ANGLE
 TO 7 × 10 PLOCKYAS INSTALLED PETILETH
 WALL STUDS W 1/2" LAG SCREUB 11" O.C.
 STAGGERED AND IN ACCORDANCE TO
 SECTION RIPSJ122 OF THE NORTH
 CAROLINA RESIDENTIAL CODE, 2012
 EDITION
 - EDITION.
 PRECAST REINFORCED CONCRETE LINTELS ENGINEERED BY OTHERS MAY BE USED IN LIEU OF STEEL LINTELS.

NOTE: ALL EXTERIOR WALLS AND ATTIC WALLS ARE TO BE 2 x 6 @ 16" O.C. (UNO). 2 x 4 @ 16" O.C. EXTERIOR WALLS MAY BE CONSTRUCTED IN LIEU OF 2 x 6 WALLS (UNO). ALL INTERIOR LOAD BEARING WALLS ARE TO BE 2 x 4 @ 16" O.C. (UNO) AND NON-LOAD BEARING INTERIOR WALLS ARE TO BE 2 x 4 @ 24" O.C.



RENAISSANCE

RESIDENTIAL DESIGN, INC. 8810 GLENMIST CT. | RALEIGH, NC 27612 (919) 649-4128 WWW.RRDCAROLINA.COM The art of transforming your vision into re aity

J.S.THOMPSON ENGINEERING, INC 606 WADEAVE, SUITE 104 PALEIGH, NC 27605 PHONE: (019) 758-9919 FAX: (019) 758-9921 NC. LICENSENO.: C1733



H&H HOMES, IN WILMINGTON DRIVE LEFT

DATE: FEBRUARY 12, 2018

REV.:

SCALE: 1/4"=1'-0" DRAWN BY: WG

ENGINEERED BY: WLF

REVIEWED BY: JES

CEILING FRAMING PLAN

ATTIC VENT CALCULATION:

1994 SQ. FT. OF ATTIC DIVIDED BY 1500 REGUIRES 13.3 SQ. FT. OF NET FREE YENTILATING AREA (MIN.).

STRUCTURAL NOTES:

- STITUTE OF THE TO BE 12
 SEF (IND.)
 CIRCLES DENOTE (3) 2 x 4 POSTS
 FOR ROCE SUPPORT.
 RAME DON'ER WALLS ON TOP
 OF DOUBLE OR TIPLE RAFTERS.
 IN PS-LESS ARE TO BE SPACED
 A MIN OF 8 -0', FASTEN MEMBERS
 WITH THREE ROUS OF 2d MAILS 0
 16' OC. (TYP)
 3, STICK FRAME OVER FRAMED
 BOCE SECUROUS WILL A BRIDGES
- , STICK FRAME OVER-FRAMED

 ROOF SECTIONS W 2 x 8 RIDGES,
 2 x 6 RAFTERS 4 (6) O.C. AND


 H.AT 2 x 10 VALLEYS OR USE
 VALLEY TRUSSES.
 5. FASTEN H.AT VALLEYS TO

 BATTERS OF TRUSSES (1) TO

 BATTERS OF TRUSSES (1) TO
- RAFTERS OR TRUSSES WITH RAFTERS OR TRUSSES WITH SIMPSCN H25A HURRICANE TIES OF 32" OC. MAX. PASS HURRICANE TIES THROUGH NOTCH IN ROOF SHEATHING. EACH RAFTER IS TO BE FASTENED TO THE FLAT
- DE FASTENED TO THE FLAT
 VALLEY WITH A MIN OF (6) 12d
 TOE NAILS.
 RETER TO NOTES AND DETAIL.
 SHEETS FOR ADDITIONAL.
 STRUCTURAL INFORMATION.

BRICK SUPPORT NOTE:

- FOR BRICK SUPPORT ROOF LINES, BOLT A 5 * x 3 1/2 * x 5/6 * STEEL AVAILE TO 2 x 1/0 BLOCKING INSTALLED DETUREN WALL STUDS W 1/2 * LAG SCREWS TO* OC. 51 AGGERED AND IN ACCORDANCE WITH SECTION TRO3.122 OF THE NORTH CAROLINA RESIDENTIAL CODE, 2/0/2 EDITION!
- EDITION.
 WHERE ROOF SLOPES EXCEED 1:12, NSTALL 3° x 3° x 1/4° STEEL PLATE STOPS AT 24°
 O.C. PER SECTION R103.12.1 OF THE NORTH
 CAROLINA RESIDENTIAL CODE, 2012
 EDITION

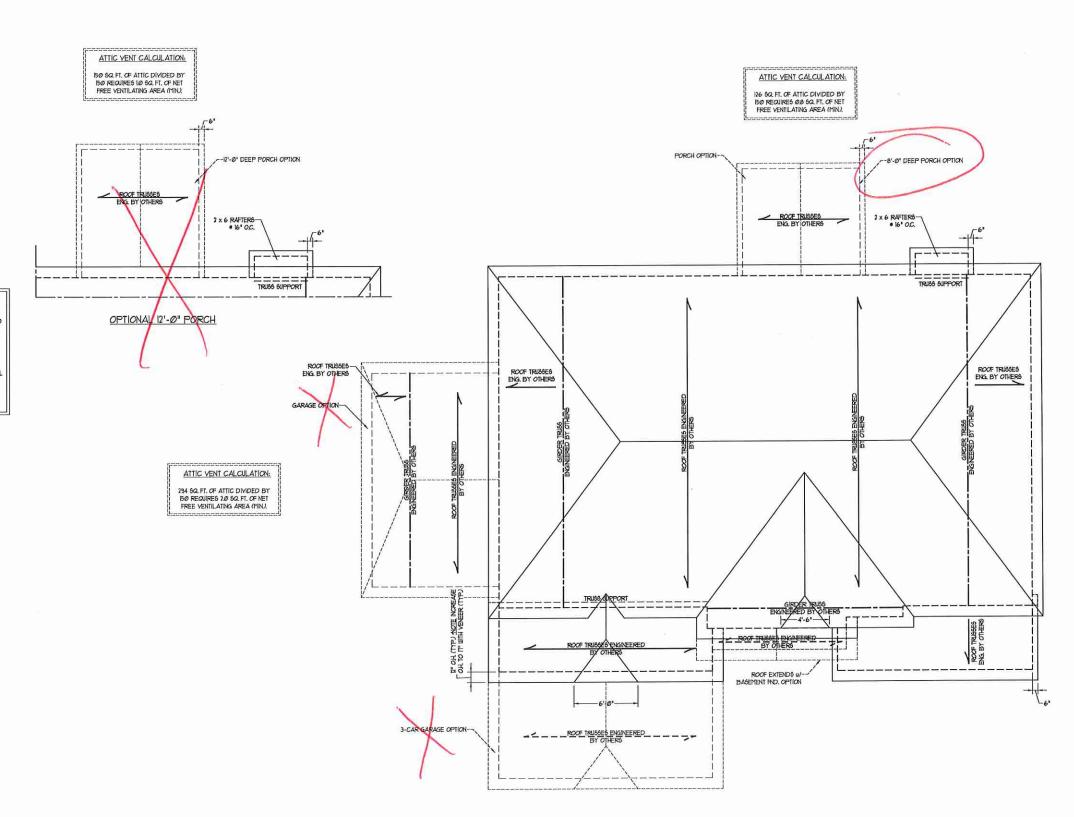





RENAISSANCE

RESIDENTIAL DESIGN, INC.
4810 GLENMIST CT. | RALEIGH, NC 27612
(919) 649-4128
WWW.RRDCAROLINA.COM
"The an of transforming your vision into re stry."

J.S.THOMPSON ENGINEERING, INC (68 WADE AVE. SUITE IN RALEIGH, NC 27605 PHONE (1919 789991 FAX, 1919 789921 N.C. LICENSE NO. 2 C1733





H&H HOMES, INC. WILMINGTON DRIVE LEFT


DATE: FEBRUARY 12, 2018 REV.:

SCALE: 1/4"=1'-0"


DRAWN BY: WG ENGINEERED BY: WLF


REVIEWED BY: JES


ROOF PLAN ELEVATION - C

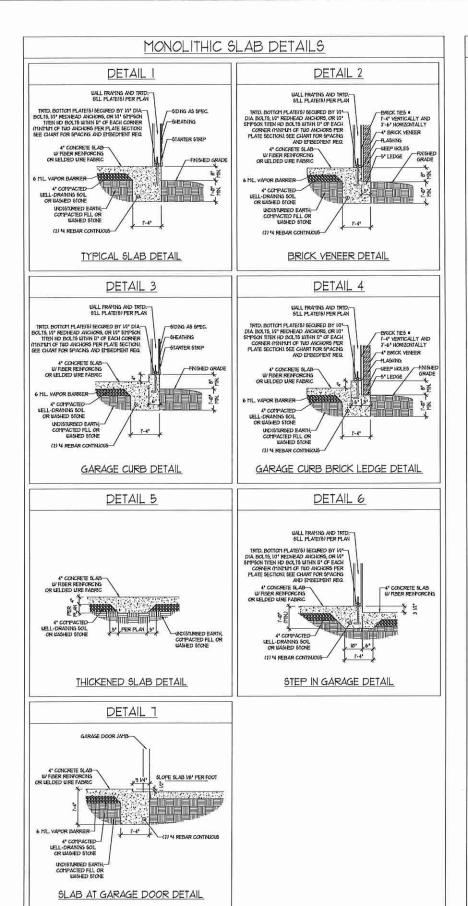


STEMWALL DETAILS

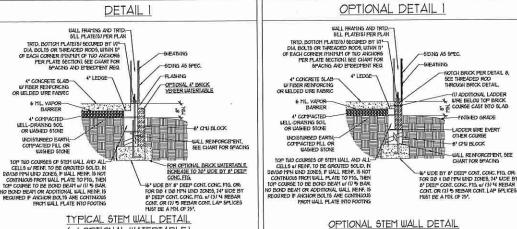

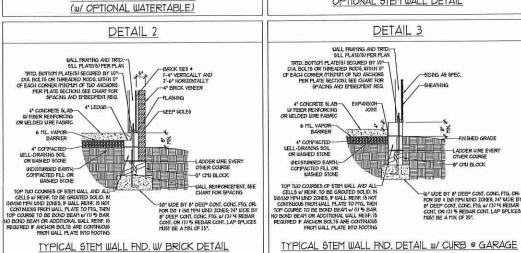


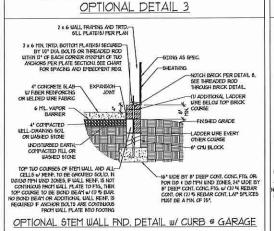

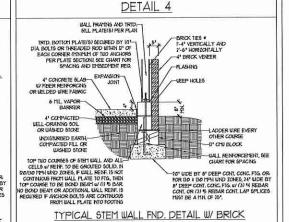

FINSHED GRADE

LADDER USE EVERY OTHER COURSE

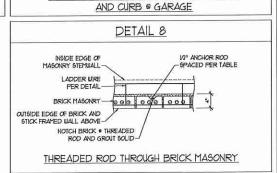

YARYARYARYARYARY

Signal Si ശ Q Q 56 8 8 RIN 104 RALE O IN SE 工皿 EZ. · C WAN S **22** %

STRUCTURAL NOTES:

WALL HEIGHT MEASURED FROM TOP OF FOOTING TO TOP OF THE WALL. TIE MULTIPLE WYTHES TOGETHER WITH LADDER WIRE AT 16" O.C. VERTICALLY

MASONRY STEMWALL SPECIFICATIONS

4" BRICK AND 4"

CMU

GROUT SOLID

GROUT SOLID

GROUT SOLID W 14

NOT APPLICABLE

NOT APPLICABLE

MASONRY WALL TYPE

ENGINEERED DESIGN BASED ON SITE CONDITIONS

4" BRICK AND 8"

UNGROUTED

UNGROUTED

GROUT SOLID

REBAR # 36' O.C.

GROUT SOLID w/ 14 GROUT SOLID w/ 14

GROUT SOLID w/ 14 GROUT SOLID w/ 14 REBAR @ 24" O.C. REBAR @ 64" O.C.

12" CMU

UNGROUTED

UNGROUTED

GROUT SOLID w/ *4 REBAR # 64* O.C.

REBAR # 64" OC

8' CM

UNGROUTED

UNGROUTED

GROUT SOLID

GROUT SOLID u/ 4 REBAR # 36" O.C.

GROUT SOLID w/ 4

REBAR # 24" O.C.

WALL HEIGHT

2 AND BELOW

4

6

AND GREATER

2. THE PULLTIFICE WITHERS TOGETHER WITH LADDER WIRE AT 16" OC. VERTICALLY.
3. CHART APPLICABLE FOR HOUSE FOUNDATION ONLY. CONSULT ENGINEER FOR DESIGN OF GARAGE FOUNDATION NOT COPICION TO HOUSE.
4. BACKFILL, OF CLEAN 51 / 16" WASHED STONE IS ALLOWABLE.
5. BACKFILL OF GHELL DRANDED OR SAND - GRAVEL INTRIVERS SOILS (15 PSF-FT BELOW GRADE)
CLASSFIED AS GROUP I ACCORDING TO UNIFIED SOILS CLASSIFICATION SYSTEM IN ACCORDANCE WITH TABLE RADS OF THE 2012 INTERNATIONAL RESIDENTIAL CODE ARE ALLOWABLE.
6. PREP SLAD PER SEGGE JAM DESIGNEY
MINIMA 14" LAP SPLICE LENGTH.
1. COCATE SEGRED IN CENTER OF ET AND STATEMENT OF THE 2012 INTERNATIONAL RESIDENTIAL CODE.

LOCATE REBAR IN CENTER OF FOUNDATION WALL.

LUCATE REQUIRED, FILL BLOCK SOLID WITH TYPE "5" HORTAR OR 3000 PSI GROUT, USE OF "LOW LIFT GROUTING" HETHOD REQUIRED WERN FILLING WALLS WITH GROUT AT HEIGHTS OF 5" AND GREATER

ANCH	OR SPACING AND	EMBEDMENT
WIND ZONE	100 MPH	IIØ MPH
6PACING	6'-0' O.C. 3'-0" O.C. FOR STRAPS	4'-0" O.C. 2'-0" O.C. FOR STRAPS
EMBEDMENT	3"	15" INTO MASONRY 1" INTO CONCRETE
WIND ZONE	12Ø MPH	130 MPH
SPACING	6'-0" O.C. w/ DBL. SILL FLATE OR 4'-0" O.C. w/ SINGLE SILL FLATE w/ 2" x 2" x 1/8" WASHERS	6'-0" O.C. u/ DBL. SILL PLATE OR 4'-0" O.C u/ SINGLE SILL PLATE u/ 2" x 2" x 1/6" WASHERS
EMBEDMENT	15" INTO MASONRY 1" INTO CONCRETE	15" INTO MASONRY 1" INTO CONCRETE

NOTE: HORIZONTAL FOOTING REBAR REQUIRED IN HIGH WIND ZONES ONLY (120 MPH - 130 MPH)

> DATE: DECEMBER 22, 2017 SCALE: NTS RAWN BY: 157 INEERED BY: JES

DETAILS


FOUNDATION


D-1 FOUNDATION DETAILS




GENERAL WALL BRACING NOTES:


- WALL BRACING DESIGNED IN ACCORDANCE WITH CHAPTER 6 OF THE 2012 NC RESIDENTIAL BUILDING CODE INCRC). TABLES AND FIGURES REFERENCED ARE FROM THE 2012 NORC.
- AND FROMES REFERENCED AND HIGH THE 1901 NCRC.
 SEE THIS SHEET FOR GENERAL DETAILS, REFER TO THE 2011 NCRC FOR ADDITIONAL INFORMATION AS NEEDED,
 SEE STRICTURAL SHEETS FOR BRACED WALL LOCATIONS, DIMENSIONS, HOLD DOWN TYPE AND LOCATIONS, BRACED WALL LINE
 KEY WITH WALL DESIGN SUMMARY OF REQUIRED/PROVIDED TOTALS FOR EACH WALL LINE AND ANY SPECIAL NOTES OR
- ALL EXTERIOR WALLS ARE TO BE SHEATHED WITH CS-WSP IN ACCORDANCE WITH SECTION R600.103 UNLESS NOTED
- ALL EXTERIOR AND INTERIOR WALLS TO HAVE IZ! GYPSIM INSTALLED, WHEN NOT USING METHOD 'GB!', GYPSIM TO BE
- INCLUDING TOP AND BOTTOM PLATES AND INTERMEDIATE SUPPORTS (UND.). YERRY ALL FASTENER OPTIONS FOR IZ! AND 5/8" GYPSUM PRIOR TO CONSTRUCTION. FOR INTERIOR FASTENER OPTIONS SEE TABLE 17(02.35. FOR EXTERIOR FASTENER OPTIONS SEE TABLE R6/023(1). EXTERIOR GB TO BE NATALLED VERTICALLY.
- REQUIRED BRACED WALL LENGTH FOR EACH SIDE OF THE CIRCUMSCRIBED RECTANGLE ARE INTERPOLATED FER TABLE REWOLDS, NETHOD CS-USP CONTRIBUTES ITS ACTUAL LENGTH, PETHOD GB CONTRIBUTES 5 ITS ACTUAL LENGTH, AND PETHOD FF CONTRIBUTES IS TIMES ITS ACTUAL LENGTH.

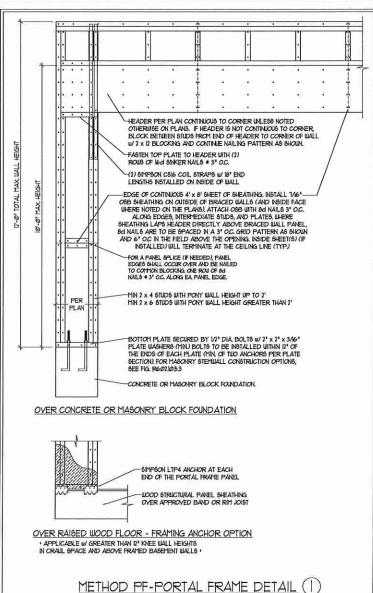


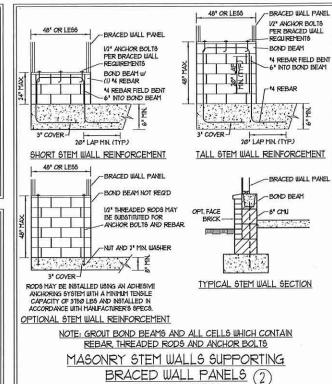

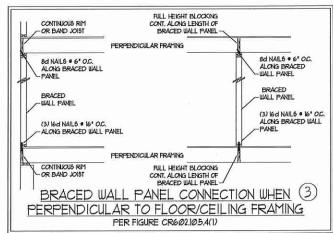



PER FIGURE R602.1053

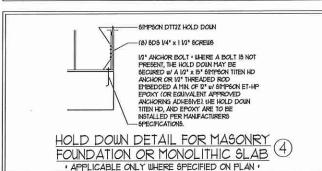


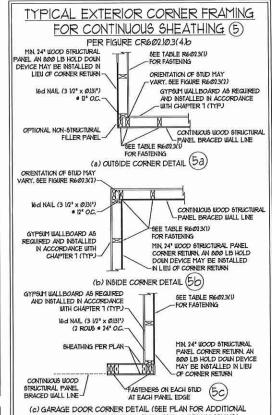



STRUCTURAL INFORMATION OR ALTERNATE CONFIGURATIONS)

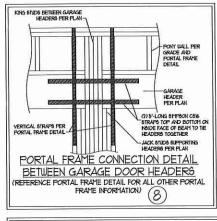

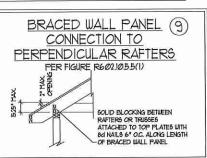

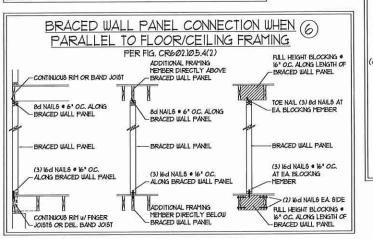

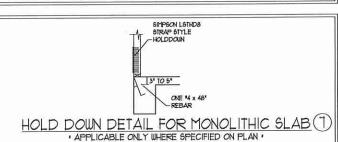

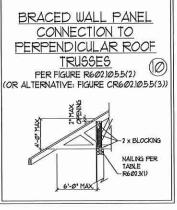



This sealed page is to be used in conjunction with a full ered by J.S. Thompson Engineering, Inc. only. Use of this individual sealed page within architectural pages or shop drawings by others is a punishable uffense under N.C. Statute § 89C23

OZ. S 0 OL 工世 Z. တ်စြဲ **Z** 909

XXXXXXXXXXXXXXXXXXX

DETAIL AND BRACING NOTES WALL

DATE: MARCH 19, 2018

CALE: NONE

GINEERED BY: JST


REVIEWED BY: 1ES


D-2 BRACED WALL AND PORTAL FRAME DETAILS NOTE: LOCATE REBAR MIN 3" ABOVE BOTTOM OF FOOTING w/ MIN 25" LAP SPLICE LENGTH.

This sealed nave is to be used in conjunction with a full plan set engineered by J.S. Thompson Engineering Inc. only. Use of this individual sealed page within architectural pages or shop drawings by others is a punishable offense under N.C. Statute § 89C23

ANCHOR SPACING AND EMBEDMENT				
WIND ZONE	IDD MPH	IIØ MPH	120 MPH	130 МРН
SPACING.	6'-0" O.C. 3'-0" O.C. FOR STRAPS	4'-0" O.C. 2'-0" O.C. FOR STRAPS	6'-0" O.C. W DBL. SILL PLATE OR 4'-0" O.C W/ SINGLE SILL PLATE W/ 2" x 2" x V8" WASHERS	6'-0" O.C. W DBL. SILL PLATE OR 4'-0" O.C w/ SINGLE SILL PLATE w/ 2" x 2" x V8" WASHERS
EMBEDMENT	7*	7*	7*	7*

-2 x 6 STUD FRAMING (UND) TRTD. BOTTOM PLATE(S) SECURED BY -W TRID. BOTTOM PLATE IN' DIA BOLTS WITHIN IT' OF EACH BRICK TIES . CORNER (MINIMUM OF TWO ANCHORS PER 1'-4" VERTICALLY AND PLATE SECTION, SEE CHART FOR SPACING AND EMBEDMENT REG 2'-6" HORIZONTALLY -4" BRICK VENEER FLASHING 4º CONCRETE SLAB-W FIBER REINFORCING OR WELDED WIRE FABRIC WEEP HOLES 5" LEDGE 4" WASHED STONE INDISTURBED FARTH COMPACTED FILL OR WASHED STONE PER PLAN FINISHED GRADI IN HIGH WIND ZONES-TYPICAL SLAB W/ BRICK VENEER LEDGE

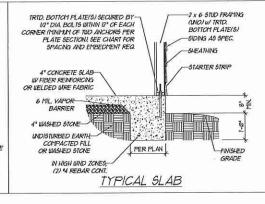

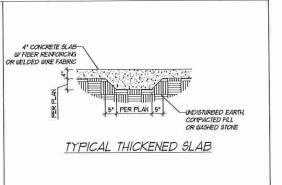

2 5 0 S (O) 5 2 0 Z ھ≷ق S

ш

DETAILS. AL NOTE FOUNDATION I

DATE: DECEMBER 22, 2017 TALE NTS

D-3 FOUNDATION DETAILS AND STRUCTURAL NOTES

INFERED BY: 155

GENERAL NOTES

- L ENGINEER'S SEAL APPLIES ONLY TO STRUCTURAL COMPONENTS INCLIDING ROOF RAFTERS, HIPS, VALLEYS, RIDGES, FLOORS, WALLS, BEAMS, HEADERS, COLUMNS, CANTILEVERS, OFFSET LOAD BEARNS WALLS, PIERS, GIRDER SYSTEM AND FOOTING. EXCINEER'S SEAL DOES NOT CERTIFY DIMENSIONAL ACCURACY OF ARCHITECTURAL LAYOUT INCLUDING ROOF. ENGINEER'S SEAL DOES NOT APPLY TO 1-JOIST OR FLOOR/ROOF TRUSS LAYOUT DESIGN AND ACCURACY.
- 2. ALL CONSTRUCTION SHALL CONFORM TO THE LATEST REQUIREMENTS OF THE NORTH CAROLINA RESIDENTIAL CODE (NCRC), 2012 EDITION, PLUS ALL LOCAL CODES AND REGULATIONS. THE STRUCTURAL ENGINEER IS NOT RESPONSIBLE FOR AND WILL NOT HAVE CONTROL OF NSTRUCTION MEANS, METHODS, TECHNIQUES, SEQUENCES OR PROCEDURES, OR SAFETY PRECAUTIONS AND PROGRAMS IN CONNECTION WITH THE CONSTRUCTION WORK. NOR WILL THE ENGINEER BE RESPONSIBLE FOR THE CONTRACTORS FAILURE TO CARRY OUT THE CONSTRUCTION WORK IN ACCORDANCE WITH THE CONTRACT DOCUMENTS
- STRUCTURAL DESIGN BASED ON THE PROVISIONS OF THE NORC, 2012 EDITION (R3014 R3017)

DESIGN CRITERIA:	LIVE LOAD (PSF)	DEAD LOAD (PSF)	DEFLECTION (I
ATTIC WITH LIMITED STORAGE	20	lø	L/240
ATTIC WITHOUT STORAGE	1Ø	lø.	L/360
DECK8	40	10	L/360
EXTERIOR BALCONIES	40	100	L/360
FIRE ESCAPES	40	1Ø	L/360
HANDRAILS/GUARDRAILS	200 LB OR 50 (PLF)	10	L/36Ø
PASSENGER VEHICLE GARAGE	50	10	L/360
ROOMS OTHER THAN SLEEPING ROO	40	10	L/36Ø
SLEEPING ROOMS	30	100	L/360
STAIRS	40	10	L/360
WIND LOAD	(BASED ON FIGURE R3/012(4) WIND ZONE AND EXPOSURE)		
GROUND SHOW LOAD: Pg	20 (PSF)		

- 1-JOIST SYSTEMS DESIGNED WITH 12 PSF DEAD LOAD AND DEFLECTION (IN) OF L/480
- FLOOR TRUSS SYSTEMS DESIGNED WITH IS PSF DEAD LOAD
- FOR 90 AND 100 MPH WIND ZONES, FOUNDATION ANCHORAGE IS TO COMPLY WITH SECTION R40316 OF THE NORC, 2012 EDITION. FOR 100 MPH, 120 MPH, AND 130 MPH WIND ZONES, FOUNDATION ANCHORAGE IS TO COMPLY WITH SECTION 4504 OF THE NORC, 2012 EDITION.
- 5. ENERGY EFFICIENCY COMPLIANCE AND INSULATION VALUES OF THE BUILDING TO BE IN ACCORDANCE WITH CHAPTER II OF THE NORC, 2012

FOOTING AND FOUNDATION NOTES

- I, FOUNDATION DESIGN BASED ON A MINIMUM ALLOUABLE BEARING CAPACITY OF 2000 PSF. CONTACT GEOTECHNICAL ENGINEER IF BEARING
- 2. FOR ALL CONCRETE SLABS AND FOOTINGS, THE AREA WITHIN THE PERMETER OF THE BUILDING ENVELOPE SHALL HAVE ALL YEGETATION, TOP SOIL AND POREIGN MATERIAL REPOVED. FILL MATERIAL SHALL BE FREE OF VEGETATION AND POREIGN MATERIAL. THE FILL SHALL BE COMPACIED TO ASSURE INFORM SUPPORT OF THE SLAB, AND EXCEPT UNERE APPROVED, THE FILL DEPTHS SHALL NOT EXCEED 24" FOR CLEAN SAND OR GRAVEL A 4" THICK BASED COURSE CONSIST COURSE IA NOT REQUIRED WHERE A CONCRETE SLAB IA NATALLED ON HELL-DRAINED OR BAND-GRAVEL MIXTURE SOILS OF ASSETS AS GROUP I ACCORDING TO THE INITED SOIL CLASSFICATION SYSTEM IN ACCORDANCE WITH TABLE RAPS OF THE NORC 2012 EDITIO
- PROFERLY DEMATER EXCAYATION PRIOR TO POURNIG CONCRETE WHEN BOTTOM OF CONCRETE 6LAB IS AT OR BELOW WATER TABLE. F
 APPLICABLE, 3/4" I' DEEP CONTROL JONTS ARE TO BE SAMED WITHIN 4 TO 02 HOURS OF CONCRETE FINISHING AND WALL LOCATIONS HAVE
 BEEN MARKED. ADJUST WHERE NECESSARY.
- 4. CONCRETE SHALL CONFORM TO SECTION R4022 OF THE NORC, 2012 EDITION, CONCRETE REINFORCING STEEL TO BE ASTM AGIS GRADE 6.0. WELDED WIRE FABRIC TO BE ASIM AUS. MANTAN A MINIMICONCRETE COVER AROUND RENFORCING STEEL OF 3" IN FOOTINGS AND 1 1/2" IN SLABS. FOR POURED CONCRETE WALLS, CONCRETE COVER FOR REINFORCING STEEL MEASURED FROM THE INSIDE FACE OF THE WALL SHALL. NOT BE LESS THAN 3/4" CONCRETE COVER FOR RENEORCING STEEL MEASURED BROW THE QUITALDE FACE OF THE HIALL SHALL NOT BE LESS THAN I 1/2" FOR "5 BARS OR SMALLER, AND NOT LESS THAN 2" FOR "6 BARS OR LARGE
- 5. MASONRY UNITS TO CONFORM TO ACE 530/ASCE 5/TMS 402. MORTAR SHALL CONFORM TO ASTM C210
- 6. THE INSUPPORTED HEIGHT OF MASONRY PIERS SHALL NOT EXCEED FOUR TIMES THEIR LEAST DIMENSION FOR UNFILLED HOLLOW CONCRETE MASONRY UNITS AND TEN TIMES THEIR LEAST DIMENSION FOR SOLID OR SOLID FILLED PIERS. PERS MAY BE FILLED SOLID WITH CONCRETE OR TYPE M OR 6 MORTAR PIERS AND WALLS SHALL BE CAPPED WITH 8" OF SOLID MASONRY.
- 1. THE CENTER OF EACH OF THE PIERS SHALL BEAR IN THE MIDDLE THIRD OF ITS RESPECTIVE FOOTING EACH GIRDER SHALL BEAR IN THE
- 8. ALL CONCRETE AND MASCHINY FOUNDATION WALLS ARE TO BE CONSTRUCTED IN ACCORDANCE WITH THE PROVISIONS OF SECTION R404 OF THE INCRC, 2012 EDITION OR IN ACCORDANCE WITH ACI 318, ACI 339, INCINA TRASS-A OR ACE 530/ASCC 57/THS 407, MASCHINY FOUNDATION WALLS ARE TO BE REMPORCED PER TABLE R404/LIX), R404/LIX), R404/LIX), R404/LIX) OR R404/LIX OF THE INCRC, 2012 EDITION. CONCRETE FOUNDATION WALLS AT TO BE REMPORCED PER TABLE R404/LIX) OF THE INCRC, 2012 EDITION. STEP CONCRETE FOUNDATION WALLS TO 2 % 6 FRAMED WALLS AT

FRAMING NOTES

- ALL FRAMING LUMBER SHALL BE 12 SPF MINIMUM (Fb = 815 PSI, Fv = 315 PSI, E = 16000000 PSI) UNLESS NOTED OTHERUISE (UNO). ALL TREATED LUMBER SHALL BE 2 SYP MINMUM (Ho . 915 PS), BY . 115 PS), E . 16000000 PS)) UNLESS NOTED OTHERWISE (UNO).
- LAMINATED VENEER LUMBER (LVL.) SHALL HAVE THE FOLLOWING MINIMUM PROPERTIES: Ho =2600 PSI, Fy = 265 PSI, E = 1900000 PSI. LAMINATED STRAND LIMBER (I.S.) SHALL HAVE THE FOLLOWING MINIMAL PROFERTIES. FO = 2325 PSI, FV = 380 PSI, E = 8500000 PSI.
 PARALLEL STRAND LIMBER (PSI.) UP TO 1" DEPTH SHALL HAVE THE FOLLOWING MINIMAL PROFERTIES. FC = 2500 PSI, E = 18000000 PSI. PARALLEL STRAND LUMBER (PSL) MORE THAN 1" DEPTH SHALL HAVE THE FOLLOWING MINIMUM PROPERTIES: Fc = 2900 PSI, E = 20000000 PSI. INSTALL ALL CONNECTIONS FER MANUFACTURER'S SPECIFICATIONS.
- ATEXICATIONS ATTER AUGUL CONFORM TO THE FOLLOWING ASTM SPECIFICATIONS


DISCOUNT DIFFE OWNER COLOURS			LOTTONIA WOLL OF TOX IONLINE
	A	W AND WT SHAPES:	A5TM A992
	B.	CHANNELS AND ANGLES:	ASTM A36
	C.	PLATES AND BARS:	ASTM A36
	D.	HOLLOW STRUCTURAL SECTIONS:	ASTM A500 GRADE B
	E.	STEEL PIPE:	ASTM A53, GRADE B, TYPE E OR :

4. STEEL BEAMS SHALL BE SUPPORTED AT EACH END WITH A MINIMUM BEARING LENGTH OF 3 1/2" AND FULL FLANGE WIDTH (UNO), PROVIDE SOLID BEARING FROM BEAM SUPPORT TO FOUNDATION. BEAMS SHALL BE ATTACHED AT THE BOTTOM FLANGE TO EACH SUPPORT AS

A WOOD FRAMING (2) 1/2" DIA x 4" LONG LAG SCREUS (2) V2" DIA x 4" WEDGE ANCHORS B. CONCRETE C. MASONRY (RILLY GROUTED) (2) I/O DIA x 4" I ONG SIMPSON TITEN HD ANCHORS

LATERAL SUPPORT IS CONSIDERED ADEQUATE PROVIDING THE JOISTS ARE TOO NAILED TO THE 2x NAILER ON TOP OF THE STEEL BEAM, AND THE 2x NAILER IS SECURED TO THE TOP OF THE STEEL BEAM w/ (2) ROUS OF SELF TAPPING SCREUS & 16" O.C. OR (2) ROUS OF I/A" DIAMETER BOLTS & 16" O.C. IF I/A" BOLTS ARE USED TO FASTEN THE NAILER, THE STEEL BEAM SHALL BE FABRICATED w/ (2) ROUS OF 9/6" DIAMETER

- 5. SQUARES DENOTE POINT LOADS WHICH REQUIRE SOLID BLOCKING TO GIRDER OR FOUNDATION, SHADED SQUARES DENOTE POINT LOADS FROM ABOVE WHICH REQUIRE BOLID BLOCKING TO SUPPORTING MEMBER BELOW.
- 6. ALL LOAD BEARING HEADERS TO CONFORM TO TABLE RE0025(1) AND RE0025(2) OF THE NORC, 2012 EDITION OR BE (2) 2 x 6 WITH (1) JACK (1) KING STUD EACH END (UNO), WHICHEVER IS GREATER ALL HEADERS TO BE SECURED TO EACH JACK STUD WITH (4) 8d NAILS. ALL BEAMS TO BE SUPPORTED WITH (2) STUDS AT EACH BEARING POINT (UNO).
- 1. ALL BEAMS, HEADERS, OR GIRDER TRUSSES PARALLEL TO WALL ARE TO BEAR FULLY ON (1) JACK OR (2) STUDS MINIMUM OR THE NUMBER OF JACKS OR STUDS NOTED. ALL BEAMS OR GIRDER TRUSSES PERPENDICULAR TO WALL AND SUPPORTED BY (3) STUDS OR LESS ARE TO HAVE I 1/2" MINIMUM BEARING (INO). ALL BEAMS OR GIRDER TRUSSES PERPENDICULAR TO BUILL AND SUPPORTED BY MORE THAN (3) STUDS OR OTHER NOTED COLUMN ARE TO BEAR FULLY ON SUPPORT COLUMN FOR ENTIRE WALL DEPTH (UNO). BEAM ENDS THAT BUTT INTO ONE ANOTHER ARE TO EACH BEAR EQUAL LENGTHS (UNO)
- 8. FLITCH BEAMS SHALL BE BOLTED TOGETHER USING 1/2" DIAMETER BOLTS (ASTM A3/01) WITH WASHERS PLACED AT THREADED END OF BOLT. BOLTS SHALL BE SPACED AT 24" CENTERS (MAXIMUM), AND STAGGERED AT TOP AND BOTTOM OF BEAM (2" EDGE DISTANCE), WITH (2) BOLTS
- ALL I-JOIST OR TRUSS LAYOUTS ARE TO BE IN COMPLIANCE WITH THE OVERALL DESIGN SPECIFIED ON THE PLANS, ALL DEVIATIONS ARE TO BE BROUGHT TO THE ATTENTION OF THE ENGINEER OF RECORD PRIOR TO INSTALLATION
- 10. BRACED WALL PANELS SHALL BE CONSTRUCTED ACCORDING TO THE CURRENT NORTH CAROLINA RESIDENTIAL CODE WALL BRACING CRITERIA THE AMOUNT, LENGTH, AND LOCATION OF BRACING SHALL COMPLY WITH ALL APPLICABLE TABLES IN SECTION REGISTA
- IL PROVIDE DOUBLE JOIST UNDER ALL WALLS PARALLEL TO FLOOR JOISTS. PROVIDE SUPPORT UNDER ALL WALLS PARALLEL TO FLOOR TRUSSES OR 1-JOISTS PER MANUFACTURER'S SPECFICATIONS. INSTALL BLOCKING BETWEEN JOISTS OR TRUSSES FOR POINT LOAD SUPPORT FOR ALL POINT LOADS ALONG OFFSET LOAD LINES.
- 12. FOR ALL HEADERS SUPPORTING BRICK VENEER THAT ARE LESS THAN 8"-0" IN LENGTH, REST A 6" x 4" x 5/6" STEEL ANGLE WITH 6" MINIMUM EMBEDDEN AT SIDES FOR BRICK SUPPORT. FOR ALL HEADERS 8'-8" AND GREATER IN LEVATH, BOLT A 6" x 4" x 5/6" STELL AVAILE TO HEADER WITH 12" LAG SCREUS AT 12" O.C. STAGGERED FOR BRICK SUPPORT. FOR ALL BRICK SUPPORT AT ROOF LINES, BOLT A 6" x 4" x 5/16" STEEL ANGLE TO 2 x 10 BLOCKING INSTALLED BETWEEN WALL STUDS WITH 1/2" LAG SCREWS AT 12" O.C. STAGGERED AND IN ACCORDANCE WITH SECTION R103,722 OF THE NCRC, 2012 EDITION
- B, FOR STICK FRAMED ROOFS; CIRCLES DENOTE (3) 2 x 4 POSTS FOR ROOF MEMBER SUPPORT. HIP SPLICES ARE TO BE SPACED A MINIMUM OF 8'-8". FASTEN MEMBERS WITH THREE ROUS OF DID NAILS AT 16" O.C. FRAME DORMER WALLS ON TOP OF DOUBLE OR TRIPLE RAFTERS AS
- 14. FOR TRUBSED ROOFS, FRAME DORMER WALLS ON TOP OF 2 x 4 LADDER FRAMING AT 24" O.C. BETWEEN ADJACENT ROOF TRUBSES. STICK FRAME OVER-FRAMED ROOF SECTIONS WITH 2 x 8 RIDGES, 2 x 6 RAFTERS AT 16" O.C. AND FLAT 2 x 10 VALLEYS (UNO)
- 5. ALL 4 x 4 AND 6 x 6 POSTS TO BE INSTALLED WITH 100 LB CAPACITY UPLIFT CONNECTORS TOP AND BOTTOM (UNO.) POSTS MAY BE SECURED USING ONE SIMPSON HE OR LIBID UPLIFT CONNECTOR FASTENED TO THE BAND AT THE BOTTOM AND THE BEAM AT THE TOP OF EACH POST. ONE IS "SECTION OF SIMPSON CISIC COIL STRAFPING WITH (8) BUT HOS NAILS AT EACH END MAY BE USED IN LIEU OF EACH TWIST STRAP IF DESIRED. FOR MASONRY OR CONCRETE FOUNDATION USE SIMPSON POST BASE.

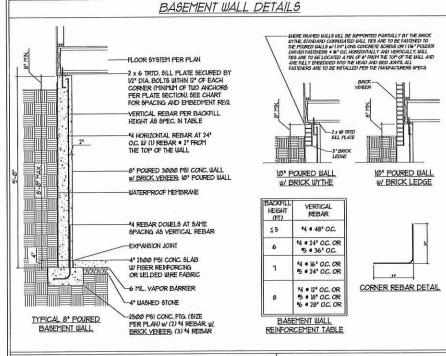

STRUCTURAL NOTES:

- FOR "4 REBAR, 24" MINIMIM REBAR LAP SPLICE LENGTH, FOR "5 REBAR, 33" MINIMIM REBAR LAP SPLICE LENGTH, FOR "5 REBAR, 33" MINIMIM REBAR LAP SPLICE LENGTH, FREBAR TO MAINTAIN A MINIMIM CONCRETE COVER TO BOILS OF 3" AND TO FORTHORK OR AIR OF 3" (AND).
 REBAR TO BE ASIM A65 GRADE 60.

(3) 12d NAILS EACH END

- SOIL BEARNING CAPACITY IS REQUIRED TO BE 2000 PSF MN.
 NSTALL 14 L-BARS AT ALL WALL CORNERS AT 84YE SPACING AS HORIZ STEEL. SEE
- ALCUITE CONCRETE TO CARE BEFORE THE BACKFILL OATH BE NOTALLED. THE BACKFILL IS RECOYNED TO BE PLACED IN D'I LIFTS AND CAREFULLY TAPPED.

 A 14 LEDGE IS TO BE PROVIDED FOR THE PORCH SLAB. THE WALLS ARE REGULRED TO BE SONDED TO THE SLABS USING "4 x 36" REBAR DOUBLE 32" O.C. EMBEDDED 4" INTO THE

DIE H COR FRANKS IS TO BE NATALLED AND A MIN OF SEVEN DAYS IS REQUIRED TO

HILERE THE FLOOR JOISTS ARE PARALLEL TO THE WALLS, 2 x 4 BLOCKING IS TO BE NSTALLED 24" OC. BETWEEN THE BOTTOM HANSES OF THE FLOOR SYSTEM FOR A HIN OF 6"-9" AMAY FROM THE WALL OR DIAGONAL 7 x 6 BLOCKS NAY BE NSTALLED 24" OC. FROM THE BOOK OF THE SILL PLATE TO THE TOP FLAKE AND SUBLOCKNIX, ATTACHED W

NOTE TO FOUNDATION CONTRACTOR:

ALTERNATE REINFORCED CONCRETE POURED WALL DESIGNS ENGINEERED BY OTHERS MAY BE CONSTRUCTED, NO CONTINUOUS FOOTINGS OR LUG FOOTINGS MAY BE REDUCED IN SIZE.



GENERAL NOTES

- ENGINEER'S SEAL APPLIES ONLY TO STRUCTURAL COMPONENTS INCLUDING ROOF RAFTERS, HIPS, VALLEYS, RIDGES, FLOORS, WALLS, BEAMS, HEADERS, COLUMNS, CANTILLEVERS, OFFSET LOAD BEARING WALLS, PIERS, GIRDER SYSTEM AND FOOTING. ENGINEER'S SEAL DOES NOT CERTIFY DIMENSIONAL ACCURACY OF ARCHITECTURAL LAYOUT INCLUDING ROOF, ENGINEER'S SEAL DOES NOT APPLY TO 1-JOIST OR FLOOR/ROOF TRUSS LAYOUT DESIGN AND ACCURACY.
- 2. ALL CONSTRUCTION SHALL CONFORM TO THE LATEST REQUIREMENTS OF THE NORTH CAROLINA RESIDENTIAL CODE (NCRC), 2012 EDITION, PLUS ALL LOCAL CODES AND REGULATIONS. THE STRUCTURAL ENGINEER IS NOT RESPONSIBLE FOR AND WILL NOT HAVE CONTROL OF CONSTRUCTION MEANS METHODS. TECHNIQUES SEQUENCES OR PROCEDURES OR SAFETY PRECAUTIONS AND PROGRAMS IN CONNECTION WITH THE CONSTRUCTION WORK NOR WILL THE ENGINEER BE RESPONSIBLE FOR THE CONTRACTORS FAILURE TO CARRY OUT THE CONSTRUCTION WORK IN ACCORDANCE WITH THE CONTRACT DOCUMENTS
- 3. STRUCTURAL DESIGN BASED ON THE PROVISIONS OF THE NORC, 2012 EDITION (R3014 R3011)

DESIGN CRITERIA:	LIVE LOAD (PSF)	DEAD LOAD (PSF)	DEFLECTION (IN)
ATTIC WITH LIMITED STORAGE	20	Ю	L/240
ATTIC WITHOUT STORAGE	100	10	L/360
DECKS	40	Ø	L/360
EXTERIOR BALCONIES	40	lø	L/360
FIRE ESCAPES	40	Ø	L/360
HANDRAILS/GUARDRAILS	200 LB OR 50 (PLF)	10	L/360
PASSENGER VEHICLE GARAGE	50	100	L/36Ø
ROOMS OTHER THAN SLEEPING ROO	40	Ю	L/360
BLEEPING ROOMS	3Ø	Ø	L/360
STAIRS	40	lø .	L/360
WIND LOAD	(BASED ON FIGURE R30(2(4) WIND ZONE AND EXPOSURE)		
GROUND SNOW LOAD: Pg	20 (PSF)		

- 1-JOIST SYSTEMS DESIGNED WITH 12 PSF DEAD LOAD AND DEFLECTION (IN) OF L/480
- 4. FOR 90 AND 100 MPH WIND ZONES, FOUNDATION ANCHORAGE 15 TO COMPLY WITH SECTION R40316 OF THE NCRC, 2012 EDITION. FOR 100 MPH, 120 MPH, AND 130 MPH WIND ZONES, FOUNDATION ANCHORAGE 15 TO COMPLY WITH SECTION 4504 OF THE NCRC, 2012 EDITION.
- 5. ENERGY EFFICIENCY COMPLIANCE AND INSULATION VALUES OF THE BUILDING TO BE IN ACCORDANCE WITH CHAPTER II OF THE NORC, 2012

FOOTING AND FOUNDATION NOTES

- 1. FOUNDATION DESIGN BASED ON A MINIMUM ALLOWABLE BEARING CAPACITY OF 2000 PSF. CONTACT GEOTECHNICAL ENGINEER IF BEARING
- 2. FOR ALL CONCRETE SLABS AND FOOTINGS, THE AREA WITHIN THE PERIMETER OF THE BUILDING ENVELOPE SHALL HAVE ALL VEGETATION, TOP 501L AND FOREIGN MATERIAL REPTORED. FILL MATERIAL SHALL BE FREE OF VEGETATION AND FOREIGN MATERIAL. THE FILL SHALL BE COTPACTED TO ASSUME INFORM SUPPORT OF THE BLAB, AND DOCEDET WHERE APPROVED, THE FILL DEPTHS SHALL NOT EXCEED 24" FOR CLEAN SAND OR GRAVEL A 4" THICK BASED COURSE CONSISTING OF CLEAN GRADED SAND OR GRAVEL SHALL BE PLACED. A BASE CONSIST IN TRECINED WHERE A CONCRETE SLAB IS INSTALLED ON URLL-DRAWNED OR SAND-GRAVEL MOTING SOLIS CLASSFIED AS GROUP. I, ACCORDING TO THE WHITED SOIL CLASSFIED AS GROUP. I, ACCORDING TO THE WHITED SOIL CLASSFIED AS
- 3. PROPERLY DEWATER EXCAVATION PRIOR TO POURNG CONCRETE WHEN BOTTOM OF CONCRETE SLAB IS AT OR BELOW WATER TABLE. IF AFFLICABLE, 3/4" - 1" DEEP CONTROL JOINTS ARE TO BE SAUED WITHIN 4 TO 12 HOURS OF CONCRETE FINISHING AND WALL LOCATIONS HAVE BEEN MARKED. ADJUST WHERE NECESSARY.
- 4. CONCRETE SHALL CONFORM TO SECTION R40/2 OF THE NORC, 20/0 EDITION. CONCRETE REINFORCING STEEL TO BE ASTM A6/5 GRADE 60, WELDED WIRE FABRIC TO BE ASTM A8/5, MAINTAN A HINMAIN CONCRETE CONER AROUND REINFORCING STEEL OF 3' N ROOTINGS AND I UP' IN SLABS. FOR POURED CONCRETE WALLS, CONCRETE COVER FOR REINFORCING STEEL MEASURED FROM THE INSIDE FACE OF THE WALL SHALL NOT BE LESS THAN 3.4". CONCRETE COVER FOR REINFORCING STEEL MEASURED FROM THE CUTSIDE FACE OF THE WALL. SHALL NOT BE LESS THAN LVZ" FOR "5 BARS OR SMALLER, AND NOT LESS THAN 2" FOR "5 BARS OR LARGER.
- 5. MASONRY UNITS TO CONFORM TO ACE 53/0/ASCE 5/TMS 4/02. MORTAR SHALL CONFORM
- 6. THE UNSUPPORTIED HEIGHT OF MASONRY PIERS SHALL NOT EXCEED FOUR TIMES THEIR LEAST DMIDSIGN FOR UNFILLED HOLLOU CONCRETE MASONRY UNITS AND TEXT TIMES THEIR LEAST DMIDSIGN FOR SOLID OR SOLID FILLED PIERS. PERS MAY BE FILLED SOLID WITH CONCRETE OR TIMES MY OR MORTAR PIERS AND WALLS SHALL BE CAPPED WITH 8" OF SOLID MASONRY.
- 1. THE CENTER OF EACH OF THE PIERS SHALL BEAR IN THE MIDDLE THIRD OF ITS RESPECTIVE FOOTING, EACH GIRDER SHALL BEAR IN THE MIDDLE THIRD OF THE PIER
- 8. ALL CONCRETE AND MASCARY FOUNDATION WALLS ARE TO BE CONSTRUCTED IN ACCORDANCE WITH THE PROVISIONS OF SECTION RAW OF THE NCRC, 200 EDITION OR IN ACCORDANCE WITH ACI 189, ACI 189, NCM T R86-A OR ACE 5506/ASCE 510716 402. MASCARY FOUNDATION WALLS ARE TO BE REINFORCED FER TABLE RAWALKI), RAWALKI), RAWALKI), OR RAWALKI OF THE NCRC, 200 EDITION. CONCRETE FOUNDATION WALLS ARE TO BE REINFORCED FER TABLE RAWALKI). ARE TO BE REINFORCED FER TABLE RAWALKI) OF THE NCRC, 200 EDITION. 6THE CONCRETE FOUNDATION WALLS TO 2 x 6 FRAMED WALLS AT 16" OC. WHERE GRADE PERMITS (UNO).

This sealed page is to be used in conjunction with a full olan set engineered by LS. Thompson Engineering, Inc only. Use of this individual sealed page within architectural pages or shop drawings by others is a punishable offense under N.C. Statute § 89C-23

FRAMING NOTES

- ALL FRAMM'S LIMBER SHALL BE 12 SFF MINMUM (Fb = 815 P6), Fv = 315 P6), E = 16,000,00 P6) UNLEGS NOTED OTHERUISE (UNO). ALL TREATED LUMBER SHALL BE 12 SYP MINMUM (Fb = 915 P6), Fv = 115 P6), E = 16,000,00 P6) UNLEGS NOTED OTHERUISE (UNO).
- 2. LAMINATED VENEER LUMBER (LVL) SHALL HAVE THE FOLLOWING MINIMUM PROPERTIES: Ho +2600 PSI, FV + 285 PSI, E + 19000000 PSI. LAMINATED STRAND LUMBER (LGL) SHALL HAVE THE FOLLOWING MINIMUM PROPERTIES: Fb = 2325 PSI, Fv = 310 PSI, E = 8500000 PSI. PARALLEL STRAND LUMBER (PSL) UP TO 1" DEPTH SHALL HAVE THE FOLLOWING MINIMUM PROPERTIES: Fc = 25000 PSI, E = 120000000 PSI. PARALLEL STRAND LUMBER (PSL) MORE THAN 1" DEPTH SHALL HAVE THE FOLLOWING MINIMUM PROPERTIES: FC = 2900 PSI, E = 20000000 PSI. INSTALL ALL CONNECTIONS PER MANUFACTURER'S SPECIFICATIONS.
- 3. STRUCTURAL STEEL SHALL CONFORM TO THE FOLLOWING ASTM SPECIFICATIONS

W AND WT SHAPES: CHANNELS AND ANGLES: ASTM A992 PLATES AND BARS: ASTM A36 HOLLOW STRUCTURAL SECTIONS: ASTM A500 GRADE B ASTM A53, GRADE B, TYPE E OR S

4. 6TEEL BEAMS SHALL BE SUPPORTED AT EACH END WITH A MINIMUM BEARNS, LENSTH OF 3 I/2" AND RULL FLANGE WIDTH (INO), PROVIDE SOLID BEARNS, FROM BEAM SUPPORT TO FOUNDATION, BEAMS SHALL BE ATTACHED AT THE BOTTOM FLANGE TO EACH SUPPORT AS

A WOOD FRAMING (2) 1/2" DIA x 4" LONG LAG SCREWS (2) 1/2" DIA x 4" WEDGE ANCHORS (2) 1/2" DIA x 4" LONG SIMPSON TITEN HD ANCHORS B. CONCRETE C. MASONRY (FULLY GROUTED)

LATERAL, SUPPORT 16 CONSIDERED ADEQUATE PROVIDING THE JOISTS ARE TOO NAILED TO THE 2x NAILER ON TOP OF THE STEEL BEAM, AND THE 2x NAILER IS SECURED TO THE TOP OF THE STEEL BEAM W/ (2) ROUS OF SELF TAPPING SCREUS . IS* O.C. OR (2) ROUS OF VI* DIAMETER BOLTS # 16" O.C. F 1/2" BOLTS ARE USED TO FASTEN THE NAILER, THE STEEL BEAM SHALL BE FABRICATED W/ (2) ROUS OF 9/16" DIAMETER

- SQUARES DENOTE POINT LOADS WHICH REQUIRE SCLID BLOCKING TO GIRDER OR POUNDATION, SHADED SQUARES DENOTE POINT LOADS
 FROM ABOVE WHICH REQUIRE SOLID BLOCKING TO SUPPORTING MEMBER BELOW.
- 6. ALL LOAD BEARING HEADERS TO CONFORM TO TABLE R50/25(1) AND R50/25(2) OF THE NCRC, 20/2 EDITION OR BE (2) 2 x 6 WITH (1) JACK AND (I) KING STUD EACH END (UNO), WHICHEVER IS GREATER ALL HEADERS TO BE SECURED TO EACH JACK STUD WITH (4) 8d NAILS. ALL BEAMS TO BE SUPPORTED WITH (2) STUDS AT EACH BEARING POINT (UNO).
- 1. ALL BEAMS, HEADERS, OR GIRDER TRUSSES PARALLEL TO WALL ARE TO BEAR FILLY ON (1) JACK OR (2) STUDS MINIMUM OR THE NUMBER OF JACKS OR STUDS NOTED. ALL BEAMS OR GIRDER TRUSSES FERFENDICILLAR TO WALL AND SUPPORTED BY (3) STUDS OR LESS ARE TO HAVE I IN MINMM BEARNS (UNO). ALL BEAMS OR GIRDER TRUSSES FERFENDICILLAR TO WALL AND SUPPORTED BY MORE THAN (3) STUDS OR OTHER NOTED COLUMN ARE TO BEAR FULLY ON SUPPORT COLUMN FOR ENTIRE WALL DEPTH (UNO), BEAM ENDS THAT BUTT INTO ONE ANOTHER ARE TO EACH BEAR EQUAL LENGTHS (UNO)
- FLITCH BEAMS SHALL BE BOLTED TOGETHER USING (3" DIAMETER BOLTS (ASTM ASØ1) WITH WASHERS PLACED AT THREADED END OF BOLT. BOLTS SHALL BE SPACED AT 24" CENTERS (MAXMMM), AND STAGGERED AT TOP AND BOTTOM OF BEAM (2" EDGE DISTANCE), WITH (3) BOLTS LOCATED AT 6" FROM EACH END (INO)
- 9. ALL I-JOINT OR TRUSS LAYOUTS ARE TO BE IN COMPLIANCE WITH THE OVERALL DESIGN SPECIFIED ON THE PLANS. ALL DEVIATIONS ARE TO BE BROUGHT TO THE ATTENTION OF THE ENGINEER OF RECORD PRIOR TO INSTALLATION.
- 10 PRACED UIAI I, PANELS SHALL BE CONSTRUCTED ACCORDING TO THE CURRENT NORTH CAROLINA RESIDENTIAL CODE WALL BRACING ITERIA THE AMOUNT, LENGTH, AND LOCATION OF BRACING SHALL COMPLY WITH ALL APPLICABLE TABLES IN SECTION R60210.
- IL PROVIDE DOUBLE JOIST UNDER ALL WALLS PARALLEL TO FLOOR JOISTS. PROVIDE SUPPORT UNDER ALL WALLS PARALLEL TO FLOOR TRUSSES OR 1-JOISTS FER MANUFACTURER'S SPECIFICATIONS. INSTALL BLOCKING BETWEEN JOISTS OR TRUSSES FOR POINT LOAD SUPPORT FOR ALL POINT LOADS ALONG OFFSET LOAD LINES.
- 12. FOR ALL HEADERS SUPPORTING BRICK YENEER THAT ARE LESS THAN 8'-0" IN LENGTH, REST A 6" x 4" x 5/16" STEEL ANGLE WITH 6" MINIMUM EMBEDMENT AT BIDES FOR BRICK SUPPORT, FOR ALL HEADERS 8"-0" AND GREATER IN LENGTH BOLT A 6" x 4" x 5/6" STEEL ANGLE TO HEADER WITH MY LAG SCREWS AT 12" O.C. STAGGERED FOR BRICK SUPPORT, FOR ALL BRICK SUPPORT AT ROOF LINES, BOLT A 6" x 4" x 5/6" STEEL ANGLE TO 2 x 10" BLOCKING INSTALLED BETWEEN WALL STUDS WITH MY LAG SCREWS AT 12" O.C. STAGGERED AND IN ACCORDANCE WITH SECTION R103.122 OF THE NORG, 2012 EDITION.
- 13. FOR STICK FRAMED ROOFS: CIRCLES DENOTE (3) 2 x 4 POSTS FOR ROOF MEMBER SUPPORT, HIP SPLICES ARE TO BE SPACED A MINIMUM OF 8".0", FASTEN MEMBERG WITH THREE ROUG OF 12d NAILG AT 16" O.C. FRAME DORMER WALLG ON TOP OF DOUBLE OR TRIPLE RAFTERG AS
- 14. FOR TRUSSED ROOFS: TRAY'E DORM'ER WALLS ON TOP OF 2 x 4 LADDER FRAMING AT 24" O.C. BETWEEN ADJACENT ROOF TRUSSES. STICK FRAME OVER-FRAMED ROOF SECTIONS WITH 2 x 8 RIDGES, 2 x 6 RAFTERS AT 16" O.C. AND FLAT 2 x 10 VALLEYS (UND).
- 5. ALL 4 x 4 AND 6 x 6 POSTS TO BE INSTALLED WITH 100 LB CAPACITY UPLIFT CONNECTORS TOP AND BOTTOM (UNO.) POSTS MAY BE SECURED USING ONE SIMPSON HIS OR LITED UPLIFT CONNECTOR FASTENED TO THE BAND AT THE BOTTOM AND THE BEAM AT THE TOP OF EACH POST. ONE 16" SECTION OF SIMPSON CSIG COIL STRAPPING WITH (8) 8d HDG NAILS AT EACH END MAY BE USED IN LIEU OF EACH TWIST STRAP IF DESIRED. FOR MASONRY OR CONCRETE FOUNDATION USE SIMPSON POST BASE.



0 Z NO S S (919) (919) 7.1733 2 Z Z O III 工皿 S

YANYANYANYANYANYE

NOTES STANDARD STRUCTURAL

DATE: DECEMBER 22, 2017

SCALE: N/A

DRAWN BY: IES SINEERED BY: JES

REVIEWED BY: JST

S-0 STRUCTURAL NOTES

