

CLG.

D.G.

DISP.

D.S.

.ש.ע

EXH. EXT.

FTG

GAR. DISP. GARBAGE DISPOSAL

RE/S

RE-SAWN REVERSE





NORTH CAROLINA 40' SERIES PLAN 240.2596-R

LOT 11 - MASON POINTE -ELEVATION B

SHEET INDEX

PLAN #240.2596-R

- ROOF PLAN, FRONT & REAR ELEVATIONS 'A'
- REOF FLANT, TROM IS REAR ELEVATIONS AT A RIGHT ELEVATIONS AT A CRAWL SPACE PARTIAL FIRST FLOOR PLANT FRONT S RIGHT ELEVATIONS 'A' AT CRAWL SPACE PARTIAL FRONT S RIGHT ELEVATIONS AT CONCRETE PORCH FRONT ELEVATIONS 'A' AT OPTIONAL 9"-1" PLATE HEIGHT PARTIAL RIGHT, LETT, AND FRONT ELEVATION AT W MAGONRY OPT #1 AND #2

- PARTIAL FIRST & SECOND FLOOR PLANS B'
 ROOF PLAN, FRONT & REAR ELEVATIONS B'
 LEFT & RIGHT ELEVATIONS B'
 PARTIAL FIRST FLOOR PLAN, FRONT & RIGHT ELEVATIONS B' AT CRANL SPACE
 PARTIAL FRONT & RIGHT ELEVATIONS AT CONCRETE PORCH
 FRONT ELEVATIONS B' AT OPTIONAL 9"-I" PLATE HEIGHT
 PARTIAL FLOOR PLAN, ROOF, FRONT ELEVATION, PARTIAL RIGHT ELEVATION B'

- AT EXTENDED PORCH OPTION
 PARTIAL RIGHT, LEFT, AND FRONT ELEVATION 'B' W/ STONE

- PARTIAL FIRST & SECOND FLOOR PLANS (C'
 ROOF PLAN, FRONT & REAR ELEVATIONS (C'
 LEFT & RIGHT ELEVATIONS (C'
 PARTIAL FIRST FLOOR PLAN, FRONT & RIGHT ELEVATIONS (C' AT CRAWL SPACE
 PARTIAL FRONT & RIGHT ELEVATIONS AT CONCRETE PORCH
 FRONT ELEVATIONS (C' AT OPTIONAL 9'-1)" PLATE HEIGHT
 PARTIAL FLOOR PLAN, ROOF, FRONT ELEVATION, PARTIAL RIGHT ELEVATION (C'
 AT EXTENDED PORCH (CPTION)
- AT EXTENDED PORCH OPTION

 AT EXTENDED PORCH OPTION

 PARTIAL RIGHT, LEFT, AND FRONT ELEVATION 'C' W STONE OPT #I AND #2

 PARTIAL RIGHT, LEFT, AND FRONT ELEVATION 'C' W STONE OPT #I AND #2

 AT EXTENDED PORCH OPTION

- PARTIAL FIRST & SECOND FLOOR PLANS 'D'
 ROOF PLAN, FRONT & REAR ELEVATIONS 'D'
 LEFT & RIGHT ELEVATIONS 'D'
 ARTIAL FIRST FLOOR PLAN, FRONT & RIGHT ELEVATIONS 'D' AT CRAVL SPACE
 PARTIAL FRONT & RIGHT ELEVATIONS W OPTIONAL MASONRY AT CONCRETE PORCH
 FRONT ELEVATIONS 'D' AT OPTIONAL "L" PLATE HEIGHT
 PARTIAL RIGHT, LEFT, AND FRONT ELEVATION 'D' W STONE OPT #I AND #2

- SECTIONS SECTIONS AT CRAWL SPACE
- FIRST FLOOR UTILITY PLAN SECOND FLOOR UTILITY PLAN FIRST FLOOR UTILITY PLAN OPTIONS SECOND FLOOR UTILITY PLAN OPTIONS
- PARTIAL FLOOR PLANS, & ELEVATIONS W OPT. 12'X12' DECK AT CRANL SPACE PARTIAL FLOOR PLANS, & ELEVATIONS W OPT. 12'X24' DECK AT CRANL SPACE PARTIAL FLOOR PLANS, & ELEVATIONS W OPT. 12'X21' SCREENED-IN DECK AT CRANL SPACE PARTIAL FLOOR PLANS, & ELEVATIONS W OPT. 12'X24' SCREENED-IN DECK AT CRANL SPACE PARTIAL FLOOR PLANS, & ELEVATIONS W OPT. SUNROOM AT SLAB INTERFACE PARTIAL FLOOR PLANS, & ELEVATIONS W OPT. SUNROOM AT CRANL SPACE

- PARTIAL FLOOR PLAN ROOF & ELEVATIONS W/ OPT, COVERED PATIO
- PARTIAL FLOOR PLAN, ROOF & ELEVATIONS W OPT. EXTENDED COVERED PATIO
 PARTIAL FLOOR PLAN, ROOF & ELEVATIONS W OPT. EXTENDED COVERED PATIO
 PARTIAL FLOOR PLAN, ROOF & ELEVATIONS W OPT. SCREENED-IN COVERED PATIO
 PARTIAL FLOOR PLAN, ROOF & ELEVATIONS W OPT. SCREENED-IN EXTENDED COVERED PATIO

CODE INFORMATION

CODE ABBREVIATIONS

N.C.-R. NORTH CAROLINA RESIDENTIAL CODE
N.C.-B. NORTH CAROLINA BUILDING CODE

N.C.-M. NORTH CAROLINA MECHANICAL CODE

N.C.-E. NORTH CAROLINA ELECTRICAL

NC-EC NORTH CAROLINA ENERGY CODE

NORTH CAROLINA PLUMBING CODE NORTH CAROLINA FUEL GAS CODE

- ARCHITECTURAL DETAILS
- ARCHITECTURAL DETAILS ARCHITECTURAL DETAILS
- ARCHITECTURAL DETAILS
- ARCHITECTURAL DETAILS ARCHITECTURAL DETAILS

ARCHITECTURAL DETAILS ARCHITECTURAL DETAILS

NORTH CAROLINA 40' SERIES KB HOME

HOME

NORTH CAROLINA DIVISION 4518 S. MIAMI BLVD. SUITE 180 DURHAM, NC 27703

TEL: (919) 768-7988 FAX: (919) 472-0582

2018_NORTH

CAROLINA STATE BUILDING

CODES

PROJECT No.: 1350999:56

DIVISION MGR.: 05/07/19

MCP

DIVISION REVISIONS NC20023NCP- 05/07/20 - KBA

240.2596-R SHEET:

SPEC. LEVEL 1 RALEIGH-DURHAM 40' SERIES

SECTION INDICATOR SHEET NUMBER DETAIL REFERENCE DETAIL NUMBER KEYNOTE REFERENCE REFERENCE NUMBER OFFSET REFERENCE DIFFERENTIAL IN FLOOR LEVEL OR FINISH SURFACE REVISION REFERENCE REFER TO TITLE SHEET **SCALE NOTE**

CONSULTANTS SOUARE FOOTAGE ARCH. SYMBOLS PLAN 240.2596-R OWNER : KB HOME NORTH CAROLINA DIVISION 4506 S. MIAMI BLVD., SUITE 180 DURHAM, NC 27708 TEL. (919) 168-7980 FAX. (919) 544-2928 BUILDING SECTION SECOND FLOOR AREA TOTAL AREA 2573 SQ FT 5Q. F PORCH AREA(S) FI EVATION 'A' ELEVATION 'B' ELEVATION 'C' 62 136 KB HOME 5230 PACIFIC CONCOURSE DRIVE, SUITE 330 LOS ANGELES, CA 90045 FI EVATION 'D' ATIO AREA(S) TEL: (424) 294-3700 FAX: (3IO) 297-267I 10'x26'-7" COVERED 266 DECK AREA(S) OPEN 12'x24 SCREENED-IN 12'x12' SCREENED-IN 12'x24' 288

N.E.C. NORTH CAROLINA ENERGY CO.

N.E.C. NATIONAL ELECTRICAL CODE

I.C.B.O. INTERNATIONAL CONFERENCE
OF BUILDING OFFICIALS

A.S.T.M. AMERICAN SOCIETY FOR
TESTING MATERIALS SQ. FT. PROJECT DESCRIPTION: TESTING MATERIALS

N.F.P.A. NATIONAL FIRE PROTECTION
ASSOCIATION SQ. FT. 2 STORY SINGLE FAMILY DETACHED RESIDENTIAL PLAN W/4 ELEVATIONS AMERICAN NATIONAL STANDARDS A.N.S.I. OCCUPANCY: I.E.C.C. SQ. FT. UNDERWRITERS LABORATORIES, INC. CONSTRUCTION TYPE: **REVISION LIST** DATE LOG NUMBE 08/24/18 T.S, I.I - I.5, 2.I, 2.3, 2.4, 2.5, 3.AI - 3.D6, 4.I - 5.4 NC18024NC 03/15/19 T.S. GN.I. GN.2. GN.3. I.2. 3.AI, 3.BI, 3.B2, 3.B7, 3.CI, 3.C2, 3.C6, 3.D2, 5. 04/01/19 I.I. 2.I. 3.AI, 3.B2, 3.C2, 3.D2, 5.I NCIGOITNO 05/07/19 T5, I.I-I.5, 3.AI-3.A5, 3.BI, 3.B3, 3.B4, 3.B6, 3.B7, 3.CI-3.C8, 3.DI-3.D6 4.1, 4.2, 5.1, 5.2, 5.4, 7.5, 7.6 NCIGOSSNC 6 03/04/20 T5, I.I, I.3, I.4, 3.AI, 3.A3-6, 3.B2-8, 5.3, 8.3, 8.4 NG200ITNG

APPLICABLE CODES:

GROUND-FAULT CIRCUIT INTERRUPTER AIR CONDITIONING SHELF AND POLE ADJUSTABLE GALVANIZED IRON S.C. SOLID CORE ALTERNATE SMOKE DETECTOR GI ASS AMPERAGE SECTION GYPSUM BOARD HOLLOW CORE CENTER LINE SHEET HDR. HEADER CABINET SHEATHING CEIL ING SHWR SHOWER HEADER HEIGHT CLR. SIM. CLEAR SIMILAR HORIZONTAL SLIDER CONCRETE SLIDING CARPET IN LIEU OF SL. GL. SLIDING GLASS INSULATION STANDARD DRYER INTERIOR SHEET VINYL LAMINATED TEMPERED GLASS DUAL GLAZED LAVATORY THK. THICK LUMINOUS TOP OF CURB DIAMETER DIMENSION MEDICINE CABINET TOP TOP OF PLATE MANUFACTURER T.O.S. TOP OF SLAB DISPOSAL DIVIDED LIGHT MINIMIJM TYPICAL UNLESS NOTED OTHERWISE MOUNTED U.N.O. DOOR NOT IN CONTRACT V.P. VAPOR PROOF N.I.C. DOWNSPOUT WASHER NOT TO SCALE DISHWASHER **OVER** ON CENTER MOOD FIFV FI EVATION OPTIONAL MATER HEATER 0.S.A. OUTSIDE AIR EQUAL EXHAUST PROPERTY LINE MEATHER PROOF EXTERIOR PUSH BUTTON FORCED AIR UNIT F.G./FX FIXED GLASS PLATE FUEL GAS PLYWOOD FINISH PAIR P.T.D.F. PRESSURE TREATED DOUGLAS FIR FLR. LINE FLOOR LINE FLUOR FLUORESCENT FR. DR FRENCH DOOR RADIUS F.M.C. FLOOR MATERIAL CHANGE RETURN AIR GRILL REFRIGERATOR IF BOX IS 1/2" SQ. THEN SCALE IS 1/8" = 1'-0" FOOTING

ABBREVIATIONS

GENERAL REQUIREMENTS

- THE WORD 'CONTRACTOR' AS USED HEREIN SHALL MEAN THE GENERAL CONTRACTOR, SUBCONTRACTORS AND ALL PERSONS DIRECTLY OR INDIRECTLY EMPLOYED BY ANY OF THEM.
- - ALL LAWS, STATUTES, THE MOST RECENT BUILDING CODES, ORDINANCES, RULLES, REQUATIONS, AND LAWFUL ORDERS OF A FUBIL ORDINITIES HAVING JURISDICTION OVER OWNER, CONTRACTOR, ANY SUBCONTRACTOR, THE PROJECT, THE PROJECT SITE, THE WORK, OR THE PROSECUTION OF THE WORK.
- THE FEDERAL OCCUPATIONAL SAFETY AND HEALTH ACT AND ALI OTHER APPLICABLE CODE REQUIREMENTS RELATING TO SAFETY.
- THE FAIR HOUSING AMENDMENTS ACT, THE AMERICANS WITH DISABILITIES ACT, AND ALL OTHER APPLICABLE CODE REQUIREMENTS RELATING THERETO.
- CONTRACTOR SHALL CAREFULLY STUDY AND REVIEW THE CONSTRUCTION DOCUMENTS AND INFORMATION FURNISHED BY OWNER, AND SHALL PROMPTLY REPORT IN WRITING TO OWNER'S REPRESENTATIVE ANY ERRORS, INCONSISTENCIES, OR OMISSIONS IN THE CONSTRUCTION DOCUMENTS OR INCONSISTENCIES WITH APPLICABLE CODE REQUIREMENTS OR DESERVED BY THE CONTRACTOR.
- IF CONTRACTOR PERFORMS WORK WHICH HE KNOWS OR SHOULD KNOW IS IF CONTRACTOR PERFORMS WORK WHICH HE KNOWS OR SHOULD KNOW IS CONTRARY TO APPLICABLE CODE REQUIREMENTS, WITHOUT THE AGREEME OF ORNER, CONTRACTOR SHALL BE RESPONSIBLE FOR SUCH WORK AND SHALL BEAR THE RESULTANT LOSSES, INCLUDING, WITHOUT LIMITATION, TH COSTS OF CORRECTING DEFECTIVE WORK.
- CONTRACTOR SHALL PROVIDE CERTIFICATES OF INSURANCE ACCEPTABLE TO OWNER PRIOR TO COMMENCEMENT OF WORK.
- CONTRACTOR SHALL TAKE FIELD MEASUREMENTS, VERIFY FIELD CONDITIONS, AND CAREFULLY COMPARE WITH THE CONSTRUCTION DOCUMENTS SUCH FIELD MEASUREMENTS, CONDITIONS, AND OTHER NFORMATION KNOWN TO CONTRACTOR BEFORE COMMENCING THE WORK ERRORS, INCONSISTENCIES, OR OMISSIONS DISCOVERED AT ANY TIME SHALL BE PROMPTLY REPORTED IN WRITING TO THE OWNER.
- CONTRACTOR SHALL PROMPTLY NOTIFY OWNER'S REPRESENTATIVE THE MORK THAT THE CONSTRUCTION DOCUMENTS ARE NOT IN COM-PLIANCE WITH APPLICABLE CODE REQUIREMENTS.
- BY SUBMITTAL OF BID. CONTRACTOR WARRANTS TO OWNER THAT ALL MATERIALS AND EQUIPMENT TO BE FURNISHED ARE NEW UNLESS NOTED OTHERWISE AND ALL WORK WILL BE OF GOOD QUALITY AND FREE FROM FAULTS AND DEFECTS.
- SUB-CONTRACTORS SHALL INSURE THAT ALL MORK IS DONE IN A PROFESSIONAL WORKMANLIKE MANNER BY SKILLED MECHANICS AND SHALL REPLACE ANY MATERIALS OR ITEMS DAMAGED BY SUB-CONTRACTORS PERFORMANCE. SUB-CONTRACTORS AND SUPPLIERS ARE HEREBY NOTIFIED THAT THEY ARE TO CONTRACTORS AND SUPPLIERS ARE HEREBY NOTIFIED THAT THEY ARE TO CONTRACTORS AND SUPPLIERS FULLY WITH EACH OTHER DURING THE COURSE OF CONSTRUCTION TO DETERMINE THE EXACT EXTENT AND OVERLAP OF EACH OTHERS WORK AND TO SUCCESSFULLY COMPLETE THE EXECUTION OF THE WORK. ALL SUB-CONTRACTOR WORKMANSHIP SHALL BE OF GUALLITY TO PASS INSPECTIONS BY LOCAL AUTHORITIES, LENDING INSTITUTIONS, ARCHITECT OR BUILDER. ANY ONE OR ALL OF THE ABOVE MENTIONED INSPECTORS MAY INSPECT MORKMANSHIP AT ANY TIME, AND CORRECTIONS NEEDED TO ENHANCE THE GUALITY OF BUILDING WILL BE DONE IMMEDIATELY. EACH SUBCONTRACTOR, UNLESS SPECIFICALLY EXEMPTED BY THE TERMS OF HISHERS SUB-CONTRACT AGREEMENT, SHALL BE RESPONSIBLE FOR CLEANING UP AND REMOVING FROM THE JOB SITE ALL TRASH AND DEBRIS NOT LEFT BY OTHER SUB-CONTRACTORS. BUILDER WILL DETERMINE HOW SUB-CONTRACTORS SHALL INSURE THAT ALL WORK IS DONE IN A SOON AFTER SUBCONTRACTOR COMPLETES EACH PHASE OF HIS WORK THAT TRASH AND DEBRIS WILL BE REMOVED FROM THE SITE.
- APPROVAL BY THE BUILDING INSPECTOR DOES NOT MEAN APPROVAL OR ALLOWABLE FAILURE TO COMPLY WITH THE PLANS AND SPECIFICATIONS. ANY DESIGN WHICH FAILS TO BE CLEAR OR IS AMBIGUOUS MUST BE REFERRED TO THE ARCHITECT OR ENSINEER FOR INTERPRETATION.
- ALL EQUIPMENT AND MATERIALS FURNISHED AND INSTALLED UNDER THESE PLANS SHALL BE GUARANTEED BY THE CONTRACTOR FOR A PERIOD OF ONE YEAR FROM THE DATE OF ACCEPTANCE OF THE WORK BY OWNER UNLESS STIPULATED OTHERWISE.
- ALL TRADE NAMES AND BRAND NAMES CONTAINED HEREIN ESTABLISH QUALITY STANDARDS. SUBSTITUTIONS ARE PERMITTED, WITH PRIOR APPROVAL BY THE OWNER'S REPRESENTATIVE. THE CONTRACTOR SHALL SUBMIT FOR THE ARCHITECT'S AND BUILDER'S APPROVAL ALL MATERIALS OR EQUIPMENT WHICH IS CONSIDERED "OR EQUAL" TO THAT SPECIFIED.
- CONSTRUCTION DOCUMENTS IDENTIFIED AS "BID SET" ON ANY OR ALL SHEETS MAY BE SUBJECT TO REVIEW. THIS REVIEW MAY RESULT IN CHANGES WHICH MAY BE MADE TO THE PLANS PRIOR TO THE ISSUANCE OF THE FINAL CONSTRUCTION SET WHICH WILL CONTAIN NO "BID SET" DESIGNATIONS. CONSTRUCTION DOCUMENTS IDENTIFIED AS "BID SET" ARE NOT TO BE CONSTRUCT AS BEING THE COMPLETED OR FINAL DRAWINGS AND THEY SHOULD NOT IN ANY WAY BE USED AS SUCH.
- ALL STANDARD NOTES CONTAINED HEREIN ARE TYPICAL UNLESS NOTED OTHERWISE.
- TYPICAL DETAILS AND SPECIFICATIONS ARE MINIMUM REQUIREMENTS TO BE USED WHEN CONDITIONS ARE NOT SHOWN OTHERWISE.
- SPECIFIC NOTES AND DETAILS ON DRAWINGS SHALL TAKE PRECEDENCE OVER GENERAL NOTES AND TYPICAL DETAILS, WHERE NO DETAILS ARE SHOWN CONSTRUCTION SHALL CONFORM TO SIMILAR WORK ON THE PROJECT.
- SEE ARCHITECTURAL, STRUCTURAL, ELECTRICAL, AND MECHANICAL DRAWINGS FOR PITS, TRENCHES, ROOF OPENINGS, DEPRESSIONS,
- 18. THE CONSTRUCTION DOCUMENTS AND ALL COPIES THEREOF FURNISHED TO CONTRACTOR ARE THE PROPERTY OF THE ARCHITECT AND ARE TO BE USED ON OTHER WORK

SITE WORK

- CONTRACTOR SHALL INVESTIGATE SITE DURING CLEARING AND EARTHWORK OPERATIONS FOR FILLED EXCAVATIONS OR BURIED STRUCTURES SUCH AS CESSPOOLS, CISTERNS, FOUNDATIONS, ETC., AND BURIED ARTIFACTS SUCH AS INDIAN OR DINOSAUR BONES SOILS ENGINEER SHALL BE NOTIFIED IMMEDIATELY
- 2. CONTRACTOR SHALL TAKE ALL NECESSARY MEASURES TO FULLY
- REFER TO THE SOILS REPORT AS PREPARED BY THE GEOTECHNICAL
- 4. REFER TO CIVIL ENGINEER'S CURRENT GRADING AND PLOT PLANS.

SITE WORK (continued)

- REFER TO THE LANDSCAPE ARCHITECT'S CURRENT GRADING PLAN AND CONSTRUCTION DOCUMENTS.
- ALL FOOTINGS SHALL REST ON FIRM NATURAL SOIL OR APPROVED COMPACTED FILL. REFER TO GEOTECHNICAL REPORT.
- EXCAVATIONS FOR FOOTINGS SHALL BE MADE TO THE WIDTH, LENGTH, AND DEPTH REQUIRED AND FINISHED WITH LEVEL BOTTOMS.
- EXCAVATIONS SHALL BE KEPT FREE OF STANDING WATER.
- WHERE EXCAVATIONS ARE MADE TO A DEPTH GREATER THAN INDICATED, SUCH ADDITIONAL DEPTH SHALL BE FILLED WITH CONCRETE AS SPECIFIED FOR FOOTINGS.
- FILL MATERIALS SHALL BE FREE FROM DEBRIS, VEGETABLE MATTER AND OTHER FOREIGN SUBSTANCES.
- ALL FINISH GRADES TO DRAIN AWAY FROM THE BUILDING FOOTINGS.
- 12. THERE SHALL BE NO ON-SITE WATER RETENTION.
- IS. THERE SHALL BE NO DRAINAGE TO ADJACENT PROPERTY
- FOR ONSITE CONTSRUCTION, PLANS TO COMPLY WITH NECESSARY INSPECTIONS APPROVED BY THE BUILDING OFFICIAL.
- THE REQUIREMENTS IN THESE NOTES ARE THE MINIMUM THAT SHALL BE MET. REQUIREMENTS OF THE STRUCTURAL DRAWINGS THAT EXCEED THE REQUIREMENTS SHOWN HERE SHALL BE MET.

CONCRETE

- REFER TO STRUCTURAL ENGINEERING CALCULATIONS AND SOILS REPORT FOR THE PERFORMANCE REQUIREMENTS FOR CONCRETE FOUNDATIONS.
- CONCRETE SHALL BE PROPORTIONED TO PROVIDE AN AVERAGE COMPRESSIVE STRENGTH AS PRESCRIBED IN THE N.C.-R, AS WELL AS SATISFY THE DURABILITY CRITERIA OF THE N.C.-R
- MIXING OF CONCRETE SHALL BE PERFORMED IN ACCORDANCE
- THE DEPOSITING OF CONCRETE SHALL COMPLY WITH THE PROVISIONS ACI 318, SECTION 5.10.
- THE CURING OF CONCRETE SHALL BE IN ACCORDANCE WITH
- ALL FORM WORK SHALL BE DESIGNED, CONSTRUCTED, UTILIZED, AND
- CONDUIT, PIPES AND SLEEVES OF ANY MATERIAL NOT HARMFUL TO CONCRETE AND WITHIN THE LIMITATIONS OF ACI 318, SECTION 6.3, ARE PERMITTED TO BE EMPEDDED IN CONCRETE WITH APPROVAL OF THE REGISTERED DESIGN PROFESSIONAL.
- CONSTRUCTION JOINTS INCLUDING THEIR LOCATION SHALL COMPLY WITH THE PROVISIONS OF ACI 318, SECTION 6.4.
- ALL STEEL REINFORCING OF CONCRETE SHALL BE DONE IN ACCORDANCE WITH THE N.C.-R
- TOP OF CONCRETE SLABS TO BE A MINIMUM 4" W/ MASONRY VENEER 6" ELSEWHERE (8" H.J.D.) ABOVE FINISH GRADE.
- FOUNDATION WIDTHS, DEPTHS, AND REINFORCING, AS SHOWN ON PLANS, ARE SUPERCEDED BY ANY LOCAL CODES OR ORDINANCES WHICH REQUIRE INCREASES OF THE SAME.
- ALL REINFORCEMENT, CONDUIT, OUTLET BOXES, ANCHORS, HANGERS, ALL REINFORCEMENT, CONDUIT, OUTLET BOXES, ANALORS, HANGERS, SLEEVES, BOLTS OR OTHER EMBEDDED MATERIALS AND ITEMS MUST BE SECURED AND APPROPRIATELY FASTENED IN THEIR PROPER LOCATIONS PRIOR TO THE PLACEMENT OF CONCRETE. SUB-CONTRACTOR SHALL VERIEY INSTALLATION OF HOLD-DOWNS, ANCHOR BOLTS, PA STRAPS, AND OTHER ANCHORAGE MATERIAL AND ITEMS PRIOR TO PLACEMENT OF CONCRETE.
- - POINT AND LINE LOADS FROM STRUCTURE ABOVE TO BE PROVIDED TO POST-TENSION ENGINEER PRIOR TO POST-TENSION DESIGN.
- ANCHOR BOLTS AND OTHER HARDWARE TO BE SHOWN ON POST-TENSION PLANS TO AVOID MIS-LOCATION OF HARDWARE AND POSSIBLE FIELD FIXES WHICH MAY CUT TENDONS.

MASONRY

- ALL MASONRY DESIGN SHALL FOLLOW THE REQUIREMENTS OF THE CURRENT ADOPTED CODES.
- ANCHORED MASONRY VENEER SHALL COMPLY WITH THE PROVISIONS OF N.C.-R, AND SECTIONS 6.1 AND 6.2 OF
- STONE VENEER UNITS NOT EXCEEDING 5 INCHES IN THICKNESS SHALL BE ANCHORED DIRECTLY TO MASONRY, CONCRETE OR TO STUD CONSTRUCTION BY ONE OF THE APPROVED METHODS LISTED IN THE INC-PR
- MORTAR FOR USE IN MASONRY CONSTRUCTION SHALL COMPLY WITH ASTM C 270. THE TYPE OF MORTAR SHALL BE IN ACCORDANCE WITH THE N.C. RAND SHALL MEET THE PROPORTION SPECIFICATIONS OR THE PROPERTY SPECIFICATIONS OF ASTM C 270
- GROUT SHALL CONSIST OF FIBER CEMENT MATERIAL AND AGGREGATE IN ACCORDANCE WITH ASTM C 476 AND THE PROPORTION SPECIFICATIONS
- AGGREGATES FOR MORTAR AND GROUT SHALL BE NATURAL SAND AND ROCK CONFORMING TO A.S.T.M. C-144-04 (MASONRY MORTAR, MORTAR) AND
- CEMENT SHALL BE PORTLAND CEMENT CONFORMING TO A.S.T.M. C 150
- 8. ALL BRICK SHALL CONFORM TO A.S.T.M. C 216, GRADE MW
- UNLESS SPECIFICALLY SHOWN OTHERWISE ALL BRICK SHALL BE LAID
- IO. ANCHORS, TIES AND WIRE FABRIC SHALL CONFORM TO N.C.-R.
- ANCHOR TIES AND WIRE FABRIC FOR USE IN MASONRY WALL CONSTRUCTION SHALL CONFORM TO THE N.C.-R.

METALS

- REFER TO STRUCTURAL NOTES AND SPECIFICATIONS FOR STRUCTURAL STEEL, METAL AND REINFORCING STEEL SPECIFICATIONS.
- ALL STRUCTURAL STEEL SHALL CONFORM TO AISC/CRED
- ANCHOR RODS SHALL BE SET ACCURATELY TO THE PATTERN AND DIMENSIONS CALLED FOR ON THE PLANS. THE PROTRUSION OF THE THREADED ENDS THROUGH THE CONNECTED MATERIAL SHALL BE SUFFICIENT TO FULLY ENGAGE THE THREADS OF THE NUTS, BUT SHALL NOT BE GREATER THAN THE LENGTH OF THE THREADS ON THE BOLTS
- FASTENERS FOR PRESERVATIVE-TREATED AND FIRE-RETARDANT-TREATED MOOD SHALL BE OF HOT-DIPPED ZING COATED GALVANIZED STEEL. STAINLESS STEEL, SILICON BRONZE OR COPPER, VERIEY ACCEPTABLE FASTENERS FER CHEMICALS USED IN PRESSURE PRESERVITIVELY TREATED MOOD W N.C.-R. FASTENINGS FOR WOOD FOUNDATIONS SHALL BE AS REGUIRED IN AF4FA TECHNICAL REPORT NO. T.

WOOD & FRAMING

- THE DESIGN AND CONSTRUCTION OF CONVENTIONAL LIGHT-FRAME MOOD CONSTRUCTION SHALL BE IN ACCORDANCE WITH THE PROVISIONS OF THE N.C.-R
- CONSTRUCTION, PROJECTIONS, OPENINGS AND PENETRATIONS OF EXTERIOR WALLS OF DWELLINGS AND ACCESSORY BUILDINGS SHALL COMPLY WITH TABLE RSO2.1.
- ALL LUMBER SHALL MEET THE STANDARDS OF QUALITY AS STATED IN THE N.C.-R
- LUMBER AND PLYMOOD REQUIRED TO BE PRESSURE PRESERVATIVELY TREATED IN ACCORDANCE WITH THE N.C.-R. AND SHALL BEAR THE QUALITY MARK OF AN APPROVED INSPECTION AGENCY THAT MAINTAINS CONTINUMS SUPERVISION, TESTING AND INSPECTION OVER THE QUALITY OF THE PRODUCT AND THAT HAS BEEN APPROVED BY AN ACCREDITATION BODY THAT COMPLIES WITH THE REQUIREMENTS OF THE AMERICAN LUMBER STANDARD COMMITTEE TREATED WOOD PROGRAM
- ALL LUMBER SIZES NOTED AND SPECIFIED ON PLANS ARE NOMINAL SIZES UNLESS SPECIFICALLY INDICATED AS NET SIZE.

GLUE LAMINATED LUMBER

- REFER TO THE STRUCTURAL ENGINEER'S CURRENT NOTES. CALCULATIONS, AND SPECIFICATIONS
- GLUED LAMINATED TIMBERS SHALL BE MANUFACTURED AND IDENTIFIED AS REQUIRED IN AITC AIGO, I AND ASTM D 3737.

PROTECTION AGAINST DECAY & TERMITE

- IN AREAS SUBJECT TO DECAY DAMAGE AS ESTABLISHED BY THE N.C.-R THE FOLLOWING LOCATIONS SHALL REQUIRE THE USE OF NATURALLY DRABLE WOOD OR WOOD THAT IS PRESERVATIVE TREATED IN ACCORDANCE HITH AWPA UI FOR THE SPECIES, PRODUCT, PRESERVATIVE AND END USE, PRESERVATIVES SHALL BE LISTED IN SECTION 4 OF AWPA UI
- WOOD JOISTS OR THE BOTTOM OF WOOD FLOOR WHEN CLOSER THAN IB INCHES, OR MOOD GIRDERS WHEN CLOSER THAN 12 INCHES TO THE EXPOSED PROUND IN CRANL SPACES OR UNEXCAVATED AREAS LOCATED MITHIN THE PERIPHERY OF THE BUILDING FOUNDATION.
- ALL EXTERIOR SILLS &PLATES THAT REST ON CONCRETE OR MASONRY 5. EXTERIOR FOUNDATION WALLS.
- SILLS AND SLEEPERS ON A CONCRETE OR MASONRY, UNLESS THE SLAB THAT IS IN DIRECT CONTACT WITH THE GROUND IS SEPARATE FROM THE GROUND BY AN APPROVED IMPERVIOUS MOISTURE BARRIER.
- THE ENDS OF WOOD GIRDERS ENTERING EXTERIOR MASONRY OR CONCRETE WALLS HAVING CLEARANCES OF LESS THAN 0.5 INCH ON TOPS, SIDES AND ENDS.
- MOOD SIDING AND SHEATHING ON THE EXTERIOR OF A BUILDING HAVING A CLEARANCE OF LESS THAN 6 INCHES FROM THE GROUND.
- WOOD STRUCTURAL MEMBERS SUPPORTING MOISTURE-PERMEABLE FLOORS OR ROOFS THAT ARE EXPOSED TO THE MEATHER, SUCH AS CONCRETE OR MASONRY SLABS, UNLESS SEPARATED FROM SUCH FLOORS OR ROOFS BY ANIMPERVIOUS MOISTURE BARRIER.
- WOOD FURRING STRIPS OR OTHER WOOD FRAMING MEMBERS ATTACHED 2. DIRECTLY TO THE INTERIOR OF EXTERIOR MASONRY WALLS OR CONCRETE WALLS BELOW GRADE EXCEPT WHERE AN APPROVED VAPOR RETARDER IS APPLIED BETWEEN THE WALL AND THE FURRING STRIPS OR FRAMING MEMBERS.
- ALL PORTIONS OF A PORCH, SCREEN PORCH OR DECK FROM THE BOTTOM OF THE HEADER DOWN, INCLUDING POSTS, GUARDRAILS, PICKETS, STEPS AND FLOOR STRUCTURE. COVERINGS THAT WOULD PREVENT MOISTURE OR WATER ACCUMULATION ON THE SURFACE OR AT JOINTS BETWEEN MEMBERS ARE ALLOWED
- IN AREAS SUBJECT TO DAMAGE FROM TERMITES METHODS OF PROTECTION SHALL BE ONE OF THE METHODS LISTED IN THE N.C.-R
- UNDER-FLOOR AREAS SHALL BE VENTILATED IN ACCORDANCE WITH THE REQUIREMENTS OF THE N.C.-R

WOOD & FRAMING (continued)

- WOOD STRUCTURAL PANELS SHALL CONFORM TO THE REQUIREMENTS AS SET FORTH IN THE N.C.-R
- ROOF SHEATHING PANELS SHALL BE LAID WITH FACE GRAIN OR STRENGTH AXIS PERPENDICULAR TO SUPPORTS AND WITH PANEL CONTINUOUS OVER TWO OR MORE SPANS.
- ROOF SHEATHING SHALL BE IN ACCORDANCE WITH THE N.C.-R
- FLOOR SHEATHING PANELS SHALL BE LAID WITH FACE GRAIN OR STRENGTH AXIS PERPENDICULAR TO SUPPORTS AND WITH PANEL CONTINUOUS OVER TWO OR MORE SPANS.
- STRUCTURAL FLOOR SHEATHING SHALL COMPLY WITH THE PROVISIONS OF THE N.C.-R
- REFER TO THE STRUCTURAL ENGINEER'S CURRENT SPECIFICATIONS, CALCULATIONS, AND PLANS FOR REQUIRED STRENGTH, GRADE, AND THICKNESS FOR PLYMODO FLOOR SHEATHING PANELS AND FOR DIAPHRAGM NAILING AND ADHESIVE REQUIREMENTS.
- ALL VERTICAL JOINTS OF PANEL SHEATHING SHALL OCCUR OVER, AND BE FASTENED TO, COMMON STUDS. HORIZONTAL JOINTS IN BRACED WALL PANELS SHALL OCCUR OVER, AND BE FASTENED TO, COMMON BLOCKING OF A MINIMM OF I 1/2 INCH THICKNESS.
- WHERE APPLICABLE, REFER TO THE SHEAR WALL SCHEDULE FOR REQUIRED STRENGTH, GRADE, AND THICKNESS OF PLYMOOD SHEAR PANELS AND FOR REQUIRED SHEAR WALL NAILING SCHEDULE.
- IN ONE- AND TWO-FAMILY DWELLING CONSTRUCTION USING HARD BOARD OR ALUMINUM AS A SOFFIT MATERIAL, THE SOFFIT MATERIAL SHALL BE SECURELY ATTACHED TO FRAMING MEMBERS AND USE AN UNDERLAYMENT MATERIAL OF EITHER FIRE RETARDANT TREATED WOOD, 23/92 INCH MOOD SHEATHING OR 5/8 INCH GYPSUM BOARD. VENTING REQUIREMENTS APPLY TO BOTH SOFFIT AND UNDERLAYMENT AND SHALL BE PER SECTION ROOF OF THE NORTH CAROLINA RESIDENTIAL CODE. WHERE THE PROPERTY LINE IS IN PEET OR MORE FROM THE SUILDING FACE, THE PROVISIONS OF THIS CODE SECTION DO NOT APPLY.

FLOOR FRAMING

- ALL FLOOR JOISTS SHALL BE DESIGNED I-JOIST WOOD FLOOR TRUSSES. REFER TO MANUFACTURER FOR ALL LAYOUTS AND CALCULATIONS
- REFER TO THE STRUCTURAL ENGINEER'S CURRENT PLANS & CALCULATIONS FOR SIZE, SPACING, AND ANCHORAGE OF ALL FLOOR JOISTS; SIZE, LOCATION, AND ANCHORAGE OF ALL FLOOR BEAMS AND HEADERS; AND ALL RELATED FRAMING ISSUES

ROOF FRAMING

- ROOF FRAMING SHALL BE BY PRE-MANUFACTURED ROOF TRUSSES SPACED AT 24 INCHES ON CENTER UNLESS NOTED OTHERWISE.
- WOOD TRUSSES SHALL BE DESIGNED IN ACCORDANCE WITH THE REQUIREMENTS OF THE N.C.-R
- THE MANUFACTURER SHALL SUPPLY TO THE ARCHITECT AND BUILDER CALCULATIONS AND SHOP DRAWINGS FOR APPROVAL OF DESIGN LOADS, CONFIGURATION (2 OR 3 POINT BEARING), VOLUME CEILING OPTIONS, AND SHEAR TRANSFER, PRIOR TO FABRICATION.
- THE BRACING OF WOOD TRUSSES SHALL COMPLY TO THEIR APPROPRIATE ENGINEERED DESIGN. PER THE N.C.-R
- TRUSS MEMBERS SHALL NOT BE CUT, NOTCHED, DRILLED, SPLICED OR OTHERWISE ALTERED IN ANY WAY WITHOUT THE APPROVAL OF A RESISTERED DESIGN PROFESSIONAL. ALTERATIONS RESULTING IN THE ADDITION OF LOAD (E.G. HYAC EQUIPMENT, WATER HEATER) THAT EXCEEDS THE DESIGN LOAD FOR THE TRUSSES SHALL NOT BE PREMITTED WITHOUT WRITTEN VERIFICATION THAT THE TRUSS IS CAPABLE OF SUPPORTING SUCH ADDITIONAL LOADING.
- ALL CALCULATIONS AND SHOP DRAWINGS SHALL BE SIGNED BY A PROFESSIONAL ENGINEER REGISTERED IN THE STATE WHEREIN THE PROJECT IS TO BE BUILT.
- MANUFACTURER IS TO SECURE BUILDING DEPARTMENT APPROVAL OF CALCULATIONS AND SHOP DRAWINGS PRIOR TO FABRICATION

- THE SIZE, HEIGHT, AND SPACING OF STUDS SHALL BE IN ACCORDANCE
- STUDS SHALL BE PLACED WITH THEIR WIDE DIMENSION PERPENDICULAR TO THE WALL.
- NOT LESS THAN THREE STUDS SHALL BE INSTALLED AT EACH CORNER OF AN EXTERIOR WALL.
- WOOD STUD WALLS SHALL BE CAPPED WITH A DOUBLE TOP PLATE INSTALLED TO PROVIDE OVERLAPPING AT CORNERS AND INTERSECTIC WITH BEARING PARTITIONS, END JOINTS IN TOP PLATES SHALL BE OFFSET AT LEAST 24 INCHES, JOINTS NEED NOT OCCUR OVER STUDS PLATES SHALL BE KONTERS TO THE STUDY OF THE VE A WIDTH AT LEAST EQUAL TO THE WIDTH OF THE STUDS. SEE
- WHERE JOISTS, TRUSSES OR RAFTERS ARE SPACED MORE THAN 16 INCHES ON CENTER AND THE BEARING STUDS BELOW ARE SPACED 24 INCHES ON CENTER, SUCH MEMBERS SHALL BEAR WITHIN 5 INCHES OF THE STUDS BENEATH, SEE EXCEPTIONS.
- STUDS SHALL HAVE FULL BEARING ON NOMINAL 2 BY OR LARGER PLATE OR SILL HAVING A WIDTH AT LEAST EQUAL TO THE WIDTH OF THE STUDS.
- INTERIOR NONREARING WALLS SHALL BE PERMITTED TO BE CONSTRUCTED INITERIOR NONBEARING WALLS SHALL BE PERMITTED TO BE CONSTRUCTE
 WITH 2-INCH-BY-3-INCH STUDS SPACED 24 INCHES ON CENTER OR, WHEN
 NOT A PART OF A BRACED WALL LINE, 2-INCH-BY-4-INCH FLAT STUDS
 PACED IG INCHES ON CENTER, INTERIOR NONBEARING WALLS SHALL BE CAPPED WITH AT I FAST A SINGLE TOP PLATE INTERIOR NONREARING SHALL BE FIREBLOCKED IN ACCORDANCE WITH THE N.C.-R

WOOD & FRAMING (continued)

- DRILLING AND NOTHCING OF STUDS SHALL BE IN ACCORDANCE WITH THE
- NOTHCING, ANY STUD IN AN EXTERIOR WALL OR BEARING PARTITION MAY BE CUT OR NOTCHED TO A DEPTH NOT EXCEEDING 29 PERCENT OF ITS WIDTH, STUDG IN KONBEARING PARTITIONS MAY BE NOTCHED TO A DEPTH NOT TO EXCEED 40 PERCENT OF A SINGLE STUD WIDTH, NOTCHING OF BEARING STUDG SHALL BE ON ONE EDGE ONLY AND NOT TO EXCEED ONE-FOURTH THE HEIGHT OF THE STUD. NOTCHING SHALL NOT OCCUR IN THE BOTTOM OR TOP 6 INCHES OF BEARING STUDG.
- DRILLING, ANY STUD MAY BE BORED OR DRILLED, PROVIDED THAT THE DIAMETER OF THE RESULTING HOLE IS NO MORE THAN 60 PERCENT OF THE STUD MIDTH, THE EDGE OF THE HOLE IS NO MORE THAN 5/8" INCH TO THE EDGE OF THE STUD, AND THE HOLE SHALL NOT BE CLOSER THAN 6 INCHES FROM AN ADJACENT HOLE OR NOTCH, HOLES NOT EXCEEDING 3/4 INCH DIAMETER CAN BE AS CLOSE AS I I/2 INCHES ON CENTER SPACING, STUDD LOCATED IN EXTERIOR MALLS OR BEARING PARTITIONS DRILLED OVER 40 PERCENT AND UP TO 60 PERCENT SHALL ALSO BE DOUBLED WITH NO MORE THAN TWO SUCCESSIVE DOUBLED STUDS BORED.
- CUTTING AND NOTCHING OF STUDS SHALL BE PERMITTED TO BE INCREASED TO 65 PERCENT OF THE WIDTH OF THE STUD IN EXTERIOR AND INTERIOR WALLS AND BEARING PARTITIONS, PROVIDED THAT ONE OF THE FOLLOWING CONDITIONS ARE MET: THAT ONE OF THE FOLLOWING CONDITIONS ARE MET:

 (a) THE WALL SECTION IS REINFORCED NITH 1/2-INCH EXTERIOR
 GRADE PLYMOOD OR EQUIVALENT REINFORCEMENT ON THE NOTCHED
 SIDE OF THE WALL. PLYMOOD, IF USED, SHALL REACH FROM THE
 FLOOR TO CEILING AND AT LEAST ONE STUD FURTHER ON EACH SIDE
 OF THE SECTION THAT HAS BEEN NOTCHED OR CUT.

 (b) THE EXTERIOR WALLS OF A KITCHEN MAY BE REINFORCED
 BY PLACING I/2-INCH PLYMOOD OR EQUIVALENT REINFORCED
 THE NOTCHED SIDE OF THE WALL, PLYMOOD, IF USED, SHALL REACH
 FROM THE PLOOR TO COUNTER-TOP HEIGHT AND AT LEAST ONE STUD
 FURTHER ON EACH SIDE OF THE SECTION THAT HAS BEEN
- WHEN PIPING OR DUCTWORK IS PLACED IN OR PARTIALY IN AN EXTERIOR OR INTERIOR LOAD-BEARING WALL, NECESSITATION CUTTING, DRILLING OR NOTCHING OF THE TOP PLATE B MORE THAN 50 PERCENT OF ITS WIDTH A GALVANIZED METAL TIE OF NOT LESS THAN 0.054 INCH THICK AND I I/2' NCHES WIDE SHALL BE FASTENED ACROSS AND TO THE PLATE AT EACH SIDE OF THE OPENING WITH NOT LESS THAN EIGHT IOU NAILS HAVING A MINIMM LENGTH OF 1 1/2 INCHES (36 MM) AT EACH SIDE OR EQUIVALENT. THE METAL TIE MUST EXTEND A MINIMUM OF 6 INCHES PAST THE OPENING
- HEADERS SHALL MEET THE REQUIREMENTS OF THE N.C.-R.
- PROVIDE LATERAL BRACING PER THE N.C.-R.
- FOUNDATION CRIPPLE WALLS SHALL MEET THE REQUIREMENTS OF THE
- 14. WOOD STUD WALLS SHALL BE BRACED AS REQUIRED BY THE N.C.-F
- UNLESS COVERED BY INTERIOR OR EXTERIOR WALL COVERINGS OR SHEATHING MEETING THE MINIMAN REQUIREMENTS OF THIS CODE, ALL STUD PARTITIONS OR MALLS WITH STUDD HAVING A HEIGHT-TO-LEAST THICKNESS RATIO EXCEEDING 50 SHALL HAVE BRIDGING NOT LESS THAN 2 INCHES IN THICKNESS AND OF THE SAME WIDTH AS THE STUDS FITTED SHOLLY AND NAILED THERETO TO PROVIDE ADEQUATE LATERAL

FIRE BLOCKS AND DRAFT STOPS

- FIRE BLOCKING SHALL BE PROVIDED TO CUT OFF ALL CONCEALED DRAFT OPENINGS (BOTH VERTICAL AND HORIZONTAL) AND TO FORM AN EFFECTIVE BARRIER BETWEEN STORIES, AND BETWEEN A TOP STORY AND A ROOF SPACE, FIREBLOCKING SHALL BE REVIDED IN WOOD-FRAME CONSTRUCTION IN THE LOCATIONS SPECIFIED IN THE N.C.-R
- FIRE BLOCKING SHALL CONSIST OF 2 INCHES NOMINAL LUMBER, OR TWO THICKNESSES OF LINCH MONINAL LUMBER WITH BROKEN LAP JOINTS, OR ONE THICKNESS OF 23/32-INCH MOOD STRUCTURAL PANELS WITH JOINTS BACKED BY 23/32-INCH MOOD STRUCTURAL PANELS OR ONE THICKNESS OF 3/4-INCH PARTICLEBOARD WITH JOINTS BACKED BY 3/4-INCH PARTICLEBOARD WITH JOINTS BACKED BY 3/4-INCH PARTICLEBOARD WITH JOINTS BACKED BY 3/4-INCH PARTICLEBOARD MITH JOINTS BACKED BY 3/4-INCH PARTICLEBOARD MITH JOINTS BACKED BY 3/4-INCH PARTICLEBOARD MITH JOINTS BACKED BY 3/4-INCH PARTICLEBOARD, 1/2-INCH GYPSOM BOARD, or 1/4-INCH CHENT-BASED
- BATTS OR BLANKETS OF MINERAL WOOL OR GLASS FIBER OR OTHER APPROVED MATERIALS INSTALLED IN SUCH A MANNER AS TO BE SECURELY RETAINED IN PLACE SHALL BE PERMITTED AS AN ACCEPTABLE FIRE BLOCK.
- BATTS OR BLANKETS OF MINERAL OR GLASS FIBER OR OTHER APPROVED NON-RIGID MATERIALS SHALL BE FERMITTED FOR COMPLIANCE WITH THE 10 FOOT HORIZONTAL FIREBLOCKING IN WALLS CONSTRUCTED USING PARALLEL ROMS OF STUDS OR STAGGERED STUDS. LOOSE FILL INSULATION MATERIAL SHALL NOT BE USED AS A FIREBLOCK WILLESS SPECIFICALLY TESTED IN THE FORM AND MANNER INTENDED FOR USE TO DEMONSTRATE IT'S ABILLITY TO REMAIN IN PLACE AND TO RETARD THE SPREAD OF FIRE AND HOT GASSES.
- WHEN THERE IS USABLE SPACE BOTH ABOVE AND BELOW THE CONCEALED SPACE OF A FILODRICEILING ASSEMBLY, DRAFTSTOPS SHALL BE INSTALLES OF THAT THE AREA OF THE CONCEALED SPACE DOES NOT EXCEED 1,000 SQUARE FIET, DRAFTSTOPPING SHALL DIVIDE THE CONCEALED SPACE INTO APPROXIMATELY EQUAL AREAS, WHERE THE ASSEMBLY IS ENCLOSED BY A FLOOR MEMBRANE ABOVE AND A CEILING MEMBRANE BELOW, DRAFTSTOPPING SHALL BE! PROVIDED IN FLOOR/CEILING ASSEMBLIES UNDE THE FOLLOWING CIRCUMSTANCES. ASSEMBLIES UNDER
- FLOOR FRAMING IS CONSTRUCTED OF TRUSS-TYPE OPEN-WEB OR PERFORATED MEMBERS.
- HANDRAIL AND GUARDRAIL GUARDRAIL OF 36" HIGH MIN. SHALL BE PROVIDED WHERE FINISHED GRADE OR FLOOR BELOW RAISED AREA EXCEEDS 30".

CEILING IS SUSPENDED UNDER THE FLOOR FRAMING.

HANDRAIL AT STAIRS SHALL BE PROVIDED WHEN 4 OR MORE STAIR RISERS



NORTH CAROLINA 40' SERIES

KB HOME NORTH CAROLINA DIVISION

4518 S. MIAMI BLVD. SUITE 180 DURHAM, NC 27703 TEL: (919) 768-7988 • FAX: (919) 472-0582

. 2018 NORTH CAROLINA STATE BUILDING CODES

ISSUE DATE: 06/02/15 PROJECT No.: 1350999:56

MCP

REVISIONS: 05/07/19 '

DIVISION REVISIONS NCIS024NCP - 08/24/18 - CTD 2018 CODE UPDATE NCI9015NCP/ 03/15/19 / CTD

DIVISION MGR.:

DIVISION REVISION
NCI9017NCP- 04/01/19 CTD FRAMEWALK REVISIONS NCI9033NCP- 05/07/19 - CTD



DIVISION REVISIONS NC20012NCP- 01/29/20 · KBA



THERMAL & MOISTURE PROTECTION

- PROVIDE ALL FLASHING, COUNTER-FLASHING, BITUTHENE, MEMBRANE WATERPROOFING, SHEET METAL, CAULKING, SEALANTS, ELASTOMERIC WALKING SURFACES, AND RAIN GUITERS AND/OR DIVERTERS WHERE REQUIRED, TO MAKE WORK COMPLETELY WATERPROOF.
- "CORROSION RESISTANCE" SHALL MEAN THE ABILITY OF A MATERIAL TO WITHSTAND DETERIORATION OF IT'S SURFACE OR IT'S PROPERTIES WHEN EXPOSED TO IT'S ENVIRONMENT.
- PROVIDE A MINIMUM 2 INCH DROP FROM FINISHED INTERIOR FLOOR ELEVATION TO THE HIGHEST FLOOR ELEVATION OF ANY ADJOINING DECK OR BALCONY.
- ELASTOMERIC OR MEMBRANE DECK COATINGS SHALL BE INSTALLED PER MANUFACTURERS SPECIFICATIONS AT DECKS AND BALCONIES. COLOR, FINSH, AND DETAILING SHALL BE APPROVED BY OWNER/ BUILDER AND ARCHITECT.
- UNLESS DESIGNED TO DRAIN OVER DECK EDGES, DRAINS AND OVER-FLOWS OF ADEQUATE SIZE SHALL BE INSTALLED AT THE LOW POINTS OF THE DECK OR BALCONY.
- FOUNDATION WALLS WHERE THE OUTSIDE GRADE IS HIGHER THAN THE INSIDE GRADE SHALL BE WATER-PROOFED ALL DAMPPROOFED IN ACCORDANCE WITH THE N.C.-R.
- PARAPET WALLS SHALL BE PROPERLY COPED WITH NONCOMBUSTIBLE. PACATHERPROOF MATERIALS OF A MIDTH NO LESS THAN THE THICKNESS OF THE PARAPET WALL. PARAPET COPING SHALL EXTEND 2" MINIMUM DOWN THE FACES OF THE PARAPET

FLASHING

- APPROVED CORROSION-RESISTANT FLASHING SHALL BE APPLIED APPROVED CORROSION-RESISTANT FLASHING SHALL BE APPLIED SHINGLE-FASHION IN A MANIER TO PREVENT ENTRY OF MATER INTO THE MALL 12. CAVITY OR PENETRATION OF WATER TO THE BUILDING STRUCTURAL FRAMING COMPONENTS. SELF-ADHRED DEMORRANES USED AS FLASHING IN SHALL COMPLY WITH AAMA 711. FLUID-APPLIED MEMBRANES USED AS FLASHING IN 18. EXTERIOR WALLS SHALL COMPLY WITH AAMA 714. THE FLASHING SHALL EXTERIOR WALL SHALL COMPLY WITH AAMA 714. THE FLASHING SHALL EXTER ALLS SHALL COMPLY WITH AAMA 714. THE FLASHING SHALL SCHER TO CONTACT WITH FUBBER CEMENT MATERIAL, EXCEPT AT COUNTER FLASHING. APPROVED CORROSION-RESISTANT FLASHINGS SHALL BE INSTALLED AT ALL OF THE LOCATION STATED IN V. S. ALLED AT ALL OF THE LOCATIONS STATED IN N.C.-R
- 2. AT ALL WINDOW AND DOOR OPENINGS USE FORTIFIBER WATER-RESISTIVE BARRIERS, I.C.C. ESR-IO27, INSTALLED PER MANUFACTURER'S SPECIFICATIONS OR APPROVED EQUAL
- ALL BEAMS, OUTLOOKERS, CORBELS, ETC. PROJECTED THROUGH EXTERIOR WALLS OR PENETRATING EXTERIOR FINISHES SHALL BE FLASHED WITH A MINIMUM O.O.I9-INCH (NO. 26 SHEET METAL GAGE) CORROSION-RESISTANT METAL AND CAULKED
- ALL SHEET METAL WORK SHALL BE PERFORMED IN ACCORDANCE WITH THE RECOMMENDATIONS AND STANDARDS OF THE SHEET METAL AND AIR CONDITIONING CONTRACTOR'S NATIONAL ASSOCIATION (SMACNA). THE ARCHITECTURAL SHEET METAL ANNUAL, AND SEALANT, WATERPROOFING AND RESTORATION INSTITUTE'S (SWR.I.) GUIDE -SEALANT'S: THE PROFESSIONAL'S GUIDE".
- SHEET METAL SHALL BE STEEL SHEET, HOT-DIPPED, TIGHT COATED AND GALVANIZED, CONFORMING TO A.S.T.M. A525 AND SHALL BE A NUMBER 24 SHEET METAL GAGE INLESS OTHERNISE NOTED IN THESE NOTES, PLANS, OR MANUFACTURER'S SPECIFICATIONS.
- SHEET ALUMINUM SHALL CONFORM WITH FEDERAL SPECIFICATIONS QQ-A-359 AND A.S.T.M. B209 ALLOY 3003.
- FABRICATE SHEET METAL WITH FLAT LOCK SEAMS AND SOLDER WITH TYPE AND FLUX RECOMMENDED BY MANUFACTURER. SEAL ALUMINUM SEAMS WITH EPOXY METAL SEAM CEMENT. WHERE REQUIRED FOR STRENGTH, RIVET SEAMS AND JOINTS.
- SHOP FABRICATE TO THE GREATEST EXTENT POSSIBLE IN ACCORDANCE WITH APPLICABLE STANDARDS TO PROVIDE A PERMANENTLY WATER-PROOF, MEATHER RESISTANT INSTALLATION.
- ASPHALT SHINGLES SHALL HAVE SELF-SEAL STRIPS OR BE INTERLOCKING, AND COMPLY WITH ASTM D 225 OR D 3462.
- BASE AND CAP FLASHING SHALL BE INSTALLED IN ACCORDANCE WITH MANUFACTURER'S INSTALLATION INSTRUCTIONS. BASE FLASHING SHALL BE OF EITHER CORROSION-RESISTANT METAL OF MINIMM MOMINAL, O/014-INCH THICKNESS OR MINERAL SURFACE ROLL ROOFING MEIGHING A MINIMM OF TI POUNDS PER IOO SOURABLE FEET. CAP FLASHING SHALL BE CORROSION-RESISTANT METAL OF MINIMM NOMINAL O/014-INCH THICKNESS
- VALLEY LININGS SHALL BE INSTALLED IN ACCORDANCE WITH THE MANUFACTURER'S INSTALLATION INSTRUCTIONS BEFORE APPLYING SHINGLES, VALLEY LININGS OF THE FOLLOWING TYPES SHALL BE PERMITTED AS STATED PER THE N.C.-R
- A CRICKET OR SADDLE SHALL BE INSTALLED ON THE RIDGE SIDE OF ANY CHIMMEY OR PENETRATION MORE THAN 30 INCHES WIDE AS MEASURED PERPENDICULAR TO THE SLOPE. CRICKET OR SADDLE COVERINGS SHALL BE SHEET METAL OR OF THE SAME MATERIAL AS THE ROOF COVERING. VIDE FLASHING AT THE INTERSECTION OF CRICKET OR SADDLE AND
- FLASHING AGAINST A VERTICAL SIDEMALL SHALL BE BY THE STEP-FLASHING METHOD PER NC-R.
- FLASHING AGAINST A VERTICAL FRONT WALL, AS WELL AS SOIL STACK ASPHALT SHINGLE MANUFACTURER'S PRINTED INSTRUCTIONS
- AT THE JUNCTURE OF ROOF VERTICAL SURFACES, FLASHING AND COUNTERFLASHING SHALL BE PROVIDED IN ACCORDANCE WITH THE N.C.-R. AND THE MANUFACTURER'S INSTALLATION INSTRUCTIONS AND NHERE OF METAL, SHALL NOT BE LESS THAN O.O.I. INCH (NO. 26 GALVANIZED
- 16. VALLEY FLASHING FOR CONCRETE TILE ROOFS SHALL BE AS REQUIRED

ROOFING MATERIALS

- ROOF COVERINGS SHALL BE APPLIED IN ACCORDANCE WITH THE N.C.-R AND THE MANUFACTURER'S INSTALLATION INSTRUCTIONS. INSTALLATION OF ROOF COVERINGS SHALL COMPLY WITH THE APPLICABLE PROVISIONS OF THE N.C.-R.
- ROOFS AND ROOF COVERINGS SHALL BE OF MATERIALS THAT ARE COMPATIBLE WITH EACH OTHER AND WITH THE BUILDING OR STRUCTURE TO WHICH THE MATERIALS ARE APPLIED.
- ROOF COVERING MATERIALS SHALL CONFORM TO THE APPLICABLE STANDARDS LISTED IN THE N.C.-R IN THE ABSENCE OF APPLICABLE STANDARDS OR WHERE MATERIALS ARE OF QUESTIONABLE SUITABILITY, TESTING BY AN APPROVED TESTING AGENCY SHALL BE REQUIRED BY THE BUILDING OFFICIAL TO DETERMINE THE CHARACTER. QUALITY, AND LIMITATIONS OF APPLICATION OF THE MATERIALS.

THERMAL & MOISTURE PROTECTION (continued)

- ROOF COVERING MATERIALS SHALL BE DELIVERED IN PACKAGES BEARING THE MANUFACTURER'S IDENTIFYING MARKS AND APPROVED TESTING AGENCY LABELS WHEN REQUIRED. BULK SHIPMENTS OF MATERIALS SHALL BE ACCOMPANIED BY THE SAME INFORMATION ISSUED IN THE FORM OF A CERTIFICATE OR ON A BILL OF LADING BY THE MANUFACTURER
- COMPOSITION ROOFING SHINGLES SHALL BE OF ASPHALT OR APPROVED RELATED MATERIALS AND MEET THE REQUIREME OF THE N.C.-R
- UNDERLAYMENT FOR ASPHALT SHINGLES SHALL CONFORM TO ASTM D 226 TYPE I, ASTM D 4664, TYPE I, OR ASTM D 6757. SELF-ADHERING POLYMER MODIFIED BITUMEN SHEET SHALL COMPLY WITH ASTM D 1470
- ASPHALT SHINGLES SHALL COMPLY WITH ASTM D 225 OR ASTM D 3462.
- FASTENERS FOR ASPHALT SHINGLES SHALL BE GALVANIZED STEEL, STAINLESS STEEL, ALIMINUM, OR COPPER ROOFING NAILS, MINIMUM I2 GASE SHANK NITH A MINIMUM 38 INCH DIANETER HEAD, ASTM F 1667, OF A LENGTH TO PENETRATE THROUGH THE ROOFING MATERIALS AND A MINIMUM OF 34 INCH INTO THE ROOF SHEATHING, WHERE THE ROOF SHEATHING IS LESS THAN 3/4 INCH THICK, THE FASTENERS SHALL COMPLY WITH ASTM F 1667.
- ASPHALT SHINGLES SHALL HAVE THE MINIMUM NUMBER OF FASTENERS REQUIRED BY THE MANUFACTURER. FOR NORMAL APPLICATION, ASPHALT SHINGLES SHALL BE SECURED TO THE ROOF WITH NOT LESS THAN FOUR FASTENERS PER STRIP SHINGLE OR TWO FASTENERS PER INDIVIDUAL SHINGLE PER N.C.-R.
- UNDERLAYMENT FOR ASPHALT SHINGLES SHALL BE APPLIED IN ACCOR-DANCE WITH THE N.C.-R
- THE INSTALLATION OF CLAY AND CONCRETE TILE SHALL COMPLY WITH THE PROVISIONS OF N.C.-R CLAY ROOF TILE SHALL COMLY WITH ASTM C 1167.
- CONCRETE AND CLAY TILE SHALL BE INSTALLED ONLY OVER SOLID SHEATHING OR SPACED STRUCTURAL SHEATHING BOARDS
- CLAY AND CONCRETE ROOF TILE SHALL BE INSTALLED ON ROOF SLOPES OF 2 1/2 UNITS VERTICAL IN I2 UNITS HORIZONTAL (2-1/2:12)
 OR GREATER. FOR ROOF SLOPES FROM 2 1/2 UNITS VERTICAL
 IN 12 UNITS HORIZONTAL (2-1/2:12) TO FOUR UNITS VERTICAL
 IN 12 UNITS HORIZONTAL (4:12), DOUBLE UNDERLAYMENT APPLICATION IS REQUIRED IN ACCORDANCE WITH THE N.C.-R.
- UNDERLAYMENT FOR CLAY AND CONCRETE TILE SHALL CONFORM WITH ASTM D 226, TYPE II; ASTM D 2626 TYPE I; OR ASTM D 6380 CLASS M MINERAL SURFACED ROLL ROOFING.
- 15. CONCRETE ROOF TILE SHALL COMPLY WITH ASTM C 1492.
- NAILS SHALL BE CORROSION-RESISTANT AND NOT LESS THAN II GAGE, SIGLINGH HEAD, AND OF SUFFICIENT LENGTH TO PENETRATE THE DECK A MINIMM OF 34-INCH OR THROUGH THE THICKNESS OF THE DECK A MINIMM OF SHALLER THAO OR THROUGH THE THICKNESS OF THE DECK SHALL NOT BE SMALLER THAO OOBS-INCH. PERIMETER FASTENING AREAS INCLIDE THREE TILE COURSES BUT NOT LESS THAN 36 INCHES FROM EITHER SIDE OF HIPS OR RIDGES AND EDGES OF EAVES AND GABLE RAKES.
- 17. CLAY AND CONCRETE ROOF TILES SHALL BE FASTENED IN ACCORDANCE WITH THE N.C.-R
- TILE SHALL BE APPLIED ACCORDING TO THE MANUFACTURER'S INSTALLATION INSTRUCTIONS, BASED ON CLIMATIC CONDITIONS, ROOF SLOPE, INDERLAYMENT SYSTEM, AND TYPE OF TILE BEINS INSTALLED PER THE N.C.-R.
- THE INSTALLTION OF BUILT-UP ROOFS SHALL COMPLY WITH THE N.C.-R
- 20. BUILT-UP ROOFS SHALL HAVE A DESIGN SLOPE OF A MINIMUM OF ONE-FOUTH UNIT VERTICAL IN 12 UNITS HORIZONTAL (2-PERCENT SLOPE)
 FOR DRAINAGE, EXCEPT FOR COAL-TAR BUILT-UP ROOFS THAT SHALL
 HAVE A DESIGN SLOPE OF A MINIMUM ONE-EIGHTH UNIT VERTICAL IN
 12 UNITS HORIZONTAL (1-PERCENT SLOPE).
- 21. BUILT-UP ROOF COVERING MATERIALS SHALL COMPLY WITH THE STANDARDS PER THE N.C.-R

- SEE FINISHES IN THESE GENERAL NOTES FOR EXTERIOR PLASTER
- MATERIALS USED FOR THE CONSTRUCTION OF EXTERIOR WALLS SHALL COMPLY WITH THE PROVISIONS OF THE N.C.-R
- EXTERIOR WALLS SHALL PROVIDE THE BUILDING WITH A WEATHER-RESISTANT EXTERIOR WALL ENVELOPE. THE EXTERIOR WALL ENVELOPE SHALL INCLIDE FLASHING, THE EXTERIOR WALL ENVELOPE SHA BE DESIGNED AND CONSTRUCTED IN A MANNER THAT PREVENTS THE ACCUMILATION OF WATER WITHIN THE WALL ASSEMBLY BY PROVIDING A WATER-RESISTANT BARRIER BEHIND THE EXTERIOR VENEER AS REQUIRED AND A MEANS OF DRAINING WATER THAT ENTERS THE ASSEMBLY TO THE EXTERIOR. PROTECTION ASAINST CONDENSATION IN THE EXTERIOR WALL ASSEMBLY SHALL BE PROVIDED.
- ONE LAYER OF NO. 15 ASPHALT FELT, FREE FROM HOLES AND BREAKS, COMPLYING WITH ASTM D 226 FOR TYPE I FELT OR OTHER APPROVED WATER-RESISTIVE BARRIER SHALL BE APPLIED OVER STUDS OR SHEATHING OF ALL EXTERIOR WALLS, SUCH FELT OR MATERIAL SHALL BE APPLIED HORIZONTALLY, MITH THE UPPER LAYER LAPPED OVER THE LOWER LAYER NOT LESS THAN 2 INCHES, WHERE JOINTS OCCUR, FELT SHALL BE LAPPED NOT LESS THAN 6 INCHES, THE FELT OR OTHER APPROVED MATERIAL SHALLS END TERMINATED AT PENETRATIOS AND BUILDING APPENDAGES IN A MANNER TO MEET THE REQUIREMENTS OF THE EXTERIOR WALL ENVELOPE.
- FIBER CEMENT SIDING CONFORMING TO THE REQUIREMENTS OF THE N.C.-R AND FIBER CEMENT SIDING CONFORMING TO THE REQUIREMENTS OF THE N.C.-R. AND COMPLYING WITH ASTM D SATE 914ALL BE PERMITTED ON EXTERIOR WALLS OF BUILDINGS OF TYPE V CONSTRUCTION LOCATED IN AREAS WHERE THE ULTIMATE WIND SPEED SPECIFIED DOES NOT EXCEED ICO MILES PER HOUR AND THE BUILDINGS HEIGHT IS LESS THAN 40 FIET IN EXPOSURE C. MHERE CONSTRUCTION IS LOCATED IN AREAS WHERE THE ULTIMATE WIND SPEED EXCEEDS ISO MILES PER HOUR OR BUILDING HEIGHTS ARE IN EXCESS OF 40 FT. DATA INDICATING COMPLIANCE MIST BE SUBMITTED. FIBER CEMENT SIDIN SHALL BE SECURED TO BUILDING HE OF PROVIDE WEATHER PROTECTION FOR THE EXTERIOR WALLS OF THE BUILDING.
- THE N.C.-R FIBER CEMENT SIDING SHALL BE APPLIED TO CONFORM WITH THE WEATHER-RESISTIVE BARRIER REQUIREMENTS FIBER CEMENT SIDING AND ACCESSORIES SHALL BE INSTALLED IN ACCORDANCE WITH APPROVED
- FIBER CEMENT SIDING FASTENERS AND ACCESSORIES SHALL MEET THE REQUIREMENTS OF THE N.C.-B
- EXTERIOR WALLS OF WOOD CONSTRUCTION SHALL BE DESIGNED AND CONSTRUCTED IN ACCORDANCE WITH THE N.C.-R

THERMAL & MOISTURE PROTECTION (continued)

- HARDBOARD SIDING SHALL CONFORM TO THE REQUIREMENTS OF AHA AISS,6 AND, WHERE USED STRUCTURALLY, SHALL BE SO IDENTIFIED BY THE LABEL OF AN APPROVED AGENCY.
- WOOD VENEERS ON EXTERIOR WALLS OF BUILDINGS OF TYPES I, II, III, AND IV CONSTRUCTION SHALL BE NOT LESS THAN I-INCH NOMINAL THICKNESS, 0.438-INCH EXTERIOR HARDBOARD SIDING OR 0.375-INCH EXTERIOR-TYPE WOOD STRUCTURAL PANELS OR PARTICLE-BOARD AND SHALL CONFORM TO THE REQUIREMENTS OF THE N.C.-R
- FIBER-CEMENT LAP SIDING HAVING A MAXIMUM WIDTH OF 12 INCHES SHALL COMPLY WITH THE REQUIREMENTS OF ASTM CIID6, TYPE A, MINIMUM GRADE III. LAP SIDING SHALL BE LAPPED A MINIMUM OF III/4 INCHES (32 MM) AND LAP SIDING NOT HAVING TONGUE-AND-GROOVE END JOINTS SHALL HAVE THE ENDS SEALED WITH CAULKING, INSTALLED WITH AN H-SECTION JOINT COVER, LOCATED OVER A STRIP OF FLASHING OR SHALL BE DESIGNED TO COMPLY WITH INC-R. LAP SIDING COURSES MAY BE INSTALLED WITH THE FASTENER HEADS EXPOSED OR CONCEALED, ACCORDING TO NC-R OR APPROVED MANUFACTURERS' INSTALLATION INSTRUCTIONS.

INSULATION

- INSULATING MATERIALS, INCLUDING FACINGS, SUCH AS VAPOR RETARDERS OR VAPER-PERNIEABLE MEDRANES, INSTALLED WITHIN FLOOR-CEILING ASSEMBLIES, ROOF-CEILING ASSEMBLIES, RALL-ASSEMBLIES, CRANL SPACES AND ATTICS SHALL HAVE A FLAME-SPREAD INDEX NOT TO EXCEED 28 WIHTH AN ACCOMPANYING SMOKEDEVELOPED INDEX NOT TO EXCEED 28 WHEN TRESTED IN A SAME
- DUCT INSULATION MATERIALS SHALL CONFORM TO THE FOLLOWING
- INSULATION AND COYERING ON PIPE AND TUBING SHALL HAVE A FLAME-SPREAD INDEX OF NOT MORE THAN 25 AND A SMOKE-DEVELOPED INDEX OF NOT MORE THAN 450. SEE EXCEPTIONS.
- ALL EXPOSED INSULATION MATERIALS INSTALLED ON ATTIC FLOORS SHALL HAVE A CRITICAL RADIANT FLUX OF NOT LESS THAN 0.12 WATT PER SQUARE IT. CENTIMETER PER N.C.-R TESTS FOR CRITIAL RADIANT FLUX SHALL BE MADE IN ACCORDANCE WITH ASTM E 970.
- THE USE OF ABOVE DECK THERMAL INSULATION SHALL BE PERMITTED PROVIDED SUCH INSULATION IS COVERED WITH AN APPROVED ROOF COVERING AND PASSES FM 4450 OR UL 1256 PER N.C.-R.
- CELLULOSE LOOSE-FILL INSULATION SHALL COMPLY WITH CPSC 16 CFR. PARTS 1209 AND 1404. EACH PACKAGE OF SUCH INSULATIN MATERIAL SHALL BE CLEARLY LABELED IN ACCORDANCE WITH CPSC 16 CFR, PARTS 1209 AND 1404.
- INSULATION IN FLOOR-CEILING ASSEMBLIES, ROOF-CEILING ASSEMBLIES, WALLS, CRAWL SPACES OR ATTICS SHALL BE EITHER OF THE BLONN-IN CELLULOSE TYPE OR FIBERGLASS BATTS OR BLANKET TYPE PER BUILDER'S SPECIFICATIONS.
- THE ENERGY EFFICIENCY REQUIREMENTS INCLUDING I.E.C.C. BUT NOT LIMITED TO INSULATION "R" VALUES, PERCENTAGE OF GLAZING "U" VALUES, ETC. SHALL BE DETERMINED BY THE ADDITED STATE AND LOCAL ENERGY CODE EQUIREMENTS. REFER TO MECHANICAL PLANS FOR SPECIFICATIONS.
- THE BUILDING THERMAL ENVELOPE SHALL BE DURABLY SEALED MITH AN AIR BARRIER SYSTEM TO LIMIT INFILTRATION THE SEALING METHODS BETWEEN DISSIMILAR MATERIALS INFILTRATION FOR DIFFERENTIAL EXPANSION AND CONTRACTION, FOR ALL HOMES, WHERE PRESENT THE FOLLOWING SHALL BE CAULKED, GASKETED, WEATHERSTRIPPED OR OTHERWISE SEALED MITH AN AIR BARRIER MATERIAL OR SOLID MATERIAL CONSISTENT MITH APPENDIX E-2.3 AND E-2.4 OF THE NC-R; MICH SYSTEMS AND UNDER KNEE WALLS OPEN TO UNCONDITIONED OR EXTERIOR SPACE. 2. CAPPING AND SEALING SHAFTS OR CHASES, INCLUDING FLUE 31. CAPPING AND SEALING SOFFIT OR DROPPED CEILING AREAS
- FRAMED CAVITY WALLS, THE EXTERIOR THERMAL ENVELOPE WALL INSULATION SHALL BE INSTALLED IN SUBSTANTIAL CONTACT AND CONTINUOUS ALIGNMENT MITH THE BUILDING ENVELOPE AIR BARRIER, INSULATION SHALL BE SUBSTANTIALLY FREE FROM INSTALLATION GAPS, VOIDS, OR COMPRESSION, FOR FRAMED WALLS, THE CAVITY INSULATION SHALL BE ENCLOSED ON ALL SIDES WITH A RIGID MATERIAL OR AN AIR BARRIER MATERIAL, WALL INSULATION SHALL BE ENCLOSED AT THE FOLLOWING LOCATIONS WHEN INSULATION SHALL BE ENCLOSED AT THE FOLLOWING LOCATIONS WHEN NSTALLED ON EXTERIOR WALLS PRIOR TO BEING COVERED BY SUBSEQUENT CONSTRUCTION, CONSISTENT WITH APPENDIX E-2.3 AND E-2.4 OF NC-R:
- I. TUBS
 2. SHOWERS
 3. STAIRS
 4. FIREPLACE UNITS
 ENCLOSURE OF WALL CAVITY INSULATION ALSO APPLIES TO WALLS THAT
 ADJOIN ATTIC SPACES BY PLACING A RIGID MATERIAL OR AIR BARRIER
 MATERIAL ON THE ATTIC SIDE.

DOORS & WINDOWS

- SEE FLOOR PLANS AND ELEVATIONS FOR SIZES AND TYPES OF DOORS AND WINDOWS AND FOR ANY DIVIDED LITE PATTERNS, COLORS SHALL BE APPROVED BY THE BUILDER AND ARCHITECT.
- OPENINGS FROM A PRIVATE GARAGE DIRECTLY INTO A ROOM USED FOR SLEEPING PURPOSES SHALL NOT BE PERMITTED. OTHER OPENINGS BETWEEN THE GARAGE AND RESIDENCE SHALL EQUIPPED WITH SOLID WOOD DOORS NOT LESS THAN I 3/6 INCHES THAN I 3/6 INCHES THAN I 3/6 INCHES THICK, OR 20-MINITE FIRE-RATED DOORS.
- NO DOUBLE FRENCH DOORS SHALL BE USED UNLESS THERE IS A SUFFICIENT OVERHANG OR COVERED PATIO COVERING THESE DOORS. NO DOUBLE MOOD FRENCH DOORS SHALL BE USED IN
- PROVIDE SECURITY HARDWARE FOR ALL DOORS AND WINDOWS IANCE WITH ALL STATE AND LOCAL CODE REQUIREMENTS.
- ALL AUTOMATIC GARAGE DOOR OPENERS REQUIRE THE INCLUSION OF A PHOTOELECTRIC SENSOR, EDGE SENSOR OR SOME OTHER SIMILAR DEVICE FOR REMOTE OPERATION AND AS A SAFETY PRECAUTION TO PREVENT THE DOOR FROM CLOSING WHEN SOMETHING IS BLOCKING THE PATH OF THE DOOR. SEE MANUFACTURER'S
- ALL MANUFACTURED WINDOWS AND SLIDING GLASS DOORS SHALL MEET THE AIR INFILTRATION STANDARDS OF THE CURRENT AMERICAN
 FIBER CEMENT SIDING SHALL BE APPLIED OVER SHEATHING OR MATERIALS LISTED INATIONAL STANDARDS INSTITUTE A.S.T.M. E288-73 WITH A PRESSURE DIFFERENTIAL OF 1.57 POUNDS PER SQUARE FOOT AND SHALL BE CERTIFIED AND LABELED
 - BASEMENTS, HABITABLE ATTICS AND EVERY SLEEPING ROOM SHALL HAVE AT LEAST ONE OPENABLE EMERGENCY ESCAPE AND RESCUE OPENING
 - WHERE EMERGENCY ESCAPE AND RESCUE OPENINGS ARE PROVIDED SHALL HAVE A SILL HEIGHT OF NOT MORE THAN 44 INCHES ABOVE
 - EMERGENCY ESCAPE AND RESCUE OPENINGS WITH A FINISHED SILL HEIGHT BELOW THE ADJACENT GROUND ELEVATION SHALL BE PROVIDED WITH A MINDOM WELL

DOORS & WINDOWS (continued)

- ALL EMERGENCY ESCAPE AND RESCUE OPENINGS SHALL HAVE A MINIMUNET CLEAR OPENING OF NOT LESS THAN 5 SQUARE FEET IN THE CASE OF ROUND FLOOR LEVEL WINDOW AND NOT LESS THAN 5.7 SQUARE FEET IN THE CASE OF AN UPPER STORY WINDOW.
- _ EMERGENCY ESCAPE AND RESCUE OPENINGS SHALL HAVE A MINIMUM CLEAR OPENING HEIGHT OF 24 INCHES.
- ALL EMERGENCY ESCAPE AND RESCUE OPENINGS SHALL HAVE A MINIMUM NET CLEAR OPENING WIDTH OF $20\,$ INCHES.
- EMERGENCY ESCAPE AND RESCUE OPENINGS SHALL BE OPERATIONAL FROM THE INSIDE OF THE ROOM WITHOUT THE USE OF KEYS, TOOLS OF SPECIAL KNOWLEDGE.
- THE MINIMUM HORIZONTAL AREA OF THE WINDOW WELL SHALL BE 9 SQUARE FEET, MITH A MINIMUM HORIZONTAL PROJECTION AND WIDTH OF 96 INCHES. THE AREA OF THE MINDOW WELL SHALL ALLOW ENERGENCY ESCAPE AND RESCUE OPENING TO BE FULLY OPENED PER THE N.C.-R. THE LADDER OR STEPS REQUIRED SHALL BE PERMITTED TO ENCROACH A MAXIMUM OF 6" INTO THE REQUIRED DIMENSIONS OF THE MINDOW WELL.
- MINDOW WELLS WITH A VERTICAL DEPTH GREATER THAN 44 INCHES SHALL BE EQUIPPED WITH A PERMANENTLY AFFIXED LADDER OR STEPS USABLE WITH THE WINDOW IN THE FULLY OPEN POSITION.
- BARS GRILLES COVERS SCREENS OR SIMILAR DEVICES ARE PERMITTED TO BARS, GRILLES, COVERS, SCREENS OR SIMILAR DEVICES ARE PERMITTED TO BE PLACED OVER EMERGENCY ESCAPE AND RESCUE OPENINGS, BULKHEAD ENCLOSURES, OR MINDOM WELLS THAT SERVE SUCH OPENINGS, PROVIDED THE MINIMUM NET CLEAR OPENING SIZE COMPLIES WITH THE NC.-R AND SUCH DEVICES SHALL BE RELEASABLE OR REMOVABLE FROM THE INSIDE WITHOUT THE USE OF A KEY, TOOL, SPECIAL KNOWLEDGE OR FORCE GREATER THAN THAT WHICH IS REQUIRED FOR NORMAL OPERATION OF THE ESCAPE AND RESCUE OPENING
- ALL INTERIOR EGRESS DOORS AND A MINIMUM OF ONE EXTERIOR EGRESS DOOR SHALL BE READILY OPENABLE FROM THE SIDE FROM WHICH ESPE 19 TO BE MADE WITHOUT THE USE OF A KEY OR SPECIAL KNOWLEDGE OR EFFORT.

GLAZING & SAFETY GLAZING

- HABITABLE ROOMS SHALL HAVE AN AGGREGATE GLAZING AREA OF NOT LESS THAN & PERCENT OF THE FLOOR AREA OF SUCH ROOMS. NATURAL VENTILATION SHALL BE THROUGH WINDOWS, SKYLIGHTS, DOORS, LOUVERS OR OTHER APPROVED OPENINGS TO THE OUTDOOR AIR, SUCH OPENINGS SHALL BE PROVIDED WITH READY ACCESS OR SHALL OTHERWISE BE READILY CONTROLLABLE BY THE BUILDING LESS THAN 4 PERCENT OF THE FLOOR AREA BEING VENTILATED.
- BATHROOMS, WATER CLOSET COMPARTMENTS AND OTHER SIMILAR MINDONS OF NOT LESS THAN 3 SQUARE FEET, ONE-HALF OF WHICH MUST BE OPENABLE.
- EXCEPT AS INDICATED, EACH PANE OF GLAZING INSTALLED IN HAZARDOUS LOCATIONS SHALL BE PROVIDED WITH MANUFACTURER'S DESIGNATION SPECIFYING WHO APPLIED THE DESIGNATION, DESIGNATING THE TYPE OF GLASS AND THE SAFETY GLAZING STANDARD WITH WHICH IT COMPLIES, WHICH IS VISIBLE IN THE FINAL INSTALLATION. THE DESIGNATION SHALL BE ACID ETCHED, SANDBLASTED, CERAWIC-FIRED, LASER ETCHED, EMBOSSED, OR BE OF A TYPE WHICH ONCE APPLIED CANNOT BE REMOVED WITHOUT BEING DESTROYED.
- INDIVIDUAL GLAZED AREAS, INCLUDING GLASS MIRRORS IN HAZARDOUS LOCATIONS SHALL PASS THE TEST REQUIREMENTS OF CPSC 16 CFR, PART 1201. GLAZING SHALL COMPLY WITH CPSC 16.
- THE FOLLOWING SHALL BE CONSIDERED SPECIFIC HAZARDOUS LOCATIONS FOR THE PURPOSES OF GLAZING:
- GLAZING IN ALL FIXED AND OPERABLE PANELS OF SWINGING,
- SUDING AND BIFOLD DOORS

 SLIDING AND BIFOLD DOORS

 SLAXING IN AN INDIVIDUAL PIXED OR OPERABLE PANEL IN THE SAME
 PLANE AS A DOOR WHERE THE NEAREST VERTICAL EDGE IS WITHIN
 24-INCHES OF THE DOOR IN A CLOSED POSITION AND WHOSE BOTTOM
 EDGE IS LESS THAN 60 INCHES ABOVE THE FLOOR OR MALKING
- GLAZING IN AN INDIVIDUAL FIXED OR OPERABLE PANEL THAT MEETS ALL OF THE FOLLOWING CONDITIONS:
- 3.1 EXPOSED AREA OF AN INDIVIDUAL PANE LARGER THAN 9 SQUARE
- 3.2 BOTTOM EDGE LESS THAN 18 INCHES ABOVE THE FLOOR
- ONE OR MORE WALKING SURFACES WITHIN 36 INCHES, MEASURED HORIZONTALLY AND IN A STRAIGHT LINE, OF THE GLAZING.
- GLAZING IN GUARDS AND RAILINGS, INCLUDING STRUCTURAL BALUSTER PANELS AND NONSTRUCTURAL IN-FILL PANELS, REGARDLESS OF AREA OR HEIGHT ABOYE A MALKING SURFACE.
- GLAZING IN DOORS AND ENCLOSURES FOR HOT TUBS, WHIRLPOOLS, SAUNAS, STEAM ROOMS, BATHTUBS AND SHOWERS, GLAZING ENCLOSING THESE COMPARTMENTS WHERE THE BOTTOM EXPOSED EDGE OF THE GLAZING IS LESS THAN 60 INCHES MEASURED VERTICALLY ABOVE ANY STANDING OR WALKING SURFACE.
- GLAZING IN WALLS AND FENCES ENCLOSING INDOOR AND OUTDOOR SWIMMING POOLS, HOT TUBS AND SPAS WHERE THE BOTTOM EDGE OF THE GLAZING IS LESS THAN 60 INCHES ABOVE A WALKING SURFACE AND MITHIN 60 INCHES HORIZONTALLY OF THE WATER'S EDGE. THIS LL APPLY TO SINGLE GLAZING AND ALL PANES IN MULTIPLE
- GLAZING ADJACENT TO STAIRWAYS, LANDINGS AND RAMPS WITHIN 36 INCHES HORIZONTALLY OF A WALKING SURFACE WHEN THE EXPOSED SURFACE OF THE GLAZING IS LESS THAN 36 INCHES ABOVE THE PLANE THE ADJACENT WALKING SURFACE.
- GLAZING ADJACENT TO THE LANDING AT THE BOTTOM OF STAIRWAYS WHERE THE GLAZING IS LESS THAN 36 INCHES ABOVE THE LANDING AND WITHIN A 60-INCH HORIZONTAL ARC LESS THAN 180 DEGREES FROM THE BOTTOM TREAD NOSING.
- HINGED SHOWER DOORS SHALL OPEN OUTWARD.
- GLAZING SHALL BE IN ACCORDANCE WITH ENERGY COMPLIANCE CALCULATIONS BASED ON A LOCALLY ADOPTED ENERGY CODE, THE MODEL ENERGY CODE OR THE INTERNATIONAL ENERGY CONSERVATION CODE.
- LOCATED MORE THAN 72 INCHES (1829 MM) ABOVE THE FINISHED GRADE OR SURFACE BELOW, THE LOWEST PART OF THE CLEAR OPENING OF THE NINDOM SHALL BE A MINIMUM OF 24 INCHES (610 MM) ABOVE THE FINISHED FLOOR OF THE ROOM IN WHICH THE WINDOW IS LOCATED, OPERABLE SECTIONS OF WINDOWS SHALL NOT PERMIT OPENINGS THAT ALLOW PASSAGE OF A 4 INCH (IO2 MM) DIAMETER SPHERE WHERE SUCH OPENINGS ARE LOCATED WITHIN 24 INCHES (610 MM) OF THE FINISHED FLOOR

IN DWELLING UNITS, WHERE THE OPENING OF AN OPERABLE WINDOW IS

FINISHES

- GYPSUM WALLBOARD SHALL BE INSTALLED IN CONFORMANCE WITH THE CURRENT EDITION OF THE NORTH CAROLINA RESIDENTIAL CODE AND ALL STATE AND LOCAL BUILDING CODES. THE MOST STRINGENT REQUIREMENTS SHALL GOVERN.
- MATERIALS. ALL SYPSUM BOARD MATERIALS AND ACCESSORIES SHALL CONFORM TO ASTM C 22, C 41%, C 94, C 1002, C 1041, C 1171, C 111%, C 1218, C 1946, OR C 1658 AND SHALL BE INSTALLED IN ACCORDANCE WITH THE PROVISIONS OF THE N.C.-R ADHESIVES FOR THE INSTALLATION OF GYPSUM BOARD SHALL CONFORM TO ASTM C 551.
- GYPSUM BOARD MATERIALS SHALL CONFORM TO THE APPROPRIATE STANDARDS LISTED IN THE NC.-R WHERE REQUIRED FOR FIRE PROTECTION, CONFORM TO THE NC.-R
- INTERIOR GYPSUM BOARD SHALL NOT BE INSTALLED WHERE IT IS DIRECTLY EXPOSED TO THE WEATHER OR TO WATER.
- ALL EDGES AND ENDS OF GYPSUM BOARD SHALL OCCUR ON THE FRANING MEMBERS, EXCEPT THOSE EDGES AND ENDS THAT ARE PERPENDICULAR TO THE FRANING MEMBERS. EDGES AND ENDS OF GYPSUM BOARD SHALL BE IN MODERATE CONTACT EXCEPT IN CONCEALED SPACES WHERE FIRE-RESISTACE-RATED CONSTRUCTION, SHEAR RESISTANCE, OR DIAPHRAGM ACTION IS NOT REQUIRED, CEALED SPACES WHERE FIRE-RESISTACE-RATED CONSTRUCTION.
- FASTENERS AT THE TOP AND BOTTOM PLATES OF VERTICAL ASSEMBLIES, FASTENERS AT THE TOP AND BOTTOM PLATES OF VERTICAL ASSEMBLIES, OR THE EDGES AND ENDS OF HORIZONTAL ASSEMBLIES PERFENDICULAR TO SUPPORTS, AND AT THE WALL LINE MAY BE OMITTED EXCEPT ON SHEAR-RESISTING ELEMENTS OR FIRE- RESISTIVE ASSEMBLIES, FASTENERS ALL BE APPLIED IN SUCH A MANNER AS NOT TO FRACTURE THE FACE PAPER WITH THE FASTENER HEAD.
- GYPSUM BOARD USED AS THE BASE OR BACKER FOR ADHESIVE APPLICATION OF CERAMIC TILE OR OTHER REQUIRED NON-ABSORBENT FINISH MATERIAL SHALL CONFORM TO ASTM C 1996, C 1175 OR C1275. USE OF WATER-RESISTANT GYPSUM BACKING BOARD SHALL BE PERMITTED ON CEILINGS WHERE FRAMING SPACING DOES NOT EXCEED 12 INCHES ON CENTER FOR 1/2-INCH-THICK OR 16 INCHES FOR 5/8-INCH-THICK GYPSUM BOARD WATER-RESISTANT GYPSUM BOARD SHALL NOT BE INSTALLED OVER A VAPOR RETARDER IN A SHOWER OR TUB COMPARTMENT, GUT OR EXPOSED EDGES, INCLUDING THOSE AT WALL INTERSECTIONS, SHALL BE SEALED AS RECOMMENDED BY THE MANUFACTURER.
- MATER RESISTANT GYPSUM BACKING BOARD SHALL NOT BE USED WHERE THERE WILL BE DIRECT EXPOSURE TO WATER, OR IN AREAS SUBJECT TO CONTINUOUS HIGH HUMIDITY
- WHEN APPLYING A WATER-BASED TEXTURE MATERIAL. THE MINIMUM SYPSUM BOARD THICKNESS SHALL BE INCREASED FROM 3/6 INCH TO 1/2 INCH FOR I6-INCH ON CENTER FRAMING, AND FROM I/2 INCH TO 5/6 INCH FOR 24-INCH ON CENTER FRAMING OR I/2 INCH SAG-RESISTANT GYPSUM CEILING BOARD SHALL BE USED.

- ALL LATH AND LATH ATTACHMENTS SHALL BE OF CORROSION-
- BACKING OR A LATH SHALL PROVIDE SUFFICIENT RIGIDITY TO PERMIT PLASTER APPLICATION.
- WHERE LATH ON VERTICAL SURFACES EXTENDS BETWEEN RAFTERS OR OTHER SIMILAR PROJECTING MEMBERS, SOLID BACKING SHALL BE INSTALLED TO PROVIDE SUPPORT FOR LATH AND ATTACHMENTS. GYPSUM LATH OR GYPSUM BOARD SHALL NOT BE USED, EXCEPT THAT ON HORIZONTAL SUPPORTS OF CEILINGS OR ROOF SOFFITS IT MAY BE USED AS BACKING FOR METAL LATH OR WIRE FABRIC LATH AND
- UNLESS SPECIFIED OTHERWISE, ALL WALL COVERINGS SHALL BE SECURELY UNLESS SPECIFIED OF HERWISE, ALL WALL COVENINGS SHALL BE SECURELY FASTENED PER THE N.C.-R. OR NITH OTHER APPROVED ALUMINUM, STAINLESS STEEL, ZINC-COATED OR OTHER APPROVED CORROSION-RESISTIVE FASTENERS, WHERE THE BASIC MIND SPEED IS 110 MILES PER HOUR OR HIGHER, THE ATTACHMENT OF WALL COVERINGS SHALL BE DESIGNED TO RESIST THE COMPONENT AND CLADDING LOADS SPECIFIED AND ADJUSTED FOR HEIGHT AND EXPOSURE.
 - A MINIMUM O.019-INCH (NO. 26 GALVANIZED SHEET GAGE), CORROSION-RESISTANT MEEP SCREED OR PLASTIC MEEP SCREED, WITH A MINIMUM VERTICAL ATTACHMENT FLANGE OF 31/2 INCHES SHALL BE PROVIDED AT OR BELOW THE FOUNDATION PLATE LINE ON EXTERIOR STUD MALLS IN ACCORDANCE WITH ASTM C 426. THE NEEP SCREED SHALL BE PLACED A MINIMUM OF 4 INCHES ABOVE THE EARTH OR 2 INCHES ABOVE PAYED AREAS AND SHALL BE OF A TYPE THAT MILL ALLOW TRAPPED WATER TO DRAIN TO THE EXTERIOR OF THE BUILDING. THE MEATHER-RESISTANT BARRIER SHALL LAP THE ATTACHMENT FLANGE. THE EXTERIOR LATH SHALL COVER AND TERMINATE ON THE ATTACHMENT FLANGE OF THE MEEP SCREED. A MINIMUM O.O.I9-INCH (NO. 26 GALVANIZED SHEET GAGE),

CEMENT PLASTER

PLASTERING WITH PORTLAND CEMENT PLASTER SHALL BE NOT LESS THAN THREE COATS WHEN APPLIED OVER METAL LATH OR WIRE LATH AND SHALL BE NOT LESS THAN TWO COATS WHEN APPLIED OVER MASONRY, CONCRETE, PRESSURE-PRESERVATIVE TREATER DWOD OR DECAY-RESISTANT WOOD OR SYPSUM BACKINS, IF THE PLASTER SURFACE IS COMPLETELY COVERED BY VENEER OR OTHER FACING MATERIAL OR IS COMPLETELY CONCEALED, PLASTER APPLICATION NEED BE ONLY TWO COATS, PROVIDED THE TOTAL THICKNESS IS AS SET FORTH PER THE N.C.-R

ON WOOD-FRAME CONSTRUCTION WITH AN ON-GRADE FLOOR SLAB SYSTEM EXTERIOR PLASTER SHALL BE APPLIED TO COVER, BUT NOT EXTEND BELOW LATH, PAPER AND SCREED.

THE PROPORTION OF AGGREGATE TO FIBER CEMENT MATERIALS SHALL BE

- ONLY APPROVED PLASTICITY AGENTS AND APPROVE AMOUNTS THEREOF MAY BE ADDED TO PORTLAND CEMENT. WHEN PLASTIC CEMENT IS USED, NO ADDITIONAL LINE OR PLASTICIZERS SHALL BE ADDED. HYDRATED LIME OR THE EQUIVALENT AMOUNT OF LIME PUTTY USED AS A PLASTICIZER MAY BE ADDED TO CEMENT PLASTER. OR CEMENT AND LIME PLASTER IN AN AMOUNT NOT TO EXCEED THAT
- GYPSUM PLASTER SHALL NOT BE USED ON EXTERIOR SURFACES
- PLASTER COATS SHALL BE PROTECTED FROM FREEZING FOR A PERIOD OF NOT LESS THAN 24 HOURS AFTER SET HAS OCCURRED PLASTER SHALL BE APPLIED WHEN THE AMBIENT TEMPERATURE IS HIGHER THAN 40 DEGREES F (4 DEGREES C), UNLESS PROVISIONS ARE MADE TO KEEP CEMENT PLASTER WORK ABOVE 40 DEGREES I (4 DEGREES C), PRIOR TO & DURING APPLICATION AND 48 HOURS
- COLOR AND FINISH TO BE SELECTED AND APPROVED BY OWNER/ BUILDER AND ARCHITECT
- A I-COAT EXTERIOR PLASTER SYSTEM SUCH AS "MAGNA WALL" I.C.C. NO. ER-4776. "EXPO FIBREWALL" I.C.C. NO. ER-4368. OR APPROVED EQUAL MAY BE USED IN LIEU OF A 3-COAT EXTERIOR



HOME

.

.

.

NORTH CAROLINA 40' SERIES

KB HOME NORTH CAROLINA DIVISION

4518 S. MIAMI BLVD. SUITE 180 DURHAM, NC 27703 TEL: (919) 768-7988 FAX: (919) 472-0582

2018 NORTH CAROLINA STATE BUILDING CODES

. . . .

MCP

ISSUE DATE: 06/02/15 PROJECT No.: 1350999:56

REVISIONS: 05/07/19 DIVISION REVISIONS NCIS024NCP - 08/24/18 - CTD

DIVISION MGR.:



FRAMEWALK REVISIONS NCI9033NCP- 05/07/19 - CTD DIVISION REVISIONS
NC20012NCP- 01/29/20 · KBA

DIVISION REVISION NCI9017NCP- 04/01/19 CTD



240.2596-R SHEET GN₂

MECHANICAL & PLUMBING

- ALL MATERIALS AND CONSTRUCTION METHODS SHALL BE IN CONFORMANCE NITH THE NORTH CAROLINA RESIDENTIAL AND MECHANICAL CODE. INSTALLATIONS OF MECHANICAL APPLIANCES, EQUIPMENT AND SYSTEMS NOT ADDRESSED BY THIS CODE SHALL COMPLY WITH THE APPLICABLE PROVISIONS OF THE NORTH CAROLINA RESIDENTIAL AND FUEL GAS CODE.
- CONTRACTOR SHALL DESIGN ENTIRE H.V.A.C. SYSTEM AND SUBMIT DRAWINGS FOR OWNER/BUILDER'S APPROVAL PRIOR TO ORDERIN MATERIALS OR EQUIPMENT.
- WHERE AIR CONDITIONING IS AN OPTIONAL FEATURE, HEATING SYSTEMS MUST BE DESIGNED AND DUCT WORK SIZED TO ACCOMMODATE FUTURE AIR CONDITIONING NEEDS.
- WHERE THE PRIMARY HEATING SYSTEM IS A FORCED-AIR FURNACE, AT LEAST ONE THERMOSTAT PER DWELLING UNIT SHALL BE CAPABLE OF CONTROLLING THE HEATING AND COOLING SYSTEM ON A DAILY SCHEDULE TO MAINTAIN DIFFERENT TEMPERATURE SET POINTS AT DIFFERENT TIMES OF THE DAY, THIS THERMOSTAT SHALL INCLUDE THE CAPABILITY TO SET BACK OR TEMPORARILY OPERATE THE SYSTEM TO MAINTAIN ZONE TEMPERATURES DOWN TO 55 DEG. F (13 C) OR UP TO 85 DEG. F (29 C).
- 5. ALL DUCTWORK SHALL CONFORM TO THE REQUIREMENTS OF THE N.C.-R
- COMBUSTION AIR SHALL BE PROVIDED FOR FORCED AIR UNITS IN ACCORDANCE WITH N.C.-R
- CONTRACTOR TO PROVIDE BOOT IN DUCTWORK WHEN OPTIONAL "HONEYWELL" OR "CARRIER" ELECTRONIC AIR CLEANER IS PROVIDED.
- 8. DUCTS IN THE GARAGE AND DUCTS PENETRATING THE WALLS OR CELLINGS SEPARATING THE DWELLING FROM THE GARAGE SHALL BE CONSTRUCTED OF A MINIMUM NO. 26 GAGE SHEET STEEL OR OTHER APPROVED MATERIAL AND SHALL HAVE NO OPENINGS INTO THE
- EXTERIOR-GRADE INSTALLATIONS. EQUIPMENT AND APPLIANCES INSTALLED ABOVE GRADE LEVEL SHALL BE SUPPORTED ON A SOLID BASE OR APPROVED MATERIAL A MINIMUM OF 2 INCHES THICK.
- IO. UNDER-FLOOR INSTALLATION, SUSPENDED EQUIPMENT SHALL BE A MINIMUM OF 6 INCHES ABOVE THE ADJOINING GRADE.
- CRAWL SPACE SUPPORTS. IN A CRAWL SPACE, A MINIMUM OF 2-INCH THICK SOLID BASE, 2-HOH (SI MM) THICK FORMED CONCRETE, OR STACKED MASONRY UNITS HELD IN PLACE BY MORTAR OR OTHER APPROVED METHOD. THE MATER HEATER SHALL BE SUPPORTED NOT LESS THAN 2
- 12. DRAINAGE, BELOW-GRADE INSTALLATIONS SHALL BE PROVIDED WITH A NATURAL DRAIN OR AN AUTOMATIC LIFT OR SUMP PUMP. FOR PIT REQUIREMENTS REFER TO N.C.-M

VENTING

- IN LIEU OF REQUIRED EXTERIOR OPENINGS FOR NATURAL VENTILATION IN LIEU OF REGUIRED EXTENIOR OPENINGS FOR NATURAL VENTILATION IN BATHROOMS CONTAINING A BATHROOMS FOR ROOMS CONTAINING A BATHROOM SYSTEM MAY BE PROVIDED. THE MINIMAY WENTILATION RATES SHALL BE SO CPM FOR INTERMITTENT VENTILATION OR 20 CPM FOR CONTINUOUS VENTILATION. VENTILATION AIR FROM THE SPACE SHALL BE EXHAUSTED DIRECTLY TO THE OUTSIDE PER NO.—THE
- 2. EXHAUST DUCTS SHALL TERMINATE OUTSIDE THE BUILDING AND SHALL BE EQUIPPED WITH BACKDRAFT DAMPERS.
- RANGE HOODS SHALL DISCHARGE TO THE OUTDOORS THROUGH A DICT.
 THE DUCT SERVING THE HOOD SHALL HAVE A SMOOTH INTERIOR SURFACE,
 SHALL BE AIR TIGHT, SHALL BE EQUIPPED WITH A BACK-DRAFT DAMPER
 AND SHALL BE INDEPENDENT OF ALL OTHER EXHAUST SYSTEMS, DUCTS
 SERVING RANGE HOODS SHALL NOT TERMINATE IN AN ATTIC OR CRANL
 SPACE OR AREAS INSIDE THE BUILDING, DUCTS SERVING RANGE HOODS
 SHALL BE CONSTRUCTED OF GALVANIZED STEEL, STAINLESG STEEL OR
- MHERE INSTALLED IN ACCORDANCE WITH THE MANUFACTURER'S INSTALLATION INSTRUCTIONS, AND WHERE MECHANICAL OR NATURAL VENTILATION IS OTHERWISE PROVIDED, LISTED AND LABELED DUCTLESS RANGE HOODS SHALL NOT BE REQUIRED TO DISCHARGE TO THE OUTDOORS PER N.C.-M
- DUCTS FOR DOMESTIC KITCHEN COOKING APPLIANCES EQUIPPED MITH DOWN DRAFT EXHAUST SYSTEMS SHALL BE PERMITTED TO BE CONSTRUCTED OF SCHEDULE 40 PVC PIPE PROVIDED THAT THINSTALLATION COMPLIES WITH ALL OF THE FOLLOWING PER N.C.—M
- THE DUCT SHALL BE INSTALLED UNDER A CONCRETE SLAB POURED ON GRADE.
- THE UNDERFLOOR TRENCH IN WHICH THE DUCT IS INSTALLED SHALL BE COMPLETELY BACKFILLED WITH SAND OR GRAVEL.
- THE PVC DUCT SHALL EXTEND NOT GREATER THAN I INCH ABOVE THE INDOOR CONCRETE FLOOR SURFACE.
- THE PVC DUCT SHALL EXTEND NOT GREATER THAN I INCH ABOVE GRADE OUTSIDE THE BUILDING.
- THE PVC DUCTS SHALL BE SOLVENT CEMENTED.
- EXHAUST HOOD SYSTEMS CAPABLE OF EXHAUSTING IN EXCESS OF 400 CPM SHALL BE PROVIDED WITH MAKEUP AIR AT A RATE APPROXIMATELY EQUAL TO THE EXHAUST AIR RATE THAT IS IN EXCESS OF 400 CUBIC FEET PER MINUTE, SUCH MAKEUP AIR SYSTEMS SHALL BE EQUIPPED WITH A MEANS OF CLOSURE AND SHALL BE AUTOMATICALLY CONTROLLED TO START AND OPERATE SIMULTANEOUSLY WITH THE EXHAUST SYSTEM. DAMPERS SHALL BE ACCESSIBLE FOR INSPECTION, SERVICE, REPAIR AND REPLACEMENT WITHOUT REMOVING PERMANENT CONSTRUCTION
- DOMESTIC WATER HEATERS, UNLESS SPECIFIED OTHERWISE BY THE MANUFACTURER'S INSTALLATION INSTRUCTIONS, SHALL BE VENTED TO THE OUTSIDE AIR BY A TYPE B' VENT AND COMPLY WITH THE REQUIREMENTS OF THE N.C.-M

PLUMBING

- A POTABLE WATER SUPPLY SYSTEM SHALL BE DESIGNED, INSTALLED CONTAMINATION FROM NONPOTABLE LIQUIDS, SOLIDS OR GASES BEING INTRODUCED INTO THE POTABLE MATER SUPPLY THROUGH CROSS-CONNECTIONS OR ANY OTHER PIPING CONNECTIONS TO THE SYSTEM. BACKFLOW PRE- VENTER APPLICATIONS SHALL CONFORM TO
- 2. THE SUPPLY LINES OR FITTINGS FOR EVERY PLUMBING FIXTURE SHALL BE INSTALLED SO AS TO PREVENT BACKFLOW, PLUMBING FIXTURE FITTINGS SHALL PROVIDE BACKFLOW PROTECTION IN ACCORDANCE WITH ASME All2.18.1.

MECHANICAL & PLUMBING (continued)

- WATER SERVICE PIPING SHALL BE PROTECTED IN ACCORDANCE WITH N.C.-P SECTIONS AND EXCEPTIONS)
- FIXTURE FITTINGS, FAUCETS AND DIVERTERS SHALL BE CONNECTED TO THE WATER DISTRIBUTION SYSTEM SO THAT HOT WATER CORRESPONDS TO THE LEFT SIDE OF THE FITTINGS.
- DIVERTERS FOR SINK FAUCETS WITH A SECONDARY OUTLET CONSISTING OF A FLEXIBLE HOSE AND SPRAY ASSEMBLY SHALL CONFORM TO ASTM A12.16.1 IN ADDITION TO THE REQUIREMENTS IN N.C.-P
- THE INSTALL ATION OF A WATER SERVICE OR WATER DISTRIBUTION PIPE THE INSTALLATION OF A MATER SERVICE OR MATER DISTRIBUTION PIPE SHALL BE PROHIBITED IN SOIL AND SEROUND WATER THAT IS CONTAMINATED. SROUND WATER CONDITIONS SHALL BE REQUIRED TO ACCERTAIN THE ACCEPTABILITY OF THE MATER SERVICE OR WATER DISTRIBUTION PIPING MATERIAL FOR THE SPECIFIC INSTALLATION. WHERE DETRIMENTAL CONDITIONS EXIST, APPROVED ALTERNATIVE MATERIALS OR ROJING SHALL BE REQUIRED.
- MATER DISTRIBUTION PIPE SHALL CONFORM TO NSF 61 AND SHALL CONFORM TO ONE OF THE STANDARDS LISTED IN N.C.-PILMBING. ALL MATER DISTRIBUTION PIPE AND TUBING SHALL HAVE A MINIMUM PRESSURE RATING OF IOO PSI AT 180 DEGREES F.
- PIPE PASSING THROUGH CONCRETE OR CINDER WALLS AND FLOORS OR OTHER CORROSIVE MATERIAL SHALL BE PROTECTED AGAINST EXTERNAL CORROSION BY A PROTECTIVE SHEATHING OR WRAPPING OR OTHER MEANS THAT WILL WITHSTAND ANY REACTION FROM THE LIME AND ACID OF CONCRETE, CINDER OR OTHER CORROSIVE MATERIAL SHEATHING OR WRAPPING SHALL ALLOW FOR EXPANSION AND CONTRACTION OF PIPING TO PREVENT ANY RUBBING ACTION. MINIMUM WALL THICKNESS OF MATERIAL SHALL BE 0.025-INCH
- PIPES PASSING UNDER OR THROUGH WALLS SHALL BE PROTECTED FROM
- PIPING SHALL BE INSTALLED SO AS TO PREVENT DETRIMENTAL STRAINS AND STRESSES IN THE PIPE. PROVISIONS SHALL BE MADE TO PROTECT PIPING FROM DAMAGE RESULTING FROM EXPANSION, CONTRACTION AND STRUCTURAL SETTLEMENT. PIPING SHALL BE INSTALLED TO AVOID STRUCTURAL STRESSES OR STRAINS WITHIN BUILDING COMPONENTS.
- MATER PIPES INSTALLED IN A MALL EXPOSED TO THE EXTERIOR SHALL BE LOCATED ON THE HEATED SIDE OF THE MALL INSULATION, IN OTHER CASES, MATER, SOIL, AND PASTE PIPES SHALL NOT DE INSTALLED OUTSIDE OF A BUILDING, IN INCONDITIONED ATTICS, INCONDITIONED UTILLITY ROOMS OR IN ANY OTHER PLACE SUBJECTED TO FREEZING TEMPERATURES UNLESS ADEQUATE PROVISION IS MADE TO PROTECT SUCH PIPES FROM FREEZING BY A MINIMAM OF R-65 INSULATION DETERMINED AT 15 DEG. F IN ACCORDANCE WITH ASTM CITY OF HEAT OR BOTH OR BOTH.

 EXTERIOR WATER SUPPLY SYSTEM PIPING SHALL BE INSTALLED NOT
 LESS THAN 6 INCHES BELOW THE FROST LINE AND NOT LESS
 THAN 12 INCHES BELOW GRADE.
- BUILDING SEWER PIPE SHALL CONFORM TO ONE OF THE STANDARDS
- BUILDING SEMER PIPE FITTINGS SHALL BE APPROVED FOR INSTALLATION WITH THE PIPING MATERIAL INSTALLED AND SHALL CONFORM TO THE RESPECTIVE PIPE STANDARDS OR ONE OF THE STANDARDS LISTED IN
- WHERE WASTE LINE DROPS OCCUR IN A LOCATION WHERE THE SOUND OF A FLUSHED TOILET MAY BE UNDESIRABLE, SUCH AS IN WALLS OR PARTITIONS ADJACENT TO EATING ROOMS, USE CAST IRON PIPING OR SIMILAR APPROVED HARD OR DENSE PIPING TO MITIGATE SOUND.
- CLEANOUTS ON BUILDING SEWERS SHALL BE LOCATED AS SET FORTH IN
- THE MAXIMUM WATER CONSUMPTION FLOW RATES AND QUANTITIES FOR ALL PLUMBING FIXTURES SHALL BE IN ACCORDANCE WITH N.C.-R.
- INDIVIDUAL SHOWER AND TUB/SHOWER COMBINATION VALVES SHALL BE EQUIPPED MITH CONTROL VALVES OF THE PRESSURE-BALANCE, THERMOSTATIC-MIXING OR COMBINATION PRESSURE-BALANCE/THERMOSTATIC-MIXING VALVE TYPES WITH A HIGH LIMIT STOP IN ACCORDANCE WITH ASSET (30/6 ASSET ALIZ.) (30/6/36) BIZSIS, AND SHALL E INSTALLED AND ADJISTED PER MANUFACTURE'S INSTRUCTIONS.
- GAS AND ELECTRIC WATER HEATERS HAVING AN IGNITION SOURCE SHALL ELEVATED SUCH THAT THE SOURCE OF IGNITION IS NOT LESS THAN 10 INC ABOVE THE GARAGE FLOOR. REFER TO N.C.-R FOR EXCEPTION.
- MATER HEATERS, (USING SOLID, LIQUID OR GAS FUEL) WITH THE EXCEPTION OF THOSE HAVING DIRECT VENT SYSTEMS, SHALL NOT BE INSTALLED IN BATHROOMS AND BEDROOMS OR IN A CLOSET WITH ACCESS ONLY THROUGH A BEDROOM OR BATHROOM, HOWEVER, WATER HEATERS OF THE AUTOMATIC STORAGE TYPE MAY BE INSTALLED AS REPLACEMENT IN A BATHROOM, WHEN APPROVED BY THE PLUMBING OFFICIAL, PROVIDED THEY ARE VENTED AND SUPPLIED WITH ADEQUATE COMBUSTION AIR.
- IN SEISMIC DESIGN CATEGORIES DO, DI AND D2 AND TOWNHOUSES IN SEISMIC DESIGN CATEGORY C, WATER HEATERS SHALL BE ANCHORED OR STRAPPED IN THE UPPER ONE-THIND OF THE APPLIANCE TO RESIST A HORIZONTAL FORCE EQUAL TO ONE-THIND OF THE OPERATING PICKIGHT OF THE WATER HEATER, ACTING IN ANY HORIZONTAL DIRECTION, OR IN ACCORDANCE WITH THE APPLIANCE MANUFACTURERS RECOMMENDATIONS.
- 22. APPLIANCES LOCATED IN A GARAGE OR CARPORT SHALL BE PROTECTED FROM IMPACT BY A MOVING VEHICLE.
- 23. WHERE WATER HEATERS OR HOT WATER STORAGE TANKS ARE INSTALLED IN: WHERE MATER HEATERS OR HOT MATER STORAGE TAMES ARE INSTALLED IN.
 REMOTE LOCATIONS SUCH AS SUSPENDED CEILING, ATTICS, ABOVE OCCUPIED
 SPACES, OR UNVENTILATED CRANL SPACES, A LOCATION WHERE WATER
 LEAKAGE FROM THE TANK WILL CAUSE DAMAGE TO PRIMARY STRUCTURAL
 MEMBERS, THE TANK OR WATER HEATER SHALL BE INSTALLED IN A GALVANIZED STEEL PAN HAVING A MINIMUM THICKNESS OF 24 GAGE, OR OTHER PANS APPROVED FOR SUCH USE.
- WHERE CLOTHES WASHING MACHINES ARE LOCATED ON WOOD FRAMED FLOORS WHERE LEAKAGE WOULD CAUSE DAMAGE, A GALVANIZED STEEL PAN HAVING A MINIMUM THICKNESS OF 24 GAGE, OR OTHER PANS APPROVED FOR SUCH USE SHALL BE PROVIDED

MECHANICAL & PLUMBING (continued)

- APPLIANCES AND EQUIPMENT USED FOR HEATING WATER OR STORING HOT WATER SHALL BE PROTECTED BY A SEPARATE PRESSURE-RELIEF VALVE AND A SEPARATE TEMPERATURE-RELIEF VALVE OR A COMBINATION PRESSURE-AND-TEMPERATURE RELIEF VALVE, RELIEF VALVE SHALL HAVE A MINIMUM RATED CAPACITY FOR THE EQUIPMENT SERVED AND SHALL CONFORM TO ANSI 221.22. THE RELIEF VALVE SHALL NOT BE USED AS A MEANS OF CONTROLLING THERMAL EXPANSION.
- THE WATER SUPPLY TO A DISHMASHER SHALL BE PROTECTED AGAINST BACKFLON BY AN AIR GAP COMPLYING WITH ASME AII2.13 OR AII2.12 THAT IS INSTALLED INTEGRALLY WITHIN THE MACHINE OR A BACKFLOW PREVENTER IN ACCORDANCE WITH THE NC-R.
- SINK AND DISHWASHER. THE COMBINED DISCHARGE FROM A DISHWASHER AND A ONE- OR TWO-COMPARTMENT SINK, WITH OR WITHOUT A FOOD-WASTE DISPOSER, SHALL BE SERVED BY A TRAP OF NOT LESS THAN 1/2 INCHES (36 MM) IN OUTSIDE DIAMETER. THE DISHWASHER DISCHARGE PIPE OR TUBING SHALL RISE TO THE WIDERSIDE OF THE COUNTER AND SHALL BE SECURELY FASTENED TO THE WIDERSIDE OF THE COUNTER AND SHALL BE SECURELY CONNECTING TO THE WIDERSIDE OF THE SINK RIM OR COUNTER BEFORE CONNECTING TO THE HEAD OF THE FOOD-WASTE DISPOSER OR TO A WYE FITTING IN THE SINK TAILPIECE.

- FACTORY-BUILT FIREPLACES SHALL BE LISTED AND LABELED AND SHALL BE INSTALLED IN ACCORDANCE WITH THE CONDITIONS OF THE LISTING. FACTORY-BUILT FIREPLACES SHALL BE TESTED IN ACCORDANCE WITH U. 127.
- 2. FIREPLACES ARE TO BE PROVIDED WITH AN EXTERIOR AIR SUPPLY

ELECTRICAL

- ALL MATERIALS AND APPLIANCES, INSTALLATION AND CONSTRUCTION METHODS SHALL COMPLY WITH THE NATIONAL ELECTRICAL CODE OR CURRENT SAE REQUIREMENTS.
- ALL ELECTRICAL SYSTEMS, CIRCUITS, FIXTURES AND EQUIPMENT SHALL BE GROUNDED IN A MANNER COMPLYING WITH ARTICLE 250 OF THE NATIONAL ELECTRICAL CODE.
- ALL WIRING SHALL BE SO INSTALLED THAT, WHEN COMPLETED, THE SYSTEM WILL BE FREE FROM SHORT CIRCUITS AND FROM GROUNDS OTHER THAN AS REQUIRED OR PERMITTED IN N.E.C. ARTICLE 250.
- ELECTRIC EQUIPMENT SHALL BE INSTALLED IN A NEAT AND WORK-
- ALL 125-VOLT, SINGLE-PHASE, 15- AND 20-AMPERE RECEPTACLES THE GROUND-FAULT CIRCUIT-INTERRUPTER PROTECTION FOR PERSONNEL.
 THE GROUND-FAULT CIRCUIT-INTERRUPTER PROTECTION FOR PERSONNEL.
 THE GROUND-FAULT CIRCUIT-INTERRUPTER SHALL BE INSTALLED IN A
 READILY ACCESSIBLE LOCATION.
 - A. BATHROOMS.
 - B. GARAGES AND ALSO ACCESSORY BUILDINGS THAT HAVE A FLOOR LOCATED AT OR BELOW GRADE LEVEL NOT INTENDED AS HABITABLE ROOMS AND LIMITED TO STORAGE AREAS, WORK AREAS, AND AREAS OF SIMILAR USE.

 - CRAML SPACES. WHERE THE CRAML SPACE IS AT OR BELOW GRADE LEVEL.
 - UNFINISHED PORTIONS OR AREAS OF THE BASEMENT NOT INTENDED AS HABITABLE ROOMS.
 - KITCHENS. WHERE THE RECEPTACLES ARE INSTALLED TO SERVE
 - SINKS, WHERE RECEPTACLES ARE INSTALLED MITHIN 6 FT FROM THE TOP INSIDE EDGE OF THE BOWL OF THE SINK.
- BATHTUBS OR SHOWER STALLS WHERE RECEPTACLES ARE INSTALLED MITHIN 6° OF THE OUTSIDE EDGE OF THE BATHTUB OR SHOWER STALL.
- DISHWASHER GFCI PROTECTION IS NOT REQUIRED FOR OUTLETS THAT SUPPLY DISHWASHERS INSTALLED IN DWELLING UNIT
- CRAML SPACE LIGHTING OUTLETS, GFCI PROTECTION SHALL BE PROVIDED FOR LIGHTING OUTLETS NOT EXCEEDING 120 VOLTS INSTALLED IN CRAML SPACES.
- APPLIANCE RECEPTACLE OUTLETS INSTALLED IN A DWELLING UNIT FOR SPECIFIC APPLIANCES, SUCH AS LANDRY EQUIPMENT, SHALL BE INSTALLED WITHIN 6 FEET OF THE INTENDED LOCATION OF THE APPLIANCE.
- IN EVERY KITCHEN, FAMILY ROOM, DINING ROOM, LIVING ROOM, PARLOR, LIBRARY, DEN, SUNROOM, BEDROOM, RECREATION ROOM, OR SIMILAR ROOM OR AREA OF DWELLING UNITS, RECEPTACLE OUTLETS SHALL BE INSTALLED SO THAT NO POINT ALONG THE FLOOR LINE IN ANY WALL SPACE IS MORE THAN 6 FEET, MEASURED HORIZONTALLY, FROM AN OUTLET IN THAT SPACE, INCLUDING ANY WALL SPACE 2 FEET OR MORE IN WIDTH (INCLUDING SPACE WALL SPACE 2 FEET OR MORE IN WIDTH (INCLUDING SPACE MEASURED AROUND CORNERS) AND UNBROKEN ALONS THE FLOOR LINE BY DOORWAYS AND SIMILAR OPENINGS, FIREPLACES, AND FIXED CABINETS, AND THE WALL SPACE OCCUPIED BY FIXED PAINELS IN EXTERIOR WALLS, BUT EXCLUDING SLIDING PANELS IN EXTERIOR WALLS, THE WALL SPACE AFFORDED BY FIXED ROOM DIVIDERS, SUCH AS FREESTANDING BARSTYPE COUNTERS OR RAILINGS, SHALL BE INCLUDED IN THE 6 FOOT MEASUREMENT.
- IN THE KITCHEN, PANTRY, BREAKFAST ROOM, DINING ROOM, OR SIMILAR AREA OF A DWELLING UNIT, THE TWO OR MORE 20-AMPERE SMALL-APPLIANCE BRANCH CIRCUITS REQUIRED SHALL SERVE ALL WALL AND FLOOR RECEPTACLE OUTLETS, ALL COUNTERTOP OUTLETS, AND RECEPTACLE OUTLETS FOR REFRIGERATION EQUIPMENT. THE TWO OF MORE SMALL-APPLIANCE BRANCH CIRCUITS SHALL HAVE NO OTHER OUTLETS
- IN KITCHENS, PANTRIES, BREAKFAST ROOMS, DINING ROOMS AND SIMILAR AREAS OF DWELLING UNITS, RECEPTACLE OUTLETS FOR COUNTER SPACES SHALL BE INSTALLED IN ACCORDANCE WITH THE
- (I) A RECEPTACLE OUTLET SHALL BE INSTALLED AT EACH WALL COUNTER SPACE 12 INCHES OR WIDER. RECEPTACLE OUTLETS SHALL BE INSTALLED SO THAT NO POINT ALONS THE WALL LINE IS MORE THAN 24 INCHES MEASURED HORIZONTALLY FROM A RECEPTACLE OUTLET IN THAT SPACE.

ELECTRICAL (continued)

- (2) AT LEAST ONE RECEPTACLE OUTLET SHALL BE INSTALLED AT EACH ISLAND COUNTER SPACE NITH A LONG DIMENSION OF 24 INCHES OR GREATER AND A SHORT DIMENSION OF 12 INCHES OR GREATER.
- AT LEAST ONE RECEPTACLE OUTLET SHALL BE INSTALLED AT EACH PENINSULAR COUNTER SPACE WITH A LONG DIMENSION OF 24 INCHES OR GREATER. AT DAY SHORT DIMENSION OF 12 INCHES OR GREATER. A PENINSULAR COUNTERTOP IS MEASURED FROM CONNECTING PERPENDICULAR WALL.
- COUNTERTOP SPACES SEPARATED BY RANGE TOPS, REFRIGERATORS, OR SINKS SHALL BE CONSIDERED AS SEPARATE COUNTERTOP SPACES IN APPLYING THE REQUIREMENTS OF (I), (2), AND (3),
 ABOVE. IF A RANGE, COUNTER-MOUNTED COOKING UNIT, OR SINK
 IS INSTALLED IN AN ISLAND OR PENINSULAR COUNTERTOP AND THE
 DEPTH OF THE COUNTER BEHIND THE ITEM IS LESS THEN IS NOTHE.
 IT WILL BE CONSIDERED TO DIVIDE THE COUNTERTOP SPACE INTO
 THE GENERAL COUNTERTOP SPACE FACE. COUNTERTOP SPACE INTO TWO SEPARATE COUNTERTOP SPACES. EACH COUNTERTOP SPACE SHALL COMPLY WITH APPLICABLE REQUIREMENTS.
- (5) RECEPTACLE OUTLETS SHALL BE LOCATED NOT MORE THAN 20 INCHES ABOVE THE COUNTERTOP, RECEPTACLE OUTLETS RENDERED NOT READILLY ACCESSIBLE BY APPLIANCE FASTENED IN PLACE, APPLIANCE GARAGES, SINKS, OR RANGETOPS AS COVERED IN 4) ABOVE, OR APPLIANCES OCCUPYING DEDICATED SPACE SHALL NOT BE CONSIDERED AS THESE REQUIRED OUTLETS.
- AT LEAST ONE WALL RECEPTACLE OUTLET SHALL BE INSTALLED IN BATHROOMS WITHIN 3 FEET OF THE OUTSIDE EDGE OF EACH BASIN. THE RECEPTACLE OUTLET SHALL BE LOCATED IN WALL OR PARTITION THAT IS ADJACENT TO THE BASIN OR BASIN COUNTERTOP, OR INSTALLED ON THE SIDE OR FACE OF THE BASIN CABINET NOT MORE THAN 12" BELOW THE COUNTERTOR
- 12. IN DWELLING UNITS, AT LEAST ONE RECEPTACLE OUTLET SHALL BE INSTALLED IN AREAS DESIGNATED FOR THE INSTALLATION OF LAUNDRY EQUIPMENT.
- IN EACH ATTACHED GARAGE AND IN EACH DETACHED GARAGE WITH ELECTRIC POWER, THE BRANCH CIRCUIT SUPPLYING THI RECEPTACLE(S) SHALL NOT SUPPLY OUTLETS OUTSIDE OF THE GARAGE. AT LEAST ONE RECEPTACLE OUTLET SHALL BE INSTALLED IN EACH VEHICLE BAY.
- 14. CABLE- OR RACEWAY-TYPE WIRING METHODS INSTALLED IN A GROOVE. TO BE COVERED BY MALLBOARD, SIDING, PANELING, CARPETING, OR SIMILAR FINISH, SHALL BE PROTECTED Y 1/16 INCH THICK STEEL PLATE, SLEEVE, OR EQUIVALENT OR BY NOT LESS THAN 1-1/4 INCH FREE SPACE FOR THE FULL LENGTH OF THE GROOVE IN WHICH THE CABLE OR RACEWAY
- 15. RECEPTACLES IN DAMP OR WET LOCATIONS.
 - A RECEPTACLE INSTALLED OUTDOORS IN A LOCATION PROTECTED FROM WEATHER OR IN OTHER DAMP LOCATIONS SHALL HAVE AN ENCLOSURE FOR THE RECEPTACLE THAT IS WEATHER-ROOF WHEN THE RECEPTACLE IS COVERED (ATTACHENT PLUS CAP NOT INSERTED AND RECEPTACLE COVERS CLOSED.)
 - ALL 15- AND 20- AMPERE, 125- AND 250-VOLT RECEPTACLES
 INSTALLED IN A WET LOCATION SHALL HAVE AN ENCLOSURE THAT IS
 WEATHER PROOF WHETHER OR NOT THE ATTACHMENT PLIGS CAP IS
 INSERTED. AN OUTLET BOX HOOD INSTALLED FOR THIS PURPOSE
 SHALL BE LISTED AND SHALL BE IDENTIFIED AS "EXTRA DUTY". ALL
 IS- AND 20- AMPERE, 125- AND 250-VOLT NONLOCKING
 RECEPTACLES SHALL BE LISTED WEATHER RESISTANT TYPE.
- LIGHT FIXTURES WITHIN CLOTHES CLOSETS SHALL BE INSTALLED IN ACCORDANCE WITH N.E.C.
- ALL 120-VOLT, SINGLE PHASE, I5- AND 20-AMPERE BRANCH CIRCUITS SUPPLYING OUTLETS OR DEVICES INSTALLED IN DWELLING UNIT FAMILY ROOMS, DINING ROOMS, LIVING ROOMS, PARLORS, LIBRARIES, DENS, BEDROOMS, SUNROOMS, RECREATION ROOMS, CLOSETS, HALLWAYS, OR SIMILAR ROOMS OR AREAS SHALL BE PROTECTED BY AN ARC-FAULT CIRCUIT INTERRUPTERS(), COMBINATION-TYPE, INSTALLED TO PROVIDE PROTECTION OF THE BRANCH CIRCUIT. THE ARC-FAULT CIRCUIT INTERPRIPTERS SHALL IS INSTALLED TO INTERPRIPTER SHALL IS INSTALLED TO IN A SPEATING SHALL SHOULD SHALL S NTERRUPTER SHALL BE INSTALLED IN A READILY ACCESSIBLE
- BUILDINGS SHALL BE PROVIDED WITH APPROVED ADDRESS IDENTIFICATION. THE ADDRESS IDENTIFICATION SHALL BE LEGIBLE AND PLACED IN A POSITION THAT IS VISIBLE FROM THE STREET OR ROAD FRONTING THE PROPERTY.
- TAMPER-RESISTANT RECEPTACLES IN DWELLING UNITS IN ALL AREAS.
 ALL NON-LOCKING TYPE I25-VOLT I5-AND 20-AMPERE RECEPTACLES.
 SHALL BE LISTED TAMPER-RESISTANT RECEPTACLES. EXCEPTIONS LISTED BELON.
 - RECEPTACLES LOCATED MORE THAN 5½ ABOVE THE FLOOR. 2. RECEPTACLES THAT ARE PART OF A LUMINAIRE OR APPLIANCE
 - 3. A SINGLE RECEPTACLE OR A DUPLEX RECEPTACLE FOR TWO APPLIANCES LOCATED WITHIN DEDICATED SPACE FOR EACH APPLIANCE THAT, IN NORMAL USE, IS NOT EASILY MOVED FROM ONE PLACE TO ANOTHER, AND THAT IS CORD-AND-PLUS CONNECTED.
 - 4. NON-GROUNDING RECEPTACLES USED FOR REPLACEMENTS
- DIMMER-CONTROLLED RECEPTACLES. A RECEPTACLE SUPPLYING LIGHTING LOADS SHALL NOT BE CONNECTED TO A DIMMER UNLESS THE PLUS-RECEPTACLE COMBINATION IS A NONSTANDARD CONFIGURATION TYPE THAT IS SPECIFICALLY LISTED AND IDENTIFIED FOR EACH SUCH

SMOKE DETECTORS

- SMOKE DETECTORS SHALL BE INSTALLED IN ACCORDANCE WITH THE APPROVED MANUFACTURER'S INSTRUCTIONS AND NC-R R314
- ALL SMOKE ALARMS SHALL BE LISTED IN ACCORDANCE WITH UL 217 AND INSTALLED IN ACCORDANCE WITH THE PROVISIONS OF THIS CODE AND THE HOUSEHOLD FIRE WARNING EQUIPMENT PROVISIONS OF NFPA 72

HOUSEHOLD FIRE ALARM SYSTEMS INSTALLED IN ACCORDANCE WITH NEPA AND AUDIBLE NOTIFICATION DEVICE INSTALLED AS REQUIRED BY THE NC-R R314.3 FOR SMOKE ALARMS, SHALL BE PERMITTED. THE HOUSEHOLD FIRE ALARM SYSTEM SHALL PROVIDE THE SAME LEVEL OF SMOKE DETECTION AND ALARM AS REQUIRED BY THE NG-R FOR SMOKE ALARMS IN THE EVENT THE FIRE ALARM PANEL IS REMOVED OR THE SYSTEM IS NOT CONNECTED TO A CENTRAL STATION

REQUIRED SMOKE DETECTORS SHALL BE LOCATED IN ACCORDANCE

ELECTRICAL (continued)

CARBON MONOXIDE ALARMS

- CARBON MONOXIDE ALARMS IN DMELLING UNITS SHALL BE INSTALLED OUTSIDE OF EACH SEPARATE SLEEPING AREA IN THE INMEDIATE VICINITY OF THE BEDROOMS, WHERE A FUEL-BURNING APPLIANCE IS LOCATED WITHIN A BEDROOM OR ITS ATTACHED BATHROOM, A CARBON MONOXIDE ALARM SHALL BE INSTALLED WITHIN THE BEDROOM
- SINGLE STATION CARBON MONOXIDE ALARMS SHALL BE LISTED AS COMPLYING MITH UL 2034 AND SHALL BE INSTALLED IN ACCORDANCE WITH THE NC-R R3I5 AND THE MANUFACTURER'S INSTALLATION INSTRUCTIONS.
- COMBINATION CARBON MONOXIDE AND SMOKE ALARMS SHALL BE PERMITTED TO BE USED IN LIEU OF INDIVIDUAL CARBON MONOXIDE OR SMOKE ALARMS.

DRYER VENT

THE DRYER DUCT IS REQUIRED TO IDENTIFY THE LENGTH IN ACCORDANCE WITH SECTION MI502.4.5



.

.

HOME

NORTH CAROLINA 40' SERIES KB HOME

NORTH CAROLINA DIVISION

4518 S. MIAMI BLVD. SUITE 180 DURHAM, NC 27703 ■ TEL: (919) 768-7988 ■ FAX: (919) 472-0582

2018 NORTH CAROLINA STATE BUILDING CODES

.

.

ISSUE DATE: 06/02/15 PROJECT No.: 1350999:56 DIVISION MGR.: MCP

REVISIONS: 05/07/19 DIVISION REVISIONS NCIS024NCP - 08/24/18 - CTD

2018 CODE UPDATE NCI9015NCP/ 03/15/19 / CTD

DIVISION REVISION
NCI9017NCP- 04/01/19 CTD FRAMEWALK REVISIONS NCI9033NCP- 05/07/19 - CTD

DIVISION REVISIONS
NC20012NCP- 01/29/20 · KBA

FOR INTERNAL USE ONL'

240.2596-R GN₃




INTERIOR KEY

	SQUARE FOOT	AGE		
	PLAN 240.2596	5-R		
FIRST FLOOR ARE		1158	SQ. FT.	
SECOND FLOOR A	REA	1415	SQ. FT.	
TOTAL ARE	A	2573	SQ. FT	
GARAGE AREA		416	SQ. FT.	
PORCH AREA(S)				
	ELEVATION 'A'	83	SQ. FT.	
	ELEVATION 'B'	84	SQ. FT.	
	ELEVATION 'C'	62	5Q. FT.	
PATIO AREA(S)	ELEVATION 'D'	136	SQ. FT.	
FATIO AREA(5)	IO'XIO' COVERED	100	SQ. FT.	
	10'x26'-7" COVERED		5Q. FT.	
DECK AREA(S)	10 X20 - 1 OO VEINED	200	30.11.	
	OPEN 12'x12'	144	SQ. FT.	
	OPEN 12'x24'	288	SQ. FT.	
	SCREENED-IN 12'x12'	144	SQ. FT.	
	SCREENED-IN 12'x24	288	SQ. FT.	
SUNROOM AREA				
	12'x12'	144	SQ. FT.	
•	PLATE NOTE	3S	2018 N.C.	
	8'-1" PLATE NO	TES		
 MINDOW HEA 		6'-8" U.N.C 7'-0" U.N.C	2.	
ENTRY DOOR	NINDOW HDR. HEIGHT:	6'-8" U.N.C).).	
 SLIDING GLA 	SS DOOR HEIGHT:	6'-8" (TEM	(P.)	
 INTERIOR SO INTERIOR DO 	PET HEIGHT:	7'-4" U.N.O 6'-8" U.N.C).	
- INTERIOR DO	9'-1" PLATE NO		·	
• MINDOM HEA	DER HEIGHT Ist OR 2nd		,	
 4010 WINDOW 	N OVER TUB HDR. HGT.:	8'-4" U.N.C).	
ENTRY DOOF	R HEIGHT:	6'-8" U.N.C). 	
SLIDING GLASS DOOR HEIGHT: INTERIOR SOFFIT HEIGHT: 6'-8" (TEMP.) 8'-0" U.N.O.				
TRAY CEILING: 7½" DROP UN O.				
INTERIOR DO	OR HEIGHT:	6'-8" U.N.C).	
	STAIR DATA NO	DTES	2018 N.C	
FIRST FLOOR WIT	TH 8-1" PLATE HEIGHT:	TAG DECKING		
14 TREADS A 15 RISERS A	OOR JOISTS WITH 3/4" AT 10" EACH T 7-7/16" EACH	70 220 4 110	•	
FIRST FLOOR WITH 9:1" PLATE HEIGHT: 14" DEEP T.JI. FLOOR JOISTS WITH 3/4" T&G DECKING. 15 TREADS AT 10" EACH 16 RISERS AT 7-3/4" EACH				
GENERAL PLAN NOTES				
ALL CEILING HEIGHTS, U.N.O.	SHTS PER SECTION AND	ELEVATION P	LATE	
ALL INTERIOR DO U.N.O. (REFER TO	OORS TO BE HOLLOW CO PLAN FOR SIZE).	ORE 3/8" THI	CK,	
ALL GARAGE SE EXTERIOR GRAD	RVICE DOORS TO BE H E (REFER TO PLAN FOR	OLLOW CORE SIZE).		
ALL HOUSE TO G (REFER TO PLAN	ARAGE DOORS TO BE 2 FOR SIZE).	0-MINUTE FIR	E-RATED	
ALL ENTRY DOOR	DG AND EVTERIOR EREN	KH DOODS TO	O DE	

ALL ENTRY DOORS AND EXTERIOR FRENCH DOORS TO BE SOLID CORE | 3/4" THICK (REFER TO PLAN FOR SIZE).

ALL FLOOR MATERIAL CHANGES TO OCCUR AT CENTER OF DOOR JAMBS, U.N.O.

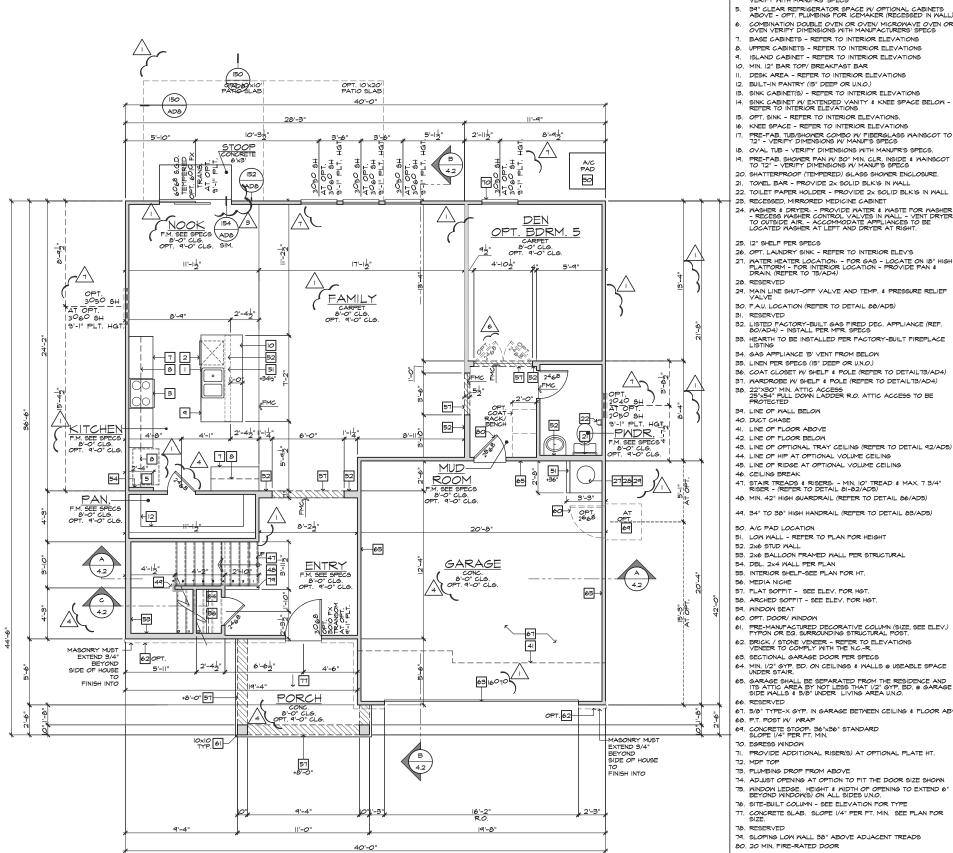

NOTE: NOT ALL KEY NOTES APPLY. SINK - GARBAGE DISPOSAL OPTIONAL - VERIFY DIMENSIONS WITH MANUFACTURERS' SPECS DISHMASHER - PROVIDE AIR GAP - VERIFY SPACING & DIMENSIONS PER MANUFACTURERS' SPECS SLIDE-IN RANGE/OVEN COMBINATION W/ BUILT-IN NON-VENTED HOOD W/LIGHT & FAN. - VERIFY WITH MANUFACTURERS' SPECS

FLOOR PLAN NOTES

. 30" COOKTOP W BUILT-IN VENTED HOOD W LIGHT & FAN VERIFY WITH MANUFRS' SPECS

HOME

NORTH CAROLINA 40' SERIES

KB HOME NORTH CAROLINA DIVISION

4518 S. MIAMI BLVD. SUITE 180 DURHAM, NC 27703 TEL: (919) 768-7988 FAX: (919) 472-0582

2018 NORTH **CAROLINA STATE BUILDING**

CODES

ISSUE DATE: 06/02/15 PROJECT No.: 1350999:56 DIVISION MGR.: MCP

DIVISION REVISIONS
NCI8024NCP · 08/24/18 · CTD

05/07/19

2018 CODE UPDATE NCI9015NCP/ 03/15/19 / CTD

REVISIONS:

DIVISION REVISION
NCI9017NCP- 04/01/19 CTD

DIVISION REVISIONS
NC20017NCP- 03/04/20 - KBA

FRAMEWALK REVISIONS
NCI9033NCP- 05/07/19 - CTD

63. SECTIONAL GARAGE DOOR PER SPECS 64. MIN. I/2" GYP. BD. ON CEILINGS & WALLS @ USEABLE SPACE UNDER STAIR.

65. GARAGE SHALL BE SEPARATED FROM THE RESIDENCE AND ITS ATTIC AREA BY NOT LESS THAT I/2" GYP, BD. @ GARAG SIDE WALLS & \$/6" WINDER LIVING AREA UN.O.

67. 5/8" TYPE-X GYP. IN GARAGE BETWEEN CEILING & FLOOR AS

69. CONCRETE STOOP: 36"x36" STANDARD SLOPE I/4" PER FT. MIN.

70. EGRESS MINDOW 71. PROVIDE ADDITIONAL RISER(S) AT OPTIONAL PLATE HT.

73. PLUMBING DROP FROM ABOVE


74. ADJUST OPENING AT OPTION TO FIT THE DOOR SIZE SHOWN 75. WINDOW LEDGE. HEIGHT & WIDTH OF OPENING TO EXTEND 6" BEYOND WINDOW(5) ON ALL SIDES U.N.O.

76. SITE-BUILT COLUMN - SEE ELEVATION FOR TYPE

77. CONCRETE SLAB. SLOPE I/4" PER FT. MIN. SEE PLAN FOR SIZE.

78. RESERVED
79. SLOPING LOW WALL 38" ABOVE ADJACENT TREADS 80. 20 MIN. FIRE-RATED DOOR

240.2596-R 1.1

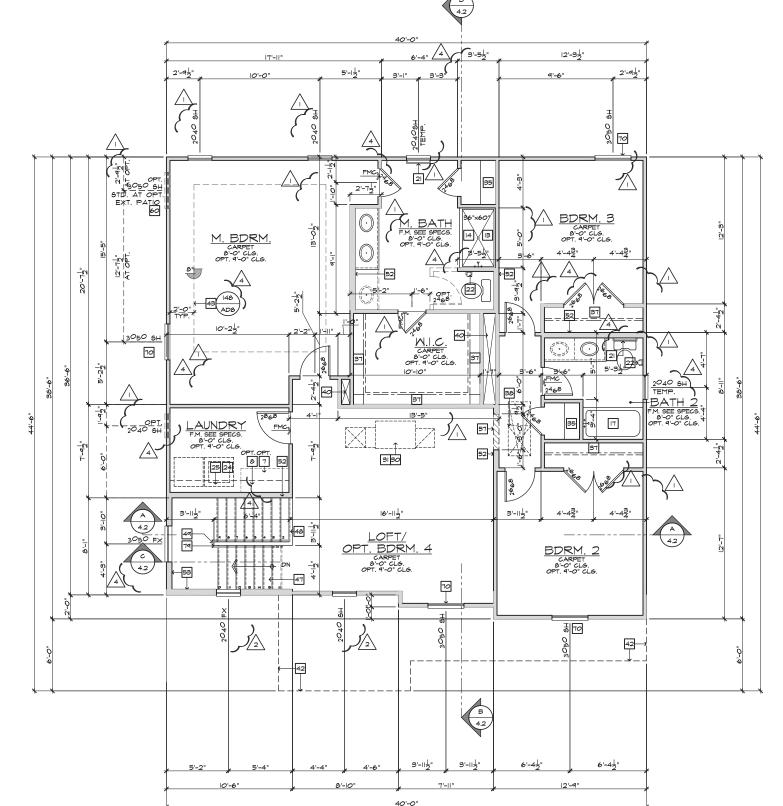



INTERIOR KEY

L	PLATE NOTE	3S 2018 N.CR			
	8'-I" PLATE NOTES				
•	MINDOM HEADER HEIGHT: 2nd FLOOR MINDOM HDR. HEIGHT: ENTRY DOOR HEIGHT: SLIDING GLASS DOOR HEIGHT: INTERIOR SOFFIT HEIGHT: INTERIOR DOOR HEIGHT:	6'-8" U.N.O. 7'-0" U.N.O. 6'-8" U.N.O. 6'-8" (TEMP.) 7'-4" U.N.O. 6'-8" U.N.O.			
	9'-I" PLATE NOTES				
•	MINDOM HEADER HEIGHT IST OR 2nd 4010 MINDOM OVER TUB HDR, HGT.; ENTRY DOOR HEIGHT; SLIPING GLASS DOOR HEIGHT; INTERIOR SOFFIT HEIGHT; TRAY CEILING; INTERIOR DOOR HEIGHT;	7'-8" U.N.O. 8'-4" U.N.O. 6'-8" U.N.O. 6'-8" (TEMP.) 8'-0" U.N.O. 7½" DROP U.N.O. 6'-8" U.N.O.			
	CELLE DAMA MOREG				

STAIR DATA NOTES

FIRST FLOOR WITH 8-1" PLATE HEIGHT:
14" DEEP T.J.I. FLOOR JOISTS WITH 3/4" T&G DECKING.

FIRST FLOOR WITH 9'-1" PLATE HEIGHT:
14" DEEP T.J.I. FLOOR JOISTS WITH 9'-4" T&G DECKING. 15 TREADS AT 10" EACH 16 RISERS AT 7-3/4" EACH

GENERAL PLAN NOTES

ALL INTERIOR DOORS TO BE HOLLOW CORE I 3/8" THICK, U.N.O. (REFER TO PLAN FOR SIZE).

ALL GARAGE SERVICE DOORS TO BE HOLLOW CORE EXTERIOR GRADE (REFER TO PLAN FOR SIZE). ALL HOUSE TO GARAGE DOORS TO BE 20-MINUTE FIRE-RATED (REFER TO PLAN FOR SIZE).

ALL ENTRY DOORS AND EXTERIOR FRENCH DOORS TO BE SOLID CORE I 3/4" THICK (REFER TO PLAN FOR SIZE). ALL FLOOR MATERIAL CHANGES TO OCCUR AT CENTER OF DOOR JAMBS, U.N.O.

SECOND FLOOR PLAN 'A'

9CALE I/4"=I'-0" (22"X34") - I/8"=I'-0" (II"XI7")

FLOOR PLAN NOTES

NOTE: NOT ALL KEY NOTES APPLY.

SINK - GARBAGE DISPOSAL OPTIONAL - VERIFY DIMENSIONS WITH MANUFACTURERS' SPECS

DISHMASHER - PROVIDE AIR GAP - VERIFY SPACING & DIMENSIONS PER MANUFACTURERS' SPECS

SLIDE-IN RANGE/OVEN COMBINATION W BUILT-IN NON-VENTED HOOD W/LIGHT & FAN. - VERIFY WITH MANUFACTURERS' SPECS

. 30" COOKTOP W BUILT-IN VENTED HOOD W LIGHT & FAN VERIFY WITH MANUFRS' SPECS

5. 94" CLEAR REFRIGERATOR SPACE W OPTIONAL CABINETS ABOVE - OPT. PLUMBING FOR ICEMAKER (RECESSED IN WALL) COMBINATION DOUBLE OVEN OR OVEN MICROMAVE OVEN OR OVEN VERIFY DIMENSIONS MITH MANUFACTURERS' SPECS

BASE CABINETS - REFER TO INTERIOR ELEVATIONS 8. UPPER CABINETS - REFER TO INTERIOR ELEVATIONS I. ISLAND CABINET - REFER TO INTERIOR ELEVATIONS

IO. MIN. 12" BAR TOP/ BREAKFAST BAR

II. DESK AREA - REFER TO INTERIOR ELEVATIONS
12. BUILT-IN PANTRY (15" DEEP OR U.N.O.)

13. SINK CABINET(S) - REFER TO INTERIOR ELEVATIONS 14. SINK CABINET W EXTENDED VANITY & KNEE SPACE BELOW - REFER TO INTERIOR ELEVATIONS

15. OPT. SINK - REFER TO INTERIOR ELEVATIONS.

16. KNEE SPACE - REFER TO INTERIOR ELEVATIONS PRE-FAB, TUB/SHOWER COMBO W/ FIBERGLASS WAINSCOT '72" - VERIFY DIMENSIONS W/ MANUF'S SPECS

18. OVAL TUB - VERIFY DIMENSIONS WITH MANUFR'S SPECS. 19. PRE-FAB, SHOWER PAN W 30" MIN, CLR. INSIDE & WAINSCOT TO 72" - VERIFY DIMENSIONS W/ MANUF'S SPECS

20. SHATTERPROOF (TEMPERED) GLASS SHOWER ENCLOSURE. 21. TOWEL BAR - PROVIDE 2x SOLID BLK'G IN WALL

22. TOILET PAPER HOLDER - PROVIDE 2x SOLID BLK'G IN WALL

23. RECESSED, MIRRORED MEDICINE CABINET MAGHER & DRYER: - PROVIDE WATER & MAGTE FOR WASHER
 RECESS WASHER CONTROL VALVES IN WALL - VENT DRYER
 TO OUTSIDE AIR: - ACCOMMODATE APPLIANCES TO BE
 LOCATED WASHER AT LEFT AND DRYER AT RIGHT.

25. I2" SHELF PER SPECS

26. OPT. LAUNDRY SINK - REFER TO INTERIOR ELEV'S 27. WATER HEATER LOCATION: - FOR GAS - LOCATE ON 18" HIGH-PLATFORM - FOR INTERIOR LOCATION - PROVIDE PAN & DRAIN. (REFER TO 15/AD4)

28. RESERVED 29. MAIN LINE SHUT-OFF VALVE AND TEMP. & PRESSURE RELIEF VALVE

30. F.A.U. LOCATION (REFER TO DETAIL 88/AD5)

32. LISTED FACTORY-BUILT GAS FIRED DEC. APPLIANCE (REF. 80/AD4) - INSTALL PER MFR. SPECS 33. HEARTH TO BE INSTALLED PER FACTORY-BUILT FIREPLACE LISTING

34. GAS APPLIANCE 'B' VENT FROM BELOW

35. LINEN PER SPECS (15" DEEP OR U.N.O.)

36. COAT CLOSET W SHELF & POLE (REFER TO DETAILTS/AD4) 37. WARDROBE W/ SHELF & POLE (REFER TO DETAILT3/AD4)

36, 22"X30" MIN. ATTIC ACCESS 25"X54" PULL DOWN LADDER R.O. ATTIC ACCESS TO BE PROTECTED

39. LINE OF WALL BELOW

40. DUCT CHASE

41. LINE OF FLOOR ABOVE

42. LINE OF FLOOR BELOW 43. LINE OF OPTIONAL TRAY CEILING (REFER TO DETAIL 92/AD5)

44. LINE OF HIP AT OPTIONAL VOLUME CEILING

45. LINE OF RIDGE AT OPTIONAL VOLUME CEILING

46. CEILING BREAK

47. STAIR TREADS & RISERS: - MIN. IO" TREAD & MAX. 7 3/4" RISER - (REFER TO DETAIL 81-82/AD5) 48. MIN. 42" HIGH GUARDRAIL (REFER TO DETAIL 86/AD5)

49. 34" TO 38" HIGH HANDRAIL (REFER TO DETAIL 83/AD5)

50. A/C PAD LOCATION

51. LOW WALL - REFER TO PLAN FOR HEIGHT

52. 2x6 STUD WALL 53. 2x6 BALLOON FRAMED WALL PER STRUCTURAL

54. DBL. 2x4 WALL PER PLAN 55. INTERIOR SHELF-SEE PLAN FOR HT.

56. MEDIA NICHE 57. FLAT SOFFIT - SEE ELEV. FOR HGT.

58. ARCHED SOFFIT - SEE ELEV. FOR HGT.

59. WINDOW SEAT 60. OPT. DOOR/ WINDOW

61. PRE-MANUFACTURED DECORATIVE COLUMN (SIZE, SEE ELEV.) FYPON OR EQ. SURROUNDING STRUCTURAL POST.

62. BRICK / STONE VENEER - REFER TO ELEVATIONS VENEER TO COMPLY WITH THE N.C.-R.

63. SECTIONAL GARAGE DOOR PER SPECS

64. MIN. I/2" GYP. BD. ON CEILINGS & WALLS @ USEABLE SPACE UNDER STAIR. 65. GARAGE SHALL BE SEPARATED FROM THE RESIDENCE AND ITS ATTIC AREA BY NOT LESS THAT 1/2" GYP. BD. @ GARAGE SIDE WALLS & 5/8" UNDER LIVING AREA U.N.O.

67. 5/8" TYPE-X GYP. IN GARAGE BETWEEN CEILING & FLOOR ABY

69. CONCRETE STOOP: 36"x36" STANDARD SLOPE I/4" PER FT. MIN.

70. EGRESS MINDOW

71. PROVIDE ADDITIONAL RISER(S) AT OPTIONAL PLATE HT.

73. PLUMBING DROP FROM ABOVE

74. ADJUST OPENING AT OPTION TO FIT THE DOOR SIZE SHOWN 75. WINDOW LEDGE. HEIGHT & WIDTH OF OPENING TO EXTEND 6" BEYOND WINDOW(5) ON ALL SIDES U.N.O.

76. SITE-BUILT COLUMN - SEE ELEVATION FOR TYPE

77. CONCRETE SLAB. SLOPE I/4" PER FT. MIN. SEE PLAN FOR SIZE.

76. RESERVED
79. SLOPING LOW WALL 36" ABOVE ADJACENT TREADS 80. 20 MIN. FIRE-RATED DOOR

240.2596-R 1.2

HOME

NORTH CAROLINA

40' SERIES

KB HOME

NORTH CAROLINA DIVISION

4518 S. MIAMI BLVD.

SUITE 180 DURHAM, NC 27703

FAX: (919) 472-0582

. . . .

2018 NORTH

CAROLINA STATE

BUILDING

CODES

PROJECT No.: 1350999:56

DIVISION REVISIONS
NCI8024NCP · 08/24/18 · CTD

2018 CODE UPDATE NCI9015NCP/ 03/15/19 / CTD

DIVISION REVISION
NCI9017NCP- 04/01/19 CTD

FRAMEWALK REVISIONS
NCI9033NCP- 05/07/19 - CTD

DIVISION REVISIONS NC20012NCP- 01/29/20 · KBA

FOR INTERNAL USE ONLY

06/02/15

MCP

05/07/19

ISSUE DATE:

REVISIONS:

DIVISION MGR.:

TEL: (919) 768-7988 •

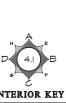


PLATE NOTES				
	8'-I" PLATE NO	DTES		
•	MINDOW HEADER HEIGHT: 2nd FLOOR WINDOW HDR. HEIGHT: ENTRY DOOR HEIGHT: SLIDING GLASS DOOR HEIGHT: INTERIOR SOFFIT HEIGHT: INTERIOR DOOR HEIGHT:	6'-8" U.N.O. T'-O" U.N.O. 6'-8" U.N.O. 6'-8" (TEMP.) T'-4" U.N.O. 6'-8" U.N.O.		
9'-I" PLATE NOTES				
:	MINDOM HEADER HEIGHT IS OR 2nd 4010 MINDOM OVER TUB HDR, HST.: ENTRY DOOR HEIGHT: SLIDING GLAGS DOOR HEIGHT: INTERIOR SOFFIT HEIGHT: TRAY CELLING: INTERIOR DOOR HEIGHT:			
STAIR DATA NOTES				

FIRST FLOOR WITH 8-1" PLATE HEIGHT:
14" DEEP T.J.I. FLOOR JOISTS WITH 3/4" T&G DECKING.


FIRST FLOOR WITH 9'-1" PLATE HEIGHT:
14" DEEP T.J.I. FLOOR JOISTS WITH 9'-4" T&G DECKING. 15 TREADS AT 10" EACH 16 RISERS AT 7-3/4" EACH

GENERAL PLAN NOTES

ALL INTERIOR DOORS TO BE HOLLOW CORE I 3/8" THICK, U.N.O. (REFER TO PLAN FOR SIZE).

ALL GARAGE SERVICE DOORS TO BE HOLLOW CORE EXTERIOR GRADE (REFER TO PLAN FOR SIZE). ALL HOUSE TO GARAGE DOORS TO BE 20-MINUTE FIRE-RATED (REFER TO PLAN FOR SIZE).

ALL ENTRY DOORS AND EXTERIOR FRENCH DOORS TO BE SOLID CORE I 3/4" THICK (REFER TO PLAN FOR SIZE). ALL FLOOR MATERIAL CHANGES TO OCCUR AT CENTER OF DOOR JAMBS, UN.O.

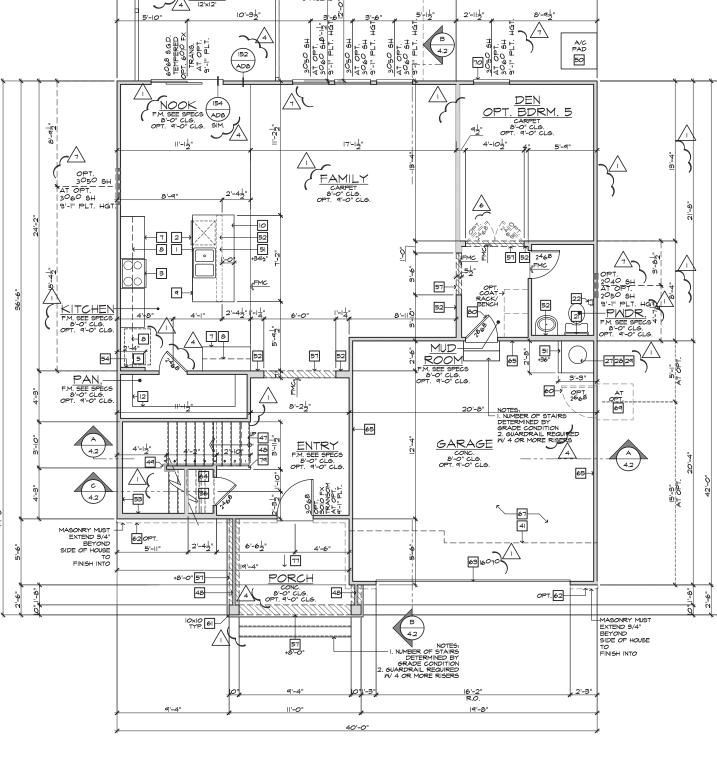

FLOOR PLAN NOTES

NOTE: NOT ALL KEY NOTES APPLY.

SINK - GARBAGE DISPOSAL OPTIONAL - VERIFY DIMENSIONS WITH MANUFACTURERS' SPECS

DISHMASHER - PROVIDE AIR GAP - VERIFY SPACING & DIMENSIONS PER MANUFACTURERS' SPECS

SLIDE-IN RANGE/OVEN COMBINATION W/ BUILT-IN NON-VENTED HOOD W/LIGHT & FAN. - VERIFY WITH MANUFACTURERS' SPECS 30" COOKTOP W BUILT-IN VENTED HOOD W LIGHT & FAN VERIFY WITH MANUFRS' SPECS

YENIT WITH FINANCES SELECT W OPTIONAL CABINETS ABOVE - OPT. PLUMBING FOR ICEMAKER (RECESSED IN WALL) COMBINATION DOUBLE OVEN OR OVEN WICKOMAYE OVEN OR OVEN VERIFY DIMENSIONS WITH MANUFACTURERS' SPECS

BASE CABINETS - REFER TO INTERIOR ELEVATIONS 3. UPPER CABINETS - REFER TO INTERIOR ELEVATIONS ISLAND CABINET - REFER TO INTERIOR ELEVATIONS

IO. MIN. 12" BAR TOP/ BREAKFAST BAR DESK AREA - REFER TO INTERIOR ELEVATIONS

12. BUILT-IN PANTRY (15" DEEP OR U.N.O.)

13. SINK CABINET(S) - REFER TO INTERIOR ELEVATIONS 14. SINK CABINET W/ EXTENDED VANITY & KNEE SPACE BELOW REFER TO INTERIOR ELEVATIONS

15. OPT. SINK - REFER TO INTERIOR ELEVATIONS.

16. KNEE SPACE - REFER TO INTERIOR ELEVATIONS PRE-FAB. TUB/SHOWER COMBO W/ FIBERGLASS WAINSCOT2" - VERIFY DIMENSIONS W/ MANUF'S SPECS

18. OVAL TUB - VERIFY DIMENSIONS WITH MANUFR'S SPECS. PRE-FAB, SHOWER PAN W 30" MIN, CLR. INSIDE & WAINSCOT TO 72" - VERIFY DIMENSIONS W/ MANUF'S SPECS

20. SHATTERPROOF (TEMPERED) GLASS SHOWER ENCLOSURE. 21. TOWEL BAR - PROVIDE 2x SOLID BLK'G IN WALL

22. TOILET PAPER HOLDER - PROVIDE 2x SOLID BLK'G IN WALL 23. RECESSED, MIRRORED MEDICINE CABINET

24. MASHER & DRYER: - PROVIDE MATER & MASTE FOR MASHER - RECESS MASHER CONTROL VALVES IN MALL - VENT DRYER TO OUTSIDE AIR: - ACCOMMODATE APPLIANCES TO BE LOCATED MASHER AT LEFT AND DRYER AT RIGHT.

25. I2" SHELF PER SPECS

26. OPT. LAUNDRY SINK - REFER TO INTERIOR ELEV'S 27. WATER HEATER LOCATION: - FOR GAS - LOCATE ON 18" HIGH-PLATFORM - FOR INTERIOR LOCATION - PROVIDE PAN & DRAIN. (REFER TO 15/AD4) 28. RESERVED

29. MAIN LINE SHUT-OFF VALVE AND TEMP. & PRESSURE RELIEF VALVE

30. F.A.J. LOCATION (REFER TO DETAIL 88/AD5)

32. LISTED FACTORY-BUILT GAS FIRED DEC. APPLIANCE (REF. 80/AD4) - INSTALL PER MFR. SPECS 33. HEARTH TO BE INSTALLED PER FACTORY-BUILT FIREPLACE LISTING

34. GAS APPLIANCE 'B' VENT FROM BELOW

35. LINEN PER SPECS (15" DEEP OR U.N.O.) 36. COAT CLOSET W SHELF & POLE (REFER TO DETAILTS/AD4)

37. WARDROBE W/ SHELF & POLE (REFER TO DETAILT3/AD4) 36, 22"X30" MIN. ATTIC ACCESS 25"X54" PULL DOWN LADDER R.O. ATTIC ACCESS TO BE PROTECTED

39. LINE OF WALL BELOW

40. DUCT CHASE 41. LINE OF FLOOR ABOVE

42. LINE OF FLOOR BELOW 43. LINE OF OPTIONAL TRAY CEILING (REFER TO DETAIL 92/AD5)

44. LINE OF HIP AT OPTIONAL VOLUME CEILING

45. LINE OF RIDGE AT OPTIONAL VOLUME CEILING 46. CEILING BREAK

47. STAIR TREADS & RISERS: - MIN. IO" TREAD & MAX. 7 3/4" RISER - (REFER TO DETAIL 81-82/AD5)

48. MIN. 42" HIGH GUARDRAIL (REFER TO DETAIL 86/AD5)

49. 34" TO 38" HIGH HANDRAIL (REFER TO DETAIL 83/AD5)

50. A/C PAD LOCATION 51. LOW WALL - REFER TO PLAN FOR HEIGHT 52. 2x6 STUD WALL

53. 2x6 BALLOON FRAMED WALL PER STRUCTURAL

54. DBL. 2x4 WALL PER PLAN 55. INTERIOR SHELF-SEE PLAN FOR HT.

56. MEDIA NICHE 57. FLAT SOFFIT - SEE ELEV. FOR HGT. 58. ARCHED SOFFIT - SEE ELEV. FOR HGT.

59. WINDOW SEAT 60. OPT. DOOR/ WINDOW

61. PRE-MANUFACTURED DECORATIVE COLUMN (SIZE, SEE ELEV. FYPON OR EQ. SURROUNDING STRUCTURAL POST. 62. BRICK / STONE VENEER - REFER TO ELEVATIONS VENEER TO COMPLY WITH THE N.C.-R.

63. SECTIONAL GARAGE DOOR PER SPECS 64. MIN. I/2" GYP. BD. ON CEILINGS & WALLS @ USEABLE SPACE UNDER STAIR.

65. GARAGE SHALL BE SEPARATED FROM THE RESIDENCE AND ITS ATTIC AREA BY NOT LESS THAT I/2" GYP, BD. @ GARAG SIDE WALLS & \$/6" WINDER LIVING AREA UN.O.

67. 5/8" TYPE-X GYP. IN GARAGE BETWEEN CEILING & FLOOR AS

69. CONCRETE STOOP: 36"x36" STANDARD SLOPE I/4" PER FT. MIN.

70. EGRESS WINDOW TI. PROVIDE ADDITIONAL RISER(S) AT OPTIONAL PLATE HT.

73. PLUMBING DROP FROM ABOVE

74. ADJUST OPENING AT OPTION TO FIT THE DOOR SIZE SHOWN 75. WINDOW LEDGE. HEIGHT & WIDTH OF OPENING TO EXTEND 6" BEYOND WINDOW(S) ON ALL SIDES U.N.O.

76. SITE-BUILT COLUMN - SEE ELEVATION FOR TYPE

77. CONCRETE SLAB. SLOPE I/4" PER FT. MIN. SEE PLAN FOR SIZE.

78. RESERVED 79. SLOPING LOW WALL 38" ABOVE ADJACENT TREADS 80. 20 MIN. FIRE-RATED DOOR

240.2596-R 1.3

HOME

NORTH CAROLINA

40' SERIES

KB HOME NORTH CAROLINA DIVISION

4518 S. MIAMI BLVD.

SUITE 180 DURHAM, NC 27703

FAX: (919) 472-0582

2018 NORTH

CAROLINA STATE

BUILDING

CODES

PROJECT No.: 1350999:56

DIVISION REVISIONS
NCI8024NCP · 08/24/18 · CTD

2018 CODE UPDATE NCI9015NCP/ 03/15/19 / CTD

DIVISION REVISION
NCI9017NCP- 04/01/19 CTD

FRAMEWALK REVISIONS
NCI9033NCP- 05/07/19 - CTD

DIVISION REVISIONS
NC20017NCP- 03/04/20 - KBA

06/02/15

MCP

05/07/19

ISSUE DATE:

REVISIONS:

DIVISION MGR.:

TEL: (919) 768-7988

SPEC. LEVEL 1 RALEIGH-DURHAM 40' SERIES

FIRST FLOOR PLAN 'A' AT CRAWL SPACE

12'-0"

150

-48 36" GUARDRAI


150

ADB

ير"0|-'اي

OPT. 24'xl2" DECK SLAB

BASIC PLAN AT CRAWL SPACE

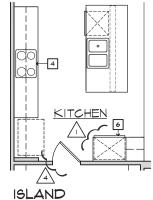

AT KITCHEN

FIRST FLOOR PLAN OPTIONS


SCALE |/4"=|'-0" (22"X34") - |/8"=|'-0" (||"X|7")

DI ANI

FLOOR PLAN NOTES NOTE: NOT ALL KEY NOTES APPLY. SINK - GARBAGE DISPOSAL OPTIONAL - VERIFY DIMENSIONS WITH MANUFACTURERS' SPECS DISHMASHER - PROVIDE AIR GAP - VERIFY SPACING & DIMENSIONS PER MANUFACTURERS' SPECS SLIDE-IN RANGE/OVEN COMBINATION W/ BUILT-IN NON-VENTED HOOD W/LIGHT & FAN. - VERIFY WITH MANUFACTURERS' SPECS 30" COOKTOP W BUILT-IN VENTED HOOD W LIGHT & FAN VERIFY WITH MANUFRS' SPECS HOME 5. 34" CLEAR REFRIGERATOR SPACE W OPTIONAL CABINETS ABOVE - OPT. PLUMBING FOR ICEMAKER (RECESSED IN WALL) 6. COMBINATION DOUBLE OVEN OR OVEN WICROWAVE OVEN OR OVEN VERIFY DIMENSIONS WITH MANUFACTURERS' SPECS . BASE CABINETS - REFER TO INTERIOR ELEVATIONS 8. UPPER CABINETS - REFER TO INTERIOR ELEVATIONS 9. ISLAND CABINET - REFER TO INTERIOR ELEVATIONS IO. MIN. 12" BAR TOP/ BREAKFAST BAR II. DESK AREA - REFER TO INTERIOR ELEVATIONS 12. BUILT-IN PANTRY (15" DEEP OR U.N.O.) 13. SINK CABINET(S) - REFER TO INTERIOR ELEVATIONS 14. SINK CABINET W/ EXTENDED VANITY & KNEE SPACE BELOW - REFER TO INTERIOR ELEVATIONS 15. OPT. SINK - REFER TO INTERIOR ELEVATIONS.16. KNEE SPACE - REFER TO INTERIOR ELEVATIONS PRE-FAB. TUB/SHOWER COMBO W/ FIBERGLASS WAINSCOT TO 72" - VERIFY DIMENSIONS W/ MANUF'S SPECS 18. OVAL TUB - VERIFY DIMENSIONS WITH MANUFR'S SPECS. 19. PRE-FAB, SHOWER PAN W 30" MIN, CLR, INSIDE & WAINSCOT TO 72" - VERIFY DIMENSIONS W/ MANUF'S SPECS 20. SHATTERPROOF (TEMPERED) GLASS SHOWER ENCLOSURE. 21. TOWEL BAR - PROVIDE 2x SOLID BLK'G IN WALL NORTH CAROLINA 22. TOILET PAPER HOLDER - PROVIDE 2x SOLID BLK'G IN WALL 23. RECESSED, MIRRORED MEDICINE CABINET 40' SERIES 24. MASHER & DRYER: - PROVIDE WATER & MASTE FOR MASHER RECESS MASHER CONTROL VALVES IN MALL - VENT DRYER TO OUTSIDE AIR. - ACCOMMODATE APPLIANCES TO BE LOCATED WASHER AT LEFT AND DRYER AT RIGHT. KB HOME NORTH CAROLINA DIVISION 25. I2" SHELF PER SPECS 26. OPT. LAUNDRY SINK - REFER TO INTERIOR ELEV'S 4518 S. MIAMI BLVD. 27. WATER HEATER LOCATION: - FOR GAS - LOCATE ON 18" HIGH PLATFORM - FOR INTERIOR LOCATION - PROVIDE PAN & DRAIN. (REFER TO 15/AD4) SUITE 180 DURHAM, NC 27703 28. RESERVED 29. MAIN LINE SHUT-OFF VALVE AND TEMP. & PRESSURE RELIEF VALVE TEL: (919) 768-7988 • FAX: (919) 472-0582 30. F.A.U. LOCATION (REFER TO DETAIL 88/AD5) 8 8 8 8 32. LISTED FACTORY-BUILT GAS FIRED DEC. APPLIANCE (REF. 80/AD4) - INSTALL PER MFR. SPECS 33. HEARTH TO BE INSTALLED PER FACTORY-BUILT FIREPLACE LISTING 2018 NORTH 34. GAS APPLIANCE 'B' VENT FROM BELOW 35. LINEN PER SPECS (15" DEEP OR U.N.O.) CAROLINA STATE 36. COAT CLOSET W SHELF & POLE (REFER TO DETAILTS/AD4) 37. WARDROBE W SHELF & POLE (REFER TO DETAIL13/AD4) **BUILDING** 36, 22"X30" MIN. ATTIC ACCESS 25"X54" PULL DOWN LADDER R.O. ATTIC ACCESS TO BE PROTECTED 39. LINE OF WALL BELOW CODES 40. DUCT CHASE 41. LINE OF FLOOR ABOVE 42. LINE OF FLOOR BELOW 43. LINE OF OPTIONAL TRAY CEILING (REFER TO DETAIL 92/AD5) 44. LINE OF HIP AT OPTIONAL VOLUME CEILING 45. LINE OF RIDGE AT OPTIONAL VOLUME CEILING 46. CEILING BREAK 47. STAIR TREADS & RISERS: - MIN. IO" TREAD & MAX. 7 3/4" RISER - (REFER TO DETAIL 81-82/AD5) 48. MIN. 42" HIGH GUARDRAIL (REFER TO DETAIL 86/AD5) 49. 34" TO 38" HIGH HANDRAIL (REFER TO DETAIL 83/AD5) 50. A/C PAD LOCATION ISSUE DATE: 06/02/15 51. LOW WALL - REFER TO PLAN FOR HEIGHT PROJECT No.: 1350999:56 52. 2x6 STUD WALL DIVISION MGR.: MCP 53. 2x6 BALLOON FRAMED WALL PER STRUCTURAL 54. DBL. 2x4 WALL PER PLAN 55. INTERIOR SHELF-SEE PLAN FOR HT. 05/07/19 REVISIONS: 56. MEDIA NICHE 57. FLAT SOFFIT - SEE ELEV. FOR HGT. DIVISION REVISIONS NCI8024NCP · 08/24/18 · CTD 58. ARCHED SOFFIT - SEE ELEV. FOR HGT. 2018 CODE UPDATE NCI9015NCP/ 03/15/19 / CTD 59. WINDOW SEAT 60. OPT. DOOR/ MINDOW DIVISION REVISION NCI9017NCP- 04/01/19 CTD 61. PRE-MANUFACTURED DECORATIVE COLUMN (SIZE, SEE ELEV.) FYPON OR EQ. SURROUNDING STRUCTURAL POST. 62. BRICK / STONE VENEER - REFER TO ELEVATIONS VENEER TO COMPLY WITH THE N.C.-R. FRAMEWALK REVISIONS NCI9033NCP- 05/07/19 - CTD 63. SECTIONAL GARAGE DOOR PER SPECS 64. MIN. I/2" GYP. BD. ON CEILINGS & WALLS @ USEABLE SPACE UNDER STAIR. DIVISION REVISIONS NC20012NCP- 01/29/20 - KBA 65. GARAGE SHALL BE SEPARATED FROM THE RESIDENCE AND ITS ATTIC AREA BY NOT LESS THAT I/2" GYP. BD. @ GARAGE SIDE WALLS & 5/8" UNDER LIVING AREA U.N.O. DIVISION REVISIONS NC20017NCP- 03/04/20 - KBA 67. 5/8" TYPE-X GYP. IN GARAGE BETWEEN CEILING & FLOOR AB DIVISION REVISIONS NC20023NCP- 05/07/20 · KBA 68. P.T. POST W WRAP 69. CONCRETE STOOP: 36"x36" STANDARD SLOPE I/4" PER FT. MIN. 70. EGRESS WINDOW 71. PROVIDE ADDITIONAL RISER(S) AT OPTIONAL PLATE HT. 73. PLUMBING DROP FROM ABOVE 74. ADJUST OPENING AT OPTION TO FIT THE DOOR SIZE SHOWN 75. WINDOW LEDGE. HEIGHT & WIDTH OF OPENING TO EXTEND 6" BEYOND WINDOW(5) ON ALL SIDES U.N.O. 240.2596-R 76. SITE-BUILT COLUMN - SEE ELEVATION FOR TYPE 77. CONCRETE SLAB. SLOPE I/4" PER FT. MIN. SEE PLAN FOR SIZE. HEET: 76. RESERVED 79. SLOPING LOW WALL 36" ABOVE ADJACENT TREADS 1.4 80. 20 MIN. FIRE-RATED DOOR

SPEC. LEVEL 1


RALEIGH-DURHAM

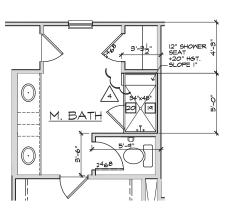



SECOND FLOOR PLAN OPTIONS

SCALE I/4"=I'-0" (22"X34") - I/8"=I'-0" (II"XI7")

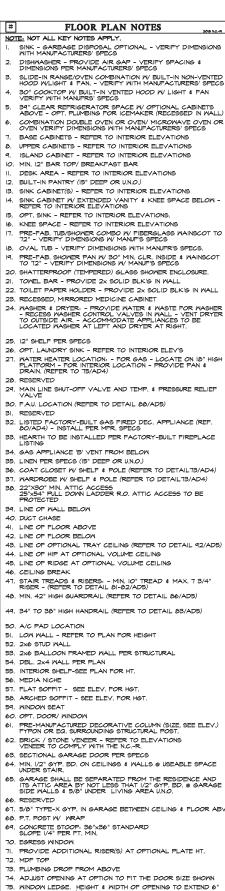

HOME

NORTH CAROLINA 40' SERIES

KB HOME NORTH CAROLINA DIVISION

4518 S. MIAMI BLVD. SUITE 180 DURHAM, NC 27703 TEL: (919) 768-7988 • FAX: (919) 472-0582

. . . .

2018 NORTH CAROLINA STATE **BUILDING** CODES

ISSUE DATE: 06/02/15 PROJECT No.: 1350999:56 DIVISION MGR.: MCP

05/07/19

DIVISION REVISIONS
NCI8024NCP · 08/24/18 · CTD

REVISIONS:

2018 CODE UPDATE NCI9015NCP/ 03/15/19 / CTD

DIVISION REVISION
NCI9017NCP- 04/01/19 CTD

FOR INTERNAL USE ONLY

240.2596-R

SPEC. LEVEL 1

HEET:

1.5

FRAMEWALK REVISIONS NCI9033NCP- 05/07/19 - CTD

64. MIN. I/2" GYP. BD. ON CEILINGS & WALLS @ USEABLE SPACE UNDER STAIR.

65. GARAGE SHALL BE SEPARATED FROM THE RESIDENCE AND ITS ATTIC AREA BY NOT LESS THAT 1/2" GYP. BD. @ GARAGE SIDE WALLS & 5/6" UNDER LIVING AREA U.N.O.

67. 5/8" TYPE-X GYP. IN GARAGE BETWEEN CEILING & FLOOR ABV

69. CONCRETE STOOP: 36"x36" STANDARD SLOPE I/4" PER FT. MIN.

71. PROVIDE ADDITIONAL RISER(S) AT OPTIONAL PLATE HT.

73. PLUMBING DROP FROM ABOVE

74. ADJUST OPENING AT OPTION TO FIT THE DOOR SIZE SHOWN 75. WINDOW LEDGE. HEIGHT & WIDTH OF OPENING TO EXTEND 6" BEYOND WINDOW(S) ON ALL SIDES U.N.O.


76. SITE-BUILT COLUMN - SEE ELEVATION FOR TYPE

77. CONCRETE SLAB. SLOPE I/4" PER FT. MIN. SEE PLAN FOR SIZE.

76. RESERVED
79. SLOPING LOW WALL 38" ABOVE ADJACENT TREADS 80. 20 MIN. FIRE-RATED DOOR

> **RALEIGH-DURHAM** 40' SERIES

NOTE: REFER TO BASIC FLOOR PLAN FOR INFORMATION NOT SHOWN HERE

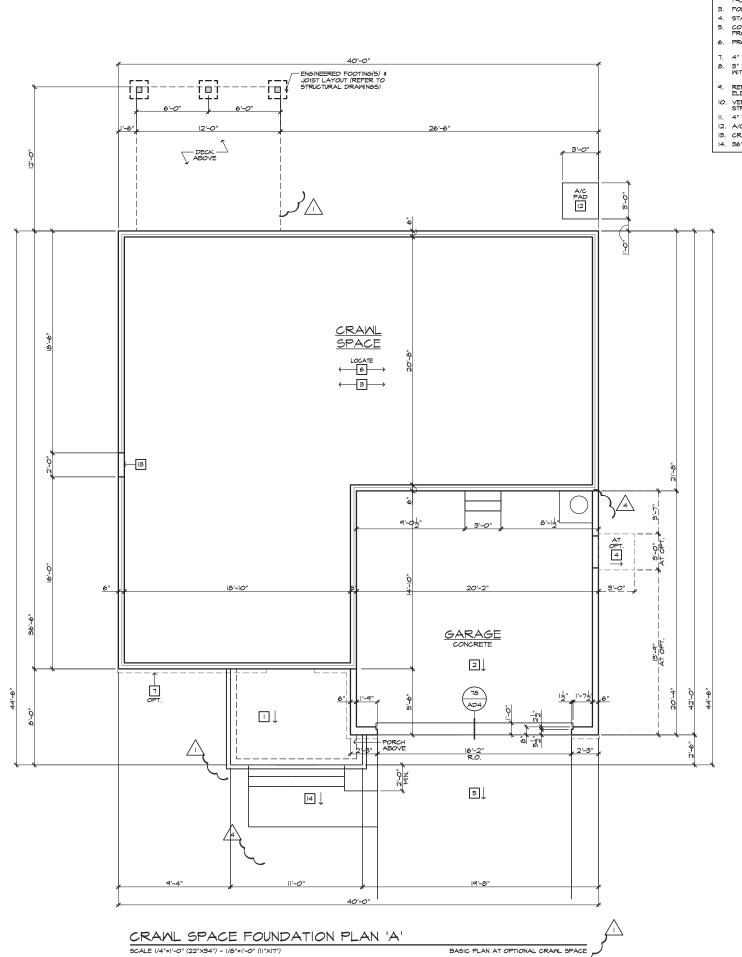

FOUNDATION PLAN NOTES

FOUNDATION P.
NOTE: NOT ALL KEY NOTES APPLY.

CONCRETE PATIO/PORCH SLAB PER STRUCTURAL- SLOPE
1/4" PER FT. MIN.
CONCRETE 6ARAGE SLAB PER STRUCTURAL- SLOPE 1/8" PER.
1'-0" MIN. TOWARD DOOR OPENING.

3. FOUNDATION PER STRUCTURAL.

4. STAIR LANDING: 36"x36" MIN.

CONCRETE DRIVEWAY SLOPE 1/4" PER FT. MIN. AWAY FROM GARAGE DOOR OPENING.

7. 4" TOE KICK FOR MASONRY VENEER.

3" DIAMETER CONCRETE FILLED PIPE BOLLARD 36" HIGH WITH MIN. 12" EMBEDMENT INTO CONCRETE.

REFER TO CIVIL DRAWINGS FOR ALL FINISH SURFACE ELEVATIONS.

IO. VERIFY LOCATION OF PIER FOOTINGS PER STRUCTURAL

II. 4" MIN. 7 3/4" MAX. TO HARD SURFACE.

12. A/C PAD. VERIFY LOCATION.
13. CRAWL SPACE ACCESS

14. 36" WIDE WALKWAY- SLOPE 1/4" PER FT. MIN.

kbHOME

NORTH CAROLINA 40' SERIES

KB HOME NORTH CAROLINA DIVISION

4518 S. MIAMI BLVD. SUITE 180 DURHAM, NC 27703 ■ TEL: (919) 768-7988 ■ FAX: (919) 472-0582

2018 NORTH CAROLINA STATE BUILDING CODES

ISSUE DATE: 06/02/15 ■ PROJECT No.: 1350999:56 ■ DIVISION MGR.: MCP

DIVISION REVISIONS
NCI8024NCP - 08/24/18 - CTD

05/07/19


2018 CODE UPDATE NC19015NCP/ 03/15/19 / CTD

REVISIONS:


DIVISION REVISION
NCI9017NCP- 04/01/19 CTD

FRAMEWALK REVISIONS NC19033NCP- 05/07/19 - CTD DIVISION REVISIONS NC20012NCP- 01/29/20 · KBA



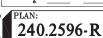

2.3

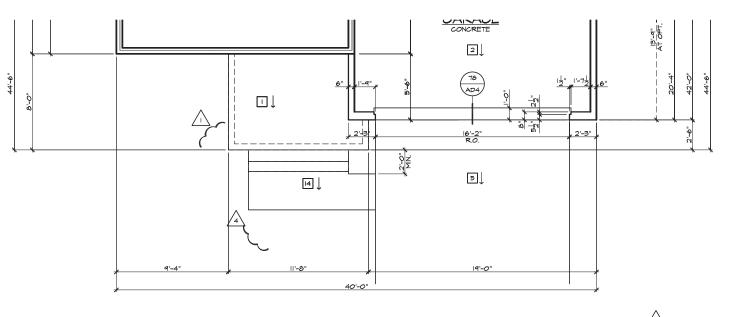

PARTIAL CRAWL SPACE FOUNDATION PLAN 'B' SCALE |/4"=1'-0" (22"X34") - |/8"=1'-0" (|1"X|7")

FOUNDATION P FOUNDATION PLAN NOTES

CONCRETE PATIO/PORCH SLAB PER STRUCTURAL- SLOPE
//4* PER FT. MIN.
CONCRETE 6ARAGE SLAB PER STRUCTURAL- SLOPE //8" PER.
I'-O" MIN. TOMARD DOOR OPENING.

3. FOUNDATION PER STRUCTURAL.

4. STAIR LANDING: 36"x36" MIN.

5. CONCRETE DRIVEWAY SLOPE 1/4" PER FT. MIN. AWAY FROM GARAGE DOOR OPENING.

6. PROVIDE UNDER FLOOR VENTILATION

7. 4" TOE KICK FOR MASONRY VENEER.

3" DIAMETER CONCRETE FILLED PIPE BOLLARD 36" HIGH WITH MIN. 12" EMBEDMENT INTO CONCRETE.

REFER TO CIVIL DRAWINGS FOR ALL FINISH SURFACE ELEVATIONS.

II. 4" MIN. 7 3/4" MAX. TO HARD SURFACE.

12. A/C PAD. VERIFY LOCATION.
13. CRAWL SPACE ACCESS
14. 36" WIDE WALKWAY- SLOPE 1/4" PER FT. MIN.



NORTH CAROLINA 40' SERIES

KB HOME NORTH CAROLINA DIVISION

4518 S. MIAMI BLVD. SUITE 180 DURHAM, NC 27703 ■ TEL: (919) 768-7988 ■ FAX: (919) 472-0582

2018 NORTH CAROLINA STATE BUILDING CODES

ISSUE DATE: 06/02/15 PROJECT No.: 1350999:56 DIVISION MGR.: MCP

REVISIONS: 05/07/19 DIVISION REVISIONS
NCI8024NCP · 08/24/18 · CTD

2018 CODE UPDATE NCI9015NCP/ 03/15/19 / CTD


DIVISION REVISION NCI9017NCP- 04/01/19 CTD

FRAMEWALK REVISIONS NC19033NCP- 05/07/19 - CTD DIVISION REVISIONS
NC20012NCP- 01/29/20 · KBA



240.2596-R SHEET:


2.4

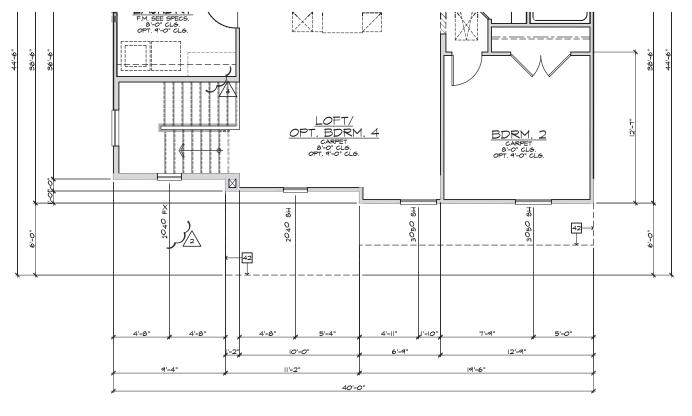

PARTIAL SECOND FLOOR PLAN 'B'


SCALE |/4"=|'-0" (22"X34") - |/8"=|'-0" (||"X|7")

BASIC PLAN

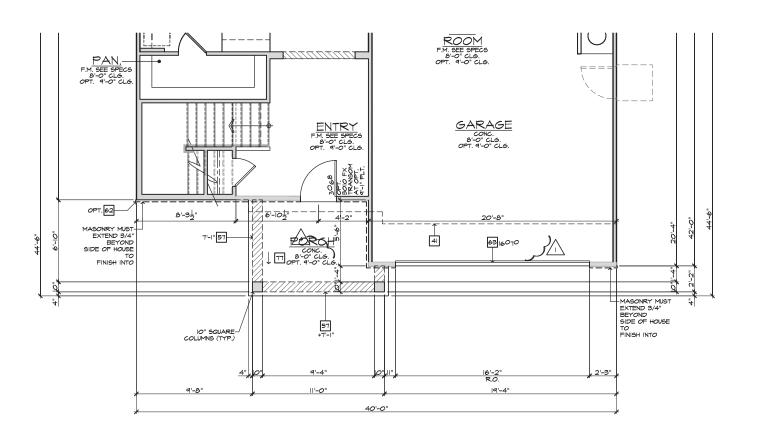

PARTIAL FIRST FLOOR PLAN 'B'


BASIC PLAN

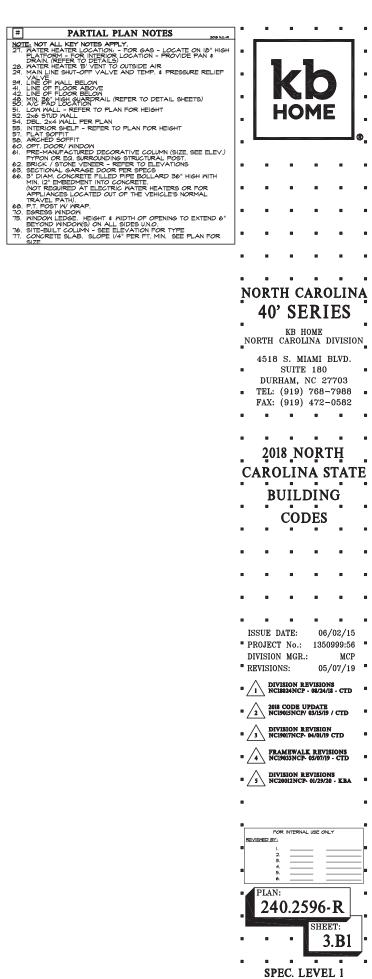

NOTE: REFER TO BASIC FLOOR PLAN FOR INFORMATION NOT SHOWN HERE


от


RALEIGH-DURHAM 40' SERIES

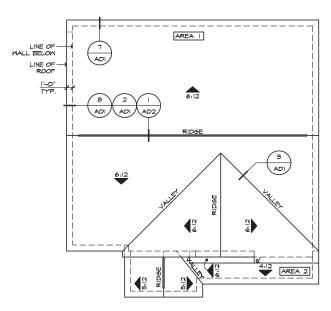


ROOF PLAN 'B'

SCALE I/8"=1'-0" (22"X34") - I/I6"=1'-0" (II"XI7")

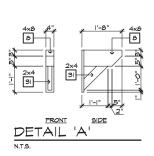


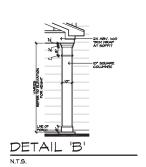

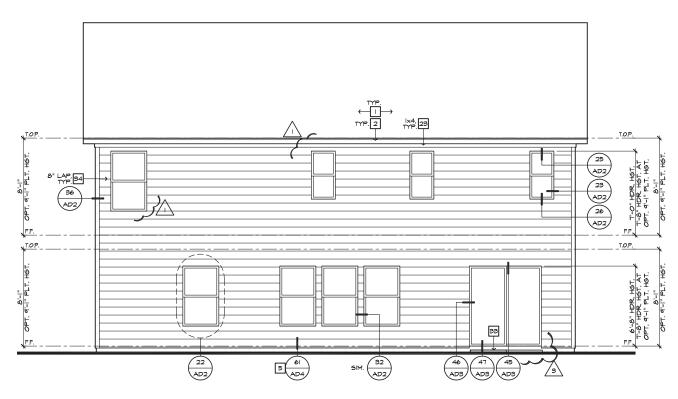

REAR ELEVATION 'B'

SCALE I/4"=I'-0" (22"X34") - I/6"=I'-0" (II"XIT")

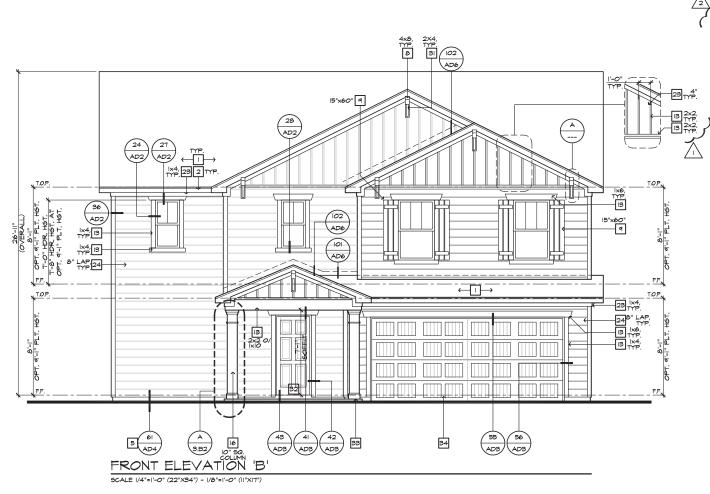

ELEVATION NOTES ROOF MATERIAL - REFER TO ROOF NOTES 2. 2X FASCIA/BARGE BOARD WITH FASCIA CAP HOME 12. DECORATIVE TRIM FYPON OR EQ. SEE ELEVATION FOR TYPE 13. TRIM PER SPEC- SEE ELEVATION FOR SIZE
14. SYNTHETIC MATERIAL 15. PRE-MANUFACTURED DECORATIVE COLUMN (SIZE, SEE ELEV.) FYPON OR EQ. SURROUNDING STRUCTURAL POST. 16. SITE-BUILT COLUMN - SEE ELEVATION FOR TYPE

NORTH CAROLINA 40' SERIES

KB HOME NORTH CAROLINA DIVISION

4518 S. MIAMI BLVD. SUITE 180 DURHAM, NC 27703

2018 NORTH

CAROLINA STATE

BUILDING

CODES

36. OPTIONAL DOOR/MINDOW - REFER TO PLAN OPTIONS 37. OPTIONAL STANDING SEAM METAL ROOF TEL: (919) 768-7988 • FAX: (919) 472-0582

4I. WATER TABLE 43. PILASTER - SEE ELEVATION FOR TYPE

ROOF PLAN NOTES 'B'

40. JACK SOLDIER COURSE

35. ALUMINUM WRAP

38. KEYSTONE 39. SOLDIER CROWN

NOTE: NOT ALL KEY NOTES APPLY.

4. G.I. FLASHING & SADDLE/CRICKET
5. G.I. DRIP SCREED

IO. PEDIMENT. SEE ELEVATION FOR TYPE

23. FRIEZE BOARD
24. SIDING W/ 4" CORNER TRIM PER SPECS

27. LIGHT WEIGHT PRECAST STONE TRIM

31. BRACKET OR KICKER - FYPHON OR EQ. 32. ENTRY DOOR

34. SECTIONAL GARAGE DOOR PER SPECS

28. P.T. LUMBER RAILINGS (+36" U.N.O.)

25. P.T. POST W WRAP - SEE STRUCTURAL FOR SIZE 26. PRE-FAB DECORATIVE TRIM

30. DECORATIVE WINDOW/DOOR TRIM - FYPON OR EQ. SEE ELEVATION FOR SIZE.

33. CONCRETE STOOP/ PORCH - SEE SLAB INTERFACE PLAN.

3. G.I. FLASHING

6. 24"x24" CHIMNEY 7. DECORATIVE VENT

DECORATIVE CORBE 9. DECORATIVE SHUTTERS

RECESSED ELEMENT

17. SHAKE SIDING18. STONE VENEER PER SPECS 19. BRICK/MASONRY VENEER PER SPECS

20. BUILT UP BRICK COLUMN 21. SOLDIER COURSE 22. ROWLOCK COURSE

INDICATES ROOF SLOPE AND DIRECTION, U.N.O.

ROOF MATERIAL: COMPOSITION SHINGLE

12" (INCHES) TYPICAL ROOF OVERHANG AT RAKE, U.N.O.
12" (INCHES) TYPICAL ROOF OVERHANG AT EAVE, U.N.O. LOCATE EAVE/ RAFTER VENTS EQUALLY BALANCED AROUND HOUSE EXCEPT ABOVE SHEARWALL PANELS.

ATTIC VENT CALCULATIONS

ATTRE VENT CALCULATIONS
PROVIDE 190, IN. OF VENTILATION PER 300 90, IN. OF ATTIC
SPACE. PROVIDE THAT AT LEAST 50% & NO MORE THAN 80% OF
THE RED. VENTILATING AREA IS PROVIDED BY VENTILATORS
LOCATED IN THE UPPER PORTION OF THE ATTIC, (HIGH VENTING)
AT 3'-O' ABOVE EAVE VENT WITH THE BALLANCE BEINS PROVIDED
BY EAVE VENTS, (LOW VENTING) (2018 NG.-R 806.2)
** CALCULATION BY UISO, HIGHLOW VENTING NOT REQUIRED.
APPROXIMATE RIDGE VENT LOCATIONS SHOWN.
ACTUAL LOCATIONS TO BE DETERMINED IN THE FIELD.

	ACTUAL LOCATIONS TO BE DETERMINED IN THE FIELD.					
	AREA VENTILATION REQUIRED:					
)	38 LINEAR FEET RIDGE VENT AT 18 SQ. IN. PER FOOT= 684 SQ. IN.					
	48 LINEAR FEET EAVE VENT AT 5 90. IN. PER FOOT: 240 SQ. IN. TOTAL: 924 SQ. IN.					
	101AL= 424 50. IN.					
	AREA 2 VENTILATION REQUIRED: ATTIC AREA = 140 SQ. FT. / 150 = 9 SQ. FT.					
	X 144 = 1246 50 IN					

VENTILATION PROVIDED: 5 LINEAR FEET RIDGE VENT AT IS SQ. IN, PER FOOT= 15 LINEAR FEET EAVE VENT AT 5 SQ. IN. PER FOOT= = <u>75 50. IN</u> TOTAL= 165 50. IN

DIVISION MGR.: MCP REVISIONS: 05/07/19 DIVISION REVISIONS
NCI8024NCP · 08/24/18 · CTD

■ PROJECT No.: 1350999:56 ■

06/02/15

ISSUE DATE:

2018 CODE UPDATE NCI9015NCP/ 03/15/19 / CTD


DIVISION REVISION NCI9017NCP- 04/01/19 CTD

FRAMEWALK REVISIONS NCI9033NCP- 05/07/19 - CTD DIVISION REVISIONS
NC20012NCP- 01/29/20 - KBA

DIVISION REVISIONS NC20017NCP- 03/04/20 - KBA


240.2596-R

3.**B**2

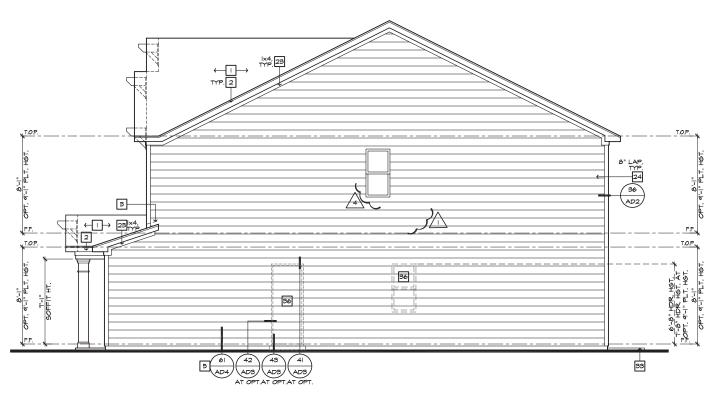

RIGHT ELEVATION 'B'

SCALE I/4"=I'-0" (22"X34") - I/8"=I'-0" (II"XI7")

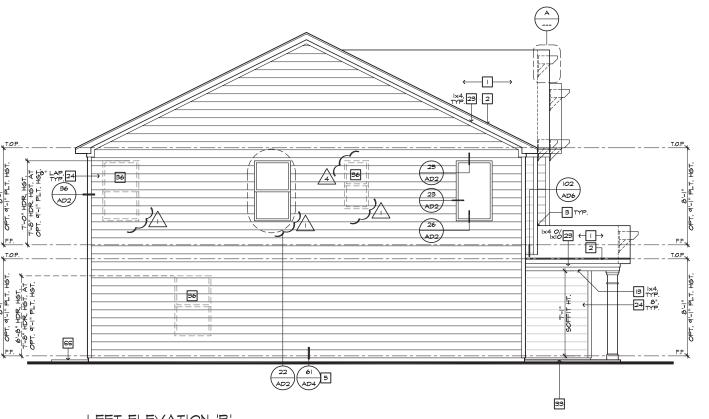

ELEVATION NOTES

NOTE: NOT ALL KEY NOTES APPLY.

I. ROOF MATERIAL - REFER TO ROOF NOTES

2. 2X FASCIA/BARGE BOARD WITH FASCIA CAP

3. G.I. FLASHING

4. G.I. FLASHING & SADDLE/CRICKET
5. G.I. DRIP SCREED

6. 24"x24" CHIMNEY
7. DECORATIVE VENT

8. DECORATIVE CORBEL

9. DECORATIVE SHUTTERS IO. PEDIMENT. SEE ELEVATION FOR TYPE

II. RECESSED ELEMENT 12. DECORATIVE TRIM FYPON OR EQ. SEE ELEVATION FOR TYPE

13. TRIM PER SPEC- SEE ELEVATION FOR SIZE 14. SYNTHETIC MATERIAL

15. PRE-MANUFACTURED DECORATIVE COLUMN (SIZE, SEE ELEV.) FYPON OR EQ. SURROUNDING STRUCTURAL POST.

16. SITE-BUILT COLUMN - SEE ELEVATION FOR TYPE

SHAKE SIDING
 STONE VENEER PER SPECS
 BRICK/MASONRY VENEER PER SPECS

21. SOLDIER COURSE 22. ROWLOCK COURSE

23. FRIEZE BOARD
24. SIDING W/ 4" CORNER TRIM PER SPECS

25. P.T. POST W WRAP - SEE STRUCTURAL FOR SIZE 26. PRE-FAB DECORATIVE TRIM

27. LIGHT WEIGHT PRECAST STONE TRIM
28. P.T. LUMBER RAILINGS (+36" U.N.O.)

30. DECORATIVE WINDOW/DOOR TRIM - FYPON OR EQ. SEE ELEVATION FOR SIZE.

31. BRACKET OR KICKER - FYPHON OR EQ. 32. ENTRY DOOR

33. CONCRETE STOOP/ PORCH - SEE SLAB INTERFACE PLAN. 34. SECTIONAL GARAGE DOOR PER SPECS

35. ALUMINUM WRAP

36. OPTIONAL DOOR/MINDOM - REFER TO PLAN OPTIONS 37. OPTIONAL STANDING SEAM METAL ROOF

38. KEYSTONE 39. SOLDIER CROWN

40. JACK SOLDIER COURSE
41. WATER TABLE

43. PILASTER - SEE ELEVATION FOR TYPE

KB HOME NORTH CAROLINA DIVISION 4518 S. MIAMI BLVD. SUITE 180

NORTH CAROLINA

40' SERIES

HOME

DURHAM, NC 27703 TEL: (919) 768-7988 • FAX: (919) 472-0582

2018 NORTH CAROLINA STATE BUILDING CODES

ISSUE DATE: 06/02/15 ■ PROJECT No.: 1350999:56 ■ DIVISION MGR.: MCP

DIVISION REVISIONS
NCIS024NCP · 08/24/18 · CTD

05/07/19

2018 CODE UPDATE NCI9015NCP/ 03/15/19 / CTD

REVISIONS:

DIVISION REVISION NCI9017NCP- 04/01/19 CTD

FRAMEWALK REVISIONS NCI9033NCP- 05/07/19 - CTD

DIVISION REVISIONS
NC20012NCP- 01/29/20 · KBA


DIVISION REVISIONS NC20017NCP- 03/04/20 · KBA

240.2596-R

3.B3


SPEC. LEVEL 1 RALEIGH-DURHAM 40' SERIES

LEFT ELEVATION 'B' SCALE I/4"=I'-0" (22"X34") - I/8"=I'-0" (II"XI7")

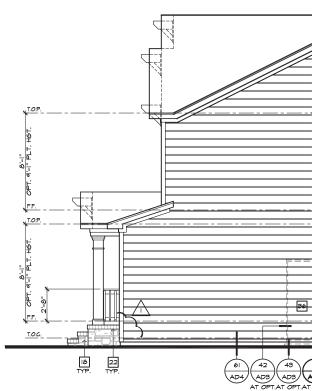


RIGHT ELEVATION 'B' AT CRAWL SPACE

SCALE 1/4"=1'-0" (22"X34") - 1/8"=1'-0" (11"X17"

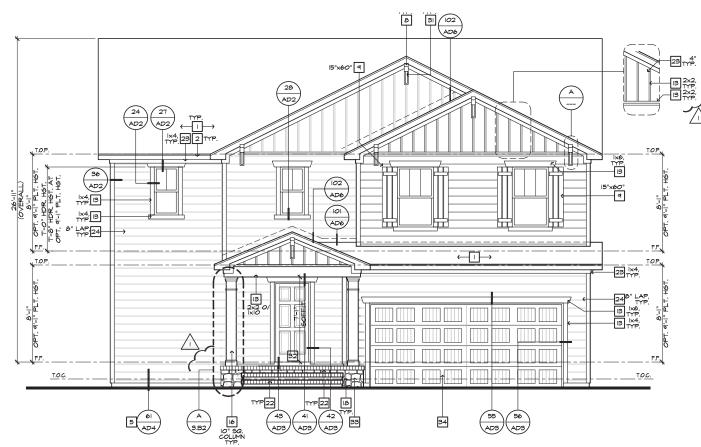


FRONT ELEVATION 'B' AT CRAWL SPACE

SCALE 1/4"=1'-0" (22"X34") - 1/8"=1'-0" (11"XIT"

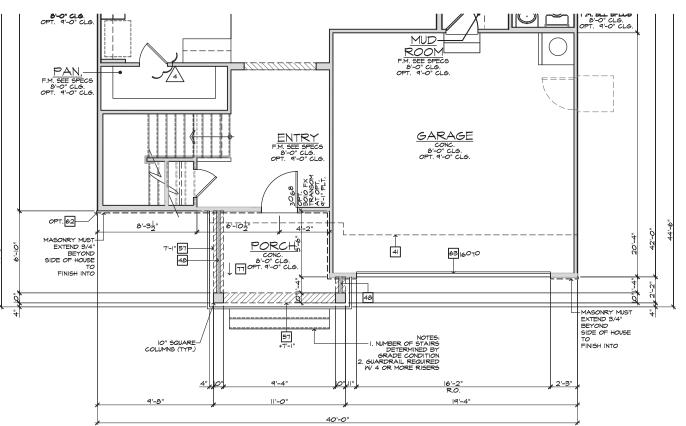


PARTIAL FIRST FLOOR PLAN 'B' AT CRAWL SPACE

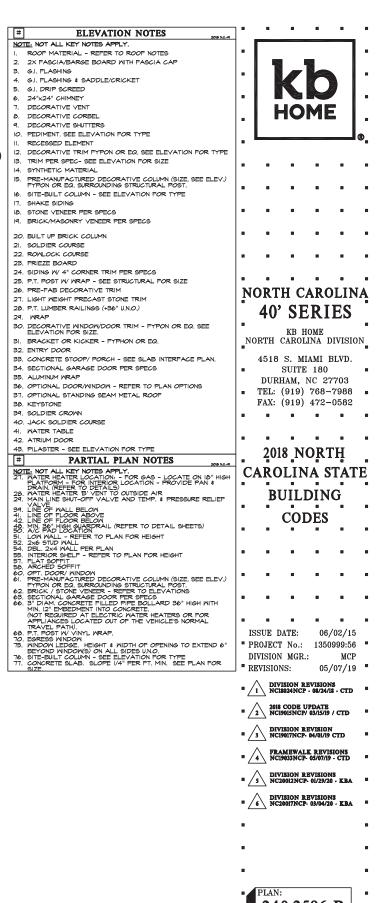

240.2596-R 3.**B**4

SPEC. LEVEL 1 NOTE: REFER TO BASIC <u>ELEVATIONS</u> FOR INFORMATION NOT SHOWN HERE RALEIGH-DURHAM 40' SERIES

NOTE: REFER TO BASIC FLOOR PLAN FOR INFORMATION NOT SHOWN HERE

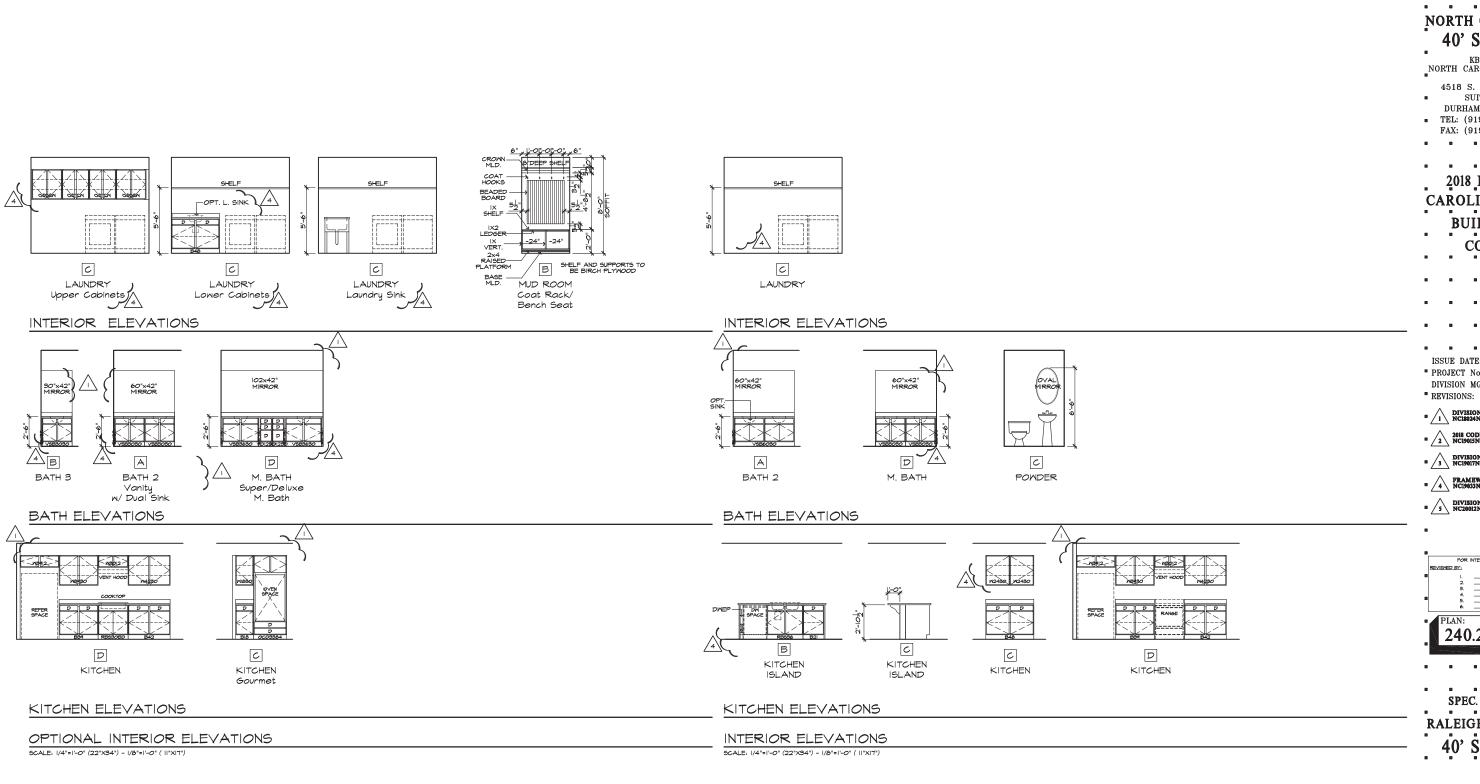



NORTH CAROLINA 40' SERIES


KB HOME NORTH CAROLINA DIVISION

4518 S. MIAMI BLVD. SUITE 180 DURHAM, NC 27703 ■ TEL: (919) 768-7988 ■ FAX: (919) 472-0582

2018 NORTH **CAROLINA STATE** BUILDING CODES


- ISSUE DATE: ■ PROJECT No.: 1350999:56 ■ DIVISION MGR.: MCP
- 05/07/19 DIVISION REVISIONS NCISE24NCP - 08/24/18 - CTD

- FRAMEWALK REVISIONS NC19033NCP- 05/07/19 CTD
- DIVISION REVISIONS
 NC20012NCP- 01/29/20 · KBA

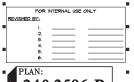

240.2596-R


4.1

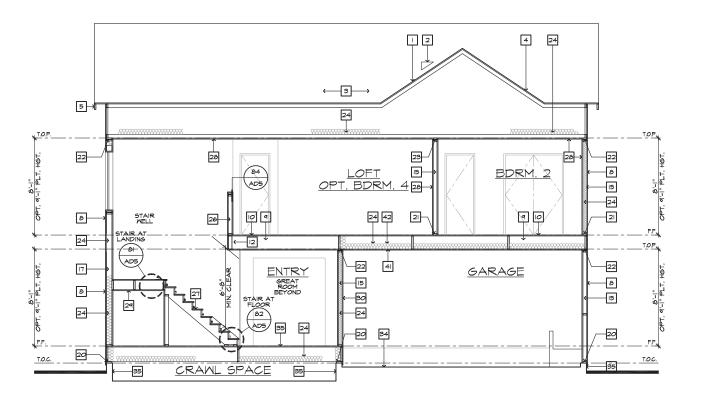

SECTION "A"

SCALE |/4"=|'-0" (22"X34") - |/8"=|'-0" (||"X|7")

AT CRAWL SPACE

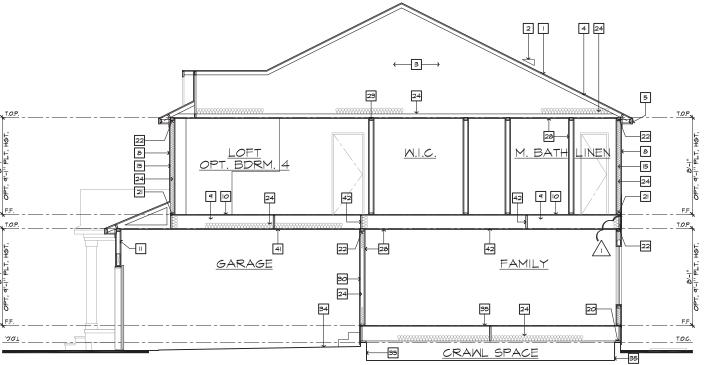

SECTION "B"

SCALE I/4"=1'-0" (22"X34") - I/6"=1'-0" (II"XI7")

SECTION NOTES

SECTION I

ROOF MATERIAL - REFER TO ROOF NOTES ROOF PITCH - REFER TO ROOF NOTES

2. PRE-MANUFACTURED WOOD ROOF TRUSS SYSTEM - SEE STRUCTURAL & TRUSS CALCS

4. ROOF SHEATHING PER STRUCTURAL

5. 2x FASCIA/BARGE BOARD

6. CONT. SOFFITED EAVE W/ VENTING

G.I. FLASHING - ROOF TO WALL

8. EXTERIOR FINISH PER ELEVATIONS

1. FLOOR FRAMING PER STRUCTURAL IO. FLOOR SHEATHING PER STRUCTURAL

II. HEADER PER STRUCTURAL

12. FLUSH BEAM PER STRUCTURAL

IS. DROPPED BEAM PER STRUCTURAL

14. FLAT/ ARCHED SOFFIT PER PLAN 15. 2x4 STUD WALL

I6. 2x6 STUD WALL

17. 2x6 BALLOON FRAMED WALL PER STRUCTURAL

18. DBL. 2x4 WALL PER PLAN

I9. 2x CRIPPLES @ I6" O.C. 20. 2x PRESSURE TREATED SILL PLATE

2I. 2x SOLE PLATE

22. DBL. 2x TOP PLATE @ EXTERIOR & BEARING WALLS 23. IX OVER 2X TOP PLATE @ INTERIOR & NON-BEARING WALLS

24. INSULATION MATERIAL PER ENERGY CALCULATIONS

25. MIN. 36" HIGH GUARD - SEE PLAN FOR HEIGHT 26. LOW WALL - SEE PLAN FOR HEIGHT

27. STAIR TREADS AND RISERS PER PLAN: - MIN. IO" TREAD & MAX, 7 3/4" RISER

& MAA. 1 DIF RIDER

28. INTERIOR FINISH. - MIN. 1/2" GYP. BD. @ WALLS & SAG
RESISTANT OR 5/8" DRYWALL @ CEILING

29. MIN. 1/2" GYP. BD. ON CEILING & WALLS @ USEABLE SPACE UNDER STAIRS.

30. GARAGE SHALL BE SEPARATED FROM THE RESIDENCE AND ITS ATTIC AREA BY NOT LESS THAT 1/2" GYP. BD. @ GARAGE SIDE WALLS & 5/8" UNDER LIVING AREA U.N.O.

31. MATERIAL TO UNDERSIDE OF ROOF SHEATHING 32. INTERIOR SHELF - MIN. I/2" GYP. BD. OVER 3/8" PLY WD.

33. CONCRETE PATIO/ PORCH SLAB PER STRUCTURAL - SLOPE I/4" PER FT. MIN.

34. CONCRETE GARAGE SLAB PER STRUCTURAL - SLOPE 2" MIN.

35. CONCRETE FOUNDATION PER STRUCTURAL 36. LINE OF OPTIONAL TRAY CEILING STEP CEILING

37. LINE OF OPTIONAL VOLUME CEILING 38. PROFILE OF OPTIONAL COVERED PATIO

39. EXTERIOR SOFFIT MATERIAL - REFER TO ELEVATIONS 40. 8" BLOCK WALL

CEILING

2, WHEN THERE IS USABLE SPACE ABOVE AND BELOW THE
CONCEALED SPACE OF A FLOOR-CEILING ASSEMBLY IN A
SINGLE-FAMILY DWILLING, DRAFT STOPPS SHALL BE INSTALLET
SO THAT THE AREA OF THE CONCEALED SPACE DOES NOT
EXCEED JOOD SQUARE FEET. DRAFTSTOPPING SHALL DIVIDE
THE CONCEALED SPACE INTO APPROXIMATELY EGGIAL AREAS.

HOME

NORTH CAROLINA 40' SERIES

KB HOME NORTH CAROLINA DIVISION

4518 S. MIAMI BLVD. SUITE 180 DURHAM, NC 27703 TEL: (919) 768-7988 • FAX: (919) 472-0582

2018 NORTH **CAROLINA STATE** BUILDING CODES

ISSUE DATE: 06/02/15 ■ PROJECT No.: 1350999:56 ■ DIVISION MGR.: MCP

05/07/19 REVISIONS: DIVISION REVISIONS
NCIS024NCP · 08/24/18 · CTD

2018 CODE UPDATE NCI9015NCP/ 03/15/19 / CTD

DIVISION REVISION
NCI9017NCP- 04/01/19 CTD


FRAMEWALK REVISIONS NCI9033NCP- 05/07/19 - CTD DIVISION REVISIONS
NC20012NCP- 01/29/20 · KBA




240.2596-R

4.3 SPEC. LEVEL 1

RALEIGH-DURHAM 40' SERIES

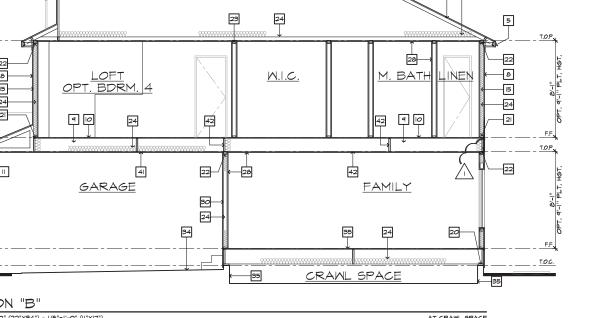


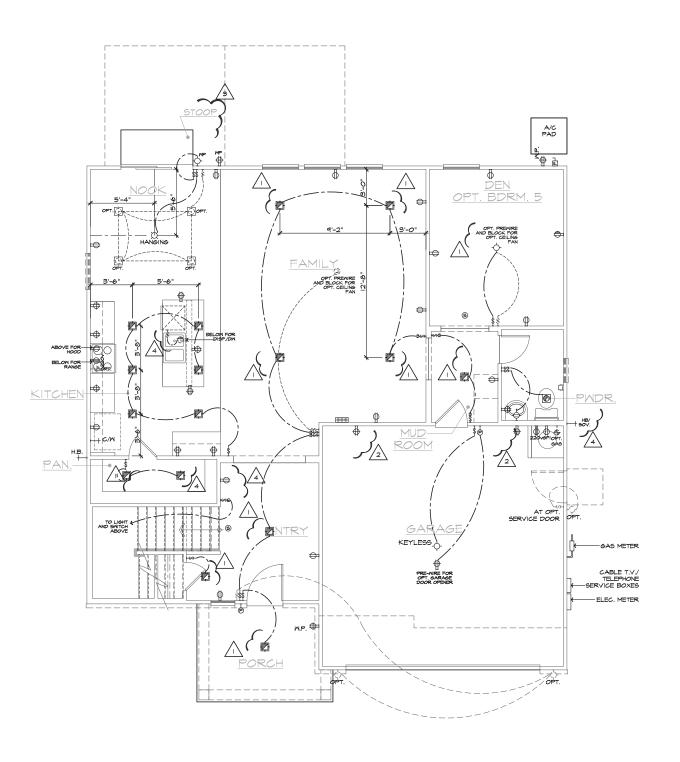

FIRST FLOOR UTILITY PLAN

SCALE |/4"=|'-0" (22"X34") - |/8"=|'-0" (||"X|7")


UTILITY LEGEND 120V DUPLEX CONVENIENCE RECEPTACLE ARC FAULT(AFCI) AND TAMPER RESISTANT(TR) 12" ABV. FIN. FLR. TYPICAL U.N.O. HE WP 6F1 120V (TR) RECEPTACLE W/ 6F1 CIRCUIT W/ WATER RESISTANT HOUSING ⊕ 6FI 120v (TR) RECEPTACLE W 6FI CIRCUIT ㅁ HOME FUSED DISCONNECT 0 120v (AFCI & TR) RECESSED FLOOR RECEPTACLE W COVER 120v (AFCI & TR) DUPLEX CONVENIENCE RECEPTACLE SMITCH CONTROLLED, 1/2 HOT \Box \Longrightarrow 220 v SINGLE CONVENIENCE RECEPTACLE HEIGHT NOTED AS PER PLAN TWO-POLE LIGHT SWITCH AT 42" ABV. FIN. FLR. 8" ABOVE COUNTER U.N.O. THREE-POLE LIGHT SWITCH 169- 4 FOUR-POLE LIGHT SWITCH WALL MOUNTED LIGHT FIXTURE W/ WATER RESISTANT HOUSING ₩.P. ф WALL MOUNTED INCANDESCENT LIGHT FIXTURE WALL MOUNTED FLUORESCENT LIGHT FIXTURE **\(\rightarrow \)** CEILING MOUNTED INCANDESCENT LIGHT FIXTURE CEILING MOUNTED FLUORESCENT LIGHT FIXTURE NORTH CAROLINA HANGING INCANDESCENT LIGHT FIXTURE Ø 40' SERIES RECESSED INCANDESCENT DIRECTIONA LIGHT FIXTURE (EYE BALL) KB HOME \bigcirc RECESSED INCANDESCENT LIGHT FIXTURE NORTH CAROLINA DIVISION LIGHTING - TRAVERSE II LED FIXTURE - PER SPECS 4518 S. MIAMI BLVD. RECESSED INCANDESCENT LIGHT FIXTURE W/ WATER RESISTANT HOUSING SUITE 180 ⋈.P. DURHAM, NC 27703 RECESSED FLUORESCENT LIGHT FIXTURE TEL: (919) 768-7988 RECESSED EXHAUST FAN FAX: (919) 472-0582 RECESSED EXHAUST FAN/ INCANDESCENT LIGHT COMBINATION © (P RECESSED EXHAUST FAN/ FLUORESCENT LIGHT COMBINATION INCANDESCENT WALL SCONCE 2018 NORTH ILLUMINATED ADDRESS SIGN - VISIBLE FROM STREET **CAROLINA STATE** BUILDING CODES OPTIONAL PRE-MIRED CEILING FAN AND SMITCH - LOCATED IN CENTER OF ROOM U.N.O. € $\vdash \bigcirc$ WALL MOUNTED JUNCTION BOX 888 DOOR CHIME ISSUE DATE: 06/02/15 +CATY RECEPTACLE PROJECT No.: 1350999:56 H® PUSH BUTTON DIVISION MGR.: MCP REVISIONS: 05/07/19 SERVICE BOX DIVISION REVISIONS NCIS024NCP - 08/24/18 - CTD HOSE BIB W/ S.O.V. 2018 CODE UPDATE NCI9015NCP/ 03/IS/I9 / CTD WATER STUB FOR ICE MAKER APPROVED CEILING MOUNTED
SMOKE DETECTOR TO BE HARD WIRED
WITH BATTERY BACK-UP AND INTERCONNECTED DIVISION REVISION
NCI9017NCP- 04/01/19 CTD APPROVED CARBON MONOXIDE ALARM/ SMOKE DET. FRAMEWALK REVISIONS NCI9033NCP- 05/07/19 - CTD HT THERMOSTAT (VERIFY LOCATION W/ HVAC PLAN) + GAS TAP DIVISION REVISIONS
NC20012NCP- 01/29/20 - KBA SWITCHING FOR ROOMS W/ CLG. FAN OPTIONS 24" MIN. SEPERATION OF ELECTRICAL BOXE AS SHOWN BELOW DWELLING REVIEWED BY: 2'-0" GFI \$ \$ \$ \$ SECONDARY MASTER NOTES MECHANICAL, ELECTRICAL, AND PLUMBING SYSTEMS ARE SHOWN FOR INTENT ONLY. THESE SYSTEMS SHALL BE ENGINETED BY OTHERS. THE CONTRACTOR SHALL BE RESPONSIBLE FOR PROPER INSTALLATION AND PLACEMENT, ALL HEIGHTS SHOWN ARE TO CENTERLINE OF FIXTURE. 240.2596-R SHEET: 5.1 SPEC. LEVEL 1 20 FOOT #4 REBAR FOR UFER GROUND AND ADDITIONAL COLD WATER GROUND, REFER TO SLAB INTERFACE PLAN FOR LOCATION. RALEIGH-DURHAM 200 AMP ELECTRICAL PANEL (DEFAULT). ELECTRICAL PLAN CHECK PERMIT REQUIRED IF LOAD EXCEED 400 AMPS. 40' SERIES

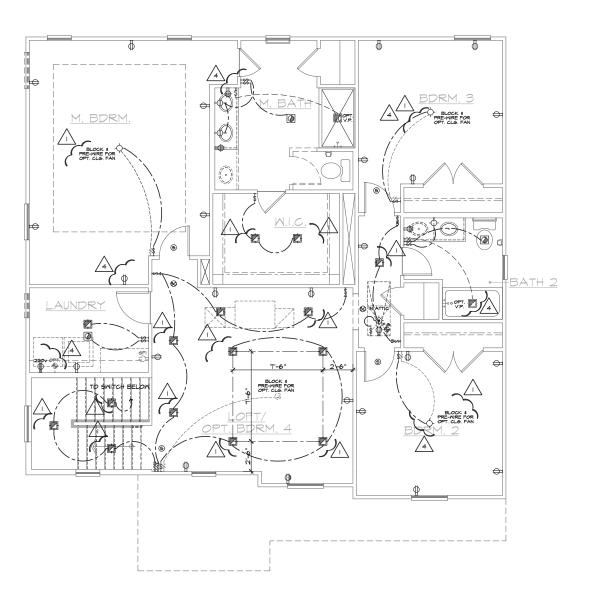



SECOND FLOOR UTILITY PLAN

SCALE I/4"=1'-0" (22"X34") - I/8"=1'-0" (II"XI7")

BASIC PLAN

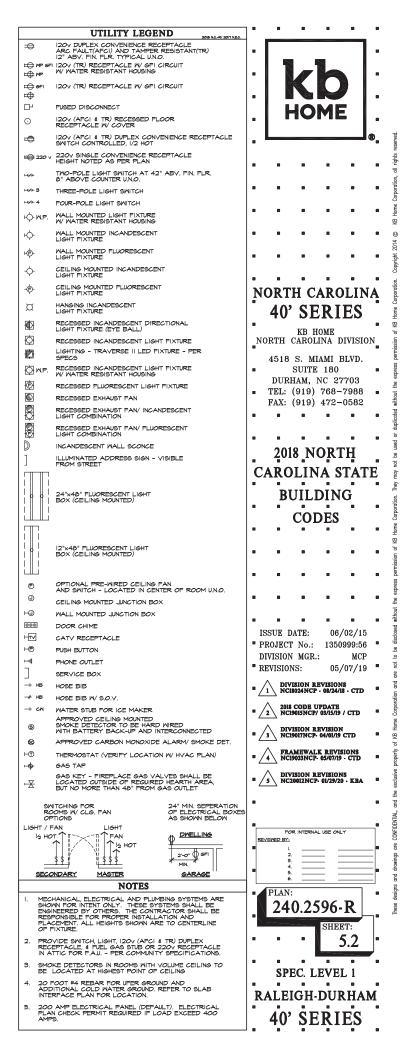

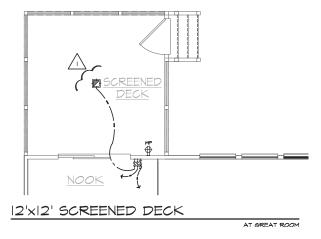


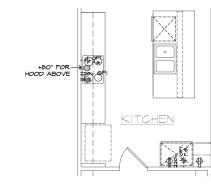


ISLAND

AT KITCHEN

FIRST FLOOR UTILITY PLAN OPTIONS SCALE I/4"=I'-0" (22"X34") - I/8"=I'-0" (II"XI7")

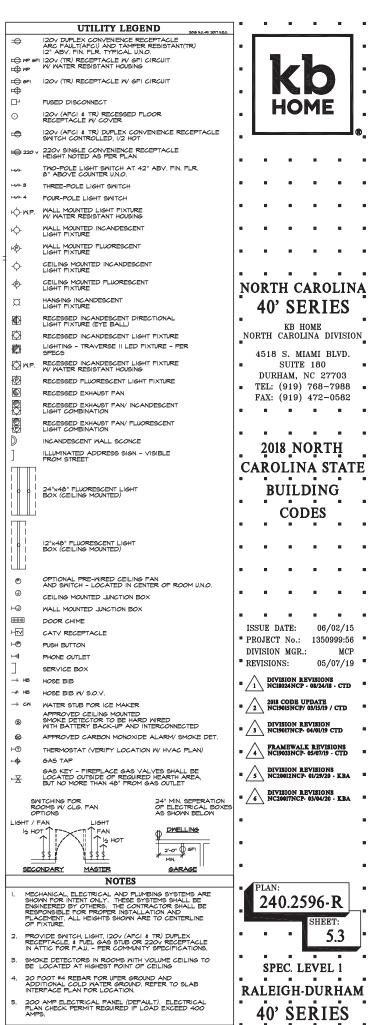


BASIC PLAN

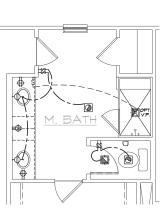



SECOND FLOOR UTILITY PLAN OPTIONS

96ALE I/4"=!"-0" (22"x34") - I/8"=!"-0" (II"XIT")

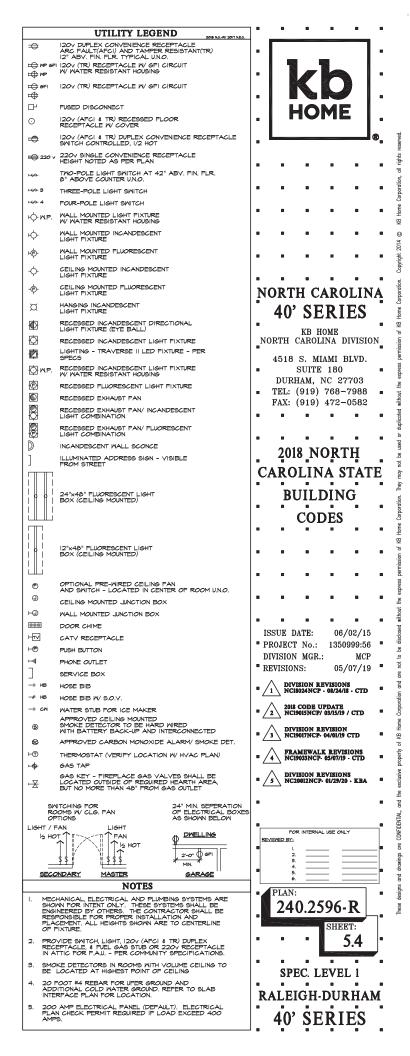

ELEVATION NOTES NOTE: NOT ALL KEY NOTES APPLY. ROOF MATERIAL - REFER TO ROOF NOTES 2. 2X FASCIA/BARGE BOARD WITH FASCIA CAP 3. G.I. FLASHING 4. G.I. FLASHING & SADDLE/CRICKET 5. G.I. DRIP SCREED 6. 24"x24" CHIMNEY 7. DECORATIVE VENT 8. DECORATIVE CORBEL 9. DECORATIVE SHUTTERS IO. PEDIMENT. SEE ELEVATION FOR TYPE II. RECESSED ELEMENT 12. DECORATIVE TRIM FYPON OR EQ. SEE ELEVATION FOR TYPE IS. TRIM PER SPEC- SEE ELEVATION FOR SIZE 14. SYNTHETIC MATERIAL 15. PRE-MANUFACTURED DECORATIVE COLUMN (SIZE, SEE ELEV.) FYPON OR EQ. SURROUNDING STRUCTURAL POST. 16. SITE-BUILT COLUMN - SEE ELEVATION FOR TYPE IT. SHAKE SIDING 18. STONE VENEER PER SPECS 19. BRICK/MASONRY VENEER PER SPECS 20. BUILT UP BRICK COLUMN 21. SOLDIER COURSE 22. ROWLOCK COURSE 23. FRIEZE BOARD 24. SIDING W/ 4" CORNER TRIM PER SPECS 25. P.T. POST W WRAP - SEE STRUCTURAL FOR SIZE 26. PRE-FAB DECORATIVE TRIM 27. LIGHT WEIGHT PRECAST STONE TRIM 28. P.T. LUMBER RAILINGS (+36" U.N.O.) 30. DECORATIVE WINDOW/DOOR TRIM - FYPON OR EQ. SEE ELEVATION FOR SIZE. 31. BRACKET OR KICKER - FYPHON OR EQ. 32. ENTRY DOOR 33. CONCRETE STOOP/ PORCH - SEE SLAB INTERFACE PLAN. 34. SECTIONAL GARAGE DOOR PER SPECS 35. ALUMINUM WRAP 36. OPTIONAL DOOR/WINDOW - REFER TO PLAN OPTIONS 37. OPTIONAL STANDING SEAM METAL ROOF 38. KEYSTONE 39. SOLDIER CROWN 40. JACK SOLDIER COURSE 41. WATER TABLE 42. ATRIUM DOOR 43. PILASTER - SEE ELEVATION FOR TYPE PARTIAL PLAN NOTES

PARTIAL PLAN NOTES NOTE: NOT ALL KEY NOTES APPLY 21. MATER HEATER LOCATION: - FOR GAS - LOCATE ON 10° HIGH PLATFORM: - FOR INTERIOR LOCATION: - PROVIDE PAN 4 DRAIN, (REFER TO DETAILS) 22. MATER HEATER BY OPEN TO OUTSIDE AIR 21. MAIN LINE SHUT-OFF VALVE AND TEMP. 4 PRESSURE RELIEF 34. LINE OF MAIL BELOW 34. LINE OF FLOOR BELOW 42. LINE OF FLOOR BELOW 43. MIN. SQLTHICH GAMAD PRAIL (REFER TO DETAIL SHEETS) 53. LOW WALL - REFER TO PLAN FOR HEIGHT 54. DBL. 2x4 WALL PER PLAN 55. INTERIOR SHELF - REFER TO PLAN FOR HEIGHT 57. FLAT SOFFIT 60. OPT. DOOR MINDOW 61. PREVMANT FOR RED DECORATIVE COLUMN (SIZE, SEE ELEV.) 62. SECOND WALL 63. SECTIONAL GARRED DECORATIVE COLUMN (SIZE, SEE ELEV.) 64. SECTIONAL GARRED DECORATIVE COLUMN (SIZE, SEE ELEV.) 65. ST DIAM CONCRETE FILLED PIPE BOLLARD 36° HIGH WITH MIN 12° EMBEDWENT INTO CONCRETE. (NOT REGUIRED AT ELECTRIC WATER HEATERS OR FOR APPLIANCES LOCATED OUT OF THE VEHICLE'S NORMAL 67. TRAVEL PATH). 68. PRINCES MINDOW 69. PRINCON LEDGE. HEIGHT 4 WIDTH OF OPENING TO EXTEND 6° BEYOND WINDOW (S) ON ALL SIDES UNO. 16. SITE-BUILT COLUMN - SEE ELEVATION FOR TYPE IN SIDE OF THE PLAN FOR BUILDING CODES

FOUNDATION P FOUNDATION PLAN NOTES

CONCRETE PATIO/PORCH SLAB PER STRUCTURAL- SLOPE I/4" PER FT. MIN. 2. CONCRETE GARAGE SLAB PER STRUCTURAL- SLOPE 1/8" PER 1'-0" MIN. TOWARD DOOR OPENING.

- 3. FOUNDATION PER STRUCTURAL. 4. STAIR LANDING: 36"x36" MIN.
- 5. CONCRETE DRIVEWAY SLOPE I/4" PER FT. MIN. AWAY FROM GARAGE DOOR OPENING.
- 6. PROVIDE UNDER FLOOR VENTILATION
- 7. 4" TOE KICK FOR MASONRY VENEER
- 3" DIAMETER CONCRETE FILLED PIPE BOLLARD 36" HIGH WITH MIN. 12" EMBEDMENT INTO CONCRETE.
- REFER TO CIVIL DRAWINGS FOR ALL FINISH SURFACE ELEVATIONS.
- IO. VERIFY LOCATION OF PIER FOOTINGS PER STRUCTURAL
- II. 4" MIN. 7 3/4" MAX. TO HARD SURFACE. 12. A/C PAD, VERIFY LOCATION.
- 13. CRAWL SPACE ACCESS
- 14. 36" WIDE WALKWAY- SLOPE 1/4" PER FT. MIN.

HOME

NORTH CAROLINA 40' SERIES KB HOME

NORTH CAROLINA DIVISION

4518 S. MIAMI BLVD. SUITE 180 DURHAM, NC 27703 TEL: (919) 768-7988 = FAX: (919) 472-0582

. 2018 NORTH **CAROLINA STATE**

ISSUE DATE: 06/02/15 PROJECT No.: 1350999:56 DIVISION MGR.: MCP REVISIONS: 05/07/19

DIVISION REVISIONS
NCIS024NCP · 08/24/18 · CTD

2018 CODE UPDATE NCI90I5NCP/ 03/I5/I9 / CTD

DIVISION REVISION NCI9017NCP- 04/01/19 CTD

FRAMEWALK REVISIONS NCI9033NCP- 05/07/19 - CTD

DIVISION REVISIONS NC20012NCP- 01/29/20 - KBA

FOR INTERNAL USE ONLY


240.2596-R SHEET:

7.1

NOTE: REFER TO BASIC <u>ELEVATIONS</u> FOR INFORMATION NOT SHOWN HERE


NOTE: REFER TO BASIC FLOOR PLAN FOR INFORMATION NOT SHOWN HERE

REFER TO SHEET 7.1 FOR NOTES NOT SHOWN HERE

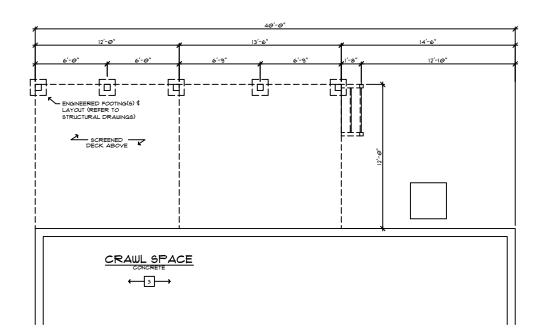


PARTIAL FIOUNDATION PLAN

SCALE: 1/4"=1'-0" (22"×34") - 1/8"=1'-0" (11"×17")

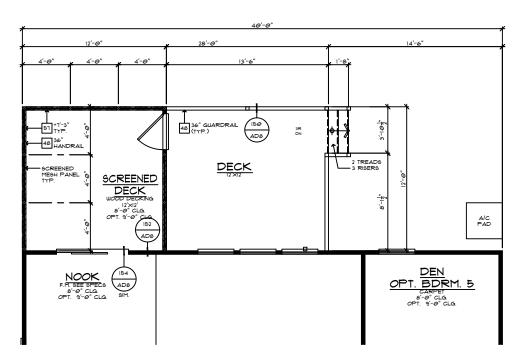

PARTIAL FIRST FLOOR PLAN

SCALE: 1/4"=1'-0" (22"×34") - 1/8"=1'-0" (11"×17")

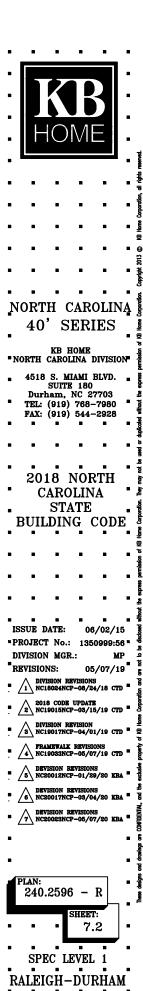





INDICATES ROOF SLOPE AND DIRECTION, U.N.O.

ROOF MATERIAL: COMPOSITION SHINGLE

12" (INCHES) TYPICAL ROOF OVERHANG AT RAKE, U.N.O. 12" (INCHES) TYPICAL ROOF OVERHANG AT EAVE, U.N.O. LOCATE EAVE/ RAFTER VENTS EQUALLY BALANCED AROUND HOUSE EXCEPT ABOVE SHEARWALL PANELS.

ATTIC VENT CALCULATIONS


PROVIDE I SQ. IN. OF VENTILATION PER 300 SQ. IN. OF ATTIC SPACE. PROVIDE THAT AT LEAST 50% & NO MORE THAN 80% OF THE REQ. VENTILATING AREA IS PROVIDED BY VENTILATORS COLOCATED IN THE UPPER PORTION OF THE ATTIC, (HIGH VENTING) AT 3"-O" ABOVE EAVE VENT WITH THE BALANCE BEING PROVIDED BY EAVE VENTS, (LOW VENTING) (2018 NC.-R 806.2) % CALCULATION BY (1/50, HIGH/LOW VENTING NOT REQUIRED. APPROXIMATE RIDGE VENT LOCATIONS SHOWN. ACTUAL LOCATIONS TO BE DETERMINED IN THE FIELD.

AREA 5 / OPTIONAL I2xI2 SCREENED DECK

 VENTILATION PROVIDED.
 12 90. IN.

 (4) LIN FEET OF RIDSE VENT AT (I8 90. IN/FOOT) = 120 90. IN.
 12 90. IN.

 (24) LIN FEET OF VENTILATED SOFFIT (5 90. IN/FOOT) = 120 90. IN.
 12 90. IN.
 TOTAL VENTILATION PROVIDED:

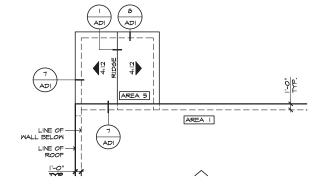

PARTIAL ROOF PLAN

SCALE |/8"=|'-0" (22"X34") - |/|6"=|'-0" (||"X|7")

ELEVATION NOTES NOTE: NOT ALL KEY NOTES APPLY. I. ROOF MATERIAL - REFER TO ROOF NOTES 2. 2X FASCIA/BARGE BOARD WITH FASCIA CAP 3. G.I. FLASHING 4. G.I. FLASHING & SADDLE/CRICKET 5. G.I. DRIP SCREED 6. 24"x24" CHIMNEY 7. DECORATIVE VENT 8. DECORATIVE CORBEL 9. DECORATIVE SHUTTERS IO. PEDIMENT. SEE ELEVATION FOR TYPE II. RECESSED ELEMENT 12. DECORATIVE TRIM FYPON OR EQ. SEE ELEVATION FOR TYPE IS. TRIM PER SPEC- SEE ELEVATION FOR SIZE 14. SYNTHETIC MATERIAL 15. PRE-MANUFACTURED DECORATIVE COLUMN (SIZE, SEE ELEV.) FYPON OR EQ. SURROUNDING STRUCTURAL POST. 16. SITE-BUILT COLUMN - SEE ELEVATION FOR TYPE IT. SHAKE SIDING 18. STONE VENEER PER SPECS 19. BRICK/MASONRY VENEER PER SPECS 20. BUILT UP BRICK COLUMN 21. SOLDIER COURSE 22. ROWLOCK COURSE 23. FRIEZE BOARD 24. SIDING W/ 4" CORNER TRIM PER SPECS 25. P.T. POST W WRAP - SEE STRUCTURAL FOR SIZE 26. PRE-FAB DECORATIVE TRIM NORTH CAROLINA 27. LIGHT WEIGHT PRECAST STONE TRIM 28. P.T. LUMBER RAILINGS (+36" U.N.O.) 30. DECORATIVE WINDOW/DOOR TRIM - FYPON OR EQ. SEE ELEVATION FOR SIZE. NORTH CAROLINA DIVISION 31. BRACKET OR KICKER - FYPHON OR EQ. 32. ENTRY DOOR 33. CONCRETE STOOP/ PORCH - SEE SLAB INTERFACE PLAN. 34. SECTIONAL GARAGE DOOR PER SPECS 35. ALUMINUM WRAP 36. OPTIONAL DOOR/WINDOW - REFER TO PLAN OPTIONS 37. OPTIONAL STANDING SEAM METAL ROOF 38. KEYSTONE 39. SOLDIER CROWN 40. JACK SOLDIER COURSE 4I. WATER TABLE 42. ATRIUM DOOR 43. PILASTER - SEE ELEVATION FOR TYPE

	,	۷Ū.	IQ "IA	UK.	ΙÜ	
# PARTIAL PLAN NOTES] C	ARC	LĪN	JA S	TAT	ľΕ
NOTE: NOT ALL KEY NOTES APPLY. 27. WATER HATER LOCATION: - FOR GAS - LOCATE ON 18" HIGH PLATFORM - FOR INTERIOR LOCATION - PROVIDE PAN & DRAIN. (REFER TO DETAILS) 28. WATER HEATER 18" VENT TO OUTSIDE AIR		В	UÏL	DİN	G	8
29. MAIN LINE SHUT-OFF VALVE AND TEMP. & PRESSURE RELIEF 94. LINE OF HALL BELON 41. LINE OF FLOOR ABOVE		•	COI	DĒS	-	-
42. LINE OF FLOOR BELOW 46. MIN. 36" HIGH GUARDRAIL (REFER TO DETAIL SHEETS) 50. AVC PAD LOCATION	•	•		•		
51. LOW WALL - REFER TO PLAN FOR HEIGHT 52. 2x6 STID WALL 54. DBL. 2x4 WALL PER PLAN 55. INTERIOR SHELF - REFER TO PLAN FOR HEIGHT	•	•	•	•		
57. FLAT SOFFIT 56. ARCHED SOFFIT 60. OPT. DOOR! NINDOM 61. PRE-MANUFACTURED DECORATIVE COLUMN (SIZE, SEE ELEV.)	•	•			•	
FYPON OR EQ. SURROUNDING STRUCTURAL POST. 62. BRICK / STONE VENEER - REFER TO ELEVATIONS 63. SECTIONAL GARAGE DOOR PER SPECS	•	•	•	•		•
66. 3" DIAM. CONCRETE FILLED PIPE BOLLARD 36" HIGH MITH MIN. 12" EMBEDMENT INTO CONCRETE. (NOT REQUIRED AT ELECTRIC MATER HEATERS OR FOR APPLIANCES LOCATED OUT OF THE VEHICLE'S NORMAL	ı IS	SSUE 1	DATE:	■ 06	■ /02/15	
TRAVEL PATH). 66. P.T. POST W WRAP, 70. EGRESS MINDOM 15. MINDOM LEDGE. HEIGHT & WIDTH OF OPENING TO EXTEND 6"	1		T No.: N MGR.		0999:56 MCP	
BEYOND MINDOW(S) ON ALL SIDES UN.O. 76. SITE-BUILT COLUMN - SEE ELEVATION FOR TYPE 77. CONCRETE SLAB. SLOPE 1/4" PER FT. MIN. SEE PLAN FOR	I	EVISIO			/07/19	
SIZE.	' • /		/ISION R 18024NCF			

DIVISION REVISIONS
NCI8024NCP · 08/24/18 · CTD 2018 CODE UPDATE NCI9015NCP/ 03/15/19 / CTD

FRAMEWALK REVISIONS NCI9033NCP- 05/07/19 - CTD

HOME

40' SERIES

KB HOME

4518 S. MIAMI BLVD.

SUITE 180

DURHAM, NC 27703

FAX: (919) 472-0582

. . . .

2010 NIODTH

TEL: (919) 768-7988 *

.

FOUNDATION P CONCRETE PATIO/PORCH SLAB PER STRUCTURAL- SLOPE I/4" PER FT. MIN. DIVISION REVISION NCI9017NCP- 04/01/19 CTD 2. CONCRETE GARAGE SLAB PER STRUCTURAL- SLOPE 1/8" PER 1'-0" MIN. TOWARD DOOR OPENING.

3. FOUNDATION PER STRUCTURAL. 4. STAIR LANDING: 36"x36" MIN. 5. CONCRETE DRIVEWAY SLOPE I/4" PER FT. MIN. AWAY FROM GARAGE DOOR OPENING.

6. PROVIDE UNDER FLOOR VENTILATION

7. 4" TOE KICK FOR MASONRY VENEER 3" DIAMETER CONCRETE FILLED PIPE BOLLARD 36" HIGH WITH MIN. 12" EMBEDMENT INTO CONCRETE.

FOUNDATION PLAN NOTES

REFER TO CIVIL DRAWINGS FOR ALL FINISH SURFACE ELEVATIONS. IO. VERIFY LOCATION OF PIER FOOTINGS PER STRUCTURAL

II. 4" MIN. 7 3/4" MAX. TO HARD SURFACE.

12. A/C PAD, VERIFY LOCATION.

13. CRAWL SPACE ACCESS

14. 36" WIDE WALKWAY- SLOPE 1/4" PER FT. MIN


240.2596-R SHEET:


7.3

<u>NOTE:</u> REFER TO BASIC <u>ELEVATIONS</u> FOR INFORMATION NOT SHOWN HERE

NOTE: REFER TO BASIC FLOOR PLAN FOR INFORMATION NOT SHOWN HERE


REFER TO SHEET 7.3 FOR NOTES NOT SHOWN HERE

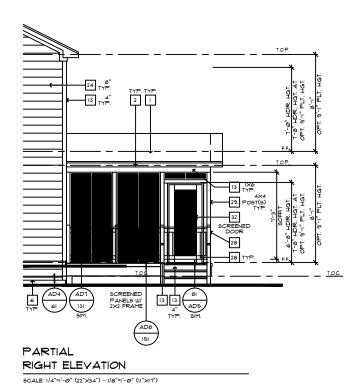

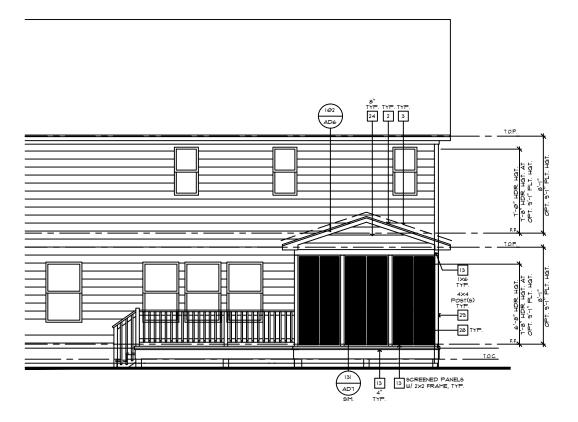

PARTIAL REAR ELEVATION

SCALE: 1/4"=1'-0" (22"×34") - 1/8"=1'-0" (11"×17")

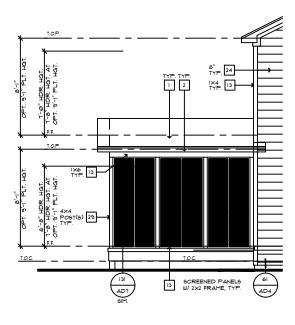

PARTIAL LEFT ELEVATION

9CALE: 1/4"=1'-0" (22"×34") - 1/8"=1'-0" (11"×17")



NORTH CAROLINA 40' SERIES

KB HOME NORTH CAROLINA DIVISION

4518 S. MIAMI BLVD. SUITE 180 Durham, NC 27703 TEL: (919) 768-7980 FAX: (919) 544-2928

2018 NORTH CAROLINA STATE BUILDING CODE

ISSUE DATE: 06/02/15
PROJECT No.: 1350999:56
DIVISION MGR.: MP

2018 CODE UPDATE 2 NC19015NCP-03/15/19 CTD

DIVISION REVISION
NC19017NCP-04/01/19 CTD


FRAMEWALK REVISIONS NC19033NCP-05/07/19


DEVISION REVISIONS
NC20012NCP-01/29/20 KBA


DEVISION REVISIONS


DEVISION REVISIONS
NC20023NCP-05/07/20 KBA


" <u>/ 7\</u> NC20023NCP-05/07/20

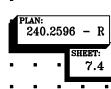


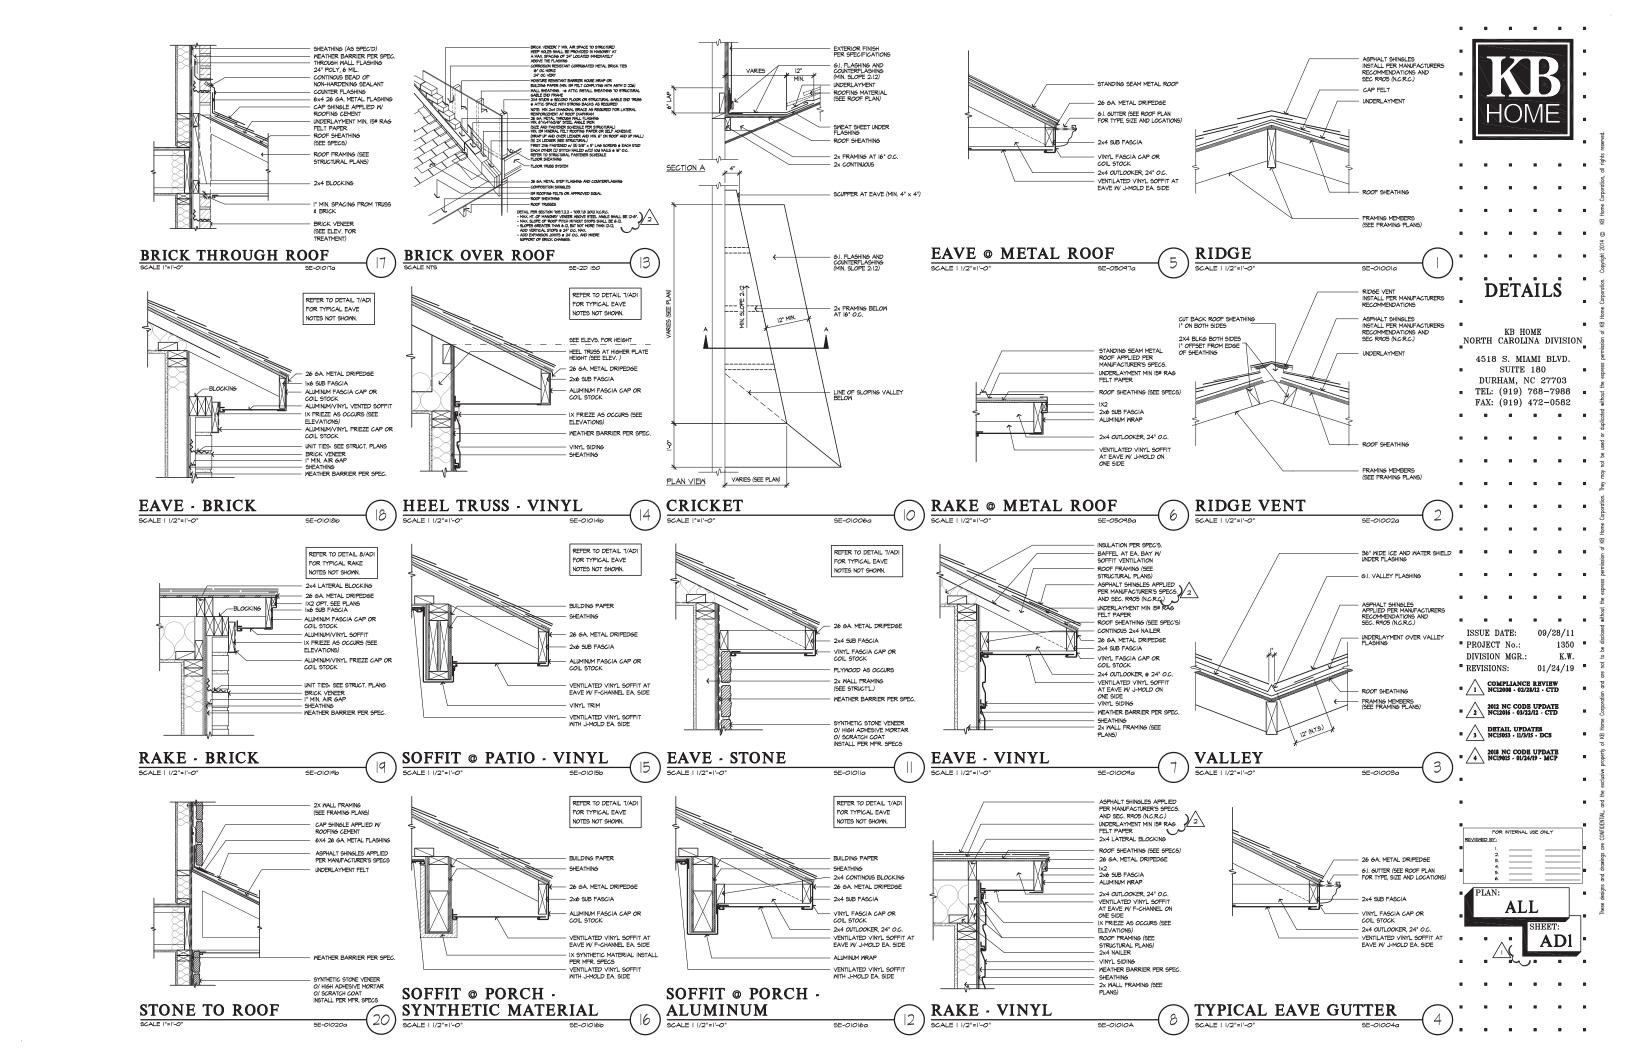


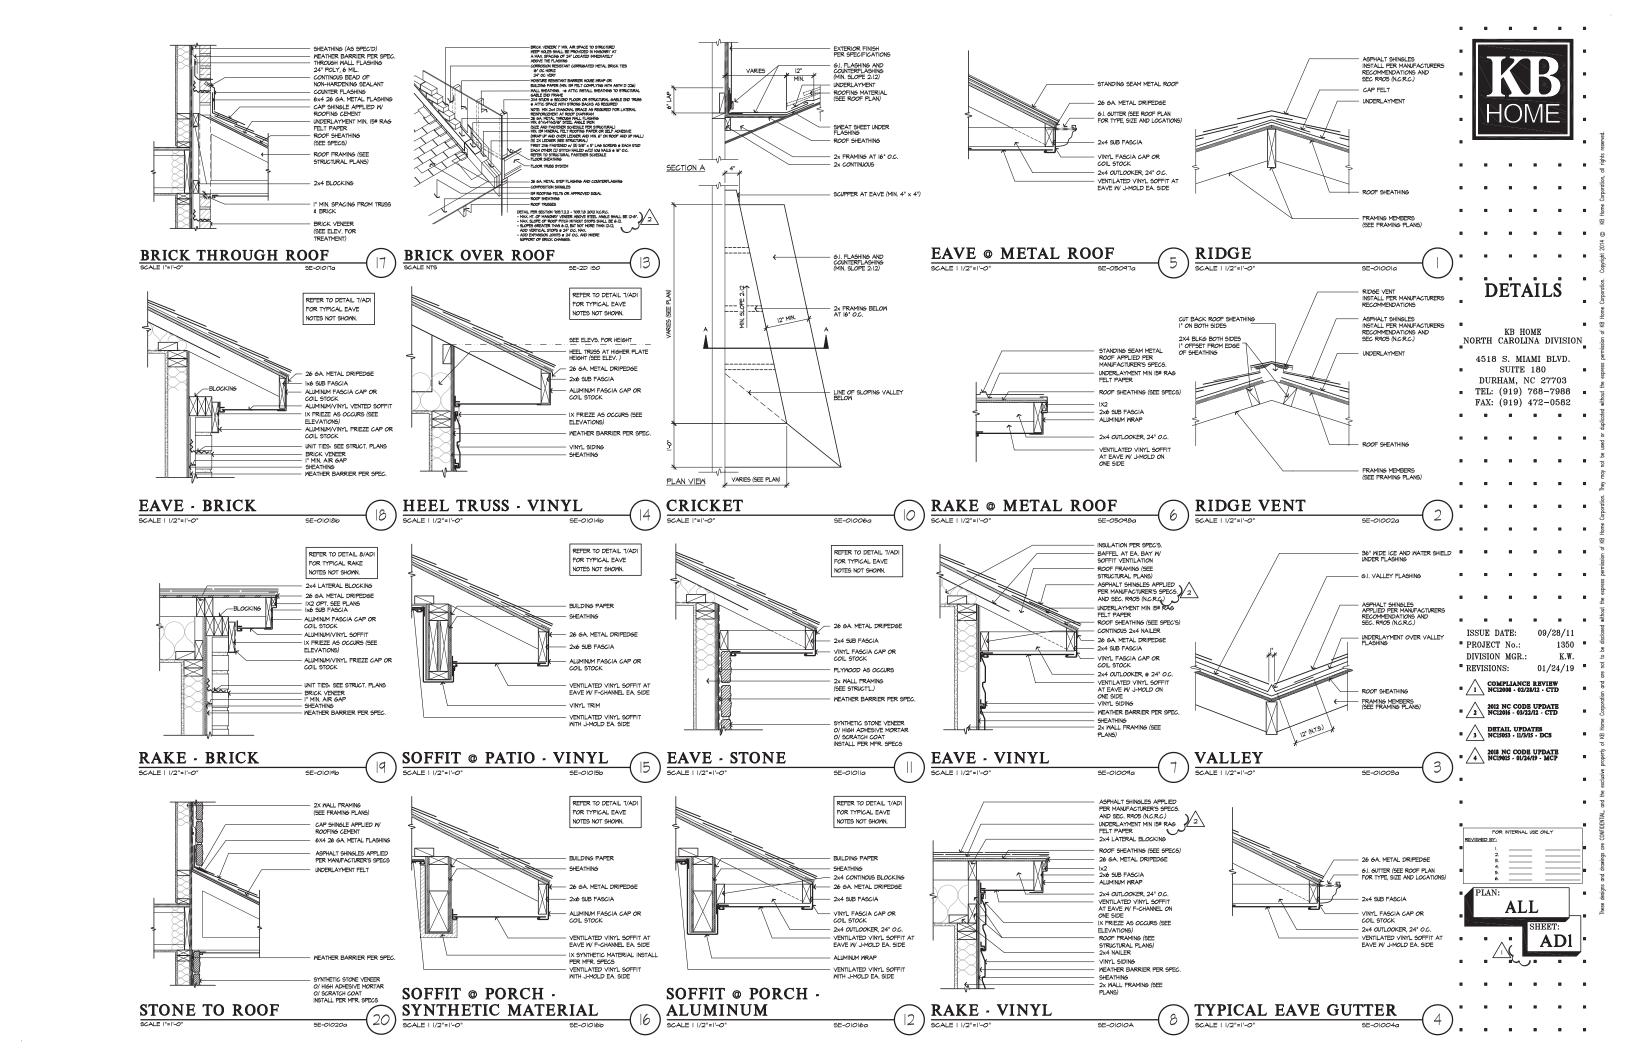


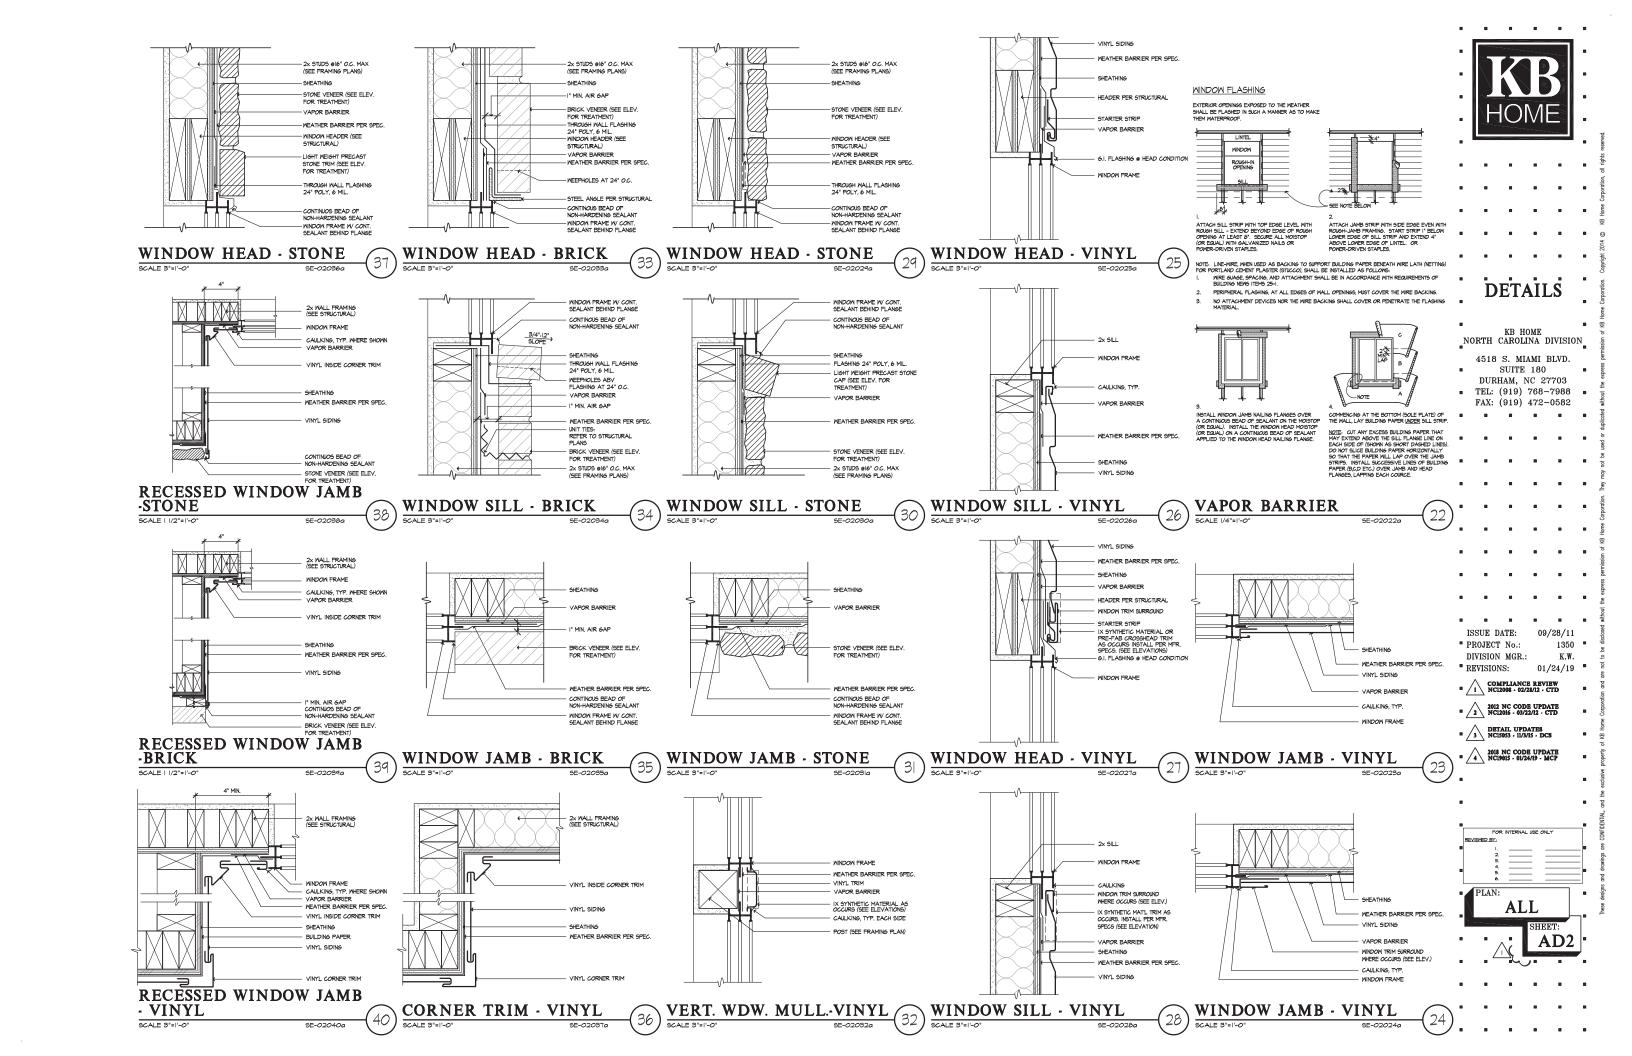


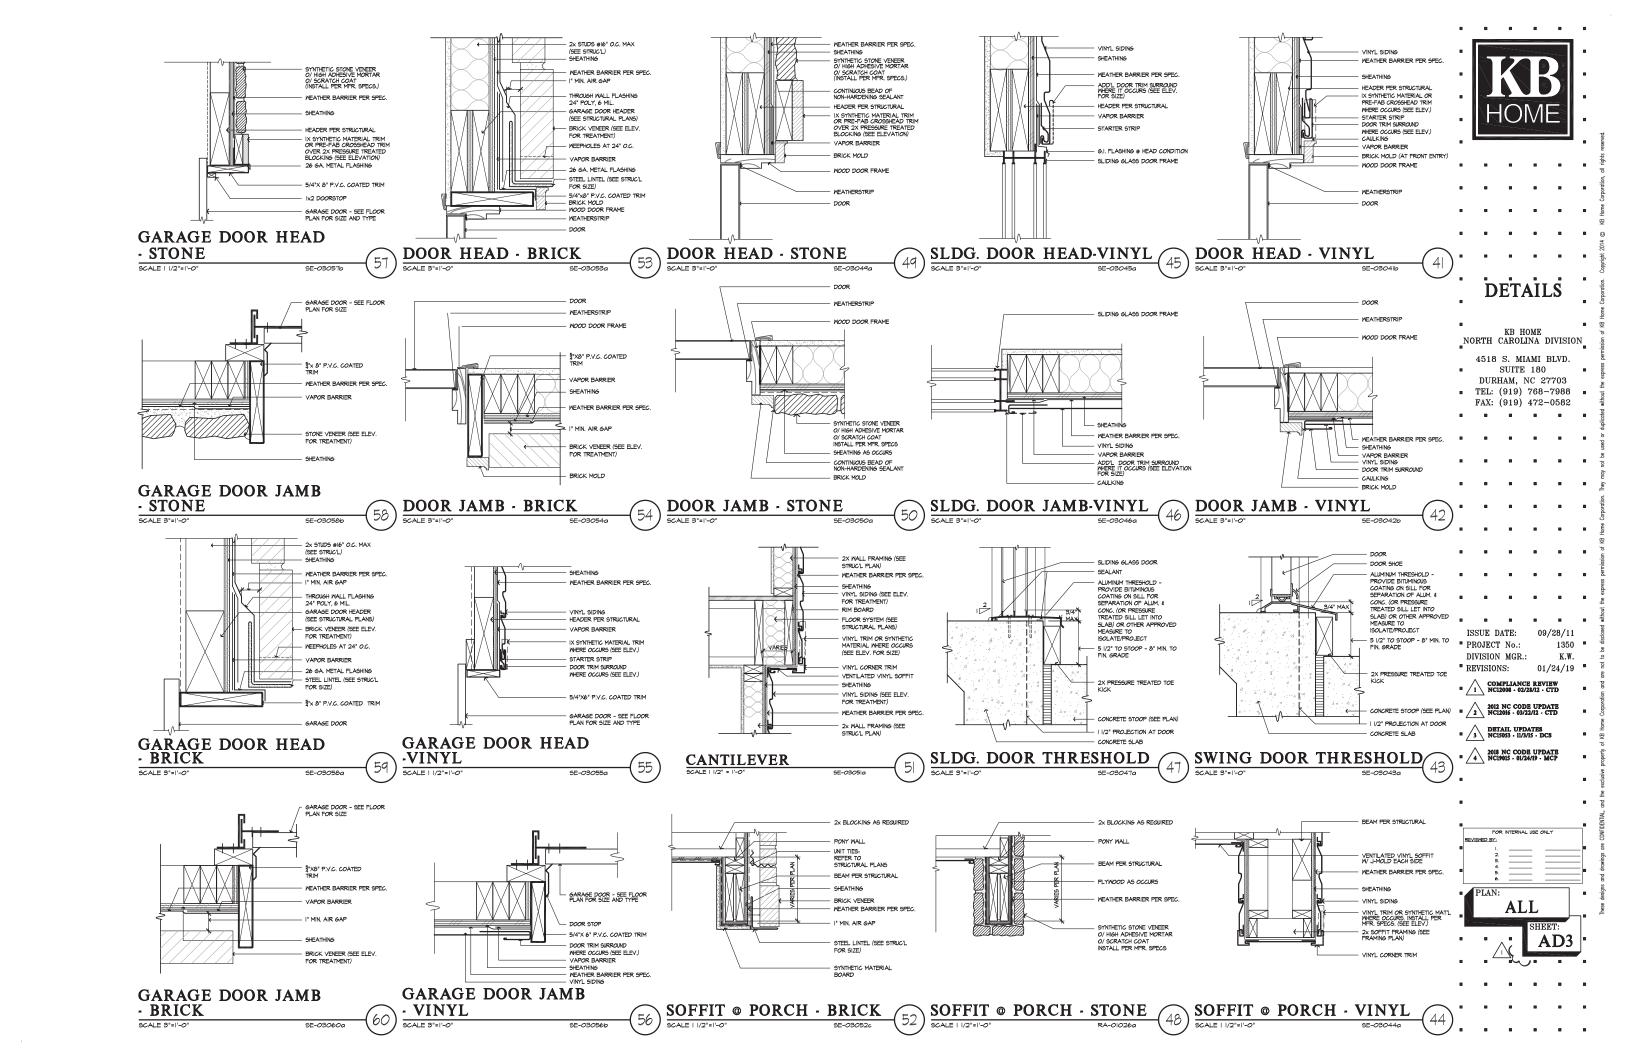

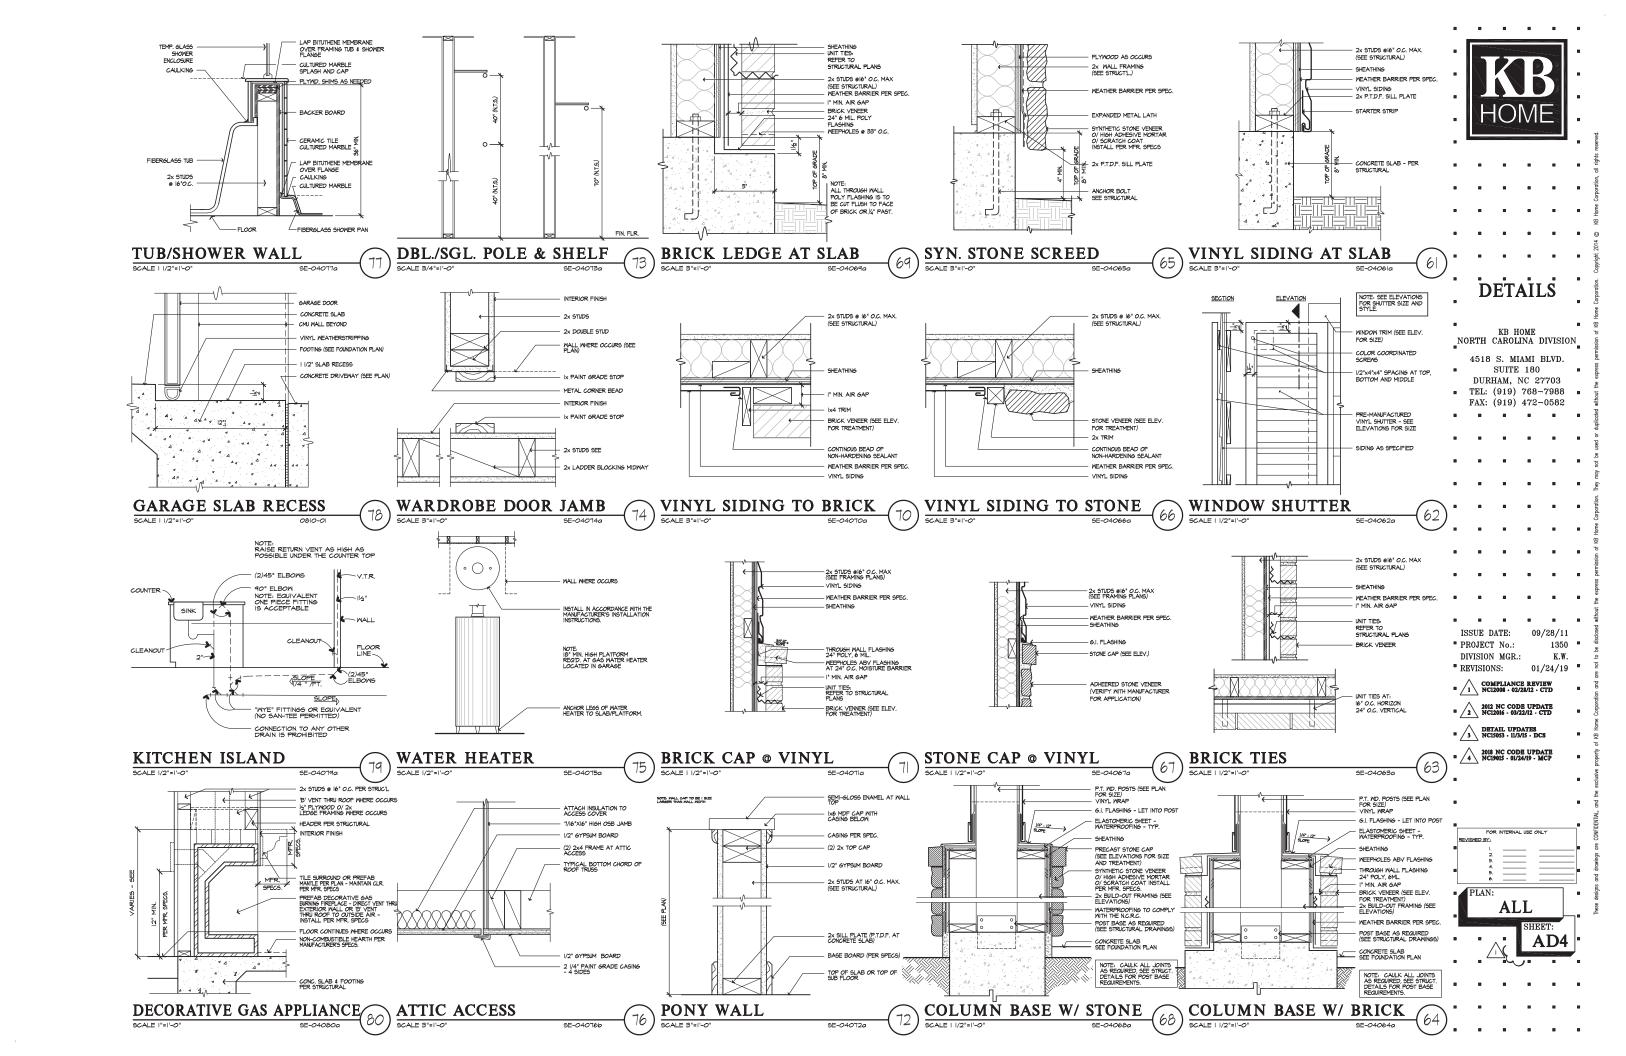

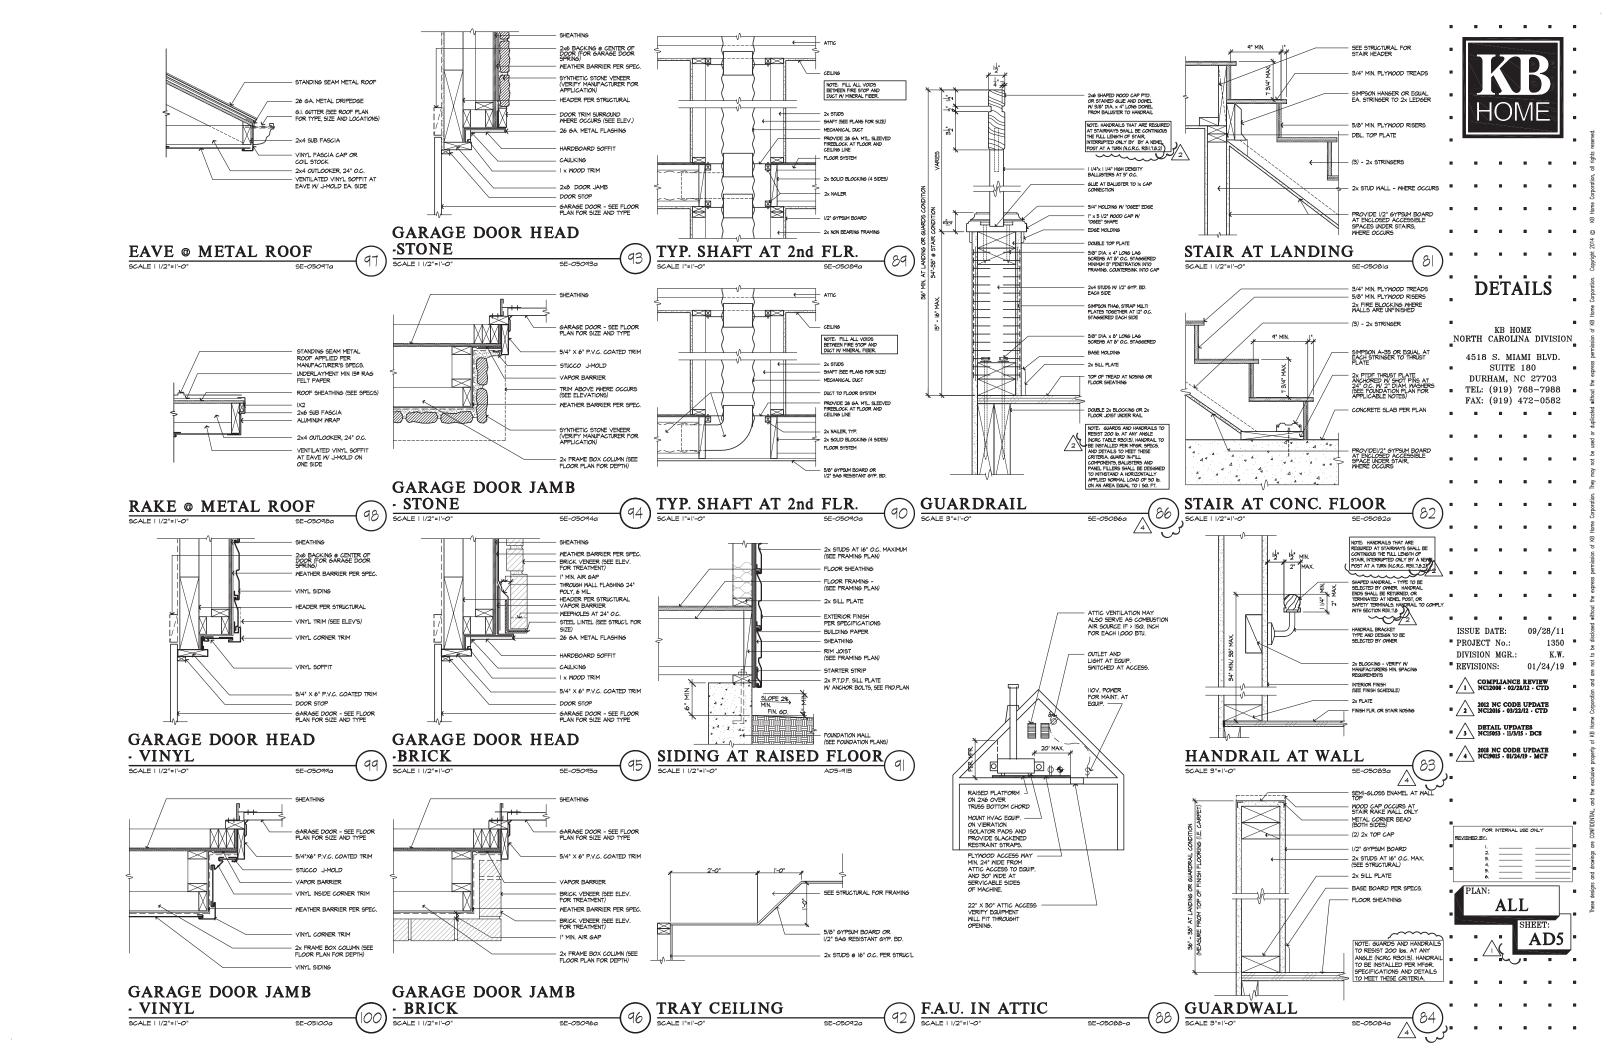


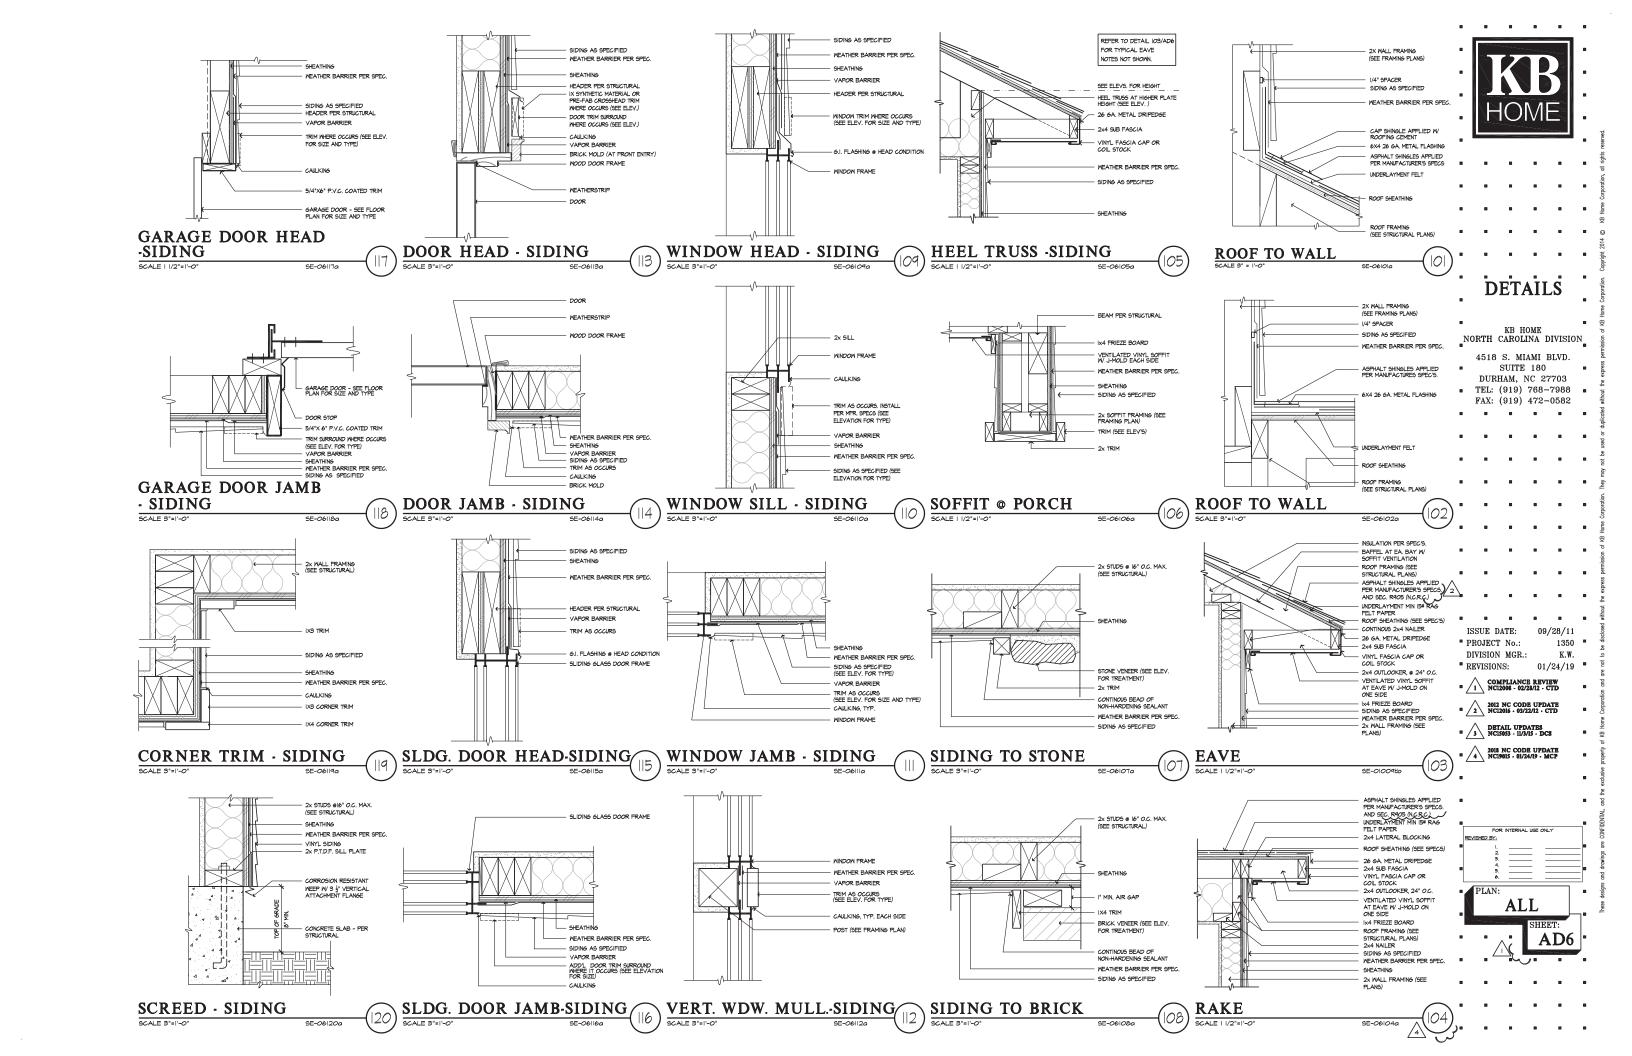


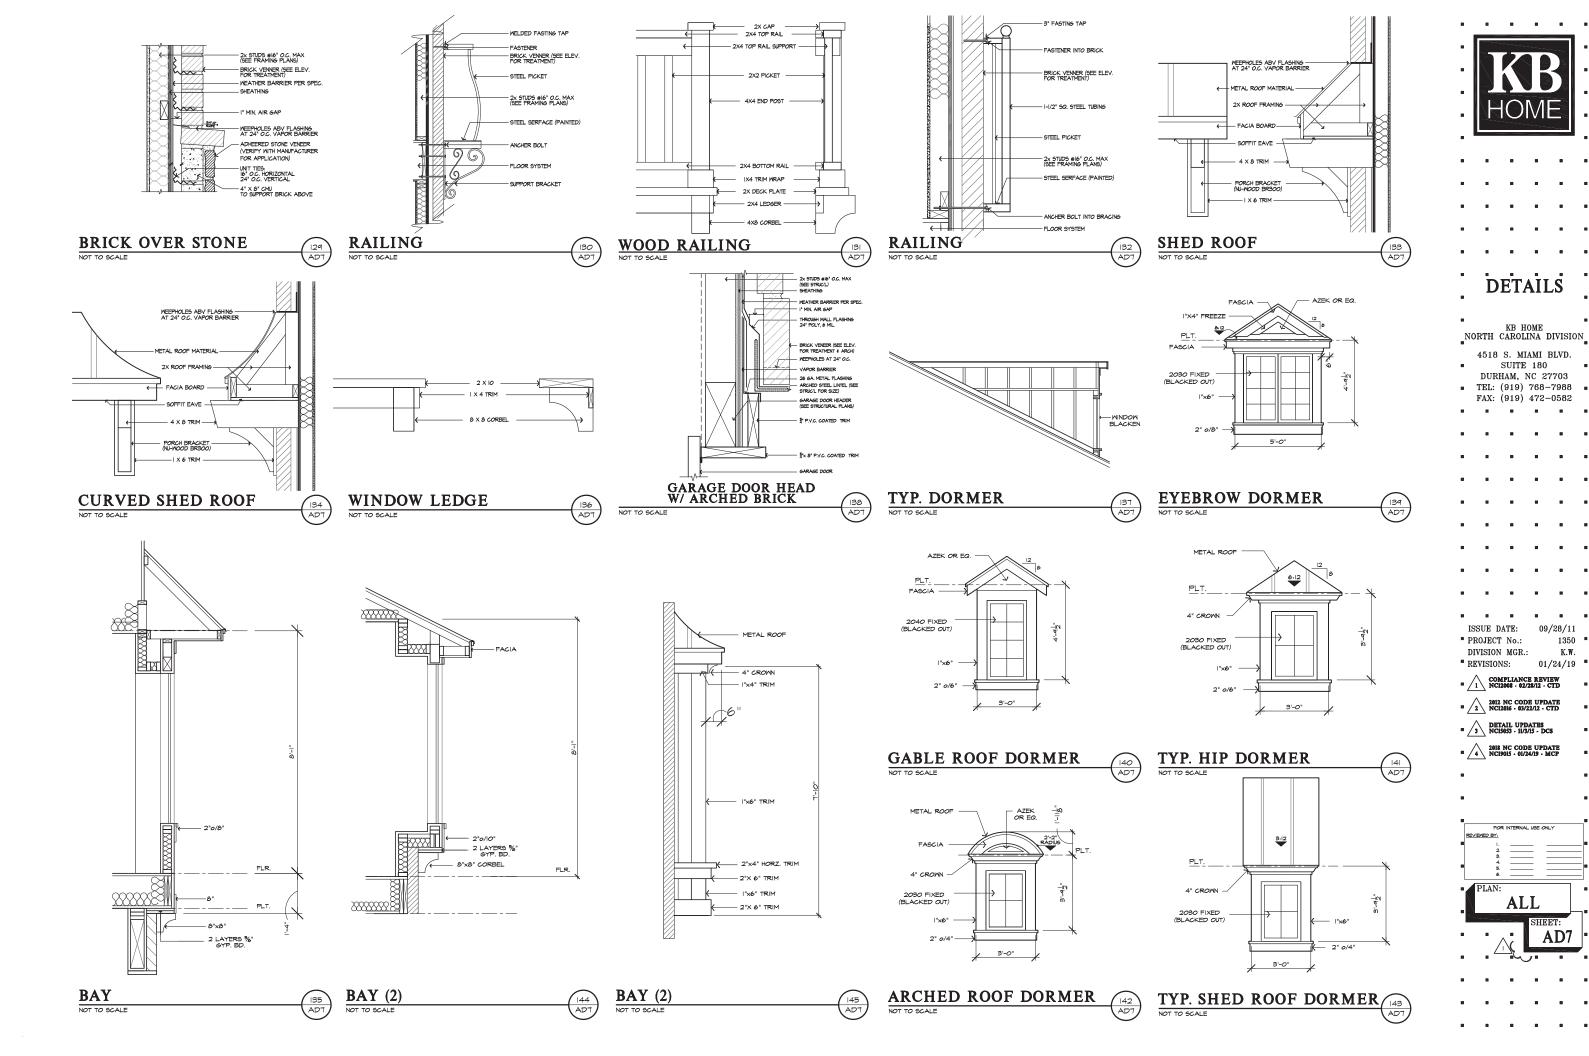

1350

K.W.

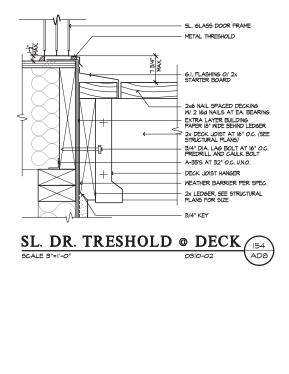

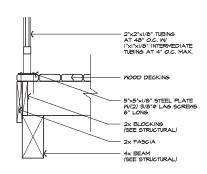




2x STUD (SEE STRUCTURAL)


3/4" T & G PLYWOOD OVER


EDGE NAILING

- 2x SOLID BLKG (SEE STRUCTURAL)

NOTE: 2x SOLID BLK'S TO HAVE (3)-2" DIA SCREENED VENT HOLES PER BLOCK M= 20pH (2)" 35" = 140 LB. FT. Y= 140 IbFT (12/65") = 250# 250#/IO5# = 3-16d NAILS TOTAL OF 6-16d NAILS.

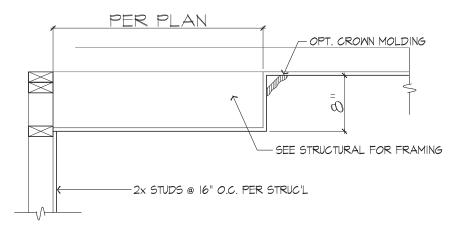

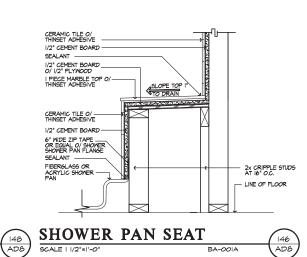

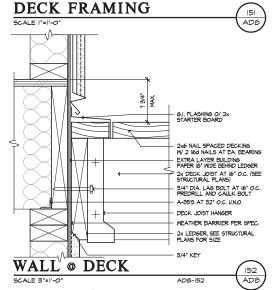

SLIDING GLASS DOOR FRAME


FLOOR SHEATHING O/ FLOOR FRAMING - SEE STRUCTURAL METAL THRESHOLD MAX. THRESHOLD HEIGHT (SEE FRAMING PLAN)

SYNTHETIC DECKING IX TRIM BOARD RIM JOIST JOIST HANGER

2x PTDF LEDGER - SEE STRUCTURAL PLANS


2x P.T.D.F. SILL PLATE

G.I. FLASHING O/ DAMPROOFING

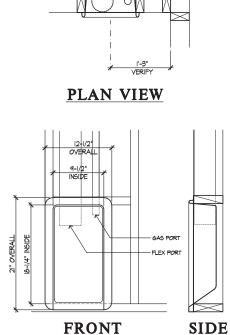

BOX TRAY CEILING

FLEX PORT

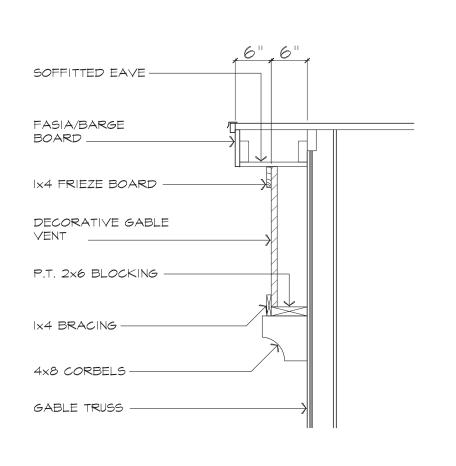

DETAILS

KB HOME NORTH CAROLINA DIVISION

4518 S. MIAMI BLVD. SUITE 180 DURHAM, NC 27703 ■ TEL: (919) 768-7988 ■ FAX: (919) 472-0582

ISSUE DATE: 09/28/11 " PROJECT No.: 1350

K.W.

DIVISION MGR.: REVISIONS: 01/24/19 COMPLIANCE REVIEW NC12008 • 02/28/12 • CTD

2012 NC CODE UPDATE NC12016 - 03/22/12 - CTD

DETAIL UPDATES
NCI5053 · IL/3/I5 · DCS



GABLE VENT DETAIL

SHEET: AD8

SWING DOOR THRESHOLD

DRYER BOX DETAIL

NOT TO SCALE

All I-Joist and Versa-Lam Beams Must be Installed per The Boise Cascade Installation Guide!

KB Homes 2596 All Elevs 11 Mason Poin

Start Framing Here 2'0

	Revisions:	BY:
S		
ite		







Structural Date: 10312019

Sheet: 1/3

ALL DIMENSIONS AND CONDITIONS

TO BE REVIEWED AND APPROVED

BY BOTH THE CONTRACTOR AND

THE ENGINEER OF RECORD


PRIOR TO INSTALLATION

BC FRAMER II


Plan Date: 08132018

By: CMM



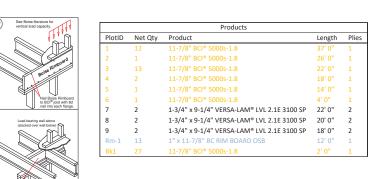

Crawl All Elevs

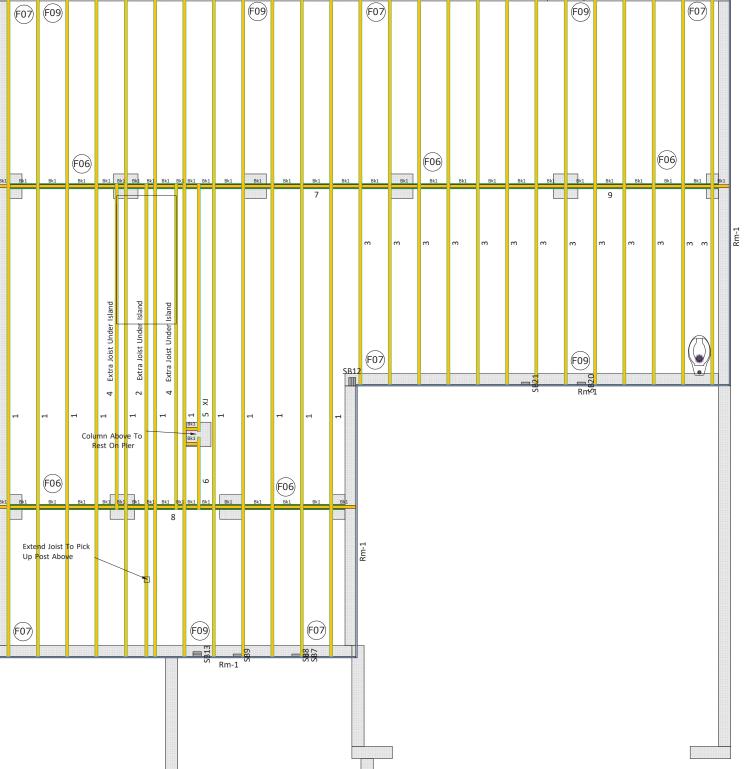



Field Locate 18x24 Access Door;


Double Band Above

Squash Blocks Required Under The Ends Of All LVL And Point Loads For Load Transfer - See Details

First Floor Layout

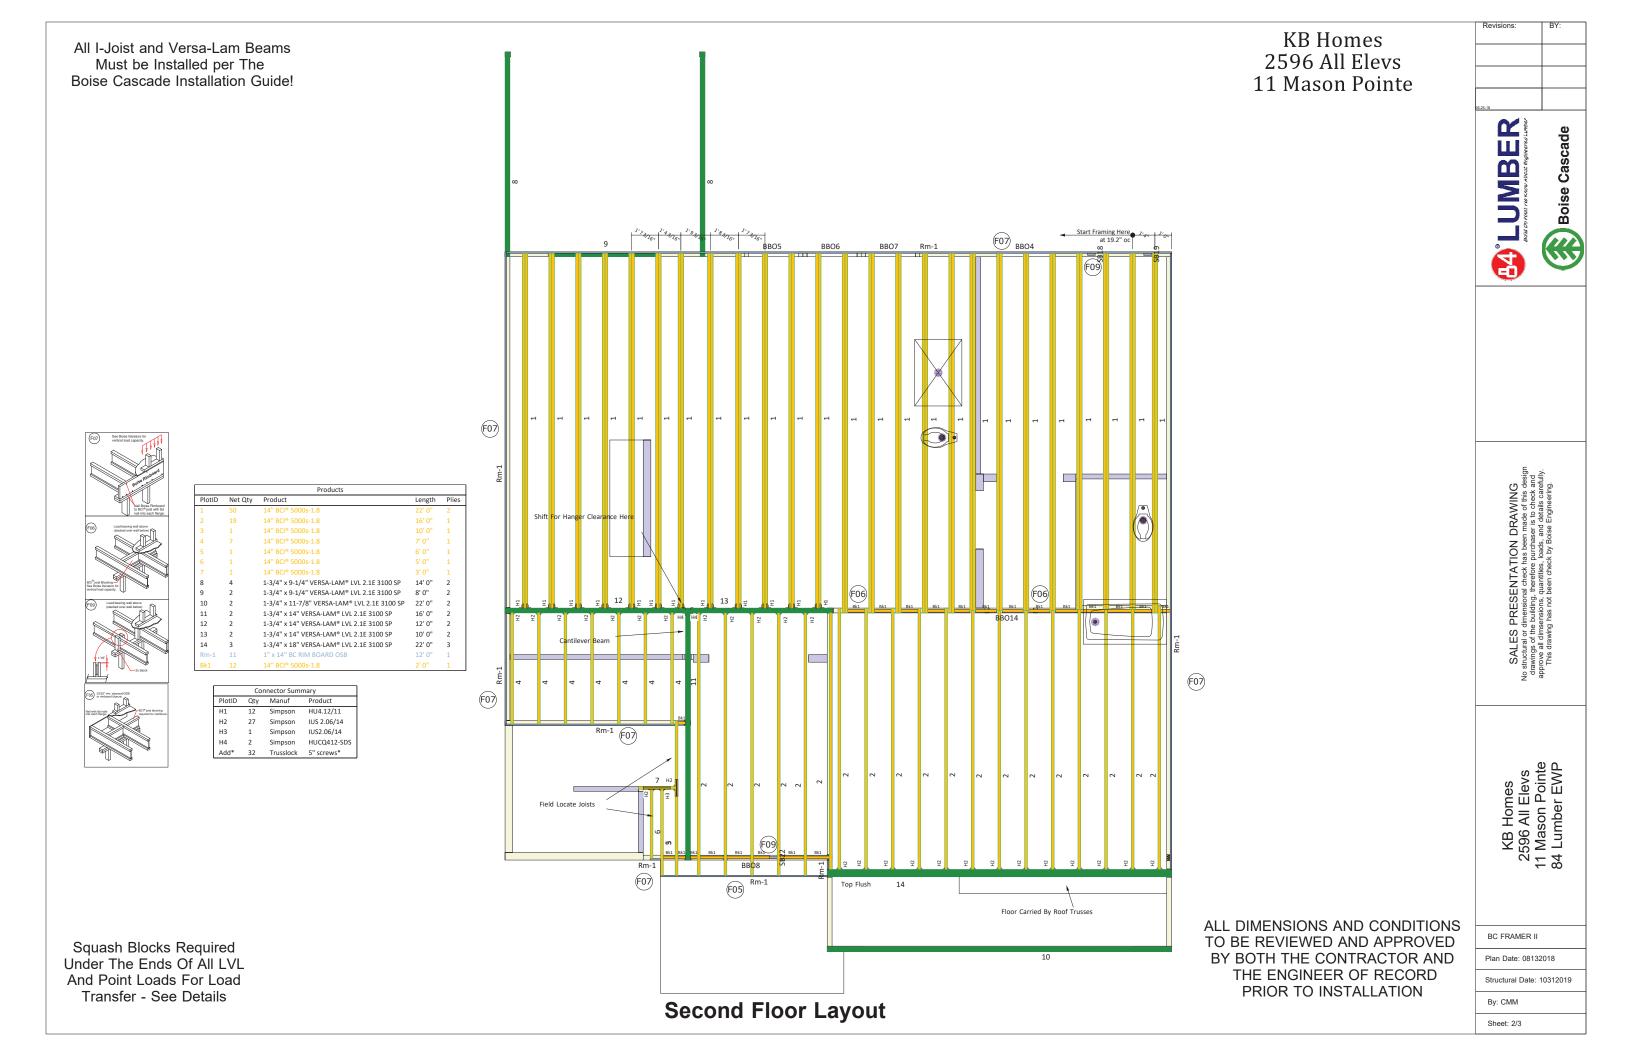

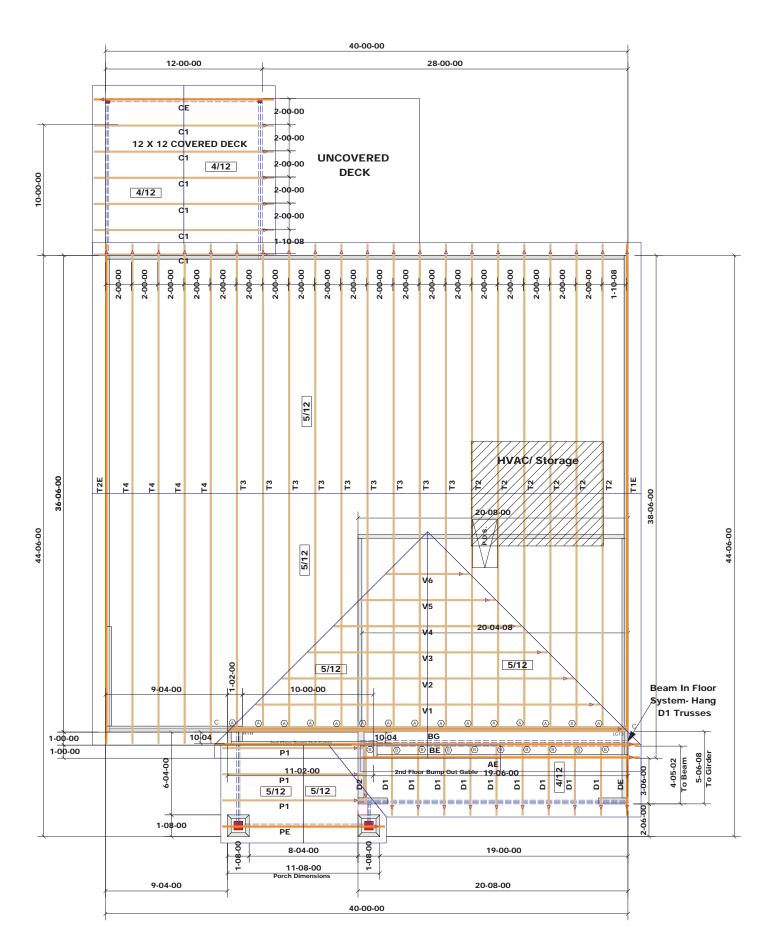

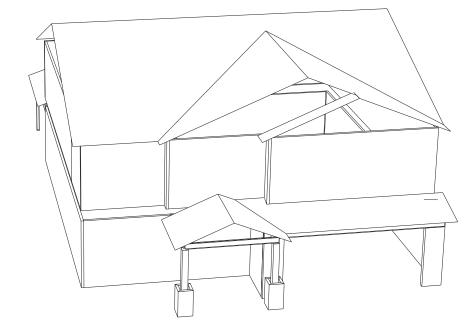

Hanger List				
Symbol	Name	Qty		
А	HUS26	15		
В	LUS26	10		
LGT3	LGT3-SDS2.5	1		
Н	HTS20	2		

LGT3-SDS2.5 used at BG girder- Outside wall at bedroom 2 for uplift and bearing enhancer, other end at stairs use (2x) HTS20 for uplift



DEDICATED TO QUALITY AND EXCELLENCE 200 EMMETT ROAD DUNN, NORTH CAROLINA 28334 PHONE: 910-892-8400 FAX: 910-892-8384

inte		VD GOR	ORDER: 23574A	SHIP DATE: 2020
Lot 11 @ Mason Pointe	KB HOME	240.2596 "B" x 12x12 CVD GOR	P.O. NUMBER: PO #	REV:
ot 11 @	KB	2596 "B"	SCALE	PRINT DATE: 6/22/20
PROJECT:	CUSTOMER:	240.2	SCALE: NOT TO SCALE	DRAWN BY: MWM
TOP LIVE: 20 PSE				

TOP LIVE: 20 PSF

TOP DEAD: 10 PSF

BOTM DEAD: 10 PSF

WIND SPD: 130 MPH

GENERAL NOTES:

DO NOT CUT OR MODIFY TRUSSES.

TRUSSES ARE SPACED 24" ON CENTER UNLESS NOTED OTHERWISE.

REFER TO THE INDIVIDUAL TRUSS DESIGN DRAWINGS FOR THE LOCATION OF LATERAL BRACING AND MULTI-PLY CONNECTION REQUIREMENTS.

PER ANSI TPI 1-2002 THE TRUSS ENGINEER IS RESPONSIBLE FOR TRUSS TO TRUSS CONNECTIONS AND TRUSS PLY TO PLY CONNECTIONS.
THIS TRUSS PLACEMENT PLAN RECCOMENDS TRUSS TO BEARING CONNECTIONS AND TRUSS TO BEAM CONNECTIONS WHICH SHALL BE REVIEWED BY THE BUILDING OF THE BUILDING DESIGNER TO RESOLVE ALL ROOF FORCES ADEQUATELY TO THE FOUNDATION

STRUCTURAL PLANS FOR:



240.2596 - RH GARAGE

PLAN RI	ELEASE / REVISIONS		
REV DATE	ARCH PLAN VERSION	REVISION DESCRIPTION	DRFT
06/22/2020	240.2596 RH D7 2020.05.07	INITIAL SETUP OF LAYOUT	ABS
06/22/2020	240.2596 RH D7 2020.05.07	CREATED LOT-SPECIFIC STRUCTURAL LAYOUT FROM MASTER PLAN AND EWP LAYOUT	ABS

NOTES

- 1. ENGINEER'S SEAL APPLIES TO STRUCTURAL COMPONENTS ONLY, ENGINEER'S SEAL DOES NOT CERTIFY DIMENSIONAL ACCURACY OR ARCHITECTURAL LAYOUT, INCLUDING ROOF GEOMETRY, JDSfaulkner, PLLC ASSUMES NO LIABILITY FOR CHANGES MADE TO THESE PLANS BY OTHERS, OR FOR CONSTRUCTION METHODS, OR FOR ANY DEVIATION FROM THE PLANS. ENGINEER TO BE NOTIFIED PRIOR TO CONSTRUCTION IF ANY DISCREPANCIES ARE NOTED ON THE PLANS
- DIMENSIONS SHALL GOVERN OVER SCALE, AND CODE SHALL GOVERN OVER DIMENSIONS.
- 3. PLANS MUST HAVE SIGNED SEAL TO BE VALID AND ARE LIMITED TO THE FOLLOWING USES:
 - A. IF THESE PLANS ARE ISSUED AS A MASTER-PLAN SET, THE SET IS VALID FOR 18 MONTHS FROM THE DATE ON THE SEAL, UNLESS ANY CODE-REQUIRED UPDATES ARE PLACED IN EFFECT BY THE MUNICIPALITY.
 - B. IF THESE PLANS ARE NOT ISSUED AS A MASTER-PLAN SET, THE SET IS VALID FOR A CONDITIONAL, ONE-TIME USE FOR THE LOT OR ADDRESS SPECIFIED ON THE TITLE BLOCK.


CODE

ALL CONSTRUCTION, WORKMANSHIP, AND MATERIAL QUALITY AND SELECTION SHALL BE PER:

2018 NORTH CAROLINA STATE BUILDING CODE: RESIDENTIAL CODE

ENGINEER OF RECORD

JDSfaulkner, PLLC
ENGINEERING, BUILDING DESIGN, & CONSTRUCTION
CONSULTING SERVICES
8600 'D' JERSEY COURT
RALEIGH, NC 27617
FIRM LIC. NO: P-0961
PROJECT REFERENCE: 20901051

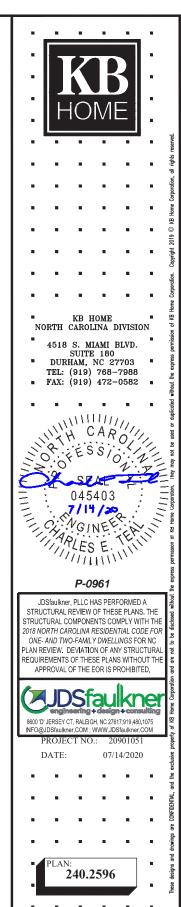

TITLE SHEET

T

NOTE: ALL CHAPTERS, SECTIONS, TABLES, AND FIGURES CITED WITHOUT A PUBLICATION TITLE ARE FROM THE APPLICABLE RESIDENTIAL CODE (SEE TITLE SHEET).

GENERAL

- IT IS THE CONTRACTOR'S RESPONSIBILITY TO VERIFY ALL DIMENSIONS PRIOR TO CONSTRUCTION. FURTHERMORE, CONTRACTOR IS ULTIMATELY RESPONSIBLE FOR CONSTRUCTION MEANS, METHODS, AND SAFETY ON SITE. NOTIFY JDSfaulkner, PLLC IMMEDIATELY IF DISCREPANCIES ON PLAN EXIST.
- BRACED-WALL DESIGN IS BASED ON <u>SECTION R602.10 WALL</u> <u>BRACING.</u> PRIMARY PRESCRIPTIVE METHOD TO BE CS-WSP. SEE WALL BRACING PLANS AND DETAILS FOR ADDITIONAL INFORMATION.

ALL NON-PRESCRIPTIVE SOLUTIONS ARE BASED ON GUIDELINES ESTABLISHED IN THE AMERICAN SOCIETY OF CIVIL ENGINEERS PUBLICATION ASCE 7 AND THE NATIONAL DESIGN SPECIFICATION FOR WOOD CONSTRUCTION - SPECIAL DESIGN PROVISIONS FOR WIND AND SEISMIC.

SEISMIC DESIGN SHALL BE PER SECTION R301.2.2 - SEISMIC PROVISIONS, INCLUDING ASSOCIATED TABLES AND FIGURES, BASED ON LOCAL SEISMIC DESIGN CATEGORY.

DESIGN LOADS

GUARDS AND HANDRAILS

ACCUMED COULDEADING CADACITY

ASSUMED SOIL BEARING-CAPACITY	2,000 PSF
	LIVE LOAD
ULTIMATE DESIGN WIND SPEED	115 MPH, EXPOSURE B
GROUND SNOW	15 PSF
ROOF	20 PSF
RESIDENTIAL CODE TABLE R301.5	LIVE LOAD (PSF)
DWELLING UNITS	40
SLEEPING ROOMS	30
ATTICS WITH STORAGE	20
ATTICS WITHOUT STORAGE	10
STAIRS	40
DECKS	40
EXTERIOR BALCONIES	60
PASSENGER VEHICLE GARAGES	50
FIRE ESCAPES	40

COMPONENT AND CLADDING LOADS, INCLUDING THOSE FOR DOORS AND WINDOWS, SHALL BE DERIVED FROM TABLES R301.2(2) AND R301.2(3) FOR A BUILDING WITH A MEAN ROOF HEIGHT OF 35 FEET, I OCATED IN EXPOSURE B.

200 (pounds, concentrated)

ABBREVIATIONS		KS	KING STUD COLUMN
		LVL	LAMINATED VENEER
ABV	ABOVE		LUMBER
AFF	ABOVE FINISHED FLOOR	MAX	MAXIMUM
ALT	ALTERNATE	MECH	
	BEARING	MFTR	MANUFACTURER
BSMT	BASEMENT	MIN	MINIMUM
CANT	BASEMENT CANTILEVER	NTS	NOT TO SCALE
		OA	
CLG	CEILING CONCRETE MASONRY UNIT		ON CENTER
CMU	CONCRETE MASONRY UNIT	PT	PRESSURE TREATED
	CASED OPENING	R	RISER
	COLUMN	REF	REFRIGERATOR
CONC	CONCRETE	RFG RO	ROOFING
CONT	CONTINUOUS	RO	ROUGH OPENING ROOF SUPPORT
D	CLOTHES DRYER	RS SC	
	DOUBLE		
	DIAMETER	SF	SQUARE FOOT (FEET)
DJ	DOUBLE JOIST	SH	
DN	DOWN		SHEATHING
DP	DEEP		SHOWER
DR	DOUBLE RAFTER	SIM	
DSP	DOUBLE STUD POCKET	SJ	SINGLE JOIST
	EACH	SP	
	EACH END		SPECIFIED
	EQUAL	SQ	SQUARE
	EXTERIOR	T TEMP	TREAD TEMPERED GLASS
	FORCED-AIR UNIT	THK	
	FOUNDATION	TJ	THICK(NESS)
FF	FINISHED FLOOR	TOC	TRIPLE JOIST TOP OF CURB / CONCRETE
FLR	FLOOR(ING)	TR	TRIPLE RAFTER
FP	FIREPLACE		TYPICAL
FTG	FOOTING	TYP	
	HOSE BIBB	UNO W	UNLESS NOTED OTHERWISE CLOTHES WASHER
	HEADER		
	HANGER		WATER HEATER
JS	JACK STUD COLUMN	XJ	WELDED WIRE FABRIC EXTRA JOIST
		ΛJ	LATRA JUIST

MATERIALS

 INTERIOR / TRIMMED FRAMING LUMBER SHALL BE #2 SPRUCE PINE FIR (SPF) WITH THE FOLLOWING DESIGN PROPERTIES (#2 SOUTHERN YELLOW PINE MAY BE SUBSTITUTED):

Fb = 875 PSI Fv = 70 PSI E = 1.4E6 PSI

 FRAMING LUMBER EXPOSED TO WEATHER OR IN CONTACT WITH THE GROUND, CONCRETE, OR MASONRY SHALL BE PRESSURE TREATED #2 SOUTHERN YELLOW PINE (SYP) WITH THE FOLLOWING DESIGN PROPERTIES:

Fb = 975 PSI Fv = 95 PSI E = 1.6E6 PSI

3. LVL STRUCTURAL MEMBERS TO BE LAMINATED VENEER LUMBER WITH THE FOLLOWING MINIMUM DESIGN PROPERTIES:

Fb = 2600 PSI Fv = 285 PSI E = 1.9E6 PSI

4. PSL STRUCTURAL MEMBERS TO BE PARALLEL STRAND LUMBER WITH THE FOLLOWING MINIMUM DESIGN PROPERTIES:

5. LSL STRUCTURAL MEMBERS TO BE LAMINATED STRAND LUMBER WITH THE FOLLOWING MINIMUM DESIGN PROPERTIES:

Fb = 2250 PSI Fv = 400 PSI E = 1.55E6 PSI

- STRUCTURAL STEEL WIDE-FLANGE BEAMS SHALL CONFORM TO ASTM A992. Fy = 50 KSI
- 7. REBAR SHALL BE DEFORMED STEEL CONFORMING TO ASTM A615,
- 8. POURED CONCRETE COMPRESSIVE STRENGTH TO BE A MINIMUM 3,000 PSI AT 28 DAYS. MATERIALS USED TO PRODUCE CONCRETE SHALL COMPLY WITH THE APPLICABLE STANDARDS LISTED IN AMERICAN CONCRETE INSTITUTE STANDARD ACI 318 OR ASTM C1157.
- 9. CONCRETE SUBJECT TO MODERATE OR SEVERE WEATHERING PROBABILITY PER TABLE R301.2(1) SHALL BE AIR-ENTRAINED WHEN REQUIRED BY TABLE R402.2.
- 10. CONCRETE MASONRY UNITS (CMU) SHALL CONFORM TO AMERICAN CONCRETE INSTITUTE PUBLICATION 530: BUILDING CODE REQUIREMENTS AND SPECIFICATIONS FOR MASONRY STRUCTURES AND COMPANION COMMENTARIES AND THE MASONRY SOCIETY PUBLICATION TMS 402/602: BUILDING CODE REQUIREMENTS AND SPECIFICATIONS FOR MASONRY
- 11. MORTAR SHALL COMPLY WITH ASTM INTERNATIONAL STANDARD C270.
- 12. INDICATED MODEL NUMBERS FOR ALL METAL HANGERS, STRAPS, FRAMING CONNECTORS, AND HOLD-DOWNS ARE SIMPSON STRONG-TIE BRAND. EQUIVALENT USP BRAND PRODUCTS ARE ACCEPTABLE
- 13. REFER TO I-JOIST EQUIVALENCE CHART ON I-JOIST DETAIL SHEET FOR SUBSTITUTION OF MANUFACTURER SERIES.

FOUNDATION

- MINIMUM ALLOWABLE SOIL BEARING CAPACITY IS ASSUMED TO BE 2,000 PSF. IT IS THE CONTRACTOR'S RESPONSIBILITY TO VERIFY SOIL BEARING CAPACITY IF UNSATISFACTORY CONDITIONS EVICT
- CONCRETE FOUNDATION WALLS TO BE SELECTED AND CONSTRUCTED PER SECTION R404 OR AMERICAN CONCRETE INSTITUTE STANDARD ACI 348.
- 3. MASONRY FOUNDATION WALLS TO BE SELECTED AND CONSTRUCTED PER SECTION R404 AND/OR AMERICAN CONCRETE INSTITUTE PUBLICATION 530: BUILDING CODE REQUIREMENTS AND SPECIFICATIONS FOR MASONRY STRUCTURES AND COMPANION COMMENTARIES AND/OR THE MASONRY SOCIETY PUBLICATION TMS 402/602: BUILDING CODE REQUIREMENTS AND SPECIFICATIONS FOR MASONRY STRUCTURES.
- I. CONCRETE WALL HORIZONTAL REINFORCEMENT TO BE PER TABLE R404.1.2(1) OR AS NOTED OR DETAILED. CONCRETE WALL VERTICAL REINFORCEMENT TO BE PER TABLES R404.1.2(3 AND 4) OR AS NOTED OR DETAILED. ALL CONCRETE WALLS SHALL COMPLY WITH APPLICABLE PROVISIONS OF CHAPTER 6.
 - A. TABLES ASSUME THAT WALLS HAVE PERMANENT LATERAL SUPPORT AT THE TOP AND BOTTOM.
 - B. FOUNDATION DRAINS ARE ASSUMED AT ALL WALLS PER SECTION R405.
- 5. PLAIN-MASONRY WALL DESIGN TO BE PER TABLE R404.1.1(1) OR AS NOTED OR DETAILED. MASONRY WALLS WITH VERTICAL REINFORCEMENT TO BE PER TABLES R404.1.1 (2 THROUGH 4) OR AS NOTED OR DETAILED. ALL MASONRY WALLS SHALL COMPLY WITH APPLICABLE PROVISIONS OF CHAPTER 6.
 - A. TABLES ASSUME THAT WALLS HAVE PERMANENT LATERAL SUPPORT AT THE TOP AND BOTTOM.
 - B. WALL REINFORCING SHALL BE PLACED ACCORDING TO FOOTNOTE (c) OF THE TABLES (REINFORCING IS NOT CENTERED IN WALL).
 - C. FOUNDATION DRAINS ARE ASSUMED AT ALL WALLS PER SECTION R405.
- 6. WOOD SILL PLATES TO BE ANCHORED TO THE FOUNDATION WITH 1/2" DIAMETER ANCHOR BOLTS WITH MINIMUM 7" EMBEDMENT, SPACED A MAXIMUM OF 6'-0" OC AND WITHIN 12" FROM THE ENDS OF EACH PLATE SECTION. INSTALL MINIMUM (2) ANCHOR BOLTS PER SECTION. SEE SECTION R403.1.6 FOR SPECIFIC CONDITIONS.
- THE UNSUPPORTED HEIGHT OF SOLID MASONRY PIERS SHALL NOT EXCEED TEN TIMES THEIR LEAST DIMENSION. UNFILLED, HOLLOW PIERS MAY BE USED IF THE UNSUPPORTED HEIGHT IS NOT MORE THAN FOUR TIMES THEIR LEAST DIMENSION.
- 8. CENTERS OF PIERS TO BEAR IN THE MIDDLE THIRD OF THE FOOTINGS, AND GIRDERS SHALL CENTER IN THE MIDDLE THIRD OF THE PIERS.
- ALL FOOTINGS TO HAVE MINIMUM 2" PROJECTION ON EACH SIDE OF FOUNDATION WALLS (SEE DETAILS).
- 10. ALL REBAR NOTED IN CONCRETE TO HAVE AT LEAST 2" COVER FROM EDGE OF CONCRETE TO EDGE OF REBAR.
- 11. FRAMING TO BE FLUSH WITH FOUNDATION WALLS.
- 12. WITH CLASS 1 SOILS, VAPOR BARRIER AND CRUSHED STONE MAY BE OMITTED.

FRAMING

- ALL BEARING HEADERS TO BE (2) 2x6 SUPPORTED W/ MIN (1) JACK STUD AND (1) KING STUD EACH END, UNO.
- 2. ALL NON-BEARING HEADERS TO BE (2) 2x4, UNO.
- 3. NON-BEARING INTERIOR WALLS NOT MORE THAN 10' NOMINAL HEIGHT AND NOT SHOWN AS BRACED WALLS MAY BE FRAMED WITH 2x4 STUDS @ 24" OC.
- SOLID BLOCKING TO BE PROVIDED AT ALL POINT LOADS THROUGH FLOOR LEVELS TO THE FOUNDATION OR TO OTHER STRUCTURAL COMPONENTS.
- ALL BEAMS SPECIFIED ARE MINIMUM SIZES ONLY. LARGER MEMBERS MAY SUBSTITUTED AS NEEDED FOR EASE OF CONSTRUCTION.
- 6. ALL EXTERIOR WALLS TO BE FULLY SHEATHED WITH 7/16" OSB.
- PORCH / PATIO COLUMNS TO BE 4x4 MINIMUM PRESSURE-TREATED LUMBER.
 - A. ATTACH PORCH COLUMNS TO SLAB / FDN WALL USING ABA, ABU, ABW, OR CPT SIMPSON POST BASES TO FIT COLUMN SIZES NOTED ON PLAN -OR- ANY OTHER COLUMN CONNECTION WITH 500# UPLIFT CAPACITY.
 - B. ATTACH PORCH COLUMNS TO PORCH BEAMS USING AC OR BC SIMPSON POST CAPS TO FIT COLUMN SIZES NOTED ON PLAN -OR- ANY OTHER COLUMN CONNECTION WITH 500# UPLIFT CAPACITY.
 - C. TRIM OUT COLUMN(S) AND BEAM(S) PER BUILDER AND DETAILS.
- 8. ALL ENGINEERED WOOD PRODUCTS (LVL, PSL, LSL, ETC.) SHALL BE INSTALLED WITH CONNECTIONS PER MANUFACTURER SPECIFICATIONS.
- 9. ENGINEERED WOOD FLOOR SYSTEMS AND ROOF TRUSS SYSTEMS:
 - A. SHOP DRAWINGS FOR THE SYSTEMS SHALL BE PROVIDED TO THE ENGINEER OF RECORD FOR REVIEW AND COORDINATION BEFORE CONSTRUCTION.
 - B. TRUSS PROFILES SHALL BE SEALED BY THE TRUSS MANUFACTURER.
 - C. INSTALLATION OF THE SYSTEMS SHALL BE PER MANUFACTURER'S INSTRUCTIONS.
 - D. TRUSS LAYOUT AND PLACEMENT BY MANUFACTURER TO COINCIDE WITH THE SUPPORT LOCATIONS SHOWN IN THESE DRAWINGS.
- 10. ALL BEAMS TO BE CONTINUOUSLY SUPPORTED LATERALLY AND SHALL BEAR FULL WIDTH ON THE SUPPORTING WALLS OR COLUMNS INDICATED, WITH A MINIMUM OF THREE STUDS, UNO.
- 11. ALL STEEL BEAMS TO BE SUPPORTED AT EACH END WITH A MIN BEARING LENGTH OF 3 1/2" AND FULL FLANGE WIDTH. BEAMS MUST BE ATTACHED AT EACH END WITH A MINIMUM OF FOUR 16d NAILS OR TWO 1/2" x 4" LAG SCREWS, UNO.
- 12. STEEL FLITCH BEAMS TO BE BOLTED TOGETHER USING (2) ROWS OF 1/2" DIAMETER BOLTS (ASTM 307) WITH WASHERS PLACED UNDER THE THREADED END OF THE BOLT. BOLTS TO BE SPACED AT 24" OC (MAX) AND STAGGERED TOP AND BOTTOM OF BEAM (2" EDGE DISTANCE), WITH TWO BOLTS TO BE LOCATED AT 6" FROM EACH END OF FLITCH BEAM.
- WHEN A 4-PLY LVL BEAM IS USED, ATTACH WITH (1) 1/2" DIAMETER BOLT, 12" OC, STAGGERED TOP AND BOTTOM, 1 1/2" MIN FROM ENDS. ALTERNATE EQUIVALENT ATTACHMENT METHOD MAY BE USED, SUCH AS SDS, SDW, OR TRUSSLOK SCREWS (SEE MANUFACTURER SPECIFICATIONS).
- 14. FOR STUD COLUMNS OF 4-OR-MORE STUDS, INSTALL SIMPSON STRONG-TIE CS16 STRAPS ACROSS STUDS @ 30" OC, 6" MAX FROM PLATES, ON INSIDE FACE OF COLUMN (EXTERIOR WALL), ON BOTH FACES OF COLUMN (INTERIOR WALL).
- 15. FLOOR JOISTS ADJACENT AND PARALLEL TO THE EXTERIOR FOUNDATION WALL SHALL BE PROVIDED WITH FULL-DEPTH SOLID BLOCKING, NOT LESS THAN TWO (2) INCHES NOMINAL IN THICKNESS, PLACED PERPENDICULAR TO THE JOIST AT SPACING NOT MORE THAN FOUR (4) FEET. THE BLOCKING SHALL BE NAILED TO THE FLOOR SHEATHING, THE SILL PLATE, THE JOIST, AND THE EXTERIOR RIM JOIST / BOARD.
- 16. BRACED WALL PANELS SHALL BE FASTENED TO MEET THE UPLIFT-RESISTANCE REQUIREMENTS IN CHAPTERS 6 AND 8 OF THE APPLICABLE CODE (SEE TITLE SHEET). REQUIREMENTS OF THE STRUCTURAL DRAWINGS THAT EXCEED THE CODE MINIMUM SHALL BE MET.



. . . .

KB HOME NORTH CAROLINA DIVISION

4518 S. MIAMI BLVD. SUITE 180 DURHAM, NC 27703 TEL: (919) 768-7988 FAX: (919) 472-0582

SPAE SPAE STATE OF STATE SELECTION OF SELECTION OF STATE SELECTION OF SELECTION OF SELECTION OF SELECTION OF SELECTION OF SELEC

P-0961

JDSfaulkner, PLLC HAS PERFORMED A STRUCTURAL REVIEW OF THESE PLANS. THE STRUCTURAL COMPONENTS COMPLY WITH THE 2018 NORTH CAROLINA RESIDENTIAL CODE FOR ONE-AND TWO-FAMILY DWELLINGS FOR NC PLAN REVIEW. DEVIATION OF ANY STRUCTURAL REQUIREMENTS OF THESE PLANS WITHOUT THE APPROVAL OF THE EOR IS PROHIBITED.



PROJECT NO.: 20901051 DATE: 07/14/2020

. . . .

240.2596

. . . .

GENERAL NOTES

GN1.0

FASTENER SCHEDULE				
CONNECTION	3" x 0.131" NAIL	3" x 0.120" NAIL		
JOIST TO SILL PLATE	(4) TOE NAILS	(4) TOE NAILS		
SOLE PLATE TO JOIST / BLOCKING	NAILS @ 8" OC (typical) (4) PER 16" SPACE (at braced panels)	NAILS @ 8" OC (typical) (4) PER 16" SPACE (at braced panels)		
STUD TO SOLE PLATE	(4) TOE NAILS	(4) TOE NAILS		
TOP OR SOLE PLATE TO STUD	(3) FACE NAILS	(4) FACE NAILS		
RIM JOIST OR BAND JOIST TO TOP PLATE OR SILL PLATE	TOE NAILS @ 6" OC	TOE NAILS @ 4" OC		
BLOCKING BETWEEN JOISTS TO TOP PLATE OR SILL PLATE	(4) TOE NAILS	(4) TOE NAILS		
DOUBLE STUD	NAILS @ 8" OC	NAILS @ 8" OC		
DOUBLE TOP PLATES	NAILS @ 12" OC	NAILS @ 12" OC		
DOUBLE TOP PLATES LAP (24" MIN LAP LENGTH)	(12) NAILS IN LAPPED AREA, EA SIDE OF JOINT	(12) NAILS IN LAPPED AREA, EA SIDE OF JOINT		
TOP PLATE LAP AT CORNERS AND INTERSECTING WALLS	(3) FACE NAILS	(3) FACE NAILS		
OPEN-WEB TRUSS BOTTOM CHORD TO TOP PLATES OR SILL PLATE (PARALLEL TO WALL)	NAILS @ 6" OC	NAILS @ 4" OC		
BOTTOM CHORD OF TRUSS TO TOP PLATES OR SILL PLATE (PERPENDICULAR TO WALL)	(3) TOE NAILS	(3) TOE NAILS		

SEE TABLE R602.3(1) FOR ADDITIONAL STRUCTURAL-MEMBER FASTENING REQUIREMENTS.

DETAILS AND NOTES ON DRAWINGS GOVERN.

BALLOON WALL FRAMING SCHEDULE (USE THESE STANDARDS UNLESS NOTED OTHERWISE ON THE FRAMING PLAN SHEETS)

FRAMING MEMBER SIZE	MAX HEIGHT (PLATE TO PLATE) 115 MPH ULTIMATE DESIGN WIND SPEED
I KAMING MILMBER SIZE	TIS WIFTI OLTHWATE DESIGN WIND SPEED
2x4 @ 16" OC	10'-0"
_	12'-0"
2x4 @ 12" OC	12 -0
2x6 @ 16" OC	15'-0"
2x6 @ 12" OC	17'-9"
2.0 @ 12 00	•
0 0 0 4011 00	401.011
2x8 @ 16" OC	19'-0"
2x8 @ 12" OC	22'-0"
<u> </u>	
(2) 2x4 @ 16" OC	14'-6"
(2) 2x4 @ 12" OC	17'-0"
(2) 2x6 @ 16" OC	21'-6"
(2) 2x6 @ 12" OC	25'-0"
(2) 2X0 @ 12 OO	20-0
(2) 2x8 @ 16" OC	27'-0"
(2) 2x8 @ 12" OC	31'-0"
., •	

- a. ALL HEIGHTS ARE MEASURED SUBFLOOR TO TOP OF WALL PLATE.
- b. WHEN SPLIT-FRAMED WALLS ARE USED FOR HEIGHTS OVER 12', THE CONTRACTOR SHALL ADD 6' MINIMUM OF CS16 COIL STRAPPING (FULLY NAILED), CENTERED OVER THE WALL BREAK.
- c. FINGER-JOINTED MEMBERS MAY BE USED FOR CONTINUOUS HEIGHTS WHERE TRADITIONALLY MILLED LUMBER LENGTHS ARE
- d. FOR GREATER WIND SPEED, SEE ENGINEERED SOLUTION FOR

ROOF SYSTEMS

TRUSSED ROOF - STRUCTURAL NOTES

1. PROVIDE CONTINUOUS BLOCKING THROUGH STRUCTURE FOR ALL



DENOTES OVER-FRAMED AREA

- 3. MINIMUM 7/16" OSB ROOF SHEATHING
- 4. TRUSS LAYOUT AND PLACEMENT BY MANUFACTURER TO COINCIDE WITH THE SUPPORT LOCATIONS SHOWN. TRUSS PROFILES SHALL BE SEALED BY THE TRUSS MANUFACTURER. TRUSS PLANS TO BE COORDINATED WITH THE SEALED STRUCTURAL DRAWINGS. INSTALLATION SHALL BE IN ACCORDANCE WITH THE MANUFACTURER'S INSTRUCTIONS.
- 5. MANUFACTURER TO PROVIDE REQUIRED UPLIFT CONNECTION.
- 6. PROVIDE H2.5A (MINIMUM) OR EQUIVALENT AT EACH TRUSS-TO-TOP PLATE CONNECTION AT OVER-FRAMED AREAS, UNLESS NOTED OTHERWISE.
- 7. UPLIFT CONNECTION TO BE CARRIED THROUGH TO FLOOR

STICK-FRAMED ROOF - STRUCTURAL NOTES

- 1. PROVIDE 2x4 COLLAR TIES AT 48" OC AT UPPER THIRD OF RAFTERS, UNLESS NOTED OTHERWISE.
- 2. FUR RIDGES FOR FULL RAFTER CONTACT.
- 3. PROVIDE CONTINUOUS BLOCKING THROUGH STRUCTURE FOR ALL POINT LOADS.



DENOTES OVER-FRAMED AREA

- 5. MINIMUM 7/16" OSB ROOF SHEATHING
- 6. PROVIDE 2x4 RAFTER TIES AT 16" OC AT 45° BETWEEN RAFTERS AND CEILING JOISTS. USE (4) 16d NAILS AT EACH CONNECTION. RAFTER TIES MAY BE SPACED AT 48" OC AT LOCATIONS WHERE NO KNEE WALLS ARE INSTALLED.
- 7. PROVIDE H2.5A (MINIMUM) OR EQUIVALENT AT EACH RAFTER-TO-TOP PLATE CONNECTION AT OVER-FRAMED AREAS, UNLESS NOTED OTHERWISE.
- 8. UPLIFT CONNECTION TO BE CARRIED THROUGH TO FLOOR SYSTEM.

BRICK VENEER LINTEL SCHEDULE			
SPAN	STEEL ANGLE SIZE	END BEARING LENGTH	
UP TO 42"	L3-1/2"x3-1/2"x1/4"	8" (MIN. @ EACH END)	
UP TO 72"	L6"x4"x5/16"* (LLV)	8" (MIN. @ EACH END)	
OVER 72"	L6"x4"x5/16"* (LLV) ATTACH LINTEL w/ 1/2" THRU BOLT @ 12" OC, 3" FROM EACH END		

* FOR QUEEN BRICK: LINTELS AT THIS CONDITION MAY BE 5"x3-1/2"x5/16"

NOTE: BRICK LINTELS AT SLOPED AREAS TO BE 4"x3-1/2"x1/4" STEEL ANGLE WITH 16D NAILS IN 3/16" HOLES IN 4" ANGLE LEG AT 12" OC TO TRIPLE RAFTER. WHEN THE SLOPE EXCEEDS 4:12 A MINIMUM OF 3"x3"x1/4" PLATES SHALL BE WELDED AT 24" OC ALONG THE STEEL ANGLE.



JDSfaulkner, PLLC HAS PERFORMED A STRUCTURAL REVIEW OF THESE PLANS. THE STRUCTURAL COMPONENTS COMPLY WITH THE 2018 NORTH CAROLINA RESIDENTIAL CODE FOR ONE- AND TWO-FAMILY DWELLINGS FOR NC PLAN REVIEW DEVIATION OF ANY STRUCTURAL REQUIREMENTS OF THESE PLANS WITHOUT THE APPROVAL OF THE EOR IS PROHIBITED.




07/14/2020 DATE:

240,2596

.

GENERAL NOTES

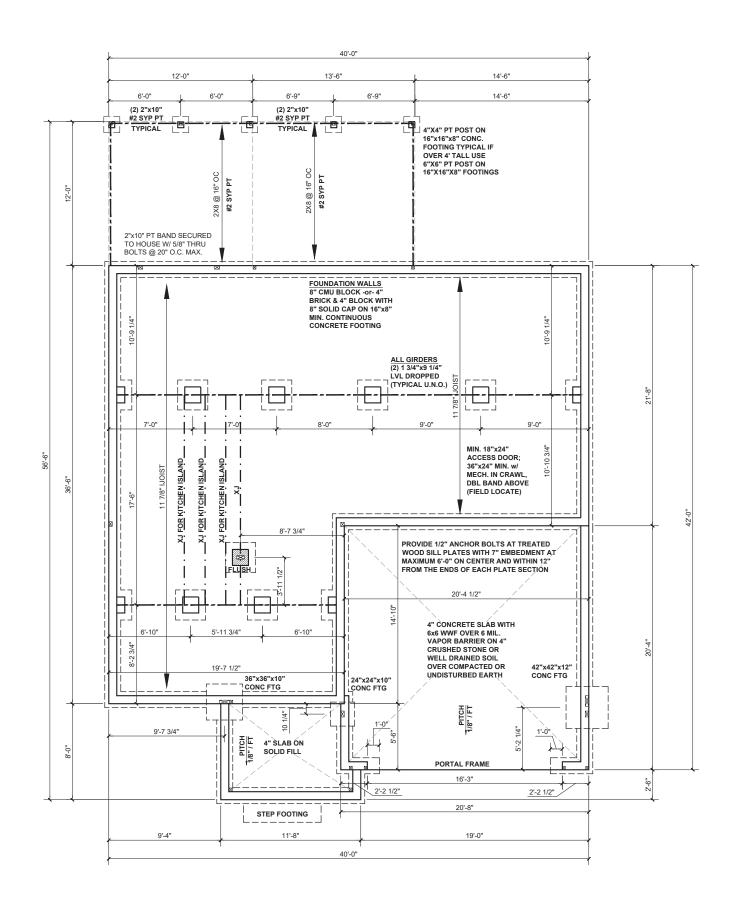

CRAWLSPACE FOUNDATION PLAN - 'B'

SCALE: 1/8" = 1'-0"

BEAM & POINT LOAD LEGEND

INTERIOR LOAD BEARING WALL

---- ROOF RAFTER / TRUSS SUPPORT

----- DOUBLE RAFTER / DOUBLE JOIST

STRUCTURAL BEAM / GIRDER

WINDOW / DOOR HEAD

■ POINT LOAD FROM ABOVE BEARING ON BEAM / GIRDER

I-JOIST SPACING NOT TO EXCEED 19.2" OC IN LOCATIONS WITH TILE FINISH FLOOR

**REFER TO I-JOIST EQUIVALENCE CHART ON I-JOIST DETAIL SHEET FOR SUBSTITUTION OF MANUFACTURER SERIES

FLOOR FRAMING TO BE 11 7/8" DEEP TJI 210 SERIES OR EQUAL, 19.2" OC MAXIMUM SPACING

8"x16" PIERS AT FOUNDATION WALL SUPPORTING DROPPED GIRDER TO HAVE A 30"x10"x8" FOOTING PROJECTION FROM THE MAIN WALL FOOTING.

FOUNDATION STRUCTURAL NOTES:

1. CONCRETE BLOCK PIER SIZE SHALL BE:

SIZE HOLLOW MASONRY SOLID MASONRY

8x16 UP TO 32" HIGH UP TO 5'-0" HIGH 12x16 UP TO 48" HIGH UP TO 9'-0" HIGH 16x16 UP TO 64" HIGH UP TO 12'-0" HIGH 24x24 UP TO 96" HIGH

WITH 30" x 30" x 10" CONCRETE FOOTING, UNO.

(1) #5 REBAR @ CENTER OFF ALL PERIMETER AND INTERNAL LOAD BEARING FOOTINGS. (2" C.C. MIN)

KB

KB HOME
NORTH CAROLINA DIVISION

4518 S. MIAMI BLVD.
SUITE 180
DURHAM, NC 27703
TEL: (919) 768-7988
FAX: (919) 472-0582

O45403

O45403

P-0961

JDSfaulkner, PLLC HAS PERFORMED A
STRUCTURAL REVIEW OF THESE PLANS. THE
STRUCTURAL COMPONENTS COMPLY WITH THE
2016 NORTH CAROLINA RESIDENTIAL CODE FOR
ONE- AND TWO-FAMILY DWELLINGS FOR NC
PLAN REVIEW. DEVIATION OF ANY STRUCTURAL
REQUIREMENTS OF THESE PLANS WITHOUT THE
APPROVAL OF THE EOR IS PROHIBITED.




8800 °D' JERSEY CT, RALEIGH, NC 27617;919.480.1075 INFO@JDSfaulkner.COM; WWW.JDSfaulkner.COM PROJECT NO.: 20901051

PLAN: 240.2596

CRAWL SPACE

S.30B

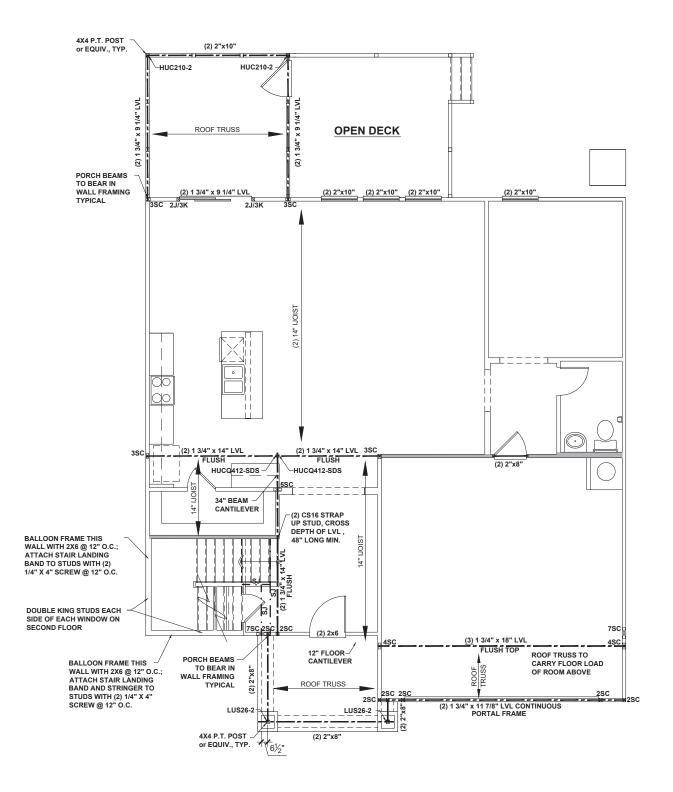

FIRST FLOOR CEILING FRAMING PLAN - 'B'

SCALE: 1/8"=1'-0"

BEAM & POINT LOAD LEGEND

INTERIOR LOAD BEARING WALL

- ROOF RAFTER / TRUSS SUPPORT - · - · - · DOUBLE RAFTER / DOUBLE JOIST

- - STRUCTURAL BEAM / GIRDER

WINDOW / DOOR HEADER

POINT LOAD TRANSFER

POINT LOAD FROM ABOVE BEARING ON BEAM / GIRDER

STRUCTURAL FRAMING NOTES - (SEE GENERAL NOTES SHEET FOR ADDITIONAL REQUIREMENTS.)

ALL FRAMING TO BE #2 SPF MINIMUM

ALL BEARING HEADERS TO BE (2) 2x6 SUPPORTE w/ MIN (1) JACK AND (1) KING EACH END, UNO.

EXTERIOR WALL OPENINGS OVER 3' TO HAVE MULTIPLE KING STUDS AS NOTED ON PLAN.

ALL NON-BEARING HEADERS TO BE (2) 2x4 (1) J / (1) K, UNO.

PROVIDE CONTINUOUS BLOCKING THROUGH STRUCTURE FOR ALL POINT LOADS.

ALL HANGERS AND CONNECTORS SPECIFIED ARE TO BE SIMPSON STRONG-TIE OR EQUIVALENT

ALL BEAMS SPECIFIED ARE MINIMUM SIZES ONLY. LARGER MEMBERS MAY SUBSTITUTED AS NEEDED FOR EASE OF CONSTRUCTION. MINIMUM BEAM SUPPORT IS (1) 2x4 STUD.

ALL EXTERIOR WALLS TO BE FULLY SHEATHED

FRONT PORCH COLUMNS TO BE MIN 4x4 PT ATTACHED AT TOP AND BOTTOM USING SIMPSON (OR EQUIV) COLUMN BASE OR SST A24 BRACKETS. TRIM OUT PER BUILDER.

10. PORCH COLUMNS TO BE MIN 4x4 PT ATTACHED A BOTTOM USING SIMPSON (OR EQUIV) ABA44 AND AT TOP USING CS 16 STRAPPING (12" MIN) TO PORCH HEADER / BAND.

WHEN A 4-PLY LVL IS USED. ATTACH WITH (1) 1/2" Ø BOLT 12" OC STAGGERED, TOP AND BOTTOM, 1-1/2" MIN FROM ENDS. ALTERNATE ATTACHMENT EQUIVALENT METHOD MAY BE USED, SUCH AS MANUFACTURER'S SPECIFICATIONS).

2. FOR STUD COLUMNS OF 4 OR MORE, INSTALL SST CS16 STRAPS @ 30" OC, 6" MAX FROM PLATES, ON INSIDE FACE OF COLUMN (EXTERIOR WALL), ON BOTH FACES OF COLUMN (INTERIOR WALL).

I-JOIST SPACING NOT TO EXCEED 19.2" OC IN LOCATIONS WITH TILE FINISH FLOOR

ALL FLUSH BEAMS TO BE DIRECTLY SUPPORTED BY (2) 2X STUDS UNLESS OTHERWISE NOTED. STUD FOUNDATION OR TO BEARING COMPONENT BELOW.

**REFER TO I-JOIST EQUIVALENCE CHART ON I-JOIST DETAIL SHEET FOR SUBSTITUTION OF MANUFACTURER SERIES

FLOOR FRAMING TO BE 14" DEEP TJI 210 SERIES OR EQUAL, 19.2" OC MAXIMUM SPACING, U.N.O.

KB HOME

NORTH CAROLINA DIVISION 4518 S. MIAMI BLVD. SUITE 180 DURHAM, NC 27703 TEL: (919) 768-7988

■ FAX: (919) 472-0582 ■

P-0961

JDSfaulkner, PLLC HAS PERFORMED A STRUCTURAL REVIEW OF THESE PLANS. THE TRUCTURAL COMPONENTS COMPLY WITH THE 018 NORTH CAROLINA RESIDENTIAL CODE FOR ONE- AND TWO-FAMILY DWELLINGS FOR NC PLAN REVIEW DEVIATION OF ANY STRUCTURA REQUIREMENTS OF THESE PLANS WITHOUT THE APPROVAL OF THE EOR IS PROHIBITED.




8600 'D' JERSEY CT, RALEIGH, NC 27617;919 480 1075 INFO@JDSfaulkner.COM; WWW.JDSfaulkner.COM

07/14/2020

240,2596

. . . .

FIRST FLOOR CEILING FRAMING PLAN

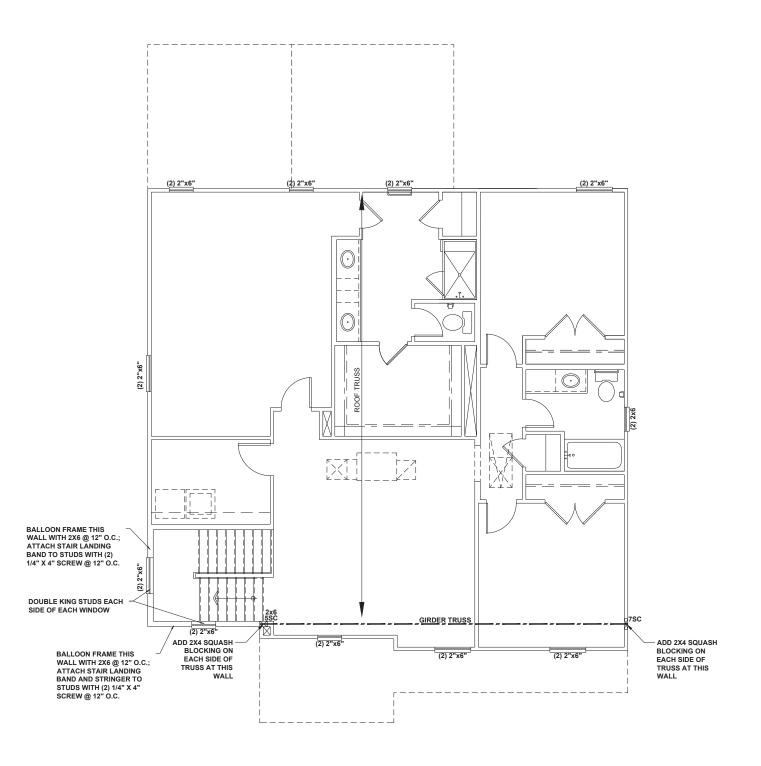

SECOND FLOOR CEILING FRAMING PLAN - 'B'

SCALE: 1/8" = 1'-0"

BEAM & POINT LOAD LEGEND

INTERIOR LOAD BEARING WALL

- ROOF RAFTER / TRUSS SUPPORT

----- DOUBLE RAFTER / DOUBLE JOIST --- STRUCTURAL BEAM / GIRDER

WINDOW / DOOR HEADER

POINT LOAD TRANSFER POINT LOAD FROM ABOVE BEARING ON BEAM / GIRDER

STRUCTURAL FRAMING NOTES - (SEE GENERAL NOTES SHEET FOR ADDITIONAL REQUIREMENTS.)

ALL FRAMING TO BE #2 SPF MINIMUM

ALL BEARING HEADERS TO BE (2) 2x6 SUPPORTED w/ MIN (1) JACK AND (1) KING EACH END, UNO.

EXTERIOR WALL OPENINGS OVER 3' TO HAVE MULTIPLE KING STUDS AS NOTED ON PLAN.

ALL NON-BEARING HEADERS TO BE (2) 2x4 (1) J / (1) K, UNO.

PROVIDE CONTINUOUS BLOCKING THROUGH STRUCTURE FOR ALL POINT LOADS.

ALL HANGERS AND CONNECTORS SPECIFIED ARE TO BE SIMPSON STRONG-TIE OR EQUIVALENT

ALL BEAMS SPECIFIED ARE MINIMUM SIZES ONLY. LARGER MEMBERS MAY SUBSTITUTED AS NEEDED FOR EASE OF CONSTRUCTION. MINIMUM BEAM SUPPORT IS (1) 2x4 STUD.

ALL EXTERIOR WALLS TO BE FULLY SHEATHED

FRONT PORCH COLUMNS TO BE MIN 4x4 PT ATTACHED AT TOP AND BOTTOM USING SIMPSON (OR EQUIV) COLUMN BASE OR SST A24 BRACKETS. TRIM OUT PER BUILDER.

10. PORCH COLUMNS TO BE MIN 4x4 PT ATTACHED A BOTTOM USING SIMPSON (OR EQUIV) ABA44 AND AT TOP USING CS 16 STRAPPING (12" MIN) TO PORCH HEADER / BAND.

WHEN A 4-PLY LVL IS USED. ATTACH WITH (1) 1/2" Ø BOLT 12" OC STAGGERED, TOP AND BOTTOM, 1-1/2" MIN FROM ENDS. ALTERNATE ATTACHMENT EQUIVALENT METHOD MAY BE USED, SUCH AS MANUFACTURER'S SPECIFICATIONS).

2. FOR STUD COLUMNS OF 4 OR MORE, INSTALL SST CS16 STRAPS @ 30" OC, 6" MAX FROM PLATES, ON INSIDE FACE OF COLUMN (EXTERIOR WALL), ON BOTH FACES OF COLUMN (INTERIOR WALL).

ALL FLUSH BEAMS TO BE DIRECTLY SUPPORTED BY
(2) 2X STUDS UNLESS OTHERWISE NOTED. STUD COLUMNS TO BE SUPPORTED BY SOLID BLOCKING TO FOUNDATION OR TO BEARING COMPONENT BELOW.



KB HOME NORTH CAROLINA DIVISION

4518 S. MIAMI BLVD. SUITE 180 DURHAM, NC 27703 TEL: (919) 768-7988

■ FAX: (919) 472-0582 ■

045403
7/14/2
CINGINEE

P-0961

JDSfaulkner, PLLC HAS PERFORMED A STRUCTURAL REVIEW OF THESE PLANS, THE TRUCTURAL COMPONENTS COMPLY WITH THE 018 NORTH CAROLINA RESIDENTIAL CODE FOR ONE- AND TWO-FAMILY DWELLINGS FOR NC PLAN REVIEW DEVIATION OF ANY STRUCTURA REQUIREMENTS OF THESE PLANS WITHOUT THE APPROVAL OF THE EOR IS PROHIBITED.




07/14/2020

240,2596

. . . .

SECOND FLOOR CEILING FRAMING PLAN

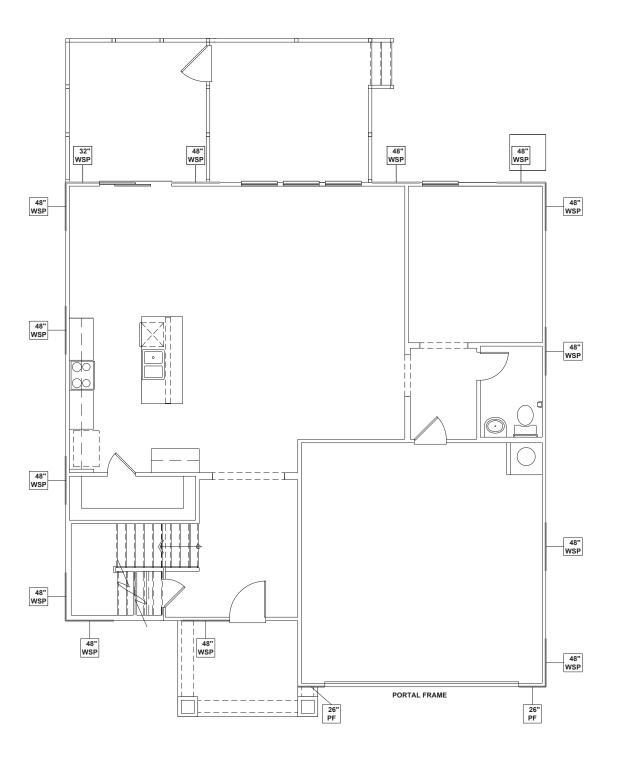

FIRST FLOOR WALL BRACING PLAN - 'B'

SCALE: 1/8"=1'-0"

WALL BRACING REQUIREMENTS

- MINIMUM PANEL WIDTH IS 24" FIGURES BASED ON THE CONTINUOUS SHEATHING METHOD USING THE RECTANGLE CIRCUMSCRIBED AROUND THE FLOOR PLAN OR PORTION OF THE FLOOR PLAN. IF NO RECTANGLE IS NOTED, THE STRUCTURE HAS BEEN FIGURED ALL WITHIN ONE RECTANGLE.
 - PANELS MAY SHIFT UP TO 36" EITHER DIRECTION
- FOR EASE OF CONSTRUCTION (NAILING & BLOCK REQUIREMENTS STILL APPLY).
- FOR ADDITIONAL WALL BRACING INFORMATION,
 REFER TO WALL BRACING DETAIL SHEET(S).

 SCHEMATIC BELOW INDICATES HOW SIDES OF RECTANGLE ARE TO BE INTERPRETED IN BRACING CHART WHEN APPLIED TO STRUCTURE:



CS16 STRAP FROM STUD, CROSS HEADER, TO WALL TOP PLATE, 36" LONG MINIMUM

SIMPSON MSTA15 HOLD DOWN CAPACITY OF 970 POUNDS PER ANCHOR WITH (12) 10d NAILS. STRAP TO BE LOCATED AT EDGE OF BRACED WALL PANEL (CS16 STRAPPING MAY BE SUBSTITUTED W/ SIMILAR LENGTH AND NAILING PATTERN.) USE HTT4 FOR ATTACHMENT TO CONCRETE.

SCALED LENGTH 24"-OF WALL PANEL AT LOCATION — OF PANEL PANEL TYPE

WALL BRACING NOTE:

WALLS WITH PROVIDED LENGTH LISTED AS "N/A" DO NOT MEET THE REQUIREMENTS OF PRESCRIPTIVE WALL BRACING FOUND IN THE NCRC. THESE WALLS HAVE BEEN ENGINERERED BASED ON DESIGN GUIDELINES ESTABLISHED IN ASCE-07 AND THE NDS: WIND & SEISMIC PROVISIONS SUPPLEMENT.

WALL BRACING: RECTANGLE 1

SIDE	REQUIRED LENGTH	PROVIDED LENGTH
FRONT	12.0 FT.	16.6 FT.
RIGHT	12.0 FT.	16.0 FT.
REAR	12.0 FT.	14.6 FT.
LEFT	12.0 FT.	16.0 FT.



•	•	•	•	•
	2	номе	KB	
NC	DIVISIO	LINA	CARO	ORTH
-	BLVD.			4518
	0 27703		SUIT: HAM.	DUR
	7988			
	2-0582	472	(919	FAX:




JDSfaulkner, PLLC HAS PERFORMED A STRUCTURAL REVIEW OF THESE PLANS. THE STRUCTURAL COMPONENTS COMPLY WITH THE 2018 NORTH CAROLINA RESIDENTIAL CODE FOR ONE- AND TWO-FAMILY DWELLINGS FOR NC PLAN REVIEW. DEVIATION OF ANY STRUCTURAL REQUIREMENTS OF THESE PLANS WITHOUT THE APPROVAL OF THE EOR IS PROHIBITED.



240,2596

FIRST FLOOR WALL BRACING PLAN

.

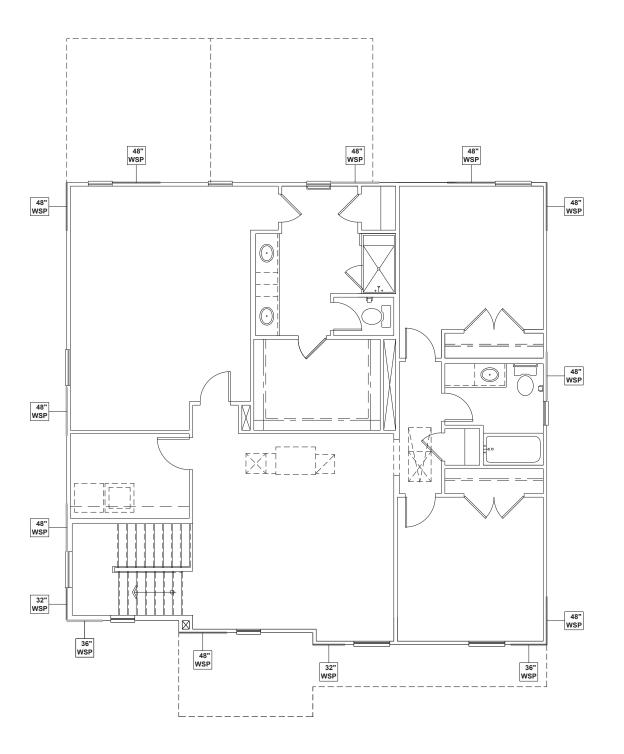

SECOND FLOOR WALL BRACING PLAN - 'B'

SCALE: 1/8" = 1'-0"

WALL BRACING REQUIREMENTS

- MINIMUM PANEL WIDTH IS 24" FIGURES BASED ON THE CONTINUOUS SHEATHING METHOD USING THE RECTANGLE CIRCUMSCRIBED AROUND THE FLOOR PLAN OR PORTION OF THE FLOOR PLAN. IF NO RECTANGLE IS NOTED, THE STRUCTURE HAS BEEN FIGURED ALL WITHIN ONE RECTANGLE.
 - PANELS MAY SHIFT UP TO 36" EITHER DIRECTION
- FOR EASE OF CONSTRUCTION (NAILING & BLOCK REQUIREMENTS STILL APPLY).
- FOR ADDITIONAL WALL BRACING INFORMATION, REFER TO WALL BRACING DETAIL SHEET(S). SCHEMATIC BELOW INDICATES HOW SIDES OF RECTANGLE ARE TO BE INTERPRETED IN BRACING CHART WHEN APPLIED TO STRUCTURE:



CS16 STRAP FROM STUD, CROSS HEADER, TO

SIMPSON MSTA15 HOLD DOWN CAPACITY OF 970 POUNDS PER ANCHOR WITH (12) 10d NAILS. STRAF TO BE LOCATED AT EDGE OF BRACED WALL PANEL (CS16 STRAPPING MAY BE SUBSTITUTED W/ SIMILAR LENGTH AND NAILING PATTERN.) USE HTT4 FOR ATTACHMENT TO CONCRETE.

-NUMERICAL SCALED LENGTH 24"-LENGTH OF PANEL OF WALL PANEL
AT LOCATION — PANEL TYPE

WALL BRACING NOTE:

WALLS WITH PROVIDED LENGTH LISTED AS "N/A" DO NOT MEET THE REQUIREMENTS OF PRESCRIPTIVE WALL BRACING FOUND IN THE NCRC. THESE WALLS HAVE BEEN ENGINEERED BASED ON DESIGN
GUIDELINES ESTABLISHED IN ASCE-07 AND THE NDS: WIND & SEISMIC PROVISIONS SUPPLEMENT.

WALL BRACING: RECTANGLE 1

SIDE	REQUIRED LENGTH	PROVIDED LENGTH
FRONT	6.0 FT.	12.6 FT.
RIGHT	6.0 FT.	12.0 FT.
REAR	6.0 FT.	12.0 FT.
LEFT	6.0 FT.	14.6 FT.



	KB	HOME	
ORTH	CAR	DLINA	DIVISION

4518 S. MIAMI BLVD. SUITE 180 DURHAM, NC 27703 TEL: (919) 768-7988

■ FAX: (919) 472-0582 ■



P-0961

JDSfaulkner, PLLC HAS PERFORMED A STRUCTURAL REVIEW OF THESE PLANS. THE STRUCTURAL COMPONENTS COMPLY WITH THE 2018 NORTH CAROLINA RESIDENTIAL CODE FOR ONE- AND TWO-FAMILY DWELLINGS FOR NC PLAN REVIEW. DEVIATION OF ANY STRUCTURAL REQUIREMENTS OF THESE PLANS WITHOUT THE APPROVAL OF THE EOR IS PROHIBITED.




8600 'D' JERSEY CT, RALEIGH, NC 27617;919.480.1075 INFO@JDSfaulkner.COM; WWW.JDSfaulkner.COM

240,2596

SECOND FLOOR WALL BRACING PLAN

S5.0B

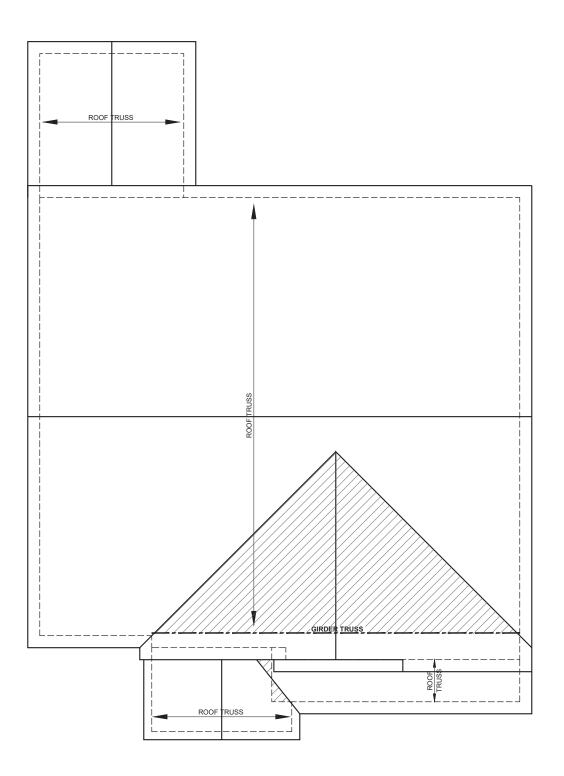

ROOF FRAMING PLAN - 'B'

SCALE: 1/8"=1'-0"

BEAM & POINT LOAD LEGEND

INTERIOR LOAD BEARING WALL

--- ROOF RAFTER / TRUSS SUPPORT

DOUBLE RAFTER / DOUBLE JOIST
STRUCTURAL BEAM / GIRDER

WINDOW / DOOR HEADER

POINT LOAD TRANSFER

■ POINT LOAD FROM ABOVE BEARING ON BEAM / GIRDER

TRUSSED ROOF - STRUCTURAL NOTES

 PROVIDE CONTINUOUS BLOCKING THROUGH STRUCTURE FOR ALL POINT LOADS.

2.

DENOTES OVER-FRAMED AREA

3. MINIMUM 7/16" OSB ROOF SHEATHING

4. TRUSS LAYOUT AND PLACEMENT BY MANUFACTURER TO COINCIDE WITH THE SUPPORT LOCATIONS SHOWN. TRUSS PROFILES SHALL BE SEALED BY THE TRUSS MANUFACTURER. TRUSS PLANS TO BE COORDINATED WITH THE SEALED STRUCTURAL DRAWINGS. INSTALLATION SHALL BE IN ACCORDANCE WITH THE MANUFACTURER'S INSTRUCTIONS.

5. MANUFACTURER TO PROVIDE REQUIRED UPLIFT CONNECTION.

6. PROVIDE H2.5A (MINIMUM) OR EQUIVALENT AT EACH TRUSS-TO-TOP PLATE CONNECTION AT OVER-FRAMED AREAS, UNLESS NOTED OTHERWISE.

7. UPLIFT CONNECTION TO BE CARRIED THROUGH TO FLOOR SYSTEM.

TRUSS UPLIFT CONNECTORS: EXPOSURE B, 115 MPH, ANY PITCH, 24" O.C. MAX ROOF TRUSS SPACING

TRUSSES SHALL BE ATTACHED TO SUPPORT WALL FOR UPLIFT RESISTANCE. CONTINUOUS OSB WALL SHEATHING BELOW PROVIDES CONTINUOUS UPLIFT RESISTANCE TO FOUNDATION. ALL TRUSSES SUPPORTED BY INTERMEDIATE SUPPORT WALLS, KNEEWALLS, OR BEAMS SHALL BE ATTACHED TO SUPPORTING MEMBER PER SCHEDULE:

ROOF SPAN IS MEASURED HORIZONTALLY BETWEEN FURTHEST SUPPORT POINTS.

ROOF PLAN UP TO 28' CONNECTOR NAILING PER TABLE 602.3(1)

OVER 28'

(1) SIMPSON H2.5A HURRICANE CLIP TO DBL TOP PLATE OR

OR (1) SIMPSON H3 CLIP TO SINGLE 2x4 PLATE



KB HOME NORTH CAROLINA DIVISION

4518 S. MIAMI BLVD.
SUITE 180
DURHAM, NC 27703
TEL: (919) 768-7988
FAX: (919) 472-0582

| . . .

CAROUNDE SEAL STATES E STATES

P-0961

JDSfaulkner, PLLC HAS PERFORMED A STRUCTURAL REVIEW OF THESE PLANS. THE STRUCTURAL COMPONENTS COMPLY WITH THE 2018 NORTH CAROLINA RESIDENTIAL CODE FOR ONE- AND TWO-FAMILY DWELLINGS FOR NC PLAN REVIEW. DEVIATION OF ANY STRUCTURAL REQUIREMENTS OF THESE PLANS WITHOUT THE APPROVAL OF THE EOR IS PROHIBITED.



O@JDSfaulkner.COM; WWW.JDSfaulkner.CO PROJECT NO.: 20901051


DATE: 07/14/2020


PLAN: **240.2596**


.

ROOF FRAMING PLAN

S7.0B

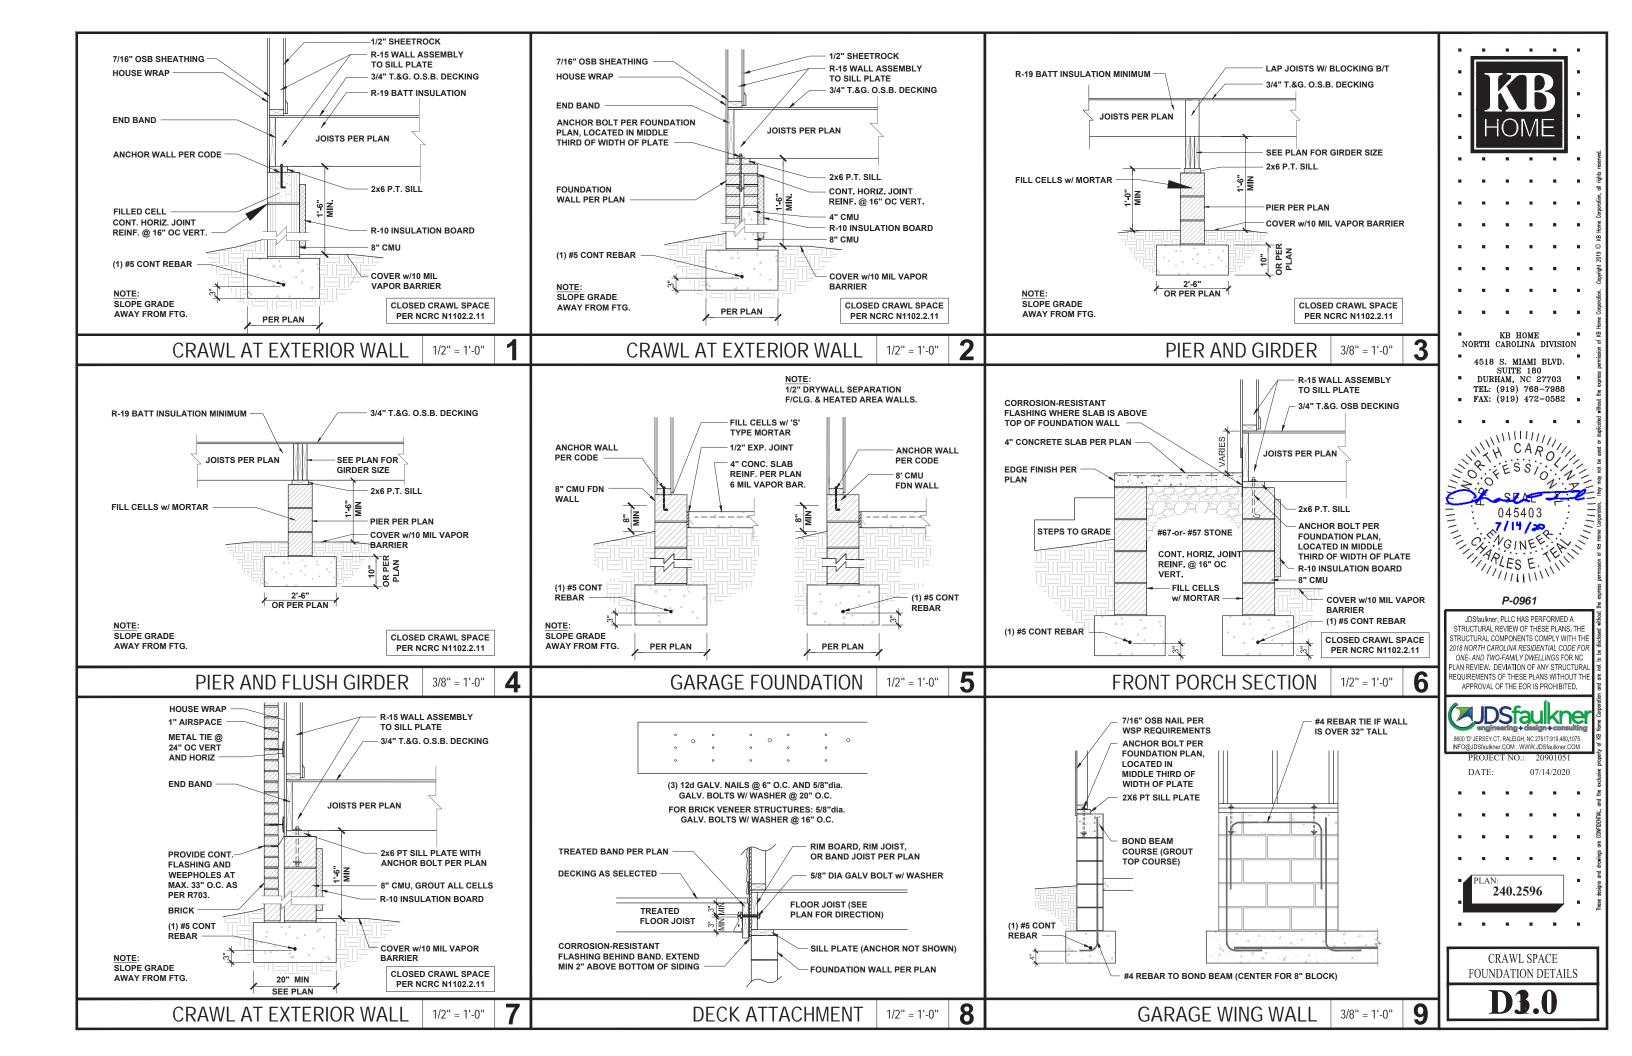

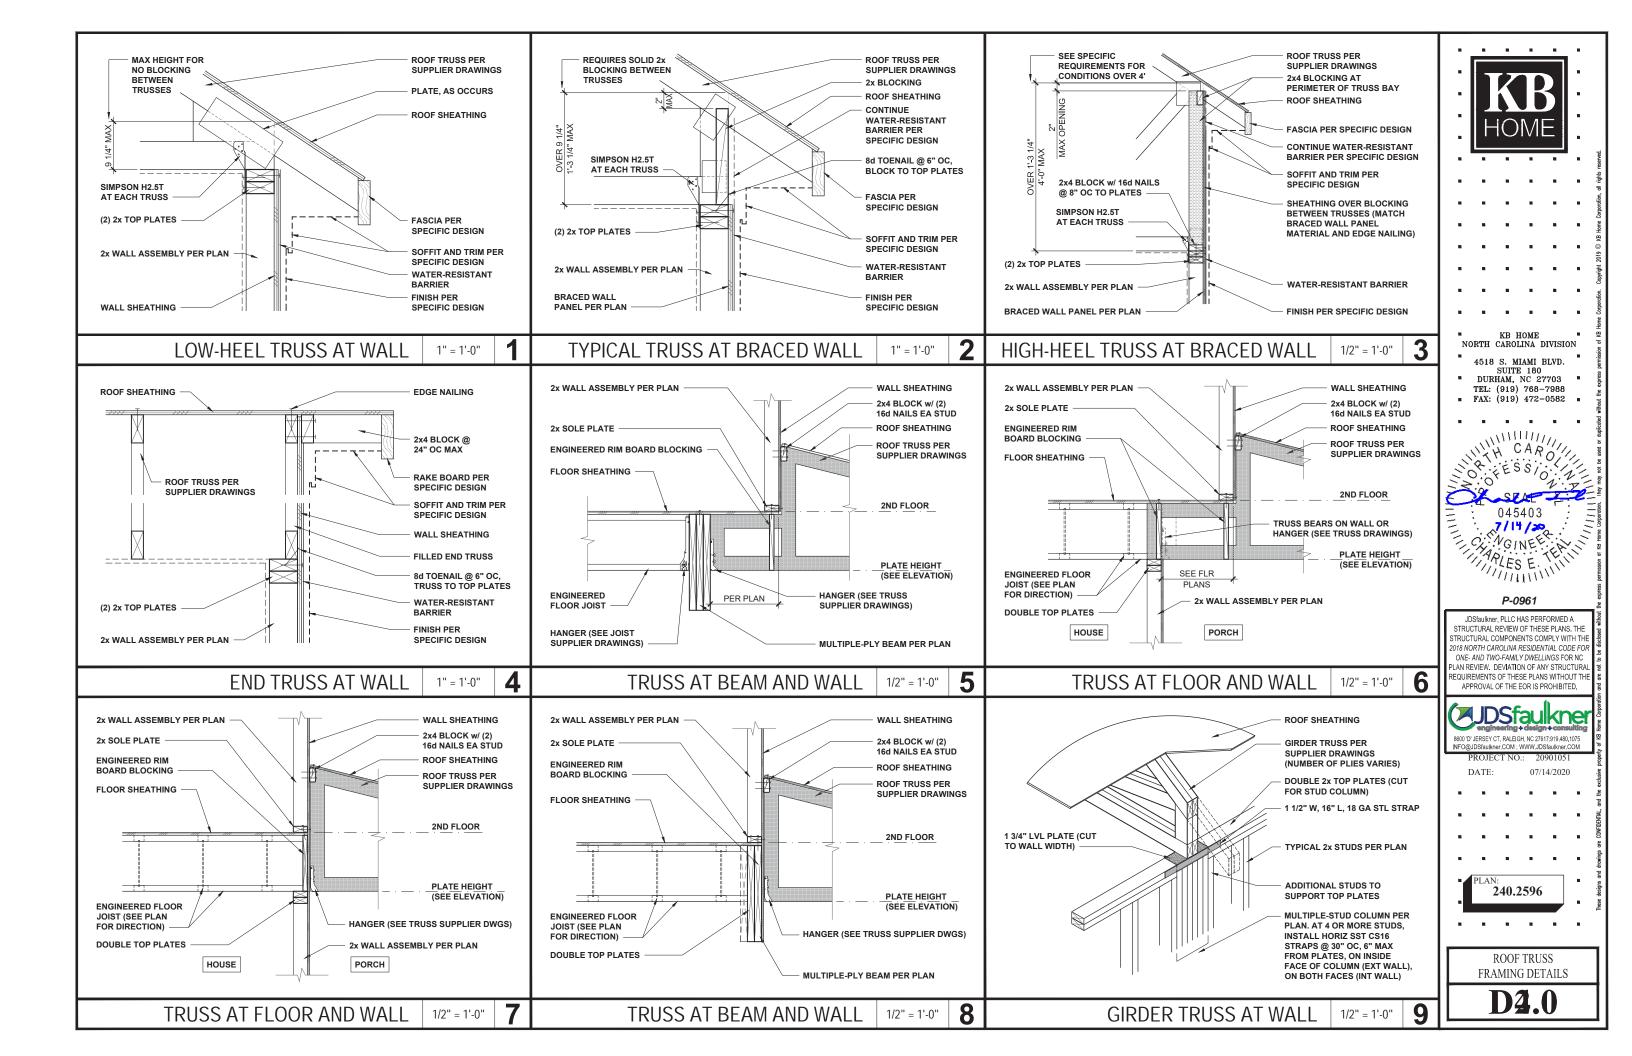

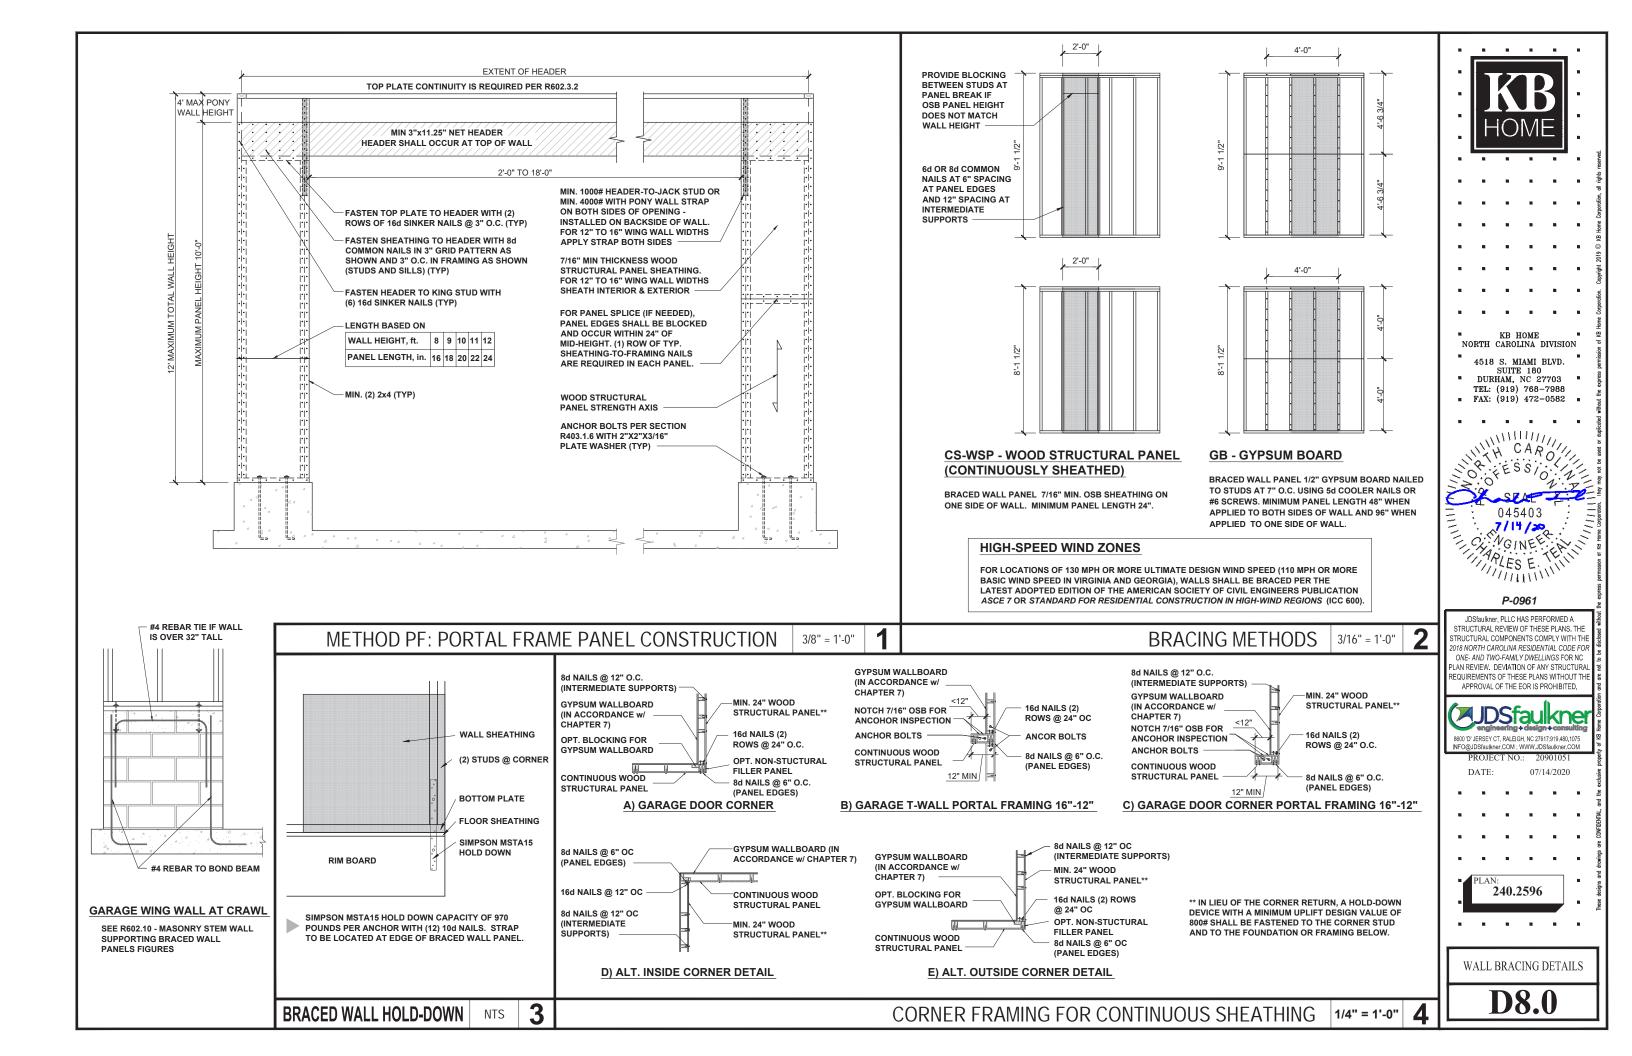

When sheathing thickness exceeds 7/8", JOIST DETAILS Load bearing or shear wall above IRC 502-7 requires lateral (must stack over wall below) **BEAM and COLUMN DETAILS** restraint (blocking) at all Plate nail - 16d (0.135" x intermediate supports in Floor panel nail - 8d (0.131" x $2\frac{1}{2}$ ") at 6" on-center* D0, D1, and D2 to strengthen the floor diaphragm. 11/4" rim board or blocking for lateral support Web Stiffeners required squash blocks BEAM TO BEAM CONNECTION B1 B1W 11/4" LSL or 11/8" rim board.* Toe nail - 10d (0.131" x 3") required each side $\widehat{L1}$ TJI® rim iois For rim board thicker than 1 3/4" at B1W and B2W - Attach Joist to rim board with one 10d (0.128"x3") nail. (A3) Blocking panels may be A2 A2W Must have 13/4" minimum joist bearing B2 B2W Top nail from joist into rim board. required with shear wa (L3) - Connect corner with four 10d (0.128"x3") nails. Toe nail from side of parallel closure into rim board at ends. Attach rim joist per A3 detail above or below - see detail B1 A3W INTERMEDIATE BEARING Load bearing or shear wall BEARING AT CONCRETE WALL NO LOAD BEARING WALL ABOVE above (must stack over wall Load from above Web stiffeners required each side at B3W Blocking panel 60% of joist dept (L4) BEARING AT COLUMN Protect untreated wood from direct contact with concret required on each side of both iois Blocking panels may be Verify column capacity of support Use 2x4 minimum squash blocks B3 B3W B4 B4W (CS) to transfer load around joist of hanger do not laterally suppor above or below (See detail B1) **FASTENING of FLOOR PANELS** * SEE I-JOIST EQUIVALENCE CHART FILLER and BACKER BLOCK SIZES * SEE I-JOIST EQUIVALENCE CHART Guidelines for Closest On-Center Spacing per Row 110 FO * 230 or 360 FO * Rim Board 210 FO * 560 FO * I-Joists PSI LVL Nail Size 360 and 9½" or LSL or wide Depth nd 230 EQ. 560 FQ 16" 8d (0.131" x 2½") 3" Filler Block $2x8 + \frac{1}{2}$ " $2x12 + \frac{1}{2}$ 2x6 2x8 (Detail H2) sheathing sheathi sheathing sheathing sheathing 2x6 2x8 2x12 10d (0.148"x 3"), 12d (0.148"x 31/4") 4" 4" 4" 2x6 2x10 $2x6 + \frac{3}{8}$ " $2x10 + \frac{3}{2}$ 2x10 + 1/2 16d (0.162"x 3½") 6" 6" 6"(2) 6"(2) 8" 6" Cantilever Fille 4'-0" 6'-0" sheathing sheathing sheathing sheathing (Detail E4) applicable applicable (1) One row of fasteners permitted (two at abutting panel edges) for diaphragms. Stagger nails when long long 4'-0" long 6'-0" long 4'-0" long 6'-0" long using 4" on-center spacing and maintain 3/8" joist and panel edge distance. For other applications, Backer Block (5/8" or 3/4" 3/4" or 7/8" 1" Net 2x6 2x8 2x12 multiple rows of fasteners are permitted if the rows are offset at least $\frac{1}{2}$ " and staggered. (Detail F1 or H2 (2) Can be reduced to 4" on-center if nail penetration into the narrow edge is no more than 1 3/8" (to avoid splitting). (1) If necessary, increase filler and backer block height for face mount hangers and maintain $\frac{1}{8}$ " gap at top of joist; see detail W. Filler and backer block lengths should accomodate required nailing • Recommended nailing is 12" on-center in field and 6" on-center along panel edge. Fastening requirements on engineered drawings supersede without splitting (12" minimum for backer blocks and 24" minimum for filler blocks). recommendations listed above. Joists must be laterally supported at cantilever and end bearings by blocking panels, hangers, or direct attachment to a rim board or rim joist. • Recommended use of a non-polyurethane subfloor adhesive on all contact points between panels and floor framing. Safety bracing (1x4 minimum) at 8' on-center (6' on-center for 110 or • Nailing rows must be offset at least 1/2" and staggered. equivalent Joists) and extended to a braced end wall. Fasten at each joist with two 8d (0.113" x $2\frac{1}{2}$ ") nails minimum (see WARNING). • 14 ga. staples may be substituted for 8d (0.113" x 21/3") nails if minimum DO NOT bevel cut joist penetration of 1" into the joist or rim beyond inside face of wall board is achieved. Rim board join • Maximum spacing of nails is 18" on-center for joists. on heams beyond the inside Rim joist $1\frac{1}{4}$ " rim board. $\widehat{A2}$ L5 (P) Use B1 or B2 at End of joists at see note 3 under DO NOT use sawn lumber for rim board or blocking, as

Protect untreated

wood from direct

11/3" knockouts at

face of wall or beam

12" on-center

it may shrink after

installation. Use only


INSTALLATION TIPS

Subfloor adhesive will improve floor performance, but may not be required.

Squash blocks and blocking panels carry stacked vertical loads (details B1 and B2). Packing out the web of a joist (with web stiffeners) is not a substitute for squash blocks or blocking panels.

When joists are doubled at non-load bearing parallel partitions, space joists apart the width of the wall for plumbing or HVAC.


Additional joist at plumbing drop (see detail).

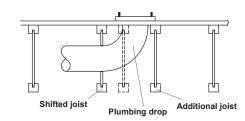

* I-JOIST EQUIVALENCY CHART

EQUIVALENT IN SPAN AND SPACING			
Depth	Mftr & Series	Mftr & Series	Mftr & Series
9 1 "	TJI - 110	BCI 4500	
	TJI - 210	BCI 5000	
	TJI - 230	BCI 6000	EverEdge 20
		BCI 6500	
11 ⁷ 8"	TJI - 110	BCI 4500	
	TJI - 210	BCI 5000	
	TJI - 230	BCI 6000	EverEdge 20
		BCI 6500	
	TJI - 360	BCI 60'S	EverEdge 30
	TJI - 560	BCI 90'S	EverEdge 50/60
14"	TJI - 110	BCI 4500	
	TJI - 210	BCI 5000	
	TJI - 230	BCI 6000	EverEdge 20
		BCI 6500	
	TJI - 360	BCI 60'S	EverEdge 30
	TJI - 560	BCI 90'S	EverEdge 50/60
16"	TJI - 110	BCI 4500	
	TJI - 210	BCI 5000	
	TJI - 230	BCI 6000	EverEdge 20
		BCI 6500	
	TJI - 360	BCI 60'S	EverEdge 30
	TJI - 560	BCI 90'S	EverEdge 50/60

JOIST NAILING REQUIREMENTS at BEARING

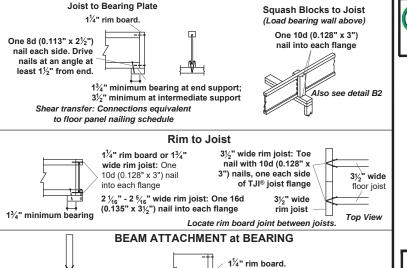

Drive nails at an

angle to minimize

splitting of plate

See framing plan (if applicable) or iLevel® Framer's Pocket

Guide for minimum end and

intermediate bearing lengths

One 10d (0.128" x 3")

nail each side of member at bearing, 11/2"

minimum from end



KB HOME NORTH CAROLINA DIVISION

4518 S. MIAMI BLVD. SUITE 180 DURHAM, NC 27703 TEL: (919) 768-7988

■ FAX: (919) 472-0582 ■

ON NGINE 045403

P-0961

JDSfaulkner, PLLC HAS PERFORMED A STRUCTURAL REVIEW OF THESE PLANS. THE STRUCTURAL COMPONENTS COMPLY WITH THE 018 NORTH CAROLINA RESIDENTIAL CODE FOR ONE- AND TWO-FAMILY DWELLINGS FOR NC PLAN REVIEW DEVIATION OF ANY STRUCTURAL REQUIREMENTS OF THESE PLANS WITHOUT THE APPROVAL OF THE EOR IS PROHIBITED.



07/14/2020

240,2596

. . . .

ENGINEERED JOIST

DETAILS