


VICINITY MAP
Not To Scale

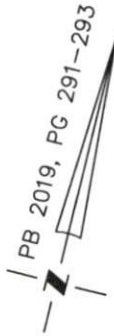


IMPERVIOUS SURFACE AREA	
DESCRIPTION	AREA (S.F.)
LOT AREA TO B/C	26,641
HOUSE	1,716
DRIVE TO R/W	650
DRIVE APRON	247
PATIO	140
LEAD WALK	42
PUBLIC WALK	0
TOTAL PROPOSED	2,795
% IMPERVIOUS AREA	=10.5%
SOD/SEEDING	
TYPE	S.F.
SOD	4,497
SEED & STRAW	19,349

SETBACKS: (PB 2019 PG 291)


FRONT - 35'
SIDE - 10'
REAR - 25'
CORNER - 20'

N/F
ALLEN MASON
SOLID ROCK
MINISTRIES CHURCH
D.B. 2386, PG. 265

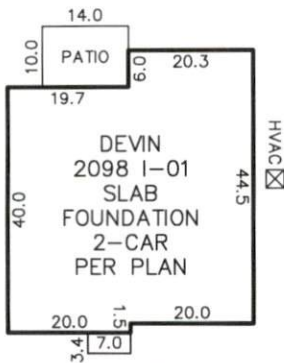

INSET
N.T.S.

N/F
PENNY MATTHEWS REYNOLDS
D.B. 1002, PG. 53

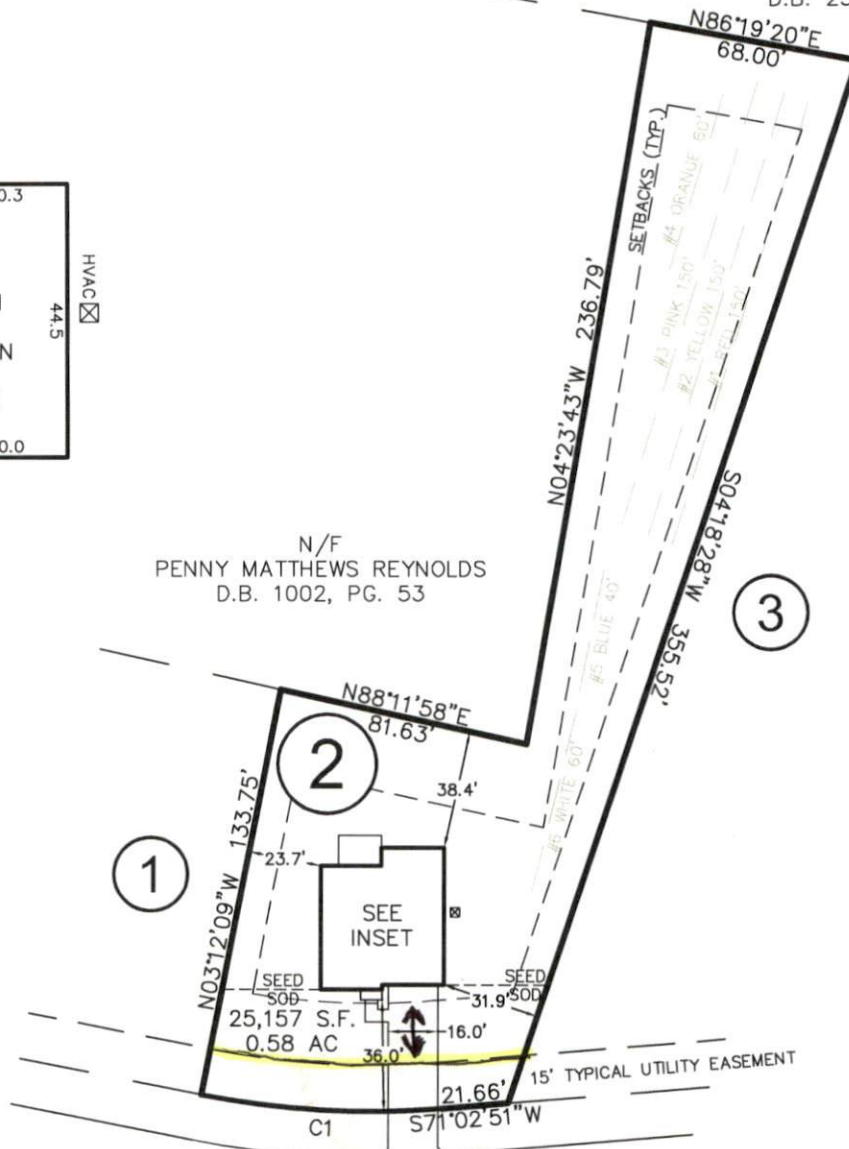


NORRIS FARM DRIVE

50' PUBLIC R/W &
UTILITY EASEMENT

CURVE	RADIUS	ARC LENGTH	CH LENGTH	CH BEARING
C1	285.00'	78.34'	78.10'	N78°55'21"E

THIS DRAWING DOES NOT
REFLECT AS-BUILT INFORMATION

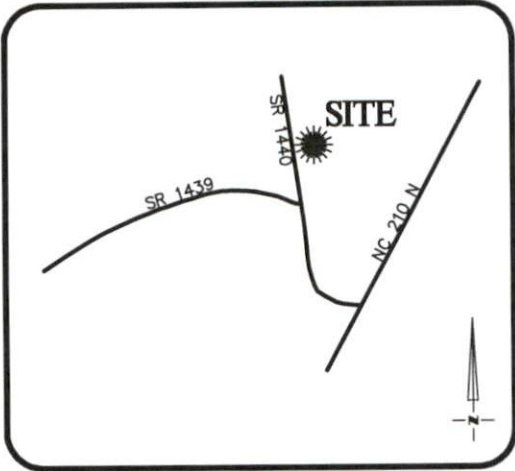


VICINITY MAP
Not To Scale



IMPERVIOUS SURFACE AREA	
DESCRIPTION	AREA (S.F.)
LOT AREA TO B/C	26,641
HOUSE	1,716
DRIVE TO R/W	650
DRIVE APRON	247
PATIO	140
LEAD WALK	42
PUBLIC WALK	0
TOTAL PROPOSED	2,795
% IMPERVIOUS AREA	=10.5%
SOD/SEEDING	
TYPE	S.F.
SOD	4,497
SEED & STRAW	19,349

SETBACKS: (PB 2019 PG 291)

FRONT - 35'
SIDE - 10'
REAR - 25'
CORNER - 20'

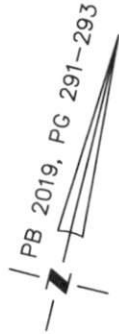


N/F
ALLEN MASON
SOLID ROCK
MINISTRIES CHURCH
D.B. 2386, PG. 265



INSET
N.T.S.

N/F
PENNY MATTHEWS REYNOLDS
D.B. 1002, PG. 53

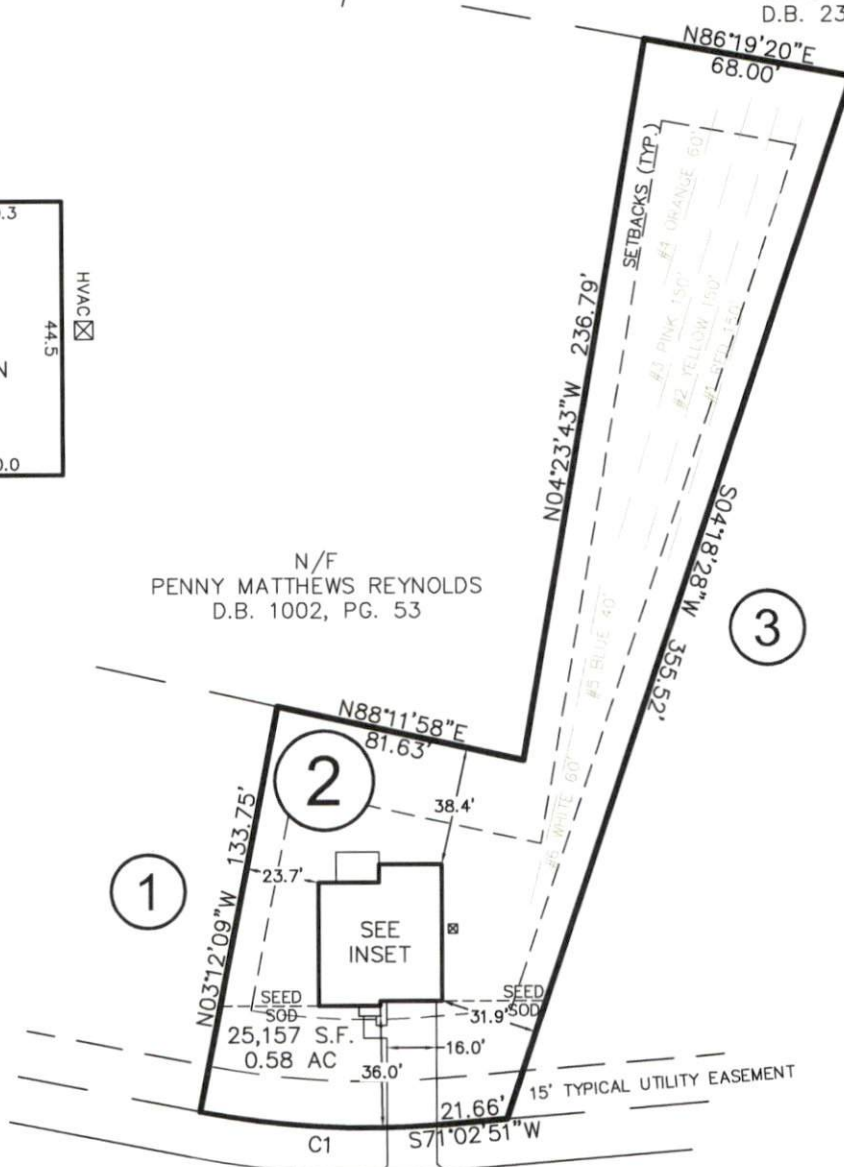

NORRIS FARM DRIVE

50' PUBLIC R/W &
UTILITY EASEMENT

CURVE	RADIUS	ARC LENGTH	CH LENGTH	CH BEARING
C1	285.00'	78.34'	78.10'	N78°55'21\"E

THIS DRAWING DOES NOT
REFLECT AS-BUILT INFORMATION

PRELIMINARY PLAT