

VICINITY MAP  
Not To Scale




IMPERVIOUS SURFACE AREA	
DESCRIPTION	AREA (S.F.)
LOT AREA TO B/C	30,967
HOUSE	1,579
DRIVE TO R/W	779
DRIVE APRON	302
PATIO	100
LEAD WALK	41
PUBLIC WALK	0
TOTAL PROPOSED	2,801
% IMPERVIOUS AREA	=9.0%
SOD/SEEDING	
TYPE	S.F.
SOD	4,856
SEED & STRAW	5,542

SETBACKS: (PB 2019 PG 291)


FRONT - 35'  
SIDE - 10'  
REAR - 25'  
CORNER - 20'

N/F ALLEN MASON SOLID ROCK MINISTRIES CHURCH D.B. 2386, PG. 265

N/F ALLEN MASON SOLID ROCK MINISTRIES CHURCH D.B. 2386, PG. 265

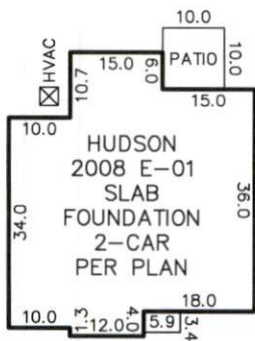

INSET  
N.T.S.

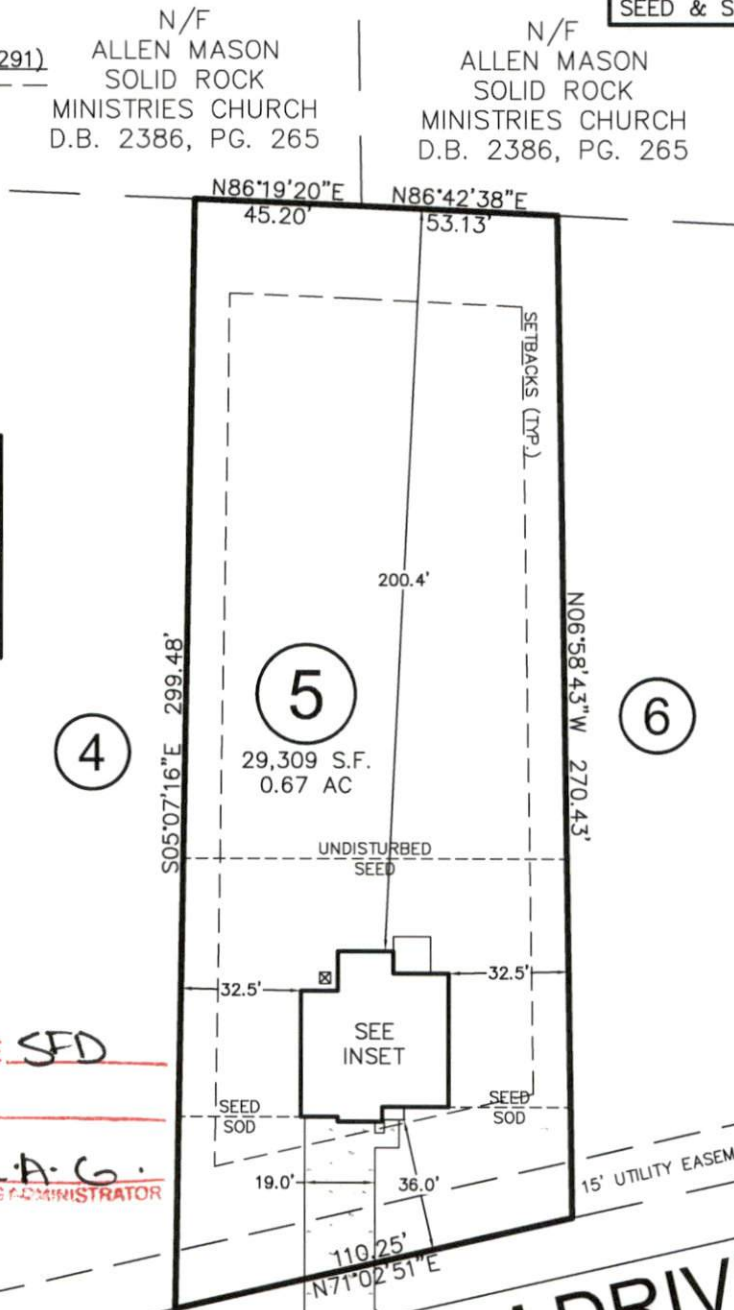

**SITE PLAN APPROVAL**

**DISTRICT RA 30 USE SFD**

**#BEDROOMS 3**

**3-12-20 K.A.G. ZONING ADMINISTRATOR**

**NORRIS FARM DRIVE**  
50' PUBLIC R/W & UTILITY EASEMENT

THIS DRAWING DOES NOT REFLECT AS-BUILT INFORMATION