

LIST OF SYMBOLS

	SECTION MARK		DATUM ELEVATION
	DETAIL MARK		SLOPE UP
	TITLE MARK		EARTH
	INTERIOR BEARING WALL		INSULATION
	NUMBER OF GANG STUDS IN WALL		

TABLE OF CONTENTS

1	ELEVATIONS
2	ELEVATIONS
3	FOUNDATION PLAN
4	1st FLOOR PLAN
5	2nd FLOOR PLAN
E1	1st FLOOR ELECTRICAL PLAN
E2	2nd FLOOR ELECTRICAL PLAN



2 LEFT SIDE ELEVATION
1/4" = 1'-0"

SPACE DATA


FIRST FLOOR, HEATED:	1444 SF
SECOND FLOOR, HEATED:	1418 SF
TOTAL HEATED:	2862 SF
GARAGE:	
FRONT PORCH:	514 SF
REAR PORCH:	46 SF
REAR PORCH:	154 SF

CRDG
CAROLINA RESIDENTIAL DESIGN GROUP, LLC
Professional Architects
Institute of Classical Architecture
Apprentice Institute of Building Design
Certified Professional Building Designer
TODD TUCKER, AIBD, CPBD
910-425-7939

AMERICAN INSTITUTE OF BUILDING DESIGN
AIBD


NATIONAL COUNCIL OF BUILDING DESIGNERS
TODD TUCKER 34 - 156

THE INFORMATION IN THESE CONSTRUCTION DOCUMENTS IS FOR THE EXCLUSIVE USE OF THE CLIENT IN CONNECTION WITH THE BUILDING DESCRIBED IN THE DOCUMENTS. NO REPRESENTATION OR WARRANTY IS PROVIDED OR ACCEPTED BY OR FOR THE ARCHITECT OR ANY OTHER PROFESSIONAL OR INDIVIDUAL PROVIDING THESE DOCUMENTS AND THE CLIENT ASSUMES ALL LIABILITY FOR ANY DAMAGE OR INJURY TO PERSONS OR PROPERTY OF ANY KIND OR FOR ANY LOSS OF PROFITS OR BUSINESS OPERATIONS, WHETHER CAUSED BY OMISSIONS OR BY THE CLIENT'S USE OF THE DOCUMENTS. THE CLIENT SHALL BE RESPONSIBLE FOR THE ACCURACY OF ALL INFORMATION PROVIDED AND OTHER RELATED WORK AS REPRESENTED BY THE RECORD SET FOR THIS PROJECT.

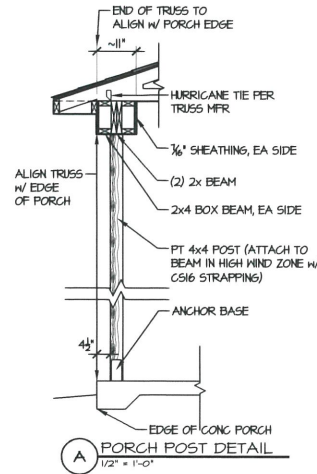


A PORCH POST DETAIL
1/2" = 1'-0"

1 FRONT ELEVATION
1/4" = 1'-0"

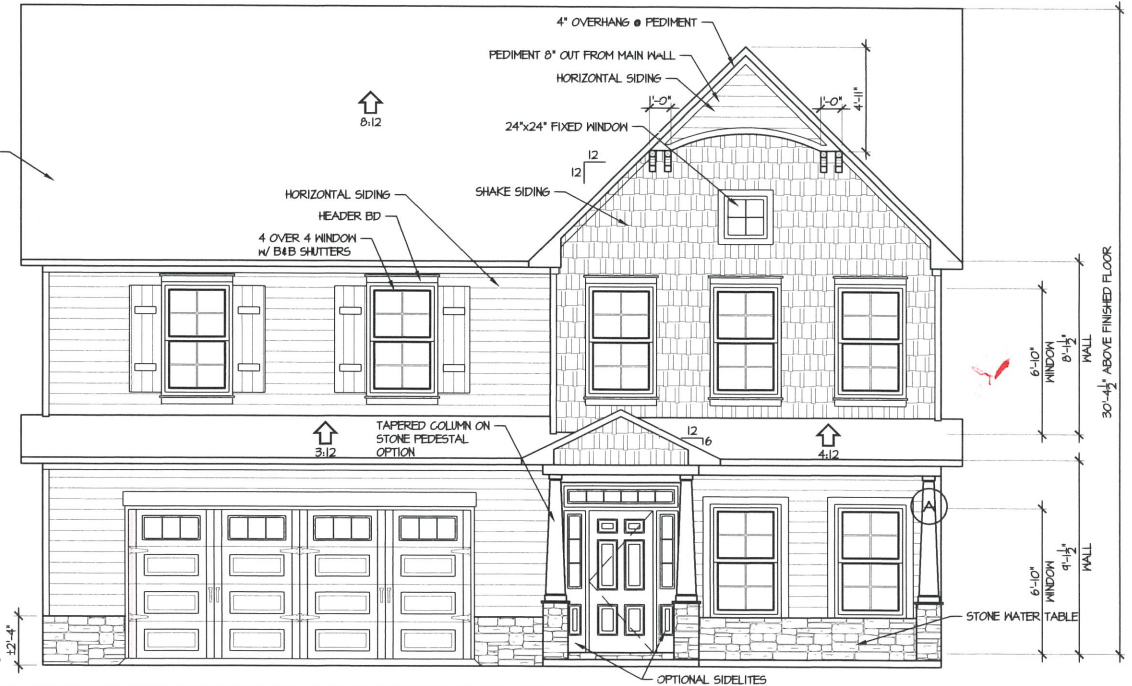

CAVINESS LAND
ELEVATIONS/DETAILS
SHEET TITLE:

CL 2862
SCALE AS NOTED
JANUARY 2018
REV: 1

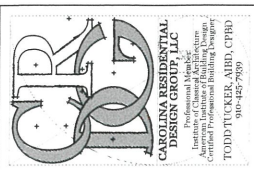

TODD TUCKER 34-156
 THE ARCHITECTURE, ENGINEERING, INTERIOR DESIGN, LANDSCAPE ARCHITECTURE AND ENVIRONMENTAL DESIGN PROFESSIONS ACT IN THE STATE OF NORTH CAROLINA. TODD TUCKER IS A LICENSED ARCHITECT IN THE STATE OF NORTH CAROLINA. HIS LICENSE NUMBER IS 40078. TODD TUCKER IS A LICENSED PROFESSIONAL ENGINEER IN THE STATE OF NORTH CAROLINA. HIS LICENSE NUMBER IS 40078. TODD TUCKER IS A LICENSED INTERIOR DESIGNER IN THE STATE OF NORTH CAROLINA. HIS LICENSE NUMBER IS 40078. TODD TUCKER IS A LICENSED LANDSCAPE ARCHITECT IN THE STATE OF NORTH CAROLINA. HIS LICENSE NUMBER IS 40078.

Caviness Land

ELEVATIONS


SHEET TITLE:

CL 2862

SCALE AS NOTED

JANUARY 2018

REV: 2

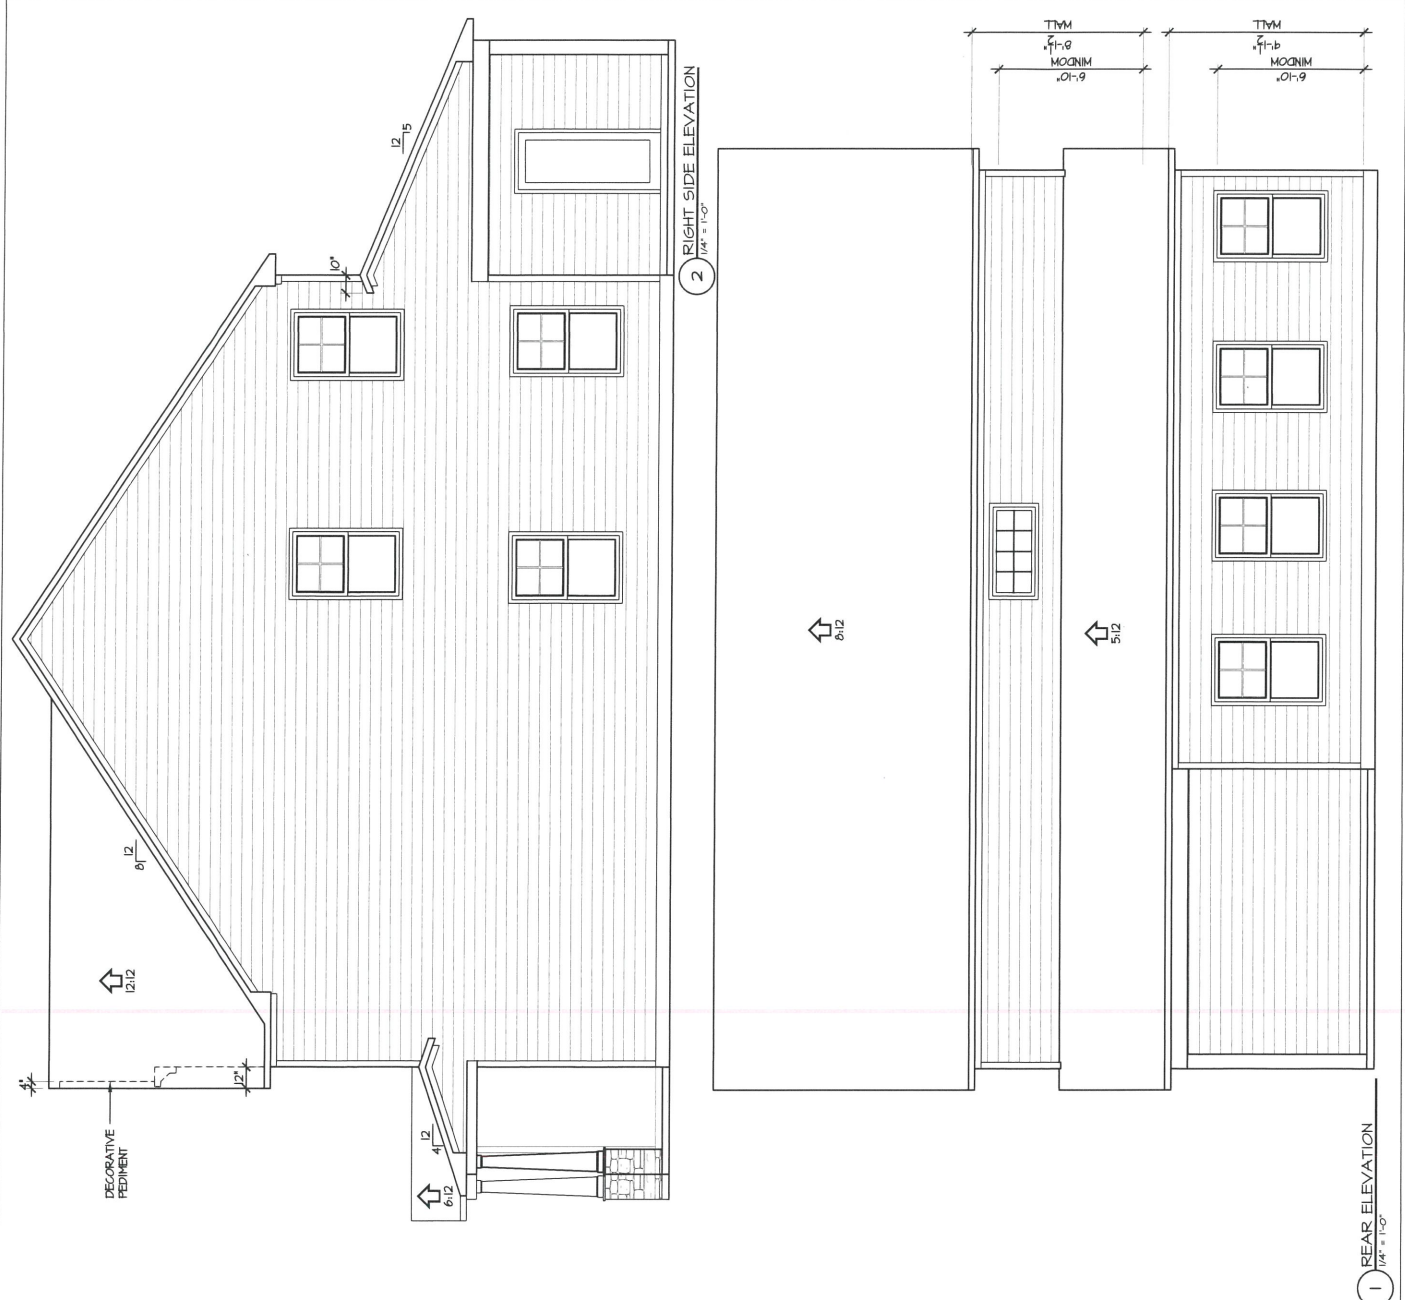

LIST OF ABBREVIATIONS

ACCES	ACCESS TO ATTIC OR CRAWL SPACE	PKT	POCKET DOOR
ABOV	ABOVE FLOOR	PREP	PREPARED
BEAM	BEAM	PL	PLATE
BRM	BEDROOM	PT	POINT LOAD (SOLID BLOCK)
CAB	CABINETS / CABINETRY	PR	PRESSURE TREATED FOR EXPOSURE
CL	CONTROL JOINT	R4S	ROD & SHELF (CLOSERS)
CON	CONCRETE	REF	REFRIGERATOR
CONC	CONCRETE MASONRY UNIT	REIN	REINFORCEMENT
COL	COLUMN	RM	ROOM
CO	CLEAR OPENING	SEG	SEGMENTED
DIAM	DIAMETER	SHWR	SHOWER
DBL	DOUBLE	SHV(S)	SHELVES
DHSH	DOUBLE HINGE / SINGLE HINGE WINDOW	SPEC(T)	SPECIFICATION / SPECIFIED
DN	DOWN	SQ	SQUARE
OPN	OPENING	SST	STAIR-FLOOR
OC	ON CENTER	SUBFL	SUB-FLOOR
CH	CHIMNEYS	SYP	SOUTHERN YELLOW PINE
DM	DISH WASHER		
EQ	EQUAL		
FDN	FOUNDATION		
FV	FOUNDATION VENT		
GL	GLASS (DOOR)		
HB	HOLE DRILL		
HDR	HEATING, VENTING & AIR CONDITION		
HNAC	HEATING, VENTING & AIR CONDITION		
KRMWLL	KNEEWALL		
LVL	LAMINATED VENEER LUMBER		
MANF	MANUFACTURED		
MAS	MASONRY		
NIC	NOT IN CONTRACT		
OV	OVERHANG		

SPACE DATA

FIRST FLOOR HEATED:	1444 SF
SECOND FLOOR HEATED:	1416 SF
TOTAL HEATED:	2862 SF
GARAGE:	54 SF
FRONT PORCH:	46 SF
REAR PORCH:	154 SF

FIELD & REDLINE NOTES

CR
CASAVENESS ARCHITECTURAL DESIGN GROUP P.L.L.C.
 Professional Services
 American Institute of Architecture
 Certified Professional Building Designer
 TODD TUCKER, AIA, AIA, CFPB
 404.857.7300

ABD
AMERICAN INSTITUTE OF BUILDING DESIGN

NATIONAL COUNCIL OF BUILDING PROFESSIONS
TODD TUCKER 34-155

THIS DOCUMENT IS NOT A CONTRACT DOCUMENT. IT IS FOR INFORMATION ONLY. IT IS NOT TO BE USED AS A CONTRACT DOCUMENT. IT IS NOT TO BE USED AS A CONTRACT DOCUMENT. IT IS NOT TO BE USED AS A CONTRACT DOCUMENT.


Caviness Land
FIRST FLOOR PLAN
 SHEET TITLE:

CL 2062

SCALE AS NOTED

JANUARY 2018

REV: **4**

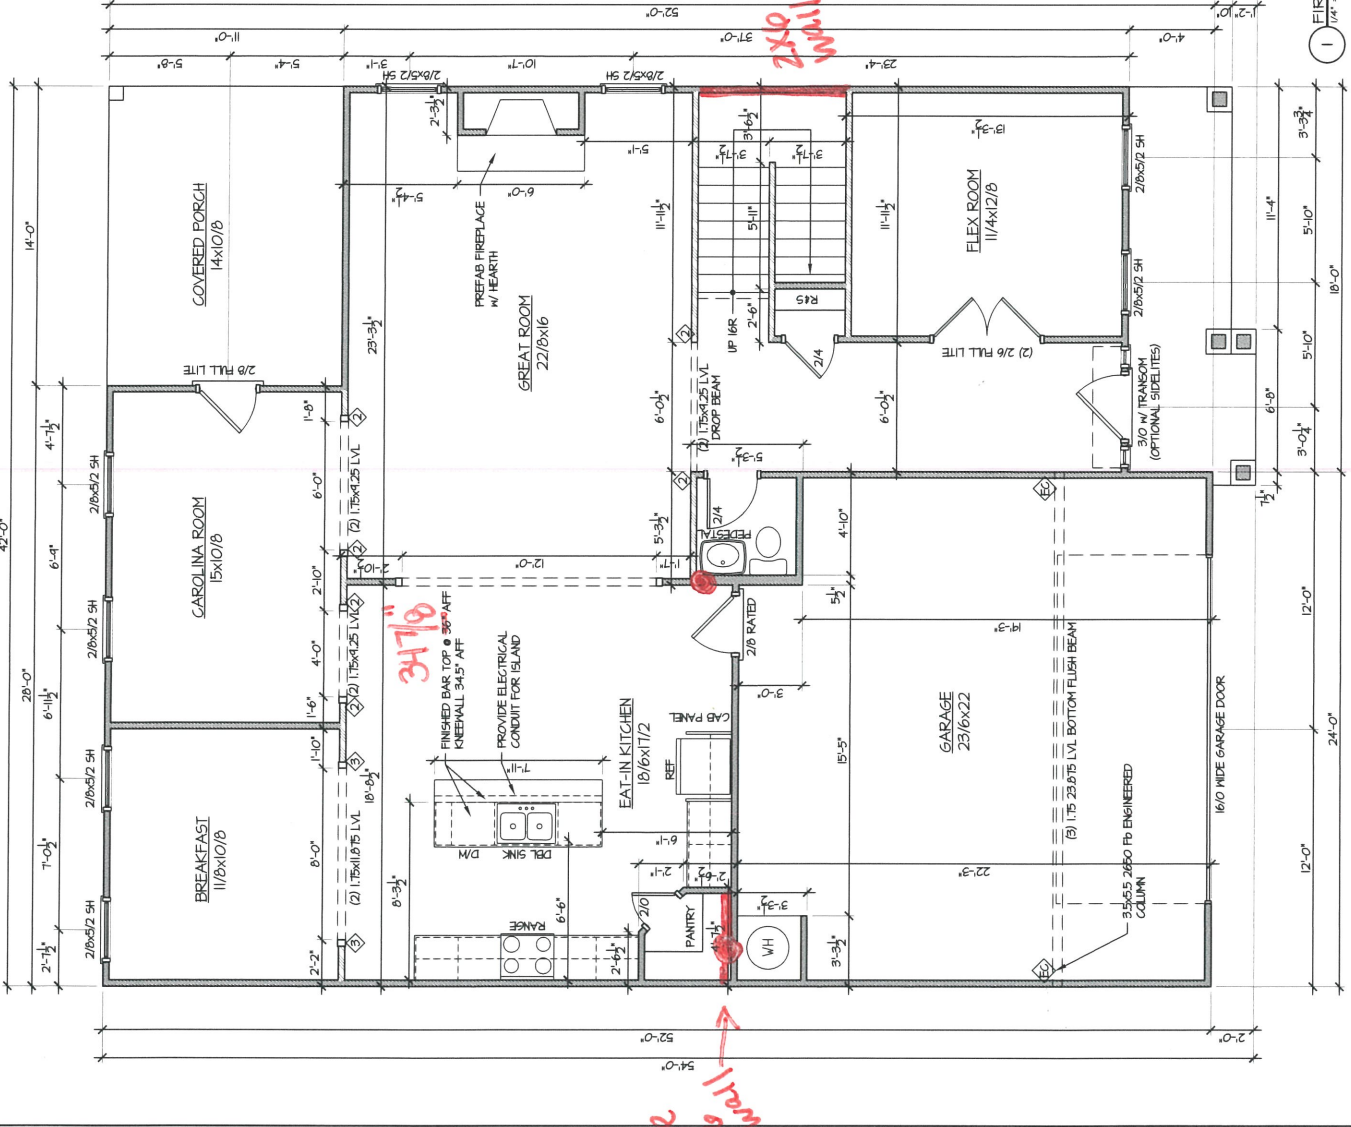

1 FIRST FLOOR PLAN
 1/4" = 1'-0"

