

2 REAR ELEVATION
1/4" = 1'-0"

1 FRONT ELEVATION
1/4" = 1'-0"

SPACE DATA

FIRST FLOOR HEATED	1026 SF
SECOND FLOOR HEATED	1276 SF
FRONT PORCH	153 SF
GARAGE	480 SF
THIRD CAR GARAGE OPT.	280 SF

ATTIC VENT CALC'S.


ATTIC AREA	1276 SF.	N/A
GABLE VENTS		
RIDGE VENTS	621 LF. / 8 SF. (628)	
SOFFIT VENT.	76 LF. / 5 SF. (288)	
RATIO	$\frac{1276}{48} = 26.58$	




TODD TUCKER 34-156
 © 2019 Caviland
 104-18 Roberson St
 Fayetteville, NC 28305
 Office: 910-339-6330
 Fax: 910-339-6333

CL 2302B
 ELEVATIONS


SCALE: 1/4" = 1'-0"
 DATE: APRIL 2020
 PLAN: CL 2302 B
 LOT NO.
 SHEET NO. 1

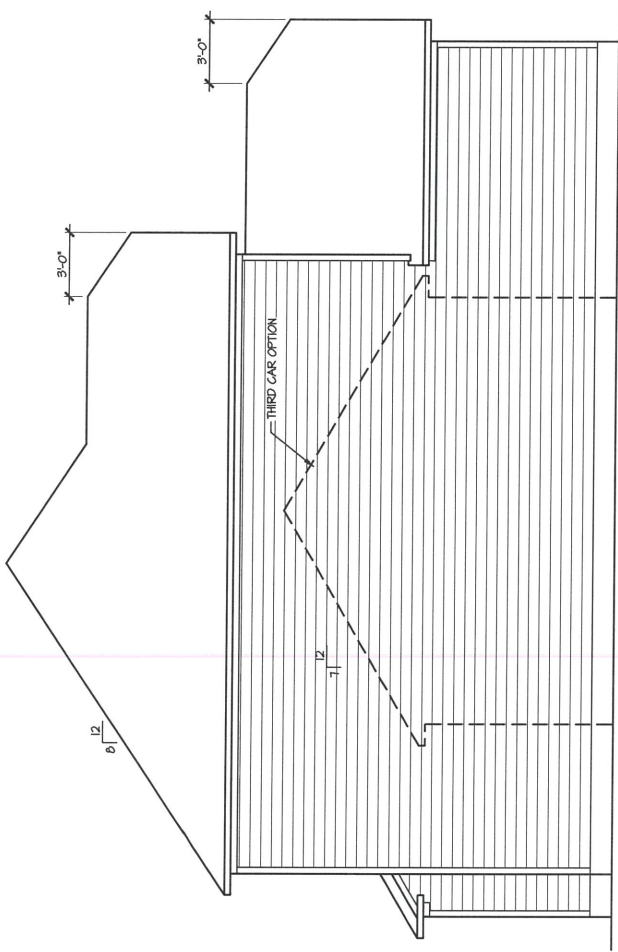

2 LEFT ELEVATION
1/4" = 1'-0"

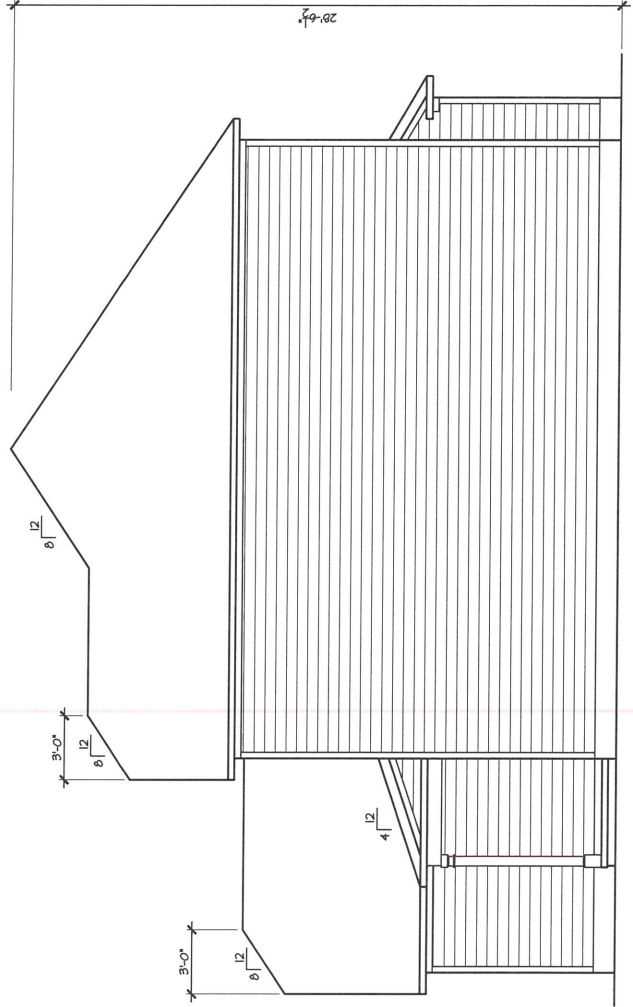

1 RIGHT ELEVATION
1/4" = 1'-0"

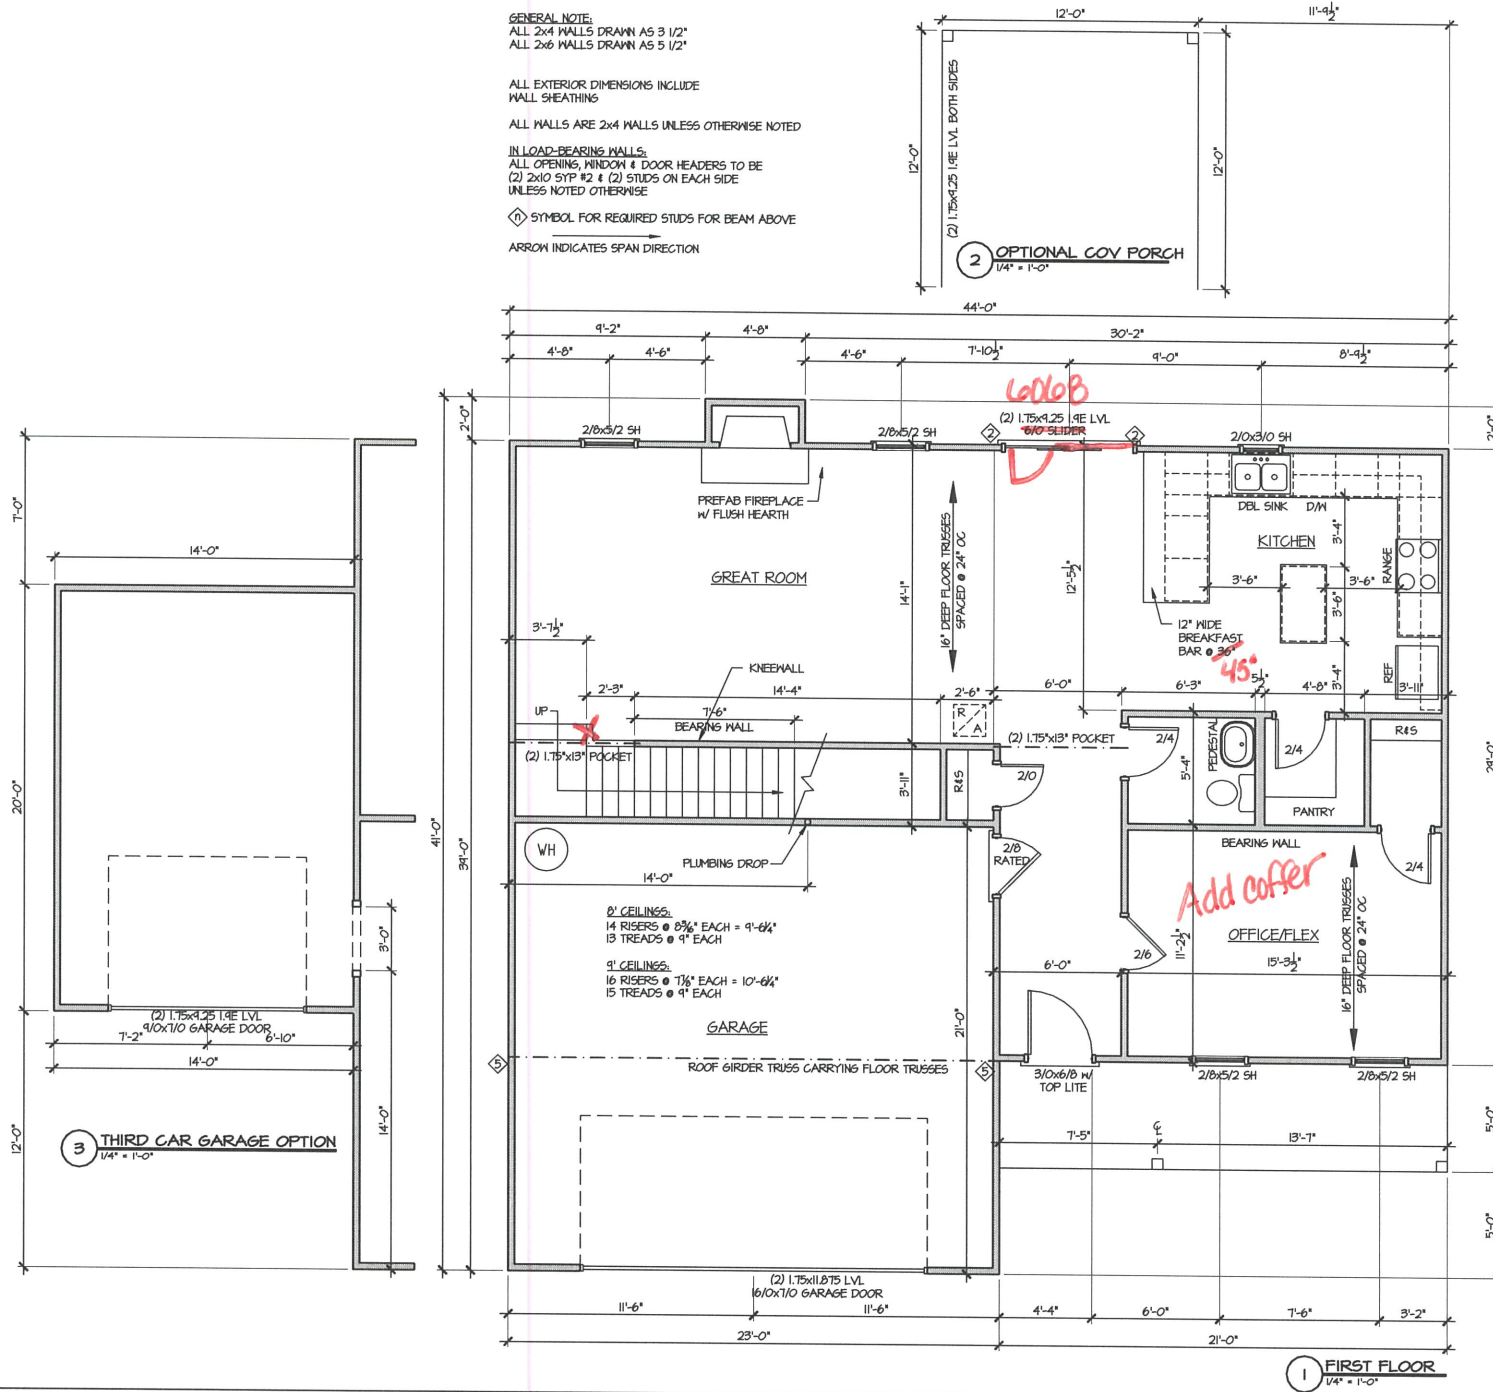

© 2019 CavLand
 1041-B Robeson St
 Fayetteville, NC 28305
 Office: 910-339-6330
 Fax: 910-339-6333

CL 2302b

FIRST FLOOR PLAN


SCALE:
 1/4" = 1'-0"

DATE:
 APRIL 2020

PLAN:
 CL 2302b

LOT NO.:

SHEET NO.
4

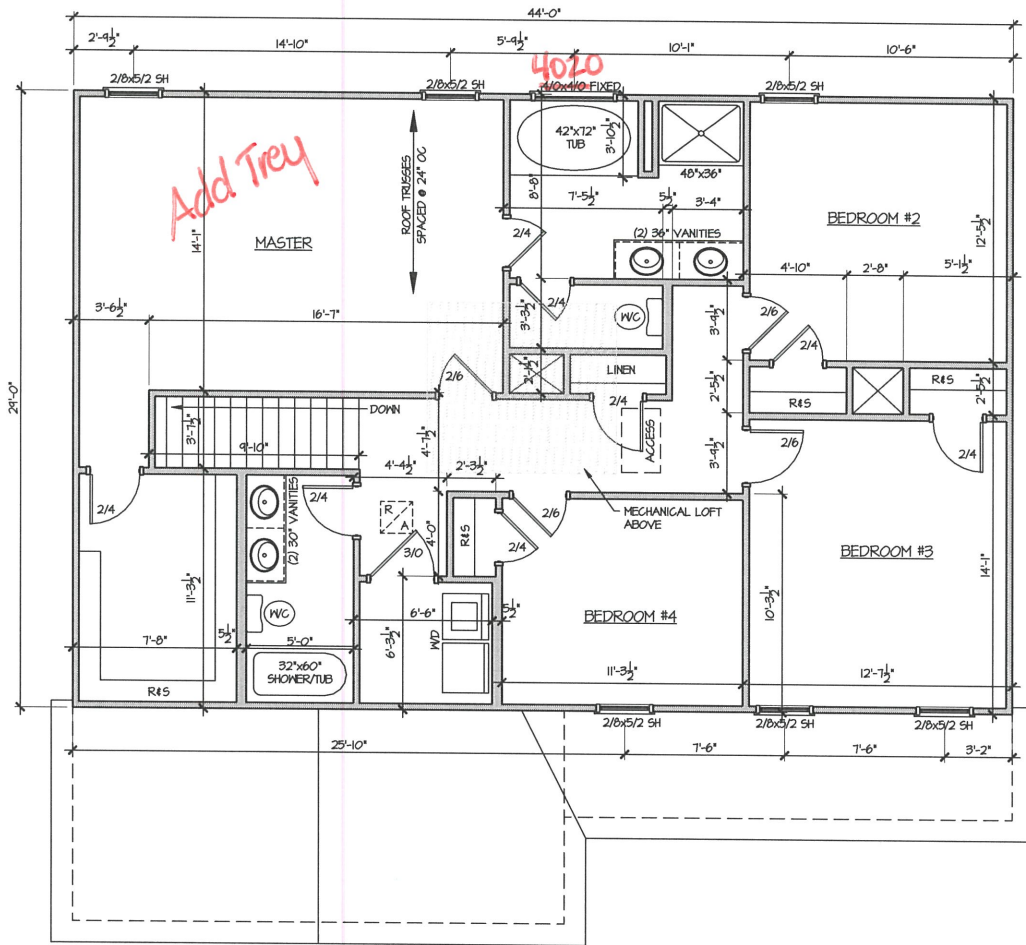

TODD TUCKER 34 - 156

© 2019 CavLand
1041-B Robeson St
Fayetteville, NC 28305
Office: 910-339-6330
Fax: 910-339-6333

CL 2302**B**

SECOND FLOOR PLAN

SCALE:
1/4" = 1'-0"

DATE:
APRIL 2020

PLAN:
CL 2302 **B**

LOT NO.

SHEET NO.

5