


Note:
 "Finley's Crossing" was formerly recorded as "Centrella Subdivision" Map #2017-353. Lots are Subject to Protective Covenants recorded in Deed Book 3616, Page 87.

- LEGEND:**
- Subject Boundary Line
 - Adjoining Boundary Line
 - R/W Right-of-Way Line
 - C/L Centerline
 - Minimum Building Line
 - Survey tie lines
 - △ CP Calculated Point
 - △ ERB Existing Iron Re-Bar Below/Above Grade
 - FH Fire Hydrant
 - WM Water Meter
 - WV Water Valve
 - SS Sanitary Sewer Clean-Out
 - TP Telephone Pedestal

FEMA FLOOD HAZARD STATEMENT
 The subject property shown on this plat is NOT located within the FEMA 1% Annual Chance Flood Hazard Area "Zone A" or "Zone AE" as shown on FIRM Number: 3720064000J
 Effective date: 10/3/2006

Note:
 Foundation Location based upon nails set in concrete footing for brick masons on October 17th, 2020. As-built dimensions of foundation confirmed on this date.

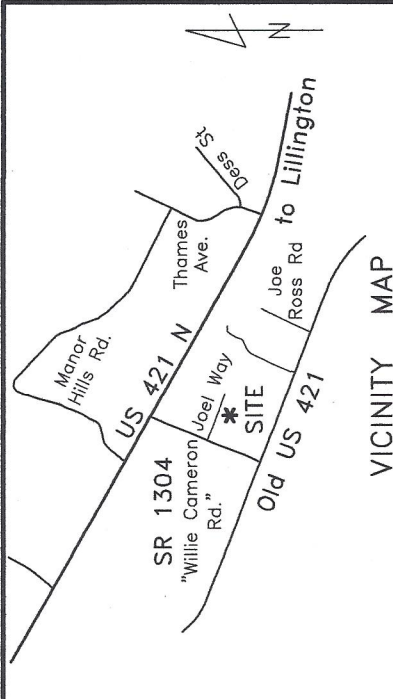

Upper Little River Twp., Harnett County
 Scale: 1" = 50' Date: Nov. 10, 2020
 Surveyed & Mapped By
STREAMLINE LAND SURVEYING, Inc.
 NC FIRM C-1898
 870 NC 55 W, Coats, N.C. 27521
 Phone: 910-897-7715

I hereby certify that the foundation location shown hereon is correct in relation to property lines of record.
 NOTE: The purpose of this survey is to locate the newly constructed foundation.
 Other features, fixtures, encumbrances and indications of use may be revealed by a complete site survey.

Robert E. Godwin, Jr.
 LAND SURVEYOR
 L-3790
 11-10-20

NOT FOR RECORDATION