




2 REAR ELEVATION
1/4" = 1'-0"

SPACE DATA	
FIRST FLOOR, HEATED:	1026 SF
SECOND FLOOR, HEATED:	1276 SF
FRONT PORCH:	105 SF
GARAGE:	
THIRD CAR GARAGE OPT:	280 SF

ATTIC VENT CALC'S.	
ATTIC AREA:	1276 SF.
GABLE VENTS:	N/A
RIDGE VENTS:	62 L.F. / 8 SF. (62%)
SOFFIT VENT:	76 L.F. / 5 SF. (30%)
RATIO:	$\frac{13}{1276} = \frac{1}{99}$

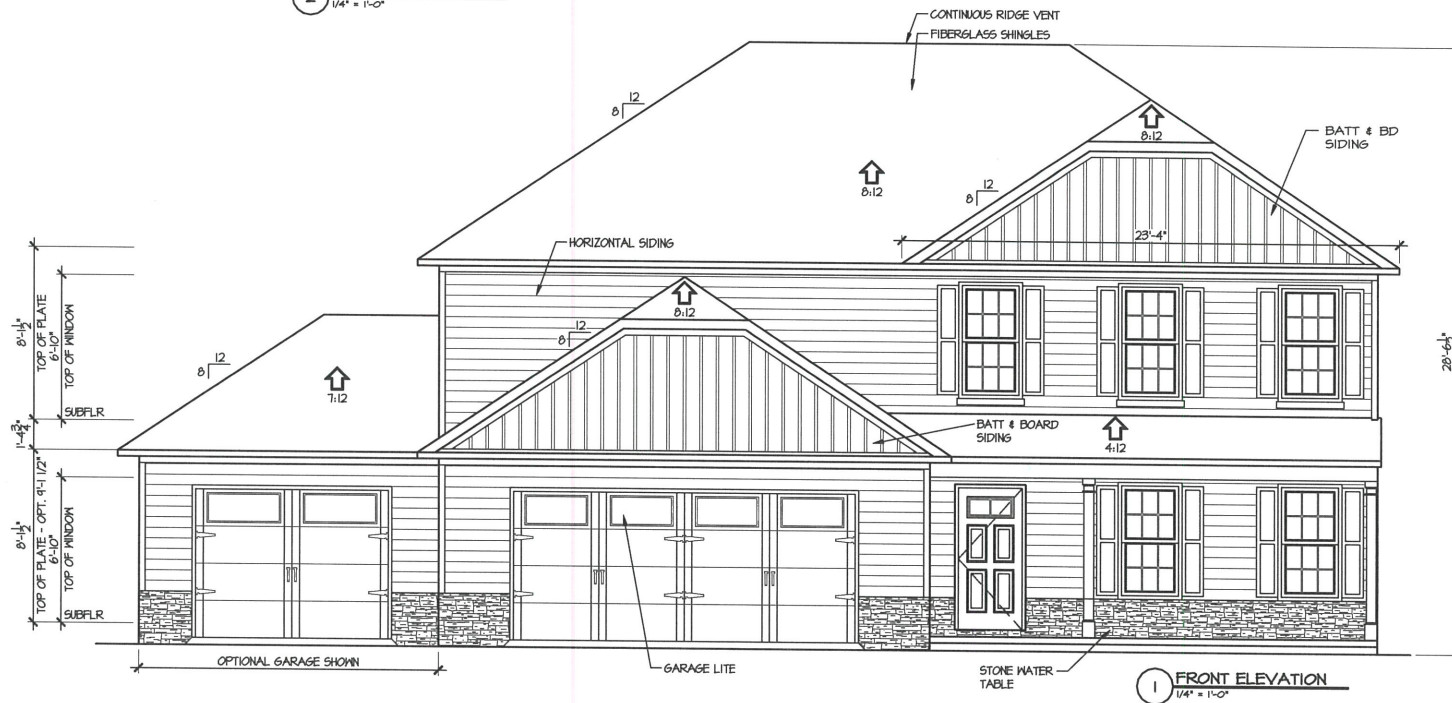

1 FRONT ELEVATION
1/4" = 1'-0"

C:\Projects\Caviness Land\CL 2302\CL 2302 4-28-20.dwg - 4/29/2020 8:15:50 PM



TODD TUCKER 34 - 156

© 2019 CavLand
1041-B Robeson St
Fayetteville, NC 28305
Office: 910-339-6330
Fax: 910-339-6330

CL 2302**B**
ELEVATIONS

SCALE:
1/4" = 1'-0"


DATE:
APRIL 2020

PLAN:
CL 2302**B**


LOT NO:

SHEET NO:
1

C:\Projects\Caviness Land\CL 2302\CL 2302 4-28-20.dwg 4/29/2020 8:15:50 PM

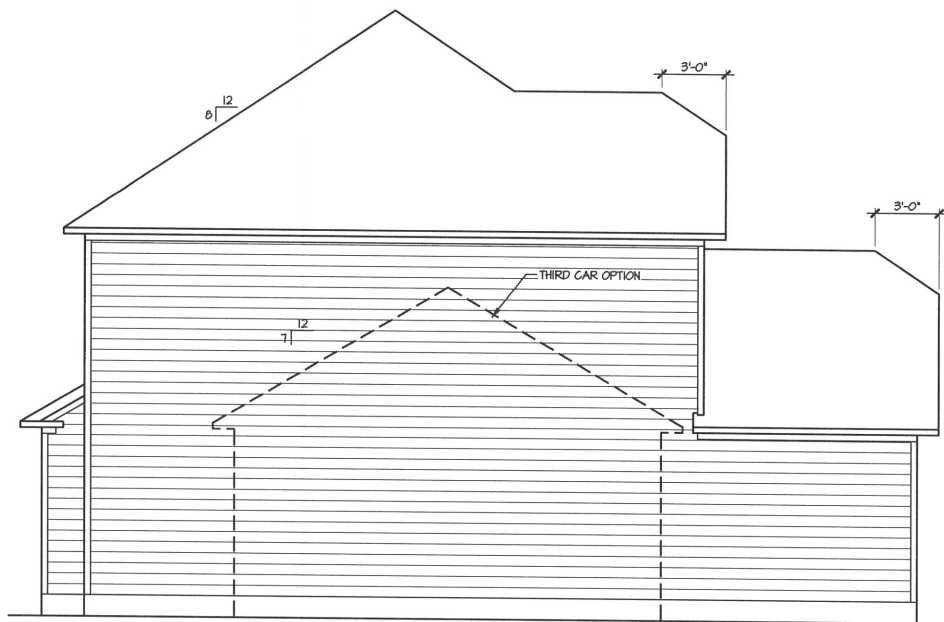

2 LEFT ELEVATION
1/4" = 1'-0"

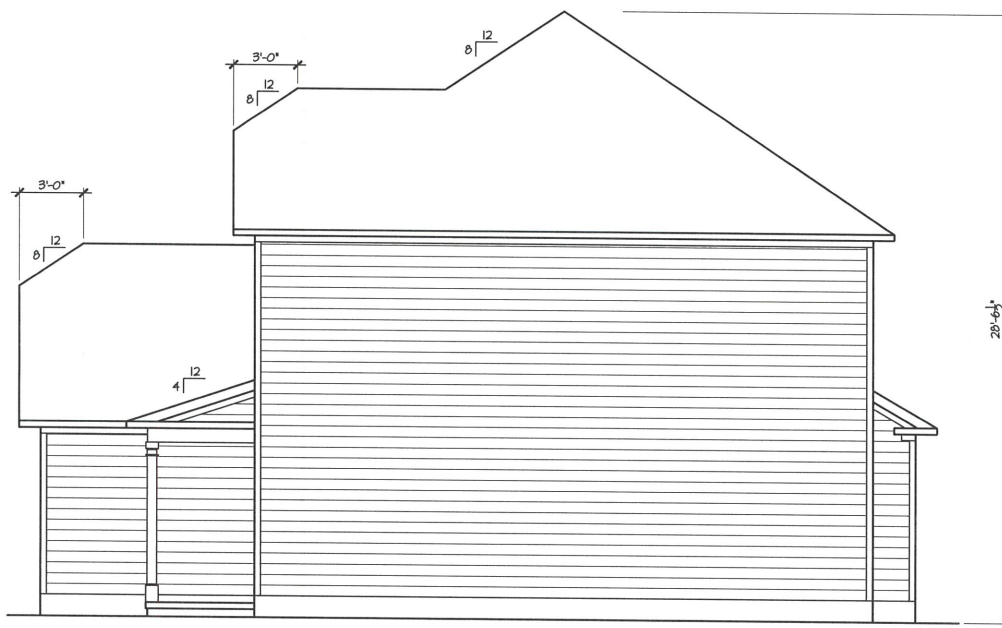

1 RIGHT ELEVATION
1/4" = 1'-0"



TODD TUCKER 34 - 156

© 2019 CavLand
1041-B Robeson St
Fayetteville, NC 28305
Office: 910-339-6330
Fax: 910-339-6333

CL 2302 **B**

ELEVATIONS

SCALE:
1/4" = 1'-0"

DATE:
APRIL 2020

PLAN:
CL 2302 **B**

LOT NO.

SHEET NO.

2

C:\Projects\Caviness Land\CL 2302\CL 2302 4-28-20.dwg, 4/28/2020 8:15:51 PM

GENERAL NOTE:
 ALL 2x4 WALLS DRAWN AS 3/2"
 ALL 2x6 WALLS DRAWN AS 5/2"

ALL EXTERIOR DIMENSIONS INCLUDE
 WALL SHEATHING


ALL WALLS ARE 2x4 WALLS UNLESS OTHERWISE NOTED

IN LOAD-BEARING WALLS:

ALL OPENING, WINDOW & DOOR HEADERS TO BE
 (2) 2x10 SYP #2 & (2) STUDS ON EACH SIDE
 UNLESS NOTED OTHERWISE

◇ SYMBOL FOR REQUIRED STUDS FOR BEAM ABOVE

ARROW INDICATES SPAN DIRECTION

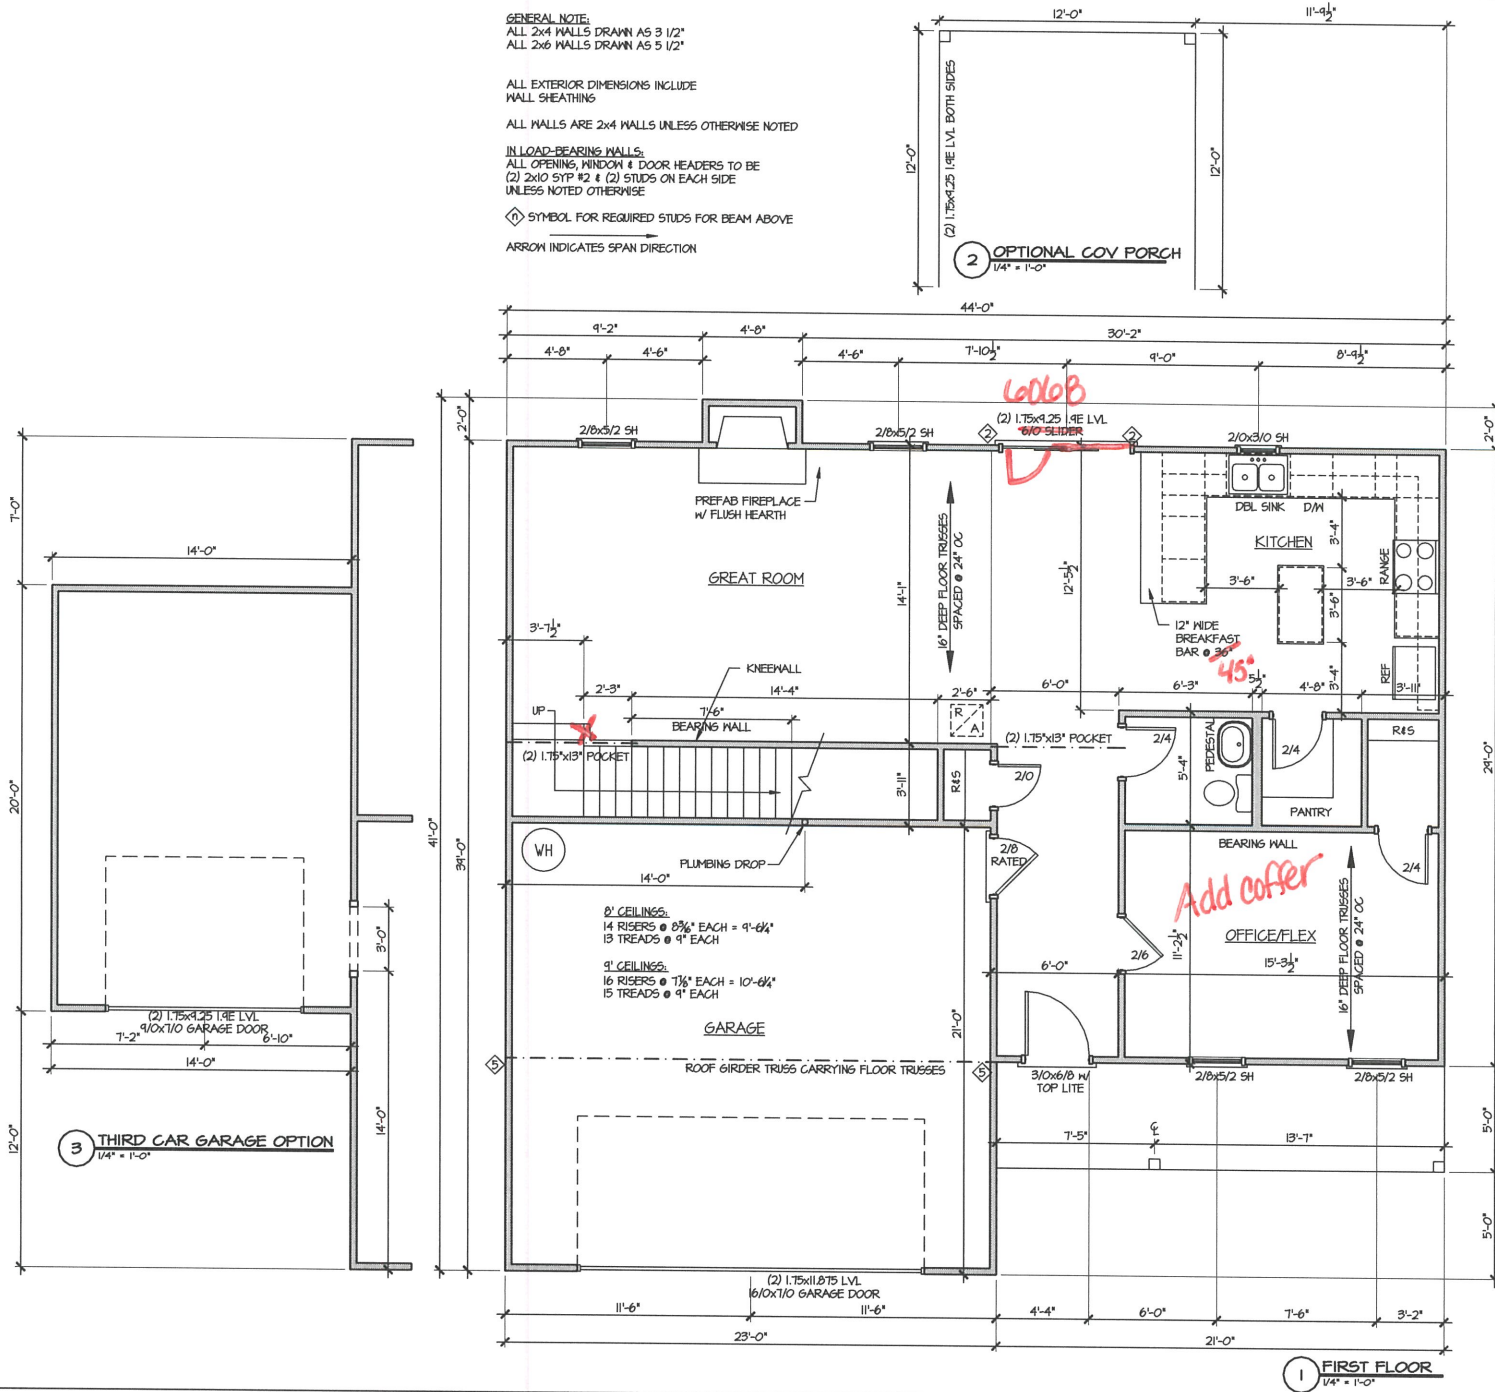

TODD TUCKER 34 - 156

© 2019 CavLand
 1041-B Robeson St
 Fayetteville, NC 28305
 Office: 910-339-6330
 Fax: 910-339-6333

CL 2302b
 FIRST FLOOR PLAN


SCALE:
 1/4" = 1'-0"

DATE:
 APRIL 2020

PLAN:
 CL 2302D

LOT NO:

SHEET NO.
 4

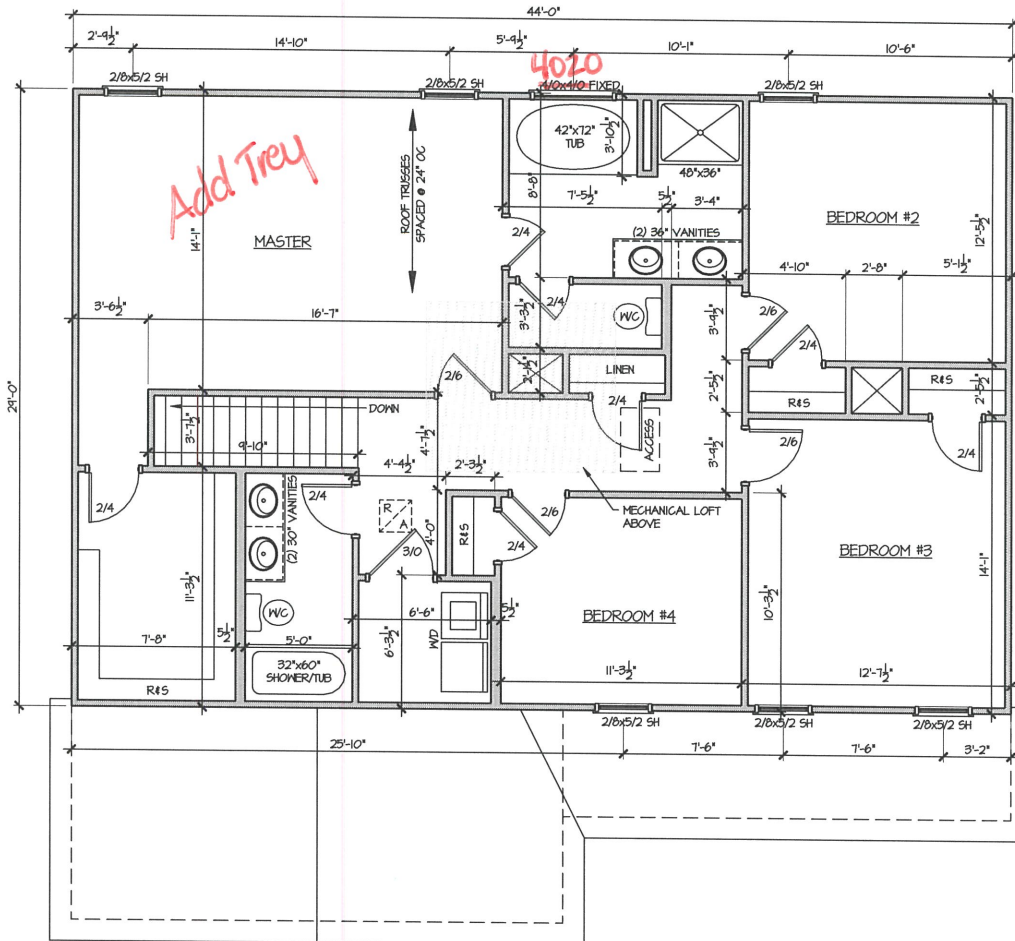

TODD TUCKER 34 - 156

© 2019 CavLand
1041-B Robeson St
Fayetteville, NC 28305
Office: 910-339-6330
Fax: 910-339-6333

CL 2302B

SECOND FLOOR PLAN

SCALE:
1/4" = 1'-0"

DATE:
APRIL 2020

PLAN:
CL 2302 **B**

LOT NO.

SHEET NO.
5