



LIST OF SYMBOLS			
	SECTION MARK		DATUM ELEVATION
	DETAIL MARK		SLOPE UP
	TITLE MARK		EARTH
	INTERIOR BEARING WALL		INSULATION
	NUMBER OF GANG STUDS IN WALL		

TABLE OF CONTENTS	
1	ELEVATIONS
2	ELEVATIONS
3	FOUNDATION PLAN
4	1st FLOOR PLAN
5	2nd FLOOR PLAN
E1	1st FLOOR ELECTRICAL PLAN
E2	2nd FLOOR ELECTRICAL PLAN

SPACE DATA	
FIRST FLOOR, HEATED:	1444 SF
SECOND FLOOR, HEATED:	1410 SF
TOTAL HEATED:	2862 SF
GARAGE:	514 SF
FRONT PORCH:	96 SF
REAR PORCH:	154 SF

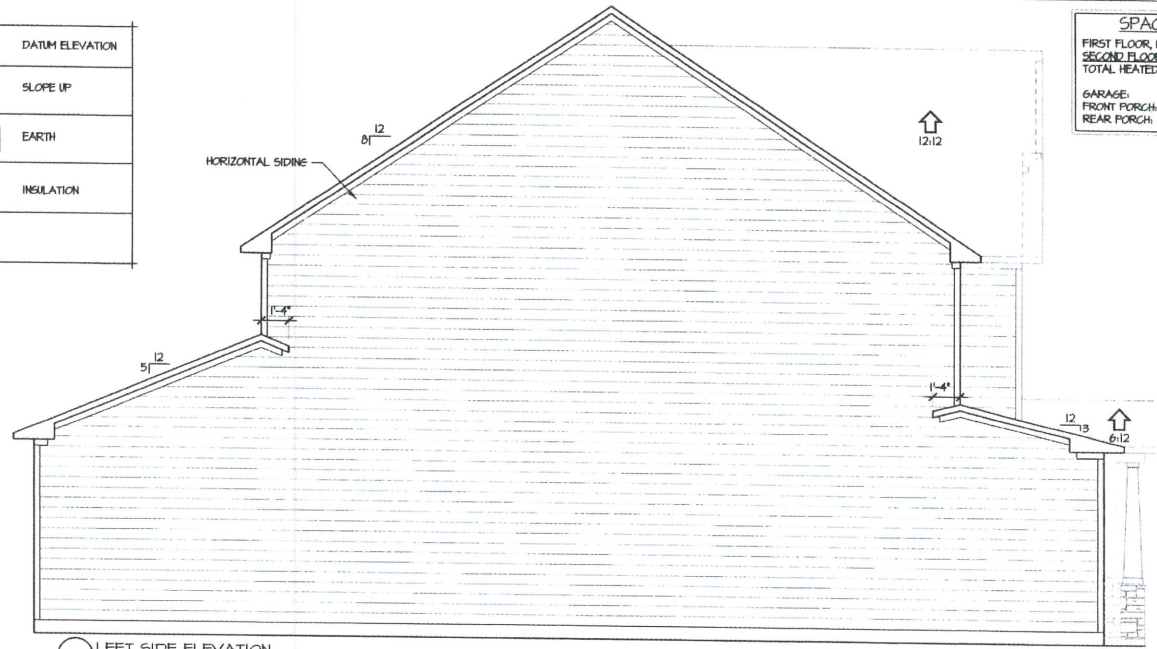


2 LEFT SIDE ELEVATION  
1/4" = 1'-0"

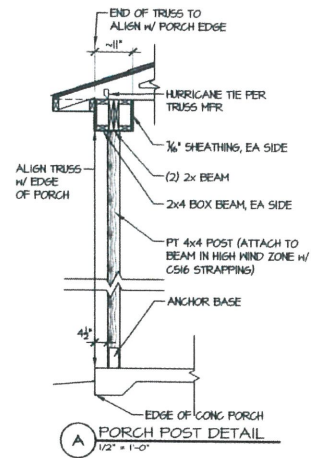

A PORCH POST DETAIL  
1/2" = 1'-0"

1 FRONT ELEVATION  
1/4" = 1'-0"

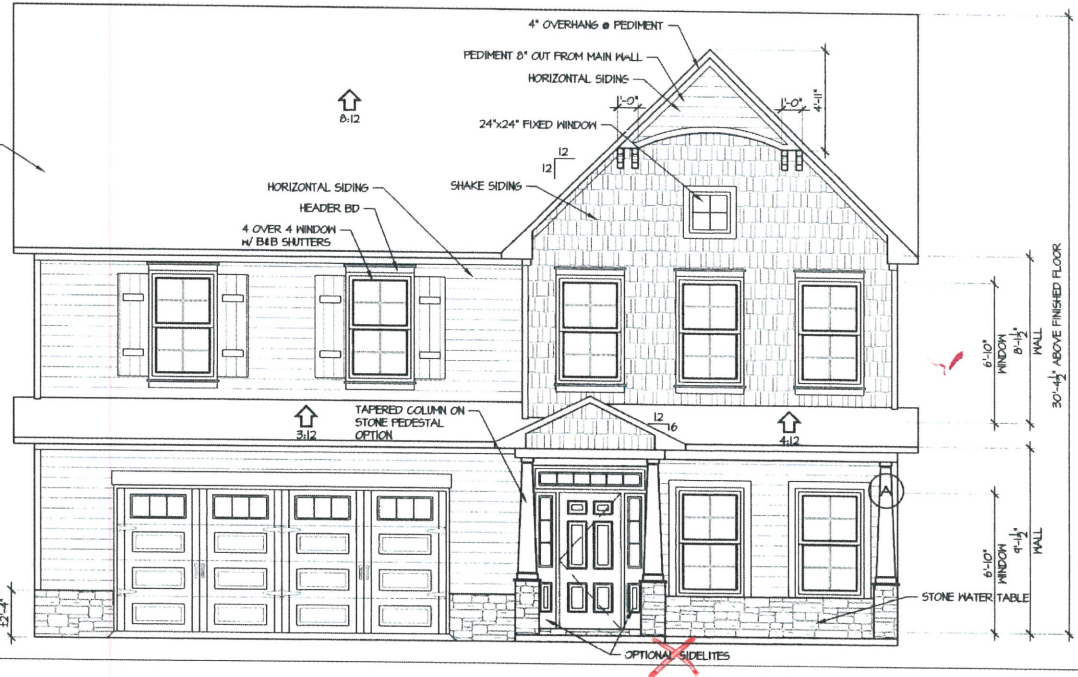

**CRDG**  
CAROLINA RESIDENTIAL DESIGN GROUP, LLC  
Professional Member  
Institute of Chartered Architects  
American Institute of Professional Design  
Certified Professional Building Designer  
TODD TUCKER, AIA, CPBD  
919-495-7930


AMERICAN INSTITUTE OF BUILDING DESIGNERS  
**A I B D**

NATIONAL COUNCIL OF ARCHITECTS  
TODD TUCKER 34 - 156

The Architectural Firm, Carolina Residential Design Group, LLC, is not responsible for any construction or other errors or omissions in this drawing or any other drawings or specifications prepared by the Architectural Firm or any other person or entity. The Architectural Firm is not responsible for any construction or other errors or omissions in this drawing or any other drawings or specifications prepared by the Architectural Firm or any other person or entity. The Architectural Firm is not responsible for any construction or other errors or omissions in this drawing or any other drawings or specifications prepared by the Architectural Firm or any other person or entity.

**Caviness Land**  
ELEVATIONS/DETAILS  
SHEET TITLE:


CL 2862  
SCALE AS NOTED  
JANUARY 2018  
REV: 1

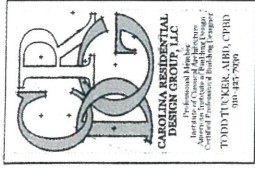

TODD TUCKER 34-156  
 ARCHITECT  
 1000 W. HARRIS STREET, SUITE 100  
 CHARLOTTE, NC 28202  
 TEL: 704.375.1111 FAX: 704.375.1112  
 WWW.TODDTUCKER.COM

ELEVATIONS  
 SHEET TITLE

CL 2062  
 SCALE AS NOTED  
 JANUARY 2018  
 REV: 2

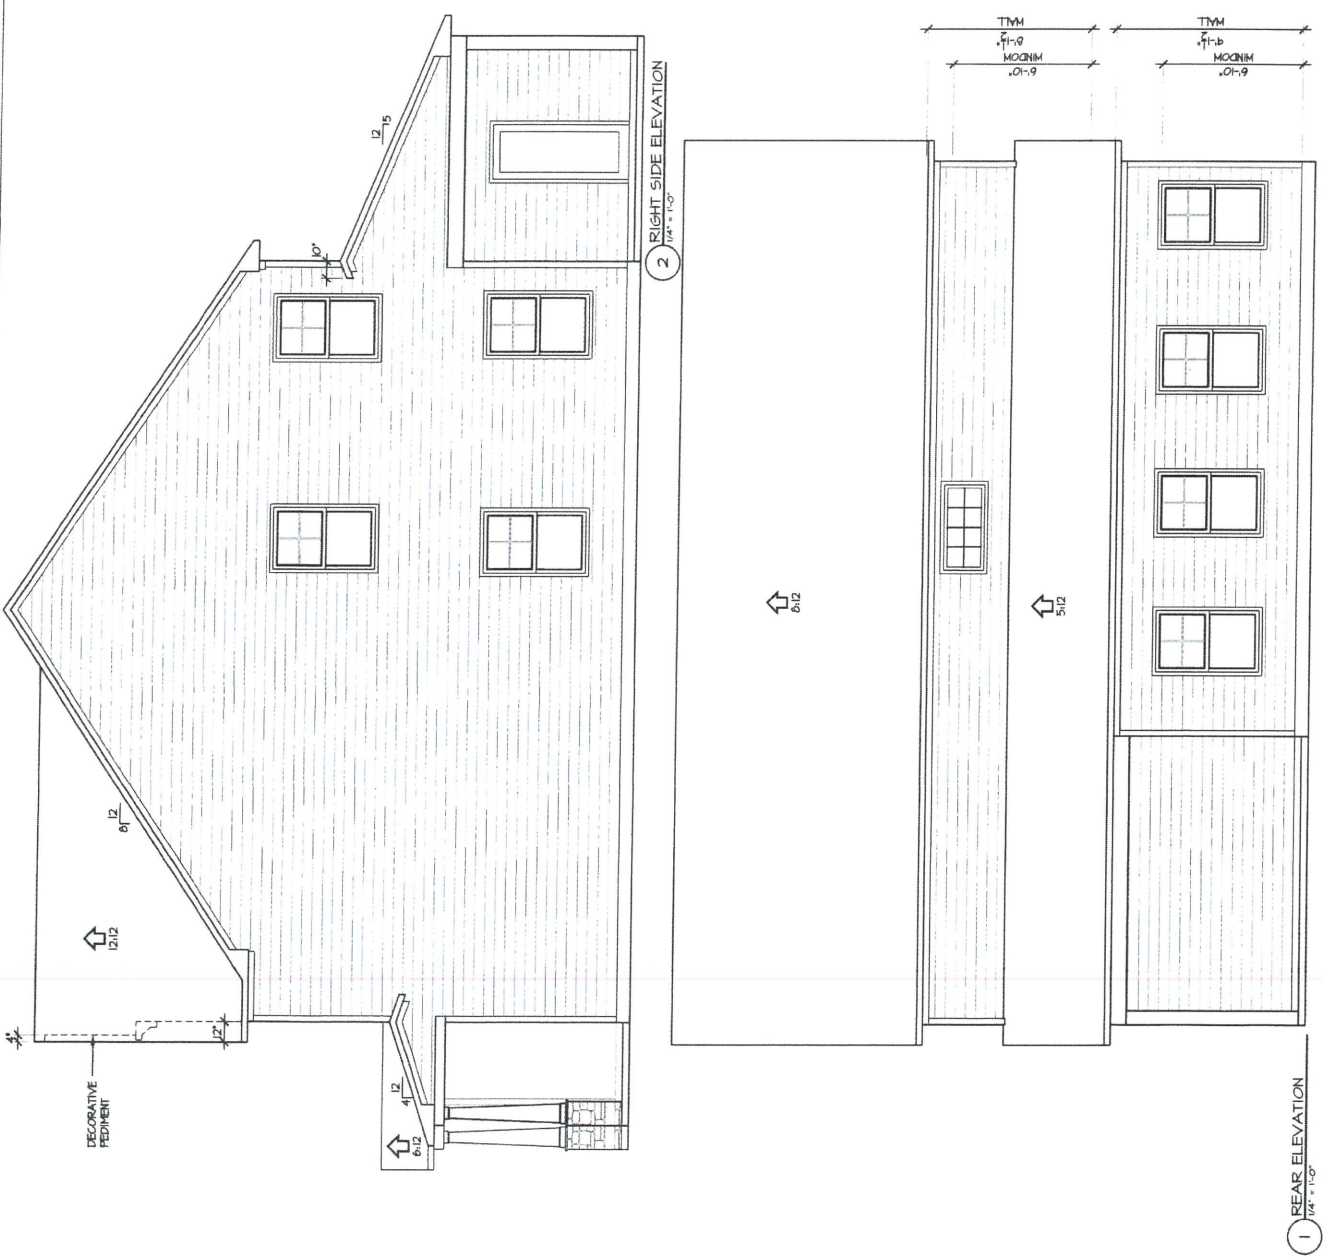

LIST OF ABBREVIATIONS

T.O. TOP CHORD T.O.M. TOP OF WALL TYP. TYPICAL UN. UNLESS OTHERWISE NOTED V.B. VAPOR BARRIER VAN. VANITY W. WIDE MTH. MITH N.P. NUMBER OF STUD POCKETS & WINDOW/DOOR JAMB S.P.	PCKT. POCKET DOOR PRF. PREFORMED PL. PLATE P.T. PRESSURE TREATED FOR EXPOSURE P.O. POINT LOAD (SOLID BLOCK) R.S. ROD & SHELF (CLOSERS) R.F. REFRIGERATOR R.E. REINFORCEMENT R.H. ROOF S.E. SEGMENTED S.H. SHELVES S.V. SHELVES S.P. SPECIFICATION / SPECIFIED S.Q. SQUARE S.T. SIMPSON STRONG-TIE OR EQUAL S.B. SIB-LOCK S.P. SOUTHERN YELLOW PINE S.P.	DM. DISH WASHER EQ. EQUAL F.N. FOUNDATION VENT F.V. FLOOR JOIST G.L. GLASS (DOOR) H.R. HOSE BIB HDR. DOOR / WINDOW / OPENING HEADER H.V.A.C. HEATING, VENTING & AIR CONDITION K.W. KNEEWALL L.V.L. LAMINATED VENEER LUMBER M.A.N.F. MANUFACTURED M.A.S. MASONRY N.C. NOT IN CONTRACT O.H. OVERHANG O.P.N.S. OPENINGS O.C. ON CENTER O.V. OVERLAP	AFF. ABOVE FLOOR BRK. BREAK CAB. CABINETS / CABINETRY C.J. CONTROL JOINT C.M.U. CONCRETE MASONRY UNIT C.O. CLEAR OPENING C.O.L. COLUMN C.S.H.T. CASHEMANT D.P.L. DOUBLE D.H.S.H. DOUBLE HANG / SINGLE HANG WINDOW D.N. DOWN D.P. DEEP A.C.C.E.S.S. ACCESS TO ATTIC OR CRAWL SPACE
---	--	--	---



