


FIELD & REDLINE NOTES

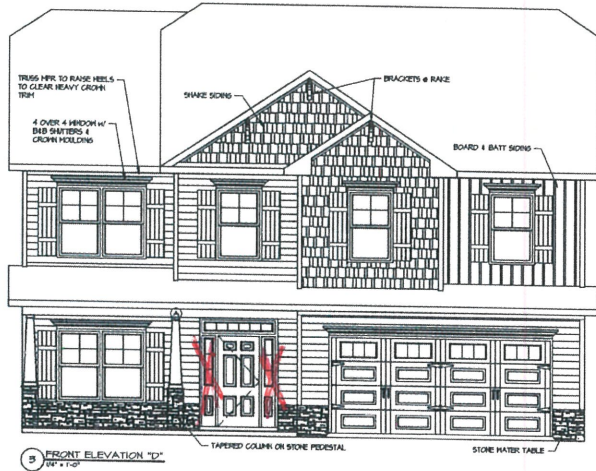

9 FRONT ELEVATION "D"
04'-11-0"


Yes

SPACE DATA


FIRST FLOOR HEATED:	1188 SF
SECOND FLOOR HEATED:	1050 SF
FRONT PORCH:	120 SF
REAR PORCH OPTION:	120 SF
GARAGE:	420 SF
3RD CAR GARAGE OPTION:	260 SF

ATTIC VENT CALCS.


ATTIC AREA:	1850 S.F.
GABLE VENTS:	N/A
ROOF VENTS:	45 LF / 6 SF. (40%)
SOFFIT VENT:	85 LF / 4 SF. (40%)
RATIO:	$\frac{13}{1850} = \frac{1}{141}$

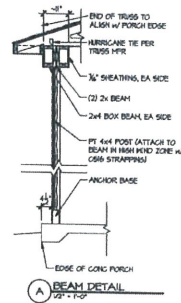


A BEAM DETAIL
02'-11-0"

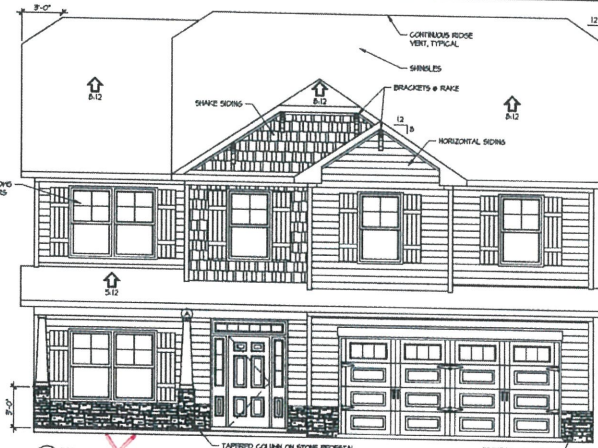

2 FRONT ELEVATION "C"
04'-11-0"

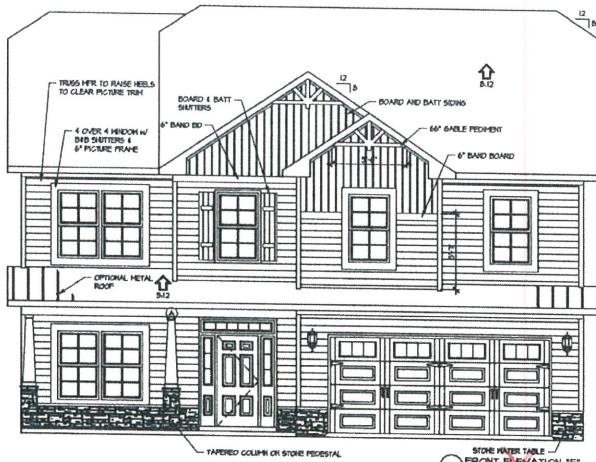

4 FRONT ELEVATION "E"
04'-11-0"

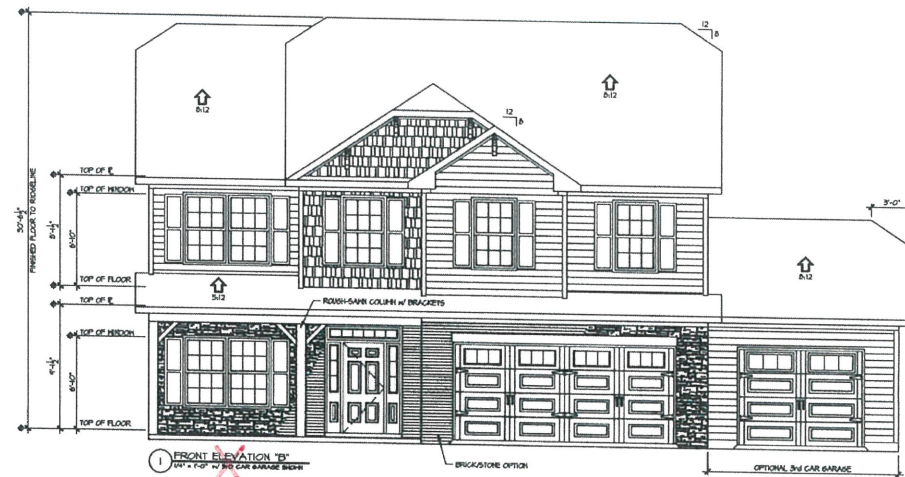

1 FRONT ELEVATION "B"
04'-11-0" w/ 3RD CAR GARAGE BUSH



© 2020 Caviness & Cates

639 Executive Place
Suite 400
Fayetteville, NC 28305
Office: 910-481-6500
Sales: 910-240-4210
Fax: 910-481-0285



TODD TUCKER 34-159
FORTIFIED-PROFESSIONAL
918-224-1174

CC 2325
ELEVATIONS

PLAN NUMBER:
SHEET TITLE:

PLAN NO: CC 2325


DATE: FEBRUARY 2020

REVISIONS:


SHEET NO:

1


CC 2325
ELEVATIONS

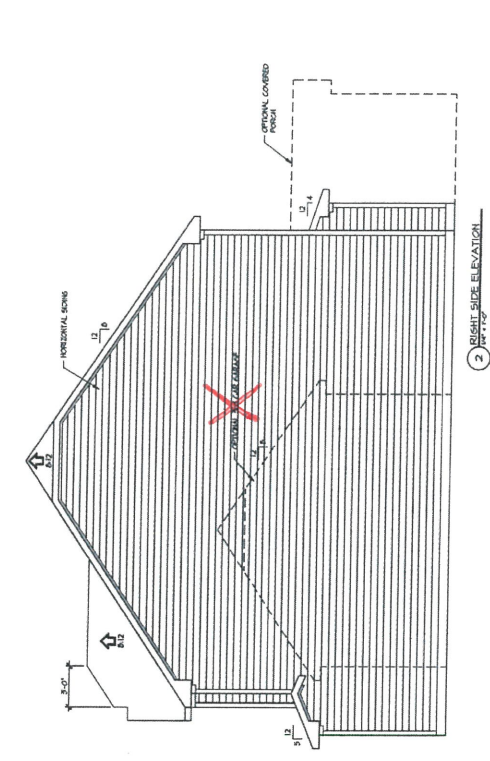

2 RIGHT SIDE ELEVATION

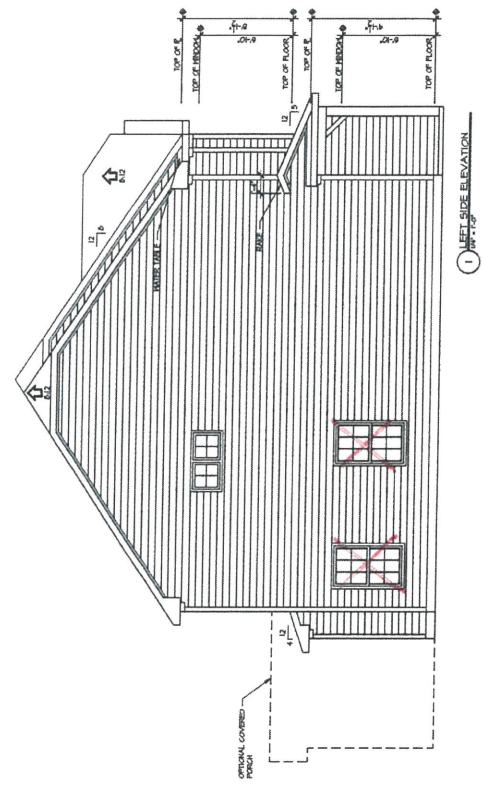

1 LEFT SIDE ELEVATION

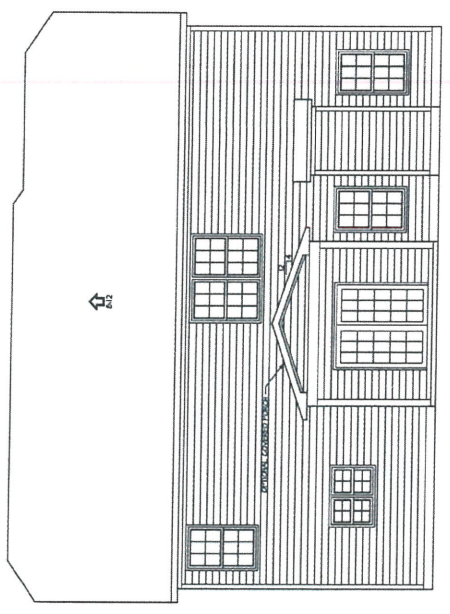

3 REAR ELEVATION

FIELD & REDLINE NOTES

FIELD & REDLINE NOTES



© 2020 Caviness & Cates
 638 Encovium Place
 Suite 400
 Fayetteville, NC 28404
 Phone: 910-481-0200
 Fax: 910-481-0200
 Email: info@caviness.com




CC 2325
 SECOND FLOOR PLANS


DATE: FEBRUARY 2020
 DRAWING NO.: CC 2325

NO.	REVISION

4
 SHEET NO.

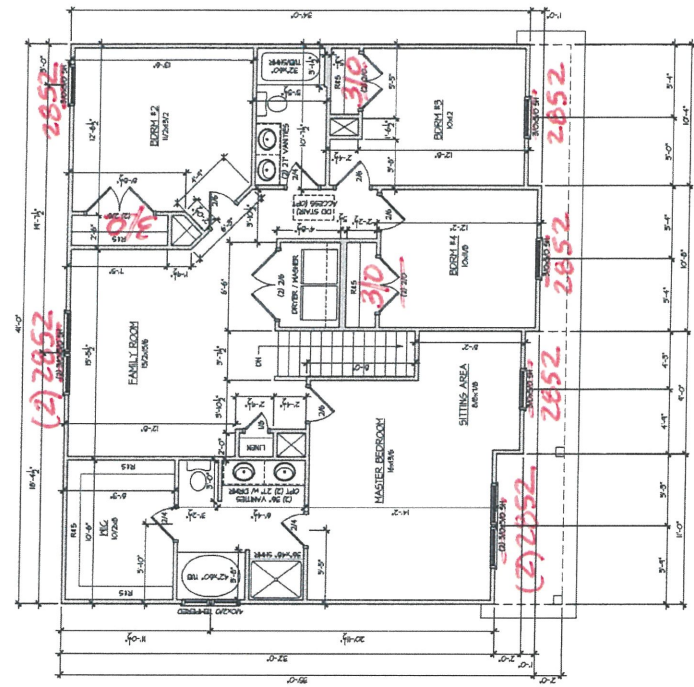

1 SECOND FLOOR PLAN
 As per floor plan

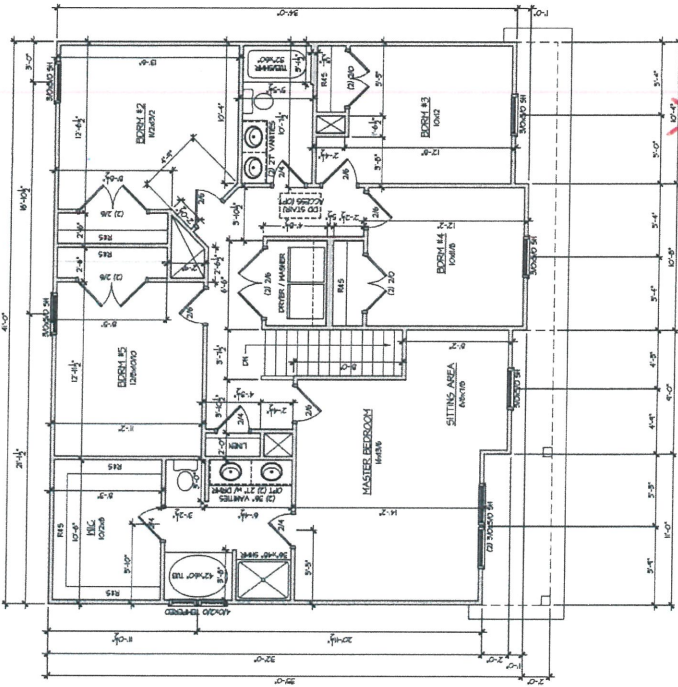

2 SECOND FLOOR PLAN
 As per floor plan

GENERAL NOTE:
 ALL 2x4 WALLS DRAWN AS 3" U2"
 ALL 2x6 WALLS DRAWN AS 5" U2"
 INTERIOR BEARING WALL:
 ALL EXTERIOR DIMENSIONS INCLUDE
 WALL STRUCTURES
 ALL WALLS ARE 2x4 WALLS UNLESS OTHERWISE NOTED