



T:\CavLand\CL 3187\CL 3187 GR 4-21-20.dwg, 4/21/2020 10:34:55 AM

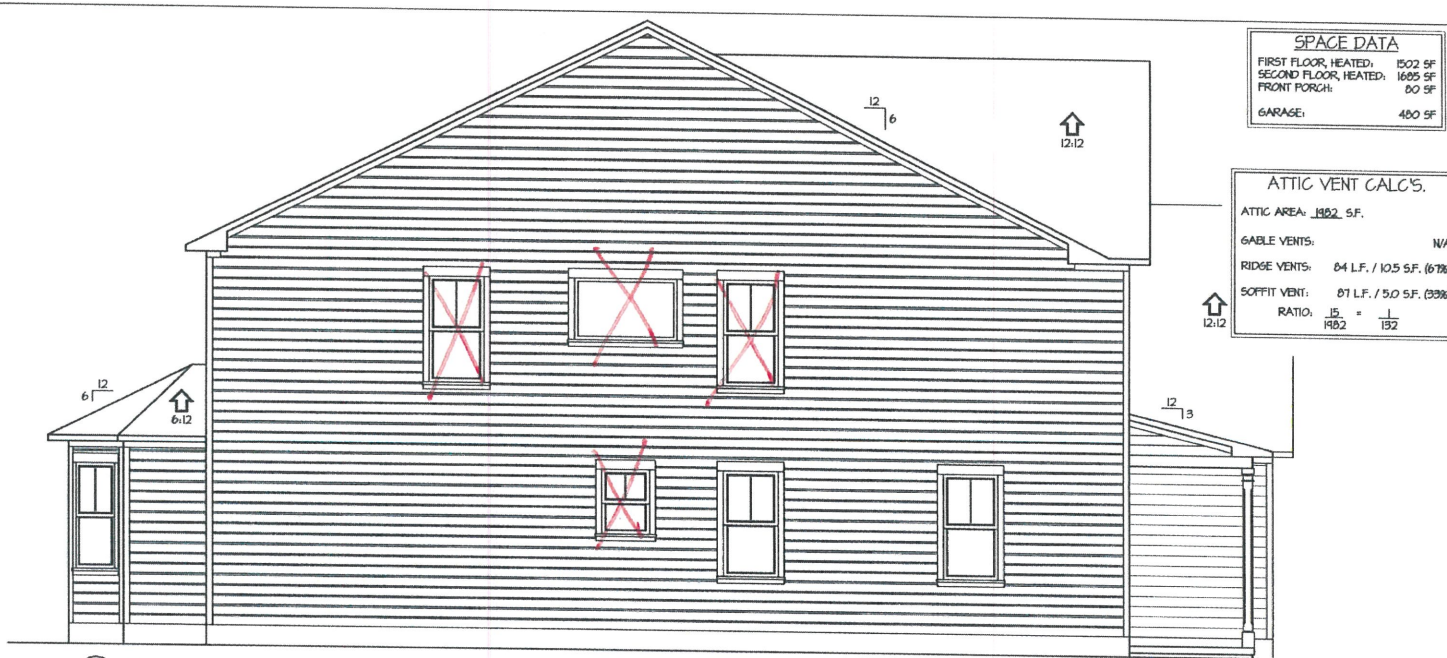

2 LEFT ELEVATION  
1/4" = 1'-0"

SPACE DATA	
FIRST FLOOR, HEATED:	1502 SF
SECOND FLOOR, HEATED:	1685 SF
FRONT PORCH:	80 SF
GARAGE:	480 SF

ATTIC VENT CALC'S.	
ATTIC AREA:	1382 SF.
GABLE VENTS:	N/A
RIDGE VENTS:	84 L.F. / 10.5 S.F. (67%)
SOFFIT VENT:	81 L.F. / 5.0 S.F. (33%)
RATIO:	$\frac{15}{1382} = \frac{1}{132}$

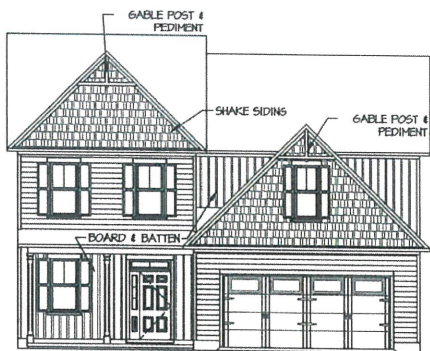


1a FRONT ELEVATION  
1/8" = 1'-0" OPTION

CHECK APPROPRIATE BOX (FIRST FLOOR)

8' CEILINGS

9' CEILINGS

ON 9' CEILINGS UPGRADE ALL FIRST FLOOR WINDOWS SHOWN AS 2/8x5/2 TO 2/8x6/0 WINDOWS (8 SINGLES / 1 THIN / 1 TRIPLE)

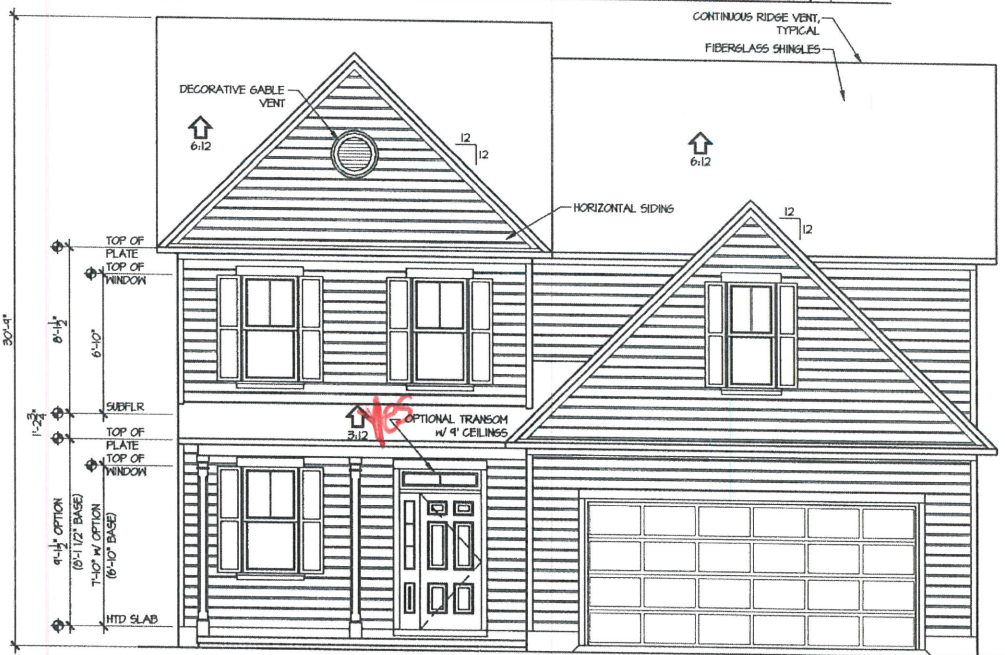

1 FRONT ELEVATION  
1/4" = 1'-0"

**Caviness Land**  
Building and Development Company  
Builder of Excellence © 2020 Caviness Land



TODD TUCKER 34-156

FORTIFIED-WISE™ PROFESSIONAL

**Caviness Land**  
SHEET TITLE: ELEVATIONS

SCALE: 1/4" = 1'-0"

DATE: FEBRUARY 2014


PLAN NO.: CL 3187

4/21/2020 SHEET NO.: 1

T:\Cavland\CL 3187 GR 4-21-20.dwg, 4/21/2020 10:34:55 AM



ARCHITECTURAL SHINGLES ON  
 1/2" ROOF FELT ON  
 APA-RATED SHEATHING ON  
 ROOF TRUSSES SPACED @ 24" OC  
 R30 INSULATION  
 HURRICANE CLIPS SPECIFIED  
 BY TRUSS MFR  
 DEL TOP PLATE W/ 3" DEL NAIL  
 PATTERN FOR SHEATHING ATTACHMENT  
 FASCIA BD

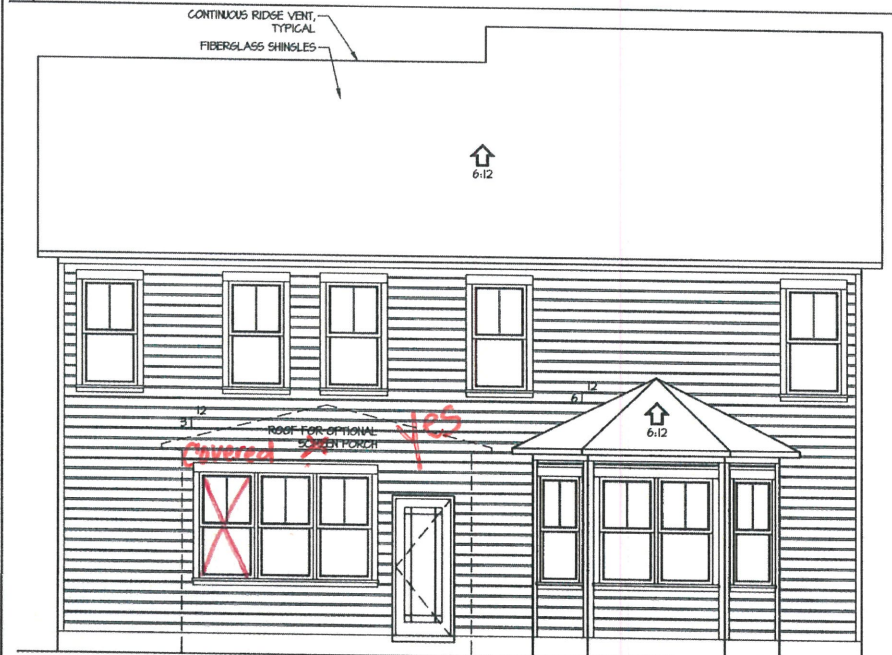


CONTINUOUS RIDGE VENT,  
 TYPICAL  
 FIBERGLASS SHINGLES

COVERED  
 ROOF FOR OPTIONAL  
 OPEN PORCH  
 YES

2 RIGHT ELEVATION  
 1/4" = 1'-0"

1 REAR ELEVATION  
 1/4" = 1'-0"

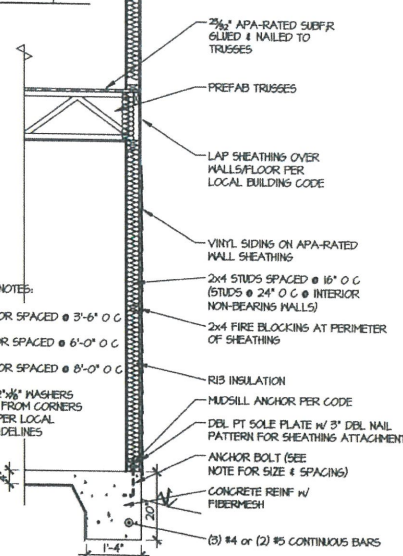

ANCHOR NOTES:  
 3/8" ANCHOR SPACED @ 3'-6" O.C.  
 1/2" ANCHOR SPACED @ 6'-0" O.C.  
 3/8" ANCHOR SPACED @ 8'-0" O.C.  
 -USE 2"x2"x1/8" WASHERS  
 -MAX 12" FROM CORNERS  
 -EMBED PER LOCAL  
 CODE GUIDELINES

3 TYPICAL WALL SECTION  
 1/2" = 1'-0"

**Caviness Land**  
 Building and Development Company  
Builder of Excellence © 2020 CavLand

AMERICAN INSTITUTE OF BUILDING DESIGNERS  
**A I B D**  
 REGISTERED PROFESSIONAL ARCHITECTS

NATIONAL COUNCIL OF  
 BUILDING OFFICIALS  
 TODD TUCKER 34-156

FORTIFIED-WISE™  
 PROFESSIONAL

**Caviness Land**

SHEET TITLE:  
**ELEVATIONS**

SCALE:  
 1/4" = 1'-0"

DATE:  
**FEBRUARY 2014**


PLAN NO:  
**CL 3187**

SHEET NO.  
2

4/21/2020


T:\CavLand\CL 3187\CL 3187 GR 4-21-20.dwg, 4/21/2020 10:34:57 AM

CHECK BOX FOR:  
 SCREEN PORCH

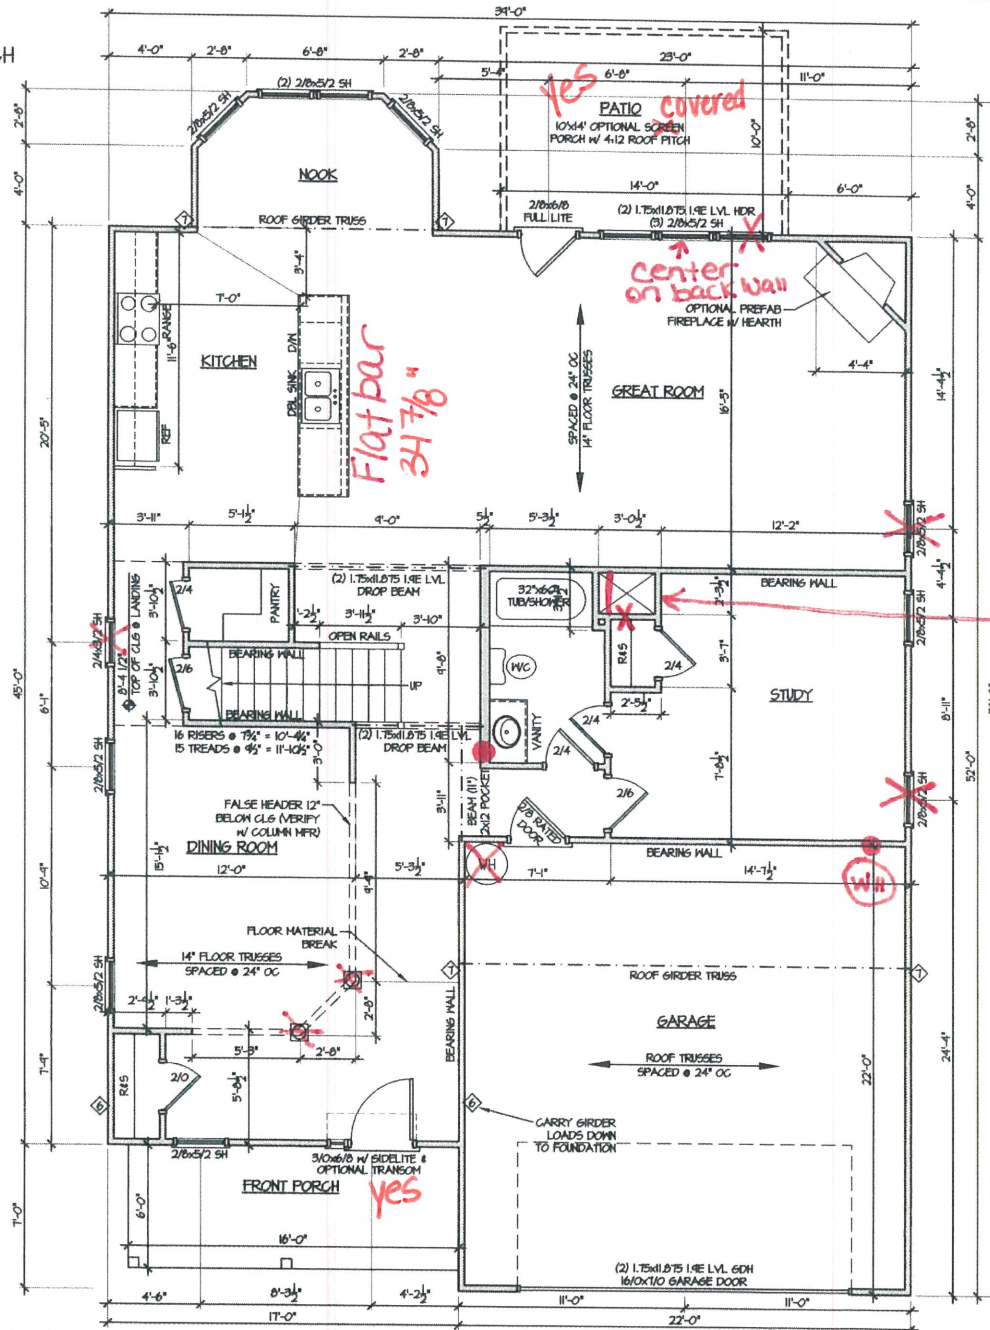

● plumbing drops

Make full closet. Do not need d/c.

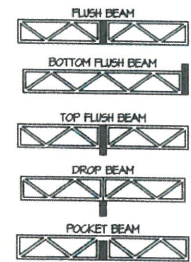

GENERAL NOTE:  
 ALL 2x4 WALLS DRAWN AS 3/2"  
 ALL 2x6 WALLS DRAWN AS 5/2"  
 ALL EXTERIOR DIMENSIONS INCLUDE WALL SHEATHING  
 ALL WALLS ARE 2x4 WALLS UNLESS OTHERWISE NOTED  
 IN LOAD-BEARING HALLS:  
 ALL OPENING WINDOW & DOOR HEADERS TO BE (2) 2x10 SYP #2 & (2) STUDS ON EACH SIDE UNLESS NOTED OTHERWISE  
 ◇ SYMBOL FOR REQUIRED STUDS FOR BEAM ABOVE  
 ARROW INDICATES SPAN DIRECTION FOR TRUSSES TRUSS HFR TO CALCULATE ALL UPLIFT LOADS AND SPECIFY ADEQUATE HANGERS & TIE DOWN

**Caviness Land**  
 Building and Development Company  
 Builder of Excellence © 2020 Caviness Land

A I B D  
 NATIONAL INSTITUTE OF BUILDING DESIGNERS

NATIONAL COUNCIL OF BUILDING CONTRACTORS  
 TODD TUCKER 34-156

FORTIFIED-WISE™ PROFESSIONAL

**Caviness Land**  
 SHEET TITLE: **FIRST FLOOR**

SCALE: 1/4" = 1'-0"

DATE: FEBRUARY 2014

PLAN NO: CL 3187

SHEET NO: 4

4/21/2020

