

~ 125 Indigo St., Lillington ~
 Lot 58, South Creek Subd., Phase 3
 Map #2020, Pages 348-351

~ Foundation Survey ~
Signature Home Builders Inc.

Neill's Creek Twp. Harnett County
 Scale: 1" = 40' Date: Feb. 6, 2021


Surveyed & Mapped By
STREAMLINE LAND SURVEYING, Inc.
 NC FIRM C-1898
 870 NC 55 W, Coats, N.C. 27521
 Phone: 910-897-7715

I hereby certify that the foundation location shown hereon is correct in relation to property lines of record.


NOTE: The purpose of this survey is to locate the newly constructed foundation. Other features, fixtures, encumbrances and indications of use may be revealed by a complete site survey.

Robert E. Godwin, Jr.
 LAND SURVEYOR
 L-3790

NOT FOR RECORDATION

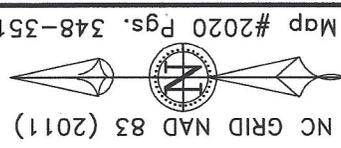

"Open Space (OS2)"

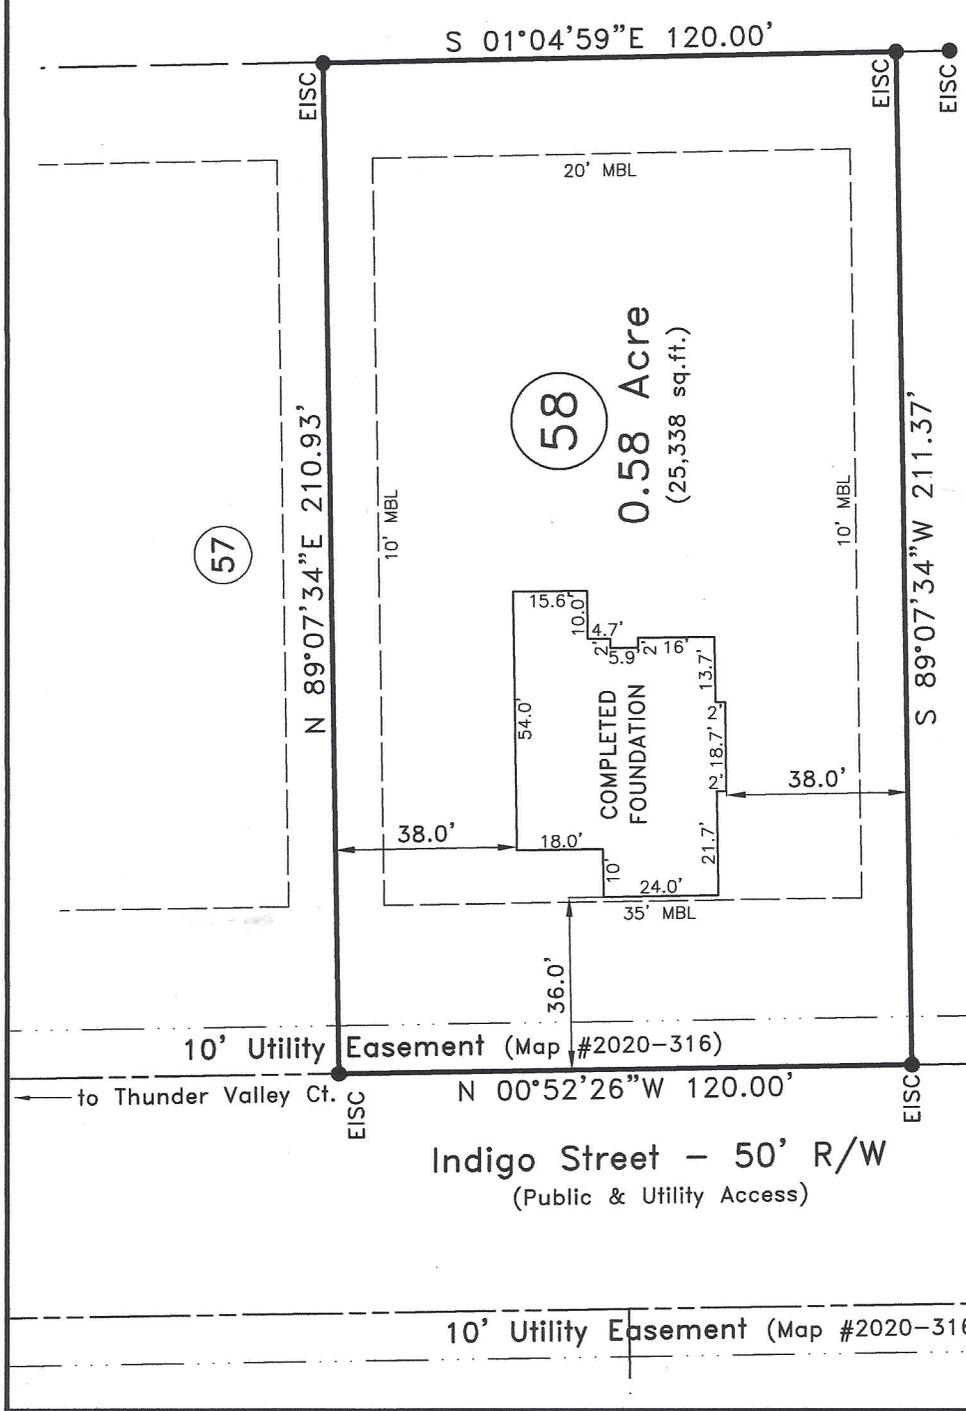

- LEGEND:**
- Subject Boundary Line
 - Adjoining Boundary Line
 - R/W Right-of-Way Line
 - C/L Centerline
 - Minimum Building Line
 - Survey tie lines
 - Calculated Point
 - △ CP
 - Existing Iron Stake with Cap
 - Below/Above Grade
 - Fire Hydrant
 - Water Meter
 - Water Valve
 - Sanitary Sewer Clean-Out
 - Telephone Pedestal

Note:
 Foundation Location based upon nails set in concrete footing for brick masons on January 16th, 2021. As-built dimensions of foundation confirmed on this date.

Impervious Surface Limit:
 PHASE 3 - 6,158 SF per lot

0 20' 40' 80'
 GRAPHIC SCALE

FEMA FLOOD HAZARD STATEMENT
 The subject property shown on this plat is located within the FEMA "Zone X" (Minimal Flood Risk) Area as shown on FIRM Number: 3720066000J
 Effective date: 10/3/2006