


LEGEND:


- Subject Boundary Line
- Adjoining Boundary Line
- R/W Right-of-Way Line
- C/L Centerline
- Minimum Building Line
- Survey tie lines
- Δ CP Calculated Point
- △ ERB Existing Iron Re-Bar
- △ BG/AG Below/Above Grade
- △ FH Fire Hydrant
- △ WM Water Meter
- △ WV Water Valve
- △ SS Sanitary Sewer Clean-Out
- △ TP Telephone Pedestal

Note:
 "Finley's Crossing" was formerly recorded as "Centrella Subdivision" Map #2017-353. Lots are Subject to Protective Covenants recorded in Deed Book 3616, Page 87.

FEMA FLOOD HAZARD STATEMENT
 The subject property shown on this plat is NOT located within the FEMA 1% Annual Chance Flood Hazard Area "Zone A" or "Zone AE" as shown on FIRM Number: 3720064000J
 Effective date: 10/3/2006

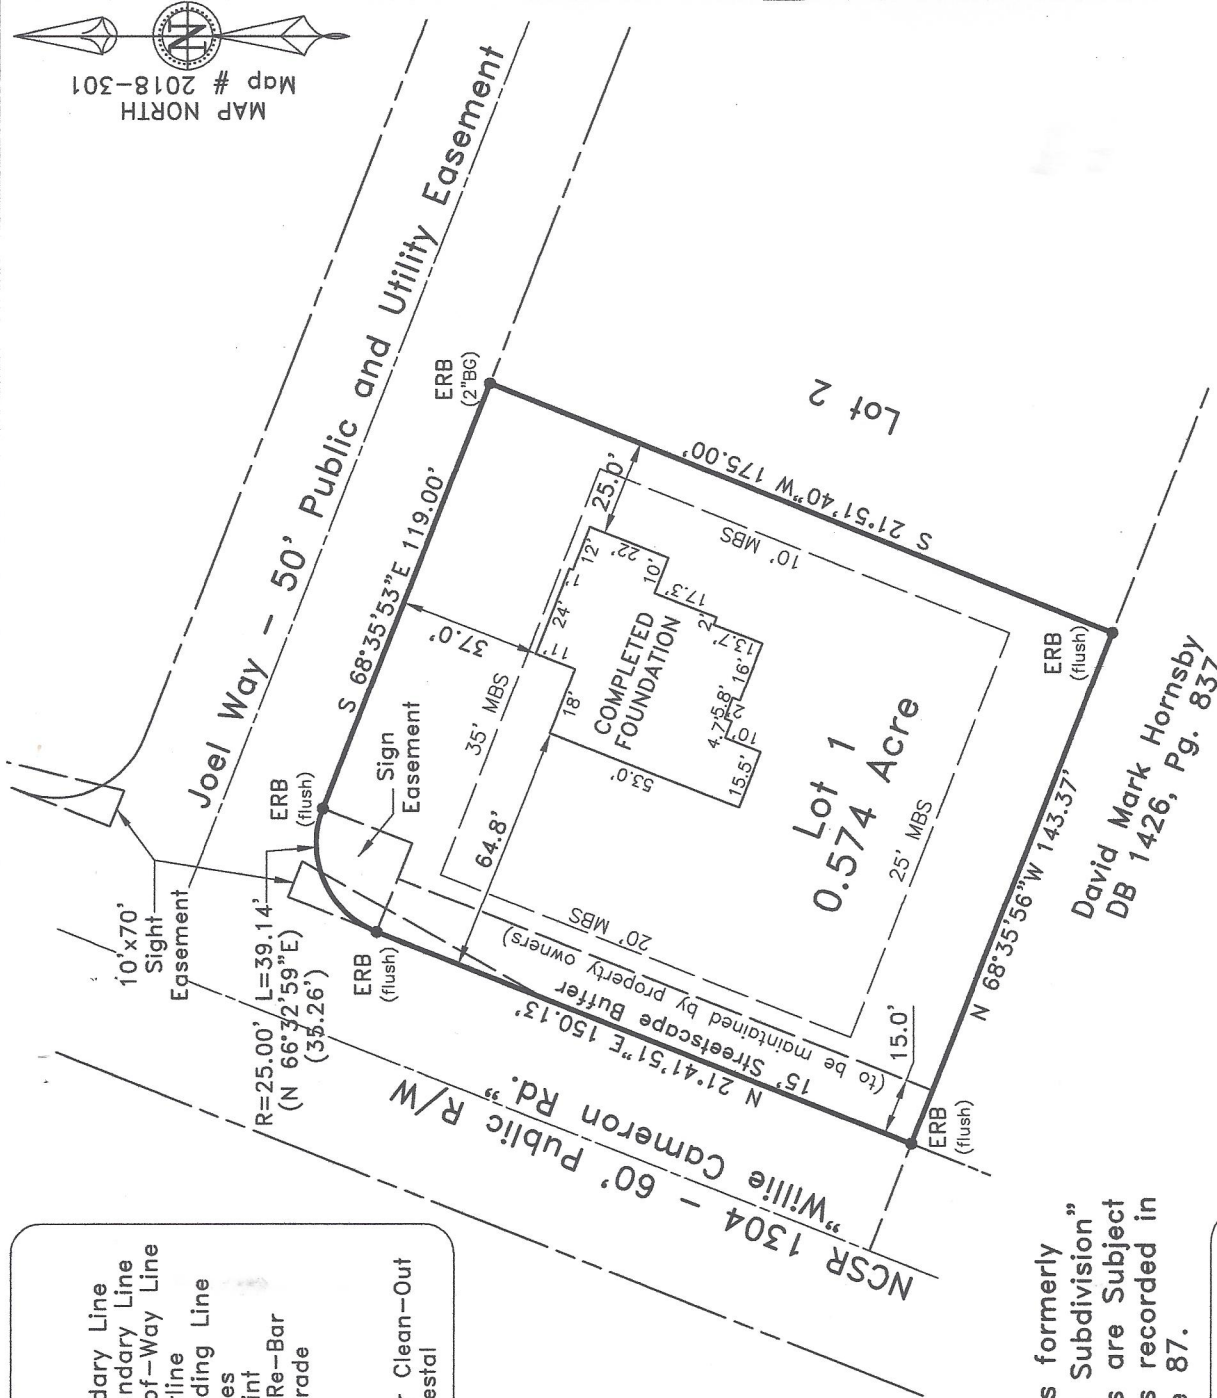

Note:
 Foundation Location based upon nails set in concrete footing for brick masons on March 8th, 2021. As-built dimensions of foundation confirmed on this date.

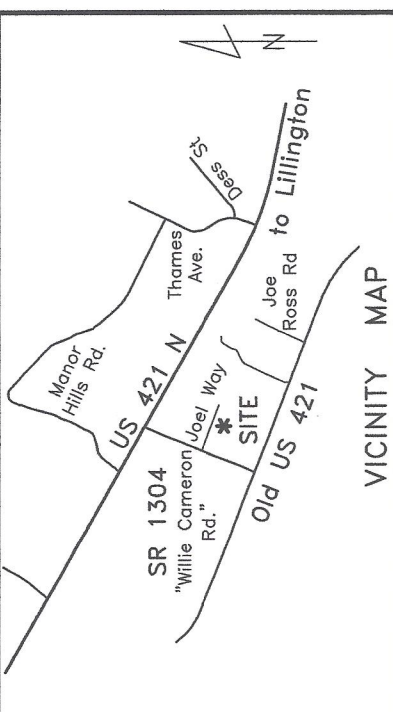

VICINITY MAP

~ 24 Joel Way, Lillington ~
 Lot 1, Finley's Crossing Subd.
 Map #2018-301

~ Foundation Survey ~
Signature Home Builders, Inc.

Upper Little River Twp., Harnett County
 Scale: 1" = 50' Date: April 7, 2021

Surveyed & Mapped By
STREAMLINE LAND SURVEYING, Inc.
 NC FIRM C-1898
 870 NC 55 W, Coats, N.C. 27521
 Phone: 910-897-7715

I hereby certify that the foundation location shown hereon is correct in relation to property lines of record.
 NOTE: The purpose of this survey is to locate the newly constructed foundation. Other features, fixtures, encumbrances and indications of use may be revealed by a complete site survey.

Robert E. Godwin, Jr.
 LAND SURVEYOR
 SEAL L-3790

NOT FOR RECORDATION