


# Forest Oaks 312

LIST OF SYMBOLS			
	SECTION MARK		DATUM ELEVATION
	DETAIL MARK		SLOPE UP
	TITLE MARK		EARTH
	INTERIOR BEARING WALL		INSULATION
	NUMBER OF STUDS IN WALL		

TABLE OF CONTENTS	
1	ELEVATIONS
2	ELEVATIONS
3	FOUNDATION PLAN
4	1st FLOOR PLAN
5	2nd FLOOR PLAN
E1	1st FLOOR ELECTRICAL PLAN
E2	2nd FLOOR ELECTRICAL PLAN

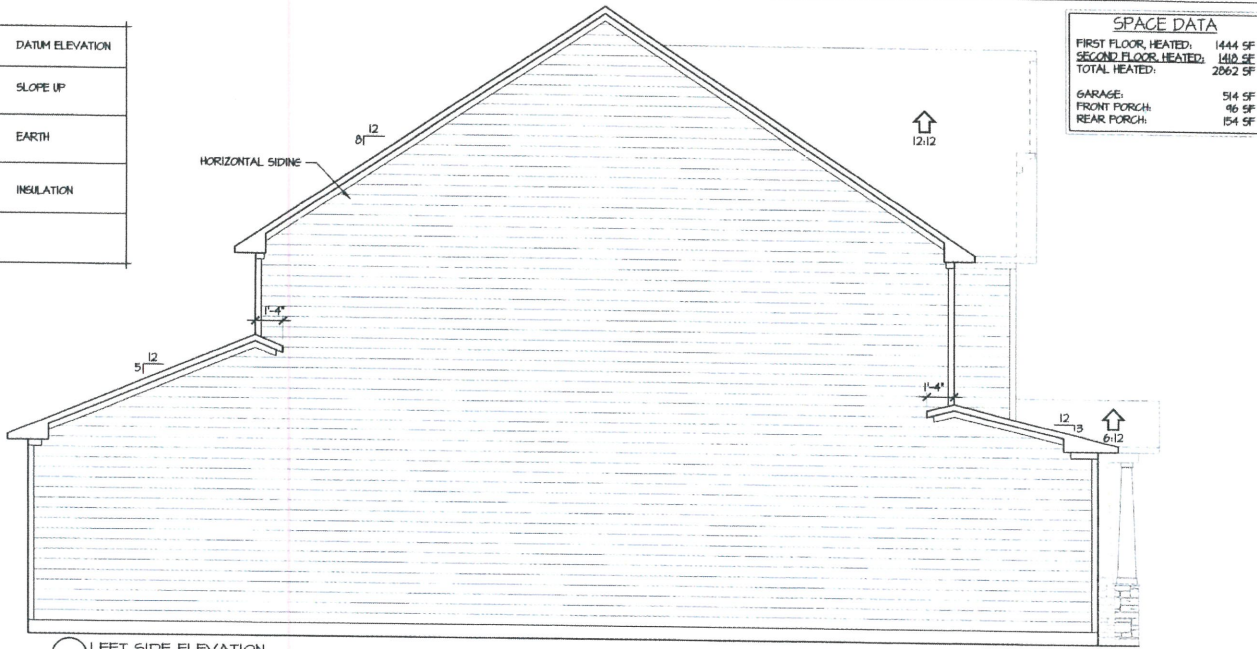

SPACE DATA	
FIRST FLOOR, HEATED:	1444 SF
SECOND FLOOR, HEATED:	1410 SF
TOTAL HEATED:	2862 SF
GARAGE:	514 SF
FRONT PORCH:	96 SF
REAR PORCH:	154 SF


**CRDG**  
**CAROLINA RESIDENTIAL DESIGN GROUP, LLC**  
 Professional Member  
 Institute of Chartered Architects  
 American Institute of Building Design  
 Certified Professional Building Designer  
 TODD TUCKER, AIA, CPBD  
 919-435-7930

**AMERICAN INSTITUTE OF BUILDING DESIGN**  
**AIBD**

**NATIONAL COUNCIL OF BUILDING SPECIFICATIONS**  
 TODD TUCKER 34 - 156


The Architectural Firm, Carolina Residential Design Group, LLC, is not responsible for any construction or building code violations or for any other conditions or circumstances that may arise from the use of these drawings. The Architectural Firm is not responsible for any conditions or circumstances that may arise from the use of these drawings. The Architectural Firm is not responsible for any conditions or circumstances that may arise from the use of these drawings. The Architectural Firm is not responsible for any conditions or circumstances that may arise from the use of these drawings.

2 LEFT SIDE ELEVATION  
1/4" = 1'-0"

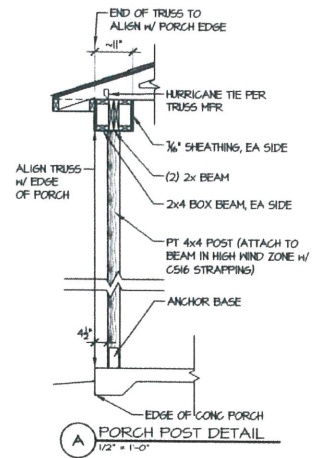


A PORCH POST DETAIL  
1/2" = 1'-0"

1 FRONT ELEVATION  
1/4" = 1'-0"

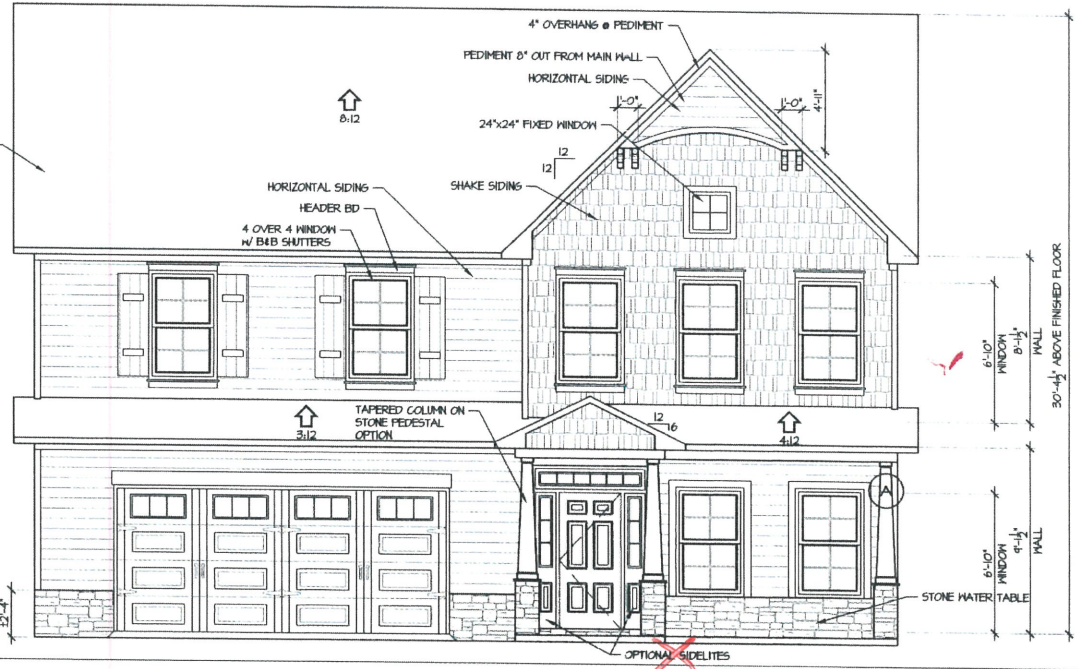


**Caviness Land**  
 ELEVATIONS/DETAILS  
 SHEET TITLE:

CL 2862  
 SCALE AS NOTED  
 JANUARY 2018  
 REV: 1

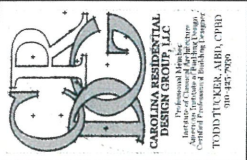

**CAROLINA RESIDENTIAL DESIGN GROUP, LLC**  
 Licensed Professional Architect  
 Carolina Residential Design Group, LLC  
 TODD TUCKER, ARCHITECT  
 910-457-7899




**INSTITUTE OF BUILDING DESIGN**  
 A B D  
 AMERICAN  
 REGISTERED PROFESSIONAL ARCHITECTS



**NATIONAL COUNCIL OF ARCHITECTS**  
 TODD TUCKER 34-156

**ELEVATIONS**

SHEET TITLE:

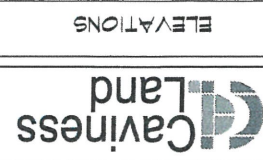

**Caviness Land**


CL 2862

SCALE AS NOTED

JANUARY 2018

REV:

2

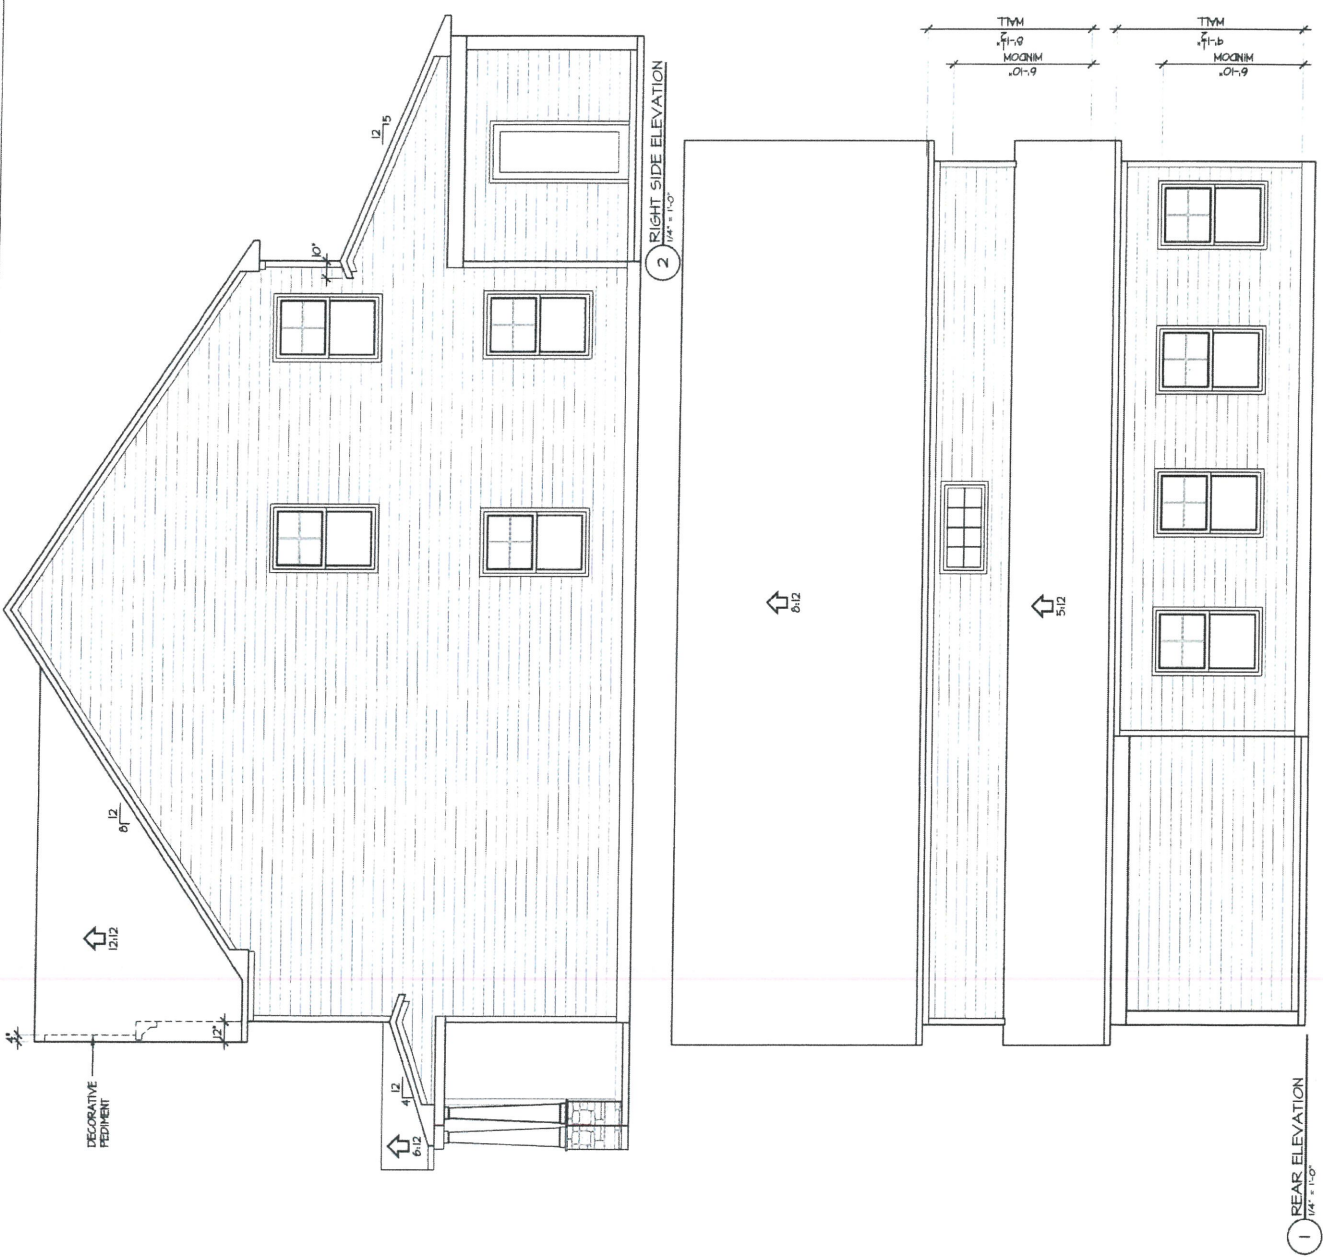


**LIST OF ABBREVIATIONS**

ACC55	ACCESS TO ATTIC OR CRAWL SPACE	DM	DISH WASHER
AF	ADJACENT FLOOR	EA	EQUAL
BRM	BREAK ROOM	FN	FOUNDATION VENT
CB	CABINETS / CABINETS	GL	GLASS (DOOR)
CL	CONTROL JOINT	HB	HOSE BIB
CMU	CONCRETE MASONRY UNIT	HDR	DOOR / WINDOW / OPENING HEADER
CO	CLEAR OPENING	HVAC	HEATING, VENTING & AIR CONDITION
CSHT	CASHEMENT	KWALL	KNEEWALL
COL	COLUMN	LVL	LAMINATED VENEER LUMBER
CSHT	CASHEMENT	MANF	MANUFACTURED
CONC	CONCRETE	MAS	MASONRY
DL	DOUBLE HANG / SINGLE HANG WINDOW	MC	NOT IN CONTRACT
DN	DOWN	OH	OVERHANG
DISH	DISH	OC	ON CENTER
DP	DEEP	OPNS	OPENINGS
TOP CHORD	T.O.	PKT	POCKET DOOR
TOP OF MALL	TOM	PL	PLATE
TYPICAL	TYP	PREP	PREPARED
UNLESS OTHERWISE NOTED	UN	PT	POINT LOAD (SOLID BLOCK)
VAPOR BARRIER	VB	PR	PRESSURE TREATED FOR EXPOSURE
VANITY	VAN	REF	REFRIGERATOR
WIDE	W	REIN	REINFORCEMENT
NUMBER OF STUD POCKETS & WINDOW/DOOR JAMB	SP	RIS	ROD & SHELF (CLOSERS)
		ROOF	ROOF
		SE6M	SEGMENTED
		SH(V)	SHALLOW
		SH(VS)	SHELVES
		SPEC	SPECIFICATION / SPECIFIED
		SQ	SQUARE
		SST	SIMPSON STRONG-TIE OR EQUAL
		SUBLR	SUB-FLOOR
		SUP	SOUTHERN YELLOW PINE

1 REAR ELEVATION (1/8" = 1'-0")

2 RIGHT SIDE ELEVATION (1/8" = 1'-0")



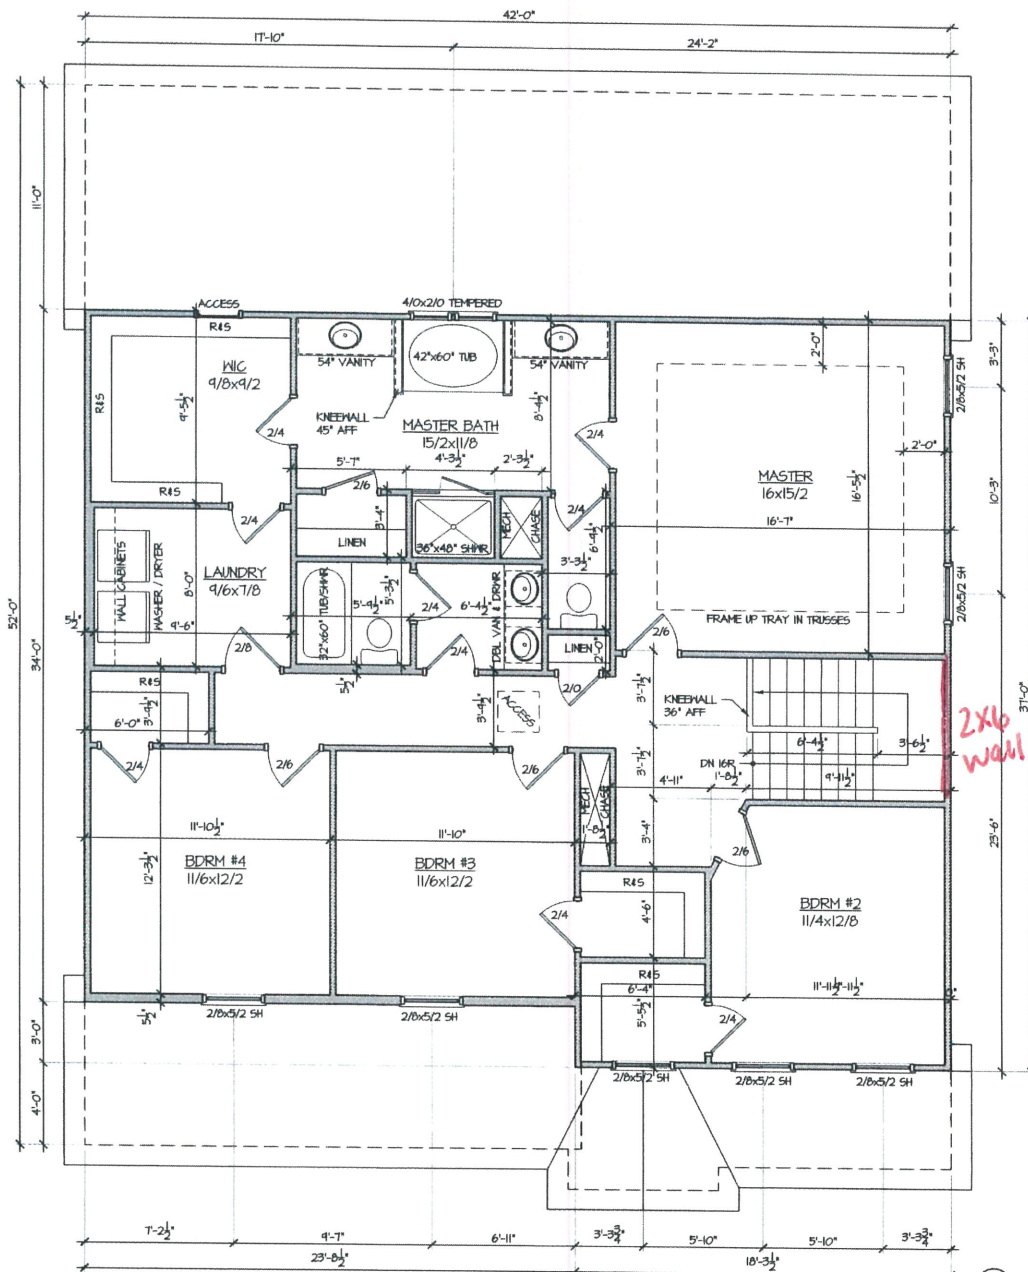

SPACE DATA	
FIRST FLOOR HEATED	1444 SF
SECOND FLOOR HEATED	1460 SF
TOTAL HEATED	2862 SF
GARAGE:	
FRONT PORCH	514 SF
REAR PORCH	46 SF
	154 SF

**FIELD & REDLINE NOTES**

---



---




---



---



---

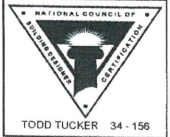

TODD TUCKER 34 - 156

THE INFORMATION IS BELIEVED TO BE CORRECT AS OF THE DATE OF THE DRAWING. THE ARCHITECT ASSUMES NO RESPONSIBILITY FOR THE ACCURACY OF THE INFORMATION PROVIDED BY OTHERS. THE ARCHITECT ASSUMES NO RESPONSIBILITY FOR THE ACCURACY OF THE INFORMATION PROVIDED BY OTHERS. THE ARCHITECT ASSUMES NO RESPONSIBILITY FOR THE ACCURACY OF THE INFORMATION PROVIDED BY OTHERS.

**CAVINNESS LAND**

**SECOND FLOOR PLAN - 4 BDRM**

SHEET TITLE:

CL 2862
SCALE AS NOTED
JANUARY 2018
REV: <b>5</b>

1 SECOND FLOOR PLAN  
1/4" = 1'-0"