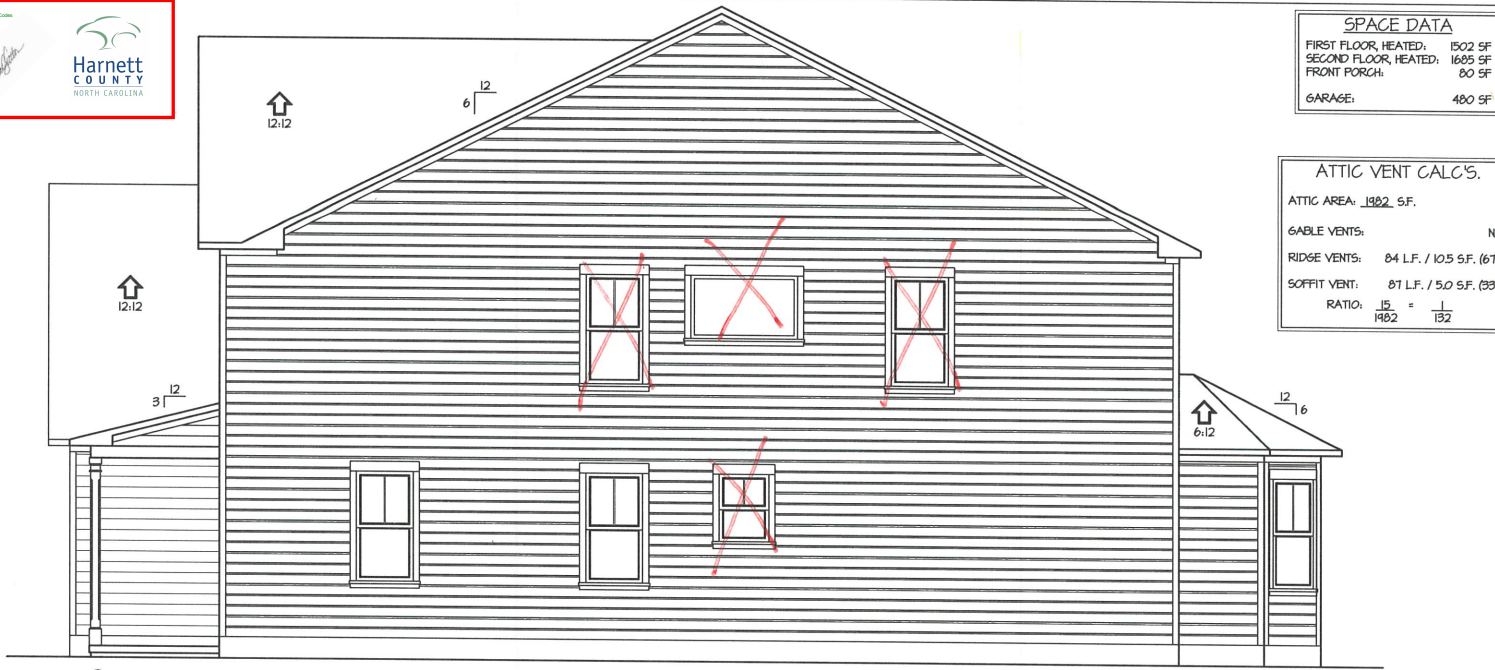


# FO 314

**NOTICE TO CONTRACTOR**  
All construction shall conform to applicable NC Building Codes and to details in these specifications and conditions.

**APPROVED**  
Unaltered building only, no other  
Project holder responsible for  
Full compliance with this code.

02/02/2021

**SPACE DATA**

FIRST FLOOR, HEATED:	1502 SF
SECOND FLOOR, HEATED:	1685 SF
FRONT PORCH:	80 SF
GARAGE:	480 SF

**ATTIC VENT CALC'S.**

ATTIC AREA: 1482 SF.


GABLE VENTS: N/A

RIDGE VENTS: 84 LF. / 10.5 SF. (67%)

SOFFIT VENT: 87 LF. / 50 SF. (33%)

RATIO:  $\frac{15}{1482} = \frac{1}{132}$


**2 RIGHT ELEVATION**  
1/4" = 1'-0"

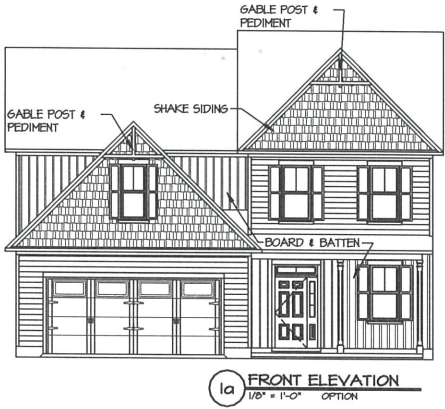

**1a FRONT ELEVATION**  
1/8" = 1'-0" OPTION


CHECK APPROPRIATE BOX (FIRST FLOOR)

- 8' CEILINGS
- 9' CEILINGS  
ON 9' CEILINGS UPGRADE ALL FIRST FLOOR  
WINDOWS SHOWN AS 2/8x5/2 TO  
2/8x6/0 WINDOWS (0 SINGLES / 1 TRIN / 1 TRIPLE)

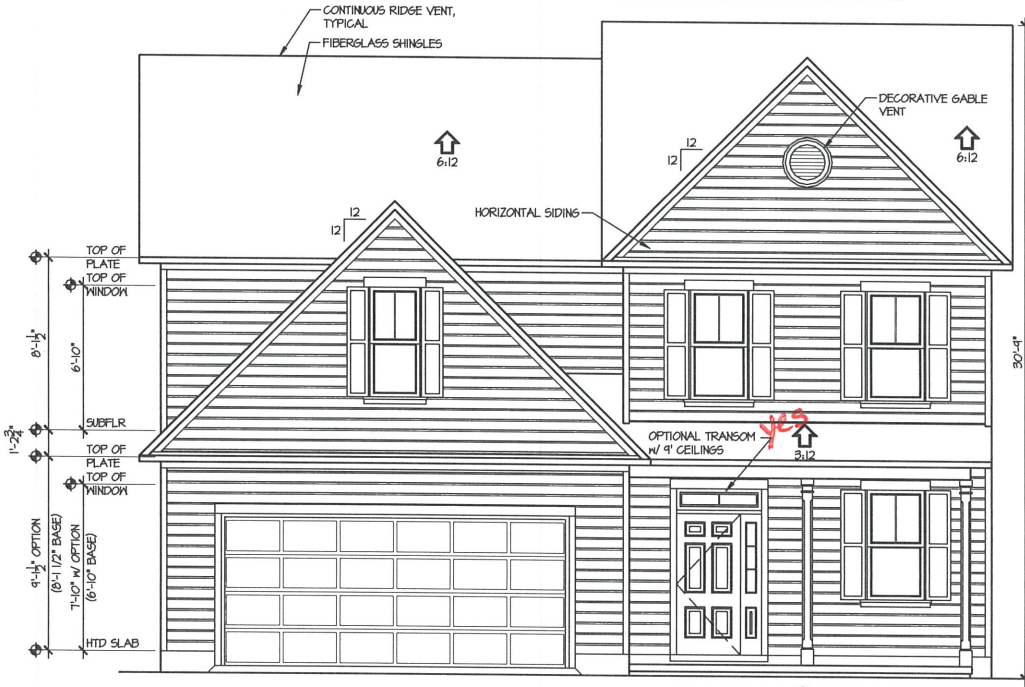

**1 FRONT ELEVATION**  
1/4" = 1'-0"

*Carolina Residential Design*



**TODD TUCKER**  
Professional Member  
American Institute of Building Design  
Institute of Classical Architecture

111 S GREEN STREET  
PARKTON, NC 28771  
(919) 425-7000

**NATIONAL COUNCIL OF BUILDERS**



TODD TUCKER 34 - 156

THE APPROXIMATE SQUARE FOOTAGE INDICATED IS FOR THE EXCLUSIVE USE OF THE CLIENT IN CONNECTION WITH THE BUILDING PERMITS IN THE JURISDICTION. THE SQUARE FOOTAGE IS PROVIDED FOR INFORMATION ONLY AND DOES NOT CONSTITUTE A GUARANTEE OF THE ACCURACY OF THE SQUARE FOOTAGE AND THE LOCAL GOVERNMENT'S OFFICE. IF THE CLIENT REQUESTS AN AS-BUILT SQUARE FOOTAGE, THE CLIENT SHALL BE RESPONSIBLE FOR THE COST OF THE AS-BUILT SQUARE FOOTAGE. THE CLIENT SHALL ALSO MAINTAIN THE SQUARE FOOTAGE AS-BUILT AND MAINTAIN RECORDS TO THE SQUARE FOOTAGE TO BE REFERRED TO BY THE CLIENT.

**Caviness Land ELEVATIONS**

SCALE: AS NOTED


DATE: FEBRUARY 2014

PLAN: CL 310T


LOT NO:

SHEET NO. **A-1**

E:\Autodesk Projects 2015\My Projects\CAVINESS LAND\CL\_3187 5-17-19.dwg, 5/17/2019 7:07:40 AM

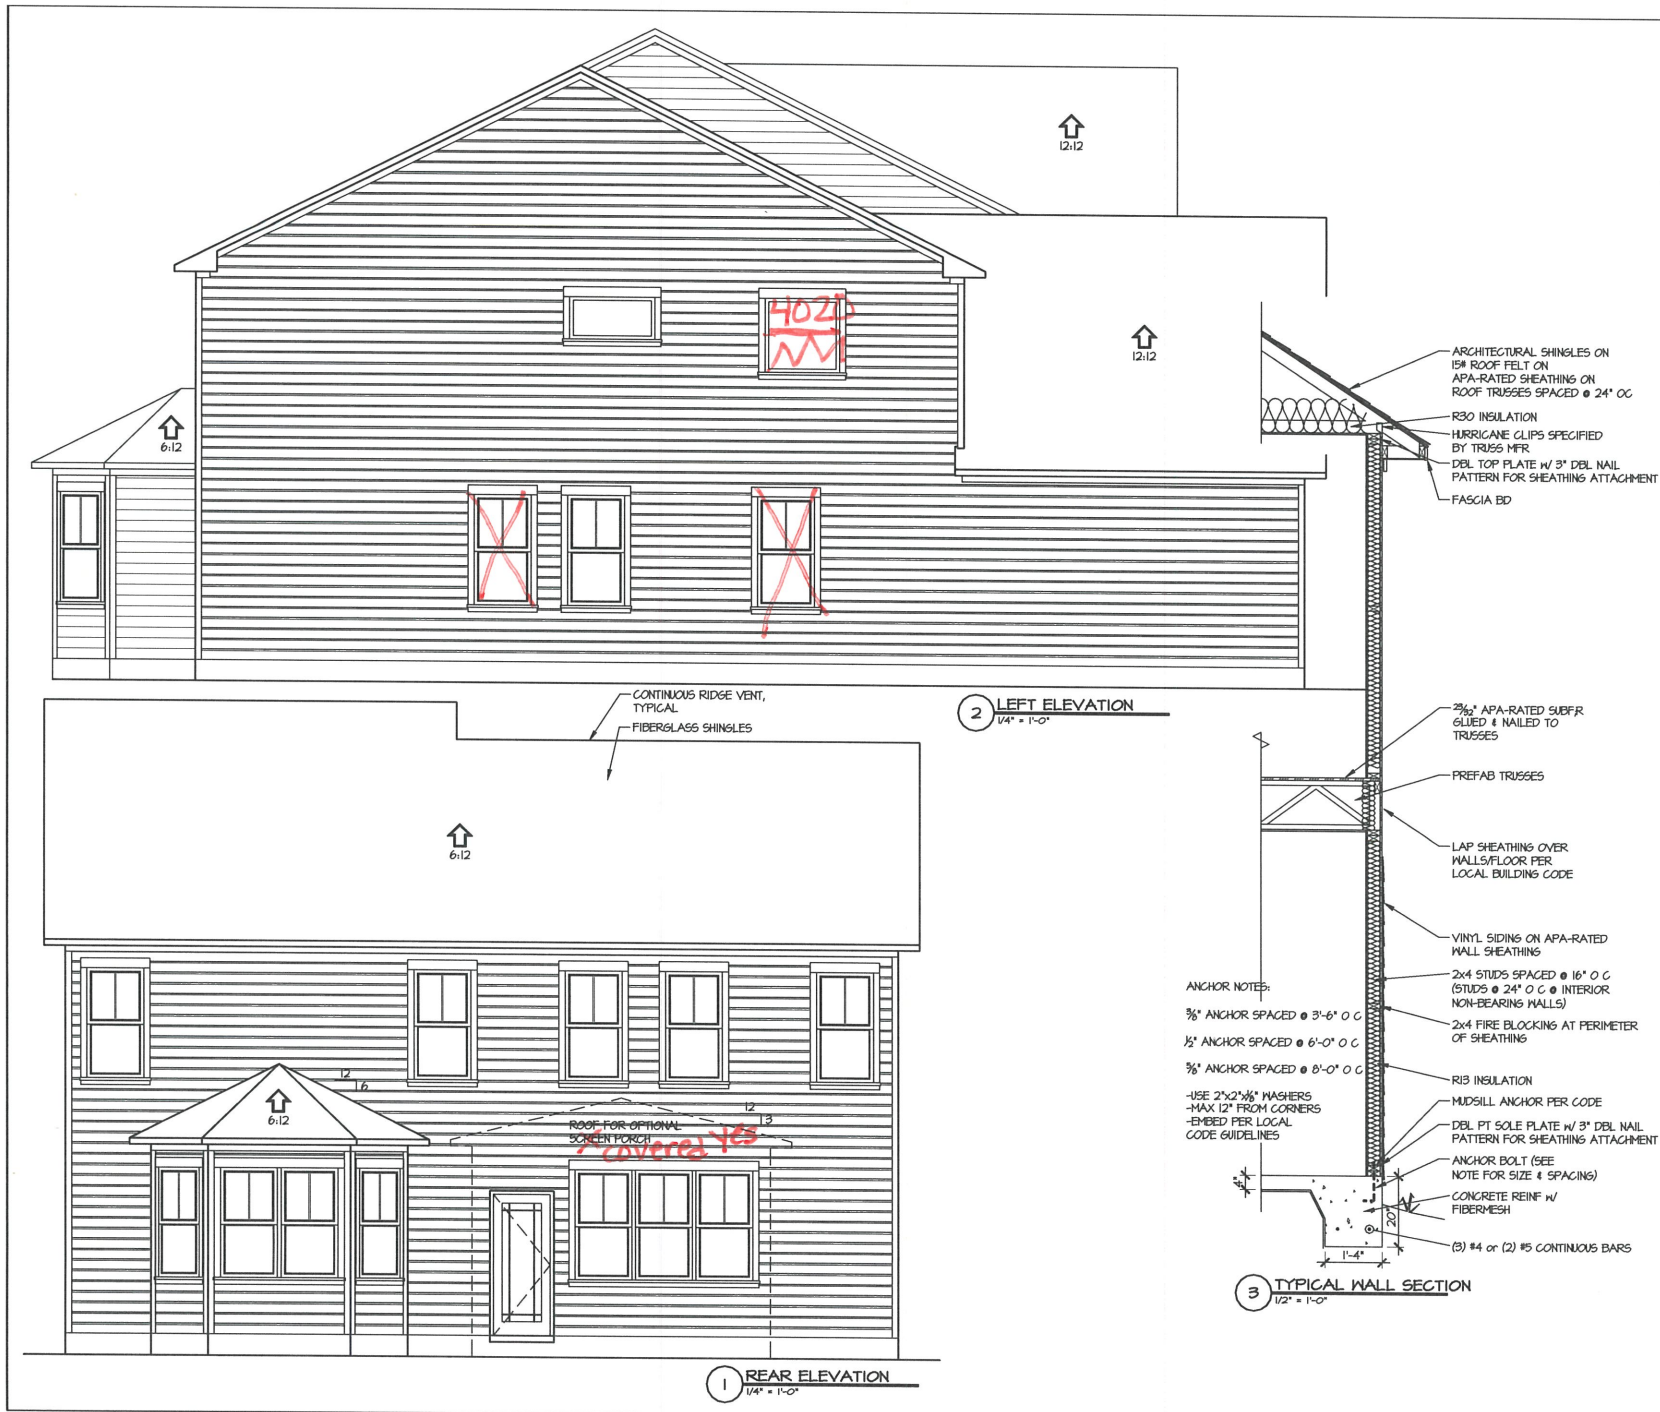

Carolina Residential Design

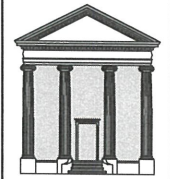

TODD TUCKER  
Professional Member  
American Institute of Building Design  
Institute of Classical Architecture  
111 S GREEN STREET  
PARKTON, NC 28371  
(910) 425-7884



TODD TUCKER 34 - 156

THE INFORMATION IN THESE CONSTRUCTION DOCUMENTS IS FOR THE EXCLUSIVE USE OF THE CLIENT IN CONNECTION WITH THE PROJECT DESCRIBED IN THE DOCUMENTS. THE DOCUMENTS AND ANY INFORMATION CONTAINED HEREIN ARE THE PROPERTY OF CAROLINA RESIDENTIAL DESIGN AND ARE NOT TO BE REPRODUCED, COPIED, OR TRANSMITTED IN ANY FORM OR BY ANY MEANS, ELECTRONIC OR MECHANICAL, INCLUDING PHOTOCOPYING, RECORDING, OR BY ANY INFORMATION STORAGE AND RETRIEVAL SYSTEM, WITHOUT THE WRITTEN PERMISSION OF CAROLINA RESIDENTIAL DESIGN. THE CLIENT SHALL BE RESPONSIBLE FOR OBTAINING ALL NECESSARY PERMITS AND REGULATORY APPROVALS TO THE PROJECTS RELATED TO THE PROJECT AND SHALL BE RESPONSIBLE FOR OBTAINING ALL NECESSARY PERMITS TO THE PROJECT AND SHALL BE RESPONSIBLE FOR THE DESIGN OF THE CLIENT.

**Caviness Land**

**ELEVATIONS**

SCALE: AS NOTED

DATE: FEBRUARY 2014

PLAN: CL 3187


LOT NO:

SHEET NO: A-2

Plumbing drops

CHECK BOX FOR:  
 SCREEN PORCH

make full  
 cidset do not need d/c

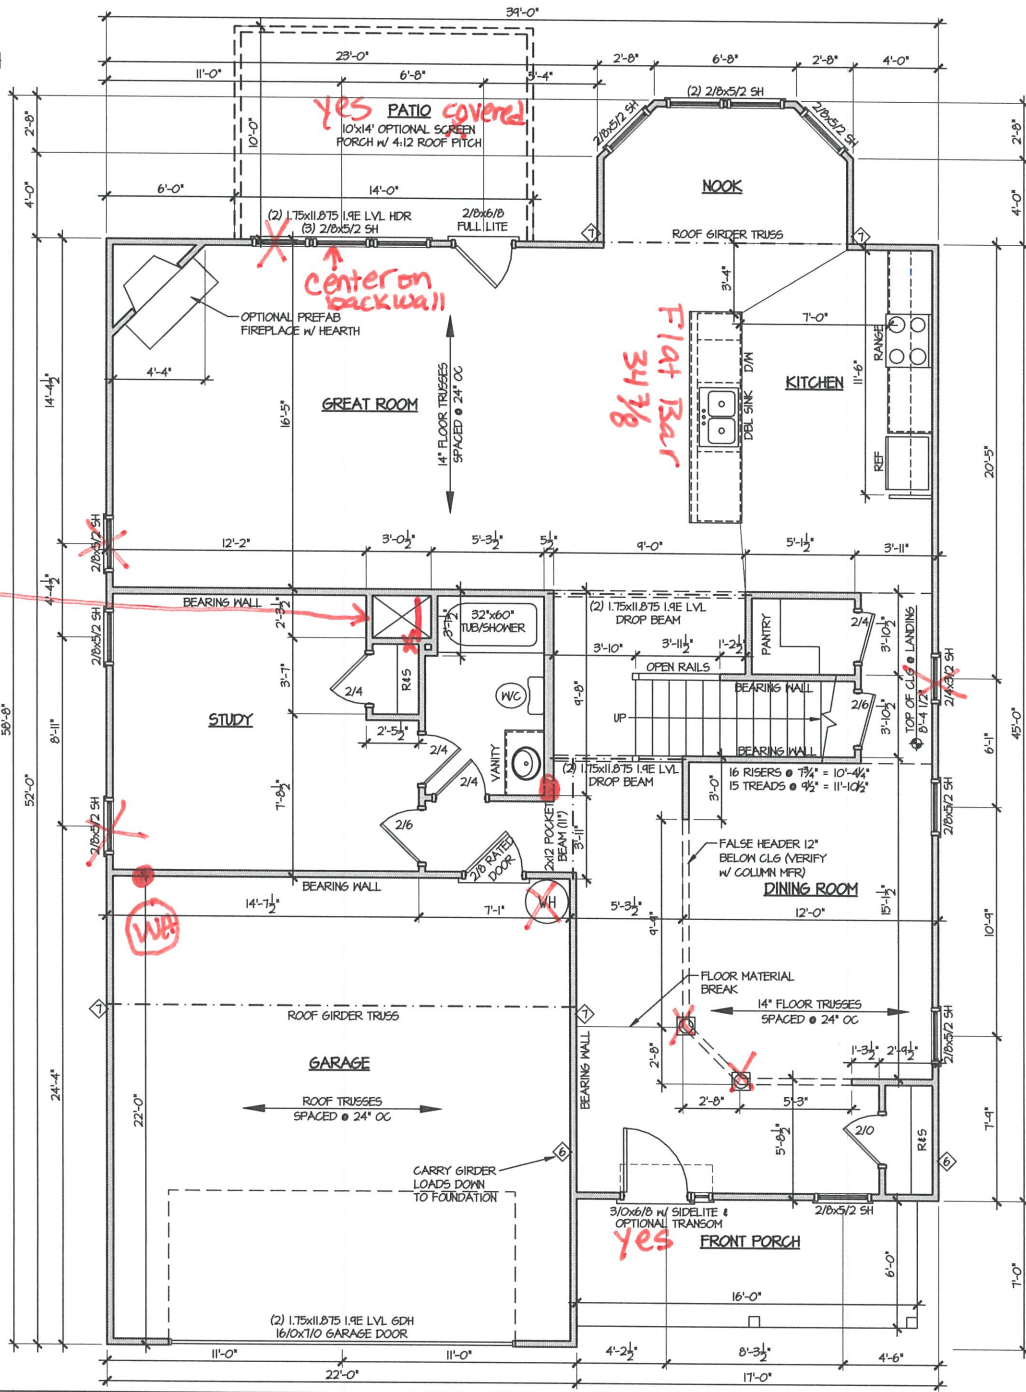

**GENERAL NOTE:**  
 ALL 2x4 WALLS DRAWN AS 3 1/2"  
 ALL 2x6 WALLS DRAWN AS 5 1/2"  
 ALL EXTERIOR DIMENSIONS INCLUDE WALL SHEATHING  
 ALL WALLS ARE 2x4 WALLS UNLESS OTHERWISE NOTED  
**IN LOAD-BEARING WALLS:**  
 ALL OPENINGS, WINDOW & DOOR HEADERS TO BE (2) 2x10 SYP #2 & (2) STUDS ON EACH SIDE UNLESS NOTED OTHERWISE  
 ◊ SYMBOL FOR REQUIRED STUDS FOR BEAM ABOVE  
 ARROW INDICATES SPAN DIRECTION FOR TRUSSES TRUSS MFR TO CALCULATE ALL UPLIFT LOADS AND SPECIFY ADEQUATE HANGERS & TIE DOWNS

Carolina Residential Design

TODD TUCKER  
 Professional Member  
 American Institute of Building Design  
 Institute of Classical Architecture  
 11 5 GREEN STREET  
 PARSONS, NC 28571  
 (910) 452-7831

TODD TUCKER 34-156

THE INFORMATION IN THESE CONSTRUCTION DOCUMENTS IS FOR THE EXCLUSIVE USE OF THE CLIENT IN CONNECTION WITH THE BUILDING PROJECTS AND IS NOT TO BE REPRODUCED OR TRANSMITTED IN ANY FORM OR BY ANY MEANS, ELECTRONIC OR MECHANICAL, INCLUDING PHOTOCOPYING, RECORDING, OR BY ANY INFORMATION STORAGE AND RETRIEVAL SYSTEM, WITHOUT THE WRITTEN PERMISSION OF THE ARCHITECT. THE CLIENT SHALL BE RESPONSIBLE FOR OBTAINING ALL NECESSARY PERMITS AND APPROVALS FROM ALL APPLICABLE AGENCIES AND AUTHORITIES. THE ARCHITECT SHALL NOT BE RESPONSIBLE FOR THE PROJECT AND OTHER RELATED WORK AS REPRESENTED BY THE DRAWINGS TO THE CLIENT.

Caviness Land

**FIRST FLOOR PLAN**


SCALE: AS NOTED

DATE: FEBRUARY 2014

PLAN: CL 3187

LOT NO:


SHEET NO: A-4

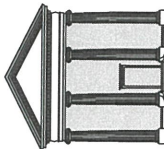



THE ARCHITECT'S & ENGINEER'S PROFESSIONAL LIABILITY INSURANCE POLICY DOES NOT COVER THE ARCHITECT OR ENGINEER FOR NEGLIGENCE OR FOR THE FAILURE OF THE ARCHITECT OR ENGINEER TO OBTAIN NECESSARY PERMITS OR TO OBTAIN NECESSARY APPROVALS FROM THE LOCAL, STATE OR FEDERAL GOVERNMENT. THE ARCHITECT OR ENGINEER SHALL BE RESPONSIBLE FOR OBTAINING ALL NECESSARY PERMITS AND APPROVALS FROM THE LOCAL, STATE OR FEDERAL GOVERNMENT. THE ARCHITECT OR ENGINEER SHALL BE RESPONSIBLE FOR OBTAINING ALL NECESSARY PERMITS AND APPROVALS FROM THE LOCAL, STATE OR FEDERAL GOVERNMENT. THE ARCHITECT OR ENGINEER SHALL BE RESPONSIBLE FOR OBTAINING ALL NECESSARY PERMITS AND APPROVALS FROM THE LOCAL, STATE OR FEDERAL GOVERNMENT.

Caviness Land  
SECOND FLOOR PLAN

SCALE:	A5 NOTED
DATE:	FEBRUARY 2014
PLAN:	CL 3187
LOT NO.:	
SHEET NO.:	A.5

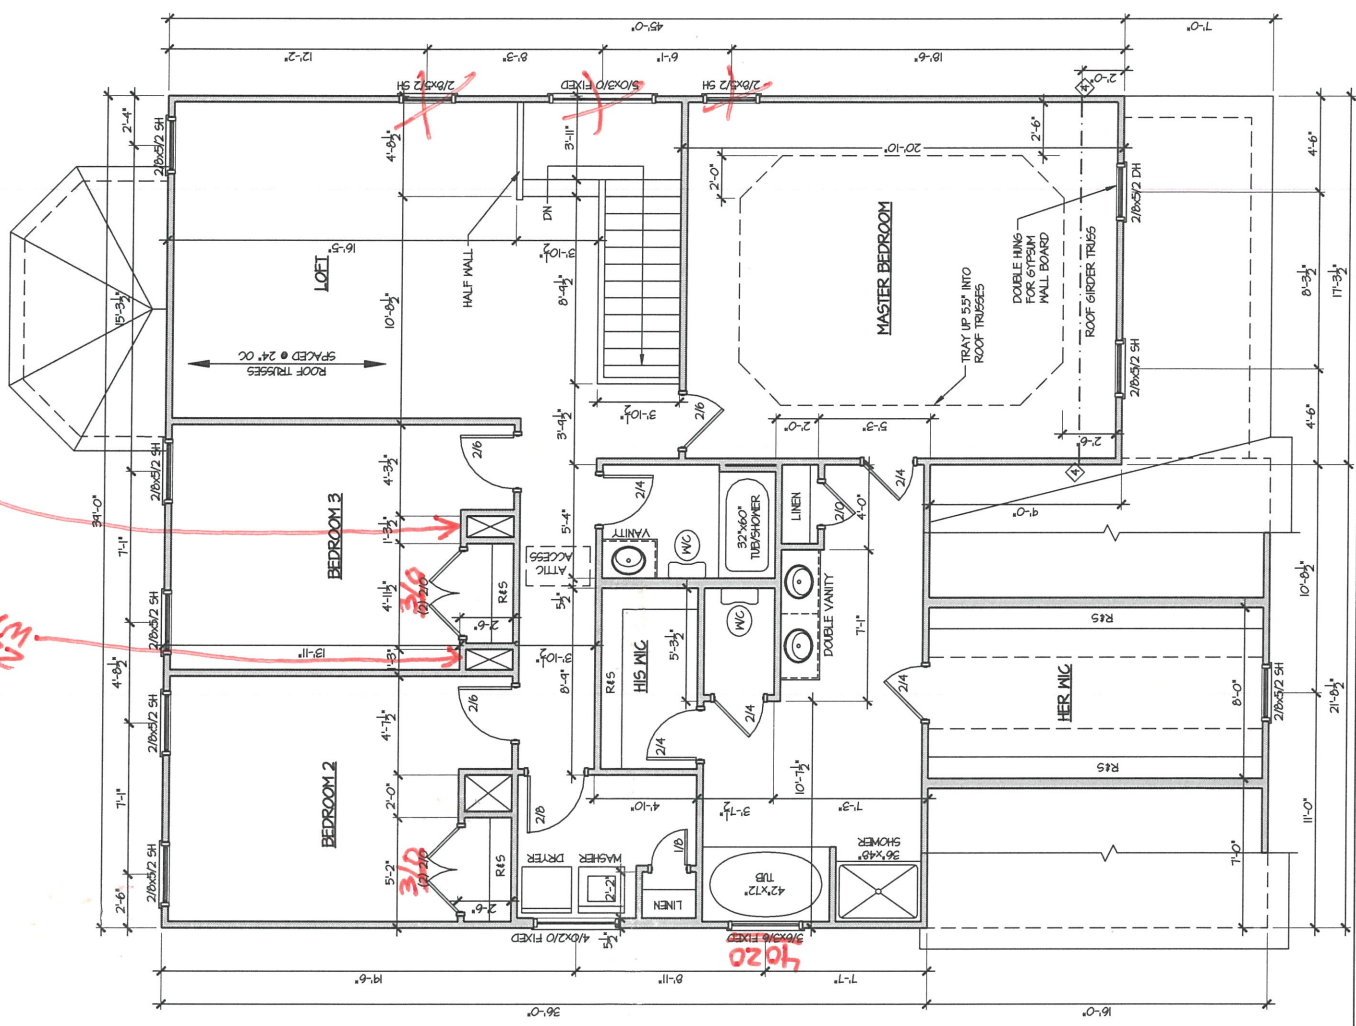

REMOVE  
22\"/>

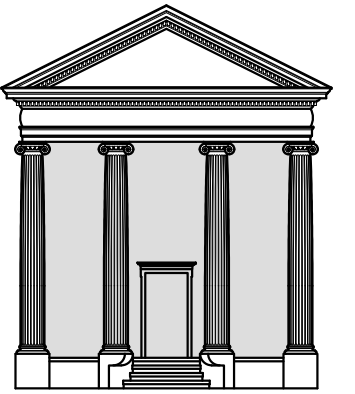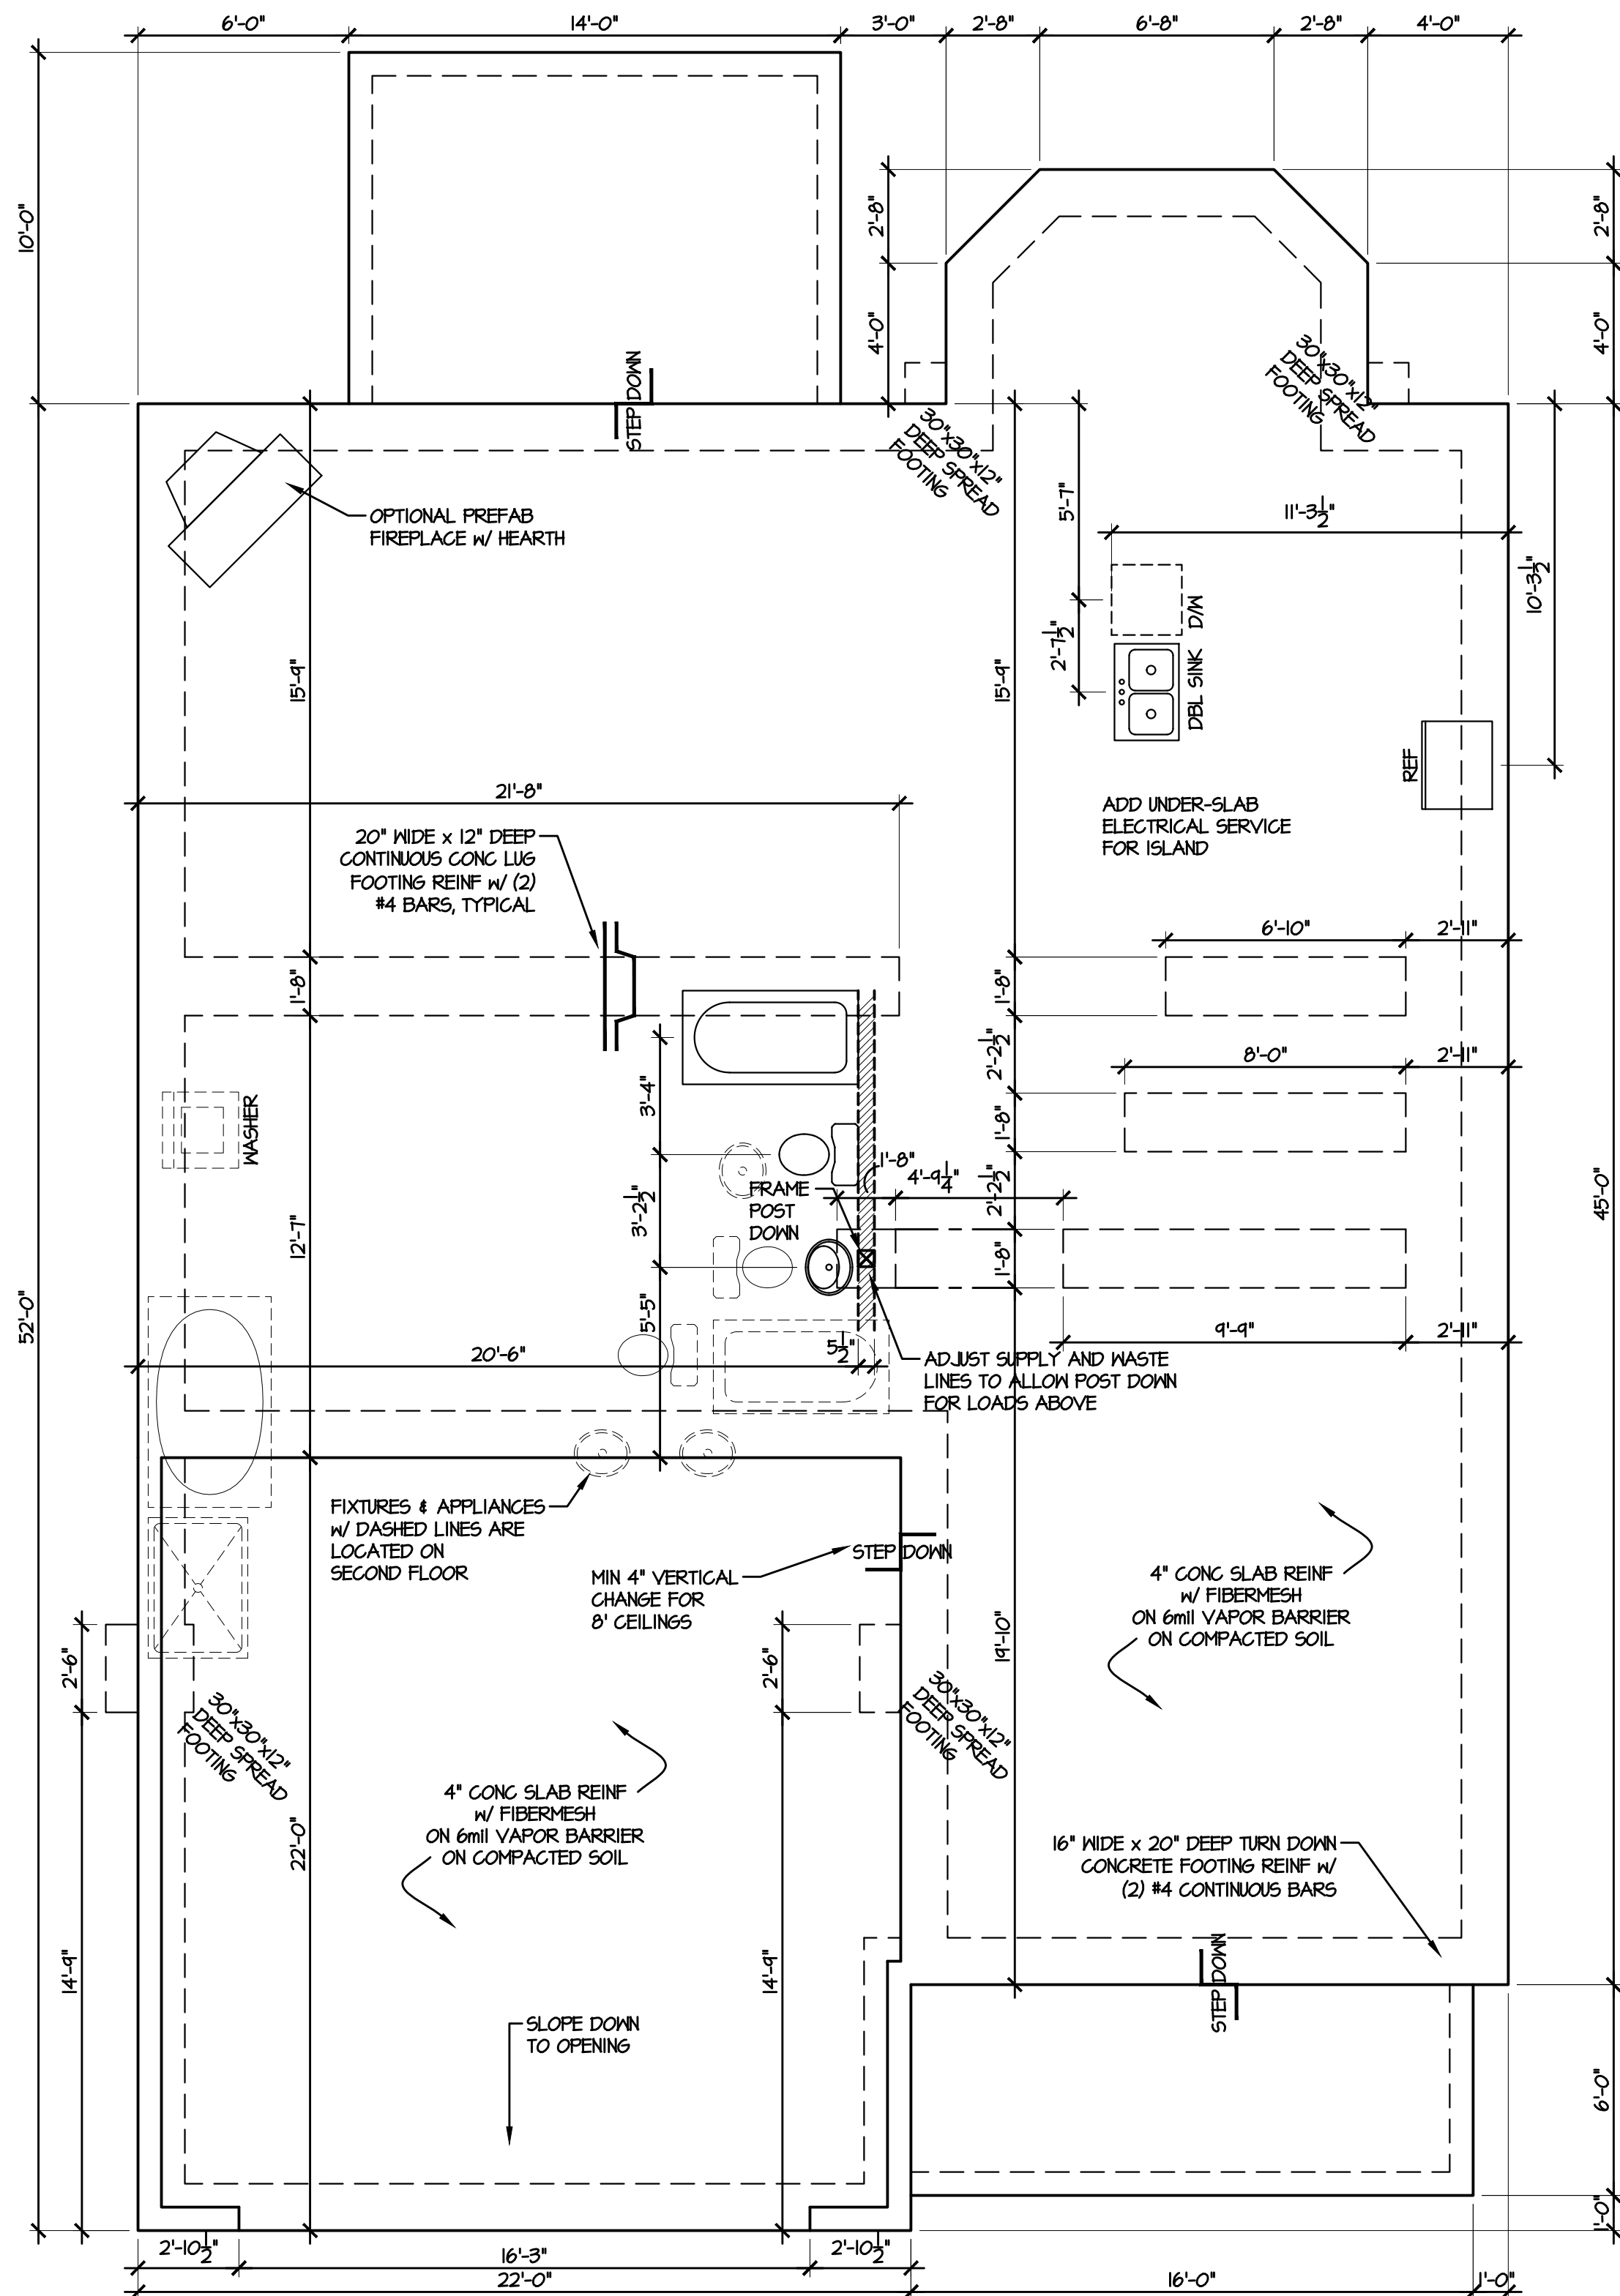

TODD TUCKER  
Professional Member  
American Institute of Building Design  
Institute of Classical Architecture  
141 S GREEN STREET  
PARKTON, NC 28371  
(910) 425-1434



TODD TUCKER 34 - 156

THE INFORMATION IN THESE CONSTRUCTION DOCUMENTS IS FOR THE EXCLUSIVE USE OF THE CLIENT IN CONSTRUCTION OF THE BUILDING DESCRIBED IN THE DOCUMENTS. THE DESIGNER HAS ATTEMPTED TO ESTABLISH AN ACCURATE SET OF CONSTRUCTION DOCUMENTS OF THE BUILDING BASED UPON THE CLIENT'S REQUIREMENTS AND THE LOCAL GOVERNING CODES. IF THE CLIENT OBSERVES OR BECOMES AWARE OF ANY FAULT OR DEFECT IN THE PROJECT OR NON-COMPLIANCE WITH THE CONSTRUCTION DOCUMENTS, PROMPT WRITTEN NOTICE SHALL BE GIVEN BY THE CLIENT TO THE DESIGNER. THE CLIENT SHALL HOLD HARMLESS THE DESIGNER FROM ALL ERRORS AND OMISSIONS PERTAINING TO THE DOCUMENTS RELATED TO THE PROJECT AND OTHER RELATED WORK AS REPRESENTED BY THE DESIGNER TO THE CLIENT.

**Caviness Land** FOUNDATION

SCALE:  
AS NOTED

DATE:  
FEBRUARY 2014

PLAN:  
CL 3187

LOT NO:

SHEET NO:  
**A-3**

**GENERAL NOTES:**


DO NOT CUT OR MODIFY TRUSSES  
 TRUSSES ARE SPACED 24" ON CENTER  
 UNLESS NOTED OTHERWISE.

REFER TO THE INDIVIDUAL TRUSS  
 DESIGN DRAWINGS FOR THE LOCATION  
 OF LATERAL BRACING AND MULTI-PLY  
 CONNECTION REQUIREMENTS.

PER ANSI TPI 1-2002 THE TRUSS  
 ENGINEER IS RESPONSIBLE FOR  
 TRUSS TO TRUSS CONNECTIONS AND  
 TRUSS PLY TO PLY CONNECTIONS.  
 THIS TRUSS PLACEMENT PLAN  
 RECOMMENDS TRUSS TO BEARING  
 CONNECTIONS AND TRUSS TO BEAM  
 CONNECTIONS WHICH SHALL BE  
 REVIEWED BY THE BUILDING  
 DESIGNER. IT IS THE RESPONSIBILITY  
 OF THE BUILDING DESIGNER TO  
 RESOLVE ALL ROOF FORCES  
 ADEQUATELY TO THE FOUNDATION.

**THIS LAYOUT IS INTENDED FOR THE PURPOSE OF TRUSS LOCATION AND PLACEMENT ONLY.  
 REFER TO THE BUILDING PLANS FOR ACTUAL BUILDING CONSTRUCTION.**

ORDER #

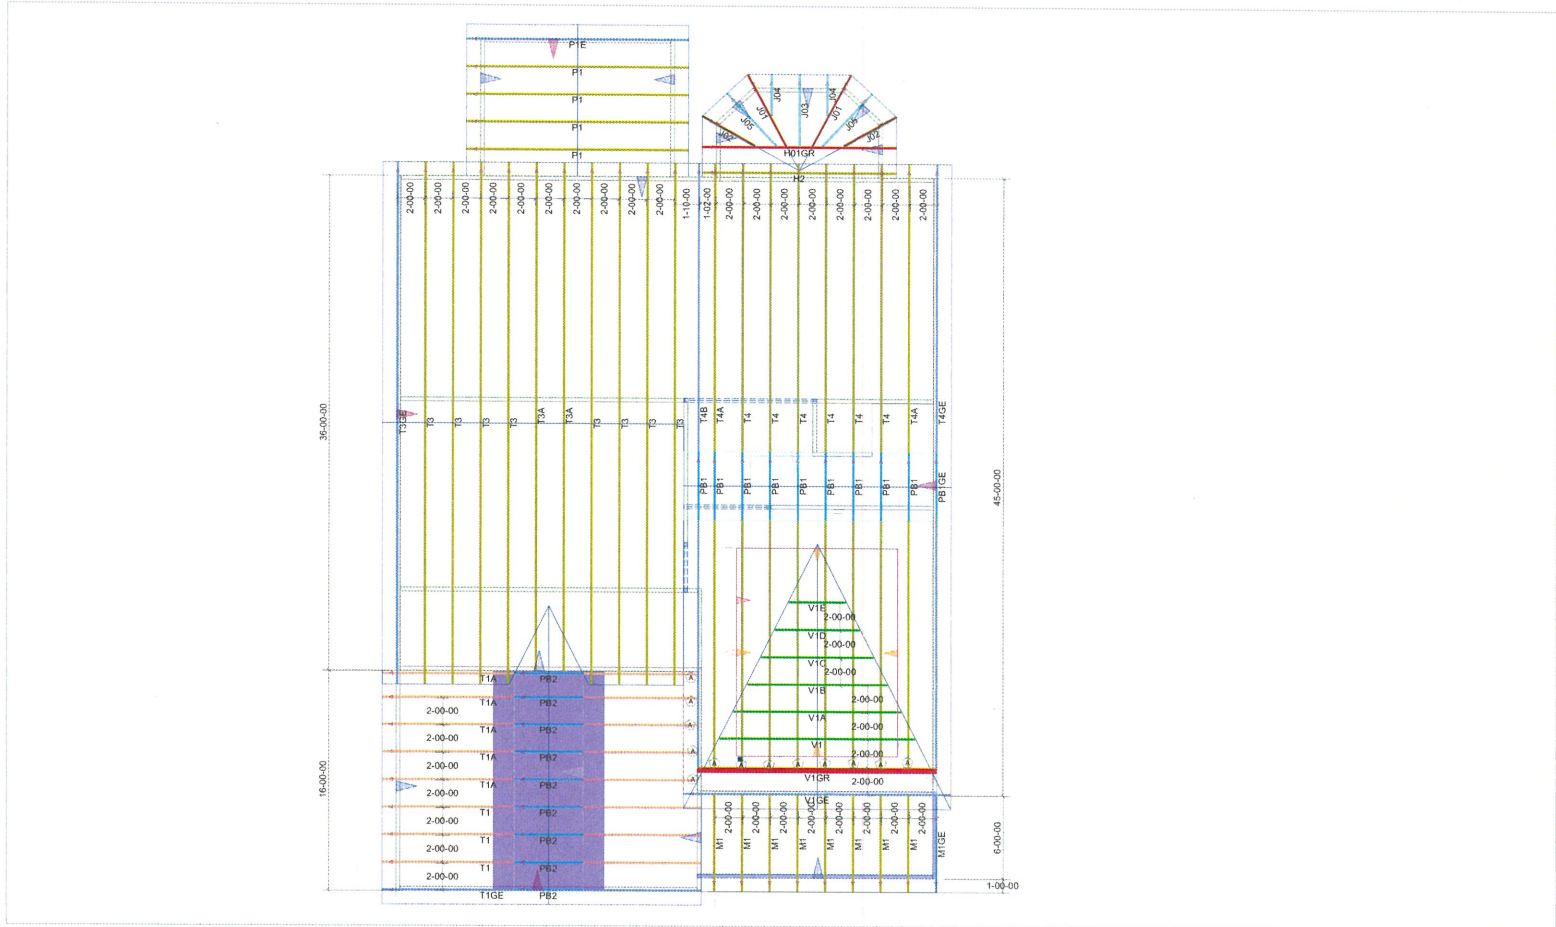

Hardware List:		
A	13	HUS26
B	999	HUS28-2
C	999	#####
D	999	#####
	999	H2.5A
	999	TBE4
	999	SUPER ANCHOR

ROOF LOADING:	
TOP LIVE:	20 PSF
TOP DEAD:	10 PSF
BOTTOM DEAD:	10 PSF
WIND SPEED:	115 MPH



DEDICATED TO QUALITY AND EXCELLENCE  
 200 EMMETT ROAD  
 DUNN, NORTH CAROLINA 28334  
 PHONE: 910-892-8400  
 FAX: 910-892-8384

PROJECT:	CL-3187		
CUSTOMER:	CAVINNESS LAND		
MODEL:	CL- 3187 W CP GOL		
SCALE:	NOT TO SCALE	P.O. NUMBER:	PO #
DRAWN BY:	User design	PRINT DATE:	truss datetime
		REV:	
		SHIP DATE:	Schd Delivery



2160 Satellite Blvd., Suite 450  
Duluth, GA 30097  
888-613-5078



Dealer  
84 Lumber-Fayetteville #2307  
Dealer Address  
620 Belt Road  
Fayetteville, NC 28301  
(910) 867-9185

Project  
CL1817 GL CP  
Created  
January 22, 2015  
Layout Name  
CL1817 GL CP  
Description  
Caviness Land  
CL1817 GL CP  
Designer  
Kyle Mihler  
Revised  
March 26, 2020



2nd Floor  
Design Method  
Building Code  
ASD (USA)  
IRC 2012

**Floor**

Live	40
Dead	10
Deflection Joist	
LL Span 1/	480
TL Span 1/	240
LL Cant 2/	360
TL Cant 2/	360
Deflection Girder	
LL Span 1/	360
TL Span 1/	240
LL Cant 2/	360
TL Cant 2/	360
Decking	
OSB	
23/32 APA Rated Shurd-	
1-Floor	
Nailed & Glued	

**Fastener**


3.5" Non-Dirg Wall
Wall
Partition Wall (Non-Load-Bearing)
Wall Opening
L.P. APA Rated OSB 1.125 X 14
L.P. 20 Plus
L.P.-LSL 1.5SE 3.5 X 9.25
(Dropped)
L.P.-LVL 2900F-2.0E 1.75 X 18
(Dropped)
L.P.-LSL 1.5SE 3.5 X 14
L.P.-LVL 2900F-2.0E 1.75 X 18
(Dropped)

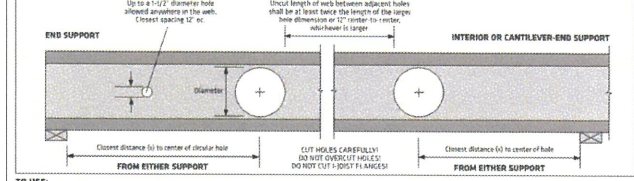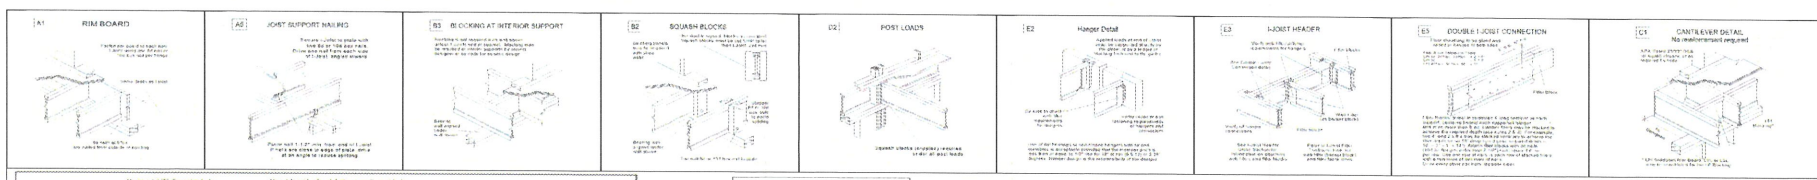


- TO USE:**
- Select the required table and depth.
  - Determine the support condition for the nearest bearing, end support or interior support (including cantilever and supports).
  - Select the row corresponding to the required Clear Span. For spans between those listed, use the next larger value.
  - Select the column corresponding to the required hole diameter. For diameters between those listed, use the next largest value.
  - The intersection of the Clear Span row and Hole Diameter column gives the maximum distance from the inside face of bearing to the center of a circular hole.
  - Double check the distance to the other support, using the appropriate support condition.

Depth	Clear Span (ft)	Distance from End Support					Distance from Interior or Cantilever-End Support					
		2"	4"	6"	8"	10"	2"	4"	6"	8"	10"	12"
14"	14'	1'-0"	1'-0"	1'-0"	1'-0"	2'-2"	-	-	-	-	-	-
	22'	1'-5"	2'-9"	4'-7"	5'-4"	6'-6"	1'-0"	2'-10"	3'-11"	5'-3"	6'-3"	
	26'	3'-0"	5'-0"	6'-5"	8'-0"	9'-8"	5'-8"	7'-0"	8'-5"	9'-7"	8'-9"	
	30'	5'-9"	7'-0"	8'-4"	9'-9"	11'-3"	12'-10"	9'-0"	10'-0"	11'-0"	12'-0"	
16"	18'	1'-0"	1'-0"	1'-4"	2'-5"	3'-2"	4'-11"	1'-0"	3'-6"	4'-6"	5'-6"	6'-6"
	22'	1'-4"	2'-5"	3'-6"	4'-9"	5'-1"	7'-5"	4'-0"	5'-0"	6'-0"	7'-0"	8'-0"
	26'	3'-6"	4'-8"	5'-11"	7'-2"	8'-7"	10'-1"	6'-6"	7'-6"	8'-6"	9'-6"	10'-6"
	30'	5'-9"	7'-0"	8'-4"	9'-9"	11'-3"	12'-10"	9'-0"	10'-0"	11'-0"	12'-0"	13'-2"

- DESIGN ASSUMPTIONS:**
- The hole locations listed above are valid for floor joists supporting only uniform loads. The total uniform load shall not exceed 130 psf (e.g., 40 psf live load and 25 psf dead load spaced 24" oc).
  - Holes located in regions from the inside face of bearing to the center of a circular hole, from the nearest support.
  - Clear Span has not been verified for these joists and is shown for informational purposes only. Verify that the joist selected will work for the span and loading conditions needed before checking hole location.
  - The maximum hole depth for circular holes is the joist depth less 4" except the maximum hole depth is 5" for 3-1/2" L.P. joists, and 8" for 3-7/8" L.P. joists.
  - Holes cannot be located in the span where designated "X" without further analysis by a design professional.
- NOTES:**
- Holes may be placed anywhere within the depth of the joist. A minimum 1/4" clear distance is required between the hole and the flanges.
  - Rounded holes up to 1 1/2" diameter may be placed anywhere in the span.
  - Perforated "telescopes" may be neglected when loading with holes.
  - Holes larger than 1/2" are not permitted in cantilevers without special engineering.
  - Multiple holes shall have a clear separator along the length of the joist of at least hole length of the larger outermost hole, or a minimum of 3" center-to-center, whichever is greater.
  - Multiple holes may be spaced closer provided they fit within the boundary of an acceptable larger hole. Example: use 3" round holes aligned parallel to the joist length may be spaced 2" apart (clear spacing) provided that a 3" high by 8" long rectangle or an 8" diameter round hole are acceptable in compliance with the table.
  - For conditions not covered in this table, use L.P.'s design software or contact your local L.P.'s Sales/Service/Engineered Wood Products distributor for more information.

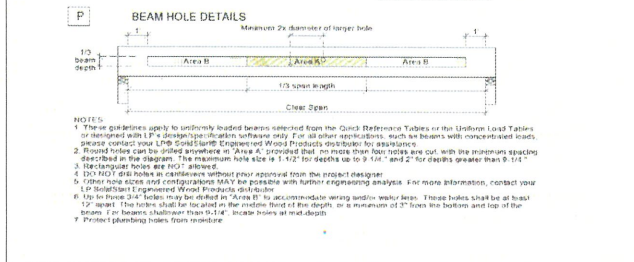

- Important Notes:**
- These guidelines apply to uniformly loaded beams selected from the Quick Reference Tables or the Uniform Load Tables or designed with L.P.'s design-type software only. For all other applications, such as beams with concentrated loads, please contact your L.P. Sales/Service/Engineered Wood Products distributor for assistance.
  - Rounded holes can be drilled anywhere in "Area A," provided that no more than four holes are cut with the maximum spacing described in the diagram. The maximum hole size is 1 1/2" for depths up to 8", and 2" for depths greater than 8".
  - The required hole size is 1/2" smaller.
  - Drill holes in cantilevers without your approval from the product designer.
  - Other hole sizes and configurations may be possible with further engineering analysis. For more information, contact your L.P. Sales/Service/Engineered Wood Products distributor.
  - For a round 2" hole, use a 2 1/8" drill bit. For an accommodation opening under a hole, use an 8" diameter hole saw or a 1 1/2" spade bit. This hole shall be located in the middle third of the depth, or a minimum of 3" from the bottom and top of the beam. For a beam's thickness from 1 1/2" to 2", square holes in mid-depth.
  - Protect planing holes from moisture.
- Handling & Storage:**
- Unload products carefully to the job site.
  - Use proper handling techniques to avoid damage to the product.
  - Use proper storage techniques to avoid damage to the product.
  - Use proper handling techniques to avoid damage to the product.
  - Use proper handling techniques to avoid damage to the product.

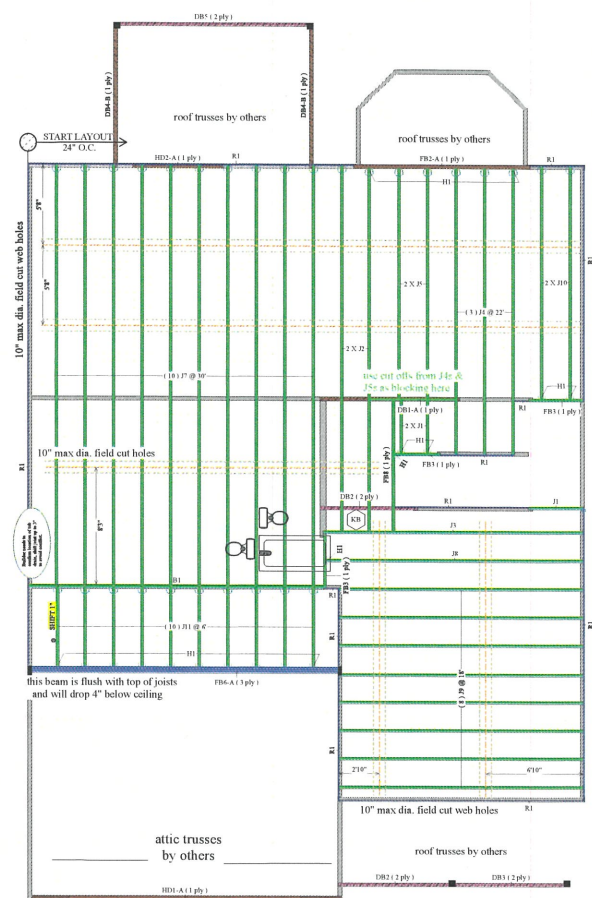

**2ND FLOOR FRAMING**  
SCALE: 1/4" = 1'