

2 RIGHT ELEVATION
1/4" = 1'-0"

SPACE DATA	
FIRST FLOOR, HEATED:	1502 SF
SECOND FLOOR, HEATED:	1685 SF
FRONT PORCH:	80 SF
GARAGE:	480 SF

ATTIC VENT CALC'S.	
ATTIC AREA:	1482 SF.
GABLE VENTS:	N/A
RIDGE VENTS:	84 L.F. / 10.5 S.F. (67%)
SOFFIT VENT:	87 L.F. / 50 S.F. (33%)
RATIO:	$\frac{15}{1482} = \frac{1}{132}$


Carolina
*Residential
Design*

TODD TUCKER
Professional Member
American Institute of Building Design
Institute of Classical Architecture
111 S GREEN STREET
PARKTON, NC 28371
(910) 425-7000

NATIONAL COUNCIL OF
BUILDING DESIGNERS

TODD TUCKER 34-156


THE INFORMATION IN THESE CONSTRUCTION DOCUMENTS IS FOR THE EXCLUSIVE USE OF THE CLIENT IN CONNECTION WITH THE PROJECT DESCRIBED IN THESE DOCUMENTS. THE CLIENT HAS AGREED TO HOLD THE ARCHITECT HARMLESS FROM AND AGAINST ALL CLAIMS, DAMAGES, LOSSES AND EXPENSES, INCLUDING REASONABLE ATTORNEY'S FEES, ARISING FROM OR RESULTING FROM THE USE OF THESE DOCUMENTS IN ANY MANNER, INCLUDING ANY REUSE, REPRODUCTION, MODIFICATION, ALTERATION, ADAPTATION, OR TRANSMISSION OF ANY KIND, IN ANY MEDIUM, WITHOUT THE WRITTEN CONSENT OF THE ARCHITECT. THE CLIENT SHALL BE RESPONSIBLE FOR OBTAINING ALL NECESSARY PERMITS AND APPROVALS FROM ALL APPLICABLE AGENCIES AND AUTHORITIES. THE ARCHITECT SHALL NOT BE RESPONSIBLE FOR ANY SUCH PERMITS AND APPROVALS. THE CLIENT SHALL BE RESPONSIBLE FOR OBTAINING ALL NECESSARY PERMITS AND APPROVALS FROM ALL APPLICABLE AGENCIES AND AUTHORITIES. THE ARCHITECT SHALL NOT BE RESPONSIBLE FOR ANY SUCH PERMITS AND APPROVALS. THE CLIENT SHALL BE RESPONSIBLE FOR OBTAINING ALL NECESSARY PERMITS AND APPROVALS FROM ALL APPLICABLE AGENCIES AND AUTHORITIES. THE ARCHITECT SHALL NOT BE RESPONSIBLE FOR ANY SUCH PERMITS AND APPROVALS.

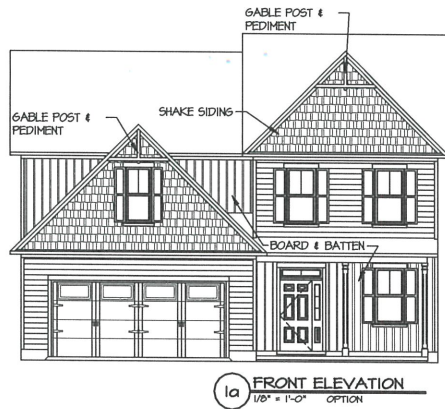

1a FRONT ELEVATION
1/8" = 1'-0" OPTION

CHECK APPROPRIATE BOX (FIRST FLOOR)

- 8' CEILINGS
- 9' CEILINGS
ON 9' CEILINGS UPGRADE ALL FIRST FLOOR
WINDOWS SHOWN AS 2/8x5/2 TO
2/8x6/0 WINDOWS (0 SINGLES / 1 TRIPLE)

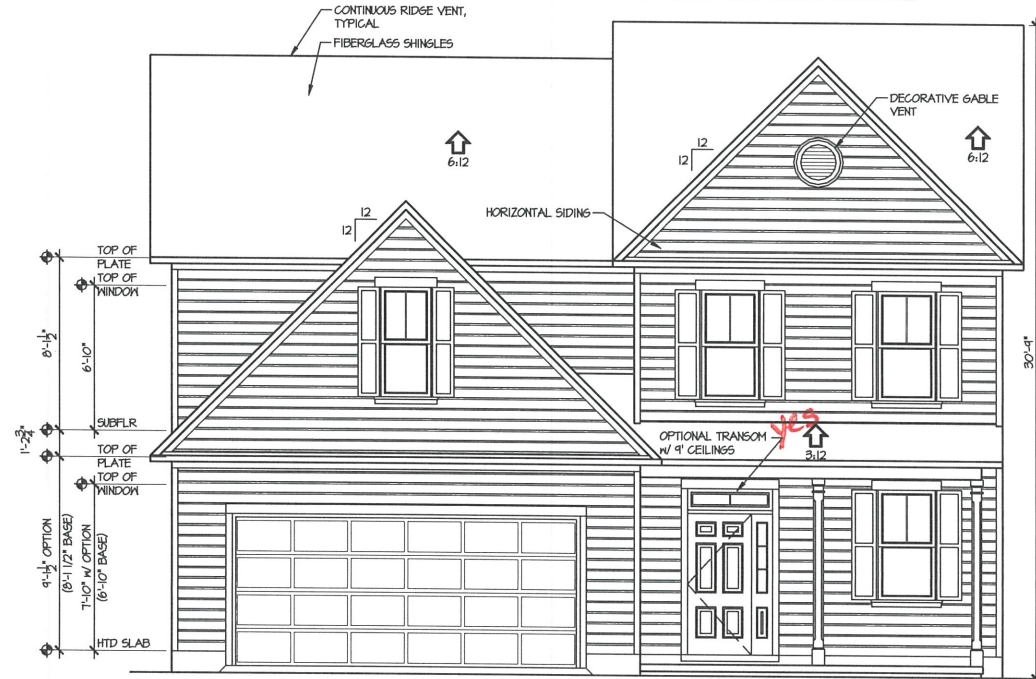

1 FRONT ELEVATION
1/4" = 1'-0"

Caviness
Land

ELEVATIONS


SCALE:
AS NOTED

DATE:
FEBRUARY 2014

PLAN:
CL 3101

LOT NO.:

SHEET NO.
A-1

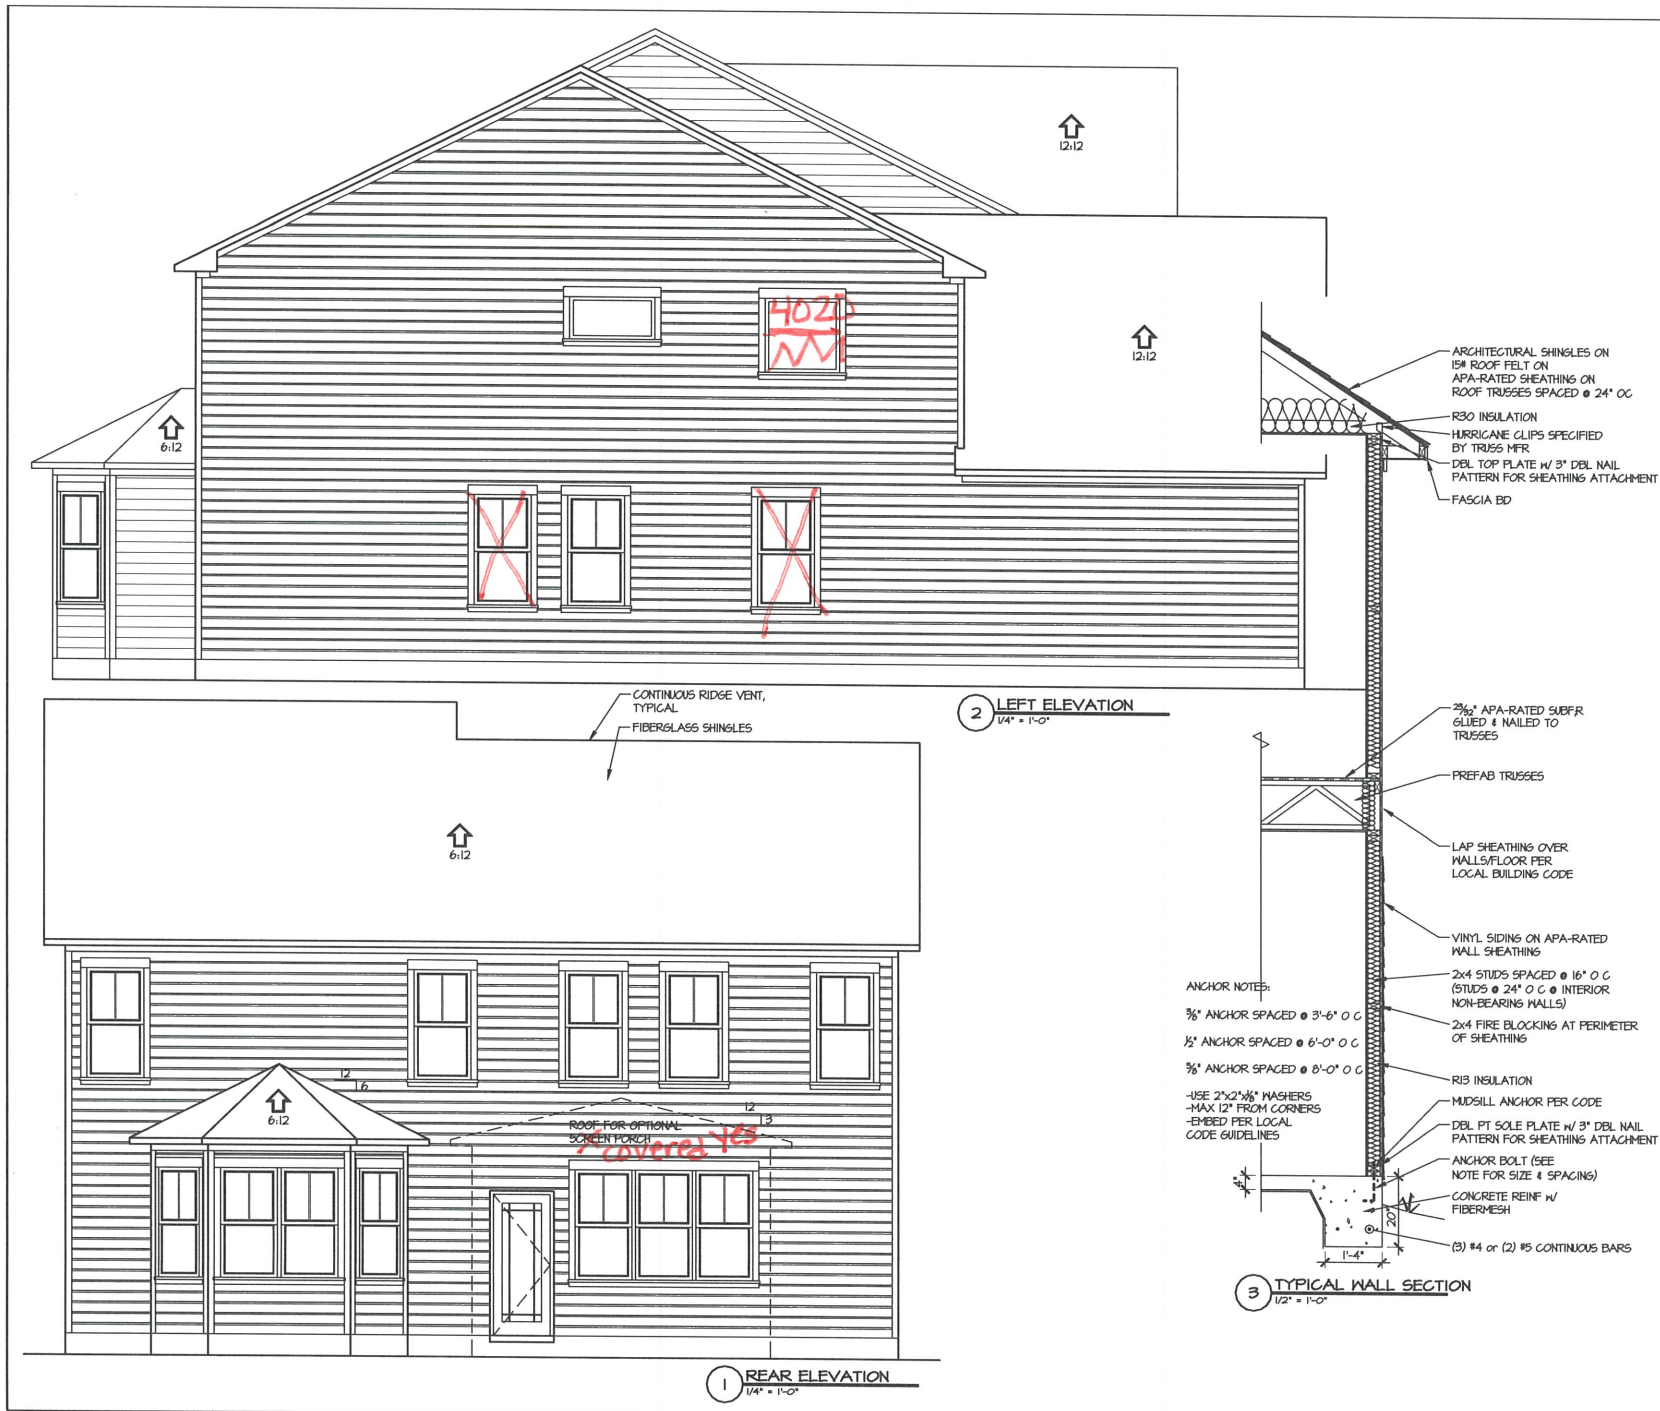

Carolina Residential Design

TODD TUCKER
Professional Member
American Institute of Building Design
Institute of Classical Architecture
111 S GREEN STREET
PARKTON, NC 28371
(910) 425-7884

TODD TUCKER 34 - 156

THE INFORMATION IN THESE CONSTRUCTION DOCUMENTS IS FOR THE EXCLUSIVE USE OF THE CLIENT IN CONNECTION WITH THE PROJECT DESCRIBED IN THE DOCUMENTS. THE DOCUMENTS AND ANY INFORMATION CONTAINED HEREIN ARE NOT TO BE REPRODUCED, COPIED, REPRODUCED, TRANSMITTED, OR IN ANY MANNER DISCLOSED TO ANY OTHER PARTY WITHOUT THE WRITTEN CONSENT OF CAROLINA RESIDENTIAL DESIGN. THE CLIENT AGREES TO HOLD CAROLINA RESIDENTIAL DESIGN HARMLESS FROM ALL LIABILITY AND DAMAGES, INCLUDING REASONABLE ATTORNEY'S FEES, ARISING FROM THE USE OF THESE DOCUMENTS. THE CLIENT SHALL HOLD CAROLINA RESIDENTIAL DESIGN HARMLESS FROM ALL LIABILITY AND DAMAGES, INCLUDING REASONABLE ATTORNEY'S FEES, ARISING FROM THE USE OF THESE DOCUMENTS. THE CLIENT SHALL HOLD CAROLINA RESIDENTIAL DESIGN HARMLESS FROM ALL LIABILITY AND DAMAGES, INCLUDING REASONABLE ATTORNEY'S FEES, ARISING FROM THE USE OF THESE DOCUMENTS.

Caviness Land

ELEVATIONS

SCALE: AS NOTED

DATE: FEBRUARY 2014

PLAN: CL 3187



LOT NO:

SHEET NO: A-2

Plumbing drops

CHECK BOX FOR:
 SCREEN PORCH

make full
 cidset do not need d/c

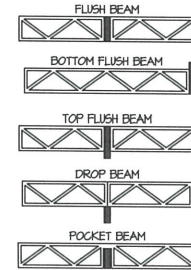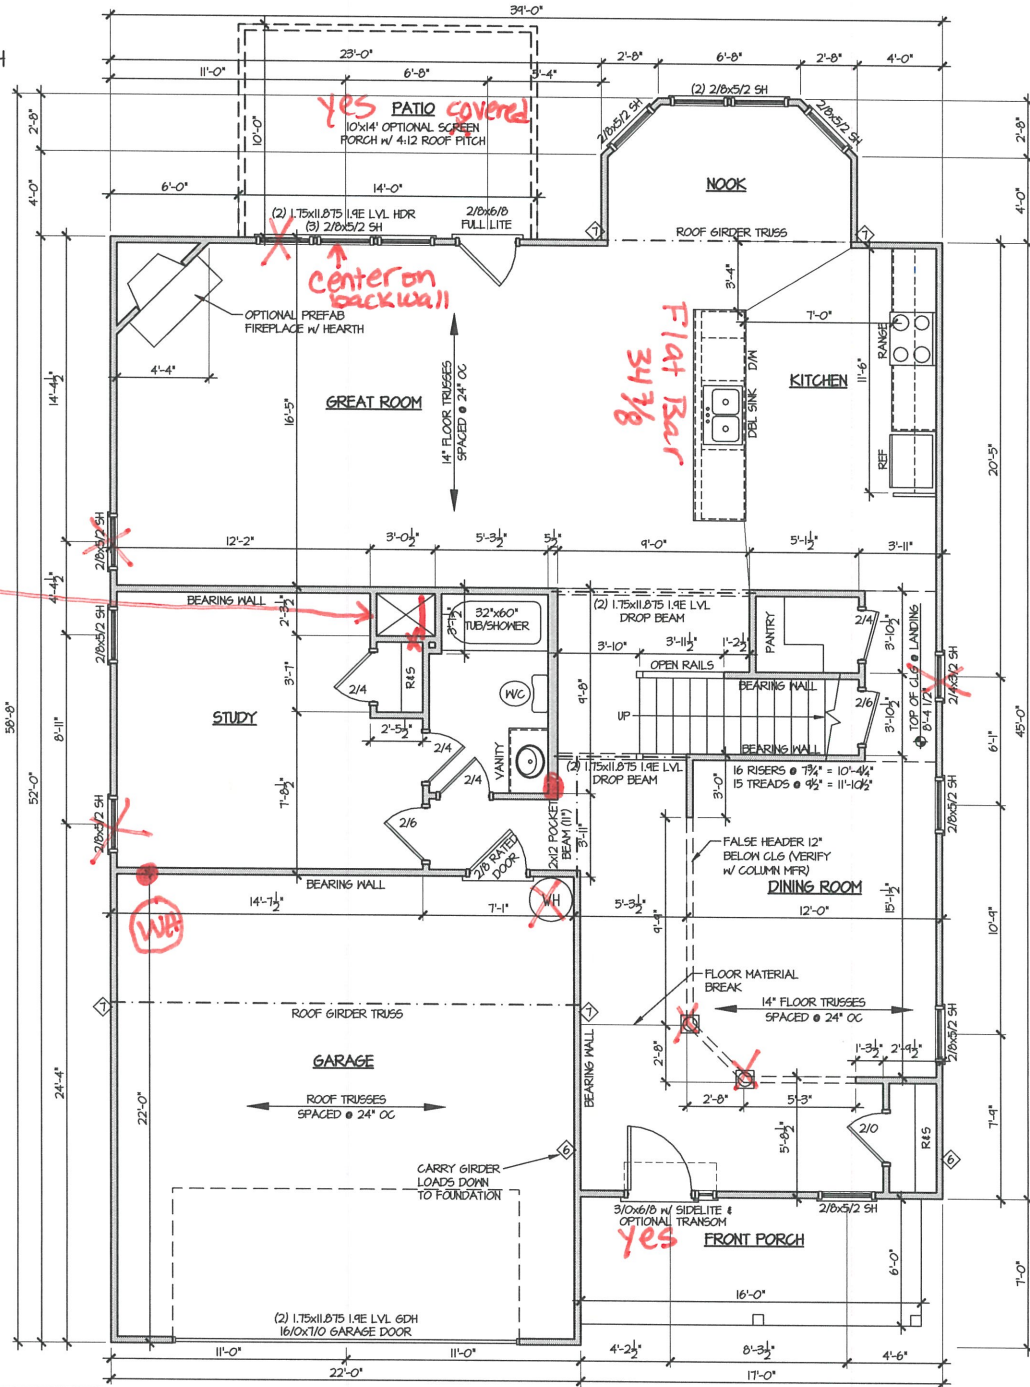

GENERAL NOTE:
 ALL 2x4 WALLS DRAWN AS 3 1/2"
 ALL 2x6 WALLS DRAWN AS 5 1/2"
 ALL EXTERIOR DIMENSIONS INCLUDE WALL SHEATHING
 ALL WALLS ARE 2x4 WALLS UNLESS OTHERWISE NOTED
IN LOAD-BEARING WALLS:
 ALL OPENINGS, WINDOW & DOOR HEADERS TO BE (2) 2x10 SYP #2 & (2) STUDS ON EACH SIDE UNLESS NOTED OTHERWISE
 ◊ SYMBOL FOR REQUIRED STUDS FOR BEAM ABOVE
 ARROW INDICATES SPAN DIRECTION FOR TRUSSES TRUSS MFR TO CALCULATE ALL UPLIFT LOADS AND SPECIFY ADEQUATE HANGERS & TIE DOWNS

Carolina Residential Design

TODD TUCKER
 Professional Member
 American Institute of Building Design
 Institute of Classical Architecture
 11 5 GREEN STREET
 PARKTON, NC 28571
 (910) 452-7831

NATIONAL COUNCIL OF BUILDING DESIGNERS

TODD TUCKER 34-156

THE INFORMATION IN THESE CONSTRUCTION DOCUMENTS IS FOR THE EXCLUSIVE USE OF THE CLIENT IN CONNECTION WITH THE BUILDING PROJECTS AND IS NOT TO BE REPRODUCED OR TRANSMITTED IN ANY FORM OR BY ANY MEANS, ELECTRONIC OR MECHANICAL, INCLUDING PHOTOCOPYING, RECORDING, OR BY ANY INFORMATION STORAGE AND RETRIEVAL SYSTEM, WITHOUT THE WRITTEN PERMISSION OF THE ARCHITECT. THE CLIENT SHALL BE RESPONSIBLE FOR OBTAINING ALL NECESSARY PERMITS AND APPROVALS FROM ALL APPLICABLE AGENCIES AND AUTHORITIES. THE ARCHITECT SHALL NOT BE RESPONSIBLE FOR THE PROJECT AND OTHER RELATED WORK AS REPRESENTED BY THE DRAWINGS TO THE CLIENT.

Caviness Land

FIRST FLOOR PLAN


SCALE: AS NOTED

DATE: FEBRUARY 2014

PLAN: CL 3187

LOT NO:

SHEET NO: A-4

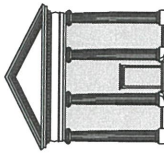

THE ARCHITECT'S & ENGINEER'S PROFESSIONAL LIABILITY INSURANCE POLICY DOES NOT COVER THE ARCHITECT OR ENGINEER FOR NEGLIGENCE OR FOR THE FAILURE OF THE ARCHITECT OR ENGINEER TO COMPLY WITH THE PROFESSIONAL STANDARDS OF CARE OR TO COMPLY WITH THE PROFESSIONAL STANDARDS OF PRACTICE. THE ARCHITECT OR ENGINEER IS NOT INSURED AGAINST THE RISK OF PROFESSIONAL LIABILITY. THE ARCHITECT OR ENGINEER IS NOT INSURED AGAINST THE RISK OF PROFESSIONAL LIABILITY. THE ARCHITECT OR ENGINEER IS NOT INSURED AGAINST THE RISK OF PROFESSIONAL LIABILITY.

Caviness Land
SECOND FLOOR PLAN

SCALE:	A5 NOTED
DATE:	FEBRUARY 2014
PLAN:	CL 3187
LOT NO.:	
SHEET NO.:	A.5

