# WINSTON -A, B, C

PLAN ID: 2548 - RIGHT HAND - NORTH CAROLINA

DATE: REVISION:

06/06/2017 INITIAL RELEASE OF PLANS

07/21/2017 CLIENT REVISIONS 10/20/2017 CLIENT REVISIONS

11/01/2017 REMOVED DROPPED HEADER AT DINING

ADDED TRAY CEILING TO OWNER'S ELECTRICAL REVISIONS

02/07/2018 ELECTRICAL REVISI 09/05/2018 CLIENT REVISIONS

11/14/2018 CLIENT REVISIONS

01/09/2019 REVISED CODE REFERENCES

12/13/2019 CLIENT REVISIONS 02/28/2020 CLIENT REVISIONS

08/28/2020 CLIENT REVISIONS 10/15/2020 Laundry door change to 5' **SHEET INDEX:** 

CS ARCHITECTURALS - COVERSHI

0 ARCHITECTURALS - QUICK VIEW

1A ARCHITECTURALS - ELEVATIONS A

1B ARCHITECTURALS - ELEVATIONS B
1C ARCHITECTURALS - ELEVATIONS C

3A ARCHITECTURALS - FLOOR PLANS A

3B ARCHITECTURALS - FLOOR PLANS B
3C ARCHITECTURALS - FLOOR PLANS C

3.1 ARCHITECTURALS - FLOOR OPTIONS

4 ELECTRICAL - FLOOR PLANS

4.1 ELECTRICAL - FLOOR OPTIONS

REVIEWERS STAMP LOCATION

 MODEL 'WINSTON' SQUARE FOOTAGES

 AREA
 ELEV 'C'

 Ist FLOOR
 1303 SF

 2nd FLOOR
 1262 SF

 TOTAL LIVING
 2565 SF

 GARAGE
 402 SF

 PORCH
 83 SF

MORGAN NORTH LOT 65 129 YOUNG FARM DRIVE LILLINGTON, NC 27546 PIN 0651-03-1414.000



Express In-R-HORTO

WINSTON


COVERSHEE


PLAN REV DATE

COPPERINT PROPERTY OF DR. HORTON NOT TO BE REPRODUCE.

SHEET NUMBER.

CS

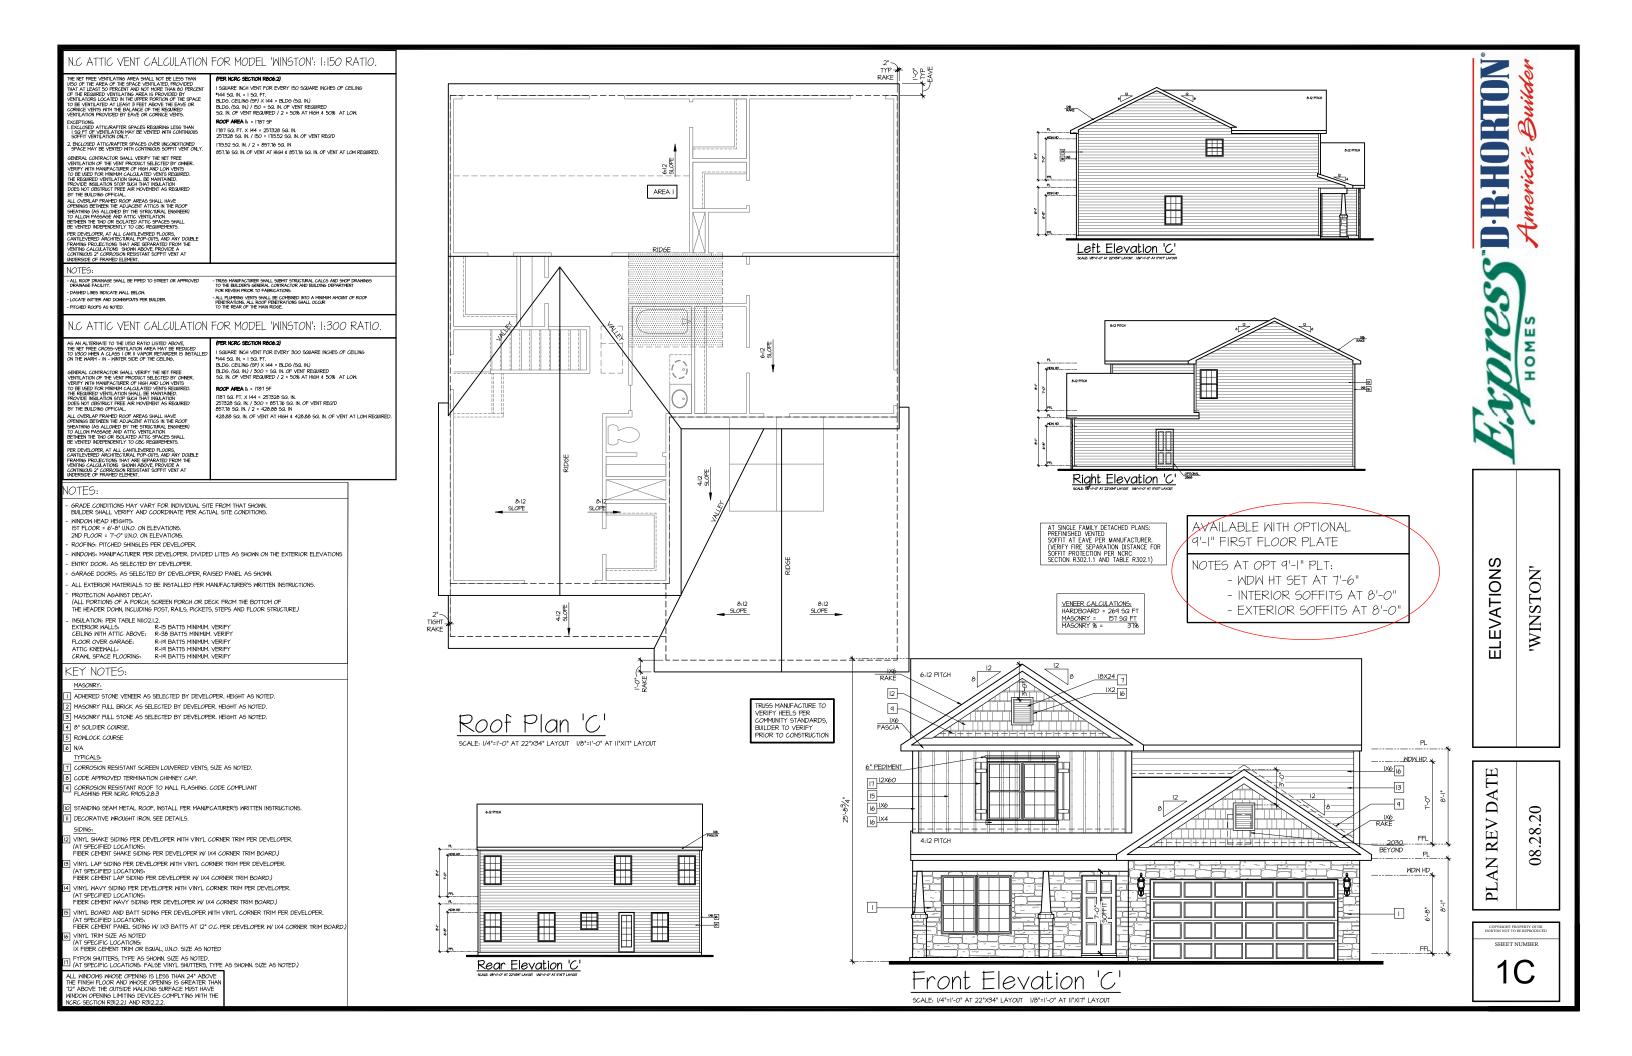

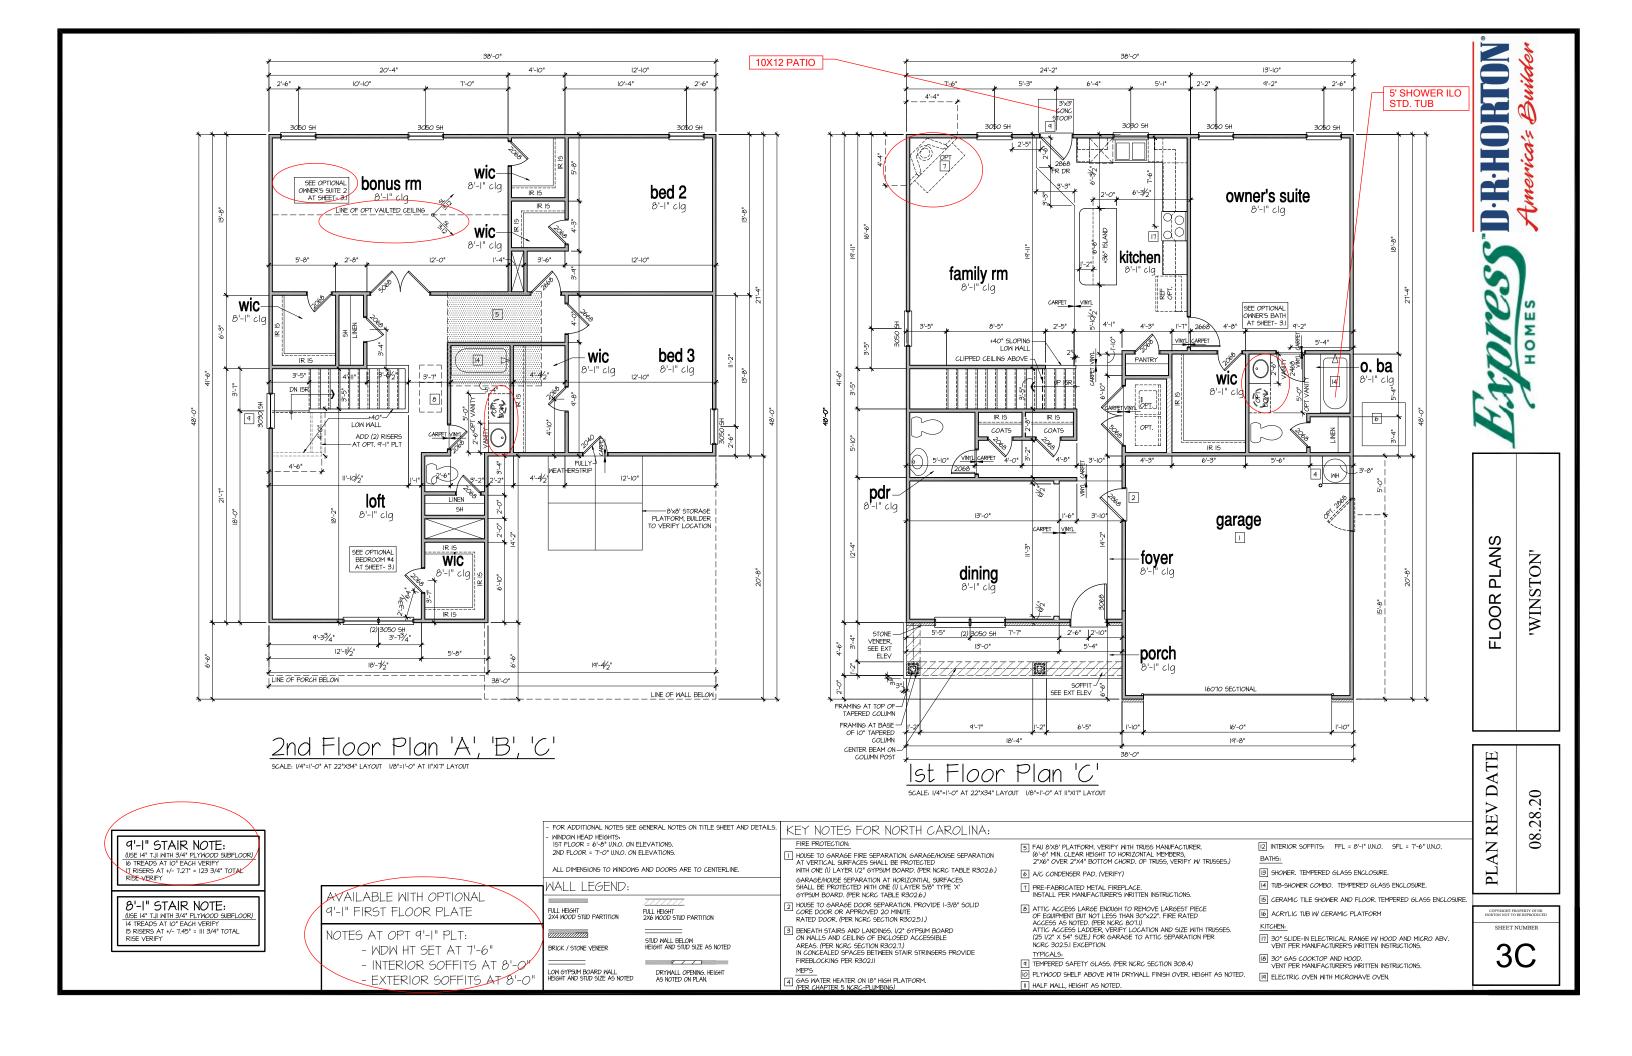

FLOOR PLANS

20 28.

3.1

9'-I" STAIR NOTE: (USE 14" T.JI WITH 3/4" PLYWOOD SUBFLOOD 16 TREADS AT IO" EACH VERIFY IT RISERS AT +/- T.2T" = 123 3/4" TOTAL RISE VERIFY 8'-I" STAIR NOTE: (USE 14" T.JI MITH 3/4" PLYMOOD SUBFLOOR) 14 TREADS AT IO" EACH VERIFY 15 RISERS AT +/- 7.45" = 111 3/4" TOTAL RISE VERIFY

10'-10" -o. ba 2 owner's suite 2 8'-1" clg INE OF OPT VAULTED CEILING

Optional Owner's Suite -2

AVAILABLE WITH OPTIONAL 9'-1" FIRST FLOOR PLATE

NOTES AT OPT 9'-1" PLT:

- WDW HT SET AT 7'-6"
- INTERIOR SOFFITS AT 8'-0"
- EXTERIOR SOFFITS AT 8'0'

FOR ADDITIONAL NOTES SEE GENERAL HOTES ON TITLE SHEET AND DETAILS. KEY NOTES FOR NORTH CAROLINA:

WINDOW HEAD HEIGHTS: IST FLOOR = 6'-8" U.N.O. ON ELEVATIONS. 2ND FLOOR = 7'-0" U.N.O. ON ELEVATIONS.

ALL DIMENSIONS TO WINDOWS AND DOORS ARE TO CENTERLINE.

## WALL LEGEND:

LOW GYPSUM BOARD WALL HEIGHT AND STUD SIZE AS NOTED

FULL HEIGHT 2X4 WOOD STUD PARTITION

FULL HEIGHT 2X6 WOOD STUD PARTITION

BRICK / STONE VENEER

STUD WALL BELOW HEIGHT AND STUD SIZE AS NOTED

DRYWALL OPENING. HEIGHT AS NOTED ON PLAN. FIRE PROTECTION:

I) HOUSE TO GARAGE FIRE SEPARATION, GARAGE/HOUSE SEPARATION AT VERTICAL SURFACES SHALL BE PROTECTED WITH ONE (I) LAYER I/2" GYPSUM BOARD, (PER NCRC TABLE R302.6.) GARAGE/HOUSE SEPARATION AT HORIZONTIAL SURFACES SHALL BE PROTECTED WITH ONE (I) LAYER 5/8" TYPE 'X' GYPSUM BOARD. (PER NCRC TABLE R302.6.)

- HOUSE TO GARAGE DOOR SEPARATION, PROVIDE I-3/8" SOLID CORE DOOR OR APPROVED 20 MINUTE RATED DOOR. (PER NCRC SECTION R302.5.I.)
- BENEATH STAIRS AND LANDINGS. I/2" GYPSUM BOARD ON WALLS AND CEILING OF ENCLOSED ACCESSIBLE AREAS. (PER NCRC SECTION R302.7.) IN CONCEALED SPACES BETWEEN STAIR STRINGERS PROVIDE FIREBLOCKING PER R302.II MEP'S
- GAS WATER HEATER ON 18" HIGH PLATFORM.

6 A/C CONDENSER PAD. (VERIFY)


- ATTIC ACCESS LARGE ENOUGH TO REMOVE LARGEST PIECE OF EQUIPMENT BUT NOT LESS THAN 30"x22". FIRE RATED ACCESS AS NOTED, (FER NCR. 80"1.)
   ATTIC ACCESS LADDER, VERIFY LOCATION AND SIZE WITH TRUSSES. (25 1/2" X 54" SIZE) FOR GARAGE TO ATTIC SEPARATION PER NCRC 302.5.] EXCEPTION.
- TYPICALS:

  [4] TEMPERED SAFETY GLASS. (PER NCRC SECTION 308.4)

- [5] FAU 8'X8' PLATFORM, VERIFY WITH TRUSS MANUFACTURER.
  (6'-6' MIN. CLEAR HEIGHT TO HORIZONTAL MEMBERS,
  2"X6" OVER 2"X4" BOTTOM CHORD. OF TRUSS, VERIFY W/TRUSSES.)
- PRE-FABRICATED METAL FIREPLACE.
  INSTALL PER MANUFACTURER'S WRITTEN INSTRUCTIONS.
- PLYWOOD SHELF ABOVE WITH DRYWALL FINISH OVER, HEIGHT AS NOTED.
- III HALF WALL, HEIGHT AS NOTED.


- [2] INTERIOR SOFFITS: FFL = 8'-1" U.N.O. SFL = 7'-6" U.N.O. BATHS:
- 3 SHOWER, TEMPERED GLASS ENCLOSURE.
- 14 TUB-SHOWER COMBO. TEMPERED GLASS ENCLOSURE.
- [5] CERAMIC TILE SHOWER AND FLOOR, TEMPERED GLASS ENCLOSURE.
- 6 ACRYLIC TUB W CERAMIC PLATFORM KITCHEN:
- | 30" SLIDE-IN ELECTRICAL RANGE W HOOD AND MICRO ABV. VENT PER MANUFACTURER'S WRITTEN INSTRUCTIONS.
- 30" GAS COOKTOP AND HOOD.
   VENT PER MANUFACTURER'S WRITTEN INSTRUCTIONS. 19 ELECTRIC OVEN WITH MICROWAVE OVEN.

REV DATE AN PL,

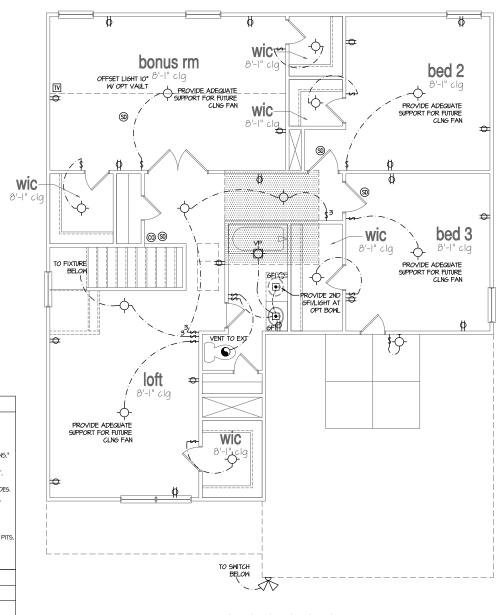

SCALE: I/4"=I'-0" AT 22"X34" LAYOUT I/8"=I'-0" AT II"XI7" LAYOU

2nd Floor Plan 'A', 'B', 'C'

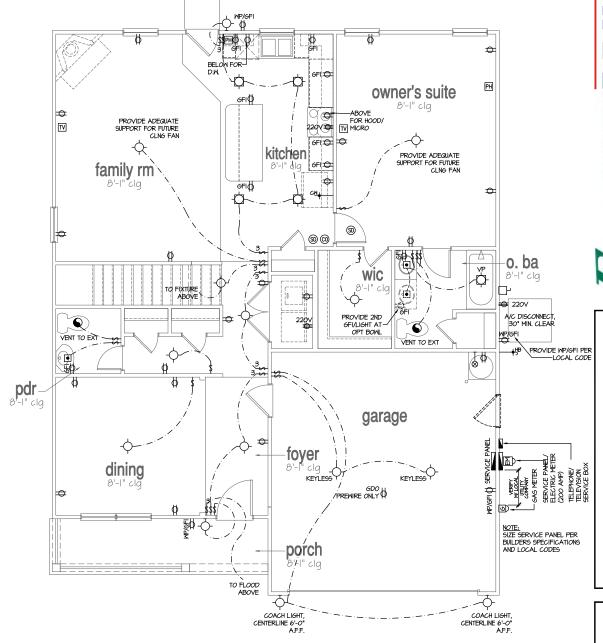

Ist Floor Plan 'A

PLAN REV DATE

FLOOR PLANS

'WINSTON'

.20

28.

SHEET NUMBER

America's

Ш ωO

PROVIDE POWER, LIGHT AND SWITCH AS REQUIRED FOR ATTIC FURNACE PER CODE AND MANUFACTURER'S INSTITTEN INSTRUCTIONS. .EGEND: DUPLEX OUTLET - CEILING MOUNTED INCANDESCENT LIGHT FIXTURE WP/GFI WEATHERPROOF GFI DUPLEX OUTLET HO- WALL MOUNTED INCANDESCENT GFI GROUND-FAULT CIRCUIT-INTERRUPTER
DUPLEX OUTLET RECESSED INCANDESCENT LIGHT FIXTURE (VP) = VAPOR PROOF HALF-SWITCHED DUPLEX OUTLET GEILING MOUNTED LED
LIGHT FIXTURE (VP) = VAPOR PROOF 220V 220 VOLT OUTLET EXHAUST FAN (VENT TO EXTERIOR) EXHAUST FANLIGHT COMBINATION (VENT TO EXTERIOR) WALL SWITCH THREE-WAY SWITCH FLUORESCENT LIGHT FIXTURE FOUR-WAY SMITCH TECH HUB SYSTEM (HIMES PUSHBUTTON SWITCH CEILING FAN (PROVIDE ADEQUATE SUPPORT) IIOV SMOKE ALARM W BATTERY BACKUP CEILING FAN WITH INCANDESCENT LIGHT FIXTURE (PROVIDE ADEGUATE SUPPORT) IIOV SMOKE ALARM CO2 DETECTOR COMBO THERMOSTAT TELEPHONE TELEVISION → HB HOSE BIBB ELECTRIC METER CM 1/4" WATER STUB OUT ELECTRIC PANEL WALL SCONCE

NOTES:

PROVIDE GROUNDING ELECTRICAL ROD PER LOCAL CODES.

PROVIDE AND INSTALL ARC FAILT CIRCUIT-INTERRUPTERS (AFCI) AS REQUIRED BY NATIONAL ELECTRICAL CODE (NEC) AND MEETING THE REQUIREMENTS OF ALL GOVERNING CODES.

ALL EXHAUST FANS SHALL HAVE BACKDRAFT DAMPERS.

FAN/LIGHTS IN WET/DAMP LOCATIONS SHALL BE LABLED "SUITABLE FOR WET OR DAMP LOCATIONS." ELECTRICAL SYSTEMS ARE SHOWN FOR INTENT ONLY. THESE SYSTEMS SHALL BE ENGINEERED BY OTHERS. THE CONTRACTOR SHALL BE RESPONSIBLE FOR PROPER INSTALLATION AND PLACEMENT.

PROVIDE AND INSTALL GROUND FAULT CIRCUIT-INTERRUPTERS (GFI) AS REQUIRED BY NATIONAL ELECTRICAL CODE (NEC.) AND MEETING THE REQUIREMENTS OF ALL GOVERNING CODES.

ELECTRICAL CONTRACTOR TO PROVIDE REQUIRED DIRECT HOOK-UPS/CUTOFFS.

HVAC CONTRACTOR TO VERIFY THERMOSTAT LOCATIONS.

ALL ELECTRICAL AND MECHANICAL EQUIPMENT (FURNACES, A/C UNITS, ELECTRICAL PANELS, SANITARY SUMP PITS, DRAIN TILE SUMP, AND WATER HEATERS) ARE SUBJECT TO RELOCATION DUE TO FIELD CONDITIONS.

NOTES:

PROVIDE GROUNDING ELECTRICAL ROD PER LOCAL CODES.
 PROVIDE AND INSTALL ARC FAULT CIRCUIT-INTERRUPTERS (AFCI) AS REQUIRED BY NATIONAL ELECTRICAL CODE (NEC) AND MEETING THE REQUIREMENTS OF ALL GOVERNING CODES.
 ALL EXHAUST FANS SHALL HAVE BACKDRAFT DAMPERS.

- FAN/LIGHTS IN WET/DAMP LOCATIONS SHALL BE LABLED "SUITABLE FOR WET OR DAMP LOCATIONS."

ELECTRICAL SYSTEMS ARE SHOWN FOR INTENT ONLY. THESE SYSTEMS SHALL BE ENGINEERED BY OTHERS. THE CONTRACTOR SHALL BE RESPONSIBLE FOR PROPER INSTALLATION AND PLACEMENT.

- PROVIDE AND INSTALL LOCALLY CERTIFIED SHOKE DETECTORS AND CO2 DETECTORS AS REQUIRED BY NATIONAL FIRE PROTECTION ASSOCIATION (NFPA) AND MEETING THE REQUIREMENTS OF ALL GOVERNING CODES.

PROVIDE AND INSTALL GROUND FAULT CIRCUIT-INTERRIPTERS (GFI) AS REQUIRED BY NATIONAL ELECTRICAL CODE (NEC) AND MEETING THE REQUIREMENTS OF ALL GOVERNING CODES.

- ELECTRICAL CONTRACTOR TO PROVIDE REQUIRED DIRECT HOOK-UPS/CUTOFFS.

- HVAC CONTRACTOR TO VERIFY THERMOSTAT LOCATIONS.

- ALL ELECTRICAL AND MECHANICAL EQUIPMENT (FURNACES, A/C UNITS, ELECTRICAL PANELS, SANITARY SUMP PITS, DRAIN TILE SUMP, AND WATER HEATERS) ARE SUBJECT TO RELOCATION DUE TO FIELD CONDITIONS.

PROVIDE POWER, LIGHT AND SWITCH AS REQUIRED FOR ATTIC FURNACE PER CODE AND

	MANUFACTURER'S WRITTEN INSTRUCTIONS.				
LEGI	LEGEND:				
ф	DUPLEX OUTLET	<b>\( \rightarrow \)</b>	CEILING MOUNTED INCANDESCENT LIGHT FIXTURE		
Фир/бы	WEATHERPROOF GFI DUPLEX OUTLET	ф	WALL MOUNTED INCANDESCENT		
∯ <i>G</i> FI	GROUND-FAULT CIRCUIT-INTERRUPTER DUPLEX OUTLET	- :	LIGHT FIXTURE  RECESSED INCANDESCENT LIGHT FIXTURE		
ф	HALF-SMITCHED DUPLEX OUTLET	ф	(VP) = VAPOR PROOF		
<b>₽</b> 220∨	220 VOLT OUTLET	•	CEILING MOUNTED LED LIGHT FIXTURE (VP) = VAPOR PROOF		
0	REINFORCED JUNCTION BOX	•	EXHAUST FAN (VENT TO EXTERIOR)		
\$	MALL SMITCH	-(2)-	EXHAUST FAN/LIGHT COMBINATION (VENT TO EXTERIOR)		
\$3	THREE-WAY SWITCH		FLUORESCENT LIGHT FIXTURE		
\$4	FOUR-WAY SWITCH	TEOTESEM ENTITIONS			
CH	CHIMES		TECH HUB SYSTEM		
9	PUSHBUTTON SMITCH		CEILING FAN (PROVIDE ADEQUATE SUPPORT)		
99	IIOV SMOKE ALARM W BATTERY BACKUP		CEILING FAN WITH INCANDESCENT		
60	IIOV SMOKE ALARM CO2 DETECTOR COMBO	LIGHT FIXTURE (PROVIDE ADEQUATE SUPPORT)			
①	THERMOSTAT	∞	GAS SUPPLY WITH VALVE		
PH	TELEPHONE				
ĪV	TELEVISION	→+	HOSE BIBB		
	ELECTRIC METER	—+ <sub>см</sub>	I/4" WATER STUB OUT		
_	ELECTRIC PANEL	K.			
<u> </u>	DISCONNECT SMITCH	K	WALL SCONCE		

FLOOR PLANS 'WINSTON'

HOMES

PLAN REV DATE 08.28.20

SHEET NUMBER

#### DESIGN SPECIFICATIONS:

Construction Type: Commerical  $\square$  Residential  $\boxtimes$ 

Applicable Building Codes:

• 2018 North Carolina Residential Building Code with All Local Amendments ASCE 7-10: Minimum Design Loads for Buildings and Other Structures

20 PSI
20 PS
60 PS
20 PSI
15 PSF
lø
40 PS
30 PS

4.3. Decks .... 4.4. Passenger Garage ... 5 Floor Dead Loads

5.2. I-Joist ..... .... 15 PSF 5.3. Floor Truss 15 PSF 6. Ultimate Design Wind Speed (3 sec. gust) ..... 6.1. Exposure ...

6.2. Importance Factor. 6.3. Wind Base Shear 6.3.I. Vx = 6.32.Vu =

1. Component and Cladding (in PSF)

MEAN ROOF HT.	UP TO 30'	30'1"-35'	35'1"-40'	40'1"-45'
ZONE 1	16.7,-18.0	17.6,-18.9	18.3,-19.7	18.8,-20.2
ZONE 2	16.7,-21.0	17.6,-22.1	18.3,-22.9	18.8,-23.6
ZONE 3	16.7,-21.0	17.6,-22.1	18.3,-22.9	18.8,-23.6
ZONE 4	18.2,-19.0	19.2,-20.0	19.9,-20.8	20.4,-21.3
ZONE 5	18.2,-24.0	19.2,-25.2	19.9,-26.2	20.4,-26.9

#### 8 Seismic

8.1.	Site Class	D
8.2.	Design Category	С
8.3.	Importance Factor	lØ
8.4.	Seismic Use Group	1
8.5.	Spectral Response Acceleration	
	851 Sms = %a	

8.6. Seismic Base Shea

8.6.2.Vu = 87 Basic Structural Sustem (check one) Bearing Wall
 Building Frame Moment, Frame

□ Dual w/ Special Moment Frame □ Dual w/ Intermediate R/C or Special Steel ☐ Inverted Pendulum

8.8. Arch/Mech Components Anchored ... 8.9. Lateral Design Control: Seismic Wind ⋈ 9. Assumed Soil Bearing Capacity



STRUCTURAL PLANS PREPARED FOR:

## WINSTON

PROJECT ADDRESS:

OWNER: DR Horton, Inc. 8001 Arrowridge Blvd

Charlotte, NC 28273

#### DESIGNER: GMD Design Group

102 Fountain Brook Circle Suite C Cary, NC 27511

These drawings are to be coordinated with the architectural, mechanical, plumbing, electrical, and civil drawings. This coordinated in the architecture is not the responsibility of the structural engineering of record (SER). Should any discrepancies become apparent, the contractor shall notify SUMMIT Engineering, Laboratory 4 Testing, P.C. before construction begins.

#### PLAN ABBREVIATIONS:

AB	ANCHOR BOLT	PT	PRESSURE TREATED
AFF	ABOVE FINISHED FLOOR	R5	ROOF SUPPORT
CJ	CEILING JOIST	SC	STUD COLUMN
CLR	CLEAR	SJ	SINGLE JOIST
DJ	DOUBLE JOIST	SPF	SPRUCE PINE FIR
DSP	DOUBLE STUD POCKET	SST	SIMPSON STRONG-TIE
EE	EACH END	SYP	SOUTHERN YELLOW PINE
ΕW	EACH WAY	TJ	TRIPLE JOIST
NTS	NOT TO SCALE	TSP	TRIPLE STUD POCKET
oc	ON CENTER	TYP	TYPICAL
PSF	POUNDS PER SQUARE FOOT	UNO	UNLESS NOTED OTHERWISE
PSI	POUNDS PER SQUARE INCH	WWF	WELDED WIRE FABRIC

Roof truss and floor joist layouts, and their corresponding loading details, were not provided to SUMMIT Engineering, Laboratory 4 Testing, P.C. (SUMMIT) prior to the initial design. Therefore, truss and joist directions were assumed based on the information provided by <u>DR Horton, Inc.</u> Subsequent plan revisions based on roof truss and floor joist layouts shall be noted in the revision list, indicating the date the layouts were provided. Should any discrepancies become apparent, the contractor shall notify SUMMIT immediately.

#### SHEET LIST:

Sheet No.	Description
CS1	Cover Sheet, Specifications, Revisions
S1.Øm	Monolithic Slab Foundation
51.Øs	Stem Wall Foundation
51.0c	Crawl Space Foundation
SI.Ø6	Basement Foundation
52.Ø	Basement Framing Plan
53.Ø	First Floor Framing Plan
54.Ø	Second Floor Framing Plan
95.Ø	Roof Framing Plan
56.Ø	Basement Bracing Plan
57.Ø	First Floor Bracing Plan
58.0	Second Floor Bracing Plan

#### DR HORTON PROJECT SIGN-OFF:

Manager	Signature
Operations	
Operations System	
Operations Product Development	
	Operations Operations System Operations Product

## SUMMIT



#### TRUCTURAL FIBERBOARD PANELS:

Fabrication and placement of structural fiberboard sheathing shall be in accordance with the applicable AFA standards. All structurally required fiberboard sheathing shall bear the

recommended in accordance with the APA.

Fiberboard wall sheathing shall comply with the requirements of local building codes for the appropriate state as indicated on these drawings. Refer to wall bracing notes in plan set for more

Wood wall sheathing shall comply with the requirements of local

building codes for the appropriate state as indicated on these drawlings. Refer to wall bracing notes in plan set for more

information. Sheathing shall be applied with the long direction perpendicular to framing, unless noted otherwise.

Roof sheathing shall be APA rated sheathing exposure I or 2.

attached to its supporting roof framing with (I)-8d CC nail at 6"o/c at panel edges and at 12"o/c in panel field unless

otherwise noted on the plans. Sheathing shall be applied with the long direction perpendicular to framing. Sheathing shall have a span rating consistent with the framing spacing. Use

suitable edge support by use of plywood clips or lumber blocking unless otherwise noted. Panel end joints shall occur

applied perpendicular to framing. Sheathing shall have a span

rating consistent with the framing spacing. Use suitable edge support by use of T4G plywood or lumber blocking unless

Apply building paper over the sheathing as required by the state Building Code.

Sheathing shall have a 1/8" gap at panel ends and edges as

otherwise noted. Panel end joints shall occur over framing.

over framing. Apply building paper over the sheathing as over training, apply building paper over the sneathing as required by the state Building Code.

Wood floor sheathing shall be APA rated sheathing exposure I or 2, Attach sheathing to its supporting fraining with (I)-8d CC fringdshark all at 6 °or at panel edges and at 12 °or in panel field unless otherwise noted on the plans. Sheathing shall be

Roof sheathing shall be continuous over two supports and

Sheathing shall have a 1/8" gap at panel ends and edges are

## REVISION LIST:

Revision No.	Date	Project No.	Description	
1	5.16.11	1245IR	Revised garage slab note. Revised roof overframing. Verified roof truss layouts creat by 84 Lumber dated 328.11. Verfied floor jois layouts created by 84 Lumber on 4.6.14	
2	6.13.17	12451R2	Added stemwall foundation plan	
3	TI.TI.T	12451R3	Revised per new architectural files. Added 9'- ceiling option.	
4	דו,דו,וו	12451R4	Revised SYP and pressure treated members no	
5	9.20.18	8@F@I	Revised per architectural redlines, Added extended porch option.	
6	11.30.18	19708R	Revised NC version only for 2018 NCRC	
7	3.14.19	21848	Revised TN version only for 2018 IRC	
8	426.19	21848R	Revised slab notes and extended porches	
9	12.30.19	21848R2	Revised SC version only for 2018 IRC	
10	1.31.20	26592	Added Crawl Space to NC plan only.	
11	10.15.20	26592R	Revised laundry door size for a 5-ft opening an added crawl girder size label	
	-			
	-			

#### GENERAL STRUCTURAL NOTES:

The design professional whose seal appears on these drawings is the structural engineer of record (SER) for this project. The SER bears the responsibility of the primary structural elements and the performance of this structure. No other party may revise alter, or delete any structural aspects of these construction documents without written permission of SUMMIT Engineering, Laboratory & Testing, P.C. (SUMMIT) or the SER. For the purposes of these construction documents the SER and SUMMIT shall be considered the same entity.

The structure is only stable in its completed form. The contractor

shall provide all required temporary bracing during construction to stabilize the structure.

The SER is not responsible for construction sequences, methods, or techniques in connection with the construction of this structure. The SER will not be held responsible for the contractor's failure to conform to the contract documents should any non-conformities occur.

Any structural elements or details not fully developed on the construction drawings shall be completed under the direction of a licensed professional engineer. These shop drawings shall be submitted to SUMMIT for review before any construction begins. The shop drawings will be reviewed for overall compliance as it relates to the structural design of this project. Verification of the shop drawings for dimensions, or for actual field conditions is not the responsibility of the SER or SUMMIT.

Verification of assumed field conditions is not the responsibility of the SER. The contractor shall verify the field conditions for accuracy and report any discrepancies to SUMMIT before

construction begins.

The SER is not responsible for any secondary structural elements or non-structural elements, except for the elements specifically

noted on the structural drawings.

This structure and all construction shall conform to all applicable sections of the international residential code.

This structure and all construction shall conform to all applicable sections of local building codes.

All structural assemblies are to meet or exceed to requirements of the current local building code.

#### FOUNDATIONS

The structural engineer has not performed a subsurface investigation. Verification of this assumed value is the responsibility of the owner or the contractor. Should any adverse soil condition be encountered the SER must be contacted before proceeding.

The bottom of all footings shall extend below the frost line for the region in which the structure is to be constructed. However, the bottom of all footings shall be a minimum of 12" below grade.

Any fill shall be placed under the direction or recommendation of a licensed professional engineer.

The resulting soil shall be compacted to a minimum of 95%

maximum dry density.

Excavations of footings shall be lined temporarily with a 6 mil polyethylene membrane if placement of concrete does not occur

within 24 hours of excavation. No concrete shall be placed against any subgrade containing water, ice, frost, or loose material.

Structural steel shall be fabricated and erected in accordance with the American Institute of Steel Construction "Code of Standard Practice for Steel Buildings and Bridges" and the manual of Steel Construction "Load Resistance Factor Design"

latest editions. Structural steel shall receive one coat of shop applied rust-inhibitive paint. All steel shall have a minimum yield stress  $(F_u)$  of 36 ksi unless

otherwise noted. Welding shall conform to the latest edition of the American Welding Society's Structural Welding Code AWS DIJ. Electrodes for shop and field welding shall be class ETØXX. All welding shall be performed by a certified welder per the above

### CONCRETE:

Concrete shall have a normal weight aggregate and a minimum compressive strength (f'c) at 28 days of 3000 psi, unless otherwise noted on the plan.

Concrete shall be proportioned, mixed, and placed in accordance with the latest editions of ACI 318: "Building Code Requirements for Reinforced Concrete" and ACI 301:

"Specifications for Structural Concrete for Buildings".

Air entrained concrete must be used for all structural elements exposed to freeze/thaw cycles and deicing chemicals. Air entrainment amounts (in percent) shall be within -1% to +2% of target values as follows:

3.1. Footings: 5% 3.2. Exterior Slabs: 5%

No admixtures shall be added to any structural concrete without written permission of the SER.

Concrete slabs-on-grade shall be constructed in accordance with ACI 302.IR-96: "Guide for Concrete Slab and Slab Construction".

The concrete slab-on-grade has been designed using a subgrade modulus of k=250 pcl and a design loading of 200 psf. The SER is not responsible for differential settlement, slab cracking or other future defects resulting from unreported conditions not in accordance with the above assumptions.

Control or saw cut joints shall be spaced in interior

slabs-on-grade at a maximum of 15 0" O.C. and in exterior slabs-on-grade at a maximum of 10'-0" unless otherwise noted. Control or saw cut joints shall be produced using conventional process within 4 to 12 hours after the slab has been finished

Reinforcing steel may not extend through a control joint. Reinforcing steel may extend through a saw cut joint. All welded wire fabric (WWF.) for concrete slabs-on-grade shall be placed at mid-depth of slab. The WWF, shall be securely

## CONCRETE REINFORCEMENT:

Fibrous concrete reinforcement, or fibermesh specified in concrete slabs-on-grade may be used for control of cracking due to shrinkage and thermal expansion/contraction, lowered water migration, an increase in impact capacity, increased abrasion resistance, and residual strength.
Fibermesh reinforcing to be 100% virgin polypropylene fibers

supported during the concrete pour.

containing no reprocessed olefin materials and specifically manufactured for use as concrete secondary reinforcement.

Application of fibermesh per cubic yard of concrete shall equal

a minimum of 0.1% by volume (1.5 pounds per cubic yard) Fibermesh shall comply with ASTM CIlle, any local building code requirements, and shall meet or exceed the current industry

standard. Steel reinforcing bars shall be new billet steel conforming to ASTM A615, grade 60.

Detailing, flabrication, and placement of reinforcing steel shall be in accordance with the latest edition of ACI 315: "Manual of Standard Practice for Detailing Concrete Structures" Horizontal footing and wall reinforcement shall be continuous and shall have 90° bends, or comer bars with the same size/spacing as the horizontal reinforcement with a class B

Lap reinforcement as required, a minimum of 40 bar diameters for tension or compression unless otherwise noted. Splices in masonry shall be a minimum of 48 bar diameters.

Where reinforcing dowels are required, they shall be equivalent in size and spacing to the vertical reinforcement. The dowel shall extend 48 bar diameters vertically and 20 bar diameters

into the footing.

Where reinforcing steel is required vertically, dowels shall be provided unless otherwise noted.

Solid sawn wood framing members shall conform to the specifications listed in the latest edition of the "National Design Specification for Wood Construction" (NDS). Unless otherwise noted, all wood framing members are designed to be Southern-Yellow-Pine (SYP) #2

LVL or PSL engineered wood shall have the following minimum design values: 2.1. E = 1,900,000 psi

22. Fb = 2600 psi 23. Fv = 285 psi 24 Fc = 700 psi

Wood in contact with concrete, masonry, or earth shall be pressure treated in accordance with AWPA standard C-I5. All other moisture exposed wood shall be treated in accordance with AWPA standard C-2

Nails shall be common wire nails unless otherwise noted. Lag screws shall conform to ANSI/ASME standard BIB2.1-1981. Lead holes for lag screws shall be in accordance with NDS

specifications. All beams shall have full bearing on supporting framing members unless otherwise noted.

Exterior and load bearing stud walls are to be 2x4 SYP \*2 a 16" OC. unless otherwise noted, Studs shall be continuous from the sole plate to the double top plate. Studs shall only be discontinuous at headers for window/door openings. A minimum of one king stud shall be placed at each end of the header.

King studs shall be continuous. Individual studs forming a column shall be attached with one 10d nail \* 6" O.C. staggered. The stud column shall be continuous to the foundation or beam. The column shall be properly blocked at all floor levels to ensure proper load transfer. Multi-ply beams shall have each ply attached with (3) 100 nails @

Four and five plu beams shall be bolted together with (2) rous of 1/2" diameter through bolts staggered @ 16" O.C. unless noted otherwise.

#### WOOD TRUSSES:

The wood truss manufacturer/fabricator is responsible for the design of the wood trusses. Submit sealed shop drawings and supporting calculations to the SER for review prior to fabrication. The SER shall have a minimum of five (5) days for review. The review by the SER shall review for overall compliance with the design documents. The SER shall assume no responsibility for the correctness for the structural design for

the wood trusses. The wood trusses shall be designed for all required loadings as specified in the local building code, the ASCE Standard "Minimum Design Loads for Buildings and Other Structures." (ASCE 7-10), and the loading requirements shown on these specifications. The truss drawings shall be coordinated with all other construction documents and provisions provided for loads shown on these drawings including but not limited to HVAC equipment, piping, and architectural fixtures attached to the trusses.

The trusses shall be designed, fabricated, and erected in accordance with the latest edition of the "National Design Specification for Wood Construction." (NDS) and "Design Specification for Metal Plate Connected Wood Trusses.
The truss manufacturer shall provide adequate bracing

information in accordance with "Commentary and Recommendations for Handling, Installing, and Bracing Metal Plate Connected Wood Trusses" (HIB-91). This bracing, both temporary and permanent, shall be shown on the shop drawings, Also, the shop drawings shall show the required attachments for

Anu chards or truss webs shown on these drawings have been shown as a reference only. The final design of the trusses shall be per the manufacturer.

#### XTERIOR WOOD FRAMED DECKS:

Decks are to be framed in accordance with local building codes and as referenced on the structural plans, either through

#### LOOD STRUCTURAL PANELS:

Fabrication and placement of structural wood sheathing shall be in accordance with the APA Design/Construction Guide "Residential and Commercial," and all other applicable APA

All structurally required wood sheathing shall bear the mark of

STRUCTURAL MEMBERS ONL

9CALE: 22x34 1/4"+1"-@" 1k/1 1/8"+1"-@" PROJECT N 528-06Rs 26592R

REFER TO COVER SHEET FOR A COMPLETE LIST OF REVISIONS

CHECKED BY: BCP



#### FOUNDATION NOTES:

- FOUNDATIONS TO BE CONSTRUCTED IN ACCORDANCE WITH CHAPTER 4 OF THE 2018 NORTH CAROLINA RESIDENTIAL BUILDING CODE WITH ALL LOCAL AND STATE AMENDMENTS
- 2. STRUCTURAL CONCRETE TO BE F<sub>c</sub> = 3000 PSI, PREPARED AND PLACED IN ACCORDANCE WITH ACI STANDARD 316.
  3. FOOTINGS TO BE PLACED ON UNDISTURBED EARTH, BEARING A MINIMUM OF
- 12" BELOW ADJACENT FINISHED GRADE, OR AS OTHERWISE DIRECTED BY THE CODE ENFORCEMENT OFFICIAL.
- FOOTING SIZES BASED ON A PRESUMPTIVE SOIL BEARING CAPACITY OF 2000 PSF. CONTRACTOR IS SOLELY RESPONSIBLE FOR VERIFYING THE SUITABILITY OF THE SITE SOIL CONDITIONS AT THE TIME OF CONSTRUCTION.
- FOOTINGS AND PIERS SHALL BE CENTERED UNDER THEIR RESPECTIVE ELEMENTS, PROVIDE 2" MINIMUM FOOTING PROJECTION FROM THE FACE OF MASONRY.
- 6. MAXIMUM DEPTH OF UNBALANCED FILL AGAINST MASONRY WALLS TO BE AS SPECIFIED IN SECTION R404.1 OF THE 2018 NORTH CAROLINA RESIDENTIAL BUILDING CODE.
- PILASTERS TO BE BONDED TO PERIMETER FOUNDATION WALL
- PROVIDE FOUNDATION WATERPROOFING, AND DRAIN WITH POSITIVE 9LOPE TO OUTLET AS REQUIRED BY SITE CONDITIONS.
- PROVIDED PERMITERS INSULATION FOR ALL FOUNDATIONS PER 2018 NORTH CAROLINA RESIDENTIAL BUILDING CODE.
- 10. CORBEL FOUNDATION WALL AS REQUIRED TO ACCOMMODATE BRICK
- CRAWL SPACE TO BE GRADED LEVEL, AND CLEARED OF ALL DEBRIS.
- FOUNDATION ANCHORAGE SHALL BE CONSTRUCTED PER THE 2016 NORTH CAROLINA RESIDENTIAL CODE SECTION RA03.16, MINIMUM 12" DIA BOLTS PRACED AT 6"-0" ON CENTER WITH A 1" MINIMUM MBEDMENT INTO MASONRY OR CONCRETE. MINIMUM (2) ANCHOR BOLTS PER PLATE SECTION AND (1) LOCATED NOT MORE THAN  $12^\circ$  FROM THE CORNER, ANCHOR BOLTS SHALL BE LOCATED IN THE CENTER THIRD OF THE PLATE.
- 13. ABBREVIATIONS:

FT = FLOOR TRUSS

- SC = STUD COLUMN TJ = TRIPLE JOIST CL = CENTER LINE EE = EACH END OC = ON CENTER EW = EACH WAY PL = POINT LOAD
- MASONRY, TYPICAL, (UNO)
- IB. WALL FOOTINGS TO BE CONTINUOUS CONCRETE, SIZES PER STRUCTURAL PLAN.
   A FOUNDATION EXCAVATION OBSERVATION SHOULD BE CONDUCTED BY A PROFESSIONAL GEOTECHNICAL ENSINEER, OR HIS QUALIFIED
  REPRESENTATIVE, IF ISOLATED AREAS OF YIELDING MATERIALS AND/OR
  POTENTIALLY EXPANSIVE SOILS ARE OBSERVED IN THE FOOTING EXCAVATIONS AT THE TIME OF CONSTRUCTION, SUMMIT ENGINEERING LABORATORY & TESTING, P.C. MUST BE PROVIDED THE OPPORTUNITY TO REVIEW THE FOOTING DESIGN PRIOR TO CONCRETE PLACEMENT.

14. ALL PIERS TO BE 16 "X16" MASONRY AND ALL PILASTERS TO BE 8"X16"

ALL FOOTINGS 4 SLABS ARE TO BEAR ON UNDISTURBED SOIL OR 95% COMPACTED FILL, VERIFIED BY ENGINEER OR CODE OFFICIAL.

REFER TO BRACED WALL PLAN FOR PANEL LOCATIONS AND ANY REQUIRED HOLD-DOWNS. ADDITIONAL INFORMATION PER SECTION R602.10.8 AND FIGURE R602.10.7 OF THE 2015 IRC.

NOTE: ALL EXTERIOR FOUNDATION DIMENSIONS ARE TO FRAMING AND NOT BRICK VENEER, UNO

NOTE: A 4" CRUSHED STONE BASE COURSE IS NOT REQUIRED WHEN SLAB IS INSTALLED ON WELL-DRAINED OR SAND-GRAVEL MIXTURE SOILS CLASSIFIED AS GROUP I PER TABLE R405.

NOTE: FOUNDATION ANCHORAGE HAS BEEN DESIGNED TO RESIST THE CONTINUOUS WIND UPLIFT LOAD PATH IN ACCORDANCE WITH METHOD 3 OF SECTION R602.3.5 OF THE 2018 NCRC.

THESE PLANS ARE DESIGNED IN ACCORDANCE WITH ARCHITECTURAL PLANS PROVIDED BY <u>DR HORTON</u> COMPLETED/REVISED ON <u>9/18/18</u>, IT 15 THE RESPONSIBILITY OF THE CLIENT TO NOTIFY SUMMIT ENGINEERING, LABORATORY & TESTING, P.C. IF ANY CHANGES ARE MADE TO THE ARCHITECTURAL PLANS PRIOR TO CONSTRUCTION SUMMIT ENGINEERING LABORATORY & TESTING, P.C. CANNOT GUARANTEE THE ADEQUACY OF THESE STRUCTURAL PLANS WHEN USED WITH ARCHITECTURAL PLANS DATED DIFFERENTLY THAN THE DATE LISTED ABOVE.


### STRUCTURAL MEMBERS ONLY

ENGINEERING SEAL APPLIES ONLY TO STRUCTURAL COMPONENTS ON THIS DOCUMENT, SEAL DOES NOT INCLUDE CONSTRUCTION MEANS. METHODS, TECHNIQUES, SEQUENCES, PROCEDURES OR SAFETY PRECAUTIONS.
ANY DEVIATIONS OR DISCREPANCIES ON PLANS ARE TO BE BROUGHT TO THE IMMEDIATE ATTENTION OF SUMMIT ENGINEERING, LABORATORY & TESTING, P.C. FAILURE TO DO SO WILL VOID SUMMIT LIABILITY.


STRUCTURAL ANALYSIS BASED ON 2018 NCRC.

MONOLITHIC SLAB FOUNDATION PLAN

SCALE: 1/4"=|"-@" ON 22"x34" OR 1/8"=|"-@" ON ||"x|1"

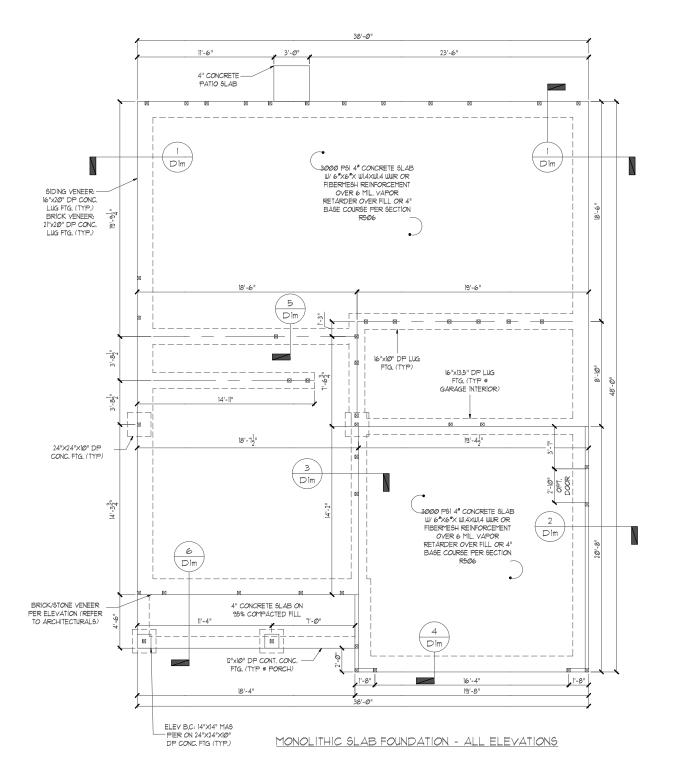



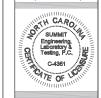

ndatí  $\vec{Q}$ Slab ist Polithia



DATE: 10/5/20 8CALE: 22x34 1/4"+1"-@" 1kt1 1/8"+1"-@" PROJECT 5 528-06Rs 26592

CHECKED BY: BCP

REFER TO COVER SHEET FOR A COMPLETE LIST OF REVISIONS

SI.Om

OR EQUIVALENT PER TABLE R10235

#### BRAÇED WALL NOTES:

- WALLS SHALL BE DESIGNED IN ACCORDANCE WITH SECTION R602.10 FROM THE 2015
- INTERNATIONAL RESIDENTIAL CODE WITH ALL LOCAL AND STATE AMENDMENTS. WALLS ARE DESIGNED FOR SEISMIC ZONES A-C AND MAXIMUM WIND SPEEDS UP TO
- REFER TO ARCHITECTURAL PLAN FOR DOOR/WINDOW OPENING SIZES, BRACING MATERIALS, METHODS AND FASTENERS SHALL BE IN ACCORDANCE WITH
- TABLE R602 104
- ALL BRACED WALL PANELS SHALL BE FULL WALL HEIGHT AND SHALL NOT EXCEED 10 FEET FOR ISOLATED PANEL METHOD AND 12 FEET FOR CONTINUOUS SHEATHING METHOD WITHOUT ADDITIONAL ENGINEERING CALCULATIONS. MINIMUM PANEL LENGTH SHALL BE PER TABLE R602/05.
  THE INTERIOR SIDE OF EXTERIOR WALLS AND BOTH SIDES OF INTERIOR WALLS
- SHALL BE SHEATHED CONTINUOUSLY WITH MINIMUM 1/2" GYPSUM BOARD (UNO).
- FOR CONTINUOUS SHEATHING METHOD, EXTERIOR WALLS SHALL BE SHEATHED ON ALL SHEATHABLE SURFACES INCLUDING INFILL AREAS BETWEEN BRACED WALL
- PANELS, ABOVE AND BELOW WALL OPENINGS, AND ON GABLE END WALLS, FLOORS SHALL NOT BE CANTILEVERED MORE THAN 24" BEYOND THE FOUNDATION OR BEARING WALL BELOW WITHOUT ADDITIONAL ENGINEERING CALCULATIONS.
- A BRACED WALL PANEL SHALL BE LOCATED WITHIN 10 FEET OF EACH END OF A BRACED WALL LINE.
   THE MAXIMUM EDGE DISTANCE BETWEEN BRACED WALL PANELS SHALL NOT.
- EXCEED 20 FEET.
- 12. MASONRY OR CONCRETE STEM WALLS W/ A LENGTH OF 48" OR LESS SUPPORTING A BRACED WALL PANEL SHALL BE DESIGNED IN ACCORDANCE WITH FIGURE R602.10.9 OF THE 2015 IRC.
- BRACED WALL PANEL CONNECTIONS TO FLOOR/CEILING SHALL BE CONSTRUCTED IN ACCORDANCE WITH SECTION R602,10.8
- BRACED WALL PANEL CONNECTIONS TO ROOF SHALL BE CONSTRUCTED IN ACCORDANCE WITH SECTION R602.10.8.2
- 15. CRIPPLE WALLS AND WALK OUT BASEMENT WALLS SHALL BE DESIGNED IN
- ACCORDANCE WITH SECTION R602.10/11

  16. PORTAL WALLS SHALL BE DESIGNED IN ACCORDANCE WITH FIGURE R602.106.4
- IT. ABBREVIATIONS:

GB = GYPSUM BOARD

WSP = WOOD STRUCTURAL PANEL 

#### GENERAL STRUCTURAL NOTES:

- CONSTRUCTION SHALL CONFORM TO 2018 NORTH CAROLINA RESIDENTIAL
- BUILDING CODE WITH ALL LOCAL AND STATE AMENDMENTS.
  CONTRACTOR SHALL VERIFY ALL DIMENSIONS, CONTRACTOR SHALL
  COMPLY WITH THE CONTENTS OF THE DRAWING FOR THIS SPECIFIC PROJECT, ENGINEER IS NOT RESPONSIBLE FOR ANY DEVIATIONS FROM THIS PLAN.

  3. CONTRACTOR IS RESPONSIBLE FOR PROVIDING TEMPORARY BRACING.
- REQUIRED TO RESIST ALL FORCES ENCOUNTERED DURING ERECTION. PROPERTIES USED IN THE DESIGN ARE AS FOLLOWS:
- MICROLLAM (LVL), F<sub>6</sub> = 2600 PSI, F<sub>7</sub> = 285 PSI, E = 13x10<sup>6</sup> PSI PARALLAM (PSI), F<sub>6</sub> = 2900 PSI, F<sub>7</sub> = 290 PSI, E = 125x10<sup>6</sup> PSI ALL WOOD MEMBERS SHALL BE 12 SYP UNLESS NOTED ON PLAN ALL STUD COLUMNS AND JOISTS SHALL BE 12 SYP (NNO).
- ALL BEAMS SHALL BE SUPPORTED WITH A (2) 2x4 12 SYP STUD COLUMN AT EACH END UNLESS NOTED OTHERWISE. ALL REINFORCING STEEL SHALL BE GRADE 60 BARS CONFORMING TO
- ASTM A615 AND SHALL HAVE A MINIMUM COVER OF 3".

  8. CONTRACTOR TO PROVIDED LOOKOUTS WHEN CEILING JOISTS SPAN
- PERPENDICULAR TO RAFTERS. FLITCH BEAMS, 4-PLY LVLS AND 3-PLY SIDE LOADED LVLS SHALL BE BOLTED TOGETHER WITH 1/2" DIA, THRU BOLTS SPACED AT 24" O.C.
- (MAX) STAGGERED OR EQUIVALENT CONNECTIONS PER DETAIL I/D3f MIN EDGE DISTANCE SHALL BE 2" AND (2) BOLTS SHALL BE LOCATED MINIMUM 6" FROM EACH END OF THE BEAM.
- MINIMUM 8" REOM EACH END OF THE BEAM.

  10. ALL NON-LOAD BEARING HEADERS SHALL BE (1) FLAT 2x4 SYP \*2,
  DROPPED. FOR NON-LOAD BEARING HEADERS EXCEEDING 8"-0" IN
  WIDTH AND/OR WITH MORE THAN 2"-0" OF CRIPPLE WALL ABOVE, SHALL BE (2) FLAT 2x4 SYP #2, DROPPED, (UNLESS NOTED OTHERWISE)

THESE PLANS ARE DESIGNED IN ACCORDANCE WITH ARCHITECTURAL PLANS PROVIDED BY <u>DR HORTON</u> COMPLETED/REVISED ON <u>9/18/18</u>, IT 15 THE RESPONSIBILITY OF THE CLIENT TO NOTIFY SUMMIT ENGINEERING, LABORATORY & TESTING, P.C. IF ANY CHANGES ARE MADE TO THE ARCHITECTURAL PLANS PRIOR TO CONSTRUCTION SUMMIT ENGINEERING LABORATORY & TESTING, P.C. CANNOT GUARANTEE THE ADEQUACY OF THESE STRUCTURAL PLANS WHEN USED WITH ARCHITECTURAL PLANS DATED DIFFERENTLY THAN THE DATE LISTED ABOVE.


## STRUCTURAL MEMBERS ONLY

ENGINEERING SEAL APPLIES ONLY TO STRUCTURAL COMPONENTS ON THIS DOCUMENT, SEAL DOES NOT INCLUDE CONSTRUCTION MEANS, METHODS, TECHNIQUES SEQUENCES, PROCEDURES OR SAFETY PRECAUTIONS.
ANY DEVIATIONS OR DISCREPANCIES ON PLANS ARE TO BE BROUGHT TO THE IMMEDIATE ATTENTION OF SUMMIT ENGINEERING, LABORATORY & TESTING, P.C. FAILURE TO DO SO WILL VOID SUMMIT LIABILITY.

STRUCTURAL ANALYSIS BASED ON 2018 NCRC.

## FIRST FLOOR FRAMING PLAN

SCALE: 1/4"=|"-@" ON 22"x34" OR 1/8"=|"-@" ON ||"x|1"

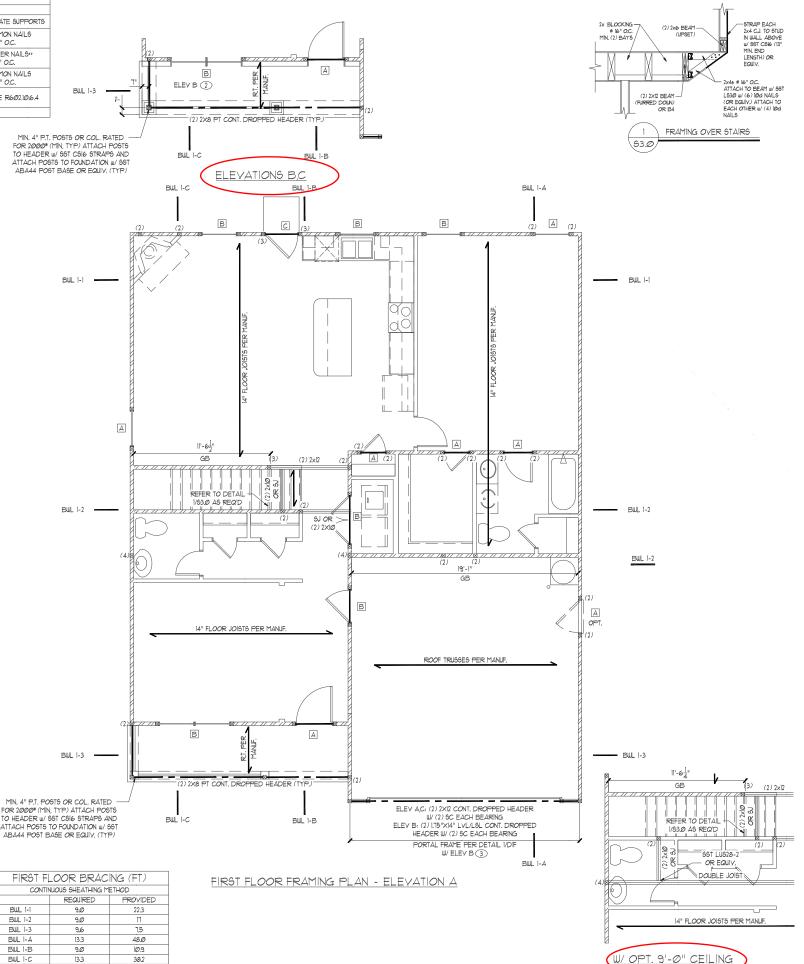

HEADER SCHEDULE				
SIZE	JACKS (EACH END			
(2) 2x6	(1)			
(2) 2x8	(2)			
(2) 2xlØ	(2)			
(2) 2x12	(2)			
(2) 9-1/4" L5L/LVL	(3)			
(3) 2x6	(1)			
(3) 2x8	(2)			
(3) 2xlØ	(2)			
(3) 2xl2	(2)			
	6 ZE (2) 2x6 (2) 2x8 (2) 2x8 (2) 2x10 (2) 2x12 (2) 9-1/4" LGLLYL (3) 2x6 (3) 2x8 (3) 2x8			

<u>NOTES:</u> 1. HEADER SIZES SHOWN ON PLANS ARE MINIMUMS, GREATER HEADER SIZES MAY BE USED FOR EASE OF CONSTRUCTION 2. ALL HEADERS TO BE DROPPED (UN.O.).
3. STUD COLUMNS NOTED ON PLAN OVERRIDE STUD

COLUMNS LISTED ABOVE (U.N.O.).

KING STUD	SCHEDULE
MAXIMUM HEADER SPAN	MINIMUM KING STUDS E.E.
4'-Ø"	(1)
6'-Ø"	(2)
8'-Ø"	(2)
10'-0"	(3)
12'-Ø"	(3)
14'-Ø"	(3)
16'-0"	(4)
18'-0"	(4)

	WALLS	STUD SCI	HEDULE	(10 FT H	EIGHT)
STUD SIZE STUD SPACING (O.C.)				CING (0,C.)	
		ROOF ONLY	ROOF #	ROOF # 2 FLOORS	NON-LOAD BEARING
	2×4	24"	16"	12"	24"
	2x6	24"	24"	16"	24"

I BRACED WALLS STUDS SHALL BE A MAX OF 16" OC 2. STUDS SUPPORTS OPTIONAL WALK-UP ATTIC SHALL BE SPACED A MAX. OF 16" OC.

3. TWO STORY WALLS SHALL BE FRAMED W/ 2x4 STUDS @ 12" O.C. OR 2x6 STUDS # 16" O.C. BALLOON FRAMED W/ HORIZ. BLOCKING @ 6'-@" O.C. VERTICALLY.

LINTEL SCHEDULE				
TAG	SIZE	OPENING SIZE		
0	L3x3x1/4"	LESS THAN 6'-0"		
2	L5x3xl/4"	6'-0" TO 10'-0"		
3	L5x3-1/2x5/16"	GREATER THAN 10'-0"		
4	L5x3-1/2x5/16" ROLLED OR EQUIV.	ALL ARCHED OPENINGS		
SECURE LINITEL TO HEADER/ (2) 1011 DIAMETER LAG				

SECURE LINTEL TO HEADER w/ (2) 1/2" DIAMETER LAG SCREWS STAGGERED @ 16" O.C. (TYP FOR (3)) ALL HEADERS WHERE BRICK IS USED, TO BE: (UNO)

SHADED WALLS INDICATED LOAD BEARING WALLS

NOTE: REDUCE JOIST SPACING UNDER TILE FLOORS. GRANITE COUNTERTOPS AND/OR ISLANDS

JOIST & BEAM SIZES SHOWN ARE MINIMUMS, BUILDER MAY INCREASE DEPTH FOR EASE OF CONSTRUCTION.

DESIGNATES JOIST SUPPORTED LOAD BEARING WALL ABOVE, PROVIDE BLOCKING UNDER JOIST SUPPORTED LOAD BEARING WALL

NOTE: MEMBERS NOTED AS PRESSURE TREATED MAY BE FRAMED WITH NON-PRESSURE TREATED LUMBER PROVIDED THE ENTIRETY OF THE MEMBER IS WRAPPED TO PREVENT

INSTALL HOLD-DOWNS FOR BRACED WALL END CONDITIONS PER SECTION R602 IO.8 & FIGURE R602 IO.1 OF THE 2015 IRC

NOTE: WALL SHEATHING AND FASTENERS HAVE BEEN DESIGNED TO RESIST THE CONTINUOUS WIND UPLIFT LOAD PATH IN ACCORDANCE WITH METHOD 3 OF SECTION R6023.5 OF THE 2018 NCRC.





 $Q_{J}$ ιÌ



SCALE: 22x34 1/4"+1"-@" 1kiT 1/8"+1"-@" PROJECT % 528-06R- 265%

CHECKED BY: BCP

REFER TO COVER SHEET FOR A COMPLETE LIST OF REVISIONS

S3.Ø

#### "OR EQUIVALENT PER TABLE R102.3.5

#### BRACED WALL NOTES:

- WALLS SHALL BE DESIGNED IN ACCORDANCE WITH SECTION R602.10 FROM THE 2015
- INTERNATIONAL RESIDENTIAL CODE WITH ALL LOCAL AND STATE AMENDMENTS. WALLS ARE DESIGNED FOR SEIGMIC ZONES A-C AND MAXIMUM WIND SPEEDS UP TO
- REFER TO ARCHITECTURAL PLAN FOR DOOR/WINDOW OPENING SIZES.
  BRACING MATERIALS, METHODS AND FASTENERS SHALL BE IN ACCORDANCE WITH
- TABLE R600 104
- ALL BRACED WALL PANELS SHALL BE FULL WALL HEIGHT AND SHALL NOT EXCEED 10 FEET FOR ISOLATED PANEL METHOD AND 12 FEET FOR CONTINUOUS SHEATHING METHOD WITHOUT ADDITIONAL ENGINEERING CALCULATIONS.
  MINIMUM PANEL LENGTH SHALL BE PER TABLE R602/05.
  THE INTERIOR SIDE OF EXTERIOR WALLS AND BOTH SIDES OF INTERIOR WALLS
- SHALL BE SHEATHED CONTINUOUSLY WITH MINIMUM 1/2" GYPSUM BOARD (UNO).
- FOR CONTINUOUS SHEATHING METHOD, EXTERIOR WALLS SHALL BE SHEATHED ON ALL SHEATHABLE SURFACES INCLUDING INFILL AREAS BETWEEN BRACED WALL PANELS, ABOVE AND BELOW WALL OPENINGS, AND ON GABLE END WALLS. FLOORS SHALL NOT BE CANTILEVERED MORE THAN 24" BEYOND THE FOUNDATION
- OR BEARING WALL BELOW WITHOUT ADDITIONAL ENGINEERING CALCULATIONS.
- A BRACED WALL PANEL SHALL BE LOCATED WITHIN 10 FEET OF EACH END OF A
  BRACED WALL LINE.
   THE MAXIMUM EDGE DISTANCE BETWEEN BRACED WALL PANELS SHALL NOT
- EXCEED 20 FEET.
  MASONRY OR CONCRETE STEM WALLS W/ A LENGTH OF 48" OR LESS SUPPORTING A BRACED WALL PANEL SHALL BE DESIGNED IN ACCORDANCE WITH FIGURE R602.10.9
- OF THE 2015 IRC.

  13. BRACED WALL PANEL CONNECTIONS TO FLOOR/CEILING SHALL BE CONSTRUCTED IN ACCORDANCE WITH SECTION R602.10.8
- BRACED WALL PANEL CONNECTIONS TO ROOF SHALL BE CONSTRUCTED IN ACCORDANCE WITH SECTION R602.10.82
- IS CRIPPLE WALLS AND WALK OUT BASEMENT WALLS SHALL BE DESIGNED IN
- ACCORDANCE WITH SECTION RE02.1011

  16. PORTAL WALLS SHALL BE DESIGNED IN ACCORDANCE WITH FIGURE R602.106.4
- 17. ABBREVIATIONS:

GB = GYPSUM BOARD

WSP = WOOD STRUCTURAL PANEL 

#### GENERAL STRUCTURAL NOTES:

- CONSTRUCTION SHALL CONFORM TO 2018 NORTH CAROLINA RESIDENTIAL
- BUILDING CODE WITH ALL LOCAL AND STATE AMENDMENTS.
  CONTRACTOR SHALL VERIFY ALL DIMENSIONS. CONTRACTOR SHALL
  COMPLY WITH THE CONTENTS OF THE DRAWING FOR THIS SPECIFIC PROJECT, ENGINEER IS NOT RESPONSIBLE FOR ANY DEVIATIONS FROM THIS PLAN.

  3. CONTRACTOR IS RESPONSIBLE FOR PROVIDING TEMPORARY BRACING
- REQUIRED TO RESIST ALL FORCES ENCOUNTERED DURING ERECTION. PROPERTIES USED IN THE DESIGN ARE AS FOLLOWS:
- PROPERTIES USED IN THE DESIGN ARE AS FOLLOWS:  $\frac{1}{N} \sum_{k=1}^{N} \frac{1}{N} \frac{1}{N} \sum_{k=1}^{N} \frac{1}{N} \frac{1}{N} = \frac{1}{N} \frac{1}{N} \frac{1}{N} \frac{1}{N} = \frac{1}{N} \frac{1}{N} \frac{1}{N} \frac{1}{N} = \frac{1}{N} \frac{1}{N} \frac{1}{N} \frac{1}{N} \frac{1}{N} = \frac{1}{N} \frac{1}{$
- STUD COLUMNS AND JOISTS SHALL BE \$2 SYP (UNO).
- ALL BEAMS SHALL BE SUPPORTED WITH A (2) 2x4 12 SYP STUD COLUMN AT EACH END UNLESS NOTED OTHERWISE. ALL REINFORCING STEEL SHALL BE GRADE 60 BARS CONFORMING TO
- ASTM A&IS AND SHALL HAVE A MINIMM COVER OF 3".

  8. CONTRACTOR TO PROVIDED LOOKOUTS WHEN CEILING JOISTS SPAN
- PERPENDICULAR TO RAFTERS.
- FERFENDICULAR TO RAFIERS.
  FLITCH BEAMS, 4-PLY LIVLS AND 3-PLY SIDE LOADED LIVLS SHALL BE BOLTED TOGETHER WITH 10" DIA, THRU BOLTS SPACED AT 24" OC. (MAX.) STAGGERED OR EQUIVALENT CONNECTIONS PER DETAIL 1/D3f. MIN. EDGE DISTANCE SHALL BE 2" AND (2) BOLTS SHALL BE LOCATED MINIMUM 6" FROM EACH END OF THE BEAM.
- MINIMUM 8" REOM EACH END OF THE BEAM.

  10. ALL NON-LOAD BEARING HEADERS SHALL BE (1) FLAT 2x4 SYP \*2,
  DROPPED. FOR NON-LOAD BEARING HEADERS EXCEEDING 8"-0" IN
  WIDTH AND/OR WITH MORE THAN 2"-0" OF CRIPPLE WALL ABOVE, SHALL BE (2) FLAT 2x4 SYP #2, DROPPED. (UNLESS NOTED OTHERWISE)

THESE PLANS ARE DESIGNED IN ACCORDANCE WITH ARCHITECTURAL PLANS PROVIDED BY <u>DR. HORTON</u> COMPLETED/REVISED ON <u>9/18/18</u>, IT IS THE RESPONSIBILITY OF THE CLIENT TO NOTIFY SUMMIT ENGINEERING, LABORATORY & TESTING, P.C. IF ANY CHANGES ARE MADE TO THE ARCHITECTURAL PLANS PRIOR TO CONSTRUCTION. SUMMIT ENGINEERING LABORATORY & TESTING, P.C. CANNOT GUARANTEE THE ADEQUACY OF THESE STRUCTURAL PLANS WHEN USED WITH ARCHITECTURAL PLANS DATED DIFFERENTLY THAN THE DATE LISTED ABOVE


### STRUCTURAL MEMBERS ONLY

ENGINEERING SEAL APPLIES ONLY TO STRUCTURAL COMPONENTS ON THIS DOCUMENT, SEAL DOES NOT INCLUDE CONSTRUCTION MEANS, METHODS, TECHNIQUES, SEQUENCES, PROCEDURES OR SAFETY PRECAUTIONS.
ANY DEVIATIONS OR DISCREPANCIES ON PLANS ARE TO BE BROUGHT TO THE IMMEDIATE ATTENTION OF SUMMIT ENGINEERING, LABORATORY & TESTING, P.C. FAILURE TO DO SO WILL VOID SUMMIT LIABILITY.

STRUCTURAL ANALYSIS BASED ON 2018 NCRC.

## SECOND FLOOR FRAMING PLAN

SCALE: 1/4"=1'-0" ON 22"x34" OR 1/8"=1'-0" ON 11"x17"

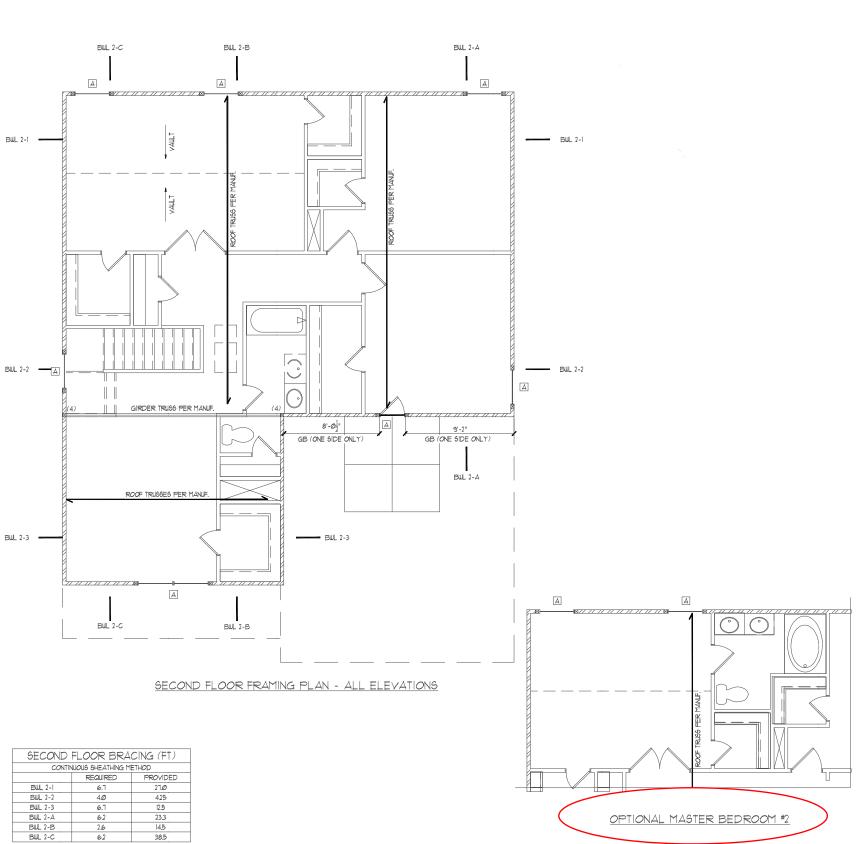

HEADER SCHEDULE					
TAG	SIZE	JACKS (EACH END)			
А	(2) 2x6	(1)			
В	(2) 2x8	(2)			
С	(2) 2xlØ	(2)			
D	(2) 2×12	(2)			
E	(2) 9-1/4" LSL/LVL	(3)			
F	(3)2x6	(1)			
G	(3) 2x8	(2)			
H	(3) 2xlØ	(2)			
	(3) 2x12	(2)			

NOTES: 1. HEADER SIZES SHOWN ON PLANS ARE MINIMUMS. GREATER HEADER SIZES MAY BE USED FOR EASE OF CONSTRUCTION.

2. ALL HEADERS TO BE DROPPED (UN.O.).
3. STUD COLUMNS NOTED ON PLAN OVERRIDE STUD COLUMNS LISTED ABOVE (UN.O.).

KING STUD	SCHEDULE
MAXIMUM HEADER SPAN	MINIMUM KING STUDS E.E.
4'-0"	(1)
6'-0"	(2)
8'-Ø"	(2)
10°-0"	(3)
12'-@"	(3)
14'-Ø"	(3)
16'-0"	(4)
18'-0"	(4)

WALL STUD SCHEDULE (10 FT HEIGHT)					
STUD SIZE	STUD SPACING (O.C.)				
	ROOF ONLY	ROOF &	ROOF & 2 FLOORS	NON-LOAD BEARING	
2x4	24"	16"	12"	24"	
2x6	24"	24"	16"	24"	

BRACED WALLS STUDS SHALL BE A MAX OF 16" OC. 2. STUDS SUPPORTS OPTIONAL WALK-UP ATTIC SHALL BE SPACED A MAX. OF 16" O.C.

3. TWO STORY WALLS SHALL BE FRAMED W/ 2x4 STUDS @ 12" BLOCKING @ 6'-0" O.C. VERTICALLY.

	LINTEL SCHED	DULE		
TAG	SIZE	OPENING SIZE		
0	L3x3x1/4"	LESS THAN 6'-0"		
2	L5x3x1/4"	6'-0" TO 10'-0"		
3	L5x3-1/2x5/16"	GREATER THAN 10'-0		
4	L5x3-1/2x5/16" ROLLED OR EQUIV.	ALL ARCHED OPENINGS		

SECURE LINTEL TO HEADER w/ (2) 1/2" DIAMETER LAG SCREWS STAGGERED @ 16" O.C. (TYP FOR (3)) ALL HEADERS WHERE BRICK IS USED, TO BE: ( UNO)

SHADED WALLS INDICATED LOAD BEARING WALLS

JOIST & BEAM SIZES SHOWN ARE MINIMUMS. BUILDER MAY INCREASE DEPTH FOR EASE OF CONSTRUCTION.

NOTE: MEMBERS NOTED AS PRESSURE TREATED MAY BE FRAMED WITH NON-PRESSURE TREATED LUMBER PROVIDED THE ENTIRETY OF THE MEMBER IS WRAPPED TO PREVENT

INSTALL HOLD-DOWNS FOR BRACED WALL END CONDITIONS PER SECTION R602.10.8 \$ FIGURE R602.10.1 OF THE 2015 IRC.

NOTE: WALL SHEATHING AND FASTENERS HAVE BEEN DESIGNED TO RESIST THE CONTINUOUS WIND UPLIFT LOAD PATH IN ACCORDANCE WITH METHOD 3 OF SECTION R60235 OF THE 2018 NCRC.





芷 Floor  $\sigma$ . Z



8CALE: 22x34 1/4"+1"-@" 1kl1 1/8"+1"-@" PROJECT 5 528-06Rs 26592

CHECKED BY: BCP

REFER TO COVER SHEET FOR A COMPLETE LIST OF REVISIONS

S4.0

TRUSS UPLIFT CONNECTOR SCHEDULE				
MAX, UPLIFT	ROOF TO WALL	FLOOR TO FLOOR	FLOOR TO FND	
600 LBS	H2.5A	PER WALL SHEATHIN	G 4 FASTENERS	
1200 LBS	(2) H2.5A	C516 (END = 11")	DTT2Z	
145Ø LBS	HT52Ø	CSI6 (END = 11")	DTT2Z	
2000 LBS	(2) MT52Ø	(2) CSI6 (END = 11")	DTT2Z	
2900 LBS	(2) HT52Ø	(2) CSI6 (END = II")	HTT4	
3685 LBS	LGT3-9D62.5	MSTC52	HTT4	

I. ALL PRODUCTS LISTED ARE SIMPSON STRONG-TIE. EQUIVALENT PRODUCTS MAY BE USED PER MANUFACTURER'S SPECIFICATIONS. 2. UPLIFT VALUES LISTED ARE FOR 5/TP 12 GRADE MEMBERS.
3. REFER TO TRUSS LAYOUT PER MANUF. FOR UPLIFT VALUES AND TRUSS TO TRUSS CONNECTIONS. CONNECTORS SPECIFIED BY TRUSS MANUFACTURER OVERRIDE THOSE LISTED ABOVE.
4. CONTACT SUMMIT FOR REQUIRED CONNECTORS WHEN LOADS EXCEED THOSE LISTED ABOVE.

NOTE: 15T PLY OF ALL SHOWN GIRDER TRUSSES TO ALIGN WITH INSIDE FACE OF WALL (TYP, UNO)

NOTE: ROOF TRUSSES SHALL BE SPACED TO SUPPORT FALSE FRAMED DORMER WALLS (TYP, UNO)

REFER TO DETAIL 5/D3F FOR EYEBROW, RETURN OR SHED ROOF FRAMING REQUIREMENTS (TYP FOR ROOFS PROTRUDING MAXIMUM 24" FROM STRUCTURE)

NOTE: TRUSS UPLIFI LOADS SHALL BE DETERMINED PER TRUSS MANUFACTURER IN ACCORDANCE WITH SECTION REØ2!!!!! WALL SHEATHING AND FASTENERS HAVE BEEN DESIGNED TO RESIST THE WIND UPLIFIT LOAD PATH IN ACCORDANCE WITH METHOD 3 OF SECTION R6Ø235 OF THE 2018 NCRC. REFER TO BRACED WALL PLANS FOR SHEATHING AND FASTENER REQUIREMENTS.


THESE PLANS ARE DESIGNED IN ACCORDANCE WITH ARCHITECTURAL PLANS PROVIDED BY <u>DR HORTON</u>
COMPLETED/REVISED ON <u>SIMBLE</u> IT IS THE RESPONSIBILITY OF THE CLIENT TO NOTIFY SUMMIT ENGINEERING, LABORATORY & TESTING, P.C. IF ANY CHANGES ARE MADE TO THE ARCHITECTURAL PLANS PRIOR TO CONSTRUCTION. SUMMIT ENGINEERING, LABORATORY & TESTING. TESTING, P.C. CANNOT GLIARANTEE THE ADEQUACY OF THESE STRUCTURAL PLANS WHEN USED WITH ARCHITECTURAL PLANS DATED DIFFERENTLY THAN THE DATE LISTED ABOVE.

## STRUCTURAL MEMBERS ONLY

ENGINEERING SEAL APPLIES ONLY TO STRUCTURAL COMPONENTS ON THIS DOCUMENT, SEAL DOES NOT INCLUDE CONSTRUCTION MEANS, METHODS, TECHNIQUES, SEQUENCES, PROCEDURES OR SAFETY PRECAUTIONS. ANY DEVIATIONS OR DISCREPANCIES ON PLANS ARE TO BE BROUGHT TO THE IMMEDIATE ATTENTION OF STRUCKER PROCEDURED, LARDAGORY & TESTING D.C. SUMMIT ENGINEERING, LABORATORY & TESTING, P.C. FAILURE TO DO SO WILL VOID SUMMIT LIABILITY.

STRUCTURAL ANALYSIS BASED ON 2018 NCRC.

ROOF FRAMING PLAN SCALE: 1/4"=1"-@" ON 22"x34" OR 1/8"=1"-@" ON 11"x11"

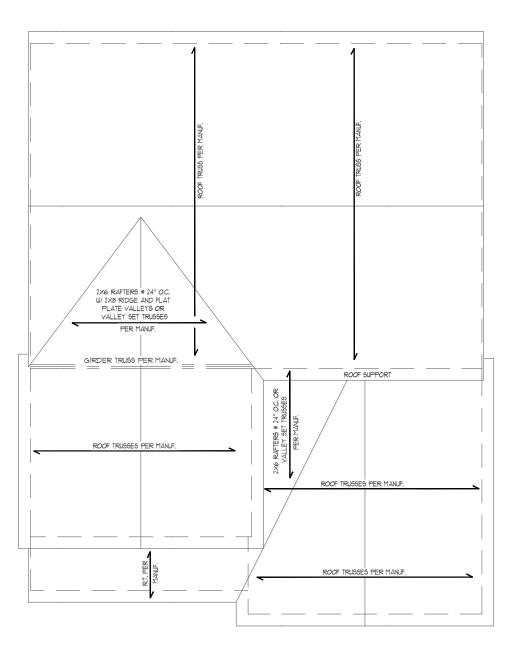

ROOF FRAMING PLAN - ELEVATION C







DATE: 10/5/20 8CALE: 22x34 1/4"+1"-@" 1kl1 1/8"+1"-@"

PROJECT % 528-06R: 26592R CHECKED BY: BCP

REFER TO COVER SHEET FOR A COMPLETE LIST OF REVISIONS

S5.2

Applicable Building Codes:

• 2018 North Carolina Residential Building Code with All Local Amendments

• ASCE 7-10: Minimum Design Loads for Buildings and Other Structures

9" -	ougos.		
٦.	Roof	Live Loads	
	1.1.	Conventional 2x	2Ø PSF
	1.2.	Trus <b>s</b>	2Ø PSF
		12.1. Attic Truss	60 PSF
2.	Roof	Dead Loads	
	2.1.	Conventional 2x	10 PSF
	2.2.	Truse	2Ø PSF
3.	Snow		15 PSF
	3.1.	Importance Factor	lø
4.	Floor	Live Loads	
	4.1.	Typ. Dwelling	40 PSF
		Sleeping Areas	
		Decks	
	4.4.	Passenger Garage	50 PSF

5. Floor Dead Loads
5.I. Conventional 2x ... 5.2 I-Joist

6.l. Exposure ..... 62. Importance Factor... 63. Wind Base Shear

6.3.l. Vx =

632. Vy = T. Component and Cladding (in PSF)

MEAN ROOF HT.	UP T <b>Ø</b> 3Ø'	<b>3</b> Ø'I"-35'	35'1"-40'	40'1"-45'
ZONE 1	16.7,-18.0	17.5,-18.9	18.2,-19.6	18.7,-20.2
ZONE 2	16.7,-21.0	17.5,-22.1	18.2,-22.9	18.7,-23.5
ZONE 3	16.7,-21.0	17.5,-22.1	18.2,-22.9	18.7,-23.5
ZONE 4	18.2,-19.0	19.2,-20.0	19.9,-2 <b>Ø</b> .7	20.4,-21.3
ZONE 5	18.2,-24.0	19.2,-25.2	19.9,-26.1	20.4,-26.9

Seismic Use Group ...

8.5. Spectral Response Acceleration 85.1. Sms = %g 85.2. Sml = %g 8.6. Seismic Base Shear

861.Vx = 862.Vy = 8.1. Basic Structural System (check one)

⊠ Bearing Wall ☐ Building Frame
☐ Moment Frame □ Dual w/ Special Moment Frame

□ Dual w/ Intermediate R/C or Special Steel
□ Inverted Pendulum

8.8. Arch/Mech Components Anchored 8.9. Lateral Design Control: Seismic 🗆 llind 🖂 9. Assumed Soil Bearing Capacity ...

#### STRUCTURAL PLANS PREPARED FOR

## STANDARD DETAILS

PROJECT ADDRESS:

OUNER: DR Horton Carolinas Division

ARCHITECT/DESIGNER

These drawings are to be coordinated with the architectural, mechanical, plumbing, electrical, and civil drawings. This coordination is not the responsibility of the structural engineering of recoord (SER, Should any cliarcepancies become apparent, the contractor shall notify SUMMIT Engineering, Laboratory 4 Testing, P.C. before construction begins.

## PLAN ABBREVIATIONS:

AB	ANCHOR BOLT	PT	PRESSURE TREATED
AFF	ABOVE FINISHED FLOOR	RS	ROOF SUPPORT
CJ	CEILING JOIST	5C	STUD COLUMN
CLR	CLEAR	SJ	SINGLE JOIST
Dυ	DOUBLE JOIST	SPF	SPRUCE PINE FIR
DSP	DOUBLE STUD POCKET	SST	SIMPSON STRONG-TIE
EE	EACH END	SYP	SOUTHERN YELLOW PINE
EW	EACH WAY	TJ	TRIPLE JOIST
NTS	NOT TO SCALE	TSP	TRIPLE STUD POCKET
ОC	ON CENTER	TYP	TYPICAL
P <b>S</b> F	POUNDS PER SQUARE FOOT	UNO	UNLESS NOTED OTHERWISE
₽91	POUNDS PER SQUARE INCH	WWF	WELDED WIRE FABRIC

Roof truss and floor joist layouts, and their corresponding loading details, were not provided to SUMMIT Engineering, Laboratory 4 Testing, P.C. (SUMMIT) prior to the initial design. Therefore, truss and joist directions were assumed based on the information provided by <u>DR Horton. Inc.</u> Subsequent plan revisions based on roof truss and floor joist layouts shall be noted in the revision list, indicating the date the layouts were provided. Should any discrepancies become apparent, the contractor shall notify **5U**1111 immediately.

## SHEET LIST:

REVISION LIST:

Date

FIII

T |2 |T

3 2.15.18

4 228.18

5 12.19.18

6 2.19.19

8 3.6.19

9 3220

Project No.

Revision

ôheet Nø.	Description	
CSI	Cover Sheet, Specifications, Revisions	
Dlm	Monolithic Slab Foundation Details	
Dls	Stem Wall Foundation Details	
Dlc	Crawl Space Foundation Details	
Dlb	Basement Foundation Details	
DIf	Framing Details	

## DR HORTON PROJECT SIGN-OFF:

Manager	Signature
Operations	
Operations System	
Operations Product Development	

## SÜMMIT



#### GENERAL STRUCTURAL NOTES:

- NERAL STRUCTURAL NOTES:

  The design professional whose seal appears on these drawings is the structural engineer of record (SER) for this project. The SER bears the responsibility of the primary structural elements and the performance of this structure. No other party may revise, after, or delete any structural aspects of these construction documents without written permission of SUMMIT Engineering, Laboratory & Testing, P.C. (SUMMIT) or the SER. For the surposes of these construction documents the SER and SUMMIT. purposes of these construction documents the SER and SUMMIT
- shall be considered the same entity.

  The structure is only stable in its completed form. The contractor shall provide all required temporary bracing during construction
- to stabilize the structure.

  The SER is not responsible for construction sequences, methods, or techniques in connection with the construction of this structure. The SER will not be held responsible for the contractor's failure to conform to the contract documents
- should any non-conformities occur.

  Any structural elements or details not fully developed on the construction drawings shall be completed under the direction of a licensed professional engineer. These shop drawings shall be submitted to SUMMIT for review before any construction begins. The shop drawings will be reviewed for overall compliance as it relates to the structural design of this project. Verification of the shop drawings for dimensions, or for actual field conditions,
- the shop drawings for dimensions, or for actual field conditions, is not the responsibility of the SER or 91/mill. Verification of assumed field conditions is not the responsibility of the SER. The contractor shall verify the field conditions for accuracy and report any discrepancies to 91/mill before construction begins.

  The SER is not responsible for any secondary structural elements or non-structural elements, except for the elements specifically noted to the structural drawings.
- noted on the structural drawings.

  This structure and all construction shall conform to all
- applicable sections of the international residential code. This structure and all construction shall conform to all applicable sections of local building codes.
   All structural assemblies are to meet or exceed to requirements.
- of the current local building code.

## FOUNDATIONS:

The structural engineer has not performed a subsurface investigation. Verification of this assumed value is the responsibility of the owner or the contractor. Should any adverse soil condition be encountered the SER must be

- 2. The bottom of all footings shall extend below the frost line for the region in which the structure is to be constructed. However, the bottom of all footings shall be a minimum of 12" below grade.
- maximum dry density.

  5. Excavations of footings shall be lined temporarily with a 6 mill polyetylene memorane if placement of concrete does not occur within 24 hours of excavation.

- with the American Institute of Steel Construction "Code of Standard Practice for Steel Buildings and Bridges" and the manual of Steel Construction "Load Resistance Factor Design latest editions.
  Structural steel shall receive one coat of shop applied
- rust-inhibitive paint.

  3. All steel shall have a minimum yield stress  $(F_u)$  of 36 kg unless
- otherwise noted

- Number IE.

  Concrete shall have a normal weight aggregate and a minimum compressive strength (fe/ at 28 days of 3000 ps), unless otherwise noted on the plan.

  Concrete shall be proportioned, mixed, and placed in
- Requirements for Reinforced Concrete" and ACI 301: "Specifications for Structural Concrete for Buildings".
- Air entrained concrete must be used for all structural elements exposed to freeze/thaw cycles and deicing chemicals. Air entrainment amounts (in percent) shall be within -1% to +2% of target values as follows:
  - 3.1. Footings: 5% 3.2. Exterior Slabs: 5%
- 4. No admixtures shall be added to any structural concrete without written permission of the SER.

- Construction" Any fill shall be placed under the direction or recomme
- of a licensed professional engineer.
  The resulting earl shall be compacted to a minimum of 95%
- No concrete shall be placed against any subgrade containing water, ice, frost, or loose material.

- STRUCTURAL STEEL:

  1. Structural steel shall be fabricated and erected in accordance

- Welding shall conform to the latest edition of the American weraing shall common to the latest edition of the American Welding Society's Structural Welding Code AUS DIJ. Electrodes for shop and field welding shall be class ETØXX. All welding shall be performed by a certified welder per the above

- accordance with the latest editions of ACI 318: "Building Code

- Concrete slabs-on-grade shall be constructed in accordance with ACI 302.IR-96: "Guide for Concrete Slab and Slab
  - The concrete slab-on-grade has been designed using a subgrade modulus of k=250 pci and a design loading of 200 psf. The SER is not responsible for differential settlement, slab cracking or other future defects resulting from urreported conditions not in accordance with the above assumptions. Control or solu cut joints shall be spaced in interior slabs-on-grade at a maximum of 15-01 O.C. and in exterior
  - slabs-on-grade at a maximum of  $|\mathcal{O}|$  unless otherwise noted. Control or saw cut joints shall be produced using conventional process within 4 to 12 hours after the slab has been finished
  - process within 4 to 12 hours after the state has been has been intered.

    9. Reinforcing steel may extend through a control joint.

    Reinforcing steel may extend through a saw cut joint.

    10. All welded wire fabric (www.) for concrete slabs-on-grade shall be placed at mid-depth of slab. The WWW. shall be securely supported during the concrete pour.

- CONCRETE REINFORCEMENT:

  I. Fibrous concrete reinforcement, or fibermesh, specified in concrete slabs-on-grade may be used for control of cracking due to shrinkage and thermal expansion/contraction lowered water migration, an increase in impact capacity, increased abrasion resistance, and residual strength.
- Fibermesh reinforcing to be 100% virgin polypropylene fibers containing no reprocessed olefin materials and specifically manufactured for use as concrete secondary reinforcement.
- Application of fibermesh per cubic yard of concrete shall equal a minimum of 0,1% by volume (15 pounds per cubic yard) Fibermesh shall comply with ASTM CIII6, any local building code requirements, and shall meet or exceed the current industry
- standard.
  Steel reinforcing bars shall be new billet steel conforming to
- of the inferior of the state of size/spacing as the horizontal reinforcement with a class B
  - Lap reinforcement as required, a minimum of 40 bar diameters for tension or compression unless otherwise noted. Splices in masonry shall be a minimum of 48 bar diameters.

- 9. Where reinforcing dowels are required, they shall be equivalent in size and spacing to the vertical reinforcement. The dowel shall extend 48 bar diameters vertically and 20 bar diameters
- into the Footing.

  10. Where reinforcing steel is required vertically, dowels shall be provided unless otherwise nated. WOOD FRAMING: Solid sawn wood framing members shall conform to the specifications listed in the latest edition of the "National" Design Specification for Wood Construction" (NDS), Unless
- otherwise noted, all wood framing members are designed to be Spruce-Yellow-Pise (SYP) 12.

  LVL or PSL engineered wood shall have the following minimum
  - sign values: 2.1. E = 1,900,000 psi
  - 2.2. F<sub>b</sub> = 2600 psi 2.3. F<sub>v</sub> = 285 psi 2.4.Fc = 100 psi
- 1.4.1°C incorption blood in contract, masonry, or earth shall be pressure treated in accordance with AWPA standard C-15. All other moisture exposed wood shall be treated in accordance with AWPA standard C-2
- Nails shall be common wire nails unless otherwise noted.

  Lag screws shall confrom to ANSI/ASME standard Bi82.1-1981.

  Lead holes for lag screws shall be in accordance with NDS specification.
- specifications All beams shall have full bearing on supporting framing members
- unless otherwise noted. Exterior and load bearing stud walls are to be 2x4 SYP  $^{\circ}$ 2 = 16" O.C. unless otherwise noted. Studs shall be continuous from the sole plate to the double top plate. Studs shall only be discontinuous at headers for window/door openings. A minimum of one king stud shall be placed at each end of the header.
- of one king stud shall be placed at each end of the header. King stude shall be continuous, individual stude forming a column shall be attached with one lod nail e 6" O.C. staggered. The stud column shall be continuous to the foundation or beam. The column shall be properly blocked at all floor levels to ensure proper load transfer. Multi-ply beams shall have each ply attached with (3) lod nails e
- 10. Flitch beams, 4-ply beams and 3-ply side loaded beams shall be bolted together with (2) rous of 1/2" diameter through boilts staggered # 16" O.C. unless noted otherwise. Min. edge distance shall be 2" and (2) bolts shall be located a min. 6" from each

## WOOD TRUSSES:

The wood truss manufacturer/fabricator is responsible for the design of the wood trusses. Submit sealed shop drawings and supporting calculations to the SER for review prior to fabrication. The SER shall have a minimum of five (5) days for review. The review by the SER shall review for overall compliance with the design documents. The SER shall assume no responsibility for the correctness for the structural design for the wood trusses.

The wood trusses shall be designed for all required loadings.

dded box bay detail (2/D2f). Added deck

stem wall and crawl space foundations

Revised garage door detail, NC only

Added high-wind foundation details

Revised per Mecklenburg County Comments Revised stem wall deck attachment and roo

Corrected dimensions at perimeter footings

Revised stem wall insulation note

Revised per 2018 NCRC

sheathing on wall sections.

Added tall turndown detail

options with basement. Revised deck options with

- In a wood trusses shall be designed for all required loadings as specified in the local building code, the AGCE Standard "Minimum Design Loads for Buildings and Other Structures."

  (ASCE 1-05), and the loading requirements shown on these specifications. The truss drawings shall be coordinated with all other construction documents and provisions provided for loads shown on these drawings including but not limited to HVAC equipment, piping, and architectural fixtures attached to
- the trusses shall be designed, fabricated, and erected in accordance with the latest edition of the "National Design Specification for Wood Construction" (NDS) and "Design Specification for Metal Plate Connected Wood Trusses."
- The truss manufacturer shall provide adequate bracing information in accordance with "Commentary and Recommendations for Handling, Installing, and Bracing Metal Plate Connected Wood Trusses" (HIB-91). This bracing, both temporary and permanent, shall be shown on the shop drawings.

  Also, the shop drawings shall show the required attachments for
- the trusses.

  Any chords or truss webs shown on these drawings have been shown as a reference only. The final design of the trusses shall be per the manufacturer

## EXTERIOR WOOD FRAMED DECKS:

Decks are to be framed in accordance with local building codes and as referenced on the structural plans, either through code references or construction details.

- WOOD STRUCTURAL PANELS:

  I. Fabrication and placement of structural wood sheathing shall be in accordance with the APA Design/Construction Guide "Residential and Commercial," and all other applicable APA
- All structurally required wood sheathing shall bear the mark of

- 3. Wood wall sheathing shall comply with the requirements of local building codes for the appropriate state as indicated on these drawings. Refer to wall bracing notes in plan set for more information. Sheathing shall be applied with the long direction perpendicular to framing, unless noted otherwise. Roof sheathing shall be APA rated sheathing exposure I or 2.
- Roof sheathing shall be continuous over two supports and attached to its supporting roof framing with (1)-8d CC nail at 6"o/c at panel edges and at 12"o/c in panel field unless otherwise noted on the plans. Sheathing shall be applied with the long direction perpendicular to framing. Sheathing shall have a span rating consistent with the framing spacing. Use
- have a span rating consistent with the framing spacing, Use suitable edge support by use of plywood clips or limber blocking unless otherwise noted. Panel end joints shall occur over framing. Apply building paper over the sheathing as required by the state Building Code. Wood floor sheathing shall be APA rated sheathing exposure I or 2. Attach sheathing to its supporting framing with (I)-Bd CC ringshark nail at 6 lore at panel edges and at 12 lore in panel field unless otherwise noted on the plans. Sheathing shall be applied perpendicular to framing, Sheathing shall have a span rating consistent with the framing spacing. Use suitable edge support by use of 14G plywood or lumber blocking unless otherwise noted. Panel end joints shall occur over framing. Apply building paper over the sheathing as required by the state Building Code.
- state Building Code.

  Sheathing shall have a 1/8" gap at panel ends and edges as recommended in accordance with the APA.

- STRUCTURAL FIBERBOARD PANELS:

  1. Fabrication and placement of structural fiberboard sheathing shall be in accordance with the applicable AFA standards
- All structurally required fiberboard sheathing shall bear the mark of the AFA. 3. Fiberboard wall sheathing shall comply with the requirements of local building codes for the appropriate state as indicated on these drawings. Refer to wall bracing notes in plan set for more
- Sheathing shall have a 1/8" gap at panel ends and edges are

PROJECT:
Standard Details
Coversheet TH CARO USBA1 4/2


STRUCTURAL MEMBERS ONLY


DATE: 3/2/2 8CALE: 22x34 V4"+1"-8" lbdT V8"+1"-8" PROJECT 1 P-19Ø1-1Ø DRAWN BY: LAG

CHECKED BY: WAJ

REFER TO COVER SHEET FOR A COMPLETE LIST OF REVISIONS



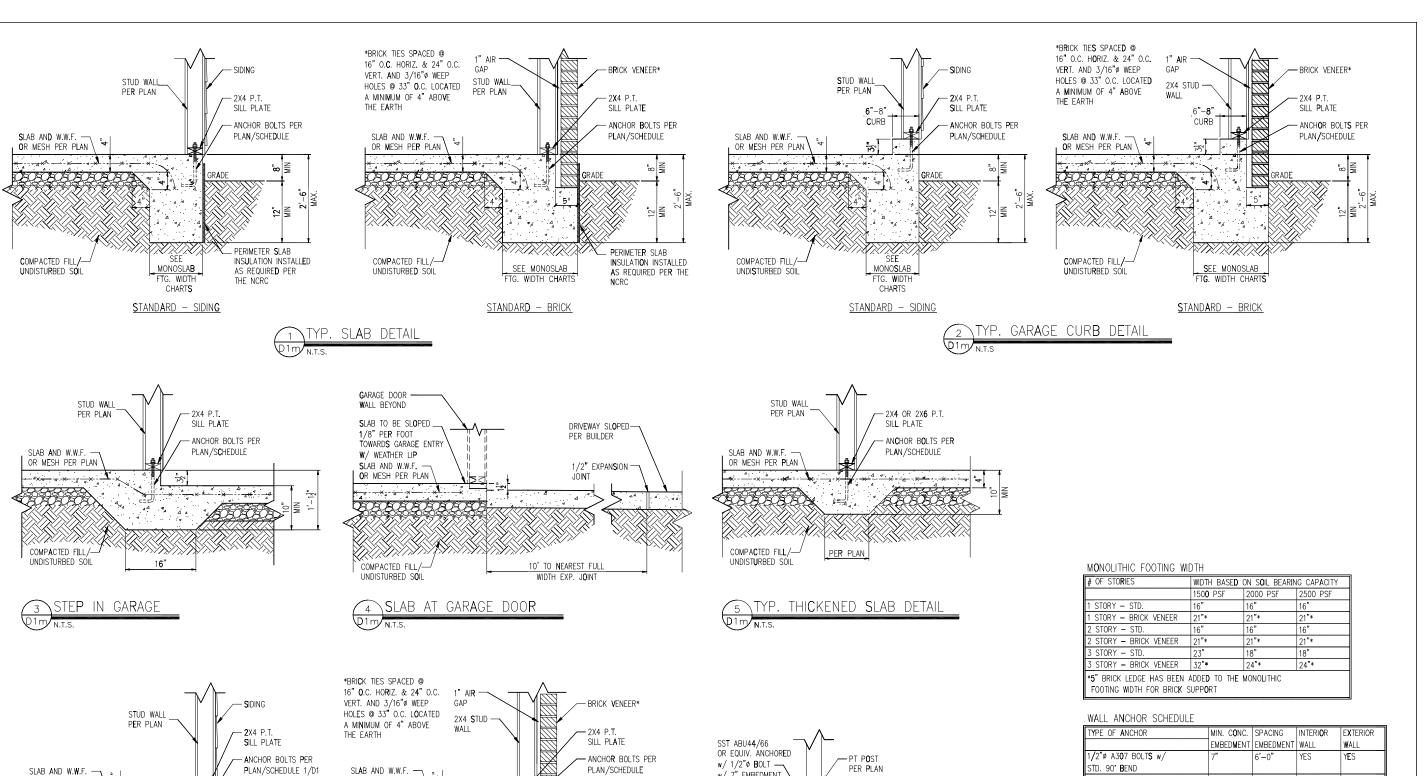

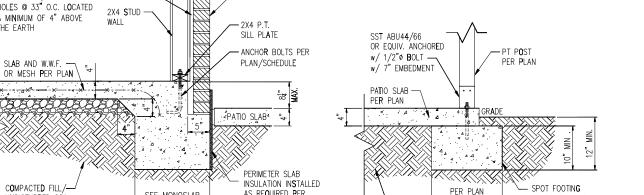

AS REQUIRED PER

THE NCRC

<u>STANDARD - BRICK</u>

SEE MONOSLAB

FTG. WIDTH CHARTS

PATIO SLAB DETAIL

UNDISTURBED SOIL

- PATIO SLAB⁴

SEE

MONOSI AF

FTG WIDTH

CHARTS

STANDARD - SIDING

- PERIMETER SLAB

THE NCRC

I**n**sulati**o**n inst**a**lled

AS REQUIRED PER

OR MESH PER PLAN

COMPACTED FILL/-

UNDISTURBED SOIL

6A COVERED PATIO DETAIL

- COMPACTED FILL/

UNDISTURBED SOIL

OR CONTINUOUS

LUG FOOTING PER PLAN

_	WALL ANGION SOFILBULL				
	TYPE OF ANCHOR	MIN. CONC.	SPACING	INTERI <b>O</b> R	EXTERIOR
I		EMBED <b>M</b> ENT	EMBEDMENT	WALL	WALL
I	1/2"ø A3 <b>0</b> 7 BOLT <b>S</b> w/	7"	6'-0"	YES	YES
	STD. 90° BEND				
ı	S\$T - MAS	4"	5'-0"	NO	YES
ı	HILTI KWIK BOLT KBI 1/2-2-3/4	2-1/4"	6'-0"	YES	NO
ı	1/2"ø HILTI THREADED ROD	7"	6'-0"	YES	YES
	w/ HIT HY150 ADHESIVE				

NOTE: INSTALL ALL ANCHORS 12" MAX. FROM ALL BOTTOM PLATE ENDS AND JOINTS.

- NOTES: 1. REFER TO GENERAL NOTES & SPECIFICATIONS ON COVERSHEET FOR ADDITIONAL INFORMATION.
- PROVIDE 6 MIL VAPOR BARRIER UNDER ALL SLABS-ON-GRADE.
   SEE ARCH. DWGS. FOR ALL TOP OF THE SLAB ELEVATIONS, SLOPES AND DEPRESSIONS.
- 4. REFER TO STRUCTURAL PLANS AND FRAMING DETAILS FOR BRACED WALL PANEL LAYOUT, DIMENSIONS, ATTACHMENT AND CONNECTIONS
- REFER TO LOCAL AND STATEWIDE CODES FOR ADDITIONAL AMENDMENTS AND REQUIREMENTS NOT SHOWN
- 6. PERIMETER INSULATION SHOWN AS REQUIRED BY LOCAL CLIMATE ZONE. INSTALL PER TABLE N1102.1.2 OF THE 2018 NCRC







Details Foundation Slab PROJECT:
Standard Details


Monolithic \$



DATE: 3/2/2 8CALE: 27x34 1/4"+1"-**8"** 18x1 1/8":1"-**8"** PROJECT & P-19Ø1-1ØR DRAWN BY: LAG CHECKED BY: WAJ

REFER TO COVER SHEET FOR A COMPLETE LIST OF REVISIONS

Dlm

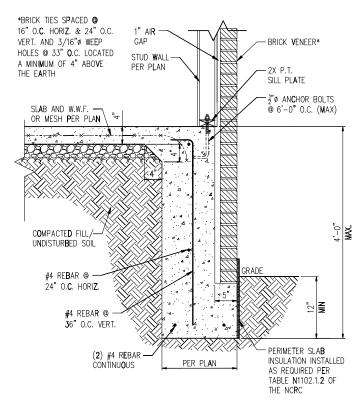

- NOTES:


  1. REFER TO GENERAL NOTES & SPECIFICATIONS ON COVERSHEET FOR ADDITIONAL INFORMATION.
  - PROVIDE 6 MIL VAPOR BARRIER UNDER ALL SLABS-ON-GRADE.
     SEE ARCH. DWGS. FOR ALL TOP OF THE SLAB ELEVATIONS, SLOPES AND DEPRESSIONS.
  - 4. REFER TO STRUCTURAL PLANS AND FRAMING DETAILS FOR BRACED WALL PANEL LAYOUT, DIMENSIONS, ATTACHMENT AND CONNECTIONS
  - 5. REFER TO LOCAL AND STATEWIDE CODES FOR ADDITIONAL AMENDMENTS AND REQUIREMENTS NOT SHOWN
  - 6. PERIMETER INSULATION SHOWN AS REQUIRED BY LOCAL CLIMATE ZONE. INSTALL PER TABLE N1102.1.2 OF THE 2018 NCRC





Details Foundation Slab PROJECT:
Standard Details

Monolithic (

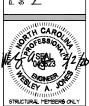


DATE: 3/2/28 8CALE: 22x34 1/4"+1-**6"** lbt1 1/8"+1-**6"** PROJECT 4 P-19Ø1-1Ø

CHECKED BY: WAJ

DRAWN BY: LAG

REFER TO GOVER SHEET FOR A COMPLETE LIST OF REVISIONS

D2m

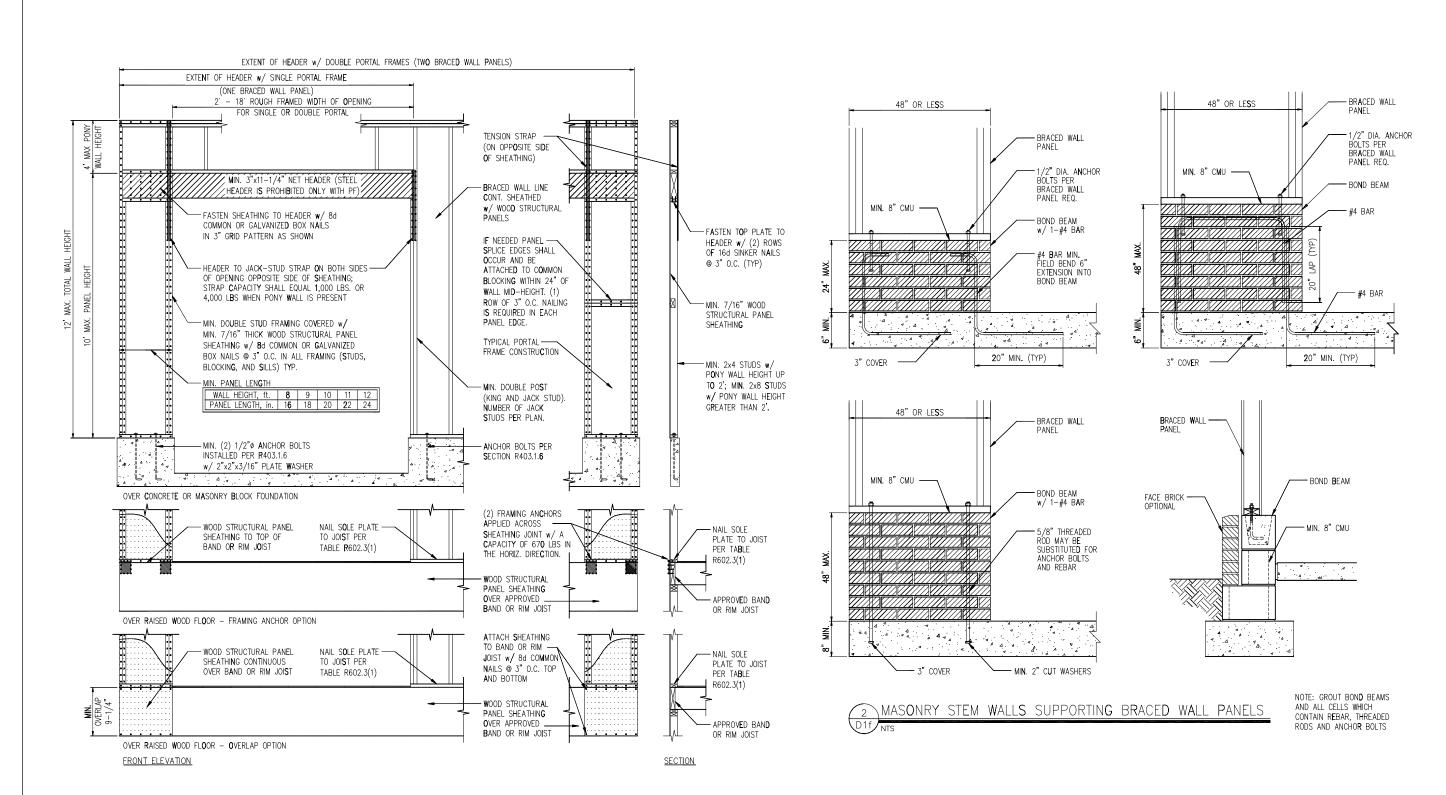



SÜMMIT

SUMMIT Engineering, Laboratory & Testing, P.C.

CLIENT:
DR Horton Carolina Divi
8001 Arrowridge Blvd.
Charlotte, NC 20213




DATE: 3/2/2 8CALE: 22x34 1/4"∗1"-**8"** |bgT 1/8"∗1"-**8"** PROJECT 4 P-19Ø1-1Ø DRAIN BY: LAG CHECKED BY: WAJ

REFER TO GOVER SHEET FOR A COMPLETE LIST OF REVISIONS

D1f

METHOD PF: PORTAL FRAME DETAIL

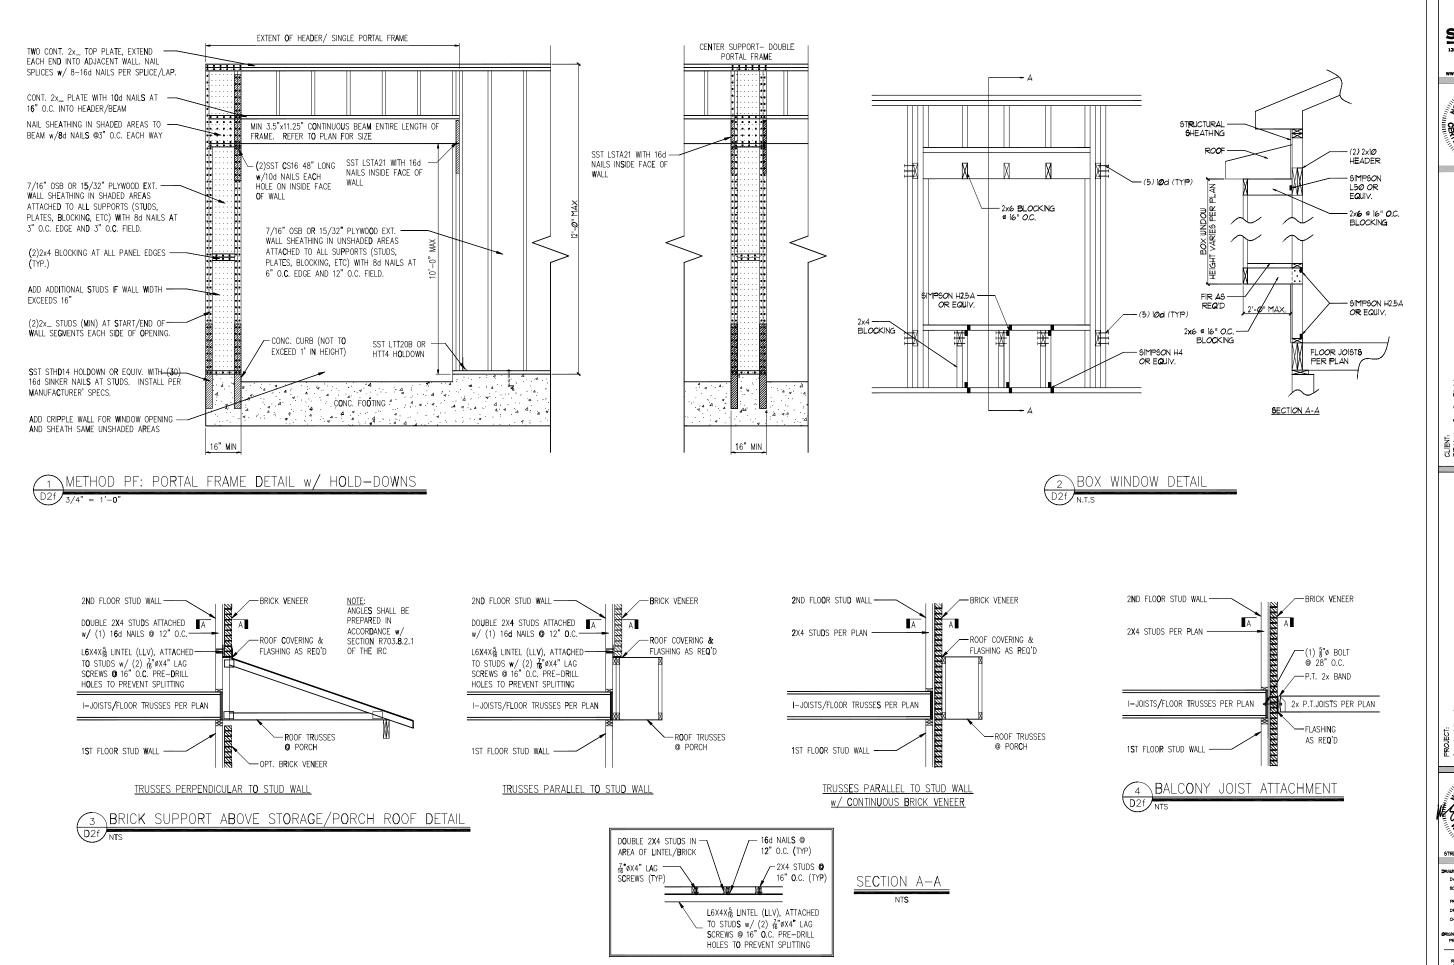

SUMMIT





Detaí PROJECT: Standard Details Framing




STRUCTURAL MEMBERS ONLY DATE: 3/2/2 8CALE: 22x34 1/4"∗1"-**8"** |bgT 1/8"∗1"-**8"** 


PROJECT & P-19Ø1-1ØR DRAWN BY: LAG CHECKED BY: WAJ

REFER TO GOVER SHEET FOR A COMPLETE LIST OF REVISIONS

D2f

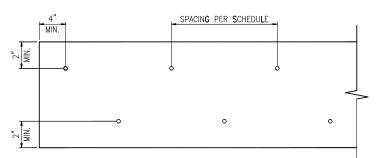

ELEVATION VIEW

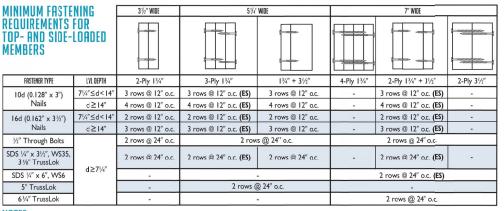

- I.All fasteners must meet the minimum requirements in the table above. Side-loaded multiple-ply members must meet the minimum fastening and side-loading capacity
- requirements given on page 48.

  2. Minimum fastening requirements for depths less than 7½" require special consideration. Please contact your technical representative.

L3x3x1/4"x8-1/2" LONG -

STEEL BEAM -

PER PLAN

COPE END OF STEEL

AS REQ'D TO CLEAR

WEB OF STEEL BEAM

LINTEL BOTH SIDES OF WEB

w/ 13/16" # HOLES @ GAGE

side are to be staggered up to one-hall the o.c. spacing, but maintaining the fastene-clearances above and

(3) if "ES" is referenced, then the fastener schedule must be repeated on each side, with the fasteners on the back side offset up to one-half the o.c. spacing of the front side (whether or not it is staggered).

SECTION VIEW

STEEL BEAM

PER PLAN

- STEEL BEAM PER PLAN

(2) 3/4"ø BOLTS

ÈACH ANGLE LEG

NOTES: 3. Three general rules for staggering or offsetting for a certain fastener schedule:

(1) if staggering or offsetting is not referenced, then none is required;

(2) if staggering is referenced, ther fasteners installed in adjacent rows on the front.

MULTI-PLY BEAM CONNECTION DETAIL


— 10d COMMON NAIL @ 12" O.C.


- SIMPSON C\$16 COIL STRAP OR EQUIV. PER MANUF. SPECIFICATIONS

EACH PLY OR PER CODE


@ 1/3 HEIGHT LOCATIONS

MULTI-PLY STUD CONNECTION DETAIL

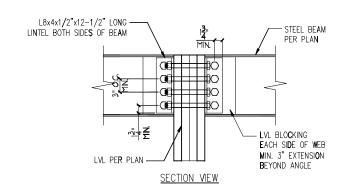

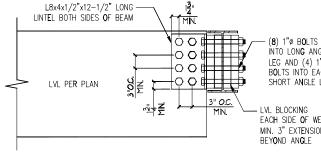


ELEVATION VIEW

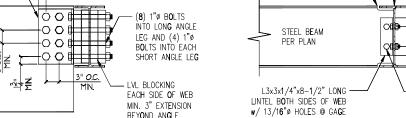





**ELEVATION VIEW** 

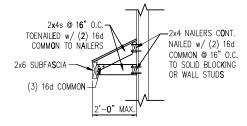

GABLE ROOF RETURN

SÜMMIT

SUMMIT LEDGE OF THE OF T

PROJECT: Standard Details Framing Details




DATE: 3/2/2 8CALE: 22x34 1/4"∗1"-**6"** lbt1 1/8"∗1"-**6"** PROJECT 4 P-1907-10R DRAIIN BY: LAG CHECKED BY: WAJ

REFER TO COVER SHEET FOR A COMPLETE LIST OF REVISIONS

**D**3f

## DR Ho Win 65 Ma

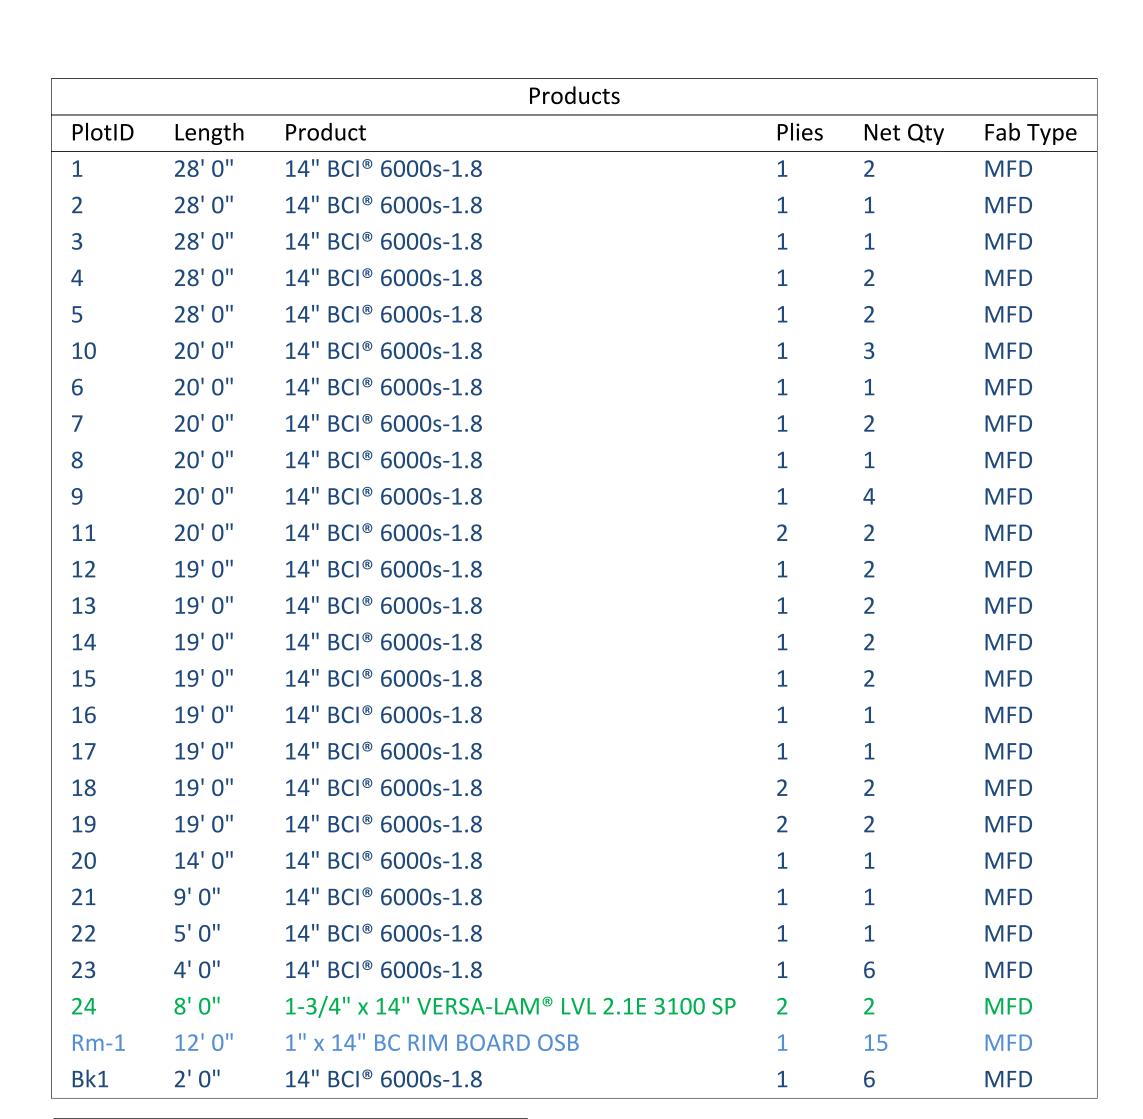

	Connector Summary				
PlotID Qty Manuf Product					
H1	13	Simpson	IUS2.37/14		
H2	1	Simpson	MIU4.75/14		

Start Framing Here
14" BCI 6000's @ 24" oc


Start Framing Here 1'8" 1'73/16" 2'0"

4' 4 1/2"

4' 3 3/4"

F07

BBO

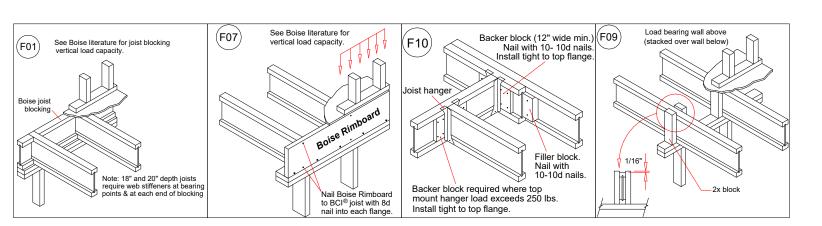

All I-Joist and Versa-Lam Beams Must be Installed per The Boise Cascade Installation Guide!

> Squash Blocks Required Under The Ends Of All LVL And Point Loads For Load Transfer - See Details

	Revisions:
rton Express	
nton Express	
ston Elev.C	
organ North	
organ moren	

ade





DR Horton Express Winston Elev.C 65 Morgan North 84 Lumber EWP

BC FRAMER II

Plan Date: 02282020

Structural Date: 10152020 By: GAT

Sheet: 2/3

Second Floor Layout

(F07)

Rm-1

14

14

13

13

12

12

10' 2 3/4"

F07

