

**PLANS DESIGNED TO THE  
2018 NORTH CAROLINA STATE  
RESIDENTIAL BUILDING CODE**

MEAN ROOF HEIGHT: 19'-9" HEIGHT TO RIDGE: 27'-5"

| CLIMATE ZONE               | ZONE 3A    | ZONE 4A    | ZONE 5A    |
|----------------------------|------------|------------|------------|
| FENESTRATION U-FACTOR      | 0.35       | 0.35       | 0.35       |
| SKYLIGHT U-FACTOR          | 0.55       | 0.55       | 0.55       |
| GLAZED FENESTRATION SHGC   | 0.30       | 0.30       | 0.30       |
| CEILING R-VALUE            | 38 or 30ci | 38 or 30ci | 38 or 30ci |
| WALL R-VALUE               | 15         | 15         | 19         |
| FLOOR R-VALUE              | 19         | 19         | 30         |
| * BASEMENT WALL R-VALUE    | 5/13       | 10/15      | 10/15      |
| ** SLAB R-VALUE            | 0          | 10         | 10         |
| * CRAWL SPACE WALL R-VALUE | 5/13       | 10/15      | 10/15      |

\* 10/13" MEANS R-10 SHEATHING INSULATION OR R-13 CAVITY INSULATION  
\*\* INSULATION DEPTH WITH MONOLITHIC SLAB 24" OR FROM INSPECTION GAP TO BOTTOM OF FOOTING; INSULATION DEPTH WITH STEM WALL SLAB 24" OR TO BOTTOM OF FOUNDATION WALL

DESIGNED FOR WIND SPEED OF 120 MPH, 3 SECOND GUST (93 FASTEST MILE) EXPOSURE "B"

COMPONENT & CLADDING DESIGNED FOR THE FOLLOWING LOADS

| MEAN ROOF | UP TO 30' | 30'-1" TO 35' | 35'-1" TO 40' | 40'-1" TO 45' |
|-----------|-----------|---------------|---------------|---------------|
| ZONE 1    | 14.2      | -15.0         | 14.9          | -15.8         |
| ZONE 2    | 14.2      | -18.0         | 14.9          | -18.9         |
| ZONE 3    | 14.2      | -18.0         | 14.9          | -18.9         |
| ZONE 4    | 15.5      | -16.0         | 16.3          | -16.8         |
| ZONE 5    | 15.5      | -20.0         | 16.3          | -21.0         |

DESIGNED FOR WIND SPEED OF 130 MPH, 3 SECOND GUST (101 FASTEST MILE) EXPOSURE "B"

COMPONENT & CLADDING DESIGNED FOR THE FOLLOWING LOADS

| MEAN ROOF | UP TO 30' | 30'-1" TO 35' | 35'-1" TO 40' | 40'-1" TO 45' |
|-----------|-----------|---------------|---------------|---------------|
| ZONE 1    | 16.7      | -18.0         | 17.5          | -18.9         |
| ZONE 2    | 16.7      | -21.0         | 17.5          | -22.1         |
| ZONE 3    | 16.7      | -21.0         | 17.5          | -22.1         |
| ZONE 4    | 18.2      | -19.0         | 19.1          | -20.0         |
| ZONE 5    | 18.2      | -24.0         | 19.1          | -25.2         |

**GUARD RAIL NOTES**

**SECTION R312**

**R312.1 Where required.** Guards shall be located along open-sided walking surfaces, including stairs, ramps and landings, that are located more than 30 inches (762 mm) measured vertically to the floor or grade below at any point within 36 inches (914 mm) horizontally to the edge of the open side. Insect screening shall not be considered as a guard.

**R312.2 Height.** Required guards at open-sided walking surfaces, including stairs, porches, balconies or landings, shall be not less than 36 inches (914 mm) high measured vertically above the adjacent walking surface, adjacent fixed seating or the line connecting the leading edges of the treads.

**Exceptions:**

1. Guards on the open sides of stairs shall have a height not less than 34 inches (864 mm) measured vertically from a line connecting the leading edges of the treads.

2. Where the top of the guard also serves as a handrail on the open sides of stairs, the top of the guard shall not be not less than 34 inches (864 mm) and not more than 38 inches (965 mm) measured vertically from a line connecting the leading edges of the treads.

**R312.3 Opening limitations.** Required guards shall not have openings from the walking surface to the required guard height which allow passage of a sphere 4 inches (102 mm) in diameter.

**Exceptions:**

1. The triangular openings at the open side of a stair, formed by the riser, tread and bottom rail of a guard, shall not allow passage of a sphere 6 inches (153 mm) in diameter.

2. Guards on the open sides of stairs shall not have openings which allow passage of a sphere 4 3/8 inches (111 mm) in diameter.

**ROOF VENTILATION**

**SECTION R806**

SQUARE FOOTAGE OF ROOF TO BE VENTED = 2,477 SQ.FT.

NET FREE CROSS VENTILATION NEEDED:

WITHOUT 50% TO 80% OF VENTING 3'-0" ABOVE EAVE = 16.51 SQ.FT.


WITH 50% TO 80% OF VENTING 3'-0" ABOVE EAVE; OR WITH CLASS I OR II VAPOR RETARDER ON WARM-IN-WINTER SIDE OF CEILING = 8.26 SQ.FT.

ELECTRICAL: PIONEER ELECTRIC  
PLUMBING: DOUBLE J PLUMBING  
HVAC: MAINSTREAM MECHANICAL

NOTICE TO CONTRACTOR:  
All construction must comply with current NC Building Codes and is subject to field inspection and verification.  
APPROVED  
Local Building Code Review  
Permit holder responsible for field compliance with the code.  
07/27/2021  
Harnett COUNTY NORTH CAROLINA

WILLIAMS FARM  
LOT 1B

3CG/ COVERED PORCH

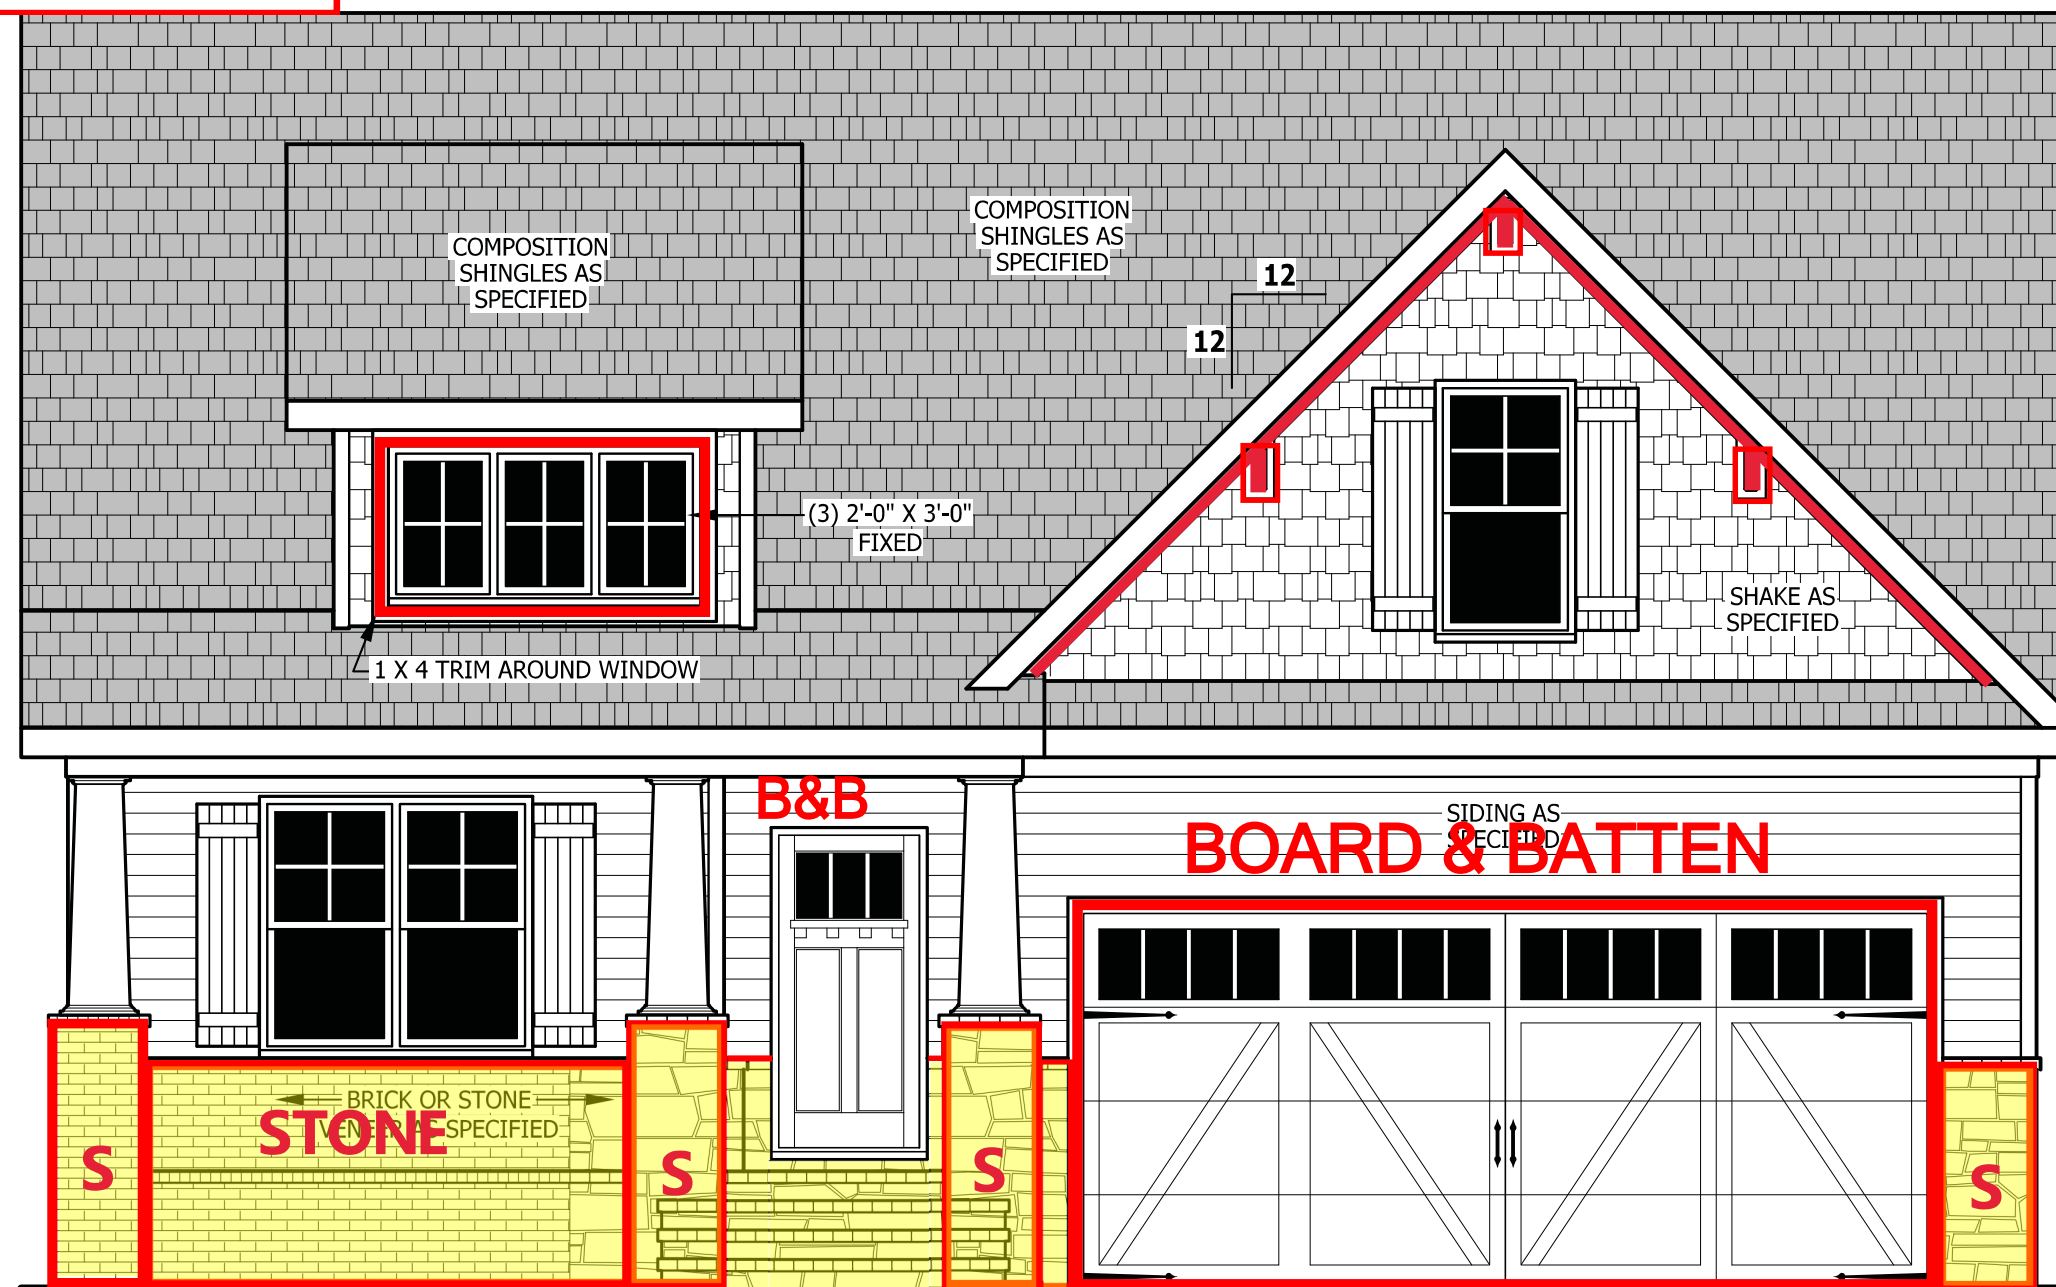

**FRONT ELEVATION - A**

SCALE 1/4" = 1'-0"

**SQUARE FOOTAGE HEATED**

FIRST FLOOR 1791 SQ.FT.  
TOTAL 1791 SQ.FT.

**HEATED OPTIONAL**  
CAROLINA ROOM 148 SQ.FT.  
TOTAL 148 SQ.FT.

**UNHEATED**  
FRONT PORCH 188 SQ.FT.  
GARAGE 469 SQ.FT.  
TOTAL 657 SQ.FT.

**UNHEATED OPTIONAL**  
SCREENED PORCH 160 SQ.FT.  
DECK OR PATIO 108 SQ.FT.  
THIRD GARAGE 292 SQ.FT.  
TOTAL 560 SQ.FT.

**AIR LEAKAGE**

**Section N1102.4**


**N1102.4.1 Building thermal envelope.** The building thermal envelope shall be durably sealed with an air barrier system to limit infiltration. The sealing methods between dissimilar materials shall allow for differential expansion and contraction. For all homes where present, the following shall be caulked, gasketed, weather stripped or otherwise sealed with an air barrier material or solid material consistent with Appendix E-2.4 of this code:

1. Blocking and sealing floor/ceiling systems and under knee walls open to unconditioned or exterior space.
2. Capping and sealing shafts or chases, including flue shafts.
3. Capping and sealing soffit or dropped ceiling areas.



**WINDOWS WITH SIDE LOAD**

SCALE 1/8" = 1'-0"

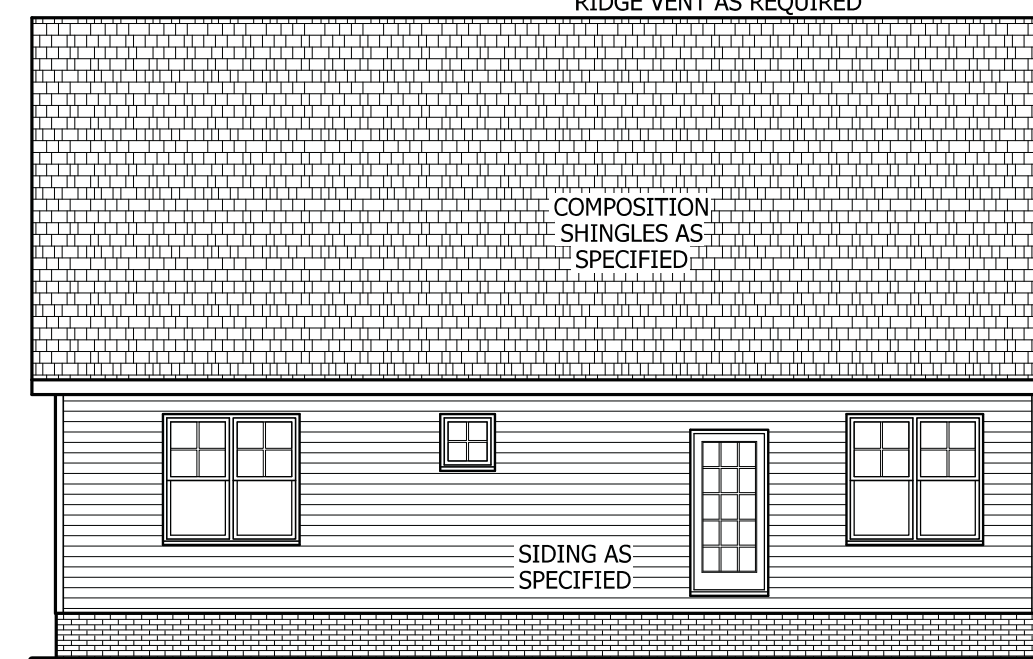


**REAR ELEVATION**

SCALE 1/8" = 1'-0"



**LEFT SIDE ELEVATION**

SCALE 1/8" = 1'-0"

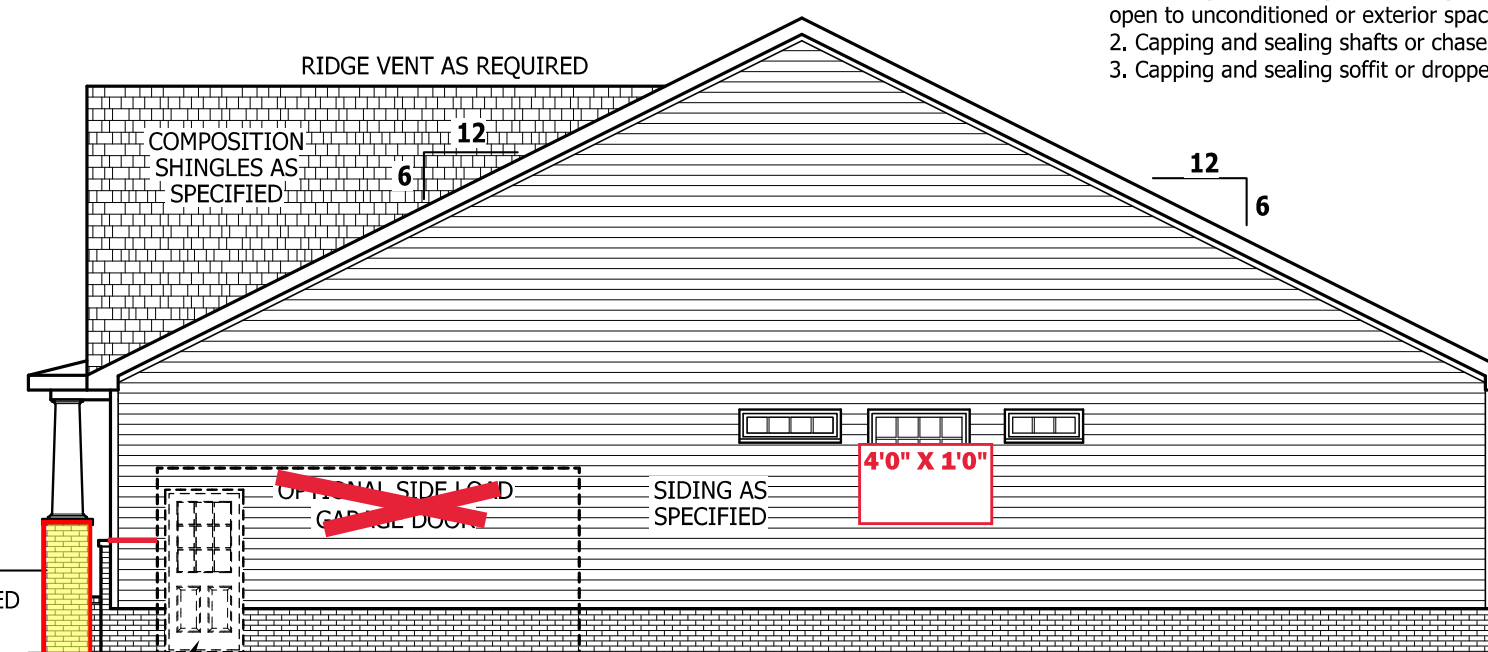

**RIGHT SIDE ELEVATION**

SCALE 1/8" = 1'-0"

PURCHASER MUST VERIFY ALL DIMENSIONS AND CONDITIONS BEFORE CONSTRUCTION BEGINS. HAYNES HOME PLANS, INC. ASSUMES NO LIABILITY FOR CONTRACTOR PRACTICES AND PROCEDURES. CODES AND CONDITIONS MAY VARY WITH LOCATION, A LOCAL DESIGNER, ARCHITECT OR ENGINEER SHOULD BE CONSULTED BEFORE CONSTRUCTION. THESE DRAWING ARE INSTRUMENTS OF SERVICE AND AS SUCH SHALL REMAIN PROPERTY OF THE DESIGNER.

**ELEVATION - A**  
**The Lauren III**

**HAYNES WEAVER HOMES**  
910.630.2100 • 919.606.4696  
350 Wagoner Drive, Fayetteville, NC 28303

**HAYNES HOME PLANS, INC.**  
P.O. Box 702, Wake Forest, NC 27588 919-435-6180 FAX 1-866-491-0396

**SQUARE FOOTAGE HEATED**

|             |             |
|-------------|-------------|
| FIRST FLOOR | 1791 SQ.FT. |
| TOTAL       | 1791 SQ.FT. |

**HEATED OPTIONAL**

|               |            |
|---------------|------------|
| CAROLINA ROOM | 148 SQ.FT. |
| TOTAL         | 148 SQ.FT. |





**UNHEATED**

|             |            |
|-------------|------------|
| FRONT PORCH | 188 SQ.FT. |
| GARAGE      | 469 SQ.FT. |
| TOTAL       | 657 SQ.FT. |

**UNHEATED OPTIONAL**

|                |            |
|----------------|------------|
| SCREENED PORCH | 160 SQ.FT. |
| DECK OR PATIO  | 108 SQ.FT. |
| THIRD GARAGE   | 292 SQ.FT. |
| TOTAL          | 560 SQ.FT. |

© Copyright 2020  
Haynes Home Plans, Inc.  
4/29/2020  
200220B  
PAGE 1 OF 6

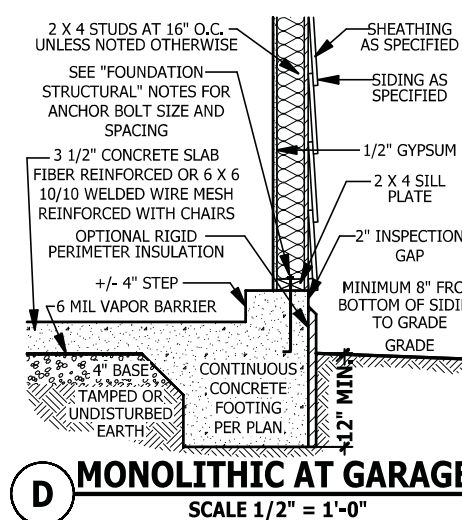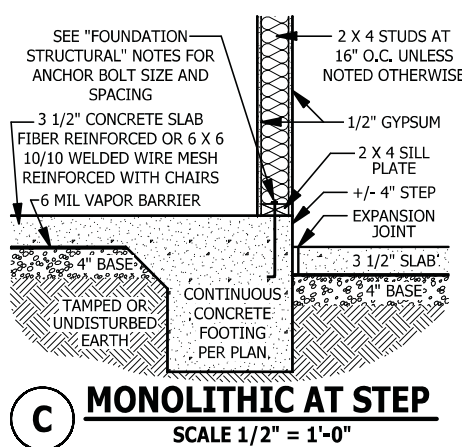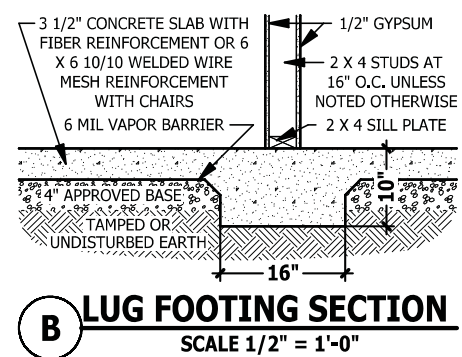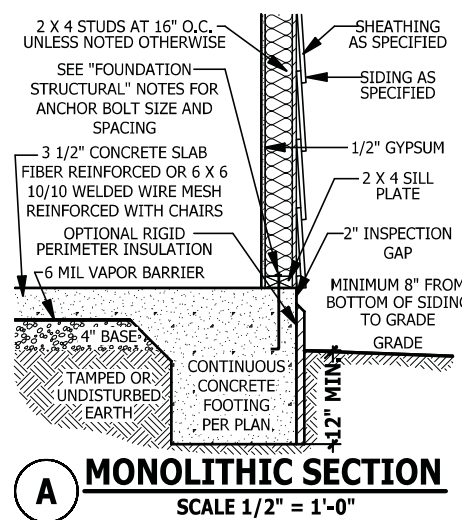


**FOUNDATION STRUCTURAL**

115 to 130 mph wind zone (1 1/2 to 2 1/2 story)  
**CONTINUOUS FOOTING:** 16" wide and 8" thick minimum. 20" wide minimum at brick veneer. Must extend 2" to either side of supported wall.  
**GIRDERS:** (3) 2 X 10 girder unless noted otherwise.  
**PIERS:** 16" X 16" piers with 8" solid masonry cap on 30" X 30" X 10" concrete footing with maximum pier height of 64" with hollow masonry and 160" with solid masonry.  
**POINT LOADS:** ■ designates significant point load and should have solid blocking to pier, girder or foundation wall.  
**115 and 120 MPH ANCHORS BOLTS:** 1/2" diameter anchor bolts embedded minimum 7", maximum 6'-0" on center, within 12" of plate ends, and minimum two anchor bolts per plate.  
**130 MPH ANCHORS BOLTS:** 1/2" diameter anchor bolts embedded minimum 15", maximum 4'-0" on center, within 12" of plate ends, and minimum two anchor bolts per plate.  
**CONCRETE:** Concrete shall have a minimum 28 day strength of 3000 psi and a maximum 5" slump. Air entrained per table 402.2. All concrete shall be in accordance with ACI standards. All samples for pumping shall be taken from the exit end of the pump.  
**SOILS:** Allowable soil bearing pressure assumed to be 2000 PSF. The contractor must contact a geotechnical engineer and a structural engineer if unsatisfactory subsurface conditions are encountered. The surface area adjacent to the foundation wall shall be provided with adequate drainage, and shall be graded so as to drain surface water away from foundation walls.

**MONOLITHIC SLAB PLAN**

SCALE 1/4" = 1'-0"

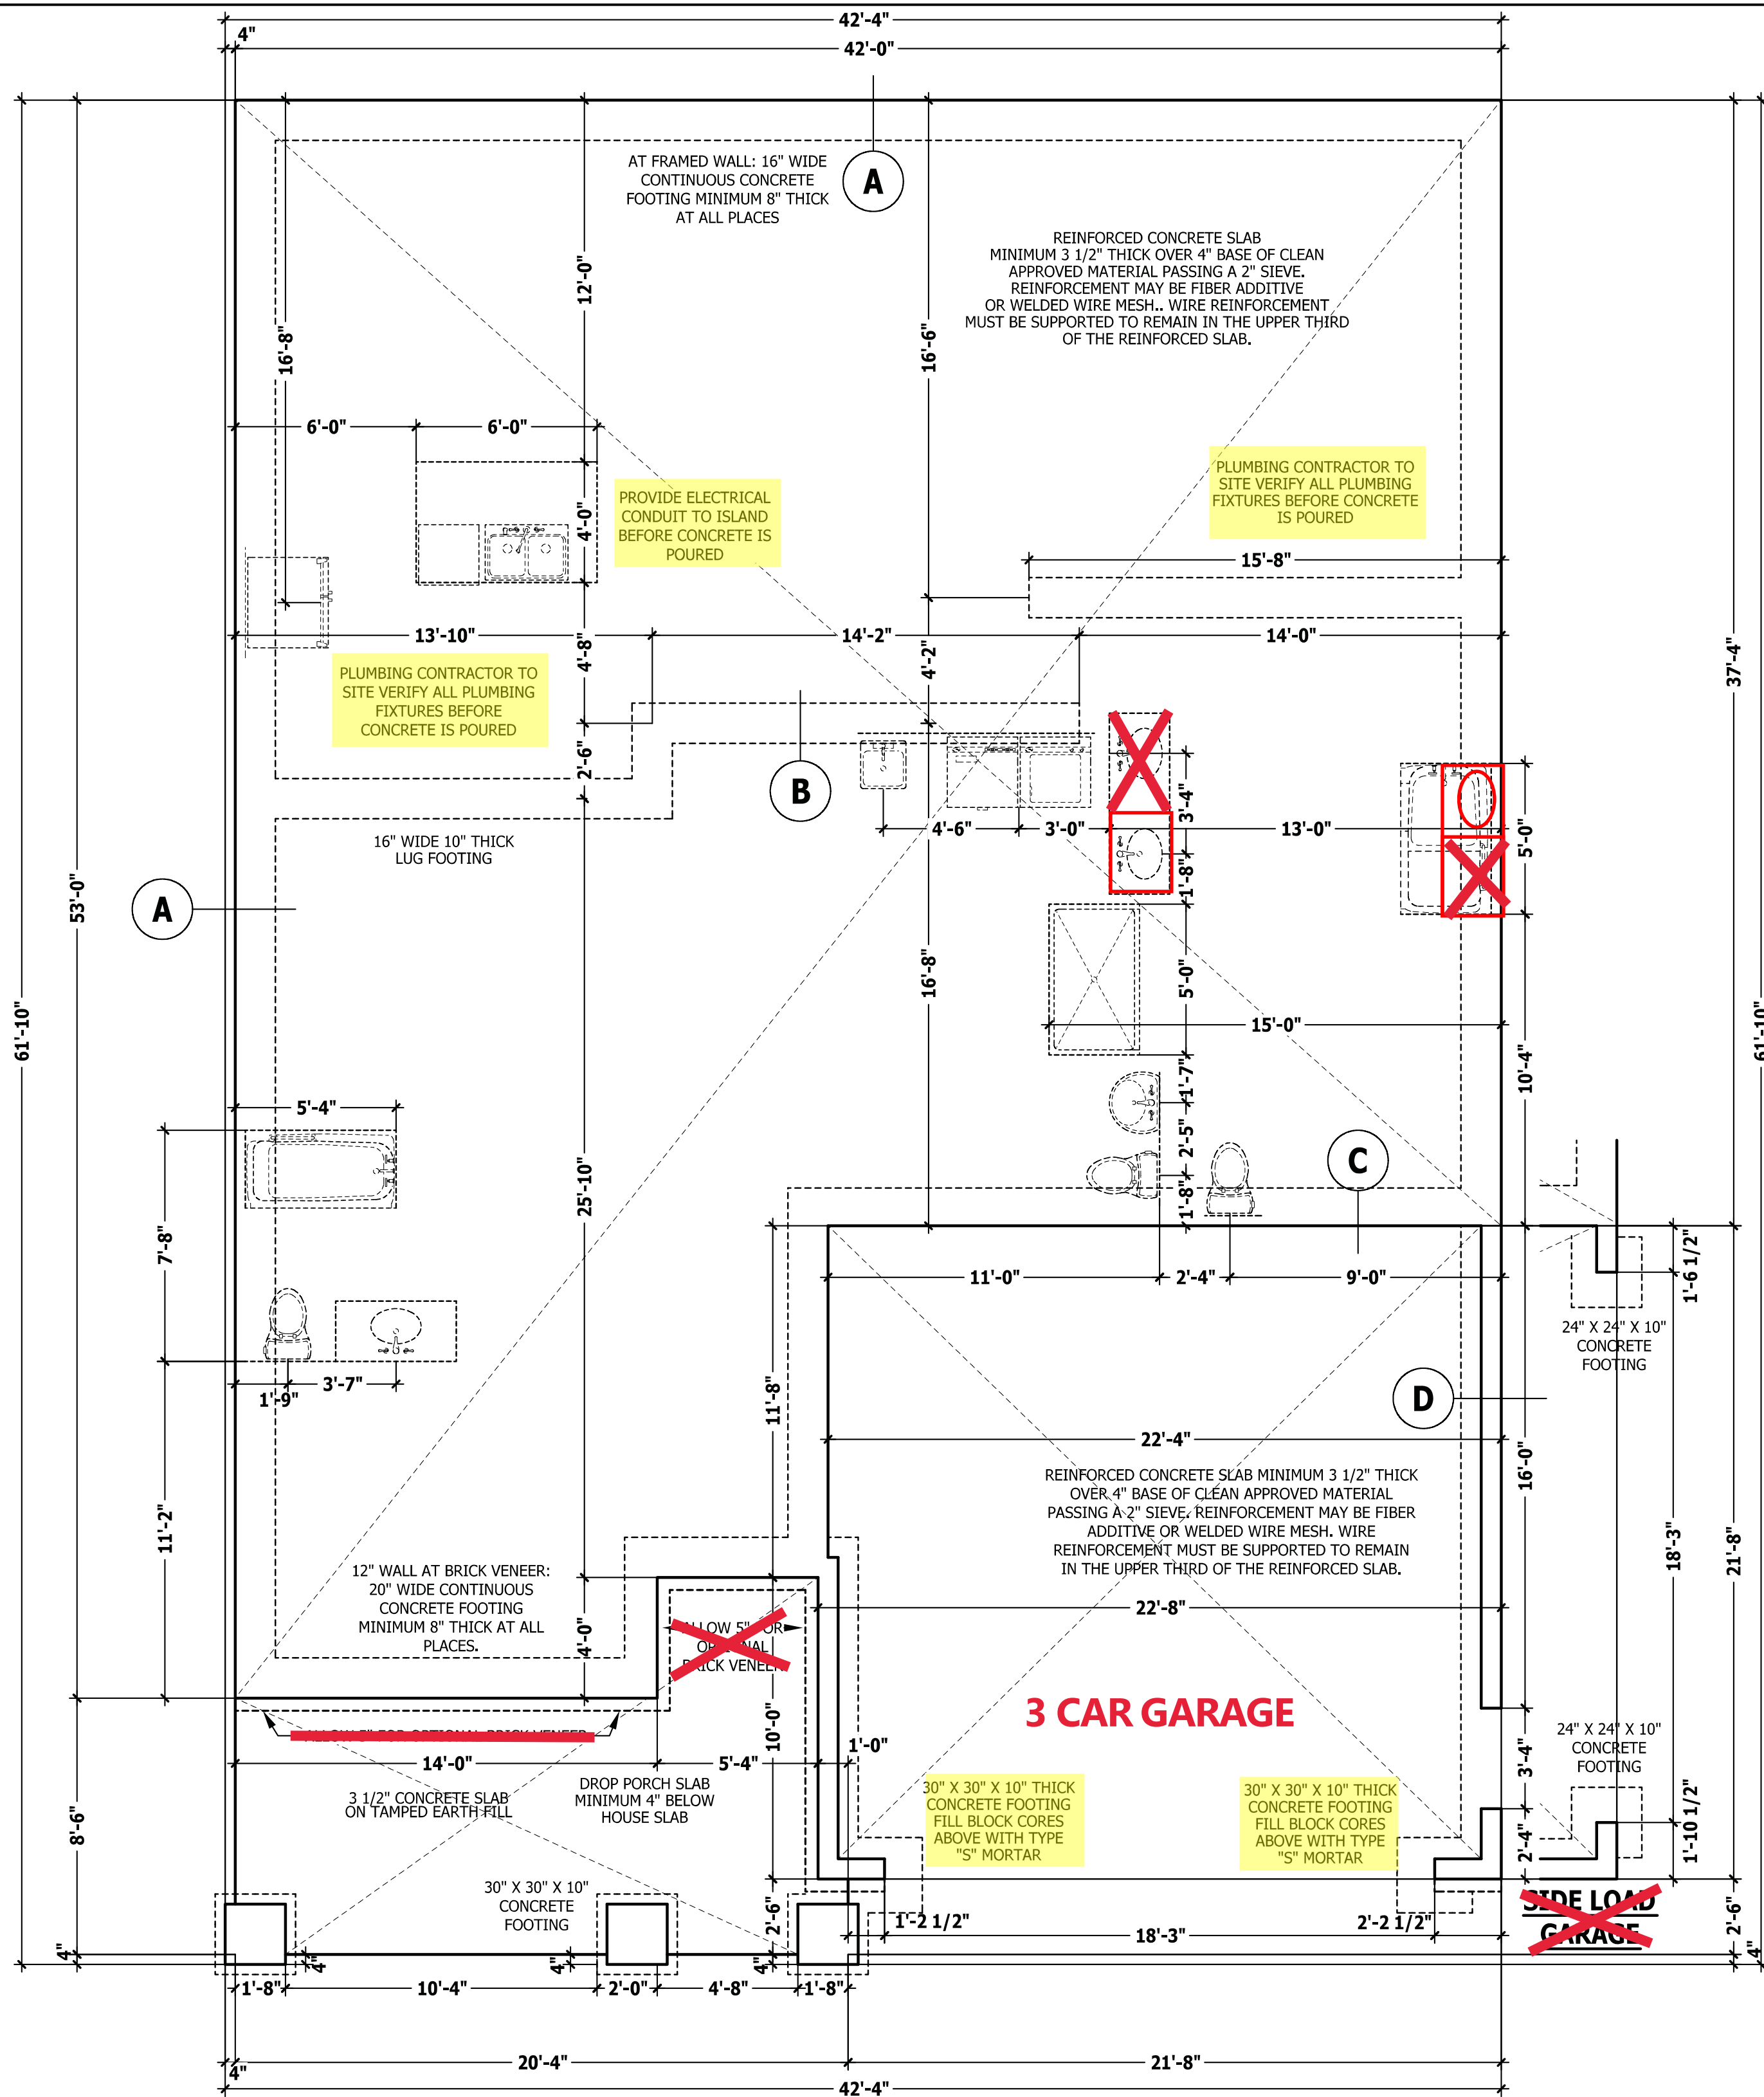

PURCHASER MUST VERIFY ALL DIMENSIONS AND CONDITIONS BEFORE CONSTRUCTION BEGINS. HAYNES HOME PLANS, INC. ASSUMES NO LIABILITY FOR CONTRACTOR PRACTICES AND PROCEDURES. CODES AND CONDITIONS MAY VARY WITH LOCATION, A LOCAL DESIGNER, ARCHITECT OR ENGINEER SHOULD BE CONSULTED BEFORE CONSTRUCTION. THESE DRAWING ARE INSTRUMENTS OF SERVICE AND AS SUCH SHALL REMAIN PROPERTY OF THE DESIGNER.

**MONOLITHIC SLAB PLAN**  
**The Lauren III**

**HAYNES WEAVER HOMES**  
 HOME PLANS, INC.  
 910.630.2100 • 919.606.4696  
 350 Waggoner Drive, Fayetteville, NC 28303

**HAYNES HOME PLANS, INC.**  
 P.O. Box 702, Wake Forest, NC 27588 919-435-6180 Fax: 1-866-491-0396

| SQUARE FOOTAGE           |             |
|--------------------------|-------------|
| <b>HEATED</b>            |             |
| FIRST FLOOR              | 1791 SQ.FT. |
| TOTAL                    | 1791 SQ.FT. |
| <b>HEATED OPTIONAL</b>   |             |
| CAROLINA ROOM            | 148 SQ.FT.  |
| TOTAL                    | 148 SQ.FT.  |
| <b>UNHEATED</b>          |             |
| FRONT PORCH              | 188 SQ.FT.  |
| GARAGE                   | 469 SQ.FT.  |
| TOTAL                    | 657 SQ.FT.  |
| <b>UNHEATED OPTIONAL</b> |             |
| SCREENED PORCH           | 188 SQ.FT.  |
| DECK OR PATIO            | 108 SQ.FT.  |
| THIRD GARAGE             | 292 SQ.FT.  |
| TOTAL                    | 560 SQ.FT.  |

© Copyright 2020  
 Haynes Home Plans, Inc.  
 4/29/2020  
 200220B  
 PAGE 2 OF 6

**COVERED REAR PORCH**

PURCHASER MUST VERIFY ALL DIMENSIONS AND CONDITIONS BEFORE CONSTRUCTION BEGINS. HAYNES HOME PLANS, INC. ASSUMES NO LIABILITY FOR CONTRACTOR PRACTICES AND PROCEDURES. CODES AND CONDITIONS MAY VARY WITH LOCATION, A LOCAL DESIGNER, ARCHITECT OR ENGINEER SHOULD BE CONSULTED BEFORE CONSTRUCTION. THESE DRAWINGS ARE INSTRUMENTS OF SERVICE AND AS SUCH SHALL REMAIN PROPERTY OF THE DESIGNER.

**FIRST FLOOR PLAN**  
**The Lauren III**

**HAYNES WEAVER HOMES**  
910.630.2100 • 919.606.4696  
350 Wiggener Drive, Fayetteville, NC 28303

**HAYNES HOME PLANS, INC.**  
P.O. Box 102, Wake Forest, NC 27588 919-435-6180 FAX 1-866-491-0396

| SQUARE FOOTAGE HEATED |             |
|-----------------------|-------------|
| FIRST FLOOR           | 1791 SQ.FT. |
| TOTAL                 | 1791 SQ.FT. |
| HEATED OPTIONAL       |             |
| CAROLINA ROOM         | 148 SQ.FT.  |
| TOTAL                 | 148 SQ.FT.  |
| UNHEATED              |             |
| FRONT PORCH           | 188 SQ.FT.  |
| GARAGE                | 469 SQ.FT.  |
| TOTAL                 | 657 SQ.FT.  |
| UNHEATED OPTIONAL     |             |
| SCREENED PORCH        | 160 SQ.FT.  |
| DECK OR PATIO         | 108 SQ.FT.  |
| THIRD GARAGE          | 292 SQ.FT.  |
| TOTAL                 | 560 SQ.FT.  |

© Copyright 2020 Haynes Home Plans, Inc.  
**4/29/2020**  
**200220B**  
**PAGE 3 OF 6**

Z:\Builder\Weaver Development Company, Inc\200220B Lauren III\200220B Lauren III.aec

**DWELLING / GARAGE SEPARATION**


REFER TO SECTIONS R302.5, R302.6, AND R302.7  
**WALLS.** A minimum 1/2" gypsum board must be installed on all walls supporting floor/ceiling assemblies used for separation required by this section.  
**STAIRS.** A minimum of 1/2" gypsum board must be installed on the underside and exposed sides of all stairways.  
**CEILINGS.** A minimum of 1/2" gypsum must be installed on the garage ceiling if there are no habitable room above the garage. If there are habitable room above the garage a minimum of 5/8" type X gypsum board must be installed on the garage ceiling.  
**OPENING PENETRATIONS.** Openings between the garage and residence shall be equipped with solid wood doors not less than 1 3/8 inches (35 mm) in thickness, solid or honeycomb core steel doors not less than 1 3/8 inches (35 mm) thick, or 20-minute fire-rated doors.  
**DUCT PENETRATIONS.** Ducts in the garage and ducts penetrating the walls or ceilings separating the dwelling from the garage shall be constructed of a minimum No. 26 gage (0.48 mm) sheet steel or other approved material and shall have no openings into the garage.  
**OTHER PENETRATIONS.** Penetrations through the separation required in Section R302.6 shall be protected as required by Section R302.11, Item 4.

**SQUARE FOOTAGE**

| HEATED            |             |
|-------------------|-------------|
| FIRST FLOOR       | 1791 SQ.FT. |
| TOTAL             | 1791 SQ.FT. |
| HEATED OPTIONAL   |             |
| CAROLINA ROOM     | 148 SQ.FT.  |
| TOTAL             | 148 SQ.FT.  |
| UNHEATED          |             |
| FRONT PORCH       | 188 SQ.FT.  |
| GARAGE            | 469 SQ.FT.  |
| TOTAL             | 657 SQ.FT.  |
| UNHEATED OPTIONAL |             |
| SCREENED PORCH    | 160 SQ.FT.  |
| DECK OR PATIO     | 108 SQ.FT.  |
| THIRD GARAGE      | 292 SQ.FT.  |
| TOTAL             | 560 SQ.FT.  |

**FIRST FLOOR PLAN**

SCALE 1/4" = 1'-0"

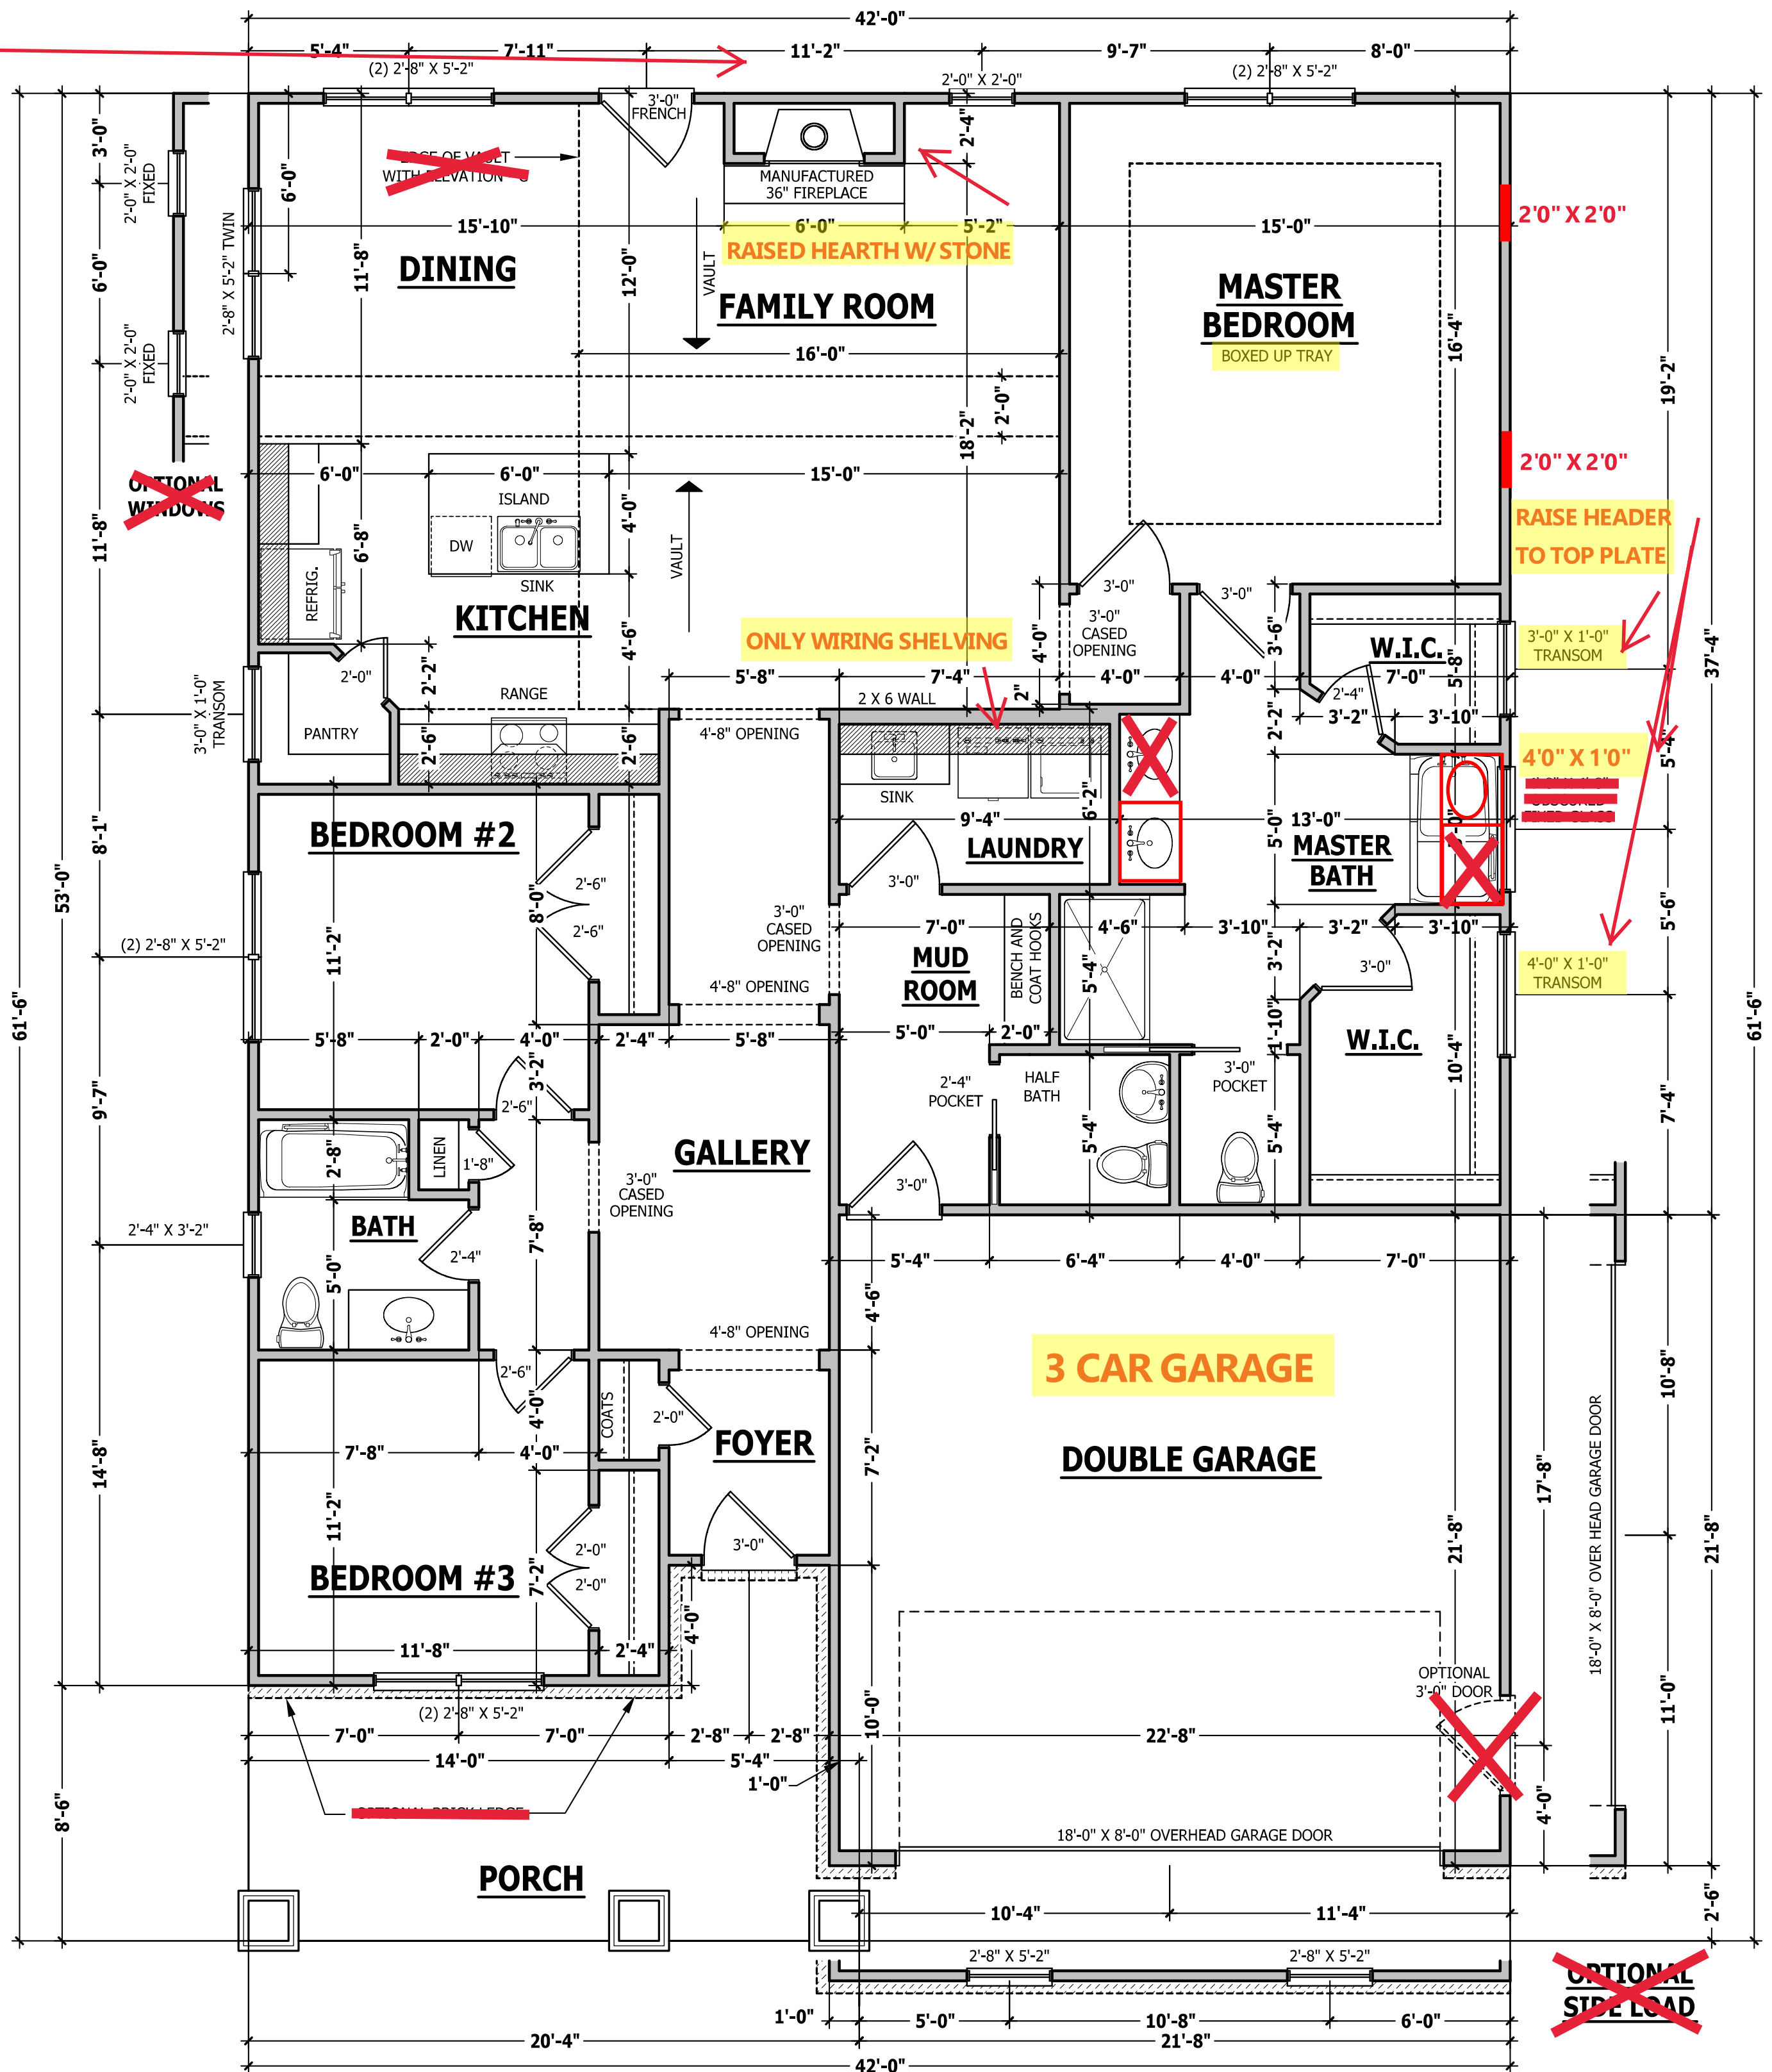

~~OPTIONAL SIDE LOAD~~

PURCHASER MUST VERIFY ALL DIMENSIONS AND CONDITIONS BEFORE CONSTRUCTION BEGINS.  
 HAYNES HOME PLANS, INC. ASSUMES NO LIABILITY FOR CONTRACTORS PRACTICES AND PROCEDURES.  
 CODES AND CONDITIONS MAY VARY WITH LOCATION. A LOCAL DESIGNER, ARCHITECT OR ENGINEER SHOULD BE CONSULTED BEFORE CONSTRUCTION.  
 THESE DRAWING ARE INSTRUMENTS OF SERVICE AND AS SUCH SHALL REMAIN PROPERTY OF THE DESIGNER.

**FIRST FLOOR STRUCTURAL**  
**The Lauren III**

**HAYNES WEAVER HOMES**  
 HOME PLANS, INC.  
 P.O. Box 702, Wake Forest, NC 27588 919-435-6180 FAX 1-866-491-0396  
 910.630.2100 919.606.4696  
 350 Wagoner Drive, Fayetteville, NC 28303

| SQUARE FOOTAGE                   |             |
|----------------------------------|-------------|
| HEATED FIRST FLOOR               | 1791 SQ.FT. |
| TOTAL HEATED                     | 1791 SQ.FT. |
| HEATED OPTIONAL CAROLINA ROOM    | 148 SQ.FT.  |
| TOTAL HEATED                     | 148 SQ.FT.  |
| UNHEATED FRONT PORCH             | 188 SQ.FT.  |
| UNHEATED GARAGE                  | 469 SQ.FT.  |
| TOTAL UNHEATED                   | 657 SQ.FT.  |
| UNHEATED OPTIONAL SCREENED PORCH | 188 SQ.FT.  |
| UNHEATED DECK OR PATIO           | 118 SQ.FT.  |
| UNHEATED THIRD GARAGE            | 292 SQ.FT.  |
| TOTAL UNHEATED OPTIONAL          | 598 SQ.FT.  |

© Copyright 2020  
 Haynes Home Plans, Inc.  
**4/29/2020**  
**200220B**  
**PAGE 4 OF 6**

### STRUCTURAL NOTES

All construction shall conform to the latest requirements of the 2018 North Carolina Residential Building Code, plus all local codes and regulations. This document in no way shall be construed to supersede the code.

**JOB SITE PRACTICES AND SAFETY:** Haynes Home Plans, Inc. assumes no liability for contractors practices and procedures or safety program. Haynes Home Plans, Inc. takes no responsibility for the contractor's failure to carry out the construction work in accordance with the contract documents. All members shall be framed, anchored, and braced in accordance with good construction practice and the building code.

#### DESIGN LOADS

| USE                          | LIVE LOAD (PSF) | DEAD LOAD (PSF) | DEFLECTION (LL) |
|------------------------------|-----------------|-----------------|-----------------|
| Attics without storage       | 10              | 10              | L/240           |
| Attics with limited storage  | 20              | 10              | L/360           |
| Attics with fixed stairs     | 40              | 10              | L/360           |
| Balconies and decks          | 40              | 10              | L/360           |
| Fire escapes                 | 40              | 10              | L/360           |
| Guardrails and handrails     | 200             | --              | --              |
| Guardrail in-fill components | 50              | --              | --              |
| Passenger vehicle garages    | 50              | 10              | L/360           |
| Rooms other than sleeping    | 40              | 10              | L/360           |
| Sleeping rooms               | 30              | 10              | L/360           |
| Stairs                       | 40              | --              | L/360           |
| Snow                         | 20              | --              | --              |

**FRAMING LUMBER:** All non treated framing lumber shall be SPF #2 (Fb = 875 PSI) or SYP #2 (Fb = 750 PSI) and all treated lumber shall be SYP #2 (Fb = 750 PSI) unless noted other wise.

**ENGINEERED WOOD BEAMS:**  
 Laminated veneer lumber (LVL) = Fb=2600 PSI, Fv=285 PSI, E=1.9x10<sup>6</sup> PSI  
 Parallel strand lumber (PSL) = Fb=2900 PSI, Fv=290 PSI, E=2.0x10<sup>6</sup> PSI  
 Laminated strand lumber (LSL) = Fb=2250 PSI, Fv=400 PSI, E=1.55x10<sup>6</sup> PSI  
 Install all connections per manufacturers instructions.

**TRUSS AND I-JOIST MEMBERS:** All roof truss and I-joist layouts shall be prepared in accordance with this document. Trusses and I-joists shall be installed according to the manufacture's specifications. Any change in truss or I-joist layout shall be coordinated with Haynes Homes Plans, Inc.

**LINTELS:** Brick lintels shall be 3 1/2" x 3 1/2" x 1/4" steel angle for up to 6'-0" span, 6" x 4" x 5/16" steel angle with 6" leg vertical for spans up to 9'-0" unless noted otherwise. 3 1/2" x 3 1/2" x 1/4" steel angle with 1/2" bolts at 2'-0" on center for spans up to 18'-0" unless noted otherwise.

**FLOOR SHEATHING:** OSB or CDX floor sheathing minimum 1/2" thick for 16" on center joist spacing, minimum 5/8" thick for 19.2" on center joist spacing, and minimum 3/4" thick for 24" on center joist spacing.

**ROOF SHEATHING:** OSB or CDX roof sheathing minimum 3/8" thick.

**CONCRETE AND SOILS:** See foundation notes.

### ROOF TRUSS REQUIREMENTS

**TRUSS DESIGN.** Trusses to be designed and engineered in accordance with these drawings. Any variation with these drawings must be brought to Haynes Home Plans, Inc. attention before construction begins.

**KNEE WALL AND CEILING HEIGHTS.** All finished knee wall heights and ceiling heights are shown furred down 10" from roof decking for insulation. If for any reason the truss manufacturer fails to meet or exceed designated heel heights, finished knee wall heights, or finished ceiling heights shown on these drawings the finished square footage may vary. Any discrepancy must be brought to Haynes Home Plans, Inc. attention, so a suitable solution can be reached before construction begins. Any variation due to these conditions not being met is the reasonability of the truss manufacturer.

**ANCHORAGE.** All required anchors for trusses due to uplift or bearing shall meet the requirements as specified on the truss schematics.

**BEARING.** All trusses shall be designed for bearing on SPF #2 plates or ledgers unless noted otherwise.

**Plate Heights & Floor Systems.** See elevation page(s) for plate heights and floor system thicknesses.

### BRACE WALL PANEL NOTES

**EXTERIOR WALLS:** All exterior walls to be sheathed with CS-WSP or CS-SFB in accordance with section R602.10.3 unless noted otherwise.

**GYPSUM:** All interior sides of exterior walls and both sides interior walls to have 1/2" gypsum installed. When not using method GB gypsum to be fastened per table R702.3.5. Method GB to be fastened per table R602.10.1.

**REQUIRED LENGTH OF BRACING:** Required brace wall length for each side of the circumscribed rectangle are interpolated per table R602.10.3. Methods CS-WSP and CS-SFB contribute their actual length. Method GB contributes 0.5 it's actual length. Method PF contributes 1.5 times its actual length.

**HD:** 800 lbs hold down hold down device fastened to the edge of the brace wall panel closets to the corner.


**Methods** Per Table R602.10.1

**CS-WSP:** Shall be minimum 3/8" OSB or CDX nailed at 6" on center at edges and 12" on center at intermediate supports with 6d common nails or 8d(2 1/2" long x 0.113" diameter).

**CS-SFB:** Shall be minimum 1/2" structural fiber board nailed at 3" on center at edges and 3" on center at intermediate supports with 1 1/2" long x 0.12" diameter galvanized roofing nails.

**GB:** Interior walls show as GB are to have minimum 1/2" gypsum board on both sides of the wall fastened at 7" on center at edges and 7" on center at intermediate supports with minimum 5d cooler nails or #6 screws.

**PF:** Portal frame per figure R602.10.1

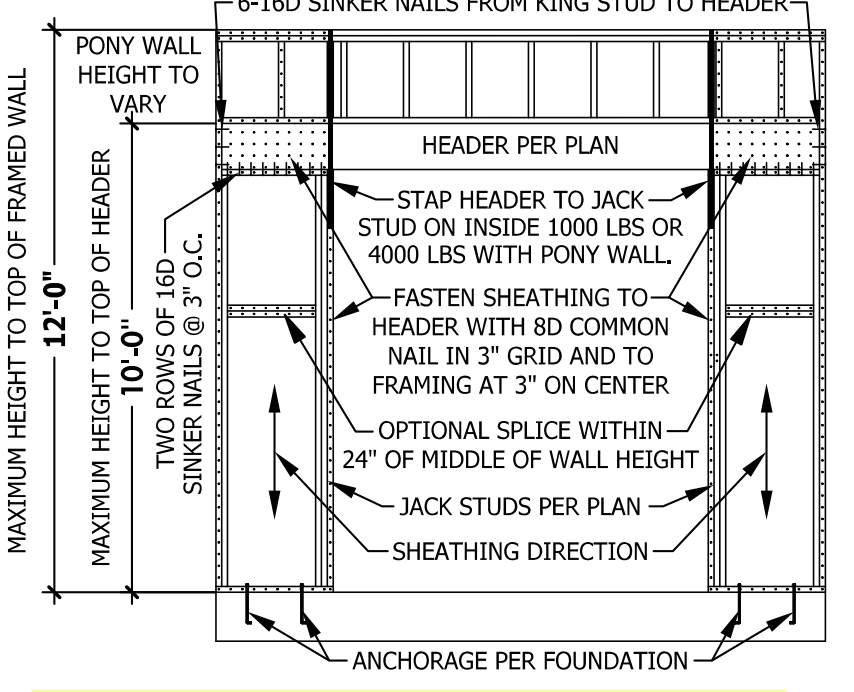

**PF PORTAL FRAME AT OPENING**  
 (METHOD PF PER FIGURE AND SECTION R602.10.1)  
 SCALE 1/4" = 1'-0"

### EXTERIOR HEADERS

- (2) 2 X 6 WITH 1 JACK STUD EACH END UNLESS NOTED OTHERWISE

- KING STUDS EACH END PER TABLE BELOW

| HEADER SPAN  | < 3' | 3'-4' | 4'-8' | 8'-12' | 12'-16' |
|--------------|------|-------|-------|--------|---------|
| KING STUD(S) | 1    | 2     | 3     | 5      | 6       |


### INTERIOR HEADERS

- LOAD BEARING HEADERS (2) 2 X 6 WITH 1 JACK STUD AND 1 KING STUD EACH END UNLESS NOTED OTHERWISE

- NON LOAD BEARING HEADERS TO BE LADDER FRAMED

## FIRST FLOOR STRUCTURAL

SCALE 1/4" = 1'-0"

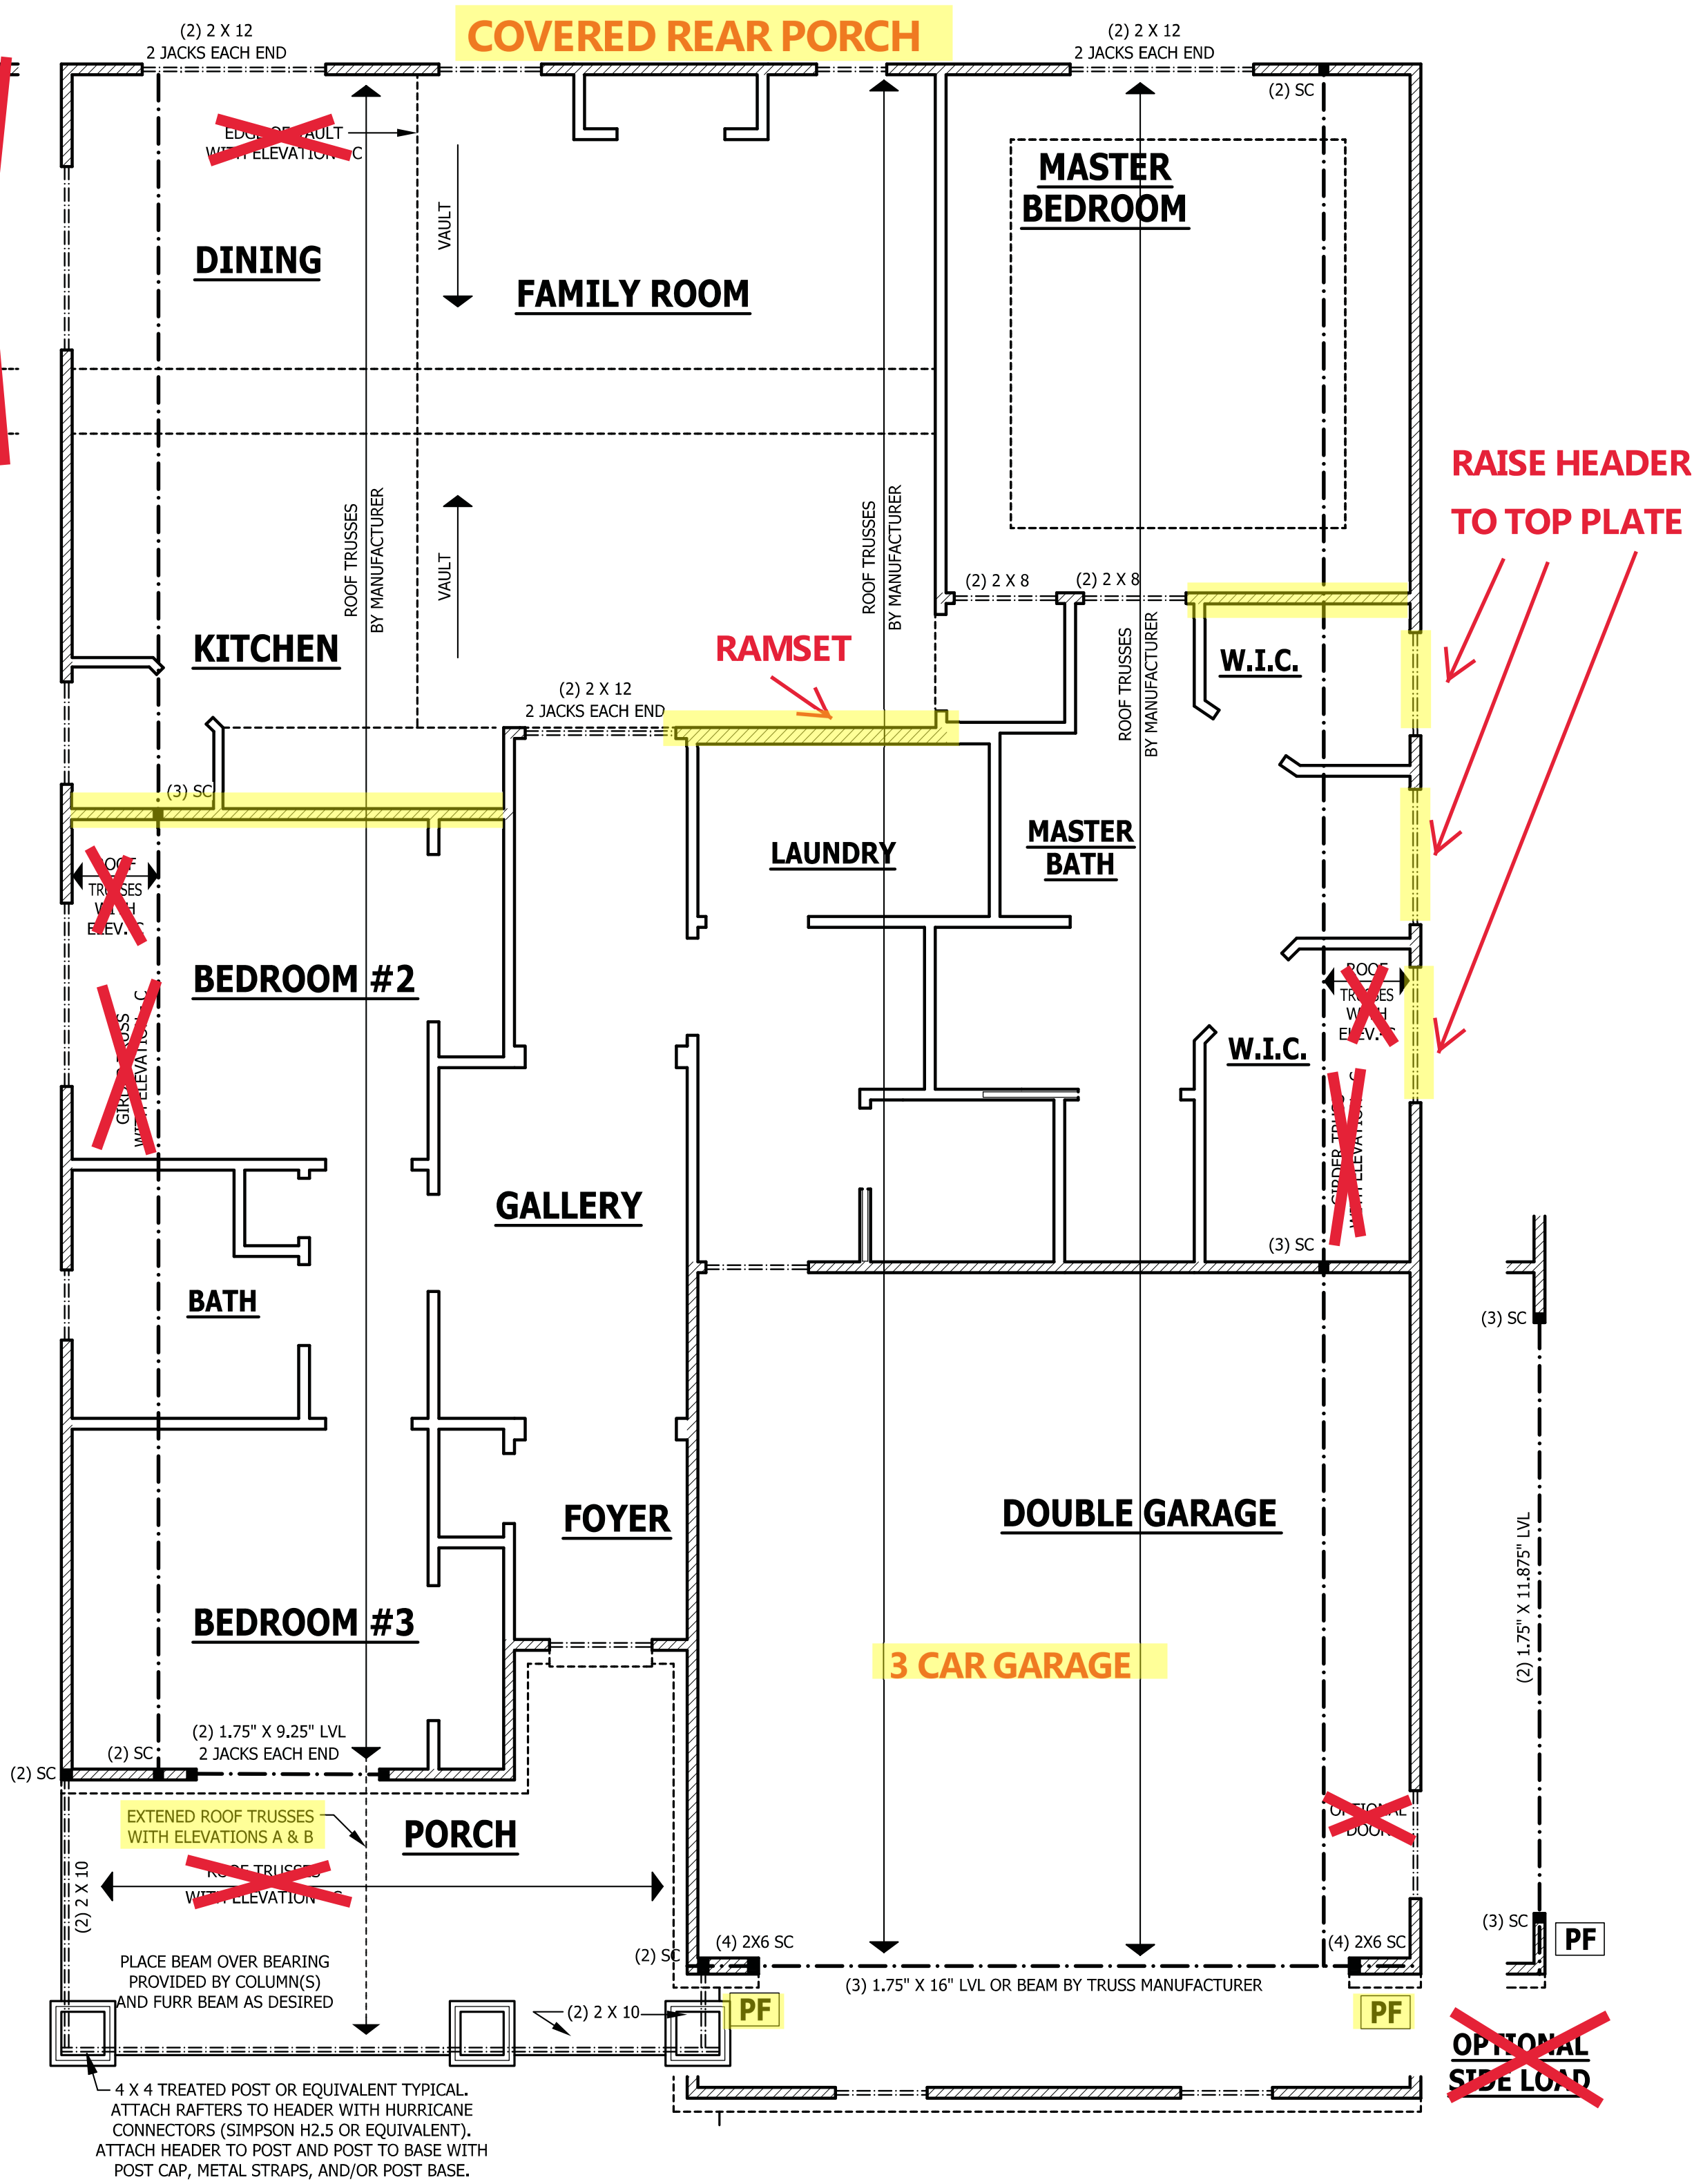

Z:\Builder\Weaver Development Company, Inc\200220B Lauren III\200220B Lauren III.aec

### ROOF TRUSS REQUIREMENTS

**TRUSS DESIGN.** Trusses to be designed and engineered in accordance with these drawings. Any variation with these drawings must be brought to Haynes Home Plans, Inc. attention before construction begins.


**KNEE WALL AND CEILING HEIGHTS.** All finished knee wall heights and ceiling heights are shown furred down 10" from roof decking for insulation. If for any reason the truss manufacturer fails to meet or exceed designated heel heights, finished knee wall heights, or finished ceiling heights shown on these drawings the finished square footage may vary. Any discrepancy must be brought to Haynes Home Plans, Inc. attention, so a suitable solution can be reached before construction begins. Any variation due to these conditions not being met is the responsibility of the truss manufacturer.

**ANCHORAGE.** All required anchors for trusses due to uplift or bearing shall meet the requirements as specified on the truss schematics.


**BEARING.** All trusses shall be designed for bearing on SPF #2 plates or ledgers unless noted otherwise.

**Plate Heights & Floor Systems.** See elevation page(s) for plate heights and floor system thicknesses.

● HEEL HEIGHT ABOVE FIRST FLOOR PLATE      ● HEEL HEIGHT ABOVE SECOND FLOOR PLATE

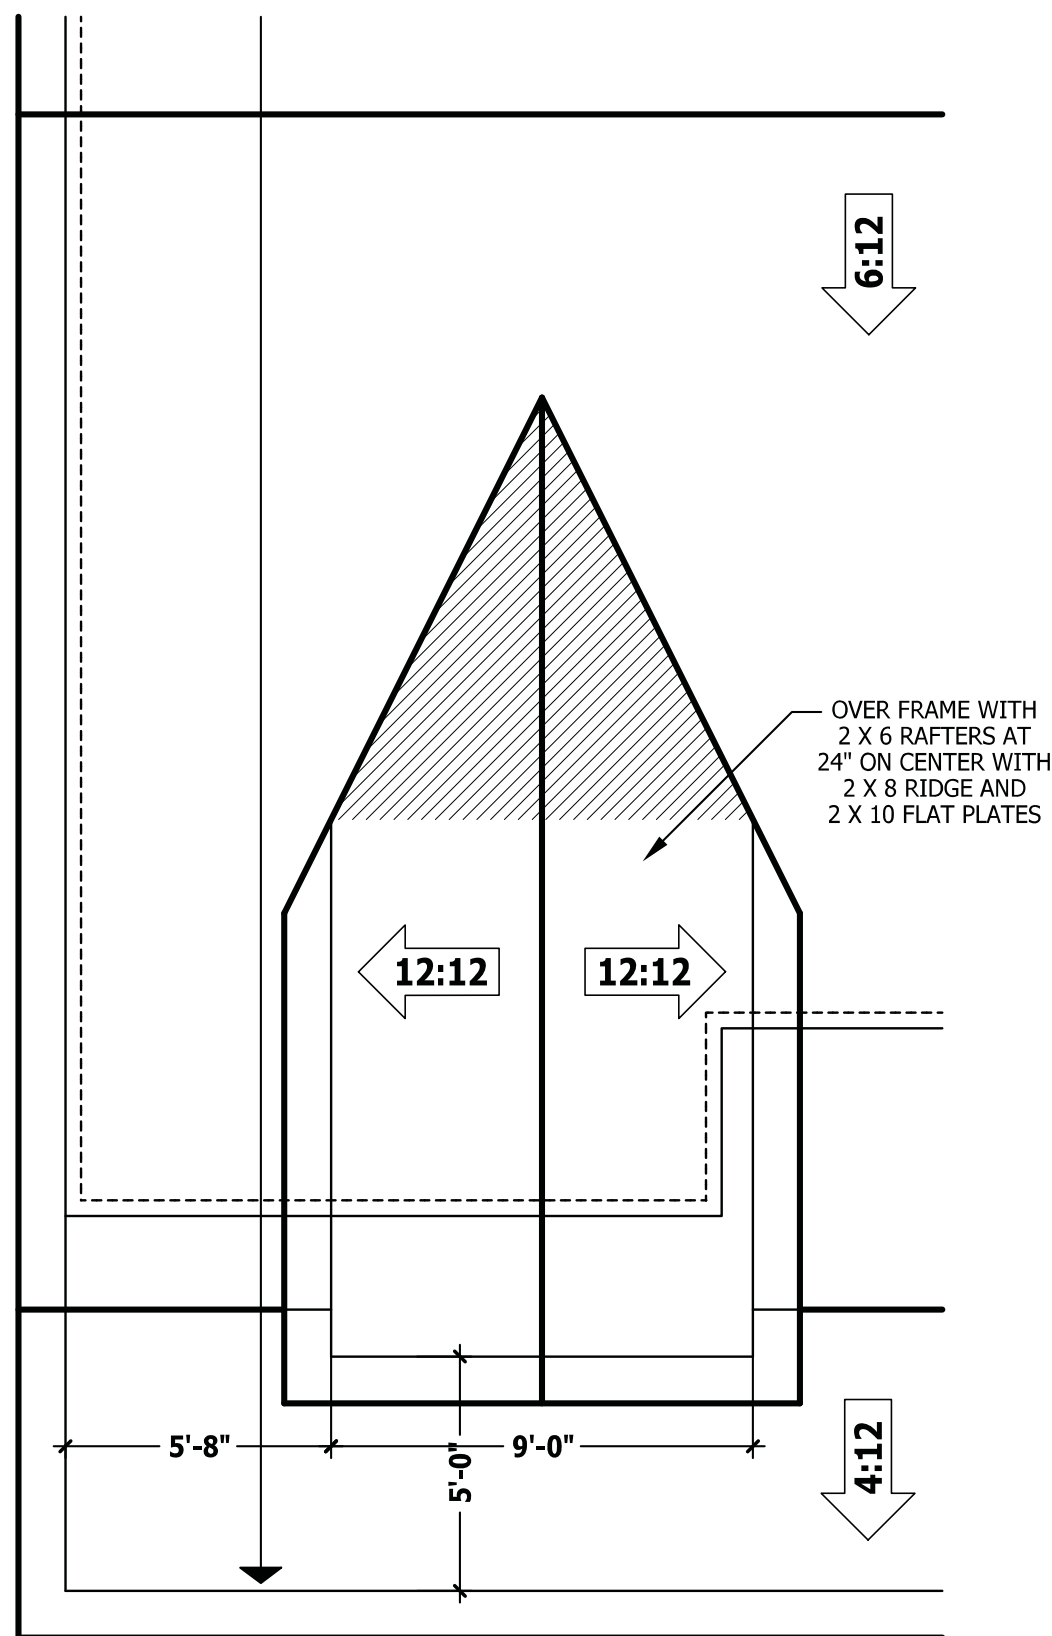

**~~DORMER WITH ELEVATION - B~~**

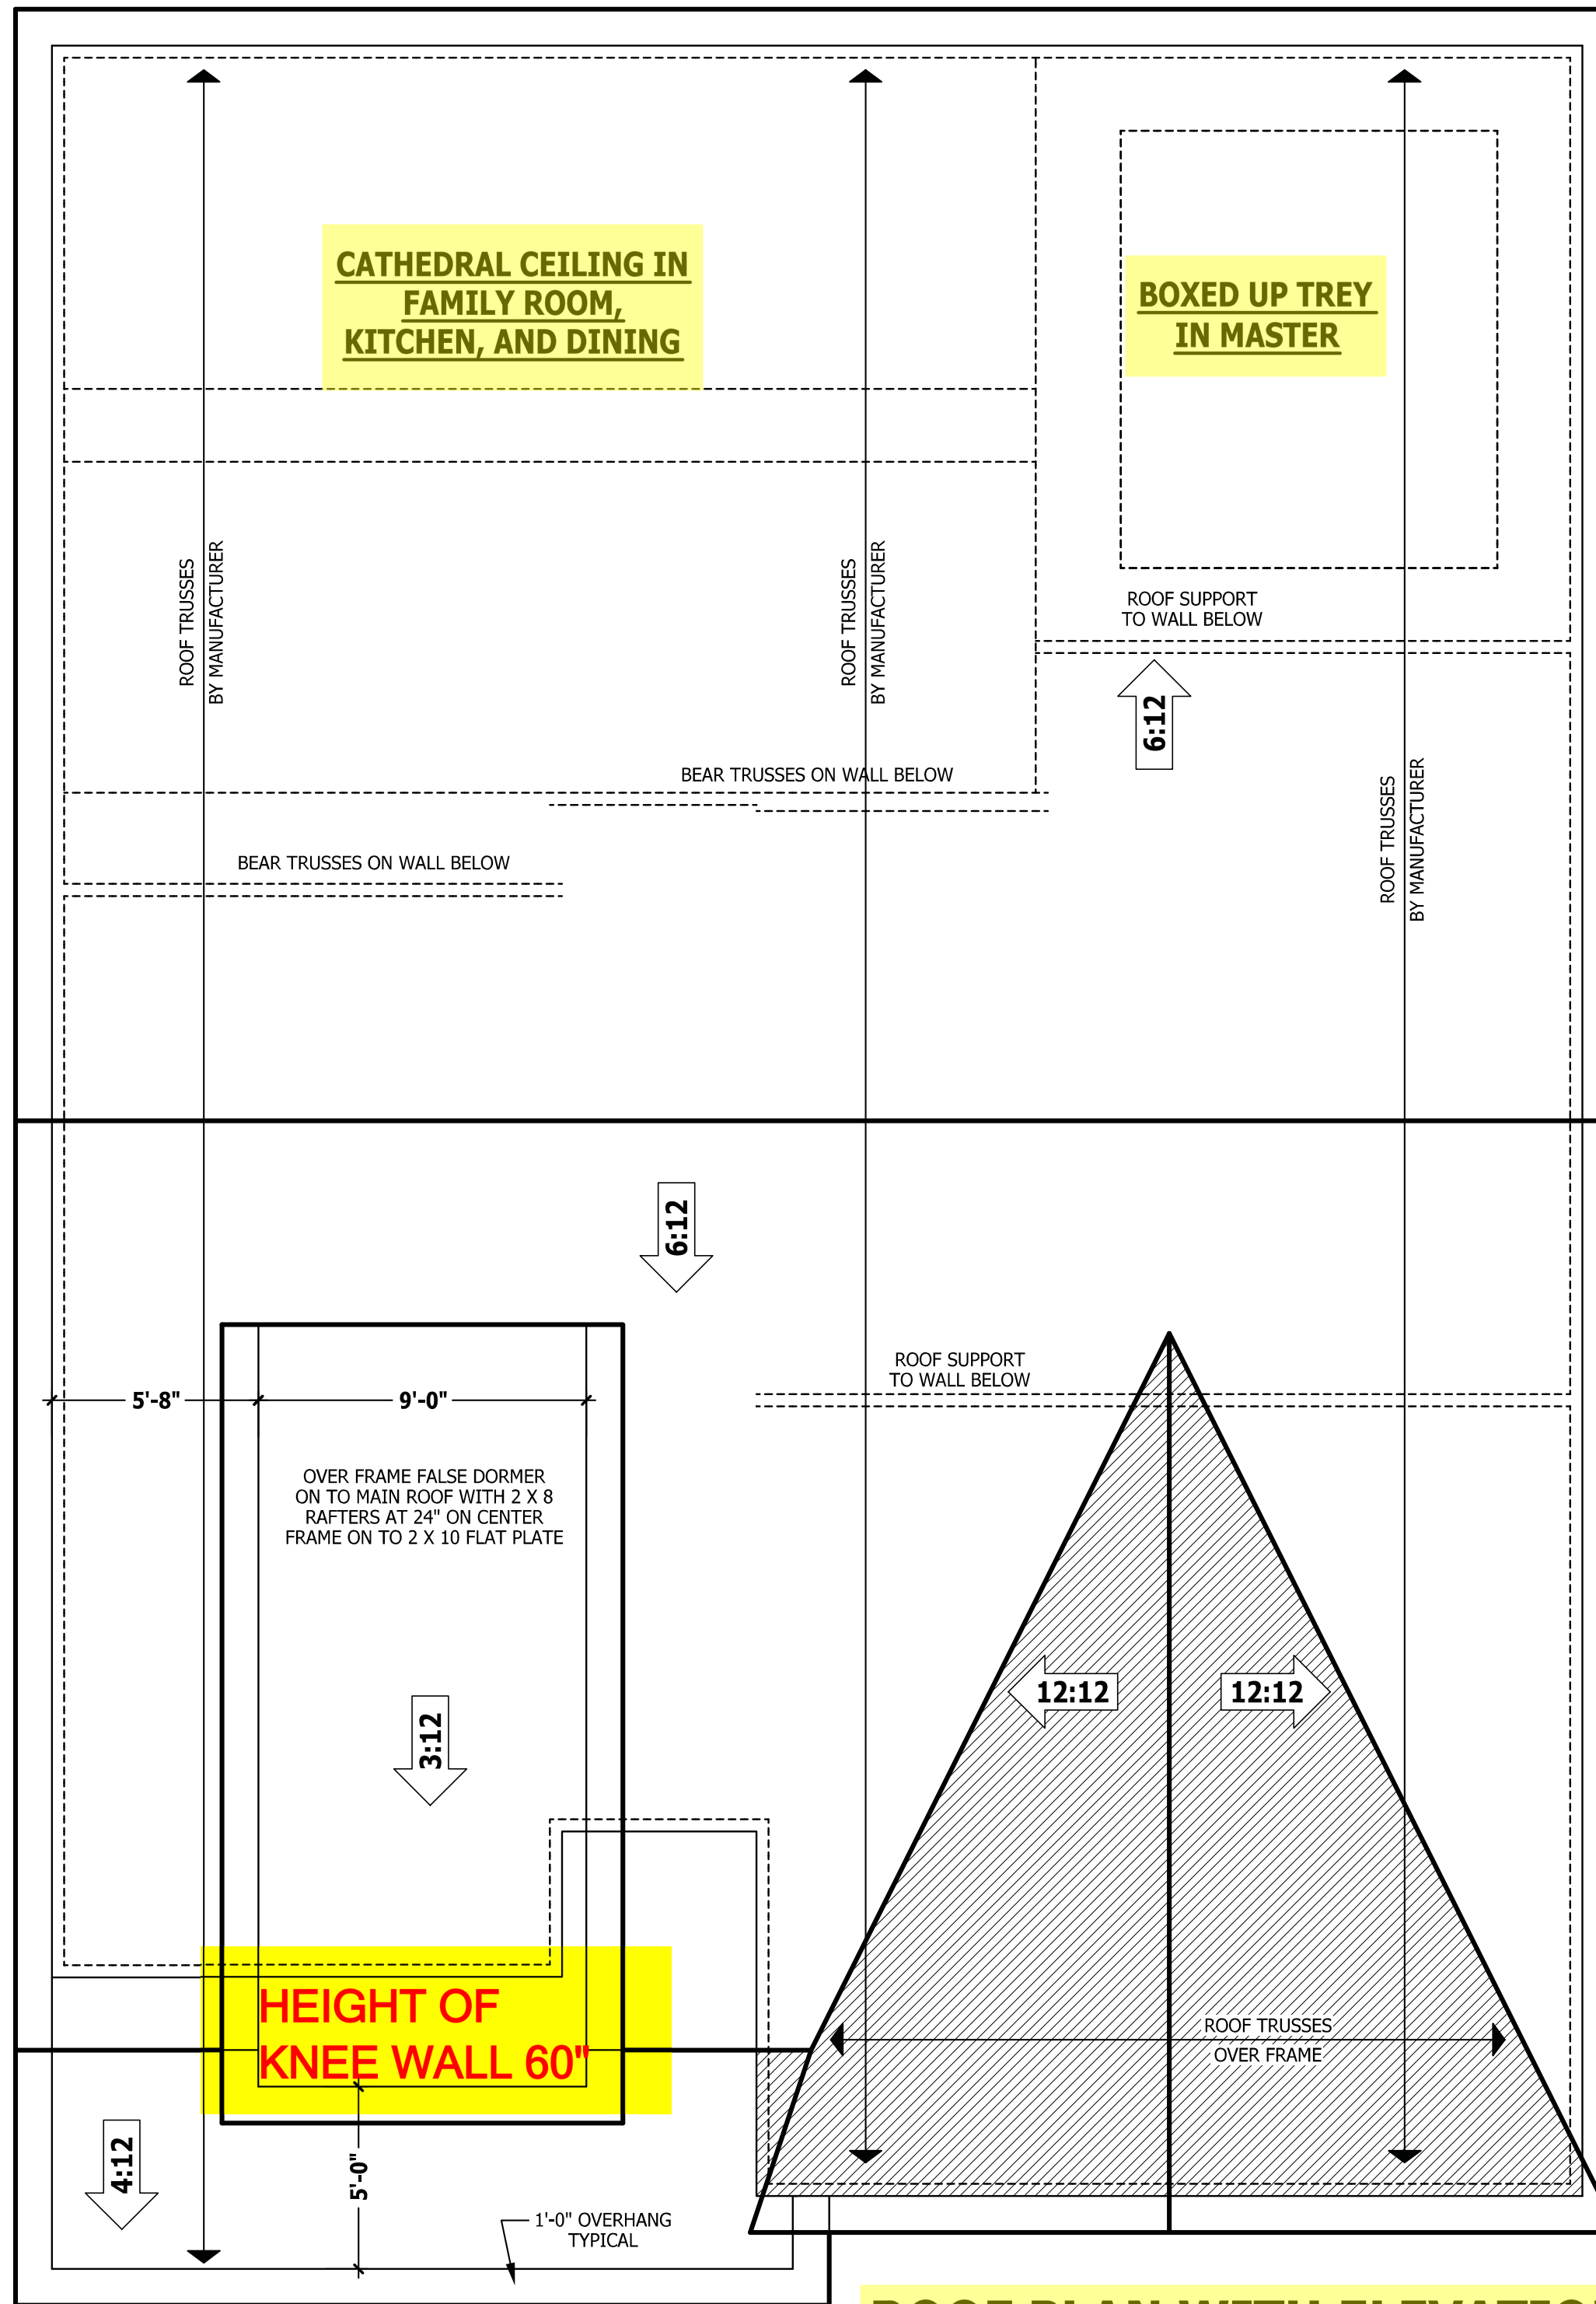

**DORMER WITH ELEVATION - A**

**ROOF PLAN WITH ELEVATIONS - A & B**  
SCALE 1/4" = 1'-0"


PURCHASER MUST VERIFY ALL DIMENSIONS AND CONDITIONS BEFORE CONSTRUCTION BEGINS. HAYNES HOME PLANS, INC. ASSUMES NO LIABILITY FOR CONTRACTOR PRACTICES AND PROCEDURES. CODES AND CONDITIONS MAY VARY WITH LOCATION, A LOCAL DESIGNER, ARCHITECT OR ENGINEER SHOULD BE CONSULTED BEFORE CONSTRUCTION. THESE DRAWING ARE INSTRUMENTS OF SERVICE AND AS SUCH SHALL REMAIN PROPERTY OF THE DESIGNER.

**ROOF PLAN WITH ELEVATIONS - A & B**


**The Lauren III**

**HAYNES WEAVER HOMES**  
HOME PLANS, INC.  
P.O. Box 702, Wake Forest, NC 27588 919-435-6180 FAX 1-866-491-0396  
910.630.2100 • 919.606.4696  
350 Waggoner Drive, Fayetteville, NC 28303


| SQUARE FOOTAGE           |             |
|--------------------------|-------------|
| <b>HEATED</b>            |             |
| FIRST FLOOR              | 1791 SQ.FT. |
| TOTAL                    | 1791 SQ.FT. |
| <b>HEATED OPTIONAL</b>   |             |
| CAROLINA ROOM            | 148 SQ.FT.  |
| TOTAL                    | 148 SQ.FT.  |
| <b>UNHEATED</b>          |             |
| FRONT PORCH              | 188 SQ.FT.  |
| GARAGE                   | 469 SQ.FT.  |
| TOTAL                    | 657 SQ.FT.  |
| <b>UNHEATED OPTIONAL</b> |             |
| SCREENED PORCH           | 180 SQ.FT.  |
| DECK OR PATIO            | 118 SQ.FT.  |
| THIRD GARAGE             | 292 SQ.FT.  |
| TOTAL                    | 560 SQ.FT.  |

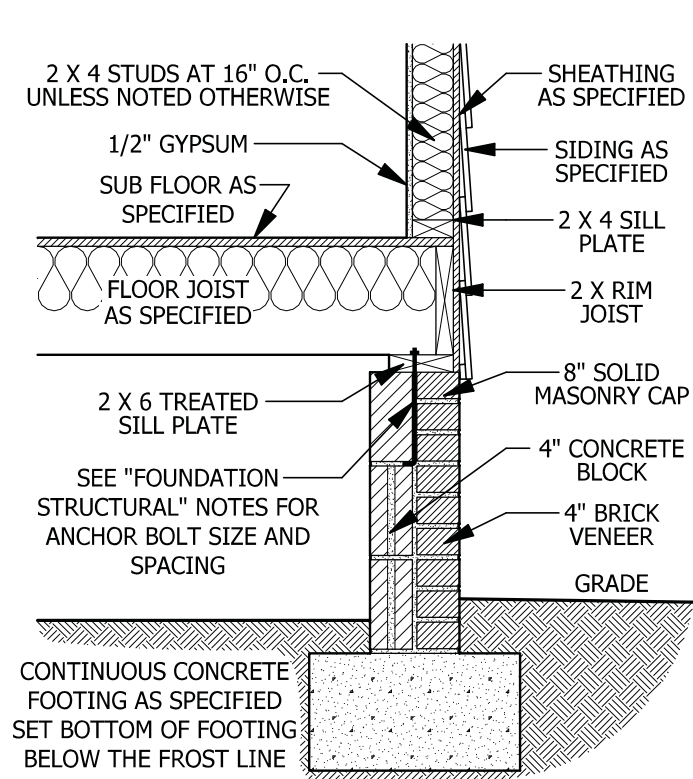


**A CRAWL SPACE WALL**  
SCALE 3/4" = 1'-0"

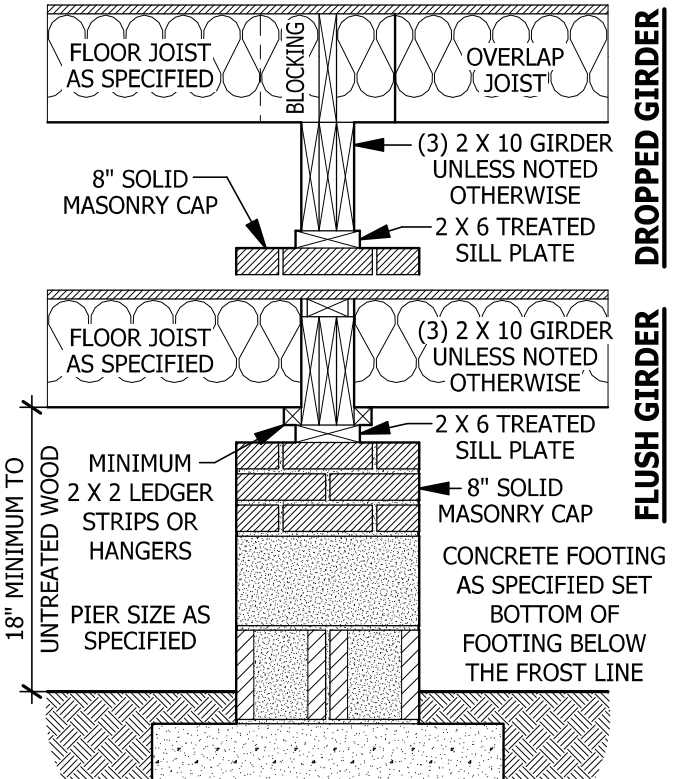


**B DROPPED/ FLUSH PIER**  
SCALE 3/4" = 1'-0"

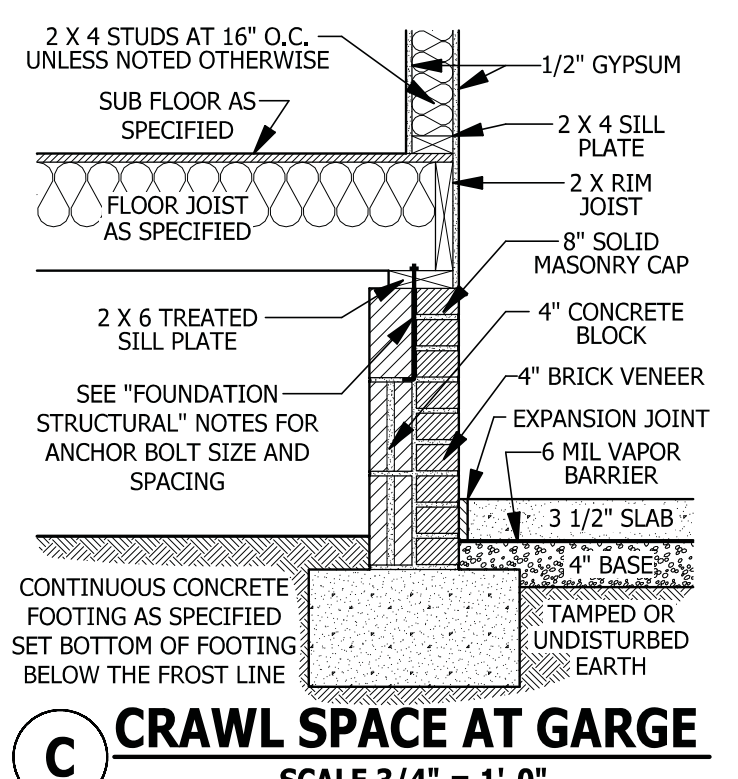


**C CRAWL SPACE AT GARGE**  
SCALE 3/4" = 1'-0"

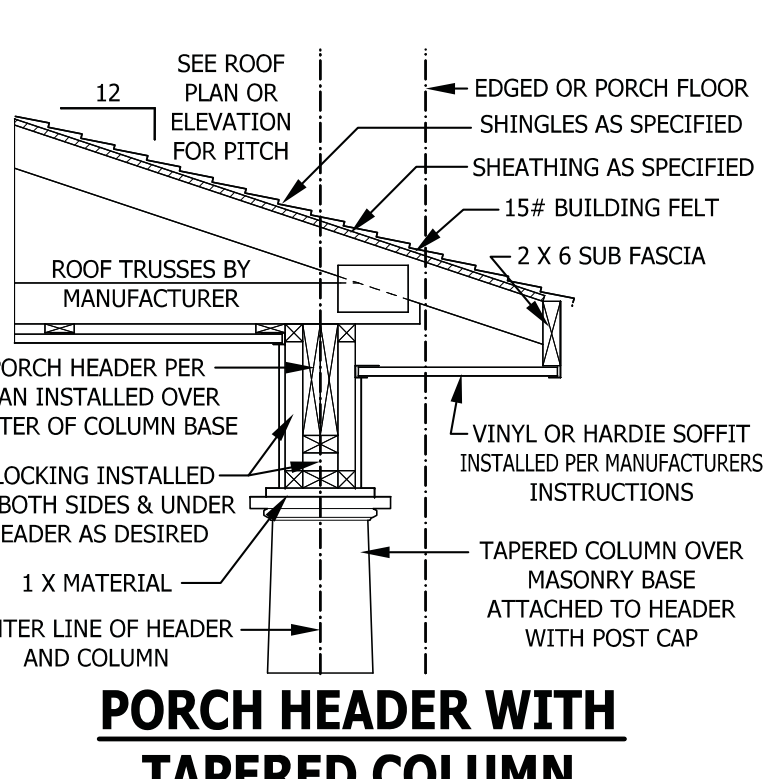


**D PORCH HEADER WITH TAPERED COLUMN**  
SCALE 3/4" = 1'-0"

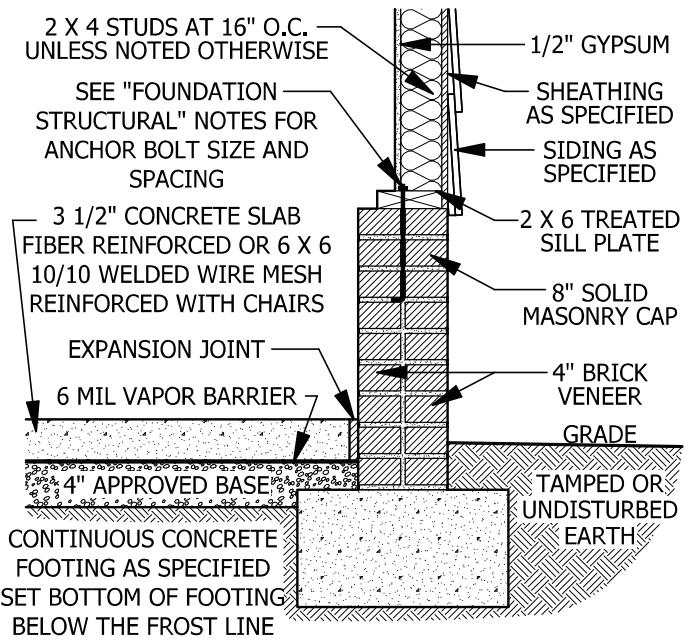




**E GARAGE STEM WALL**  
SCALE 3/4" = 1'-0"

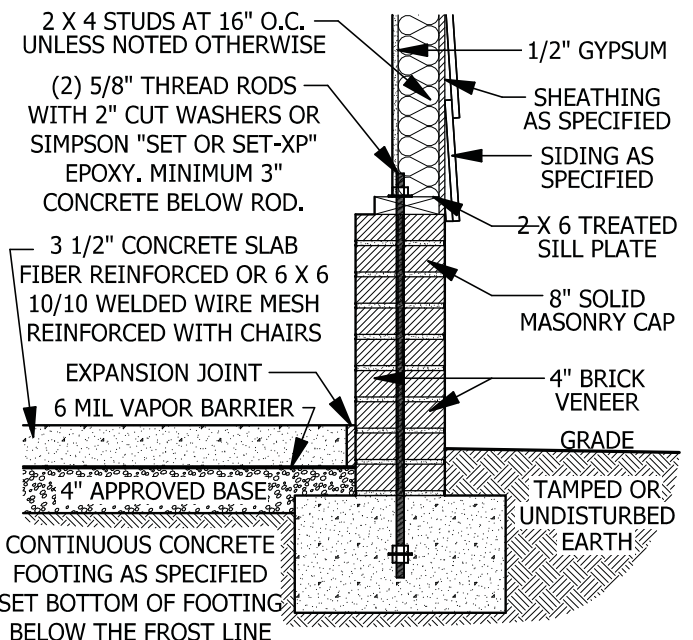

**F <48" GARAGE WING WALL**  
SCALE 3/4" = 1'-0"

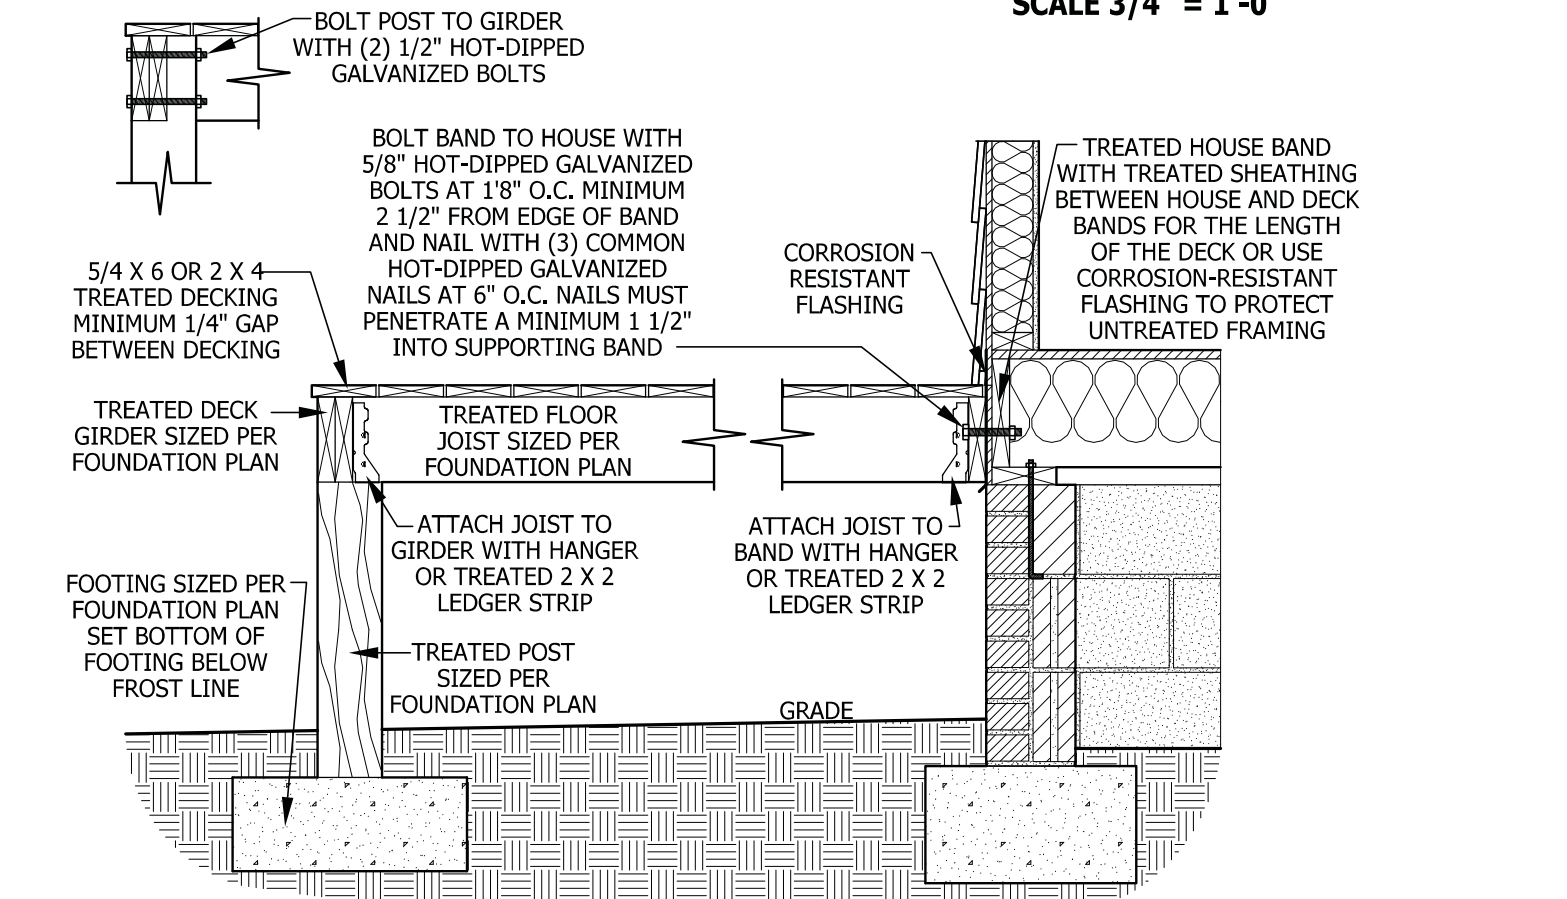

**G DECK ATTACHMENT DETAIL TO FRAMED WALL**  
SCALE 3/4" TO 1'-0"

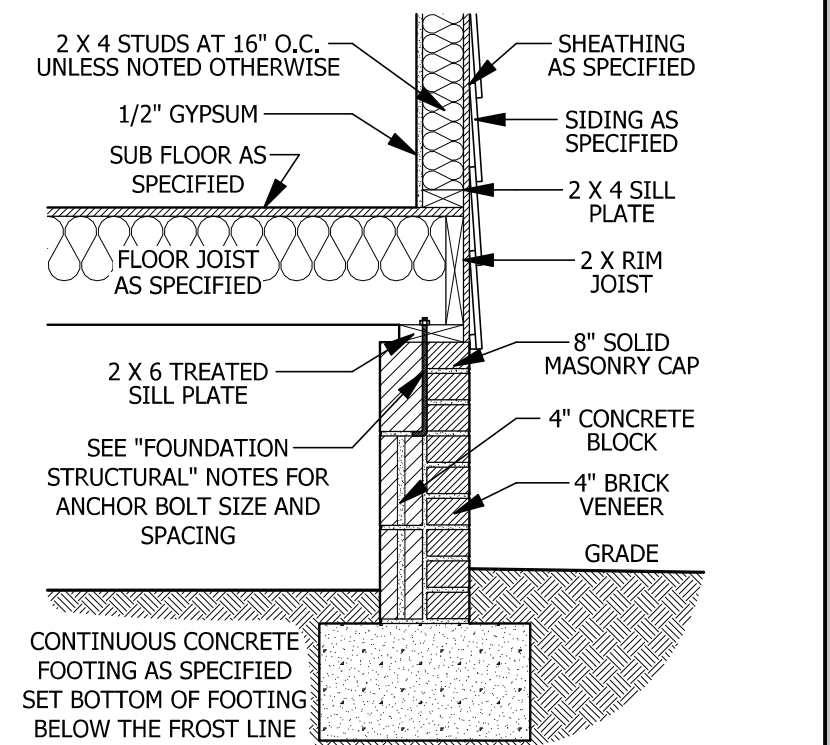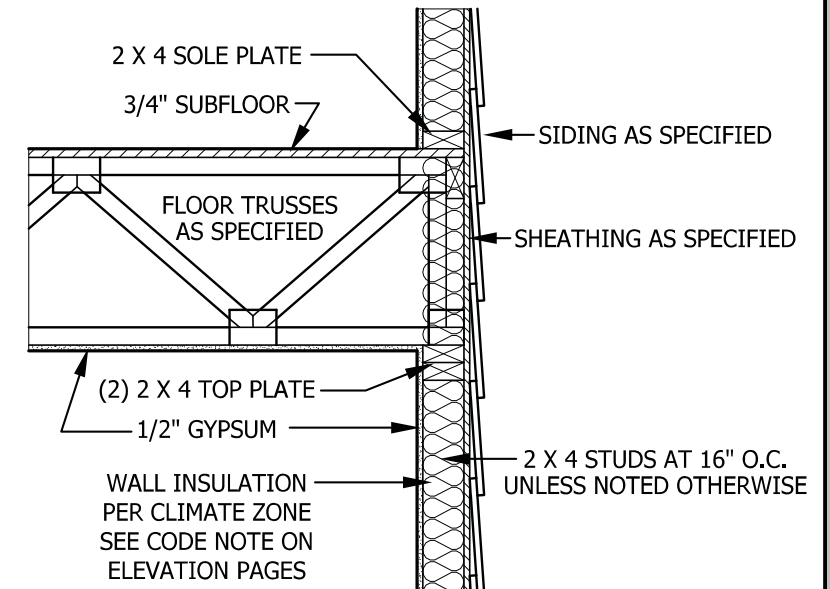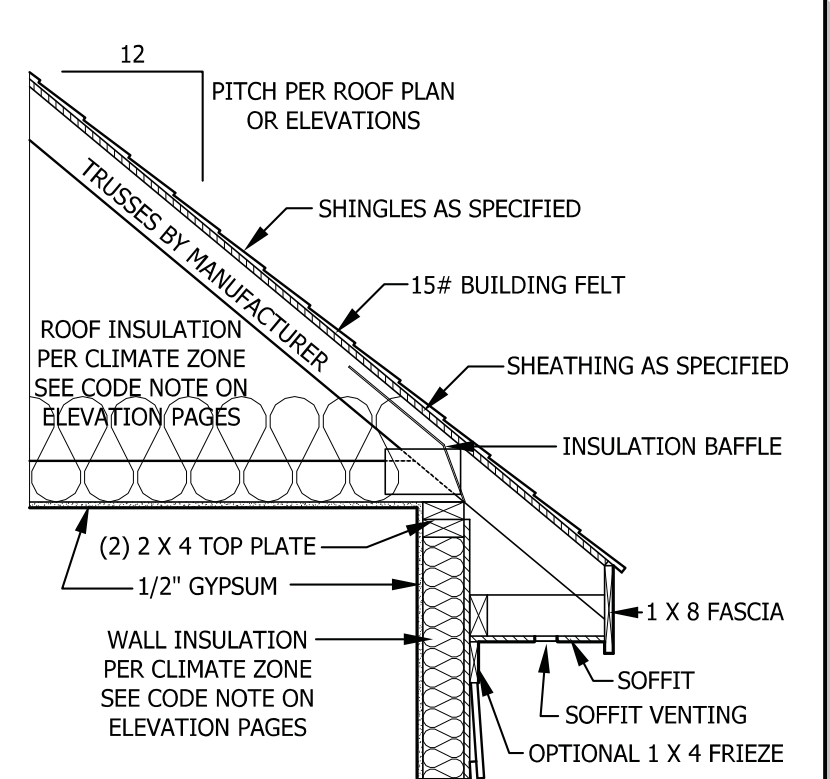

**H I J TYPICAL WALL DETAIL**  
SCALE 3/4" = 1'-0"

**DECK STAIR NOTES**


**SECTION AM110**  
**AM110.1 Stairs shall be constructed per Figure AM110.** Stringer spans shall be no greater than 7 foot span between supports. Spacing between stringers shall be based upon decking material used per AM107.1. Each Stringer shall have minimum 3 1/2 inches between step cut and back of stringer. If used, suspended headers shall be attached with 3/8 inch galvanized bolts with nuts and washers to securely support stringers at the top.

**DECK BRACING**

**SECTION AM109**  
**AM109.1 Deck bracing.** Decks shall be braced to provide lateral stability. The following are acceptable means to provide lateral stability.  
**AM109.1.1.** When the deck floor height is less than 4'-0" above finished grade per Figure AM109 and the deck is attached to the structure in accordance with Section AM104, lateral bracing is not required.  
**AM109.1.2.** 4 x 4 wood knee braces may be provided on each column in both directions. The knee braces shall attach to each post at a point not less than 1/3 of the post length from the top of the post, and the braces shall be angled between 45 degrees and 60 degrees from the horizontal. Knee braces shall be bolted to the post and the girder/double band with one 5/8 inch hot dipped galvanized bolt with nut and washer at both ends of the brace per Figure AM109.1  
**AM109.1.3.** For freestanding decks without knee braces or diagonal bracing, lateral stability may be provided by embedding the post in accordance with Figure AM109.2 and the following:  

| POST SIZE | MAX TRIBUTARY AREA | MAX. POST HEIGHT | EMBEDMENT DEPTH | CONCRETE DIAMETER |
|-----------|--------------------|------------------|-----------------|-------------------|
| 4 X 4     | 48 SF              | 4'-0"            | 2'-6"           | 1'-0"             |
| 6 X 6     | 120 SF             | 6'-0"            | 3'-6"           | 1'-8"             |

  
**AM109.1.4.** 2 x 6 diagonal vertical cross bracing may be provided in two perpendicular directions for freestanding decks or parallel to the structure at the exterior column line for attached decks. The 2 x 6's shall be attached to the posts with one 5/8 inch hot dipped galvanized bolt with nut and washer at each end of each bracing member per Figure AM109.3.  
**AM109.1.5.** For embedment of piles in Coastal Regions, see Chapter 45.

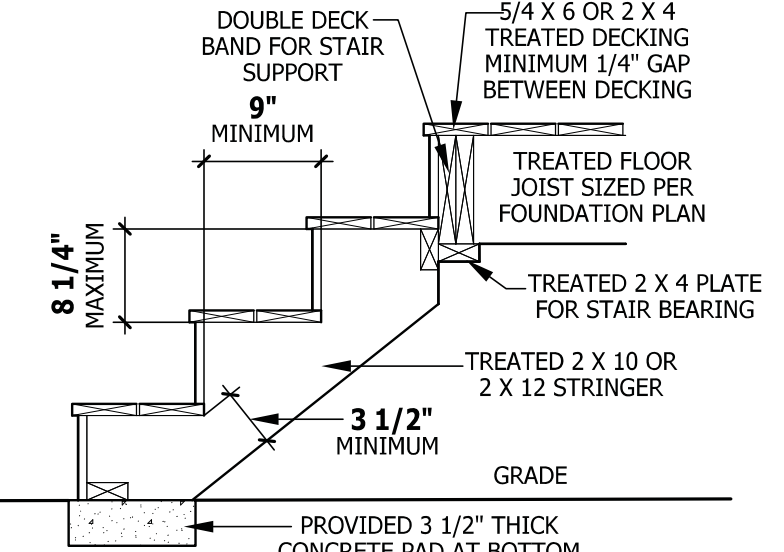


**H FIGURE AM110 TYPICAL DECK STAIR DETAIL**  
SCALE 3/4" = 1'-0"

**SMOKE ALARMS**

**SECTION R314**  
**R314.1 Smoke detection and notification.** All smoke alarms shall be listed in accordance with UL 217 and installed in accordance with the provisions of this code and the household fire warning equipment provisions of NFPA 72.  
**R314.2 Smoke detection systems.** Household fire alarm systems installed in accordance with NFPA 72 that include smoke alarms, or a combination of smoke detector and audible notification device installed as required by this section for smoke alarms, shall be permitted. The household fire alarm system shall provide the same level of smoke detection and alarm as required by this section for smoke alarms. Where a household fire warning system is installed using a combination of smoke detector and audible notification device(s), it shall become a permanent fixture of the occupancy and owned by the homeowner. The system shall be monitored by an approved supervising station and be maintained in accordance with NFPA 72.  
**Exception:** Where smoke alarms are provided meeting the requirements of Section R314.4.  
**R314.3 Location.** Smoke alarms shall be installed in the following locations:  
1. In each sleeping room.  
2. Outside each separate sleeping area in the immediate vicinity of the bedrooms.  
3. On each additional story of the dwelling, including basements and habitable attics (finished) but not including crawl spaces, uninhabitable (unfinished) attics and uninhabitable (unfinished) attics-stories. In dwellings or dwelling units with split levels and without an intervening door between the adjacent levels, a smoke alarm installed on the upper level shall suffice for the adjacent lower level provided that the lower level is less than one full story below the upper level.  
When more than one smoke alarm is required to be installed within an individual dwelling unit the alarm devices shall be interconnected in such a manner that the actuation of one alarm will activate all of the alarms in the individual unit.  
**R314.4 Power source.** Smoke alarms shall receive their primary power from the building wiring when such wiring is served from a commercial source, and when primary power is interrupted, shall receive power from a battery. Wiring shall be permanent and without a disconnecting switch other than those required for overcurrent protection. Smoke alarms shall be interconnected.

**WEEP SCREEDS**


All weep screeds and stone veneer to be installed per manufacturers instructions and per the 2012 North Carolina Residential Building code.  
**R703.6.2.1** - A minimum 0.019-inch (0.5 mm) (No. 26 galvanized sheet gage), corrosion-resistant weep screed or plastic weep screed, with a minimum vertical attachment flange of 31/2 inches (89 mm) shall be provided at or below the foundation plate line on exterior stud walls in accordance with ASTM C 926. The weep screed shall be placed a minimum of 4 inches (102 mm) above the earth or 2 inches (51 mm) above paved areas and shall be of a type that will allow trapped water to drain to the exterior of the building. The weather-resistant barrier shall lap the attachment flange. The exterior lath shall cover and terminate on the attachment flange of the weep screed.

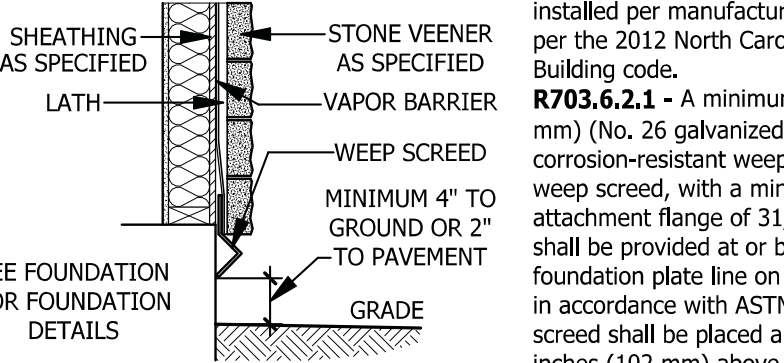

**I WEEP SCREED**  
SCALE 3/4" = 1'-0"

**STAIRWAY NOTES**

**R311.7**  
**R311.7.2 Headroom.** The minimum headroom in all parts of the stairway shall not be less than 6 feet 8 inches (2032 mm) measured vertically from the sloped line adjoining the tread nosing or from the floor surface of the landing or platform on that portion of the stairway.  
**R311.7.4 Stair treads and risers.** Stair treads and risers shall meet the requirements of this section. For the purposes of this section all dimensions and dimensional surfaces shall be exclusive of carpets, rugs or runners.  
**R311.7.4.1 Riser height.** The maximum riser height shall be 8 1/4 inches (210 mm). The riser shall be measured vertically between leading edges of the adjacent treads.  
**R311.7.4.2 Tread depth.** The minimum tread depth shall be 9 inches (229 mm). The tread depth shall be measured horizontally between the vertical planes of the foremost projection of adjacent treads and at a right angle to the tread's leading edge. Winder treads shall have a minimum tread depth of 9 inches (229 mm) measured as above at a point 12 inches (305 mm) from the side where the treads are narrower. Winder treads shall have a minimum tread depth of 4 inches (102 mm) at any point.  
**R311.7.4.3 Profile.** The radius of curvature at the nosing shall be no greater than 9/16 inch (14 mm). A nosing not less than 3/4 inch (19 mm) but not more than 1 1/4 inches (32 mm) shall be provided on stairways with solid risers.  
**R311.7.7 Handrails.** Handrails shall be provided on at least one side of each continuous run of treads or flight with four or more risers.  
**R311.7.7.1 Height.** Handrail height, measured vertically from the sloped plane adjoining the tread nosing, or finish surface of ramp slope, shall be not less than 34 inches (864 mm) and not more than 38 inches (965 mm).  
**Exceptions:**  
1. The use of a volute, turnout or starting easing shall be allowed over the lowest tread.  
2. When handrail fittings or bendings are used to provide continuous transition between flights, the transition from handrail to guardrail, or used at the start of a flight, the handrail height at the fittings or bendings shall be permitted to exceed the maximum height.  
**R311.7.7.2 Continuity.** Handrails for stairways shall be continuous for the full length of the flight, from a point directly above the top riser of the flight to a point directly above the lowest riser of the flight. Handrail ends shall be returned or shall terminate in newel posts or safety terminals. Handrails adjacent to a wall shall have a space of not less than 11/2 inch (38 mm) between the wall and the handrails.  
**Exceptions:**  
1. Handrails shall be permitted to be interrupted by a newel post.  
2. The use of a volute, turnout, starting easing or starting newel shall be allowed over the lowest tread.  
3. Two or more separate rails shall be considered continuous if the termination of the rails occurs within 6 inches (152 mm) of each other. If transitioning between a wall-mounted handrail and a guardrail/handrail, the wall-mounted rail must return into the wall.

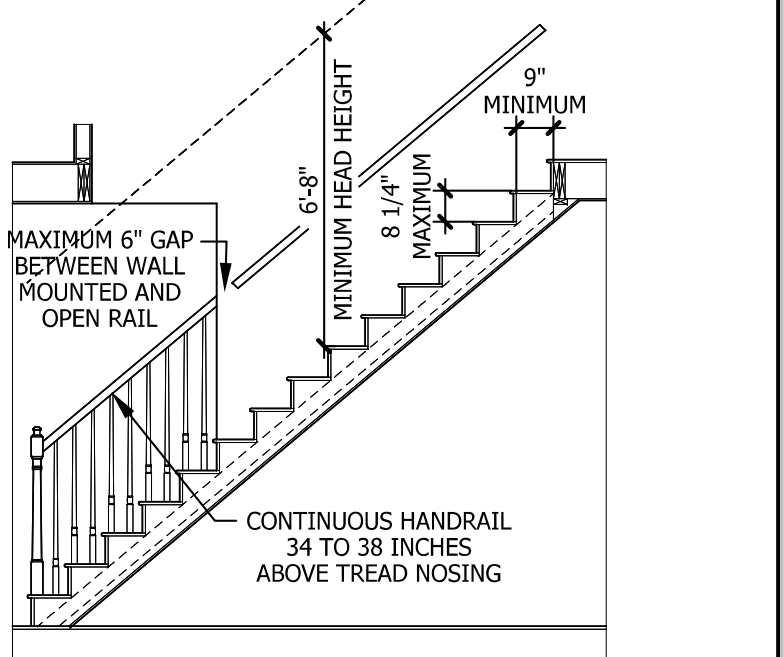

**J TYPICAL STAIR DETAIL**  
SCALE 1/4" = 1'-0"

PURCHASER MUST VERIFY ALL DIMENSIONS AND CONDITIONS BEFORE CONSTRUCTION BEGINS. HAYNES HOME PLANS, INC. ASSUMES NO LIABILITY FOR CONTRACTORS PRACTICES AND PROCEDURES. CODES AND CONDITIONS MAY VARY WITH LOCATION. A LOCAL DESIGNER, ARCHITECT OR ENGINEER SHOULD BE CONSULTED BEFORE CONSTRUCTION. THESE DRAWING ARE INSTRUMENTS OF SERVICE AND AS SUCH SHALL REMAIN PROPERTY OF THE DESIGNER.

**TYPICAL DETAILS**  
**The Lauren III**

**HAYNES WEAVER HOMES**  
HOME PLANS, INC.  
910.930.2100 • 919.606.4696  
350 Wagoner Drive, Fayetteville, NC 28303

**SQUARE FOOTAGE**  
**HEATED**  
FIRST FLOOR 1791 SQ.FT.  
TOTAL 1791 SQ.FT.  
**HEATED OPTIONAL**  
CAROLINA ROOM 148 SQ.FT.  
TOTAL 148 SQ.FT.  
**UNHEATED**  
FRONT PORCH 188 SQ.FT.  
GARAGE 657 SQ.FT.  
TOTAL 845 SQ.FT.  
**UNHEATED OPTIONAL**  
SCREENED PORCH 188 SQ.FT.  
DECK OR PATIO 292 SQ.FT.  
THIRD GARAGE 560 SQ.FT.  
TOTAL 1040 SQ.FT.

© Copyright 2020  
Haynes Home Plans, Inc.  
**4/29/2020**  
**200220B**  
**PAGE 6 OF 6**

PURCHASER MUST VERIFY ALL DIMENSIONS AND CONDITIONS BEFORE CONSTRUCTION BEGINS. HAYNES HOME PLANS, INC. ASSUMES NO LIABILITY FOR CONTRACTOR PRACTICES AND PROCEDURES. CODES AND CONDITIONS MAY VARY WITH LOCATION, A LOCAL DESIGNER, ARCHITECT OR ENGINEER SHOULD BE CONSULTED BEFORE CONSTRUCTION. THESE DRAWING ARE INSTRUMENTS OF SERVICE AND AS SUCH SHALL REMAIN PROPERTY OF THE DESIGNER.

**SCREENED PORCH ADDENDUM**

**The Lauren III**

**HAYNES WEAVER HOMES**

910.630.2100 • 919.606.4696

350 Wagoner Drive, Fayetteville, NC 28303

**HAYNES HOME PLANS, INC.**

P.O. Box 702, Wake Forest, NC 27588 919-435-6180 FAX 1-866-491-0396

| SQUARE FOOTAGE    |             |
|-------------------|-------------|
| HEATED            |             |
| FIRST FLOOR       | 1791 SQ.FT. |
| TOTAL             | 1791 SQ.FT. |
| HEATED OPTIONAL   |             |
| CAROLINA ROOM     | 148 SQ.FT.  |
| TOTAL             | 148 SQ.FT.  |
| UNHEATED          |             |
| FRONT PORCH       | 188 SQ.FT.  |
| GARAGE            | 469 SQ.FT.  |
| TOTAL             | 657 SQ.FT.  |
| UNHEATED OPTIONAL |             |
| SCREENED PORCH    | 180 SQ.FT.  |
| DECK OR PATIO     | 108 SQ.FT.  |
| THIRD GARAGE      | 292 SQ.FT.  |
| TOTAL             | 560 SQ.FT.  |


© Copyright 2020  
Haynes Home Plans, Inc.  
4/29/2020  
200220B  
ADDENDUM




**RIGHT SIDE ELEVATION**  
SCALE 1/4" = 1'-0"

**REAR ELEVATION**  
SCALE 1/4" = 1'-0"


**LEFT SIDE ELEVATION**  
SCALE 1/4" = 1'-0"

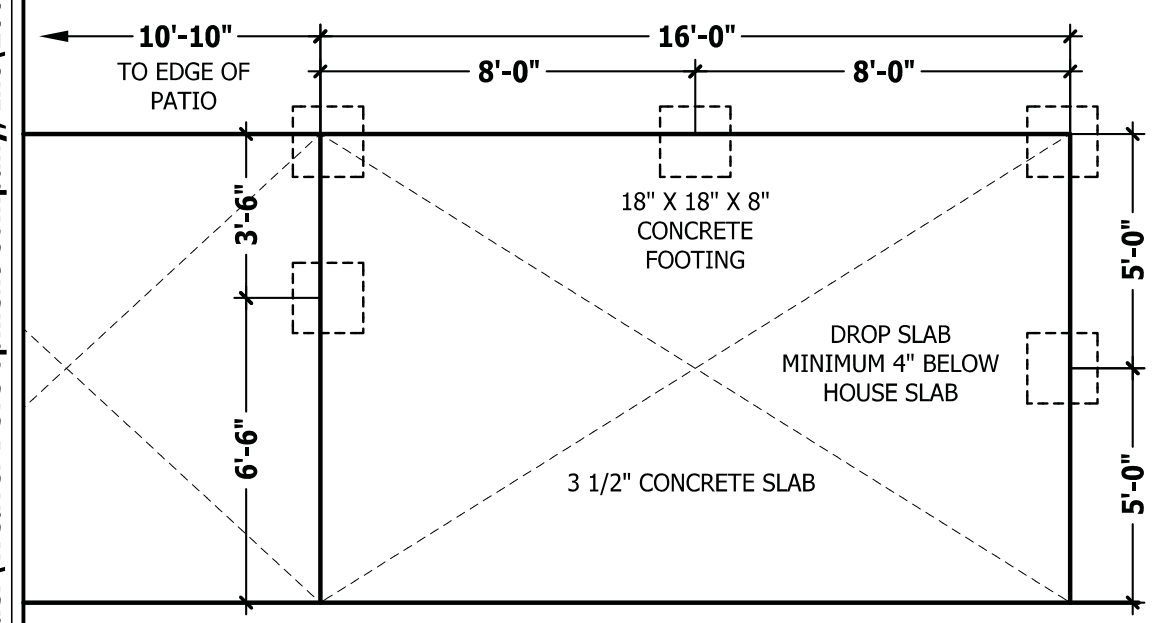


**MONOLITHIC SLAB PLAN**  
SCALE 1/4" = 1'-0"

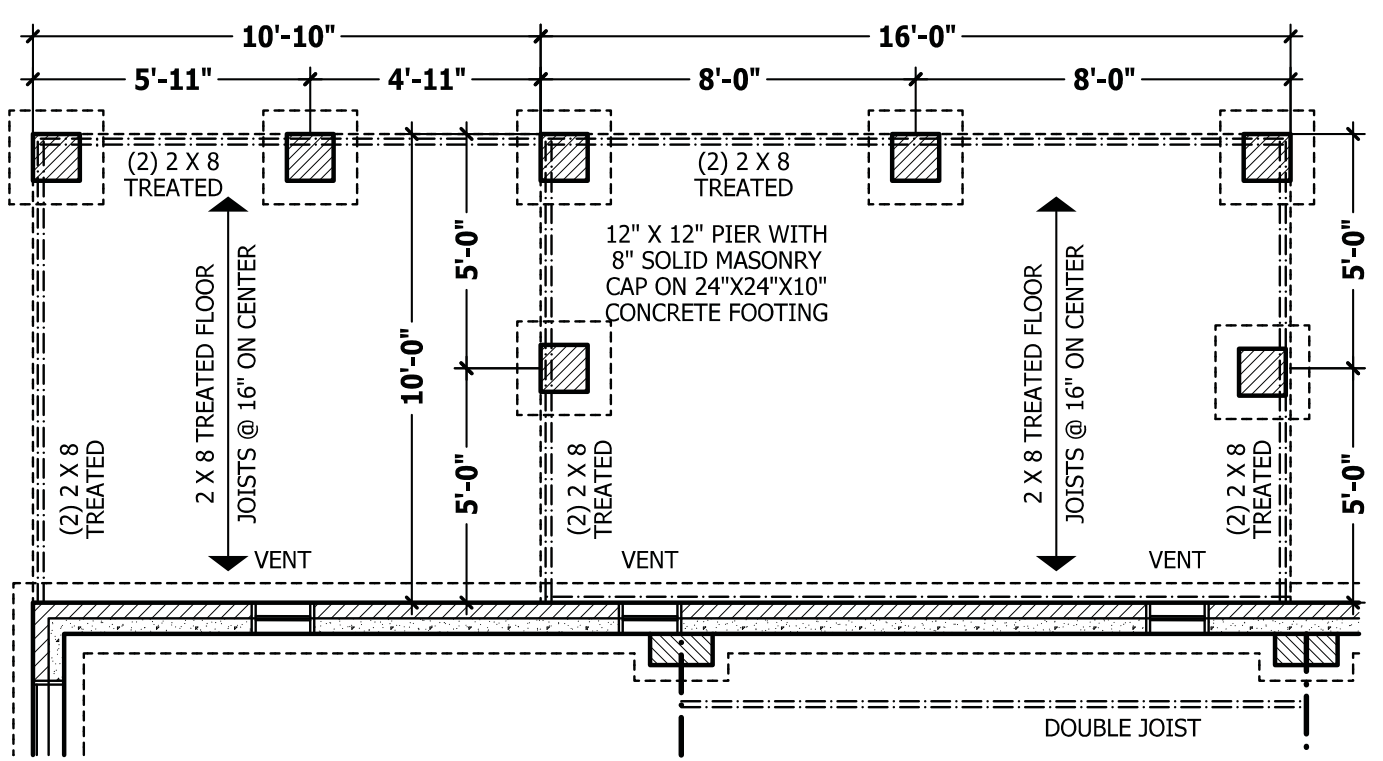


**CRAWL SPACE PLAN**  
SCALE 1/4" = 1'-0"

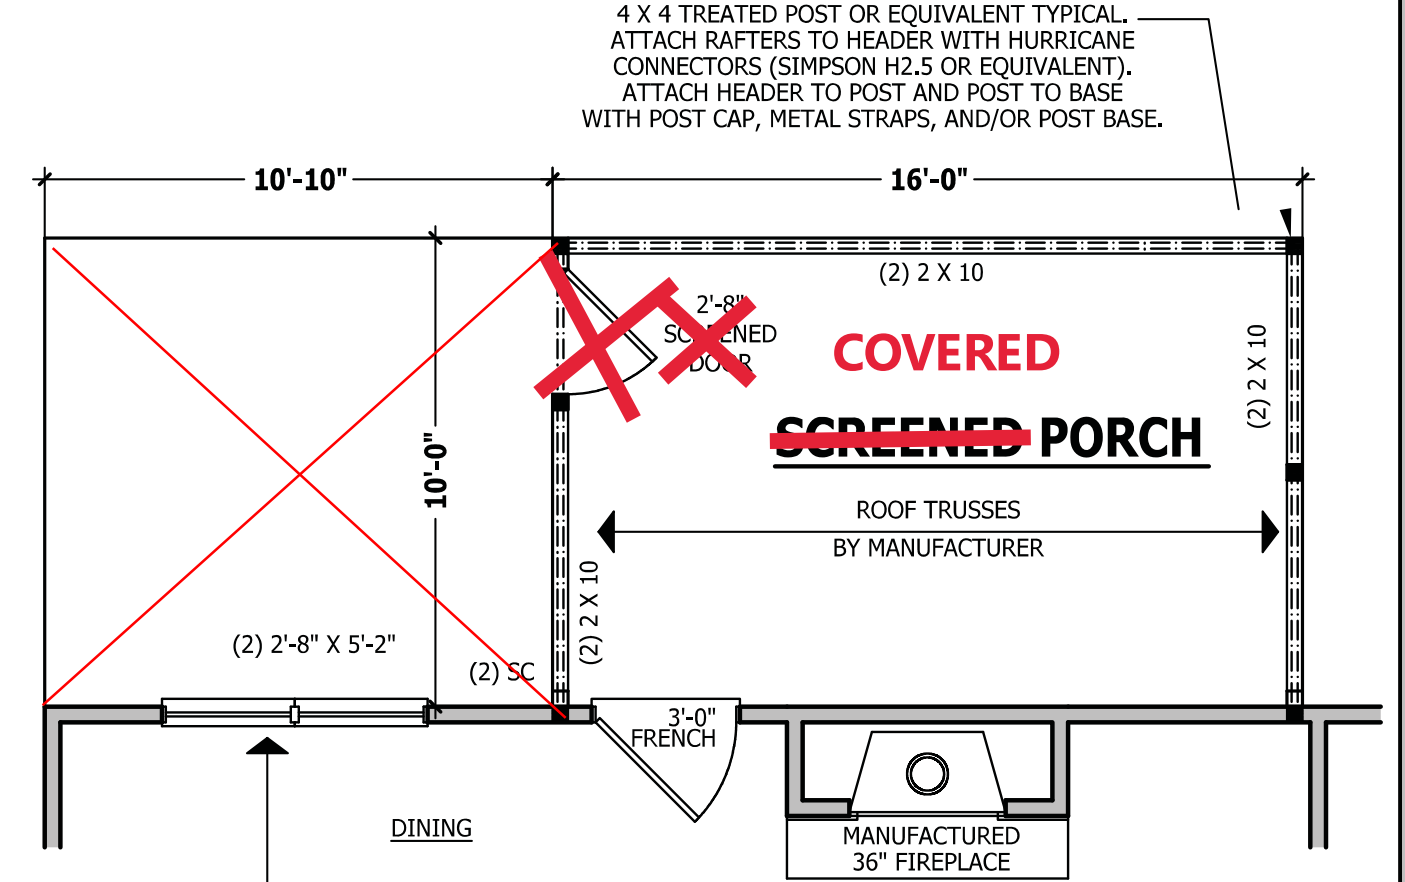

**FIRST FLOOR PLAN**  
SCALE 1/4" = 1'-0"

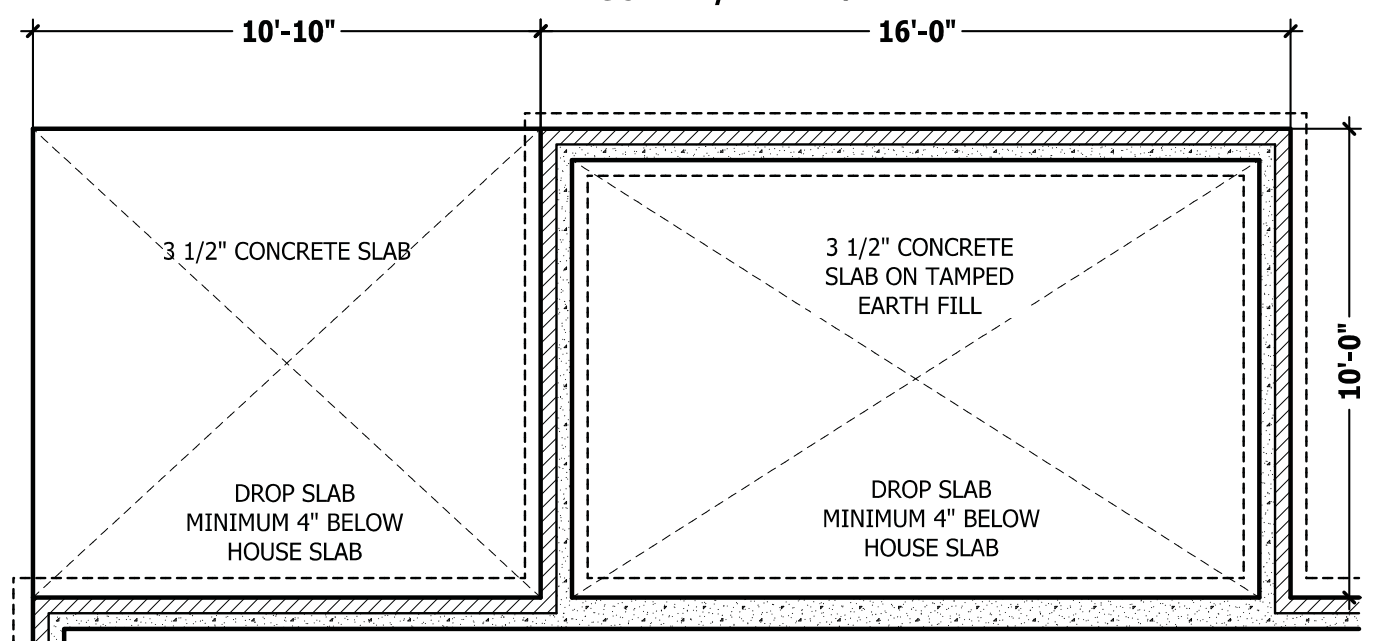


**STEM WALL SLAB**  
SCALE 1/4" = 1'-0"

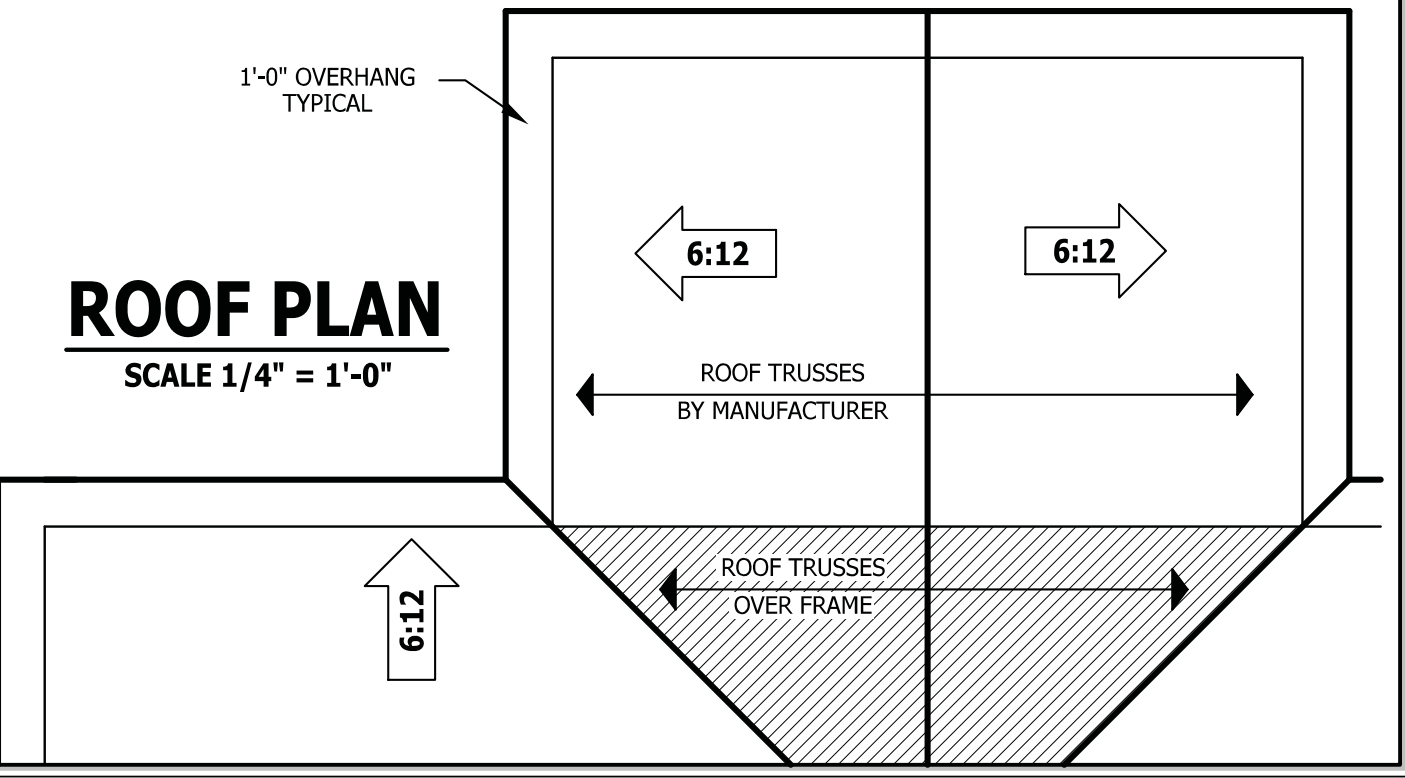


**ROOF PLAN**  
SCALE 1/4" = 1'-0"

Z:\Builder\Weaver Development Company, Inc\200220B Lauren III\200220B Lauren III.aec


PURCHASER MUST VERIFY ALL DIMENSIONS AND CONDITIONS BEFORE CONSTRUCTION BEGINS. HAYNES HOME PLANS, INC. ASSUMES NO LIABILITY FOR CONTRACTORS PRACTICES AND PROCEDURES. CODES AND CONDITIONS MAY VARY WITH LOCATION, A LOCAL DESIGNER, ARCHITECT OR ENGINEER SHOULD BE CONSULTED BEFORE CONSTRUCTION. THESE DRAWING ARE INSTRUMENTS OF SERVICE AND AS SUCH SHALL REMAIN PROPERTY OF THE DESIGNER.

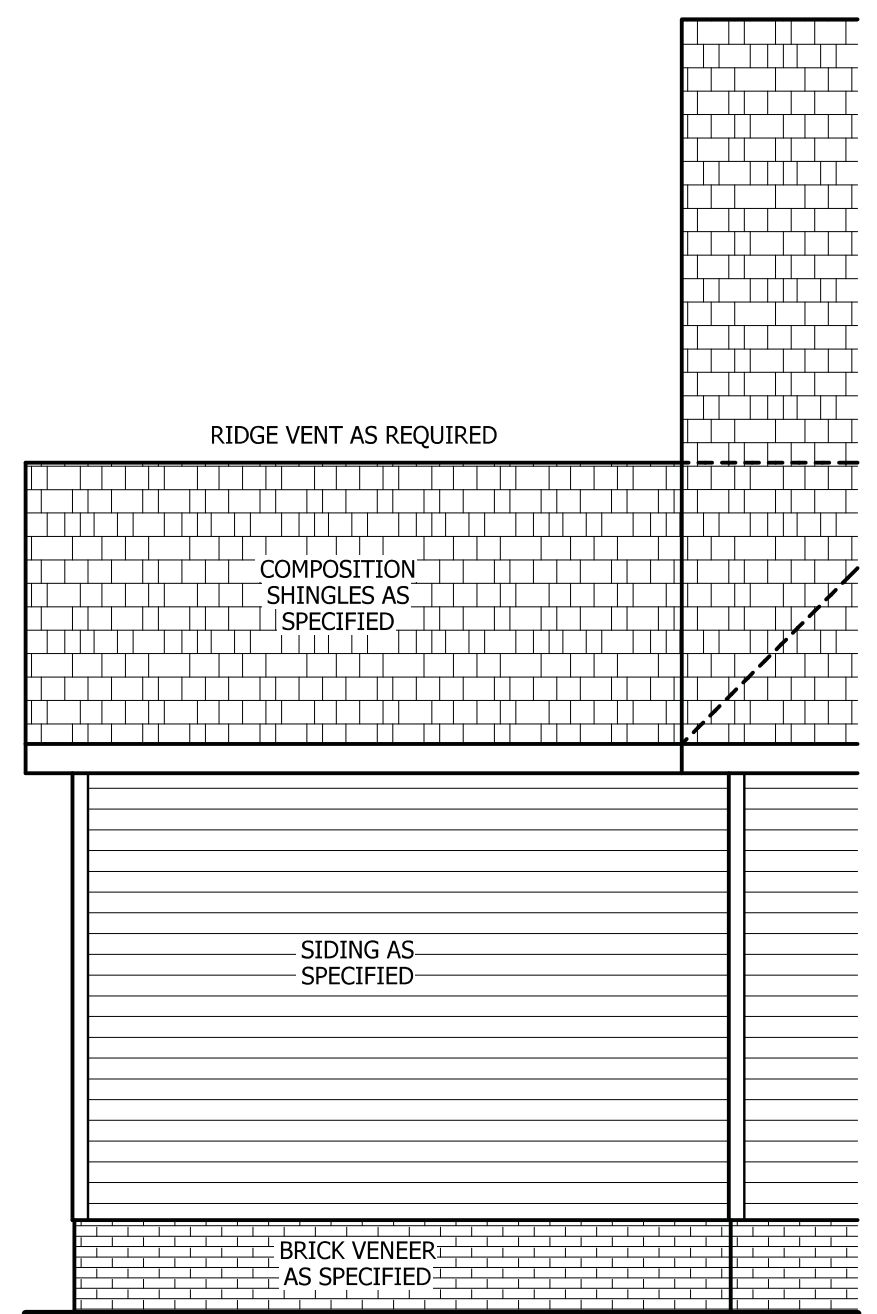

**REAR ELEVATION**  
SCALE 1/8" = 1'-0"

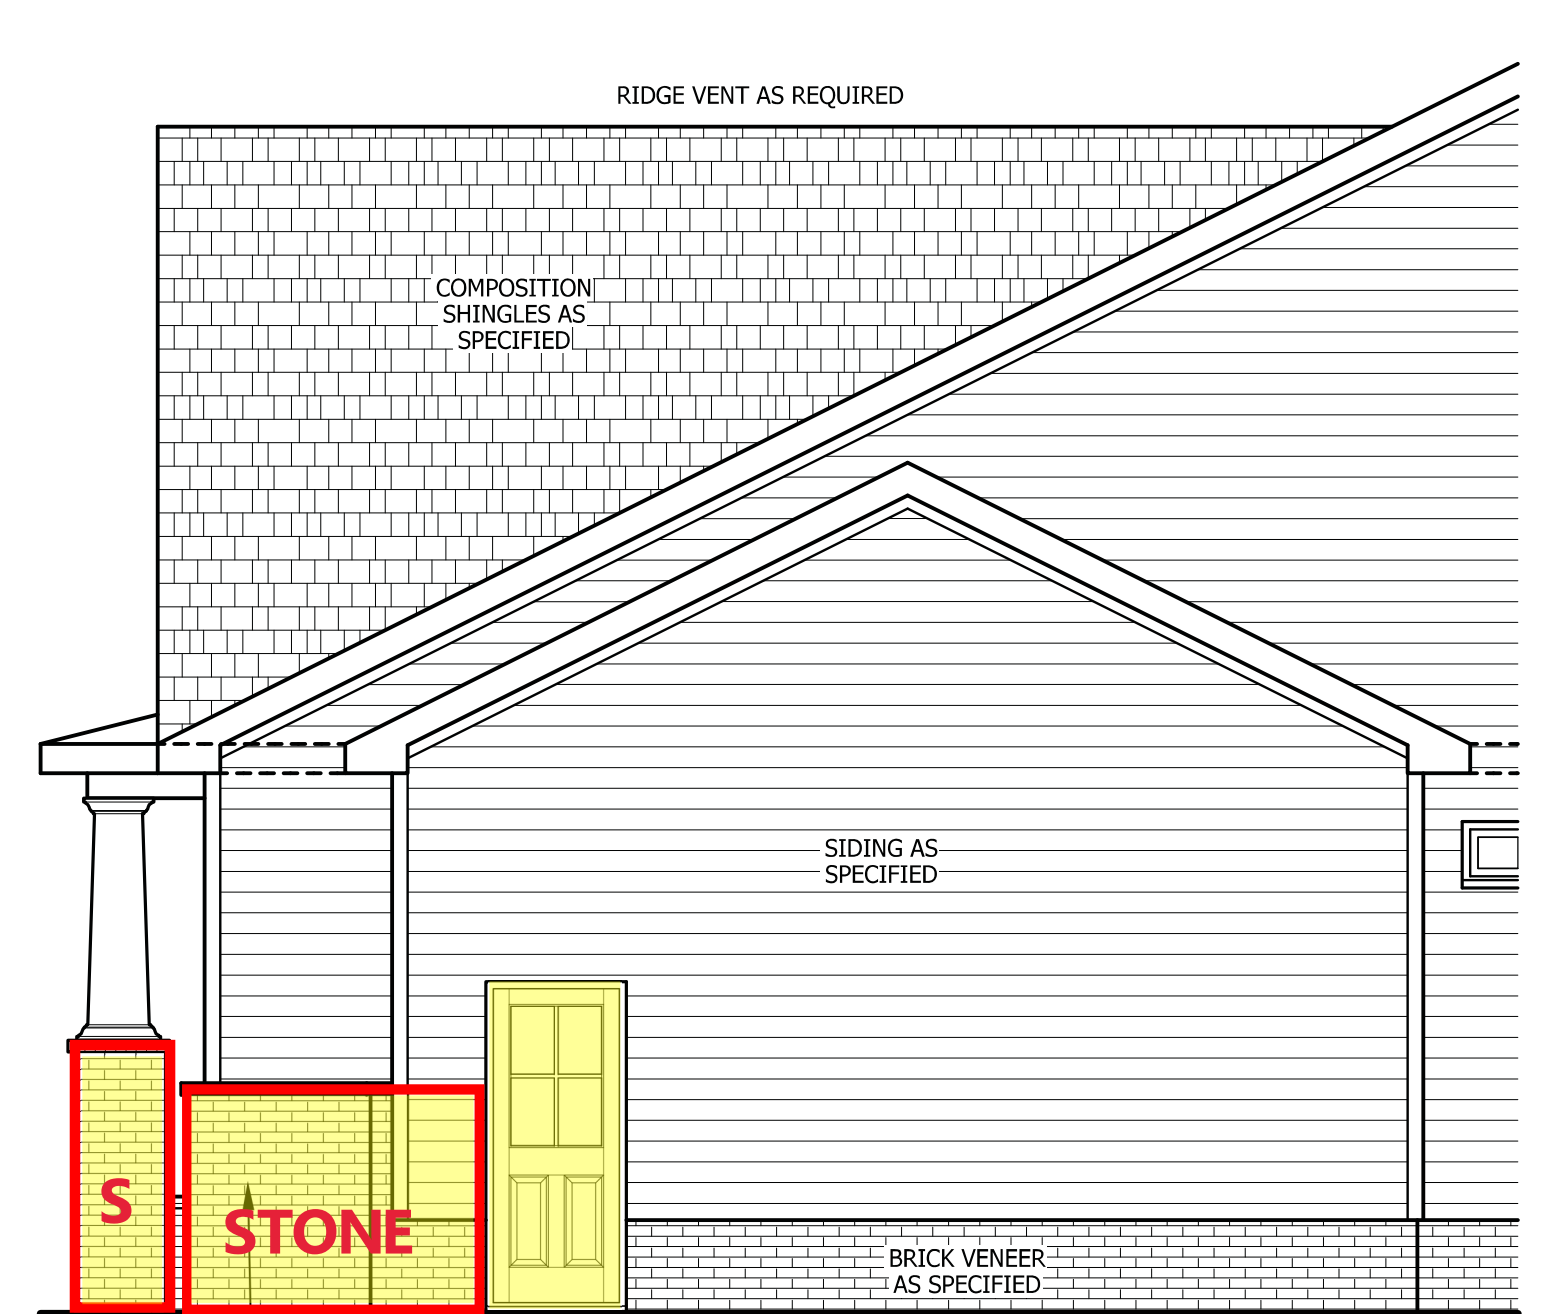


**RIGHT SIDE ELEVATION**  
SCALE 1/4" = 1'-0"

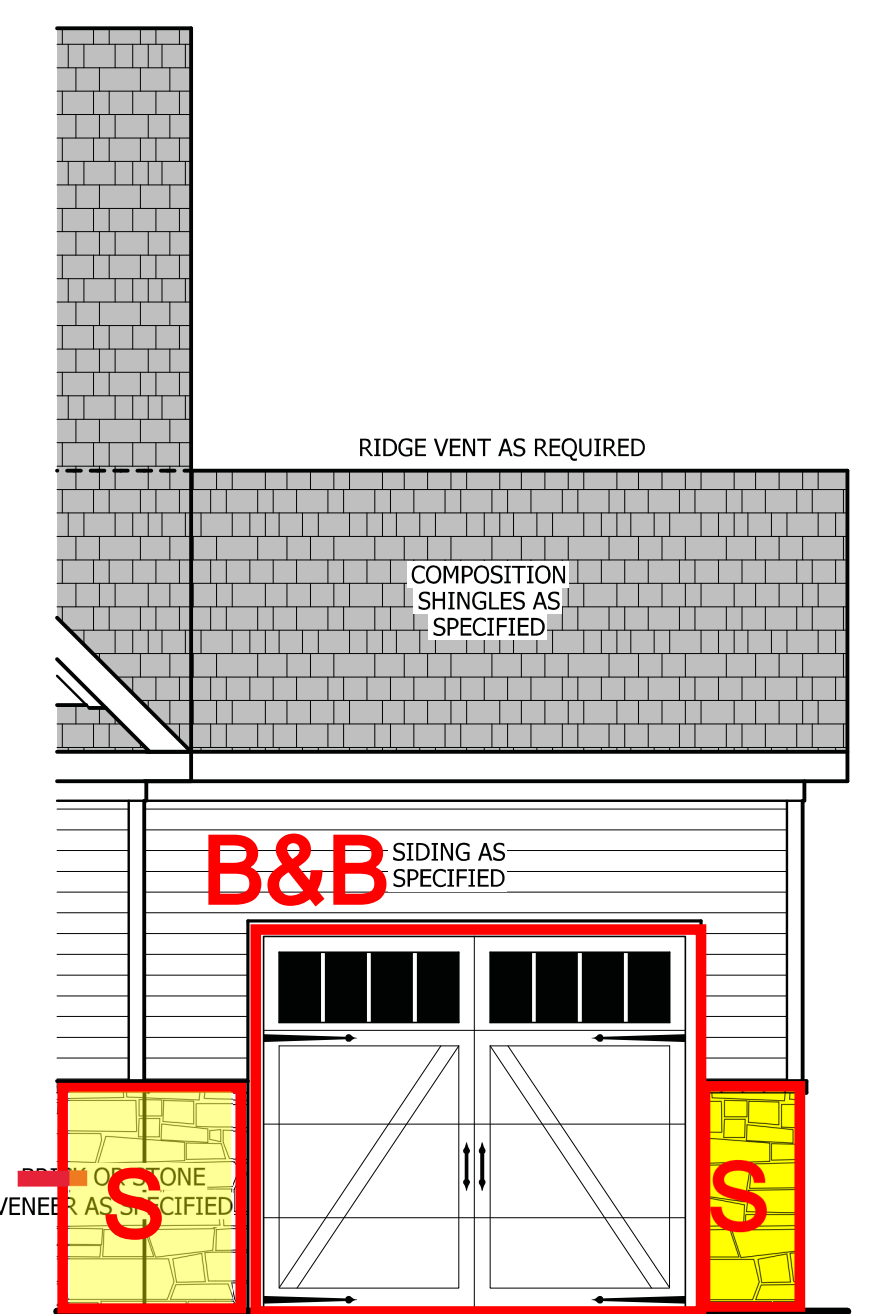


**FRONT ELEVATION**  
SCALE 1/4" = 1'-0"


SEE BASE PLAN FOR NOTES AND DETAILS

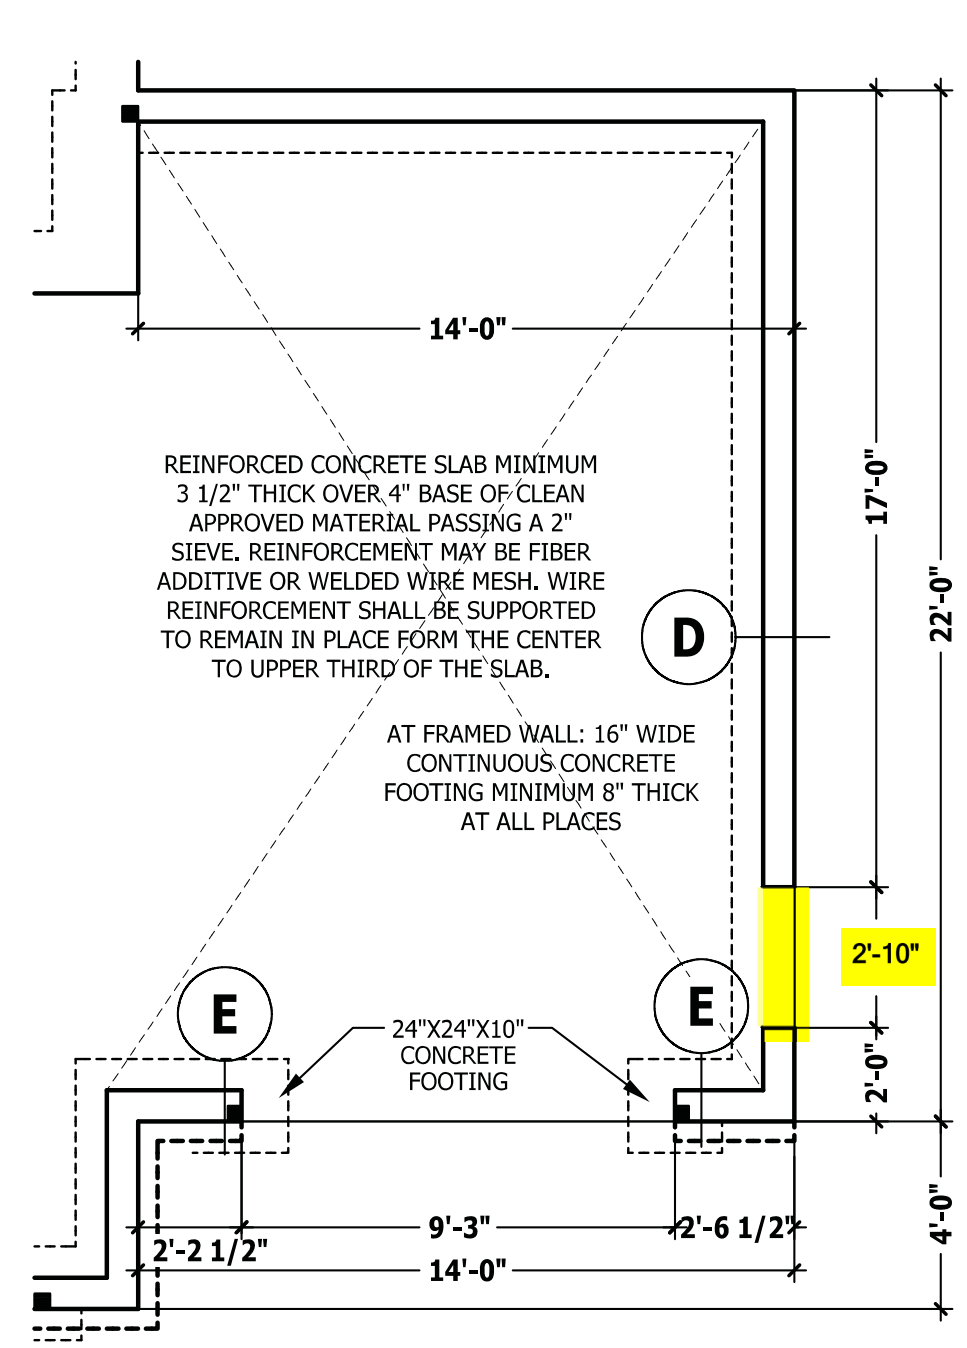


**MONOLITHIC SLAB PLAN**  
SCALE 1/4" = 1'-0"

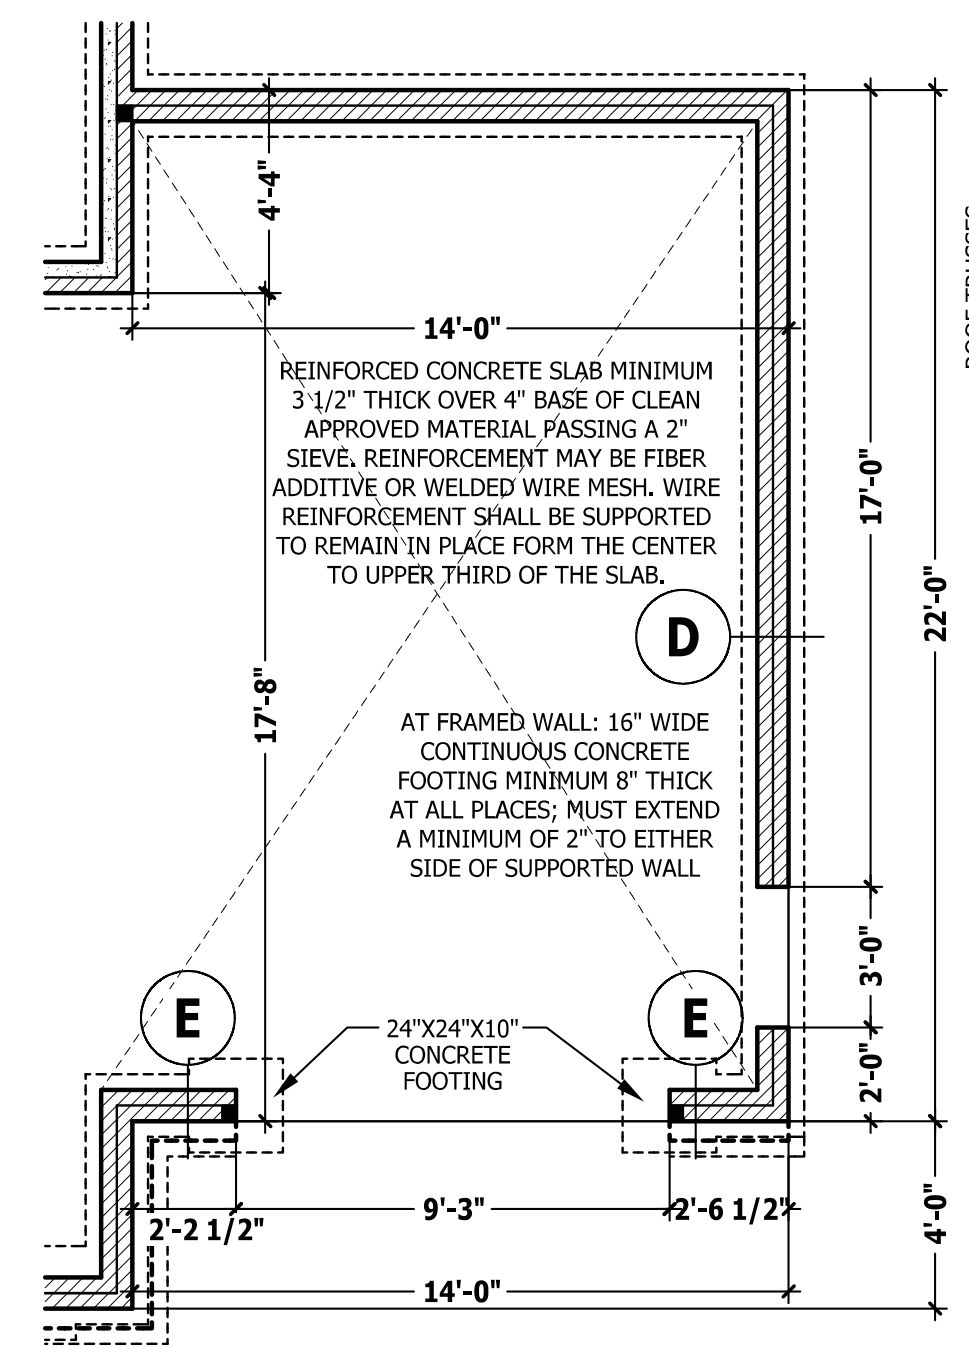

**CRAWL SPACE / STEM WALL**  
SCALE 1/4" = 1'-0"

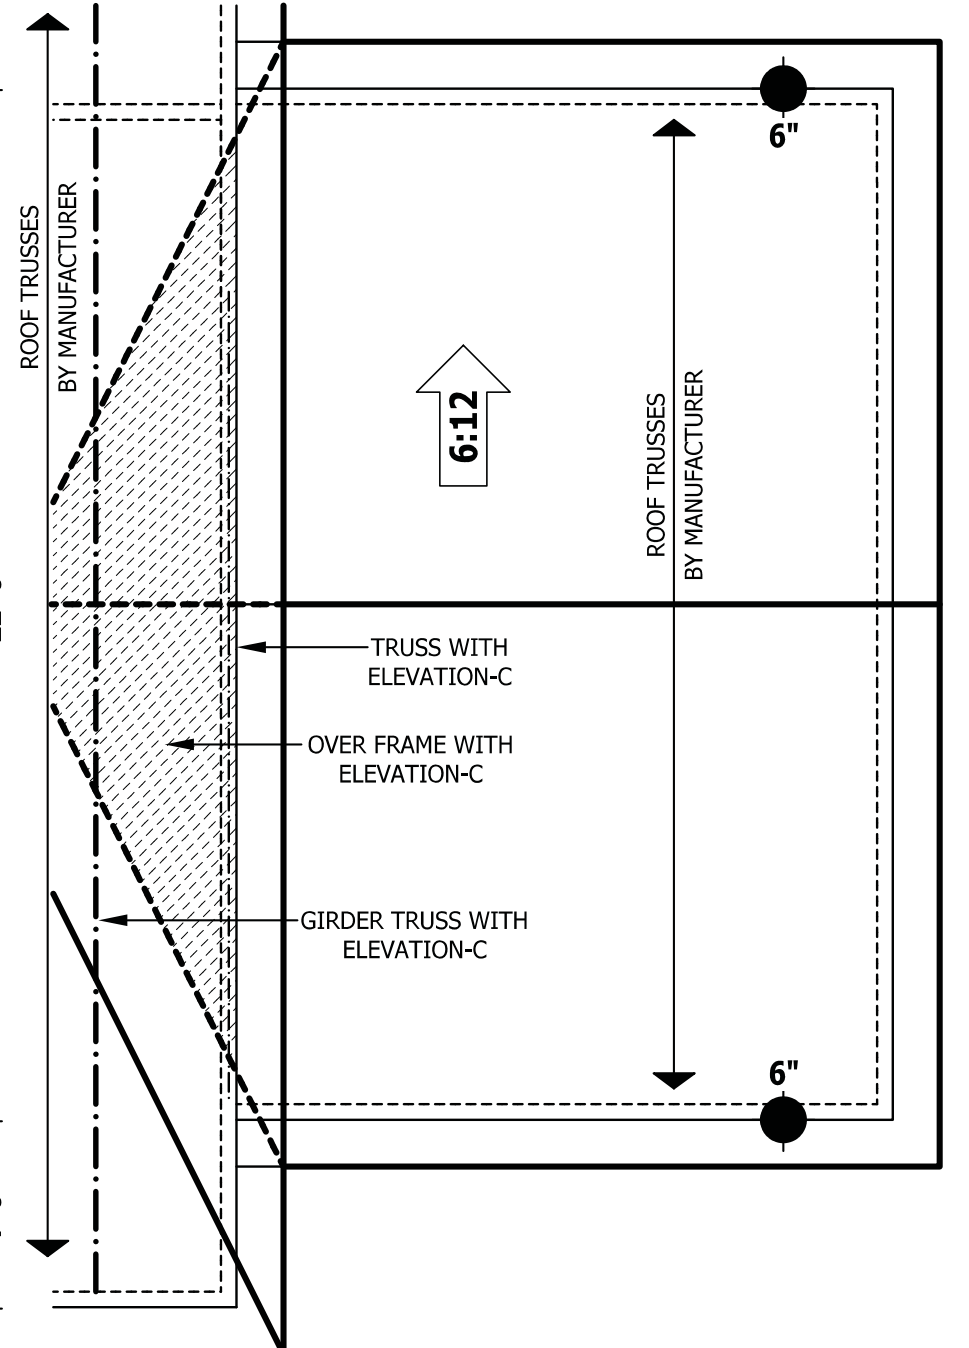

**ROOF PLAN**  
SCALE 1/4" = 1'-0"

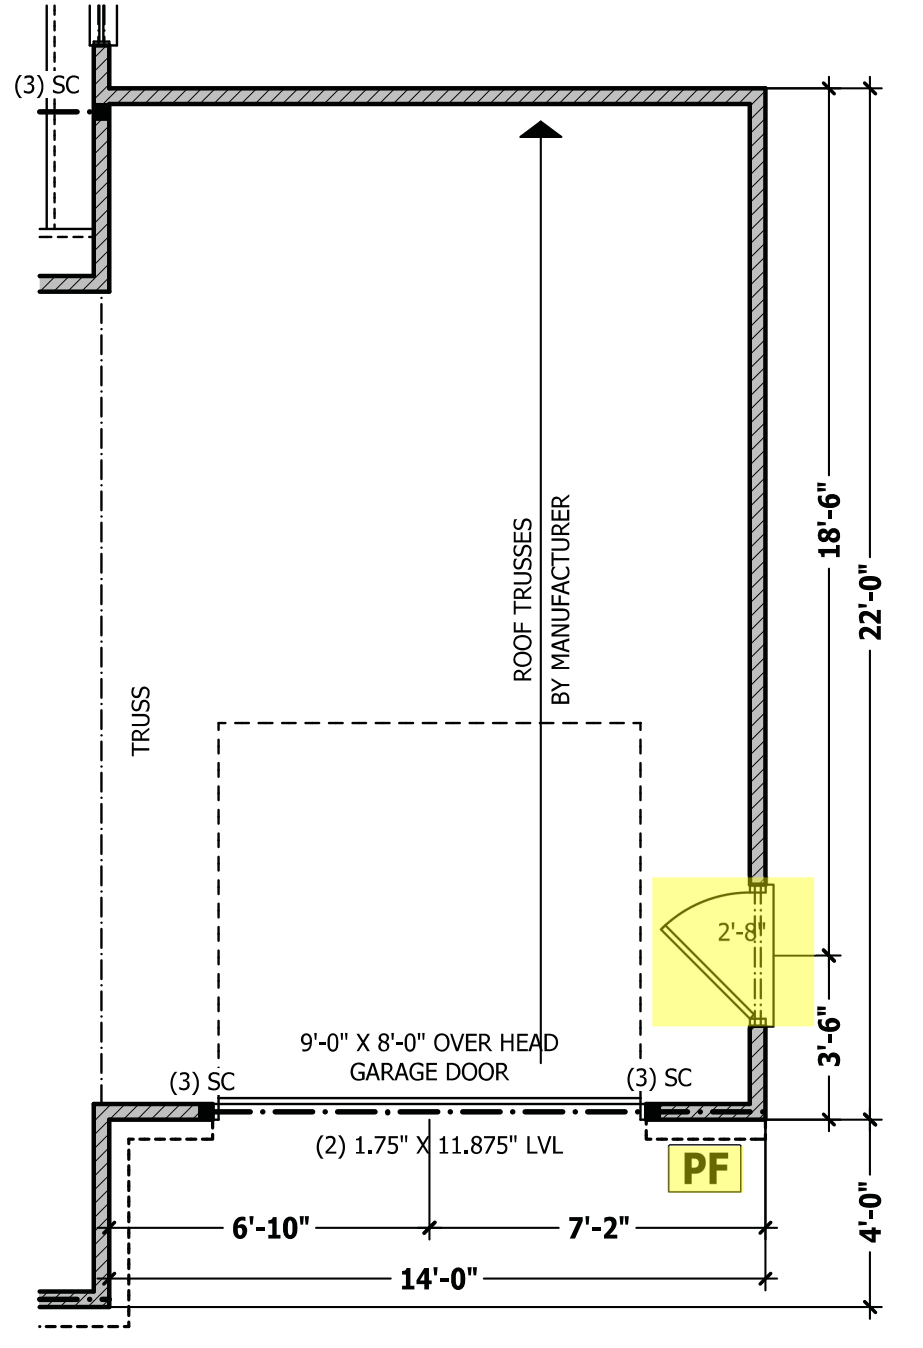

**FIRST FLOOR PLAN**  
SCALE 1/4" = 1'-0"

FRONT LOAD THIRD CAR

The Lauren III

HAYNES WEAVER HOMES


910.530.2100 • 919.606.4696  
350 Waggoner Drive, Fayetteville, NC 28303

HAYNES HOME PLANS, INC.  
P.O. Box 702, Wake Forest, NC 27588 919-435-6180 FAX 1-866-491-0396

| SQUARE FOOTAGE    |             |
|-------------------|-------------|
| HEATED            |             |
| FIRST FLOOR       | 1791 SQ.FT. |
| TOTAL             | 1791 SQ.FT. |
| HEATED OPTIONAL   |             |
| CAROLINA ROOM     | 148 SQ.FT.  |
| TOTAL             | 148 SQ.FT.  |
| UNHEATED          |             |
| FRONT PORCH       | 188 SQ.FT.  |
| GARAGE            | 469 SQ.FT.  |
| TOTAL             | 657 SQ.FT.  |
| UNHEATED OPTIONAL |             |
| SCREENED PORCH    | 180 SQ.FT.  |
| DECK OR PATIO     | 118 SQ.FT.  |
| THIRD GARAGE      | 292 SQ.FT.  |
| TOTAL             | 560 SQ.FT.  |

© Copyright 2020  
Haynes Home Plans, Inc.  
4/29/2020  
200220B  
ADDENDUM



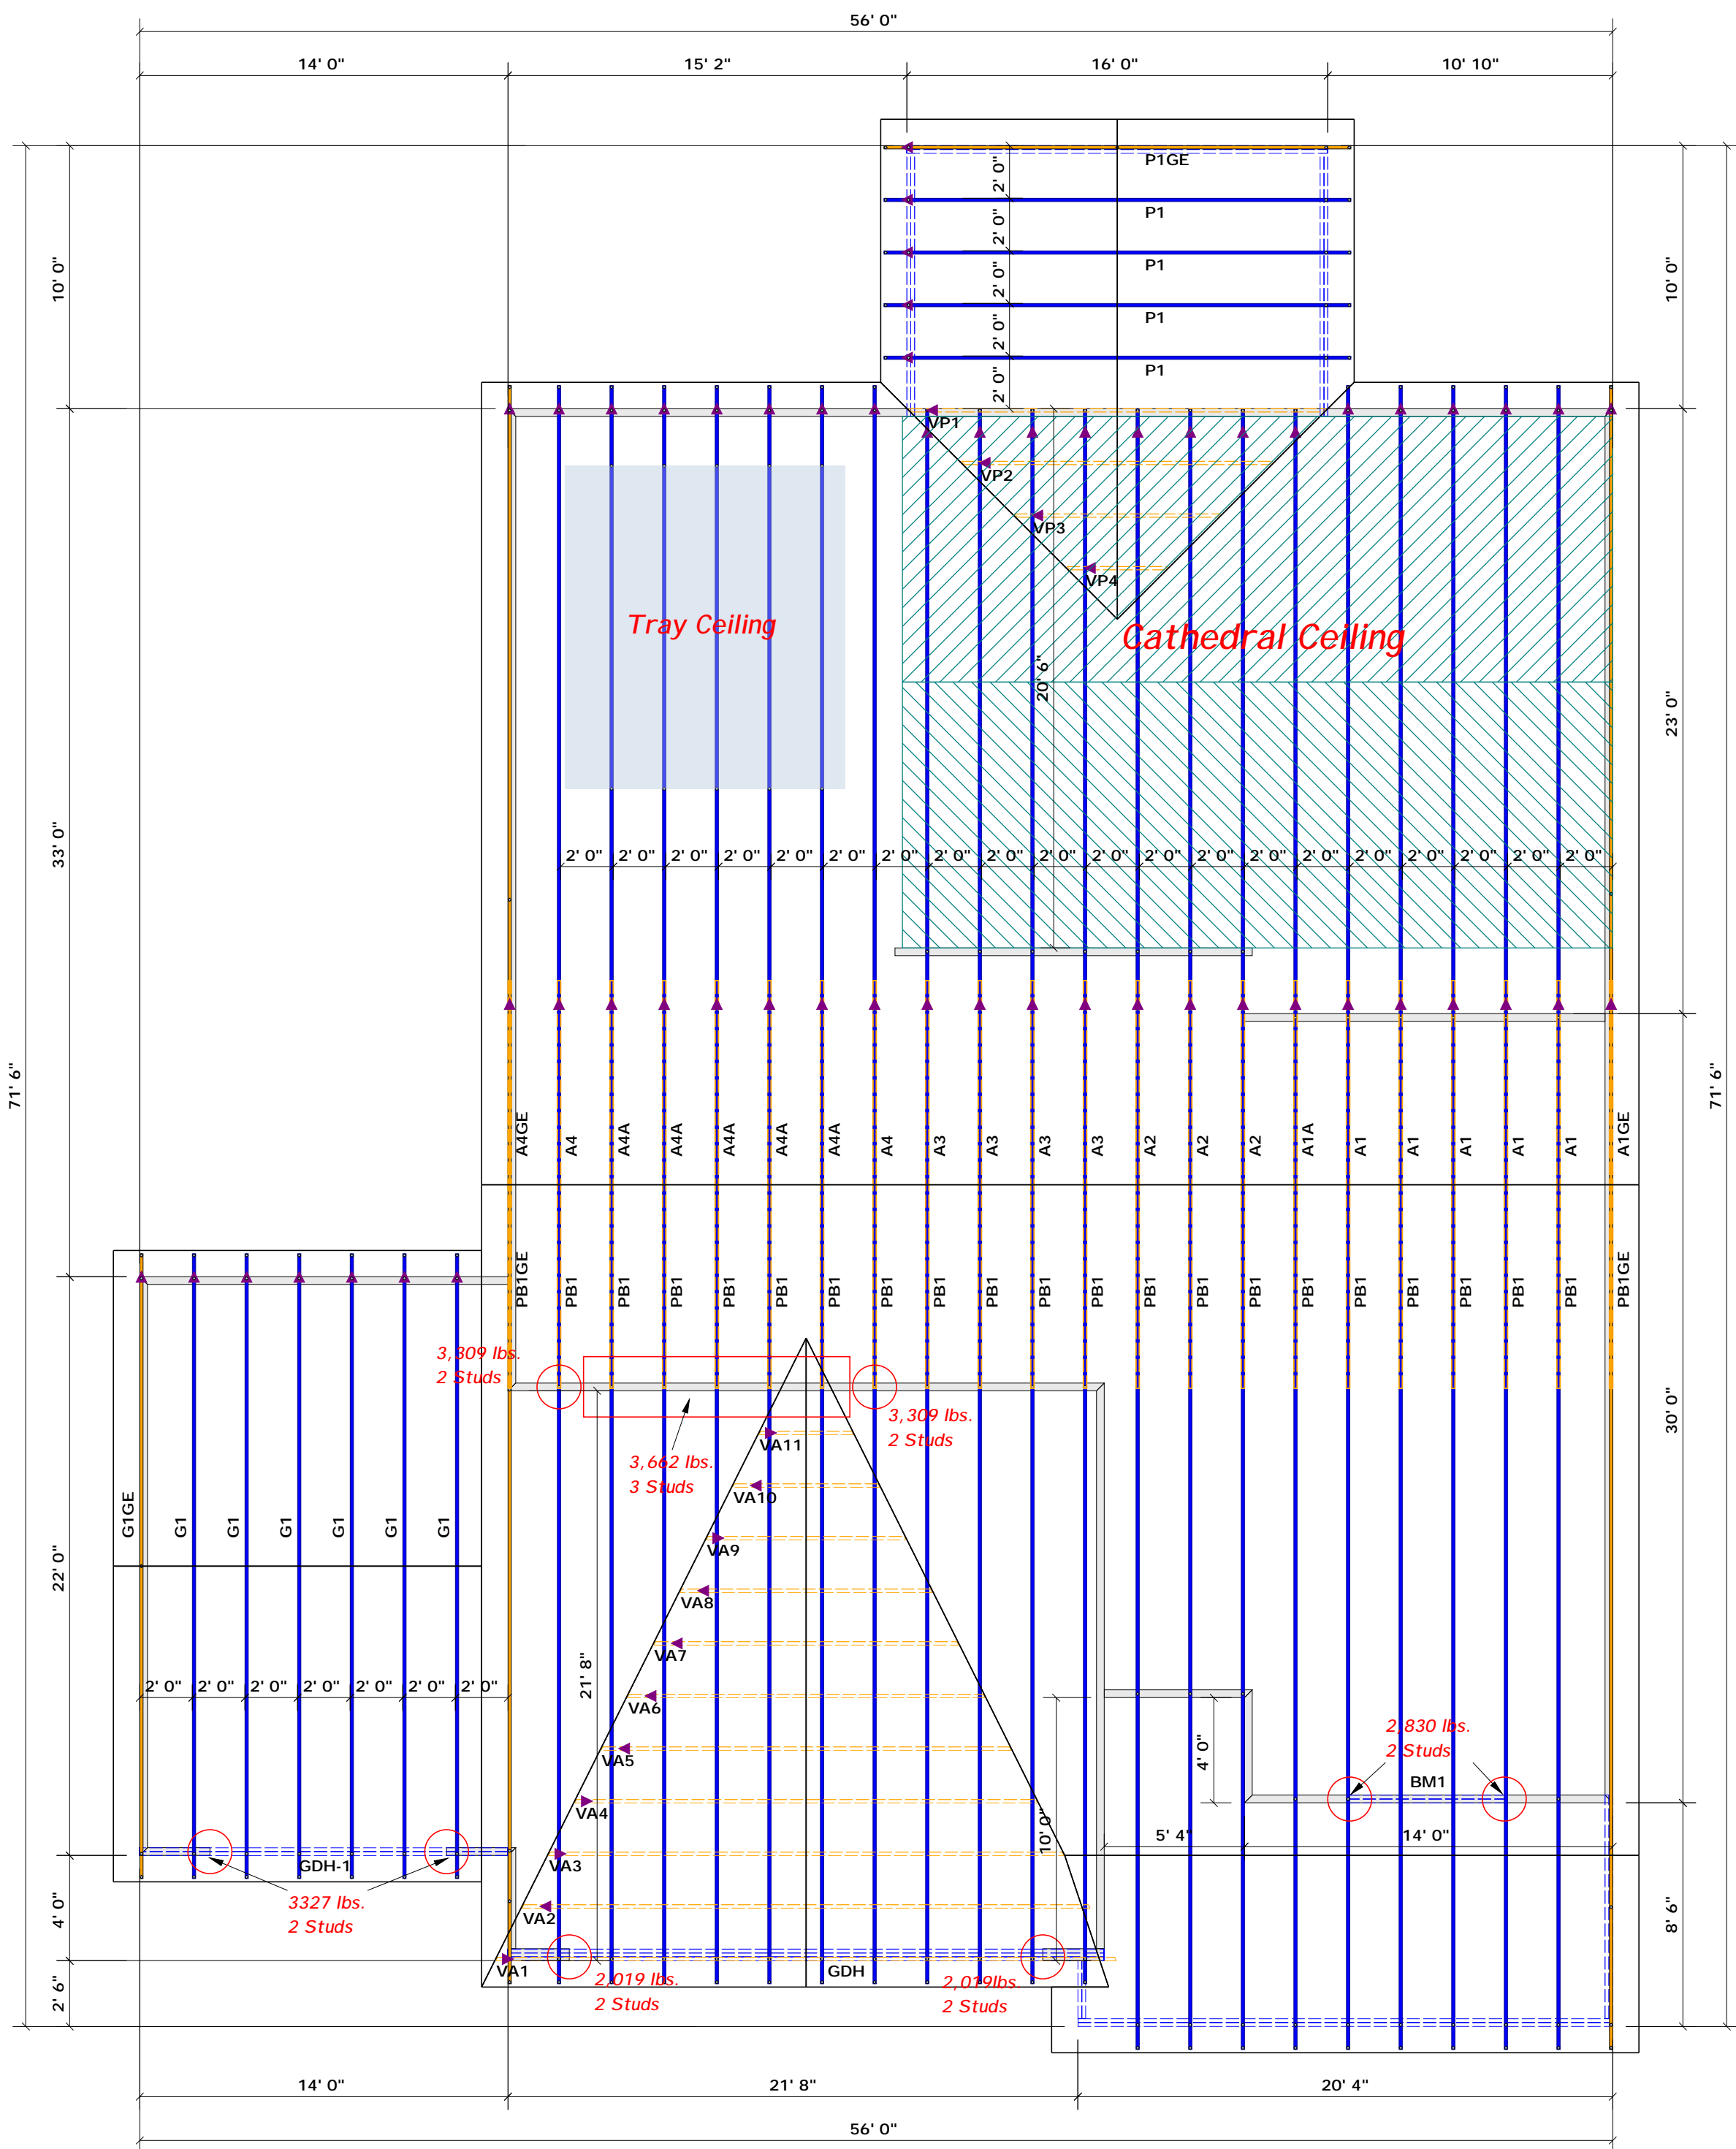

▲ = Denotes Left End of Truss  
 (Reference Engineered Truss Drawing)  
 Do Not Erect Trusses Backwards

All Truss Reactions are Less than 3,000 lbs. Unless Noted Otherwise.  
 ○ -- Denotes Reaction Greater than 3,000 lbs.

Truss Placement Plan  
 SCALE: 3/16" = 1'

| Beam Legend |        |                             |       |         |
|-------------|--------|-----------------------------|-------|---------|
| PlotID      | Length | Product                     | Plies | Net Qty |
| BM1         | 7' 0"  | 1-3/4"x 9-1/4" LVL Kerto-S  | 2     | 2       |
| GDH-1       | 14' 0" | 1-3/4"x 11-7/8" LVL Kerto-S | 2     | 2       |
| GDH         | 23' 0" | 1-3/4"x 16" LVL Kerto-S     | 3     | 3       |

| LOAD CHART FOR JACK STUDS |         |       |           |
|---------------------------|---------|-------|-----------|
| NO. JACKS                 | SPACING | LOAD  | NO. JACKS |
| 1700                      | 1       | 2550  | 1         |
| 3400                      | 2       | 5100  | 2         |
| 5100                      | 3       | 7650  | 3         |
| 6800                      | 4       | 10200 | 4         |
| 8500                      | 5       | 12750 | 5         |
| 10200                     | 6       | 15300 | 6         |
| 11900                     | 7       |       |           |
| 13600                     | 8       |       |           |
| 15300                     | 9       |       |           |


|           |                                   |           |                      |
|-----------|-----------------------------------|-----------|----------------------|
| BUILDER   | Weaver Development                | COUNTY    | Harnett              |
| JOB NAME  | Lot 1B Williams Farm              | ADDRESS   | Lot 1B Williams Farm |
| PLAN      | Lauren III / Elev. A / 3 Car / CP | MODEL     | Roof                 |
| SEAL DATE | 4/29/20                           | DATE REV. | / /                  |
| QUOTE #   | Quote #                           | DRAWN BY  | Curtis Quick         |
| JOB #     | J0521-2779                        | SALESMAN  | Lenny Norris         |

THIS IS A TRUSS PLACEMENT DIAGRAM ONLY. These trusses are designed as individual building components to be incorporated into the building design at the specification of the building designer. See individual design sheets for each truss design identified on the placement drawing. The building designer is responsible for temporary and permanent bracing of the roof and floor system and for the overall structure. The design of the truss support structure including headers, beams, walls, and columns is the responsibility of the building designer. For general guidance regarding bracing, consult BCSH-B1 and BCSH-B3 provided with the truss delivery package or online @ sbcindustry.com

Bearing reactions less than or equal to 3000# are deemed to comply with the prescriptive Code requirements. The contractor shall refer to the attached Tables ( derived from the prescriptive Code requirements ) to determine the minimum foundation size and number of wood studs required to support reactions greater than 3000# but not greater than 15000#. A registered design professional shall be retained to design the support system for any reaction that exceeds those specified in the attached Tables. A registered design professional shall be retained to design the support system for all reactions that exceed 15000#.

Signature: Curtis Quick

**ROOF & FLOOR TRUSSES & BEAMS**  
 Reilly Road Industrial Park  
 Fayetteville, N.C. 28309  
 Phone: (910) 864-8787  
 Fax: (910) 864-4444

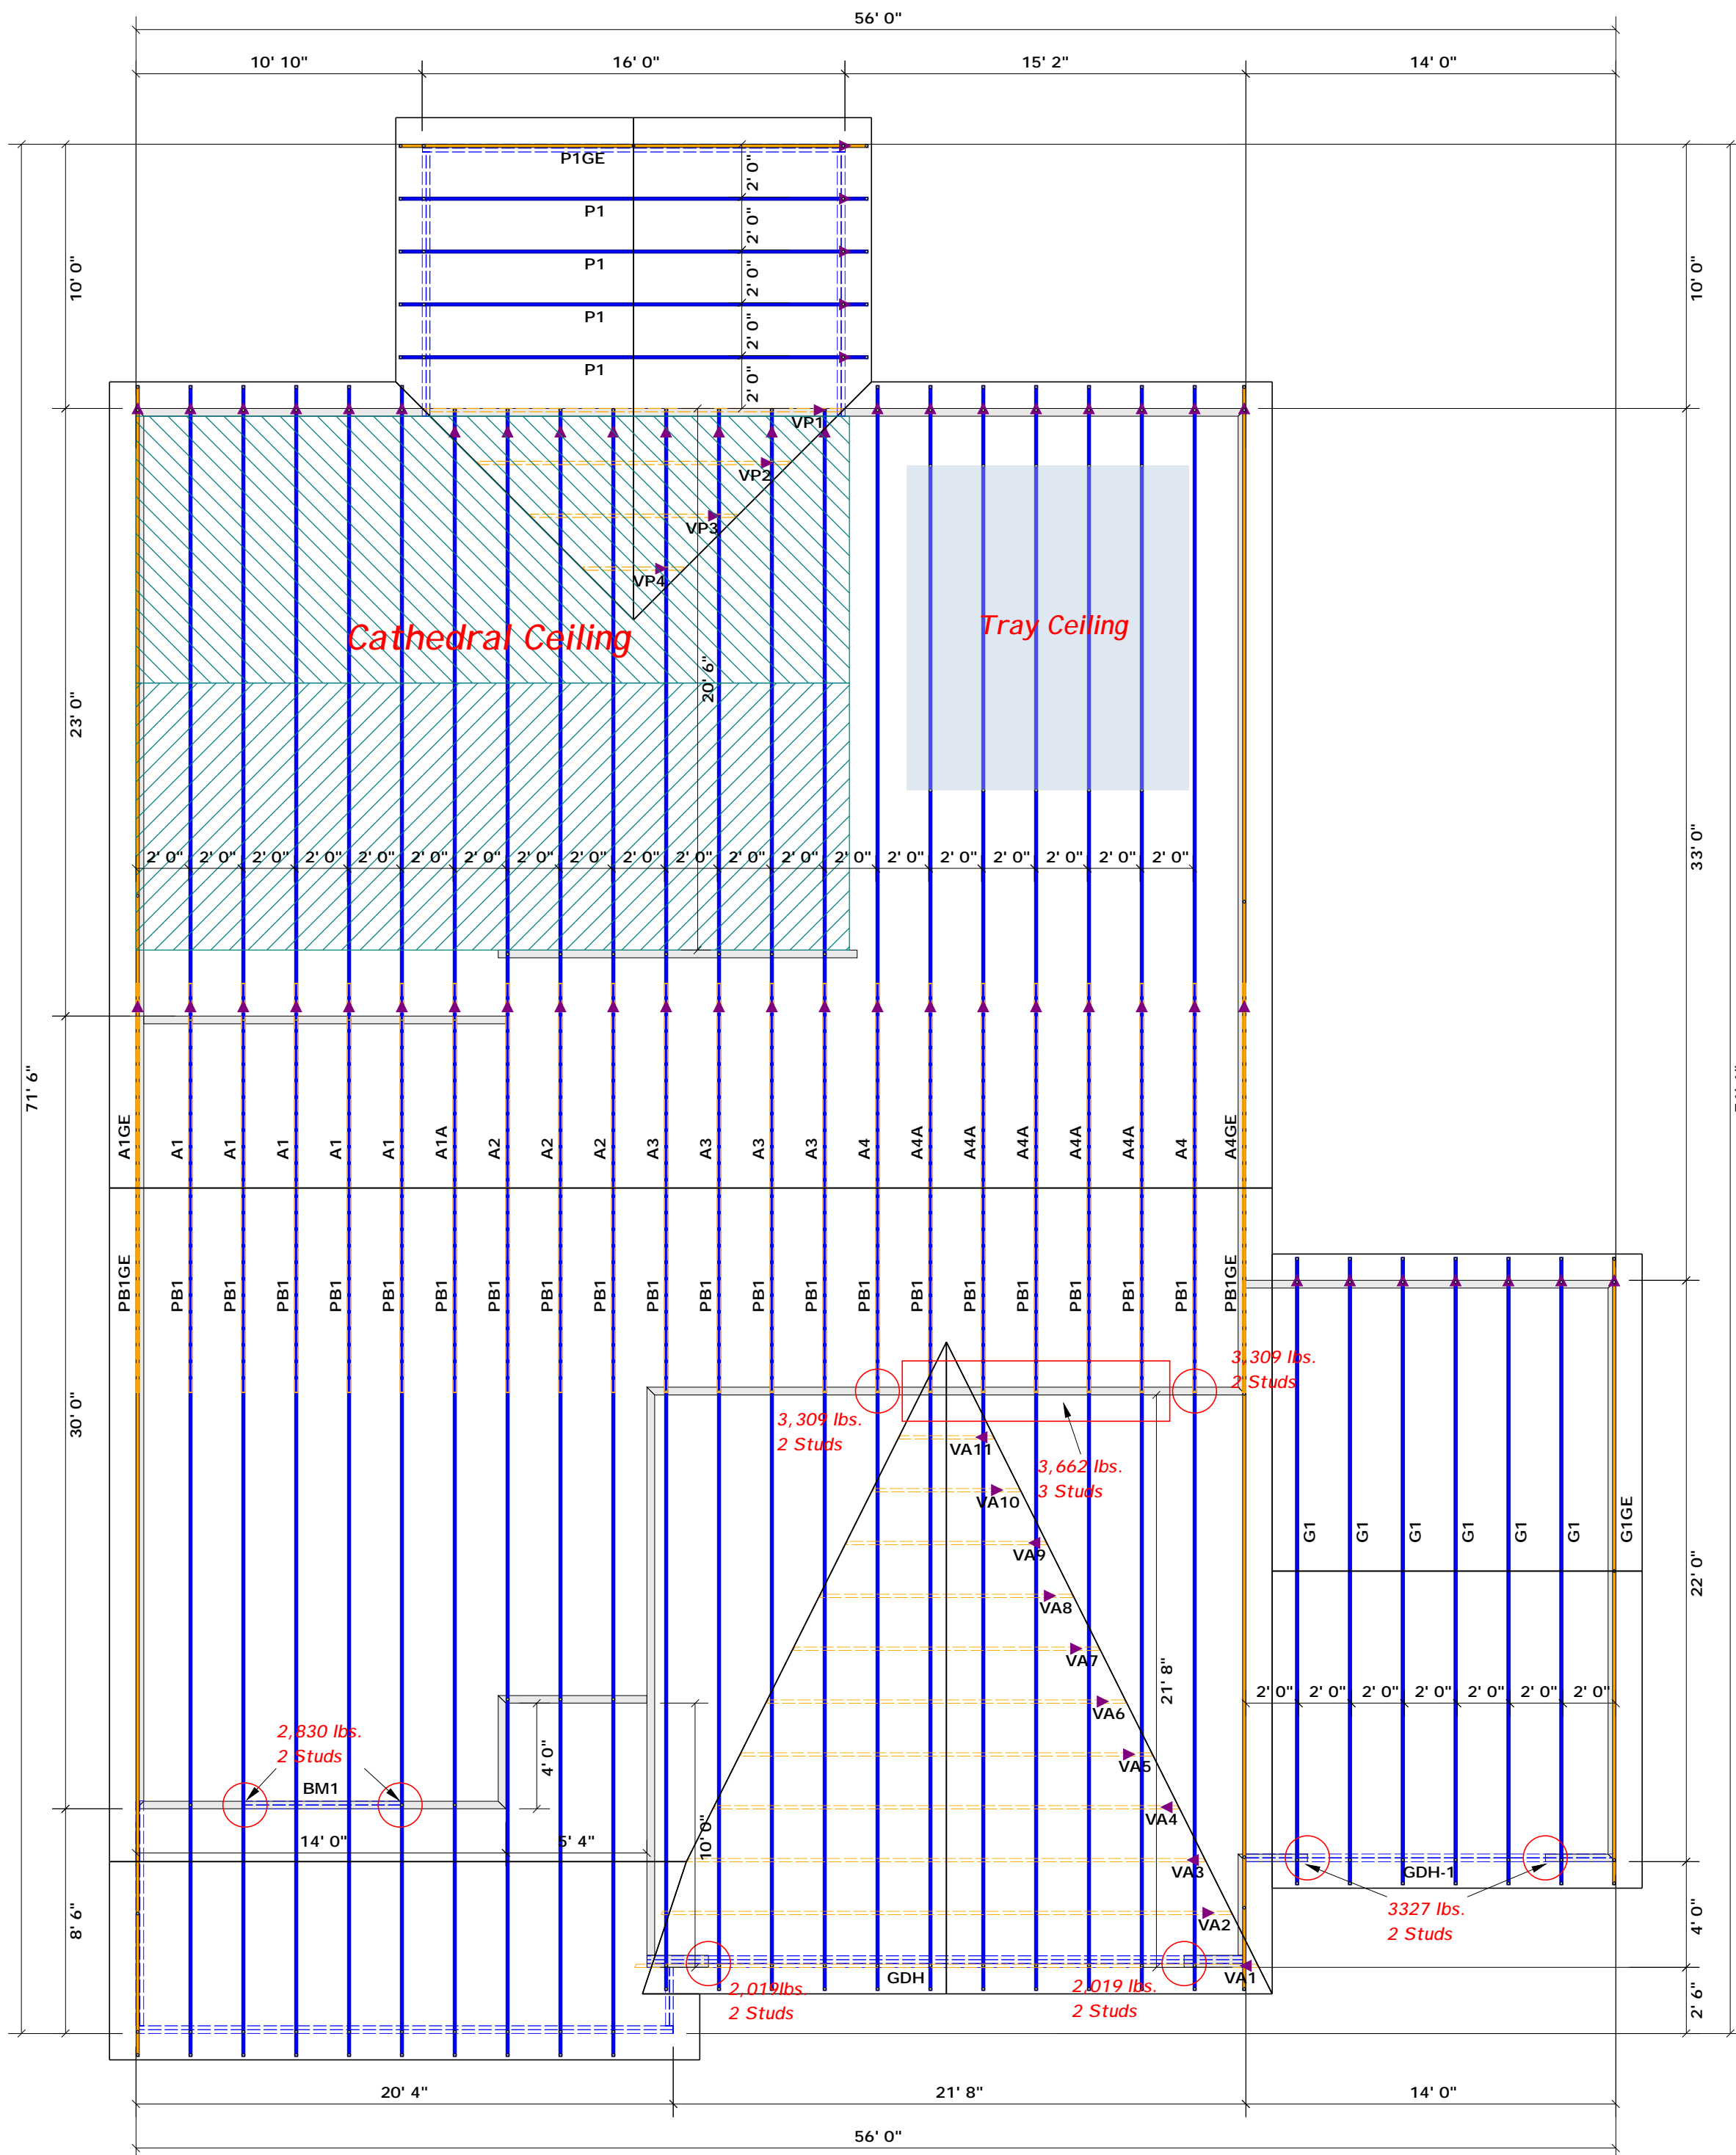

▲ = Denotes Left End of Truss  
 (Reference Engineered Truss Drawing)  
 Do Not Erect Trusses Backwards

All Truss Reactions are Less than 3,000 lbs. Unless Noted Otherwise.  
 ○ -- Denotes Reaction Greater than 3,000 lbs.

Truss Placement Plan  
 SCALE: 3/16" = 1'

| Beam Legend |        |                             |       |         |
|-------------|--------|-----------------------------|-------|---------|
| PlotID      | Length | Product                     | Plies | Net Qty |
| BM1         | 7' 0"  | 1-3/4"x 9-1/4" LVL Kerto-S  | 2     | 2       |
| GDH-1       | 14' 0" | 1-3/4"x 11-7/8" LVL Kerto-S | 2     | 2       |
| GDH         | 23' 0" | 1-3/4"x 16" LVL Kerto-S     | 3     | 3       |

| LOAD CHART FOR JACK STUDS |                      |
|---------------------------|----------------------|
| MEMBER SIZE (L x W)       | MAXIMUM SPACING (ft) |
| 1700                      | 1                    |
| 3400                      | 2                    |
| 5100                      | 3                    |
| 6800                      | 4                    |
| 8500                      | 5                    |
| 10200                     | 6                    |
| 11900                     | 7                    |
| 13600                     | 8                    |
| 15300                     | 9                    |

|           |                                   |           |                      |
|-----------|-----------------------------------|-----------|----------------------|
| BUILDER   | Weaver Development                | COUNTY    | Harnett              |
| JOB NAME  | Lot 1B Williams Farm              | ADDRESS   | Lot 1B Williams Farm |
| PLAN      | Lauren III / Elev. A / 3 Car / CP | MODEL     | Roof                 |
| SEAL DATE | 4/29/20                           | DATE REV. | / /                  |
| QUOTE #   | Quote #                           | DRAWN BY  | Curtis Quick         |
| JOB #     | J0521-2779                        | SALESMAN  | Lenny Norris         |

THIS IS A TRUSS PLACEMENT DIAGRAM ONLY. These trusses are designed as individual building components to be incorporated into the building design at the specification of the building designer. See individual design sheets for each truss design identified on the placement drawing. The building designer is responsible for temporary and permanent bracing of the roof and floor system and for the overall structure. The design of the truss support structure including headers, beams, walls, and columns is the responsibility of the building designer. For general guidance regarding bracing, consult BCSI-B1 and BCSI-B3 provided with the truss delivery package or online @ sbcindustry.com


Bearing reactions less than or equal to 3000# are deemed to comply with the prescriptive Code requirements. The contractor shall refer to the attached Tables (derived from the prescriptive Code requirements) to determine the minimum foundation size and number of wood studs required to support reactions greater than 3000# but not greater than 15000#. A registered design professional shall be retained to design the support system for any reaction that exceeds those specified in the attached Tables. A registered design professional shall be retained to design the support system for all reactions that exceed 15000#.

Signature: Curtis Quick

**ROOF & FLOOR TRUSSES & BEAMS**  
 Reilly Road Industrial Park  
 Fayetteville, N.C. 28309  
 Phone: (910) 864-8787  
 Fax: (910) 864-4444

**GDH Kerto-S LVL 1.750" X 16.000" 3-Ply - PASSED**

Level: Level

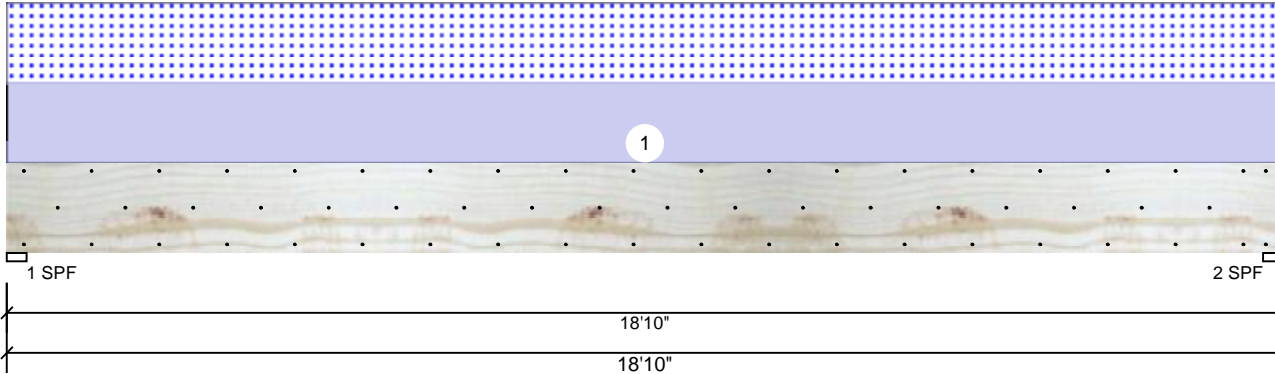

**Member Information**

|                     |               |                |             |
|---------------------|---------------|----------------|-------------|
| Type:               | Girder        | Application:   | Floor       |
| Plies:              | 3             | Design Method: | ASD         |
| Moisture Condition: | Dry           | Building Code: | IBC 2012    |
| Deflection LL:      | 480           | Load Sharing:  | Yes         |
| Deflection TL:      | 360           | Deck:          | Not Checked |
| Importance:         | Normal        |                |             |
| Temperature:        | Temp <= 100°F |                |             |

**Reactions UNPATTERNED Ib (Uplift)**

| Brg | Live | Dead | Snow | Wind | Const |
|-----|------|------|------|------|-------|
| 1   | 0    | 1127 | 951  | 0    | 0     |
| 2   | 0    | 1127 | 951  | 0    | 0     |

**Bearings**

| Bearing | Length | Cap. React | D/L Ib     | Total | Ld. Case | Ld. Comb. |
|---------|--------|------------|------------|-------|----------|-----------|
| 1 - SPF | 3.500" | 27%        | 1127 / 951 | 2078  | L        | D+S       |
| 2 - SPF | 3.500" | 27%        | 1127 / 951 | 2078  | L        | D+S       |

**Analysis Results**

| Analysis     | Actual         | Location  | Allowed       | Capacity    | Comb. | Case |
|--------------|----------------|-----------|---------------|-------------|-------|------|
| Moment       | 9334 ft-lb     | 9'5"      | 62010 ft-lb   | 0.151 (15%) | D+S   | L    |
| Unbraced     | 9334 ft-lb     | 9'5"      | 10984 ft-lb   | 0.850 (85%) | D+S   | L    |
| Shear        | 1735 lb        | 17'3 3/8" | 20608 lb      | 0.084 (8%)  | D+S   | L    |
| LL Defl inch | 0.078 (L/2813) | 9'5 1/16" | 0.460 (L/480) | 0.170 (17%) | S     | L    |
| TL Defl inch | 0.171 (L/1288) | 9'5 1/16" | 0.613 (L/360) | 0.280 (28%) | D+S   | L    |

**Design Notes**

- 1 Fasten all plies using 3 rows of 10d Box nails (.128x3") at 12" o.c. Maximum end distance not to exceed 6".
- 2 Refer to last page of calculations for fasteners required for specified loads.
- 3 Girders are designed to be supported on the bottom edge only.
- 4 Top loads must be supported equally by all plies.
- 5 Top braced at bearings.
- 6 Bottom braced at bearings.
- 7 Lateral slenderness ratio based on single ply width.

| ID | Load Type   | Location | Trib Width | Side | Dead 0.9 | Live 1 | Snow 1.15 | Wind 1.6 | Const. 1.25 | Comments |
|----|-------------|----------|------------|------|----------|--------|-----------|----------|-------------|----------|
| 1  | Uniform     |          |            | Top  | 101 PLF  | 0 PLF  | 101 PLF   | 0 PLF    | 0 PLF       | A4A      |
|    | Self Weight |          |            |      | 19 PLF   |        |           |          |             |          |

**Notes**

Calculated Structured Designs is responsible only of the structural adequacy of this component based on the design criteria and loadings shown. It is the responsibility of the customer and/or the contractor to ensure the component suitability of the intended application, and to verify the dimensions and loads.

**Lumber**

1. Dry service conditions, unless noted otherwise
2. LVL not to be treated with fire retardant or corrosive

chemicals

**Handling & Installation**

1. LVL beams must not be cut or drilled
2. Refer to manufacturer's product information regarding installation requirements, multi-ply fastening details, beam strength values, and code approvals
3. Damaged Beams must not be used
4. Design assumes top edge is laterally restrained
5. Provide lateral support at bearing points to avoid lateral displacement and rotation

6. For flat roofs provide proper drainage to prevent ponding

This design is valid until 2/26/2023

**Manufacturer Info**



Metsä Wood  
 301 Merritt 7 Building, 2nd Floor  
 Norwalk, CT 06851  
 (800) 622-5850  
[www.metsawood.com/us](http://www.metsawood.com/us)  
 ICC-ES: ESR-3633

Comtech, Inc.  
 1001 S. Reilly Road, Suite #639  
 Fayetteville, NC  
 USA  
 28314  
 910-864-TRUS



**GDH-1 Kerto-S LVL 1.750" X 11.875" 2-Ply - PASSED**

Level: Level

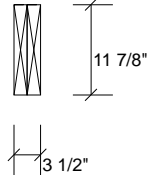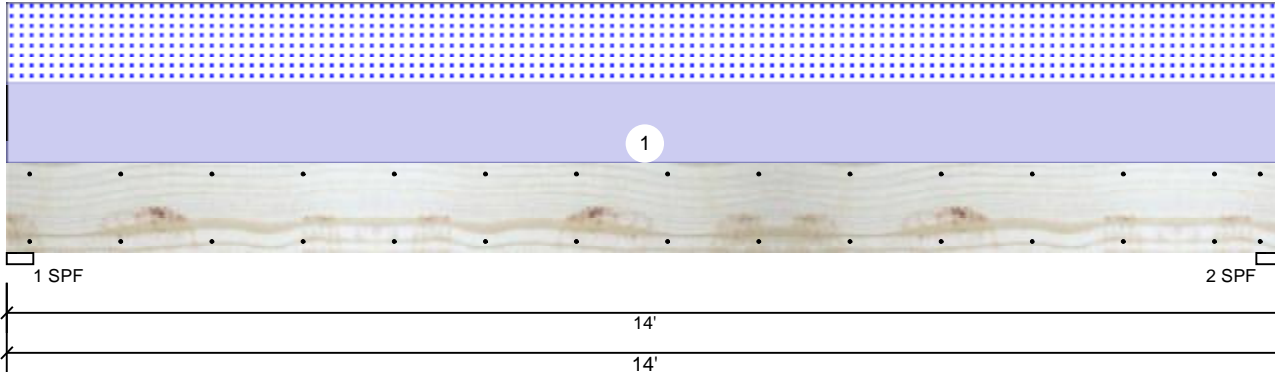

**Member Information**

|                     |               |
|---------------------|---------------|
| Type:               | Girder        |
| Plies:              | 2             |
| Moisture Condition: | Dry           |
| Deflection LL:      | 480           |
| Deflection TL:      | 360           |
| Importance:         | Normal        |
| Temperature:        | Temp <= 100°F |

|                |             |
|----------------|-------------|
| Application:   | Floor       |
| Design Method: | ASD         |
| Building Code: | IBC 2012    |
| Load Sharing:  | No          |
| Deck:          | Not Checked |

**Reactions UNPATTERNED Ib (Uplift)**

| Brg | Live | Dead | Snow | Wind | Const |
|-----|------|------|------|------|-------|
| 1   | 0    | 1696 | 1631 | 0    | 0     |
| 2   | 0    | 1696 | 1631 | 0    | 0     |

**Bearings**

| Bearing | Length | Cap. | React D/L Ib | Total | Ld. Case | Ld. Comb. |
|---------|--------|------|--------------|-------|----------|-----------|
| 1 - SPF | 3.500" | 64%  | 1696 / 1631  | 3327  | L        | D+S       |
| 2 - SPF | 3.500" | 64%  | 1696 / 1631  | 3327  | L        | D+S       |

**Analysis Results**

| Analysis     | Actual        | Location | Allowed       | Capacity     | Comb. | Case |
|--------------|---------------|----------|---------------|--------------|-------|------|
| Moment       | 10893 ft-lb   | 7'       | 22897 ft-lb   | 0.476 (48%)  | D+S   | L    |
| Unbraced     | 10893 ft-lb   | 7'       | 10911 ft-lb   | 0.998 (100%) | D+S   | L    |
| Shear        | 2747 lb       | 1'2 5/8" | 10197 lb      | 0.269 (27%)  | D+S   | L    |
| LL Defl inch | 0.195 (L/832) | 7' 1/16" | 0.339 (L/480) | 0.580 (58%)  | S     | L    |
| TL Defl inch | 0.398 (L/408) | 7' 1/16" | 0.451 (L/360) | 0.880 (88%)  | D+S   | L    |

**Design Notes**

- 1 Fasten all plies using 2 rows of 10d Box nails (.128x3") at 12" o.c. Maximum end distance not to exceed 6".
- 2 Refer to last page of calculations for fasteners required for specified loads.
- 3 Girders are designed to be supported on the bottom edge only.
- 4 Top loads must be supported equally by all plies.
- 5 Top must be laterally braced at a maximum of 8'2 5/8" o.c.
- 6 Bottom braced at bearings.
- 7 Lateral slenderness ratio based on single ply width.

| ID | Load Type   | Location | Trib Width | Side | Dead 0.9 | Live 1 | Snow 1.15 | Wind 1.6 | Const. 1.25 | Comments |
|----|-------------|----------|------------|------|----------|--------|-----------|----------|-------------|----------|
| 1  | Uniform     |          |            | Top  | 233 PLF  | 0 PLF  | 233 PLF   | 0 PLF    | 0 PLF       | G1       |
|    | Self Weight |          |            |      | 9 PLF    |        |           |          |             |          |

**Notes**  
 Calculated Structured Designs is responsible only of the structural adequacy of this component based on the design criteria and loadings shown. It is the responsibility of the customer and/or the contractor to ensure the component suitability of the intended application, and to verify the dimensions and loads.

**Lumber**  
 1. Dry service conditions, unless noted otherwise  
 2. LVL not to be treated with fire retardant or corrosive chemicals

**Handling & Installation**

1. LVL beams must not be cut or drilled
2. Refer to manufacturer's product information regarding installation requirements, multi-ply fastening details, beam strength values, and code approvals
3. Damaged Beams must not be used
4. Design assumes top edge is laterally restrained
5. Provide lateral support at bearing points to avoid lateral displacement and rotation

6. For flat roofs provide proper drainage to prevent ponding


This design is valid until 2/26/2023

**Manufacturer Info**

Metsä Wood  
 301 Merritt 7 Building, 2nd Floor  
 Norwalk, CT 06851  
 (800) 622-5850  
[www.metsawood.com/us](http://www.metsawood.com/us)  
 ICC-ES: ESR-3633

Comtech, Inc.  
 1001 S. Reilly Road, Suite #639  
 Fayetteville, NC  
 USA  
 28314  
 910-864-TRUS

**BM1 Kerto-S LVL 1.750" X 9.250" 2-Ply - PASSED** Level: Level

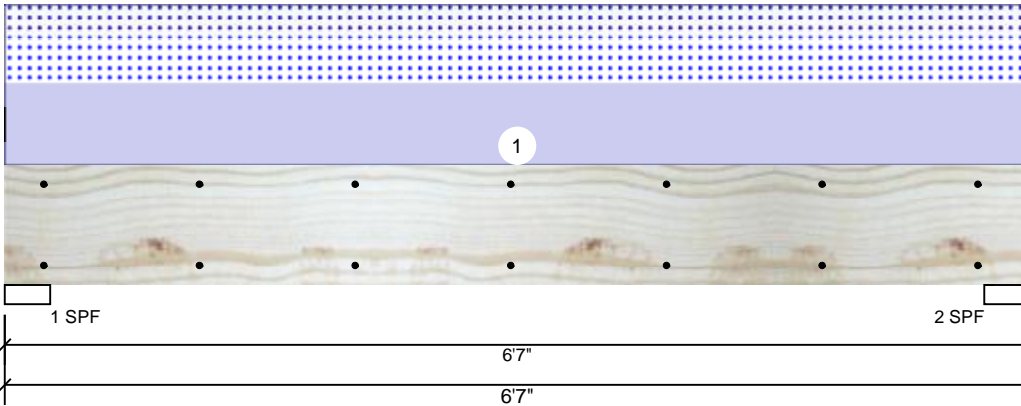

**Member Information**

|                     |               |
|---------------------|---------------|
| Type:               | Girder        |
| Plies:              | 2             |
| Moisture Condition: | Dry           |
| Deflection LL:      | 480           |
| Deflection TL:      | 360           |
| Importance:         | Normal        |
| Temperature:        | Temp <= 100°F |

|                |             |
|----------------|-------------|
| Application:   | Floor       |
| Design Method: | ASD         |
| Building Code: | IBC 2012    |
| Load Sharing:  | No          |
| Deck:          | Not Checked |

**Reactions UNPATTERNED lb (Uplift)**

| Brg | Live | Dead | Snow | Wind | Const |
|-----|------|------|------|------|-------|
| 1   | 0    | 1564 | 1541 | 0    | 0     |
| 2   | 0    | 1564 | 1541 | 0    | 0     |

**Bearings**

| Bearing | Length | Cap. React | D/L lb      | Total | Ld. Case | Ld. Comb. |
|---------|--------|------------|-------------|-------|----------|-----------|
| 1 - SPF | 3.500" | 60%        | 1564 / 1541 | 3105  | L        | D+S       |
| 2 - SPF | 3.500" | 60%        | 1564 / 1541 | 3105  | L        | D+S       |

**Analysis Results**

| Analysis     | Actual         | Location | Allowed       | Capacity    | Comb. | Case |
|--------------|----------------|----------|---------------|-------------|-------|------|
| Moment       | 4423 ft-lb     | 3'3 1/2" | 14423 ft-lb   | 0.307 (31%) | D+S   | L    |
| Unbraced     | 4423 ft-lb     | 3'3 1/2" | 10451 ft-lb   | 0.423 (42%) | D+S   | L    |
| Shear        | 2161 lb        | 1'       | 7943 lb       | 0.272 (27%) | D+S   | L    |
| LL Defl inch | 0.040 (L/1842) | 3'3 1/2" | 0.153 (L/480) | 0.260 (26%) | S     | L    |
| TL Defl inch | 0.080 (L/914)  | 3'3 1/2" | 0.204 (L/360) | 0.390 (39%) | D+S   | L    |

**Design Notes**

- 1 Fasten all plies using 2 rows of 10d Box nails (.128x3") at 12" o.c. Maximum end distance not to exceed 6".
- 2 Refer to last page of calculations for fasteners required for specified loads.
- 3 Girders are designed to be supported on the bottom edge only.
- 4 Top loads must be supported equally by all plies.
- 5 Top braced at bearings.
- 6 Bottom braced at bearings.
- 7 Lateral slenderness ratio based on single ply width.

| ID | Load Type   | Location | Trib Width | Side | Dead 0.9 | Live 1 | Snow 1.15 | Wind 1.6 | Const. 1.25 | Comments |
|----|-------------|----------|------------|------|----------|--------|-----------|----------|-------------|----------|
| 1  | Uniform     |          |            | Top  | 468 PLF  | 0 PLF  | 468 PLF   | 0 PLF    | 0 PLF       | A1       |
|    | Self Weight |          |            |      | 7 PLF    |        |           |          |             |          |

**Notes**  
 Calculated Structured Designs is responsible only of the structural adequacy of this component based on the design criteria and loadings shown. It is the responsibility of the customer and/or the contractor to ensure the component suitability of the intended application, and to verify the dimensions and loads.

**Lumber**  
 1. Dry service conditions, unless noted otherwise  
 2. LVL not to be treated with fire retardant or corrosive chemicals

**Handling & Installation**  
 1. LVL beams must not be cut or drilled  
 2. Refer to manufacturer's product information regarding installation requirements, multi-ply fastening details, beam strength values, and code approvals  
 3. Damaged Beams must not be used  
 4. Design assumes top edge is laterally restrained  
 5. Provide lateral support at bearing points to avoid lateral displacement and rotation

6. For flat roofs provide proper drainage to prevent ponding

This design is valid until 2/26/2023

**Manufacturer Info**  
 Metsä Wood  
 301 Merritt 7 Building, 2nd Floor  
 Norwalk, CT 06851  
 (800) 622-5850  
[www.metsawood.com/us](http://www.metsawood.com/us)  
 ICC-ES: ESR-3633

Comtech, Inc.  
 1001 S. Reilly Road, Suite #639  
 Fayetteville, NC  
 USA  
 28314  
 910-864-TRUS