



- Architectural Shingles
- Basement Foundation
- Screened Top Rear Porch
- Gourmet Kitchen with Stainless Hood
- All Wire Shelving
- Sod/Irrigation Full Front, Sides, Rear
- Hardi Siding, BB, Shake w/Stone Accents

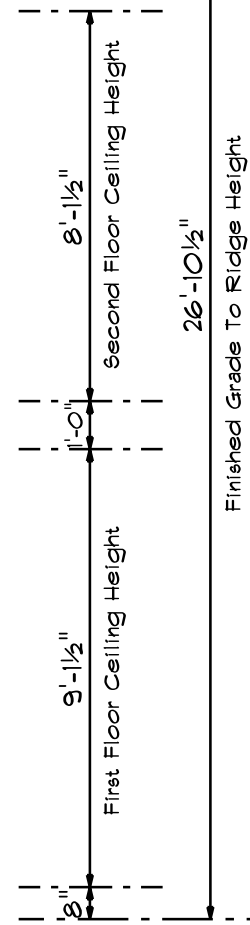

Front Elevation
Scale: 1/4" = 1'0"

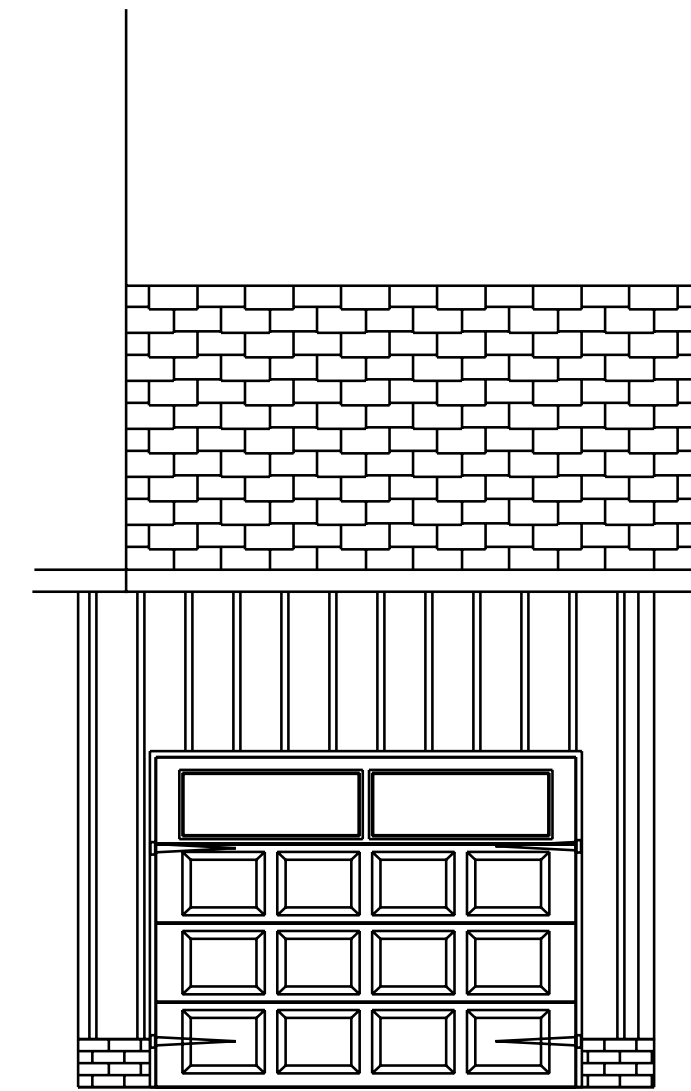

Optional
3rd Garage




Rear Elevation
Scale: 1/8" = 1'0"



Optional Side Load

Right Elevation
Scale: 1/8" = 1'0"

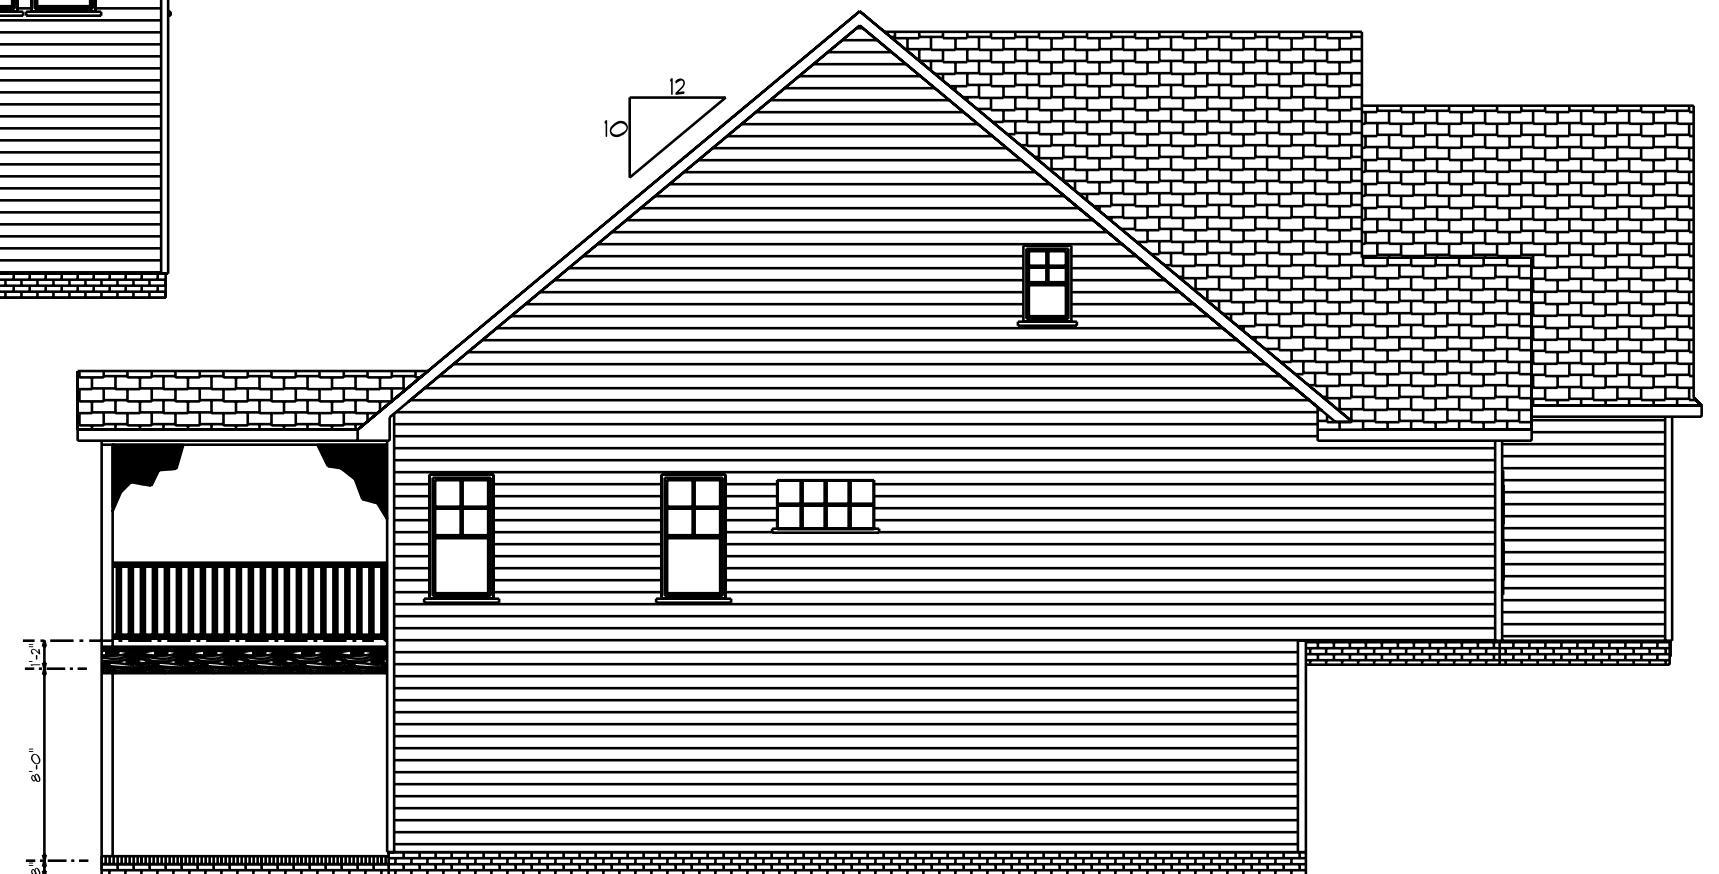

Left Elevation
Scale: 1/8" = 1'0"

DATE: Wednesday, May 19, 2021

REVISED

DRAWING*


Elev.
E

SCALE: 1/4"


DRAWN BY

APPROVED

The Dutchess

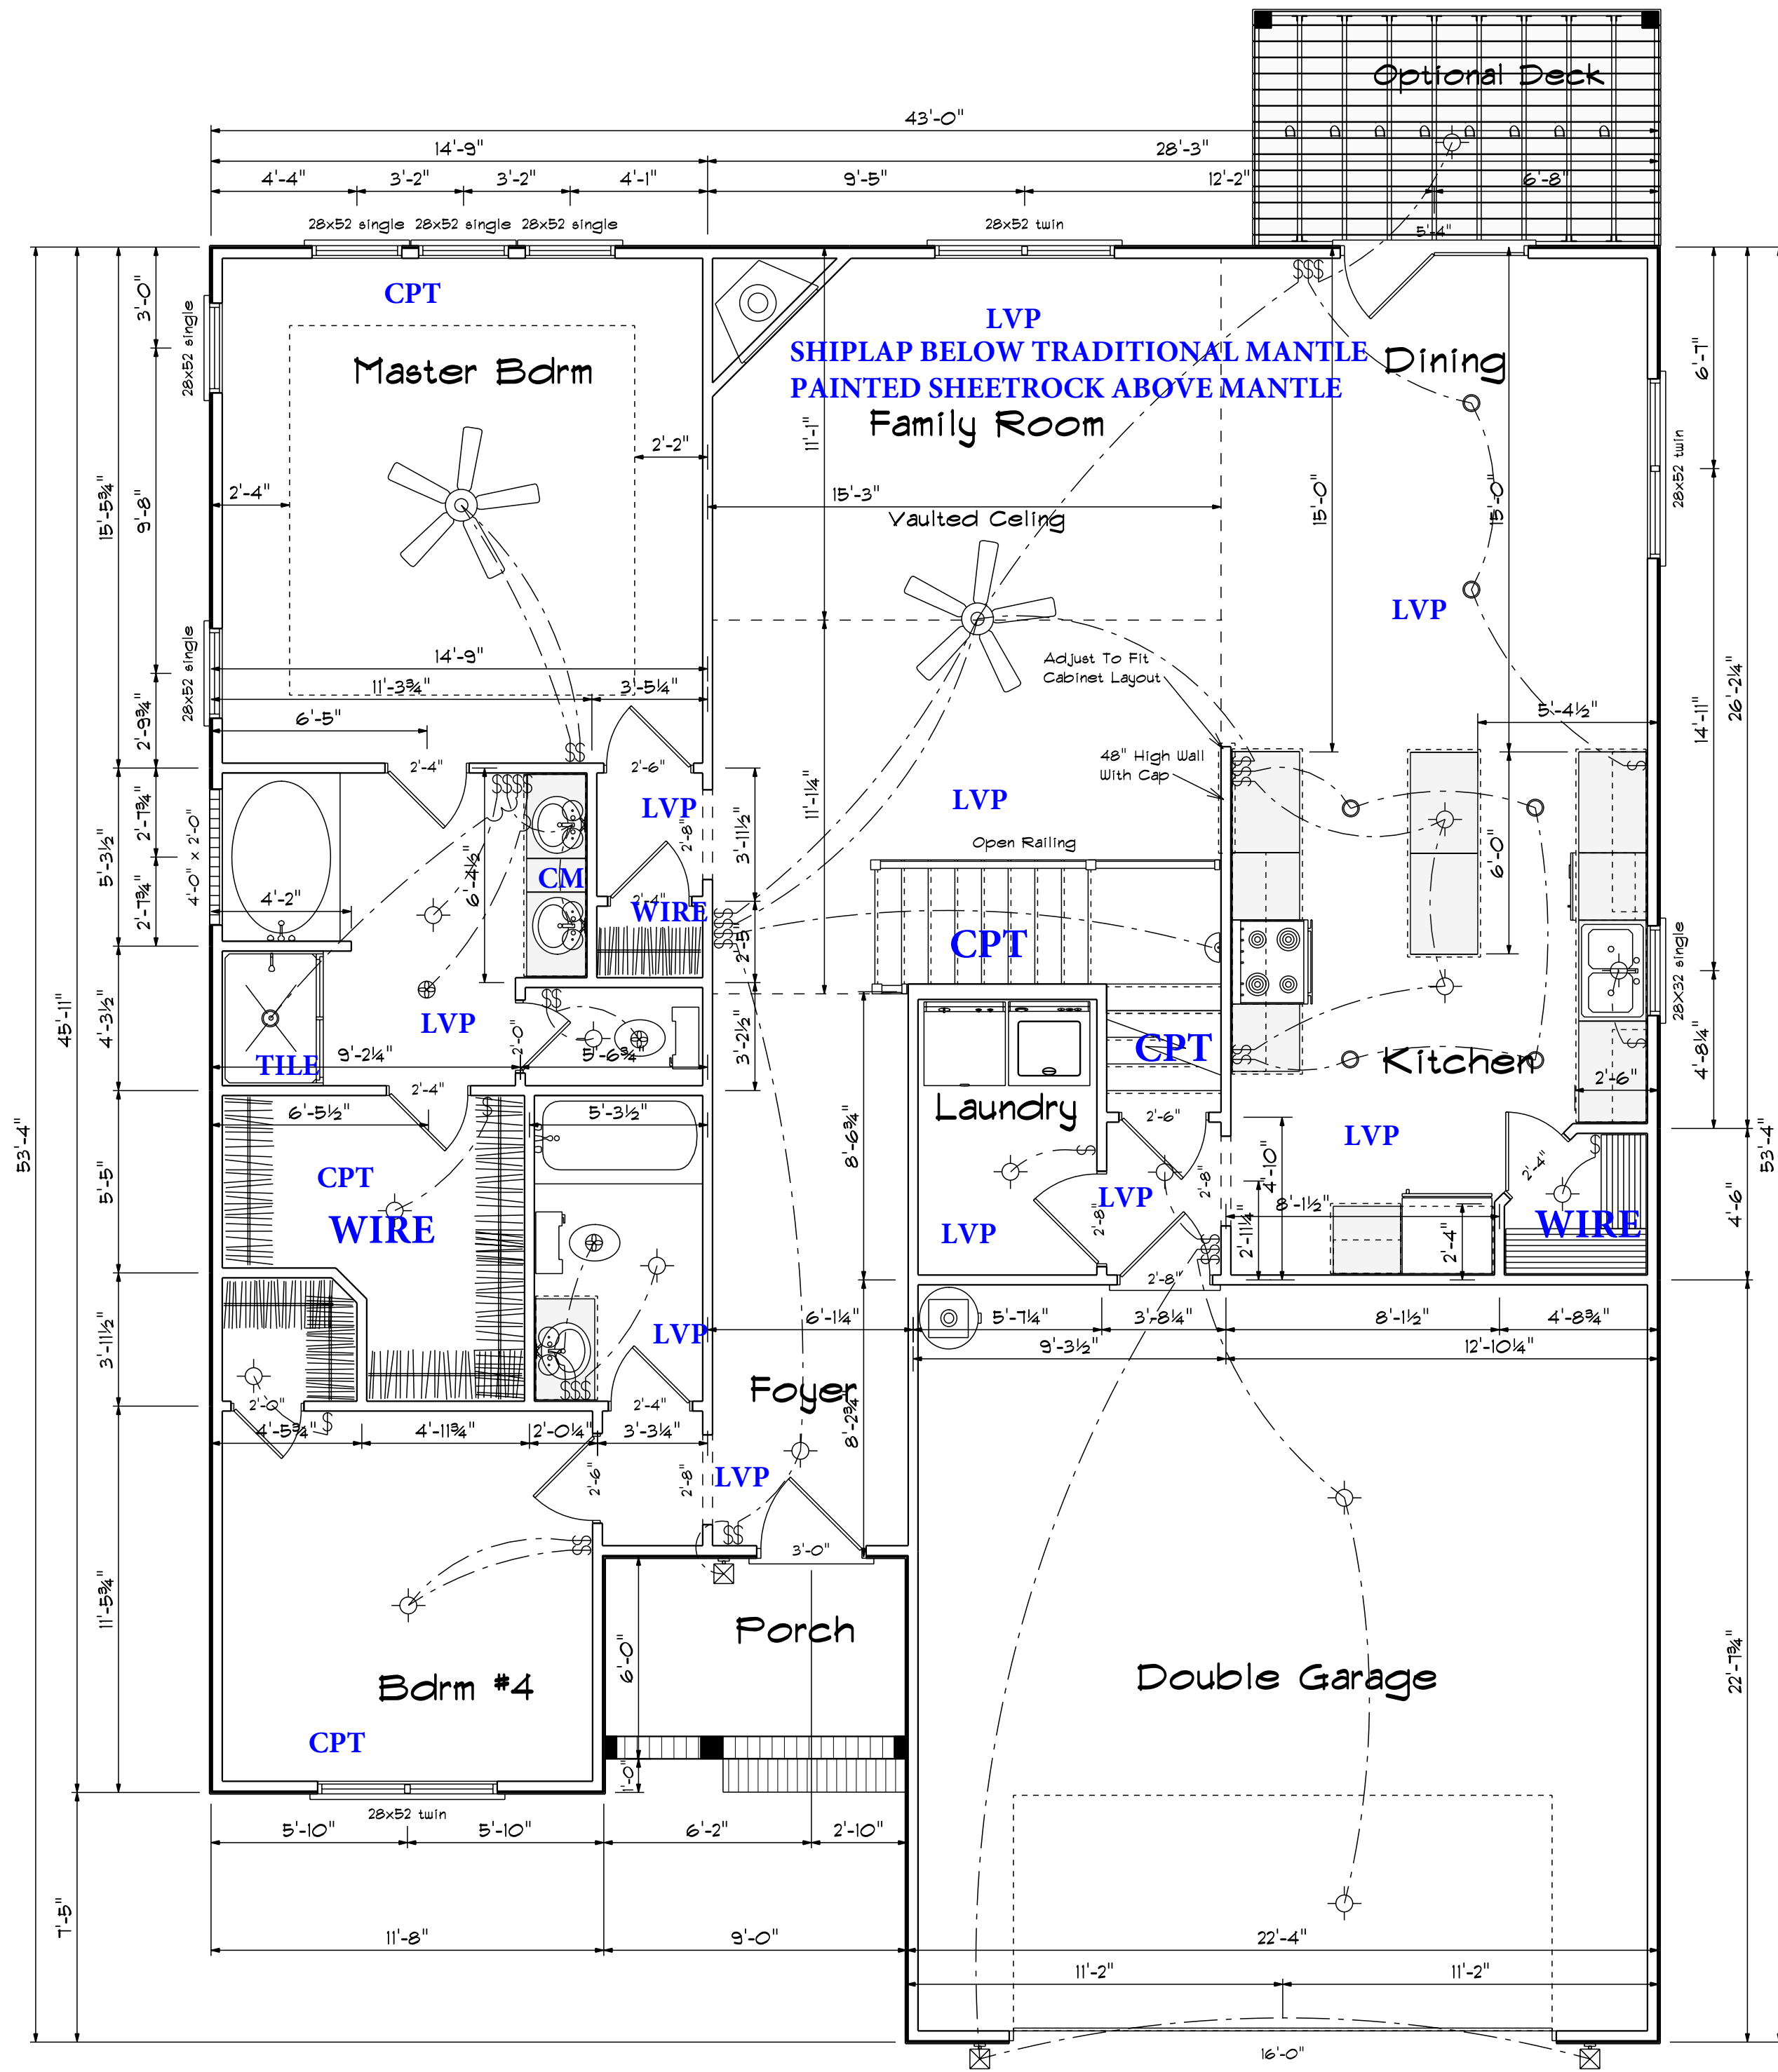

Kitchen Cabinets

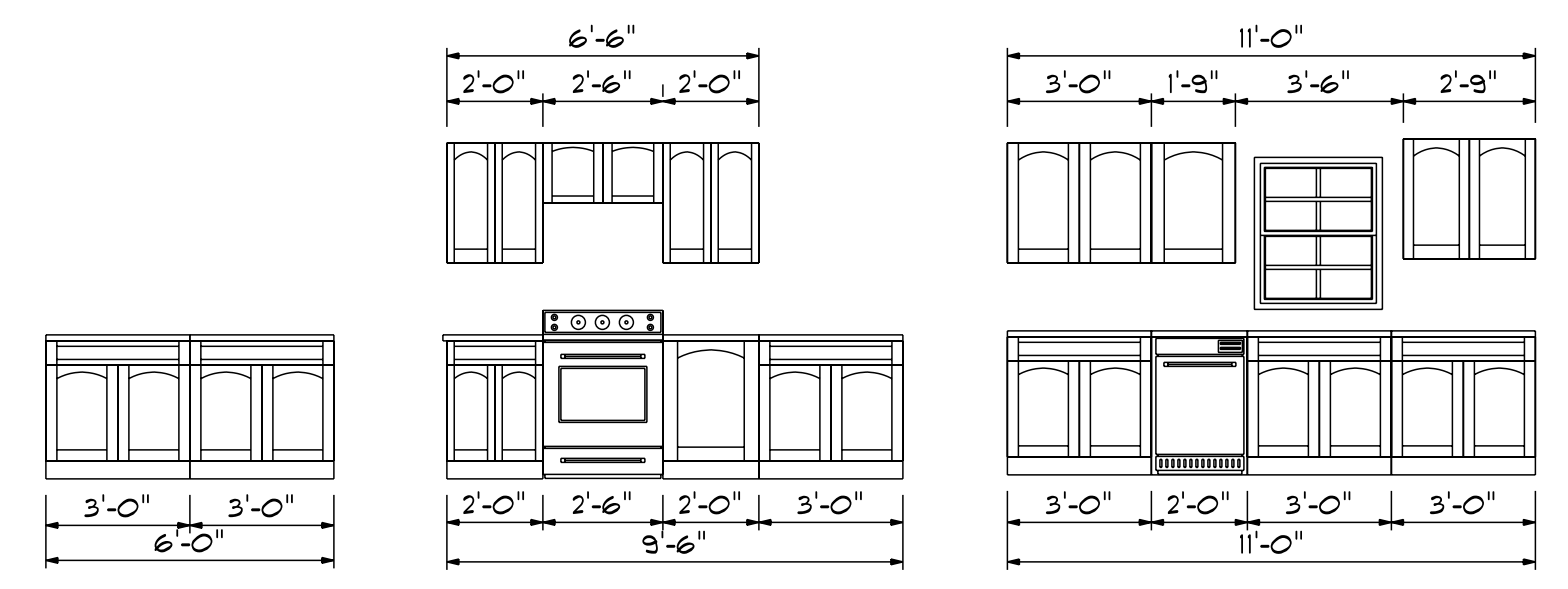

First Floor Openings


PRODUCT CODE	SIZE	HINGE DIRECTION	COUNT	R.O. WIDTH
2-8 Cased Opening	2'-8"	N	3	2'-8"
36X80 COLONIAL A 1	3'-0"	R	1	3'-3"
28 Double French Center	5'-4"	RN	1	5'-7"
192X84 - 1 PANEL	16'-0"	U	1	16'-3"
2-0 Door Unit	2'-0"	R	2	2'-2"
2-4 Door Unit	2'-4"	L	2	2'-6"
2-4 Door Unit	2'-4"	R	3	2'-6"
2-6 Door Unit	2'-6"	R	2	2'-8"
2-8 Door Unit	2'-8"	L	2	2'-10"
28X32 single	2'-8" x 3'-2"	N	1	2'-8"
28x52 single	2'-8" x 5'-2"	N	7	2'-8"
28x52 twin	5'-4" x 5'-2"	NN	3	5'-4"
4-0x2-0 Glass Block	4'-0" x 2'-0"	N	1	4'-0½"

Areas

First Floor	1511
Second Floor	711
Finished Basement	1466
<hr/>	
Heated Sq.Ft.	3820
Garage	500
Optional Garage	240
Front Porch	54
Rear Porch	144

- APPLIANCES:**
 GOURMET W/STAINLESS HOOD
MASTER BATH:
 TILED SHOWER W/PAN HINGED DOOR/PANEL
 CULTURED MARBLE TOP
 LVP FLOOR
GUEST BATH:
 FIBERGLASS TUB/SHOWER
 COMBO/NO DOOR
 CULTURED MARBLE TOP
 LVP FLOOR


First Floor Plan

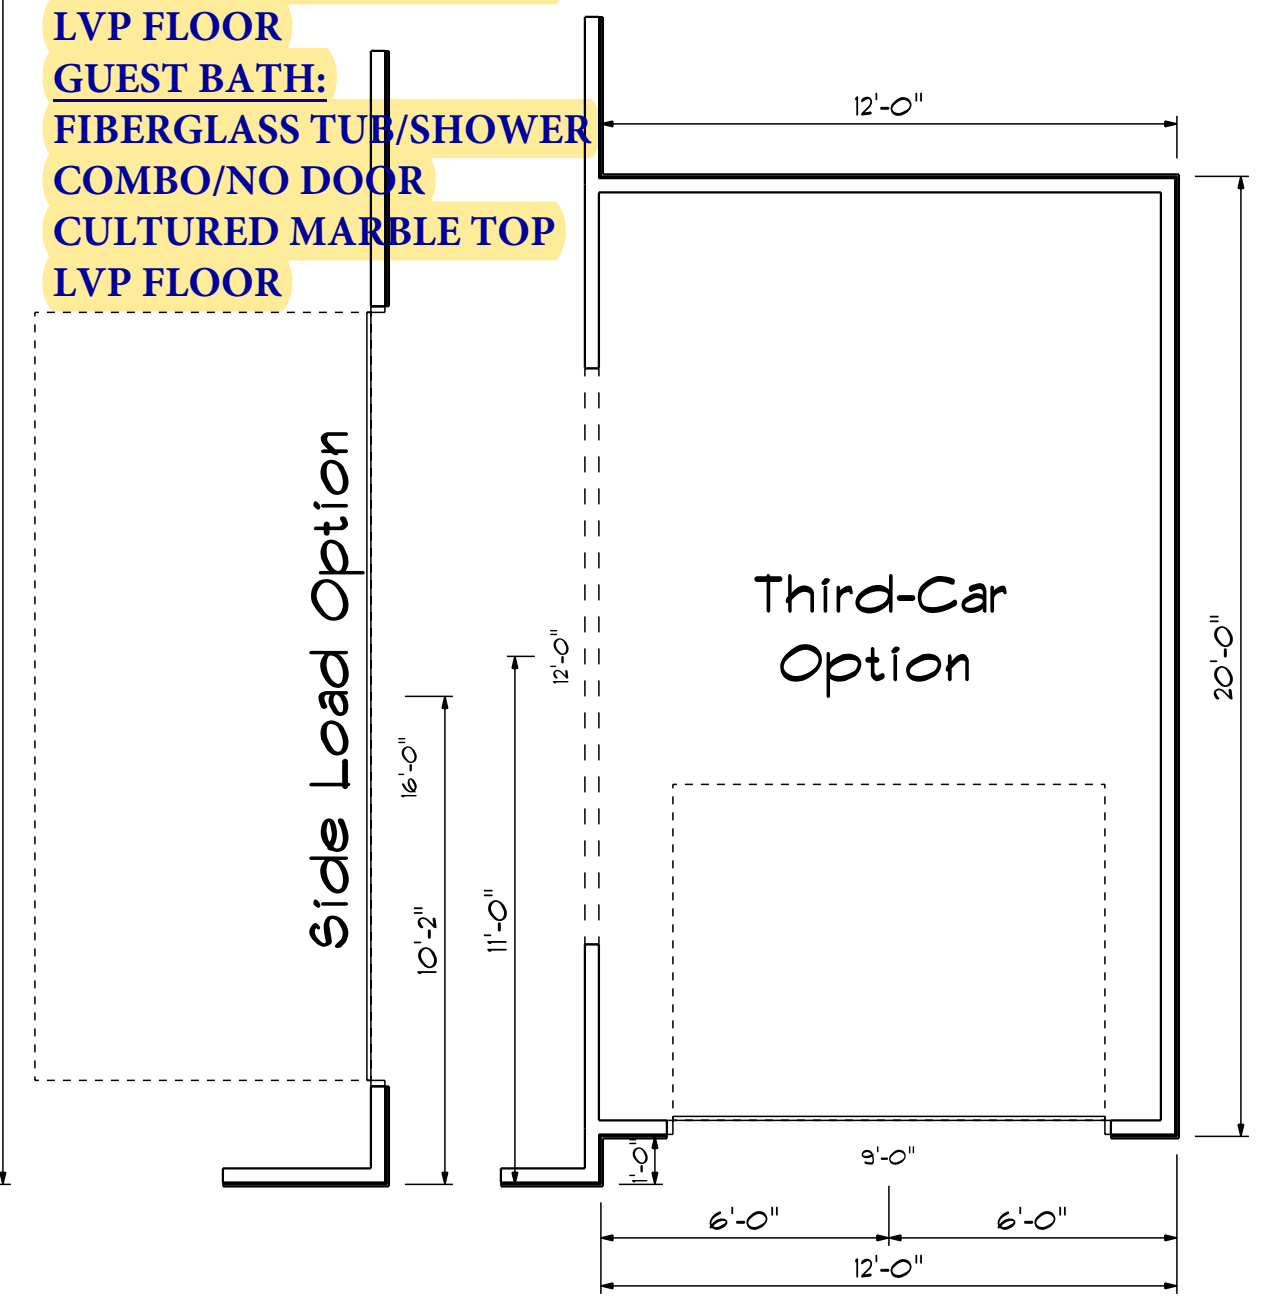

DATE: Wednesday, May 19, 2021
 REVISED
 DRAWING*

SCALE: 1/4"
 DRAWN BY
 APPROVED

The Dutchess

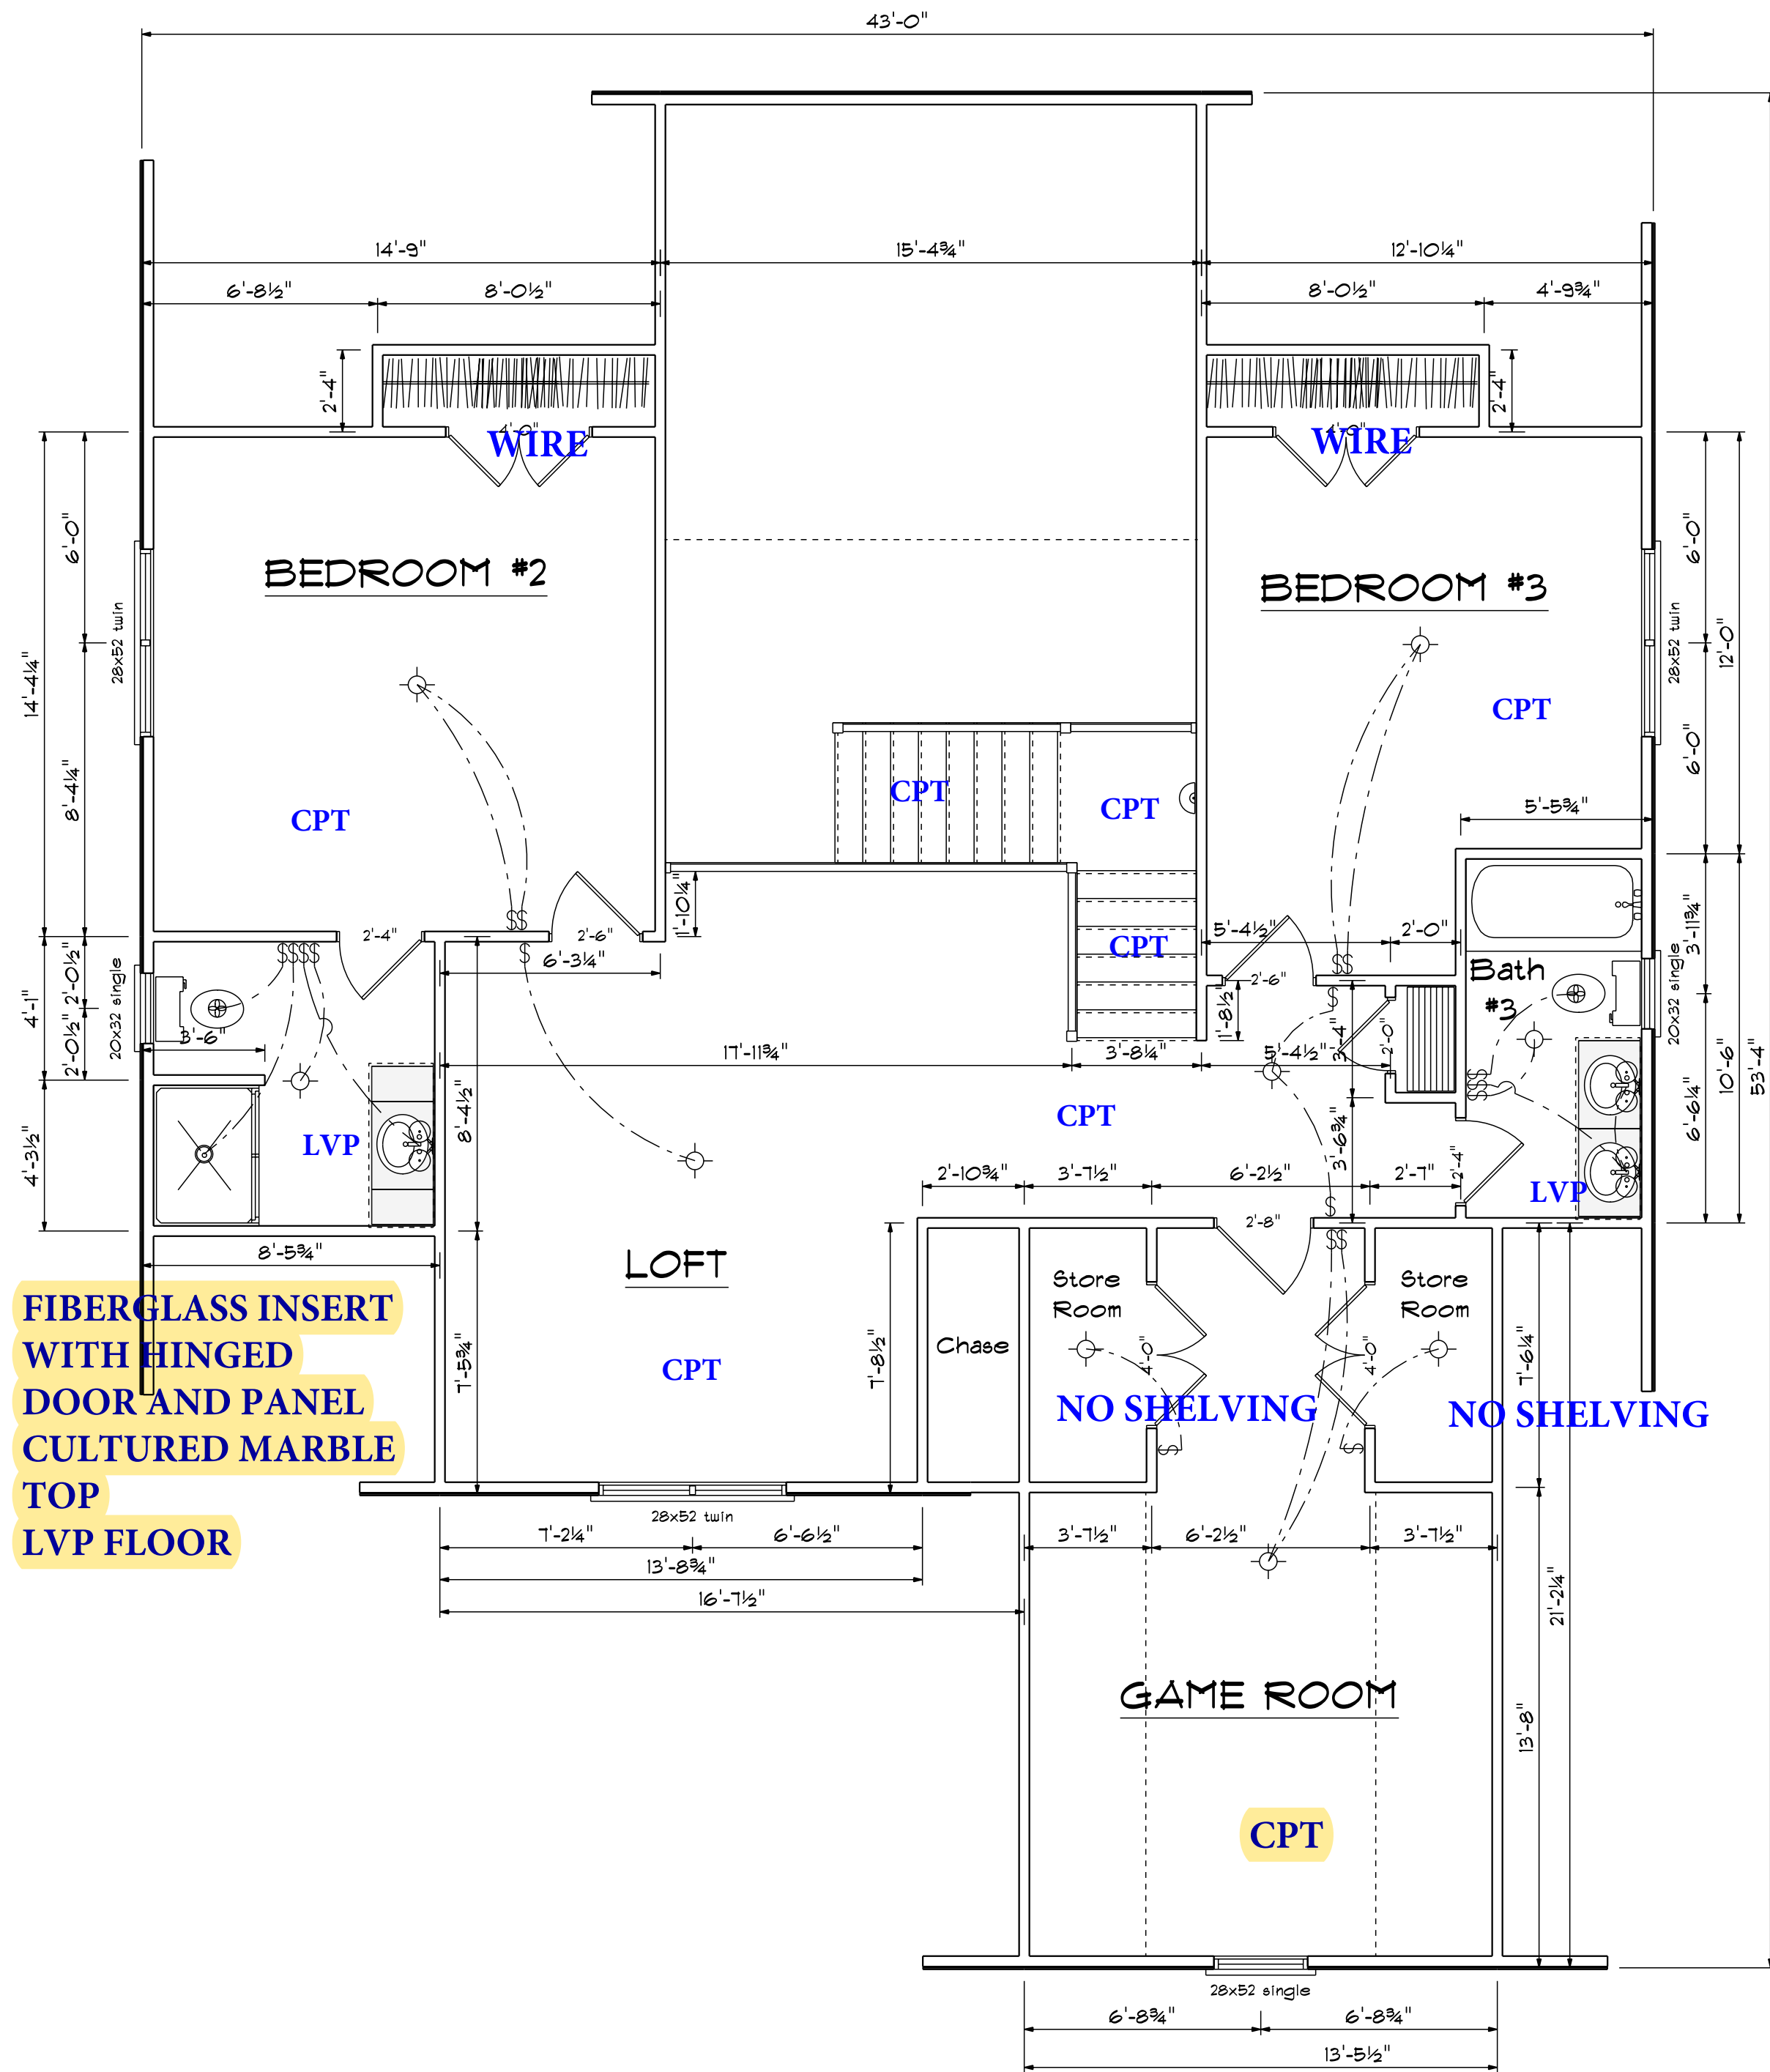


Second Floor Plan

Scale: 1/4" = 1'-0"


SECOND FLOOR OPENING SCHEDULE			
PRODUCT CODE	SIZE	HINGE	COUNT
2-0 Door Unit	2'-0"	R	2
2-4 Door Unit	2'-4"	R	2
2-6 Door Unit	2'-6"	L	2
2-6 Door Unit	2'-6"	R	1
2-8 Door Unit	2'-8"	R	1
4-0 Doublehung Door Unit	4'-0"	LR	2
20x32 single	2'-0" x 3'-2"	N	2
28x52 single	2'-8" x 5'-2"	N	1
28x52 twin	5'-4" x 5'-2"	NN	2

UPSTAIRS BATHS:
FIBERGLASS INSERTS
SHOWER INSERT W/HINGED DOOR AND PANEL
TUB SHOWER COMBO -
NO DOOR
LVP FLOOR
CULTUREM MARBLE TOPS


FIBERGLASS INSERT
WITH HINGED
DOOR AND PANEL
CULTURED MARBLE
TOP
LVP FLOOR

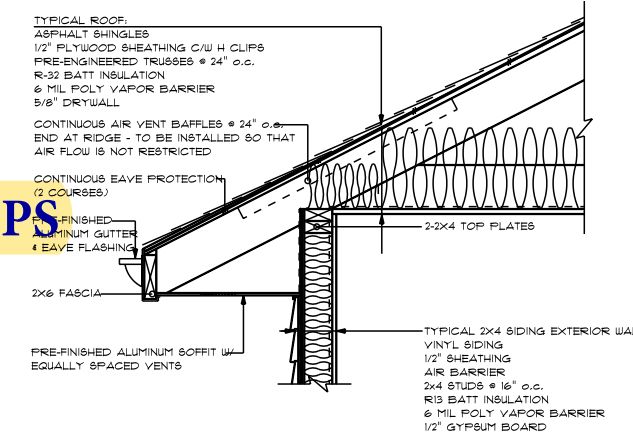

2x4/SIDING EAVE

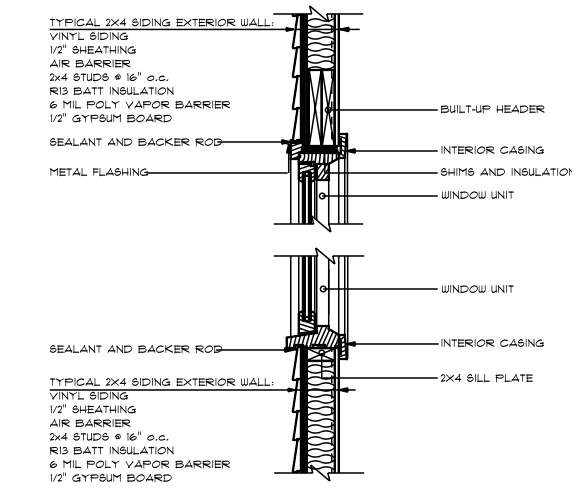

2x4/SIDING HEADER & SILL

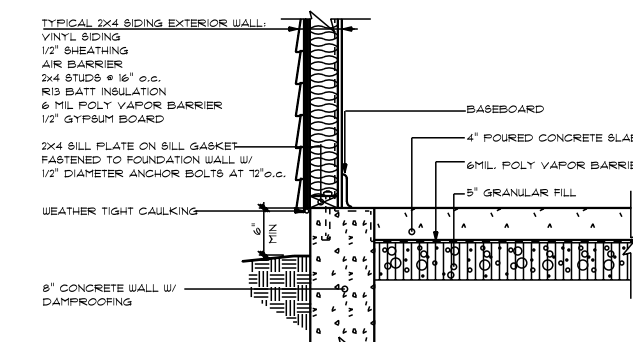

2x4/SIDING SLAB ON GRADE

DATE: Wednesday, May 19, 2021

REVISED


DRAWING*

SCALE: 1/4"

DRAWN BY

APPROVED

The Dutchess

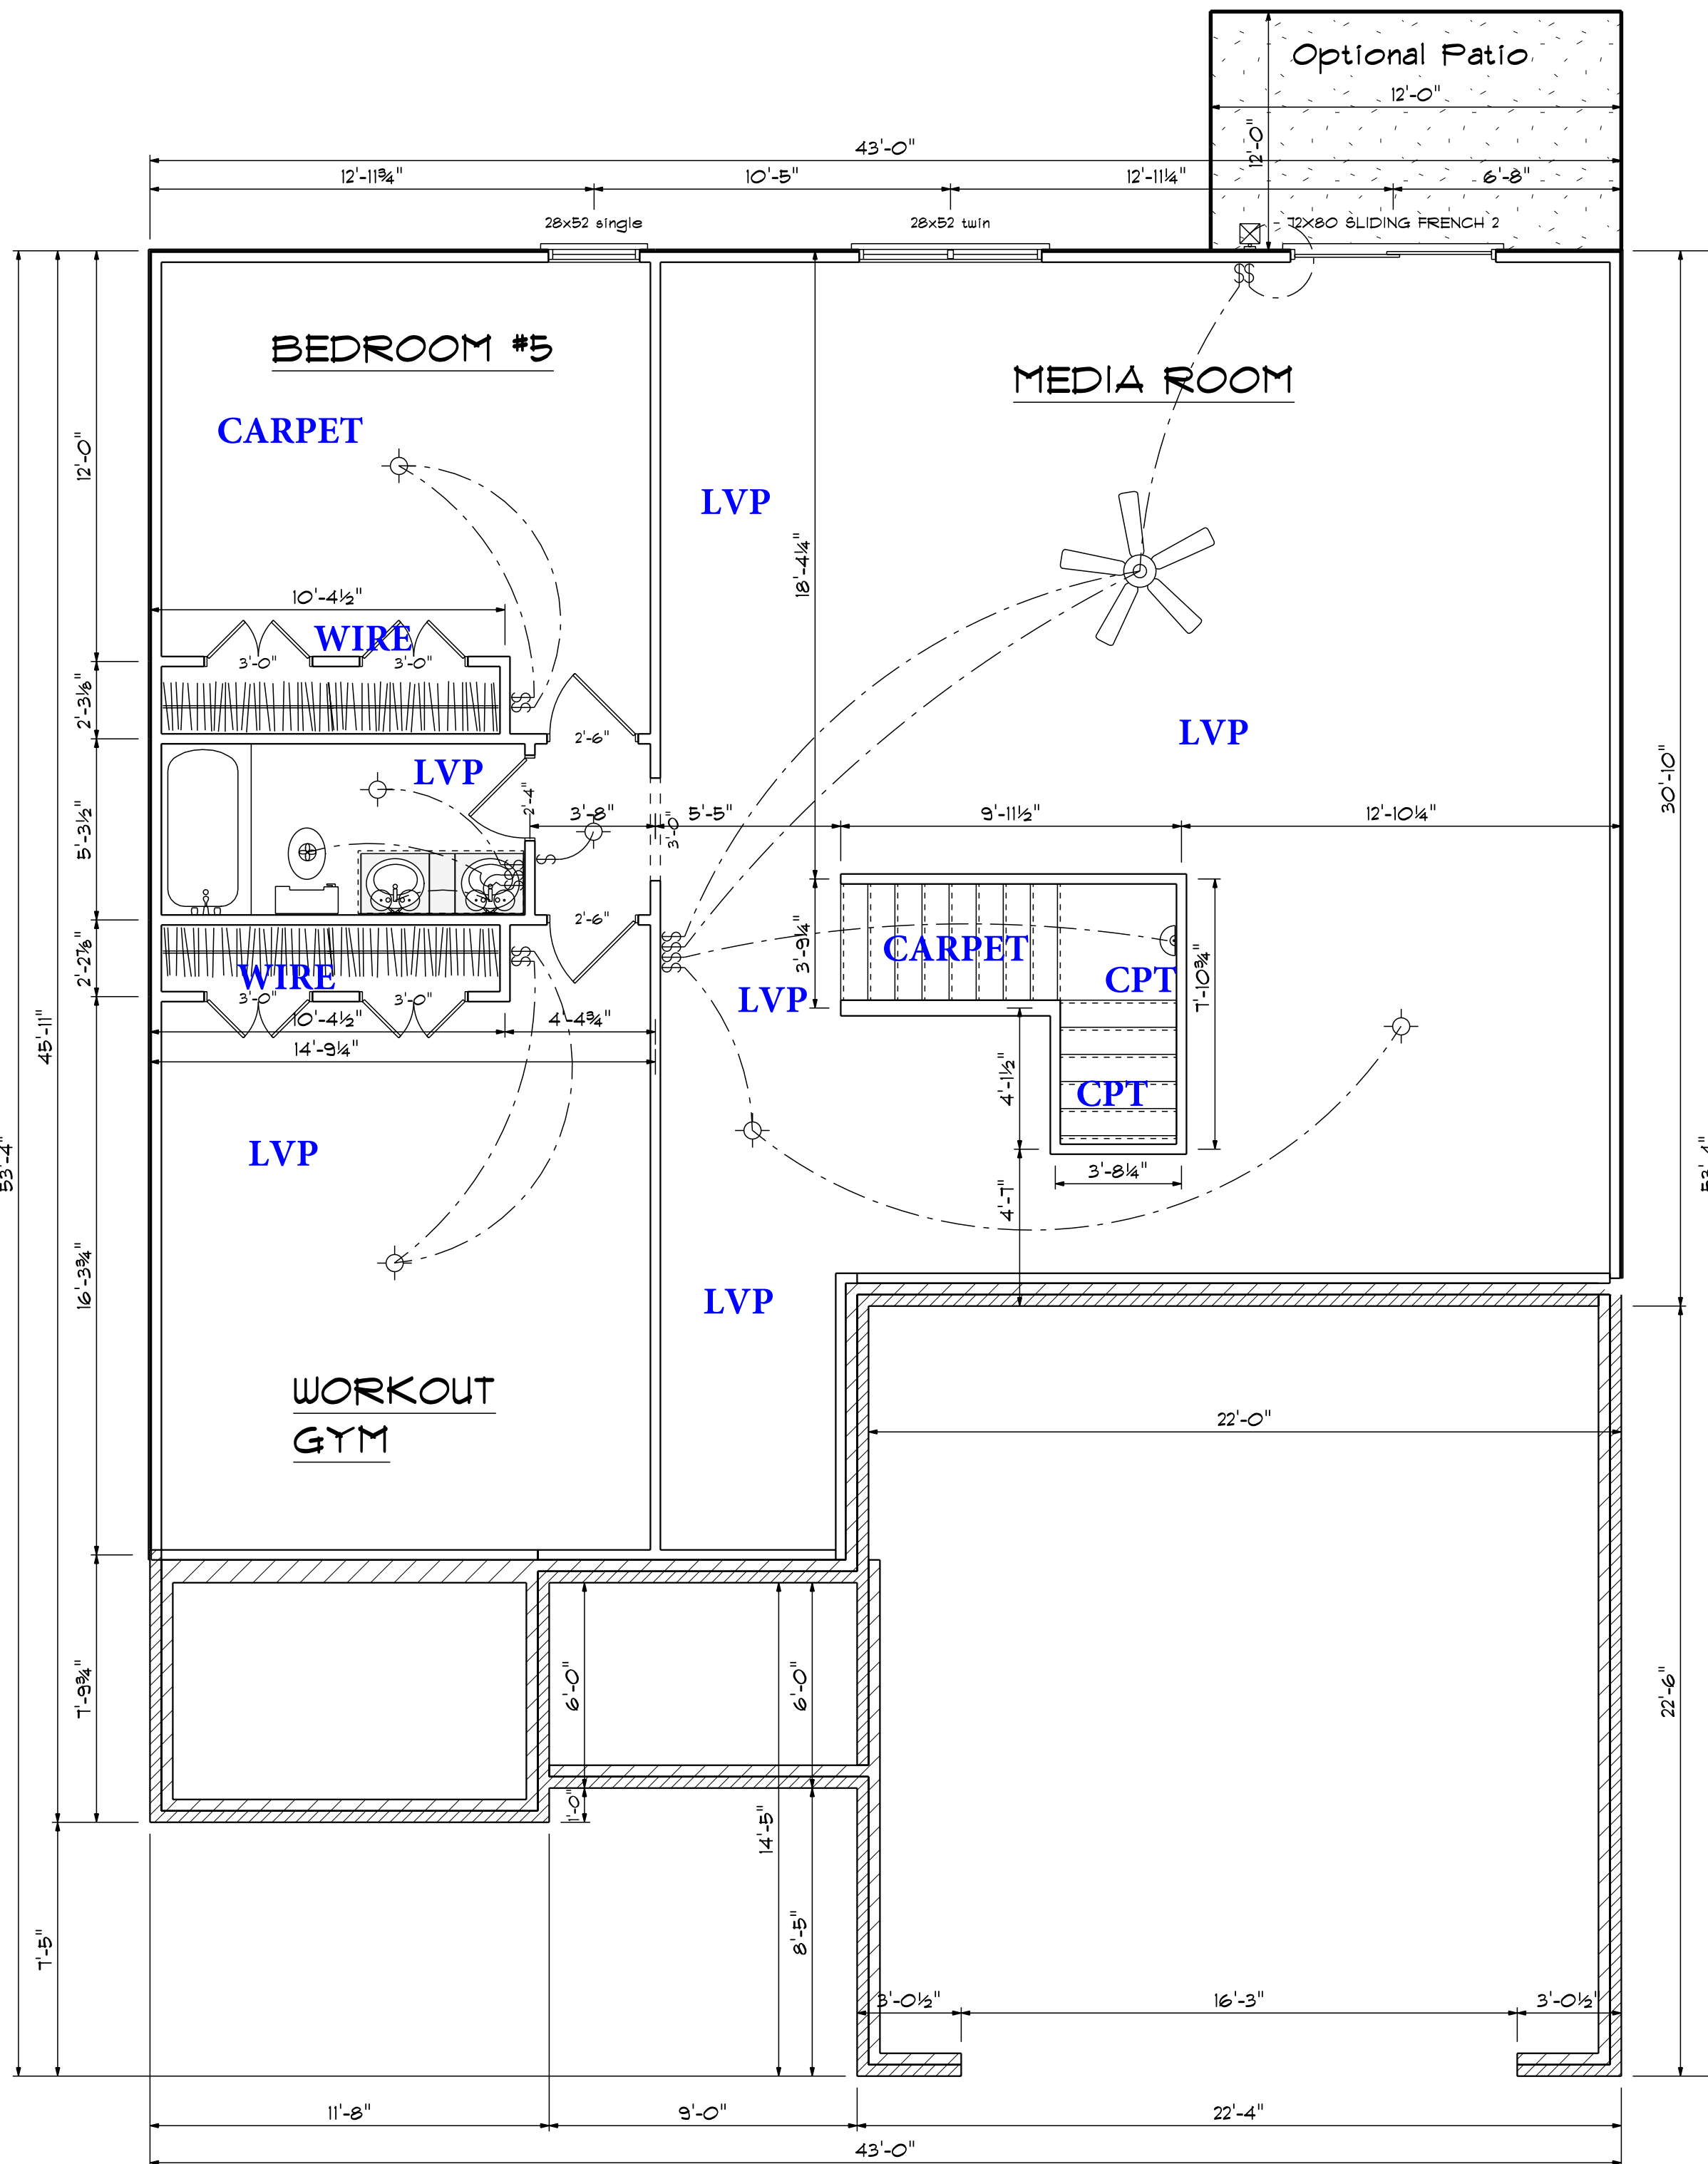

All Exterior Walls Framed With Studs At 12" O.C.

BASEMENT OPENING SCHEDULE			
PRODUCT CODE	SIZE	HINGE	COUNT
72X80 SLIDING FRENCH 2	6'-0"	NL	1
2-4 Door Unit	2'-4"	R	1
2-6 Door Unit	2'-6"	R	1
2-6 Door Unit	2'-6"	L	1
3-0 Doublehung Door Unit	3'-0"	LR	4
28x52 single	2'-8" x 5'-2"	N	1
28x52 twin	5'-4" x 5'-2"	NN	1

Basement Floor Plan

Scale: 1/4" = 1'-0"

DATE: Wednesday, May 19, 2021	REVISOR	DRAWING*
SCALE: 1/4"	DRAWN BY	APPROVED

The Dutchess

