

KENT

KENT REVISION LIST - STRUCTURAL:

1)

INVENTORY MARKED
ACX0000191

KENT REVISION LIST - ARCHITECTURAL:

1. ADDED NOTE TO EXTEND STAIR CLIP IN POWDER ROOM THE LENGTH OF THE ROOM (1-10)
2. SHOWED AHJ AND MECH LOCATIONS ON SECOND FLOOR (6-19)
3. UPDATED PLAN TO NEW CAD FORMAT AND ADDED COVER SHEET (6-19)
4. UPDATED CUSHERS (6-19)
5. CHANGED FIREPLACE FROM STANDARD TO OPTIONAL (7-25)
6. CHANGE FIREPLACE FROM 46" TO 52" (11-11-19)
7. ADDED ROOM DIMENSIONS (11-11-19)
8. CHANGE ROOM NAMES FROM MASTERS TO OWNERS (11-21-19)
9. VERIFIED AND UPDATED SQUARE FOOTAGE ON FIRST AND SECOND FLOOR (11-21-19)
10. ADDED ROOF VENTING CALCULATIONS FOR ELEV. A, B, AND C (11-29-19)
11. ADDED COURMET KITCHEN LAYOUT OPTION (12-23-19)
12. CHANGE FIREPLACE FROM STANDARD TO OPTIONAL (12-23-19)
13. REMOVE GLASS INSERTS AT GARAGE DOORS (12-23-19)
14. REMOVE METAL ACCESSORIES AT GARAGE DOORS (12-23-19)
15. CHANGE CUSHERS PER IBC4H STANDARDS (1-16-20)
16. CHANGE FIREPLACE FROM STANDARD TO OPTIONAL (1-16-20)
17. CALLED OUT REFRIGERATOR, WASHER, AND DRYER ARE OPTIONAL COMPONENTS (1-16-20)
18. VERIFIED COACH LIGHT LOCATIONS ON ALL ELEVATIONS (03-30-20)
19. REMOVED GREYS FROM WINKNWS AND DOORS ON ALL SIDE AND REAR ELEVATIONS (03-30-20)
20. REMOVED ROOF HATCH FROM ALL ELEVATIONS (03-30-20)
21. CHANGED NOTE FOR ALL GARAGES ON ELEVATIONS TO UPDATED NOTE (03-30-20)
22. UPDATED HATCHES ON ALL ELEVATIONS TO REPRESENT STONE BETTER (03-30-20)
23. ADDED ELEVATIONS TO SHOW STONE AND BRICK OPTIONS ON A2, A3, B-2, B-3, C-2, & C3 (03-30-20)
24. ADDED COLUMNS DETAIL FOR ELEVATIONS (03-30-20)
25. FIXED WINDOW TRIM AND BRICK ROWLOCK ON P-3 & P-4 (03-30-20)
26. VERIFIED AND UPDATED SQUARE FOOTAGE WITH & WITHOUT BRICK (03-30-20)
27. ADDED DIAGONAL DIMENSIONS TO SLAB INTERFERENCE PLAN (03-30-20)
28. ADDED OWNERS BATH 2 & 3 IS OPTIONS SHEET (03-30-20)
29. REPLACED OWNERS BATH WITH OWNERS BATH 1 ON BASE PLAN (03-30-20)
30. CHANGED ALL WALLS FROM 2-86 TO 2-84 EXCEPT WHERE SHARED (03-30-20)
31. CHANGED ROOM NAME "NOOK" TO "DINING ROOM" (03-30-20)
32. ADDED HOSE BIB LOCATIONS TO OPPOSITE SIDES OF THE HOUSE ON FRONT AND REAR (03-30-20)
33. CHANGED STANDARD PATH TO L2X10 (03-30-20)
34. NOTED "TEMP" WINDOWS IN OWNERS BATH (03-30-20)
35. MOVED ALL OPTIONS TO SEPARATE SHEET (03-30-20)
36. SHOWED DORMER WINDOWS ON SECOND FLOOR (03-30-20)
37. ADDED NOTE FOR ATTIC ACCESS FLOOR ON SECOND FLOOR (03-30-20)
38. NOTED "TEMP" WINKNWS IN BEDROOM 2, AND BEDROOM 4 (03-30-20)
39. CHANGED STANDARD LIGHT IN KITCHEN TO FLUORESCENT LIGHT (03-30-20)
40. NOTED PENDANT LIGHTS AS OPTIONAL (03-30-20)
41. ADDED OPTIONAL FLOOR OUTLETS IN FAMILY ROOM (03-30-20)
42. REMOVED ALL OUTLETS EXCEPT OPTIONAL FLOOR OUTLET (03-30-20)
43. VERIFIED ALL COACH LIGHT LOCATIONS (03-30-20)
44. NO RED ALL PANS AS STD LIGHT OPT PAN/LT PREWIRE IN ALL BEDROOMS (03-30-20)
45. UPDATED ELECTRICAL LEGEND (03-30-20)
46. NOTED FLOOD LIGHTS AS OPTIONAL (03-30-20)



H&H HOMES
KENT

DATE: MARCH 27, 2019
REV: JUNE 01, 2020
DRAWN BY: WJG
ENGINEERED BY:
REVIEWED BY:



COVER SHEET




H&H HOMES, INC.
 1000 WEST 10TH AVENUE, SUITE 100
 DENVER, CO 80202
 TEL: 303.733.1111
 WWW.H&HHOMES.COM


H&H HOMES, INC.
 KENT

DATE: MARCH 27, 2019
 REV: JUNE 01, 2020
 SCALE: AS NOTED
 DRAWN BY: WJT
 ENGINEERED BY:
 REVIEWED BY:
 B-2, B-3
 ELEVATIONS W/
 STONE

A-2.2

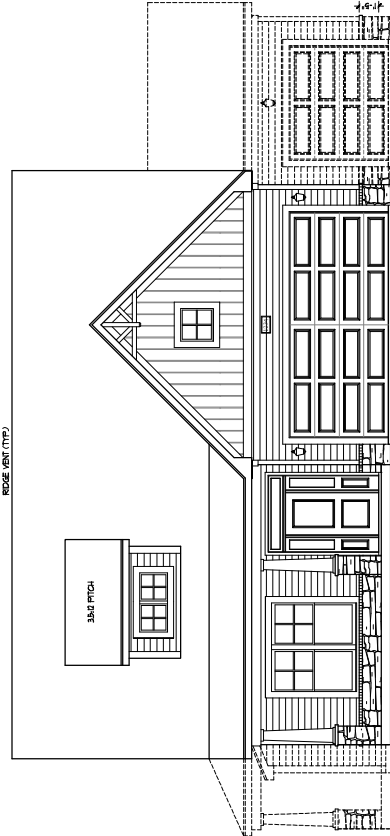


FRONT ELEVATION-B-2
SCALE: 1/4" = 1'-0"

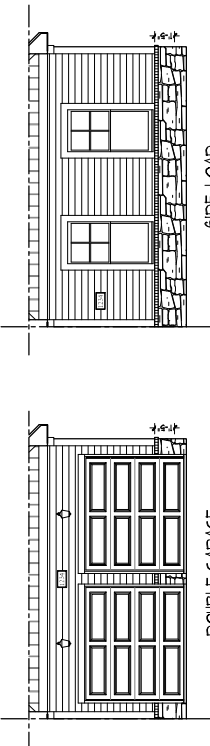

SIDE - LOAD
 GARAGE OPTION
 ONLY AVAILABLE WITH
 OPTIONAL ONE-CAR GARAGE!
 SCALE: 1/4" = 1'-0"

DOUBLE GARAGE
 DOOR OPTION
 ONLY AVAILABLE WITH
 FRONT LOAD GARAGE!
 SCALE: 1/4" = 1'-0"

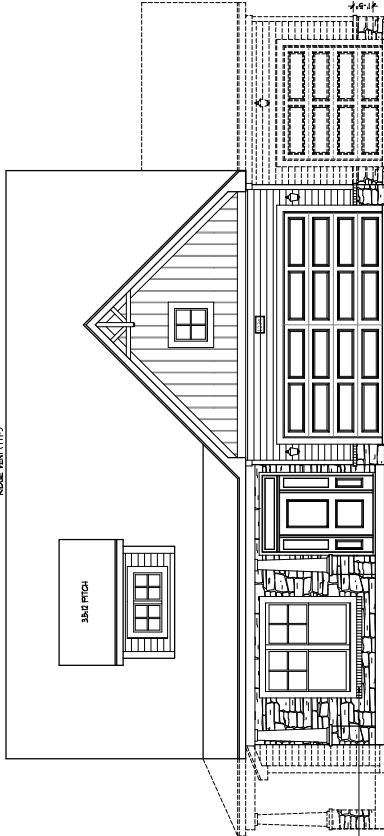

FRONT ELEVATION-B-3
SCALE: 1/4" = 1'-0"

STONE LEDGE
AS SPEC. (TYP)




PLEASE REVISIONS AND/OR COMMENTS FROM THE ARCHITECT MUST BE RECEIVED BY THE ARCHITECT PRIOR TO THE COMMENCEMENT OF CONSTRUCTION. THE ARCHITECT'S RESPONSIBILITY IS LIMITED TO THE DESIGN AND CONSTRUCTION OF THE BUILDING AS SHOWN ON THESE PLANS. THE ARCHITECT DOES NOT ASSUME RESPONSIBILITY FOR THE DESIGN OR CONSTRUCTION OF ANY OTHER STRUCTURES OR UTILITIES THAT MAY BE NEAR OR ADJACENT TO THE BUILDING. THE ARCHITECT DOES NOT ASSUME RESPONSIBILITY FOR THE DESIGN OR CONSTRUCTION OF ANY OTHER STRUCTURES OR UTILITIES THAT MAY BE NEAR OR ADJACENT TO THE BUILDING.


H&H HOMES, INC.
KENT

DATE: MARCH 27, 2019
REV: JUNE 01, 2020
SCALE: 1/4" = 1'-0"
DRAWN BY: WJF
ENGINEERED BY:
REVIEWED BY:


SLAB INTERFACE PLAN - OPTIONS
A-5.1

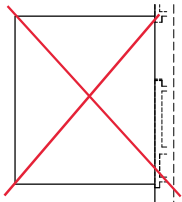


OPTIONAL EXTENDED PATIO

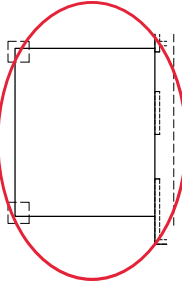


OPTIONAL COVERED PORCH

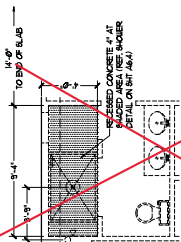


OPTIONAL OWNER'S BATH 3
FOUNDATION PLAN NOT REQUIRED FOR THIS OPTION

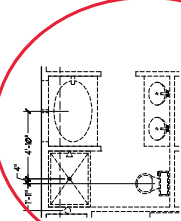


OPTIONAL OWNER'S BATH 2
FOUNDATION PLAN NOT REQUIRED FOR THIS OPTION

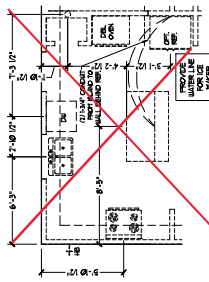


OPTIONAL COURTYARD KITCHEN

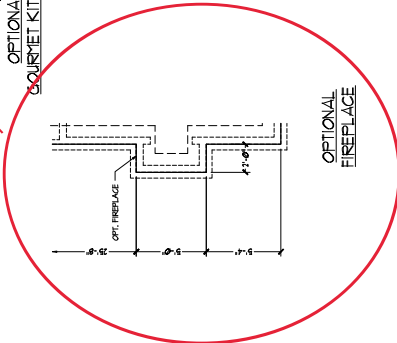


OPTIONAL FIREPLACE

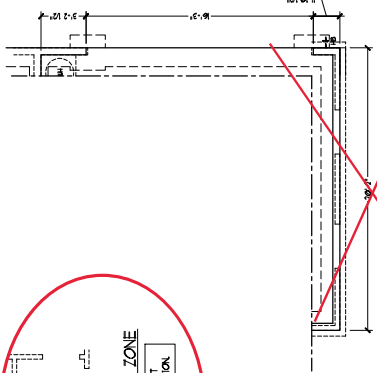


SIDE-LOAD GARAGE OPTION
(NOT AVAILABLE WITH OPTIONAL ONE-CAR GARAGE)

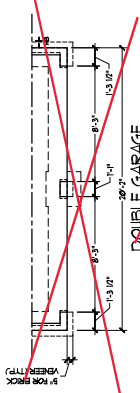

DOUBLE GARAGE DOOR OPTION
(ONLY AVAILABLE WITH FRONT LOAD GARAGE)

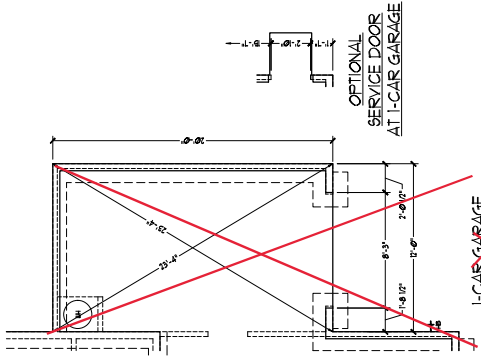

OPTIONAL SERVICE DOOR AT 1-CAR GARAGE

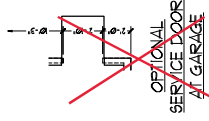

OPTIONAL SERVICE DOOR AT GARAGE

OPTIONAL OPEN RAIL TO 45" WALL W/ CAP
FOUNDATION PLAN NOT REQUIRED FOR THIS OPTION

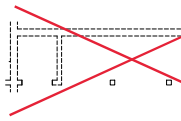




PHOTO: ROBERTSON ARCHITECTS/STANLEY
 ARCHITECTS
 10000 W. 30TH AVENUE, SUITE 100, DENVER, CO 80231
 (303) 751-1000
 WWW.H&HHOMES.COM
 H&H HOMES, INC.
 10000 W. 30TH AVENUE, SUITE 100, DENVER, CO 80231
 (303) 751-1000
 WWW.H&HHOMES.COM

H&H HOMES, INC.
 KENT

DATE: MARCH 27, 2019
 REV: JUNE 01, 2020
 SCALE: 1/4" = 1'-0"
 DRAWN BY: WJC
 ENGINEERED BY:
 REVIEWED BY:

FIRST FLOOR
 PLAN

A-6

SQUARE FOOTAGE	
1st FLOOR	1456 SF
TOTAL	1456 SF
COVERED PORCH	1456 SF
PAVED	1456 SF
2nd FLOOR	1456 SF
TOTAL	1456 SF
COVERED PORCH	1456 SF
PAVED	1456 SF

SQUARE FOOTAGE (W/ ALL FINISHES)	
1st FLOOR	1456 SF
TOTAL	1456 SF
COVERED PORCH	1456 SF
PAVED	1456 SF
2nd FLOOR	1456 SF
TOTAL	1456 SF
COVERED PORCH	1456 SF
PAVED	1456 SF


NOTE: 1. ALL DIMENSIONS SHALL BE TO THE CENTERLINE UNLESS NOTED OTHERWISE.
 2. DIMENSIONS SHALL BE TO THE CENTERLINE UNLESS NOTED OTHERWISE.
 3. DIMENSIONS SHALL BE TO THE CENTERLINE UNLESS NOTED OTHERWISE.
 4. DIMENSIONS SHALL BE TO THE CENTERLINE UNLESS NOTED OTHERWISE.
 5. DIMENSIONS SHALL BE TO THE CENTERLINE UNLESS NOTED OTHERWISE.

OWNERS BATH2

COVERED PORCH







DROP ZONE

FIREPLACE

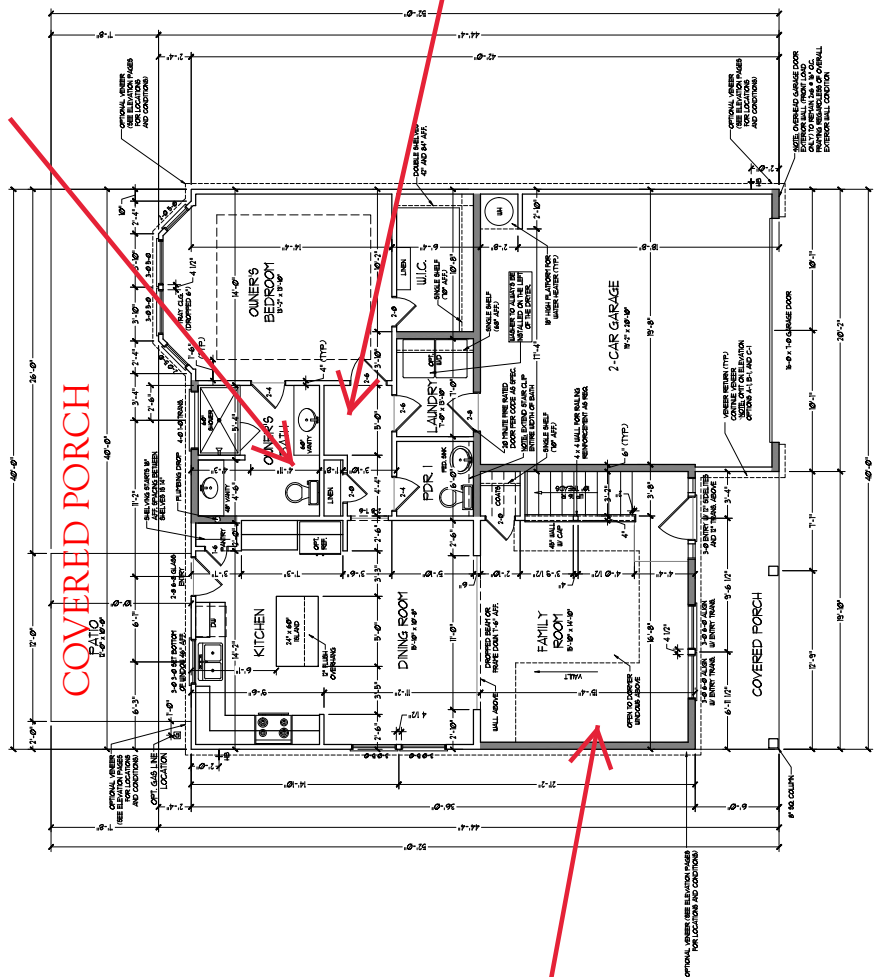

FIRST FLOOR PLAN
 (A-1, B-1 AND C-1)

PLEASE REVISIONS AND/OR COMMENTS TO BE SUBMITTED TO THE ARCHITECT WITHIN 14 DAYS OF THE DATE OF THIS SET OF DRAWINGS. ANY CHANGES TO THE DRAWINGS MUST BE APPROVED BY THE ARCHITECT. THE ARCHITECT'S OFFICE SHALL BE RESPONSIBLE FOR THE ACCURACY OF THE INFORMATION PROVIDED ON THESE DRAWINGS. THE ARCHITECT SHALL NOT BE RESPONSIBLE FOR THE ACCURACY OF THE INFORMATION PROVIDED BY OTHER PROFESSIONALS OR FOR THE ACCURACY OF THE INFORMATION PROVIDED BY THE CLIENT. THE ARCHITECT SHALL NOT BE RESPONSIBLE FOR THE ACCURACY OF THE INFORMATION PROVIDED BY THE CLIENT. THE ARCHITECT SHALL NOT BE RESPONSIBLE FOR THE ACCURACY OF THE INFORMATION PROVIDED BY THE CLIENT.

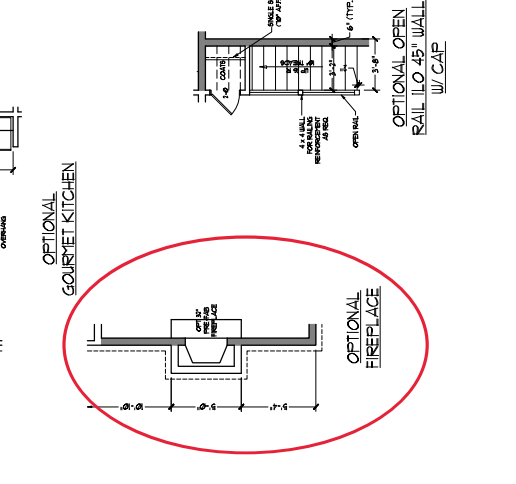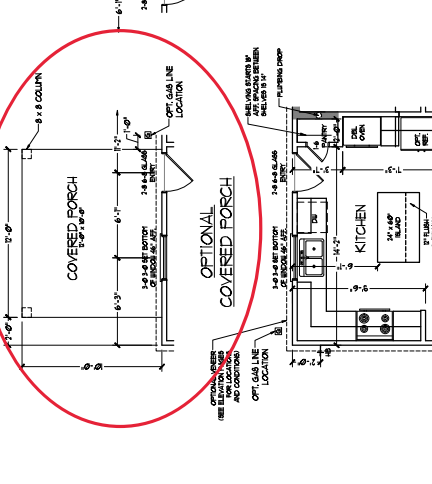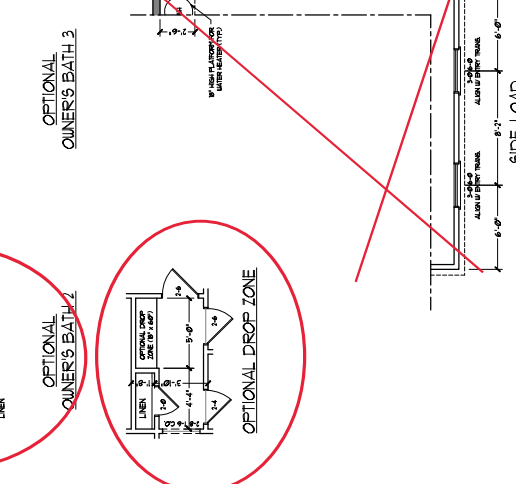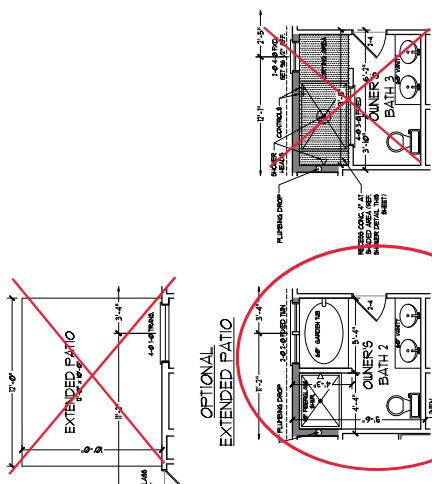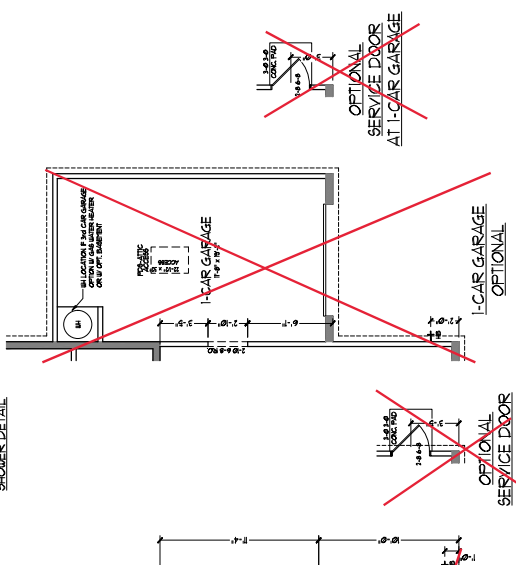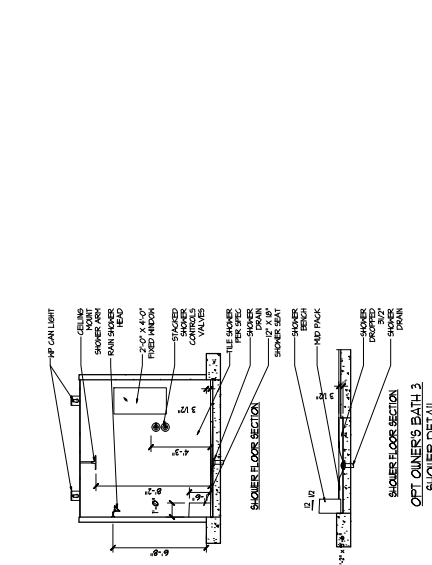

NOT AVAILABLE WITH
OPTIONAL ONE-CAR GARAGE

DOUBLE GARAGE DOOR OPTION
(ONLY AVAILABLE WITH FRONT LOAD GARAGE)

OPTIONAL SERVICE DOOR AT GARAGE

OPTIONAL SERVICE DOOR AT 1-CAR GARAGE

OPTIONAL OWNER'S BATH 3

OPTIONAL OWNER'S BATH 2

OPTIONAL OWNER'S BATH 3

OPTIONAL GOURMET KITCHEN

OPTIONAL FIREPLACE

OPTIONAL DROP ZONE

OPTIONAL OPEN RAIL 10'45" WALL W/ CAP

OPTIONAL COVERED PORCH

OPTIONAL EXTENDED PATIO

EXTENDED PATIO

COVERED PORCH

OPTIONAL COVERED PORCH

OPTIONAL GOURMET KITCHEN

OPTIONAL FIREPLACE

OPTIONAL DROP ZONE

OPTIONAL OPEN RAIL 10'45" WALL W/ CAP

OPTIONAL SERVICE DOOR AT GARAGE

OPTIONAL SERVICE DOOR AT 1-CAR GARAGE

OPTIONAL OWNER'S BATH 3

OPTIONAL OWNER'S BATH 2

OPTIONAL OWNER'S BATH 3

OPTIONAL GOURMET KITCHEN

OPTIONAL FIREPLACE

OPTIONAL DROP ZONE

OPTIONAL OPEN RAIL 10'45" WALL W/ CAP

OPTIONAL COVERED PORCH

OPTIONAL EXTENDED PATIO

EXTENDED PATIO

COVERED PORCH

OPTIONAL COVERED PORCH

OPTIONAL GOURMET KITCHEN









OPTIONAL FIREPLACE

OPTIONAL DROP ZONE

OPTIONAL OPEN RAIL 10'45" WALL W/ CAP



ALL DIMENSIONS ARE TO FACE UNLESS NOTED OTHERWISE.
 ALL FINISHES ARE TO BE DETERMINED BY THE CLIENT.
 THE CLIENT SHALL BE RESPONSIBLE FOR OBTAINING ALL NECESSARY PERMITS AND APPROVALS FROM THE LOCAL BUILDING DEPARTMENT.
 THE CLIENT SHALL BE RESPONSIBLE FOR OBTAINING ALL NECESSARY PERMITS AND APPROVALS FROM THE LOCAL BUILDING DEPARTMENT.
 THE CLIENT SHALL BE RESPONSIBLE FOR OBTAINING ALL NECESSARY PERMITS AND APPROVALS FROM THE LOCAL BUILDING DEPARTMENT.

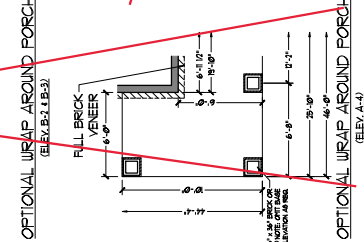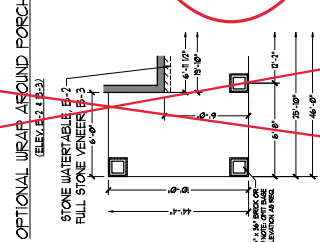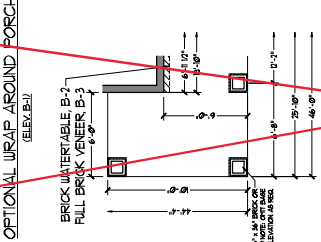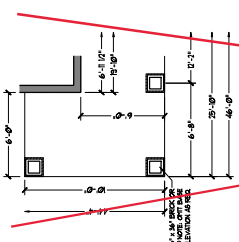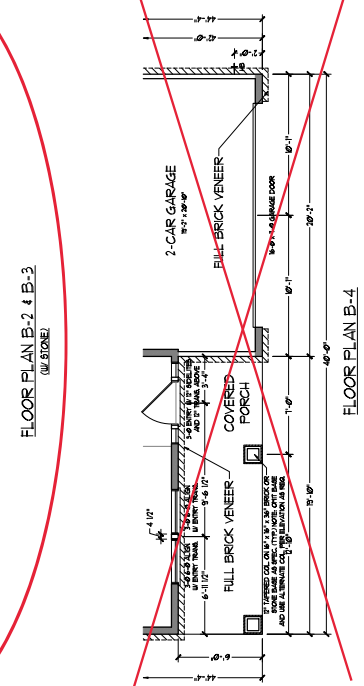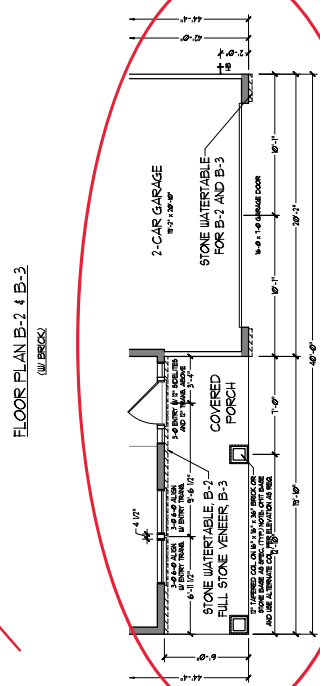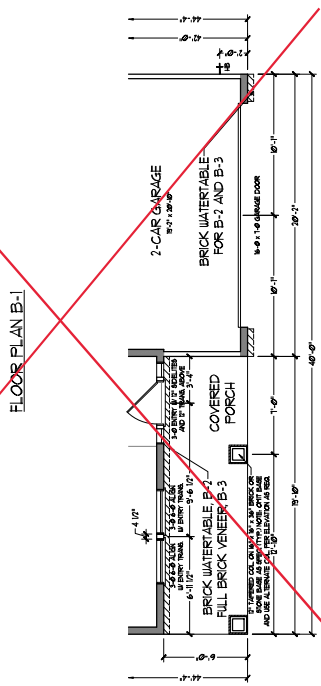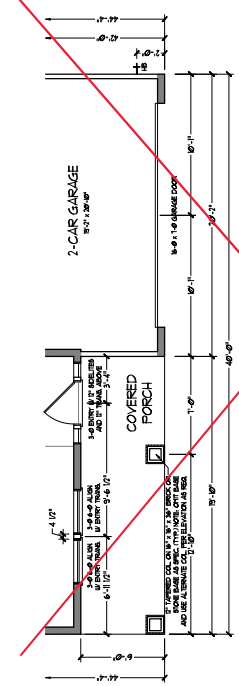







PLEASE REFER TO THE ARCHITECT'S SPECIFICATIONS FOR THE ROOFING SYSTEM. THE ROOFING SYSTEM SHALL BE AS SHOWN UNLESS OTHERWISE NOTED. ALL DIMENSIONS ARE TO FACE UNLESS OTHERWISE NOTED. THE ROOFING SYSTEM SHALL BE AS SHOWN UNLESS OTHERWISE NOTED. THE ROOFING SYSTEM SHALL BE AS SHOWN UNLESS OTHERWISE NOTED.

H&H HOMES, INC.
KENT

DATE: MARCH 27, 2019
REV: JUNE 01, 2020
SCALE: 1/4" = 1'-0"
DRAWN BY: WJZ
ENGINEERED BY:
REVIEWED BY:

ROOF PLAN
OPTIONS
A-8.3

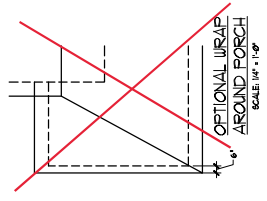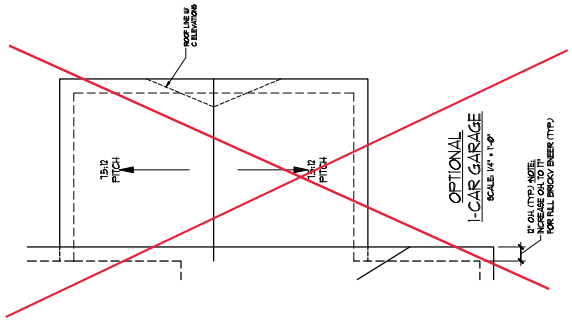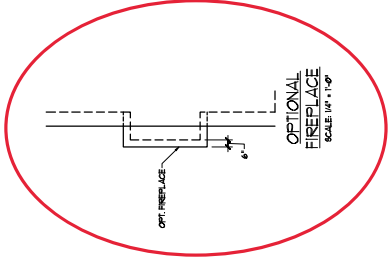
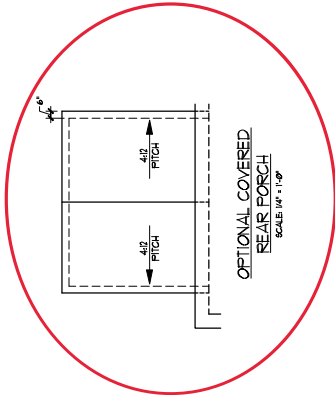


PT. 04 (TYP.) NOTE:
REFER TO
PART 05 20 00 (M.P.)




PLEASE REVISIONS AND/OR COMMENTS TO BE SUBMITTED TO THE ARCHITECT WITHIN 14 DAYS OF THE DATE OF THIS SET OF DRAWINGS. ANY CHANGES TO BE MADE TO THIS SET OF DRAWINGS SHALL BE MADE BY THE ARCHITECT. THE ARCHITECT'S OFFICE SHALL BE RESPONSIBLE FOR THE ACCURACY OF THE INFORMATION PROVIDED IN THIS SET OF DRAWINGS. THE ARCHITECT'S OFFICE SHALL NOT BE RESPONSIBLE FOR THE ACCURACY OF THE INFORMATION PROVIDED BY OTHER SOURCES. THE ARCHITECT'S OFFICE SHALL NOT BE RESPONSIBLE FOR THE ACCURACY OF THE INFORMATION PROVIDED BY OTHER SOURCES.

H&H HOMES, INC.
KENT
DATE: MARCH 27, 2019
REV: JUNE 01, 2020
SCALE: 1/4" = 1'-0"
DRAWN BY: WJG
ENGINEERED BY:
REVIEWED BY:
WALL SECTIONS
AND STAIR
DETAIL
AD-1

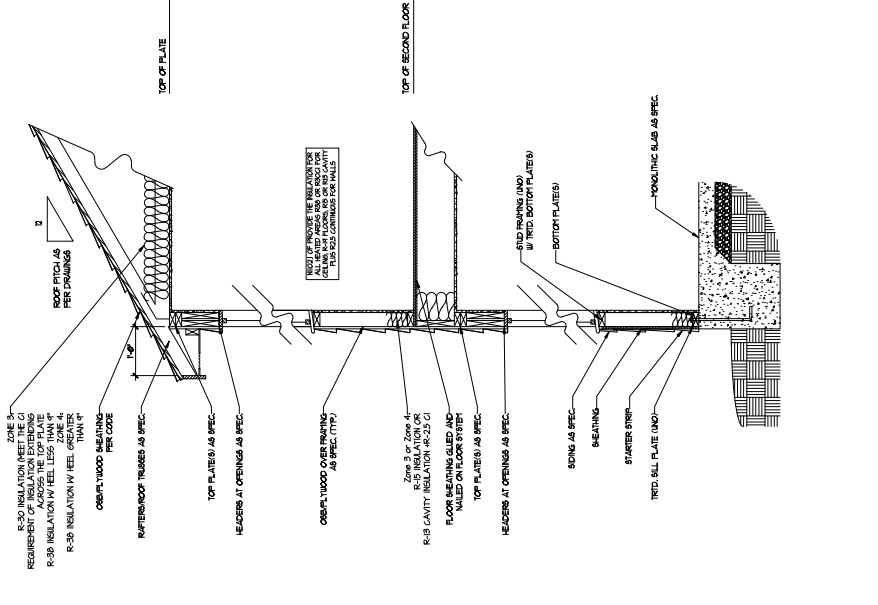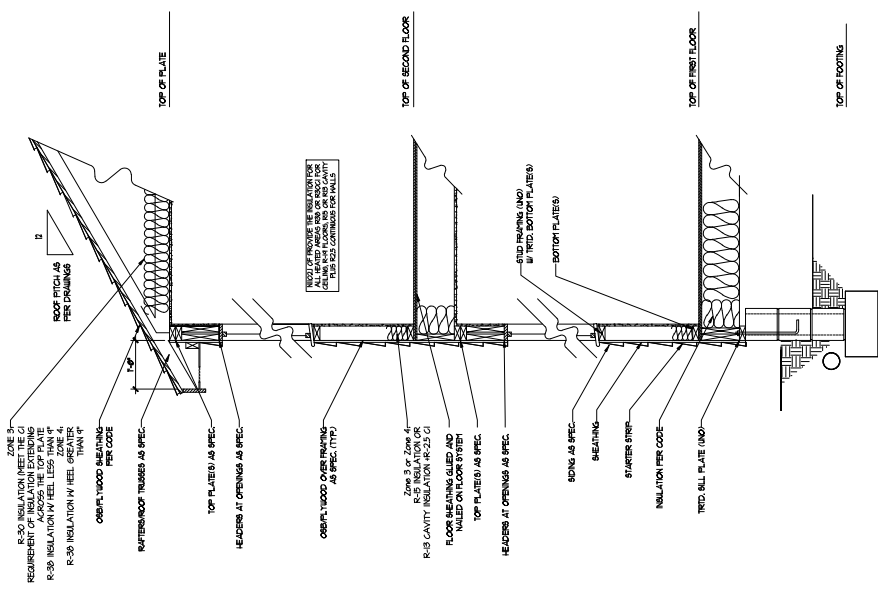

WALL SECTION W/ CRAWL SPACE
W/ STD. SIDING SHOWN (NTS)

WALL SECTION W/ SLAB
W/ STD. SIDING SHOWN (NTS)

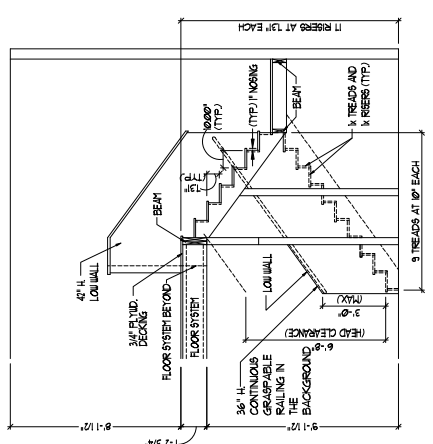

TYPICAL STAIR DETAIL
(NTS)

STAIR NOTES:
 1. WALLS SHALL BE SPACED SO THAT A 4" SPHERE CANNOT PASS THROUGH.
 2. THE TRAILING AS OPENINGS COVERED BY THE RISER, TREAD AND BOTTOM RAIL OF A GUARD, AT THE OPERABLE END OF A GUARD, SHALL BE SECURED TO THE WALL OR OTHER STRUCTURE OF A BUILDING CANNOT PASS THROUGH.
 3. OPENINGS FOR REQUIRED GUARDS ON THE SIDES OF STAIR HANDRAILS SHALL NOT ALLOW A SPHERE 4.50 INCHES IN DIAMETER TO PASS THROUGH.
 4. HANDRAILS OVER STAIRWAYS SHALL BE CONTINUOUS FOR THE FULL LENGTH OF THE FLIGHT FROM A POINT DIRECTLY ABOVE THE LOWER RISER HANDRAIL ENDS SHALL BE RETURNED OR EXTENDED TO THE WALL OR OTHER STRUCTURE OF A BUILDING NOT LESS THAN 1/2" FROM BETWEEN THE WALL AND HANDRAIL.
 5. CONTINUOUS GRIPABLE HANDRAIL MUST FIT THE ONE OR THE TWO OUTSTRA.




PLEASE REVISIONS AND/OR COMMENTS FROM THE ARCHITECT MUST BE SUBMITTED TO THE ARCHITECT FOR REVIEW AND APPROVAL. ALL CHANGES MUST BE MADE TO ALL DRAWINGS AND SPECIFICATIONS. THE ARCHITECT IS NOT RESPONSIBLE FOR ANY CHANGES MADE TO THIS DRAWING WITHOUT HIS WRITTEN CONSENT. THIS DRAWING IS THE PROPERTY OF H&H HOMES, INC. AND IS NOT TO BE REPRODUCED OR TRANSMITTED IN ANY FORM OR BY ANY MEANS, ELECTRONIC OR MECHANICAL, INCLUDING PHOTOCOPYING, RECORDING, OR BY ANY INFORMATION STORAGE AND RETRIEVAL SYSTEM. H&H HOMES, INC. 2020

H&H HOMES, INC.
KENT

DATE: MARCH 27, 2019
REV: JUNE 01, 2020
SCALE: 1/4" = 1'-0"
DRAWN BY: WJF
ENGINEERED BY:
REVIEWED BY:
FIRST FLOOR ELECTRICAL PLAN

E-1.1

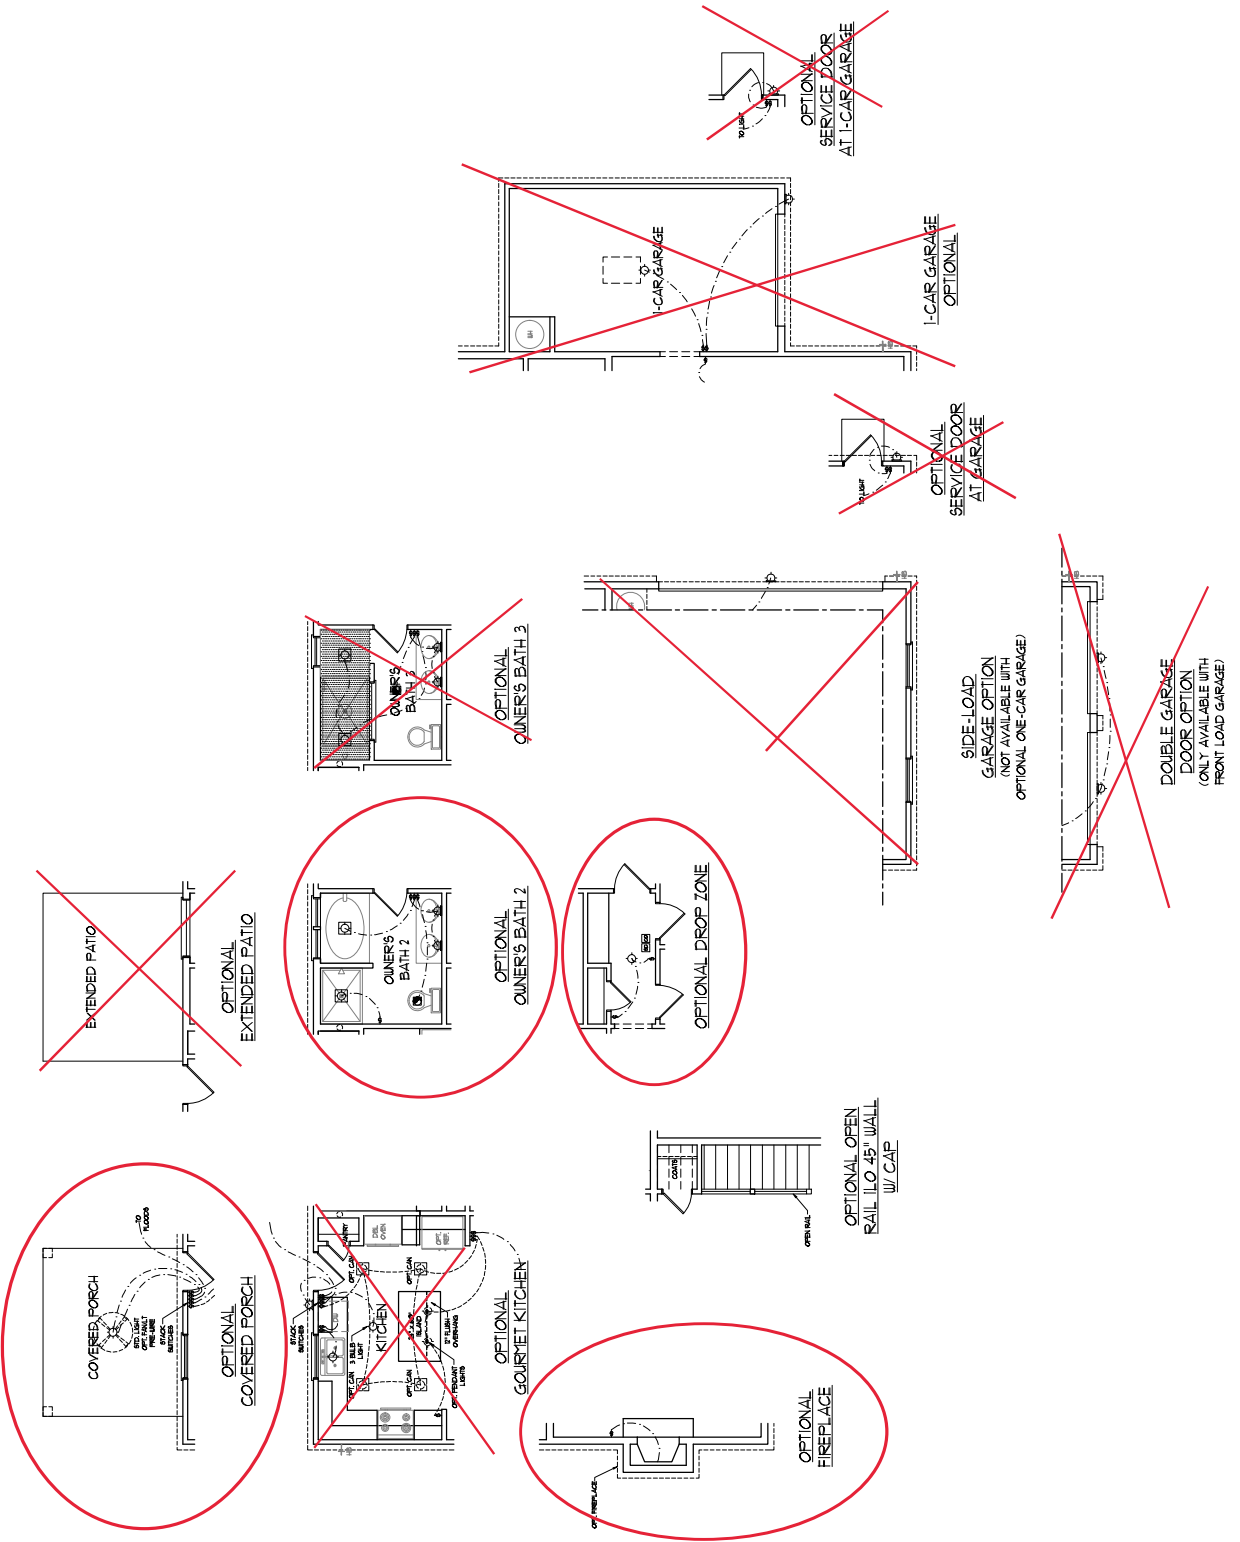

~~EXTENDED PATIO~~
OPTIONAL
~~EXTENDED PATIO~~

~~OWNER'S BATH 1~~
OPTIONAL
~~OWNER'S BATH 3~~

OWNER'S BATH 2
OPTIONAL
OWNER'S BATH 2

OPTIONAL DROP ZONE

~~OPTIONAL GOURMET KITCHEN~~

OPTIONAL FIREPLACE

OPTIONAL OPEN RAIL (10' x 45") WALL W/ CAP

SIDE-LOAD GARAGE OPTION (NOT AVAILABLE WITH OPTIONAL ONE-CAR GARAGE)

DOUBLE GARAGE DOOR OPTION (ONLY AVAILABLE WITH FRONT LOAD GARAGE)

~~OPTIONAL SERVICE DOOR AT 1-CAR GARAGE~~

~~1-CAR GARAGE OPTIONAL~~


~~OPTIONAL SERVICE DOOR AT GARAGE~~

ATTIC VENT CALCULATION:
 879 SQ FT OF ATTIC DIVIDED BY
 100 = 8.79 SQ FT PER
 FREE VENTILATING AREA (FVA)

BRICK SUPPORT NOTE:
 1. FASTEN (2) 2 x 4 BLOOMS BETWEEN WALL
 AND BRICK. BRICK TO BE 8" MIN. THICK
 6" x 4" x 8' W/ STEEL ANGLE TO (2) 2 x 4 B
 BLOOMS @ (2) 16" O.C. SPACING @ 1' O.C.
 2. BRICK TO BE 8" MIN. THICK
 THE 8" BRICK FOR ADDITIONAL BRICK
 WORK SHALL BE 8" MIN. THICK
 3. WHERE ROOF SLOPES EXCEED 1:12, INSTALL
 3" x 3" x 1/4" STEEL PLATE STOPS AT 24"
 ON CENTER. SEE SECTION 9.01 FOR NORTH
 CAROLINA RESIDENTIAL CODE, 2006
 EDITION.








STRUCTURAL NOTES:

1. TRUSSING LUMBER TO BE 'S'
2. CIRCLES PENOTE (3) 2 x 4 POLES
3. MAKE CORNER WALLS ON TOP OF DOUBLE OR TRIPLE PARTS
4. 4" MIN. OF 8' @ 1" FASTEN
5. REFER TO THESE ROOMS OF TRUSSING
6. BRICK FRAM OVER-HEADED
7. 2 x 4 BLOOMS @ 16" O.C. ROOF
8. BRICK FRAM OVER-HEADED
9. BRICK FRAM OVER-HEADED
10. BRICK FRAM OVER-HEADED
11. BRICK FRAM OVER-HEADED
12. BRICK FRAM OVER-HEADED
13. BRICK FRAM OVER-HEADED
14. BRICK FRAM OVER-HEADED
15. BRICK FRAM OVER-HEADED
16. BRICK FRAM OVER-HEADED
17. REFER TO SECTION 9.01 OF THE NORTH CAROLINA RESIDENTIAL CODE FOR RESISTANCE OF RAFTERS AND TRUSSES
18. TRUSSING SYSTEM HAS DETAIL SHEETS FOR ADDITIONAL STRUCTURAL INFORMATION








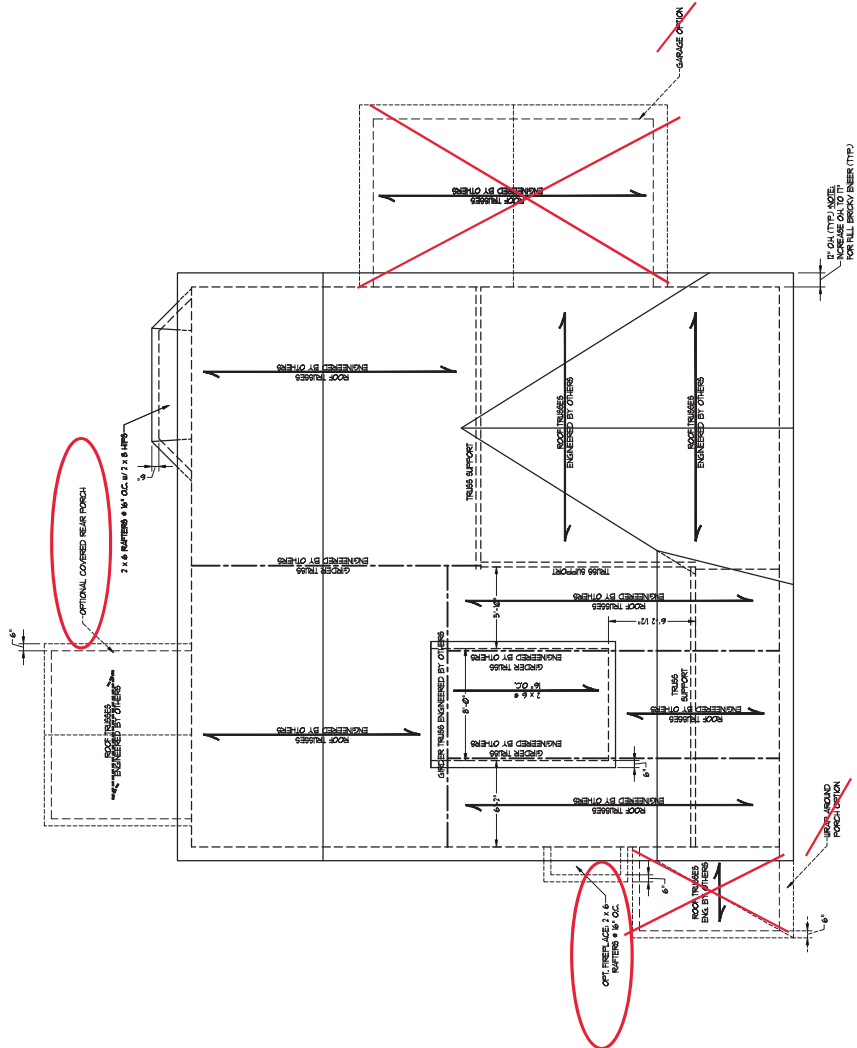


ELEVATION B

MONOLITHIC SLAB DETAILS

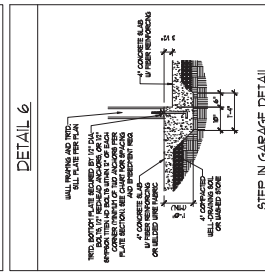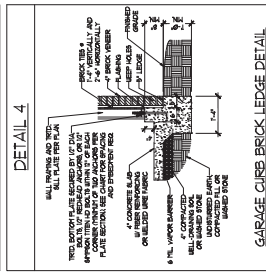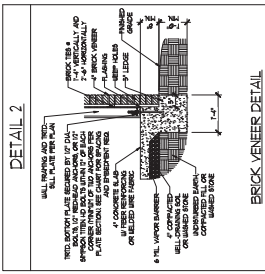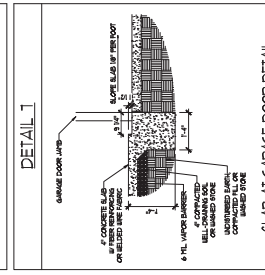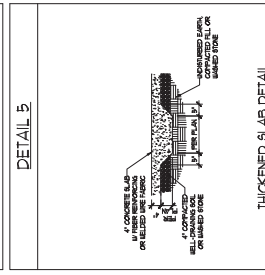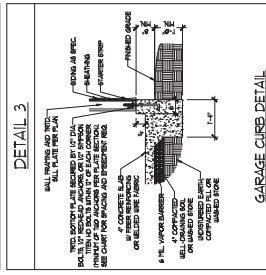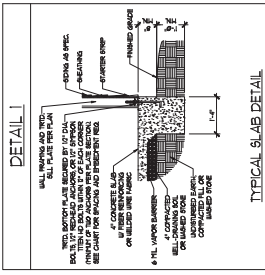

STEM WALL DETAILS

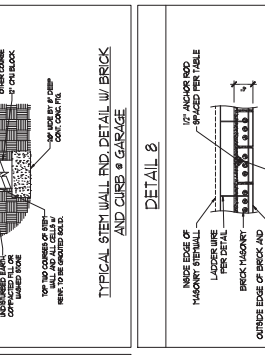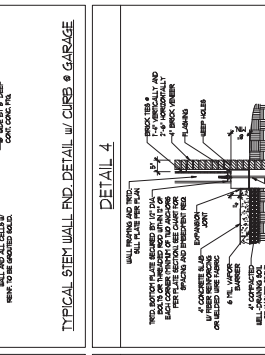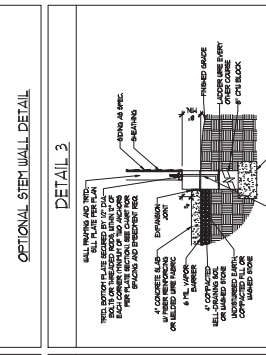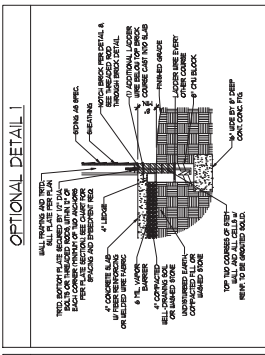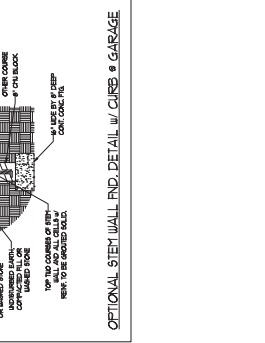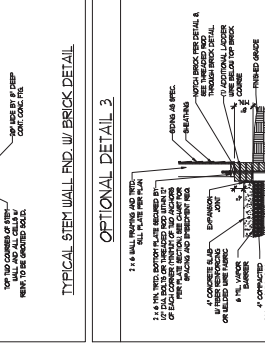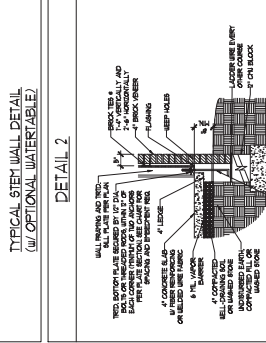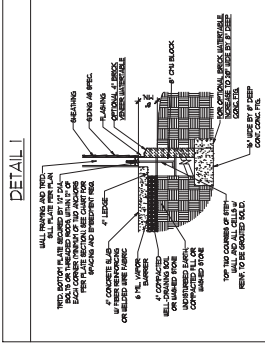

MASONRY STEM WALL SPECIFICATIONS

WALL HEIGHT (FEET)	MASONRY WALL TYPE			
	8\"/>			
7 AND BELOW	UNANCHORED	UNANCHORED	UNANCHORED	UNANCHORED
3	UNANCHORED	UNANCHORED	UNANCHORED	UNANCHORED
4	UNANCHORED	UNANCHORED	UNANCHORED	UNANCHORED
5	UNANCHORED	UNANCHORED	UNANCHORED	UNANCHORED
6	UNANCHORED	UNANCHORED	UNANCHORED	UNANCHORED
7 AND GREATER	UNANCHORED	UNANCHORED	UNANCHORED	UNANCHORED

STRUCTURAL NOTES:

- WALL HEIGHT MEASURED FROM TOP OF FOOTING TO TOP OF THE WALL.
- ANCHOR BOLTS SHALL BE INSTALLED AT 48\"/>

ANCHOR SPACING AND EMBEDMENT

WIND ZONE	100 MPH	130 MPH
SPACING	6\"/>	



