

# FIELD & REDLINE NOTES

## LIST OF SYMBOLS

|  |                                    |  |                              |
|--|------------------------------------|--|------------------------------|
|  | SECTION MARK                       |  | DATUM ELEVATION              |
|  | DETAIL MARK                        |  | SLOPE UP PITCH               |
|  | TITLE MARK                         |  | EARTH                        |
|  | INTERIOR BEARING WALL              |  | INSULATION                   |
|  | STANDARD WALL                      |  | NUMBER OF GANG STUDS IN WALL |
|  | ENGINEERED COLUMN SPEC'D BY OTHERS |  | INTERIOR WALL POINT LOAD     |


## LIST OF ABBREVIATIONS

|        |                                  |       |                                  |          |                               |       |   |
|--------|----------------------------------|-------|----------------------------------|----------|-------------------------------|-------|---|
| ACCESS | ACCESS TO ATTIC OR CRAWL SPACE   | DH    | DISH WASHER                      | PCKT     | ROCKET DOOR                   | T.C.  | TOP CHORD                                 |
| AFF    | ABOVE FLOOR                      | EQ    | EQUAL                            | PERF     | PERFORATED                    | TOM   | TOP OF WALL                               |
| BD     | BOARD                            | FDN   | FOUNDATION                       | PL       | PLATE                         | TRANS | TRANSOM                                   |
| BDRM   | BEDROOM                          | FV    | FOUNDATION VENT                  | PT       | PRESSURE TREATED FOR EXPOSURE | TYP   | TYPICAL                                   |
| BM     | BEAM                             | GL    | GLASS (DOOR)                     | PL       | POINT LOAD (SOLID BLOCK)      | UN    | UNLESS OTHERWISE NOTED                    |
| CAB    | CABINETS / CABINERY              | HB    | HOSE BIB                         | R45      | ROD & SHELF (CLOSETS)         | V.B.  | VAPOR BARRIER                             |
| CJ     | CONTROL JOINT                    | HDR   | DOOR / WINDOW / OPENING HEADER   | REF      | REFRIGERATOR                  | VAN   | VANITY                                    |
| CL     | CENTERLINE                       | HVAC  | HEATING, VENTING & AIR CONDITION | REIN     | REINFORCEMENT                 | W     | WIDE                                      |
| CMU    | CONCRETE MASONRY UNIT            | KNALL | KNEEWALL                         | RM       | ROOM                          | W     | WITH                                      |
| CO     | CLEAR OPENING                    | LVL   | LAMINATED VENEER LUMBER          | SEG      | SEGMENTED                     | #SP   | NUMBER OF STUD POCKETS @ WINDOW/DOOR JAMB |
| COL    | COLUMN                           | MANF  | MANUFACTURED                     | SHWR     | SHOWER                        |       |   |
| CONC   | CONCRETE                         | MAS   | MASONRY                          | SHL V(S) | SHELVES                       |       |   |
| CSMT   | CASEMENT                         | NIC   | NOT IN CONTRACT                  | SPEC(D)  | SPECIFICATION / SPECIFIED     |       |   |
| DBL    | DOUBLE                           | OC    | ON CENTER                        | SQ       | SQUARE                        |       |   |
| DIAM   | DIAMETER                         | OH    | OVERHANG                         | SST      | SIMPSON STRONG-TIE OR EQUAL   |       |   |
| DHSH   | DOUBLE HUNG / SINGLE HUNG WINDOW | OPNG  | OPENING                          | SUBFLR   | SUB-FLOOR                     |       |   |
| DN     | DOWN                             |       |                                  | 5YP      | SOUTHERN YELLOW PINE          |       |   |
| DP     | DEEP                             |       |                                  |          |                               |       |   |

NOTICE TO CONTRACTOR  
All construction must comply with current NC Building Codes and is subject to field inspection and verification.


APPROVED  
Contract building only review  
Homeowner responsible for  
full compliance with the code

12/03/2021

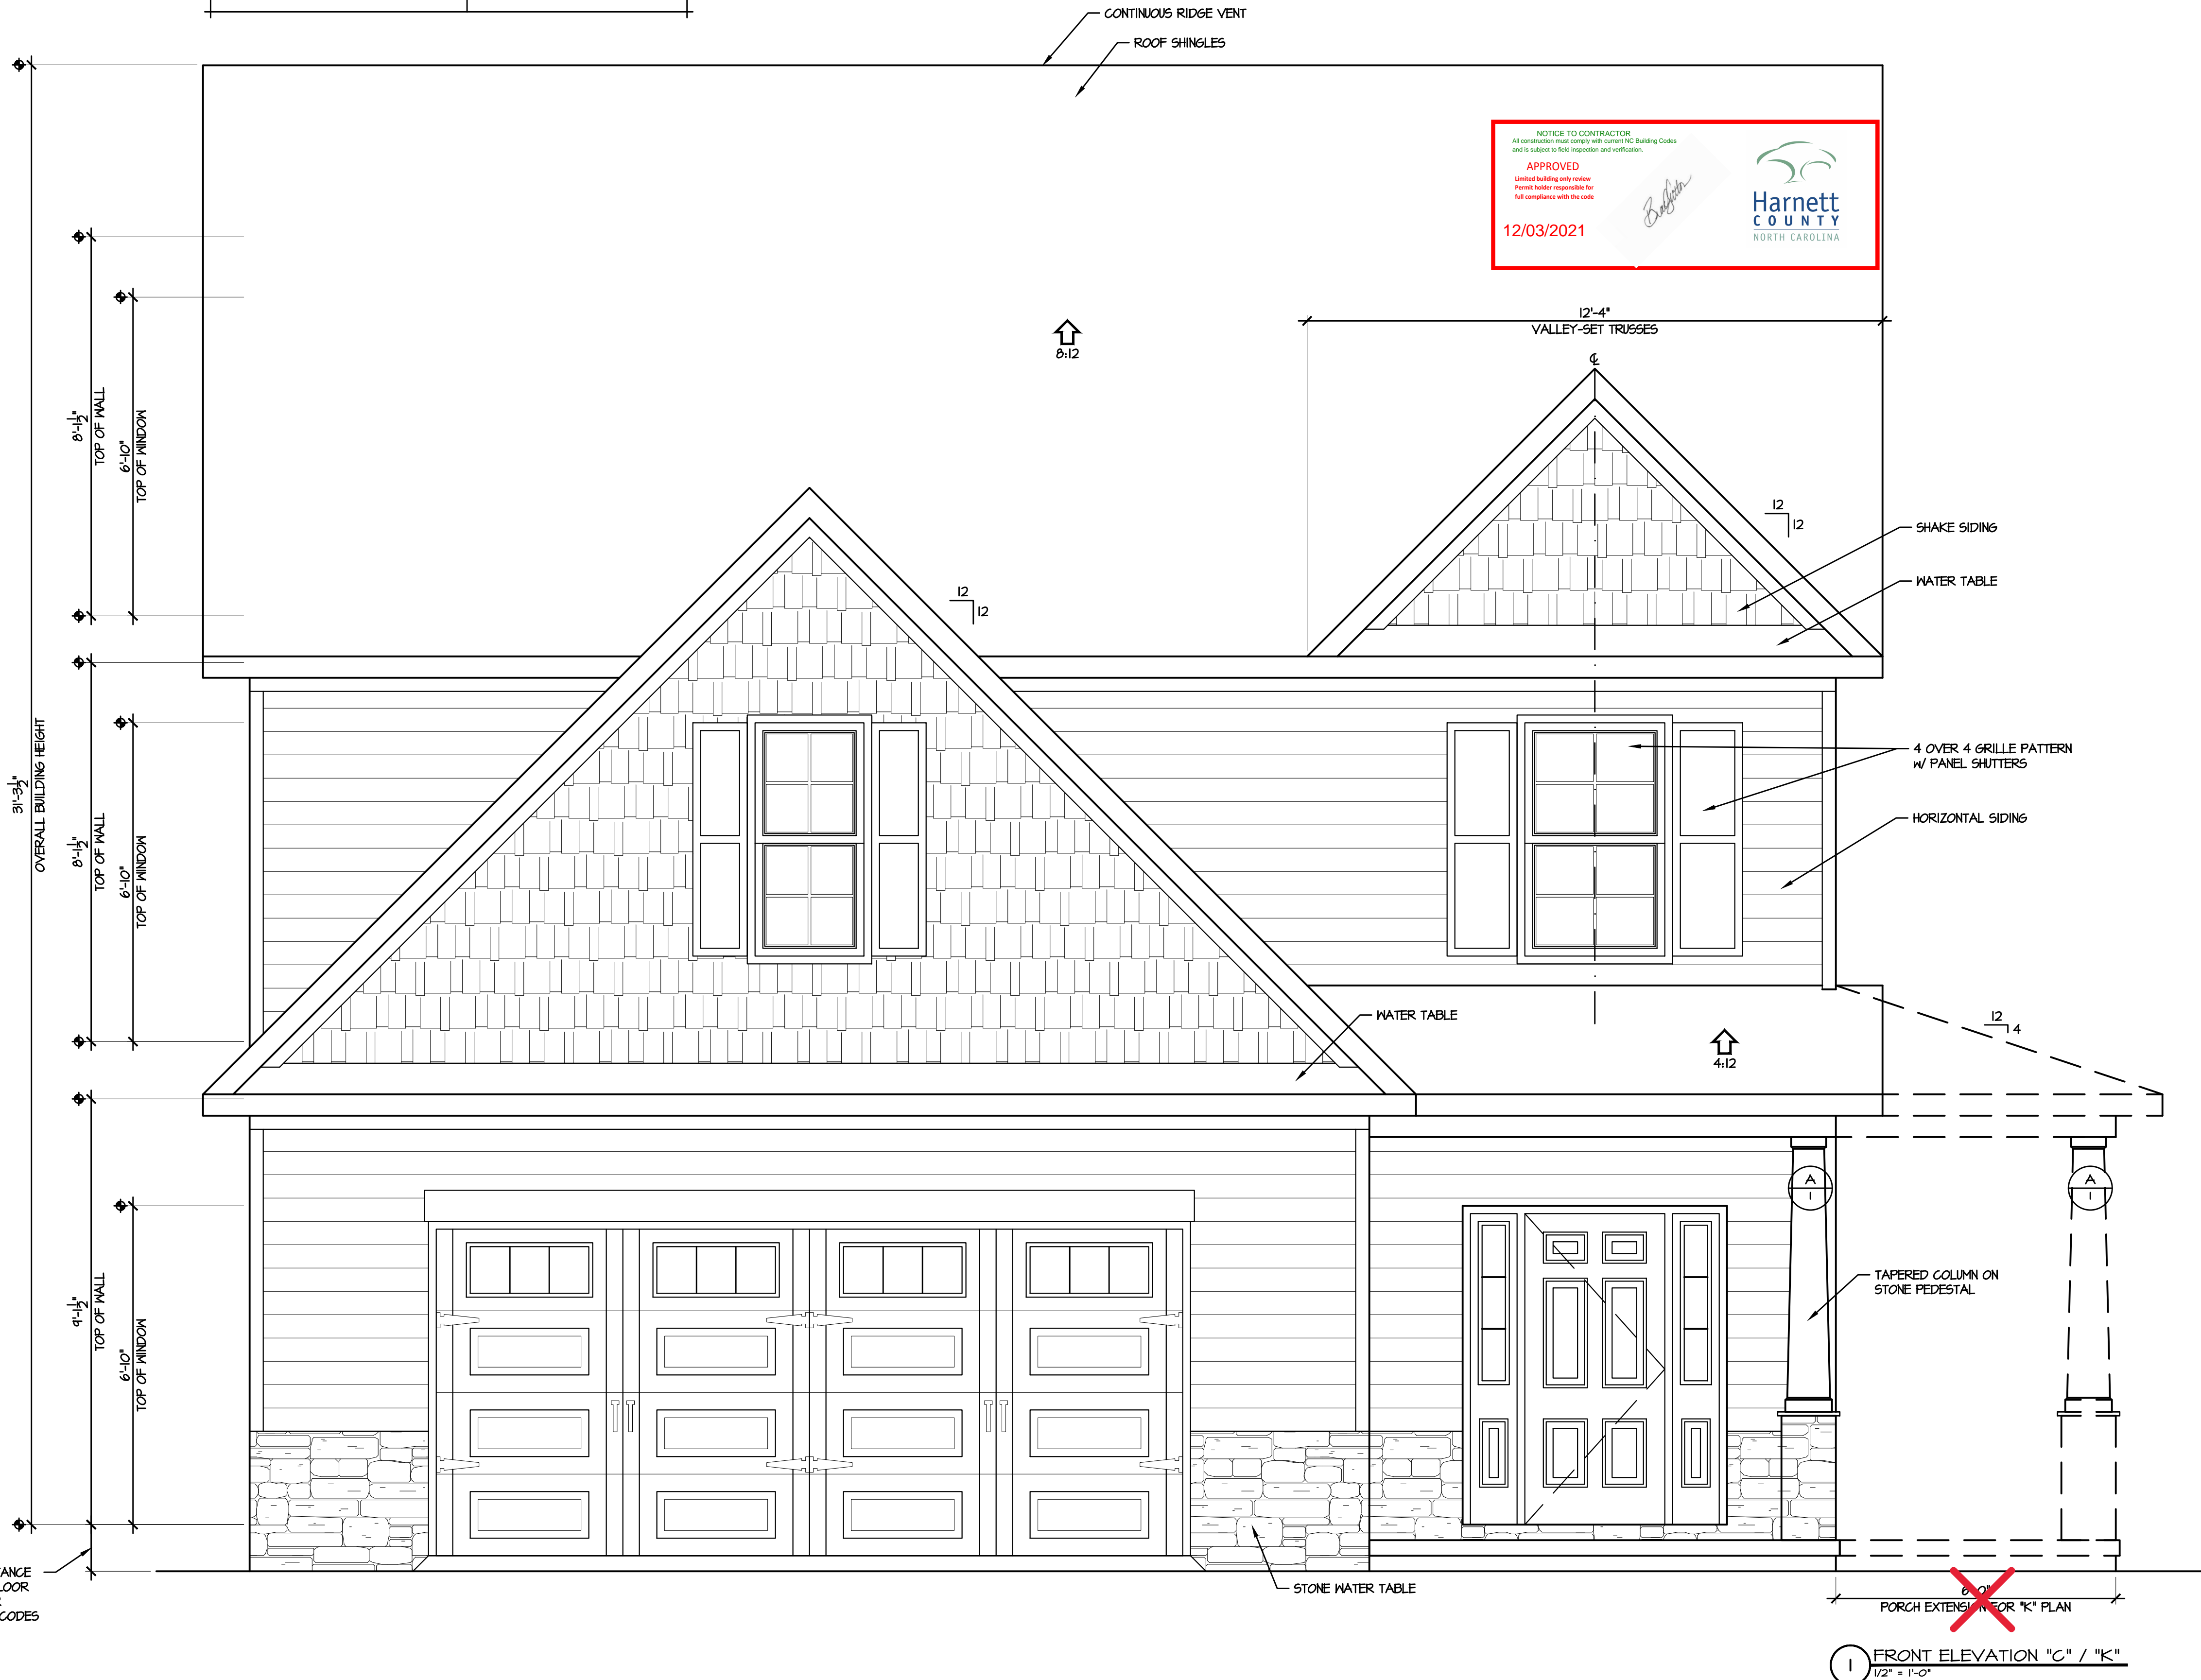



### SUMMARY

|   |   |
|---|---|
| <b>PROJECT INFO</b>   |   |
| NAME OF PROJECT:  | CL 2136                                       |
| PROJECT ADDRESS:  | TBD   |
| PROPOSED USE:   | RESIDENTIAL                                   |
| CONTACT:  | CAVINESS LAND, INC                            |
| <b>CODE COMPLIANCE:</b> 2018 NC STATE RESIDENTIAL BUILDING CODE |   |
| PROJECT COORDINATOR:  | TBD   |
| DESIGNER:   | TODD TUCKER, AIBD, CPBD 410-366-2636          |
| <b>BUILDING DESCRIPTION</b>                                     |   |
| FIRST FLOOR, HEATED:  | 844 SF  |
| SECOND FLOOR, HEATED:   | 1242 SF                                       |
| BONUS ROOM OPTION:  | 240 SF  |
| FRONT PORCH "C":  | 60 SF   |
| FRONT PORCH "K":  | 144 SF  |
| REAR PORCH:   | 120 SF  |
| GARAGE:   | 571 SF  |
| BUILDING HEIGHT:  | +/- 31'-4"                                    |
| NUMBER OF FLOOR:  | 2 (2.5 WITH BONUS ROOM)                       |
| <b>DESIGN LOADS</b>   |   |
| ROOF LOADS:   | 20 PSF LIVE, 20 PSF DEAD                      |
| ATTIC LOADS:  | 20 PSF LIVE, WHERE INDICATED (SEE TRUSS DWGS) |
| FIRST FLOOR:  | 40 PSF LIVE, 10 PSF DEAD                      |
| UPPER FLOORS:   | 30 PSF LIVE, 15 PSF DEAD                      |
| WIND LOAD:  | FOR NC: ASCE 7-05<br>FOR SC: ASCE 7-13        |

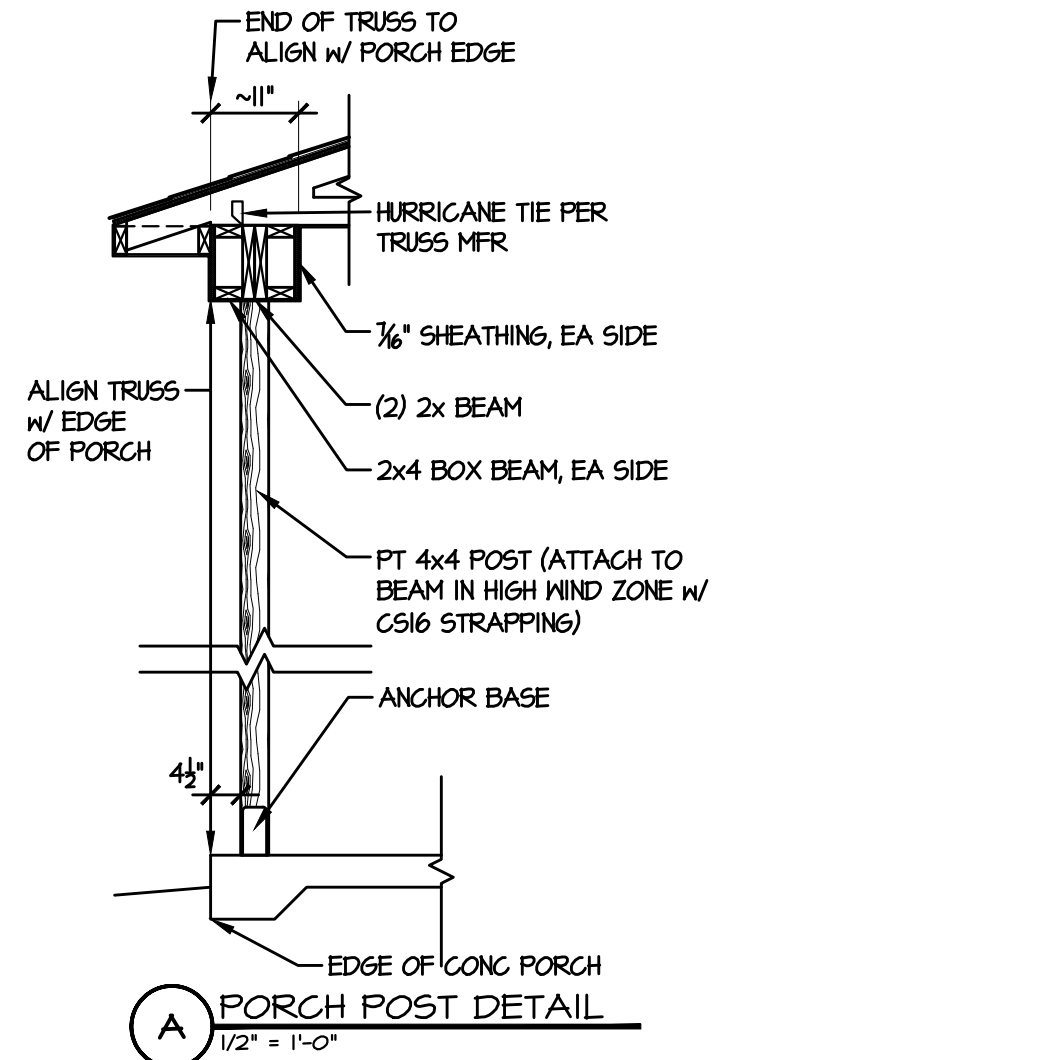

VERTICAL DISTANCE FROM FINISH FLOOR TO GRADE PER LOCAL ARB & CODES

1 FRONT ELEVATION "C" / "K"  
1/2" = 1'-0"

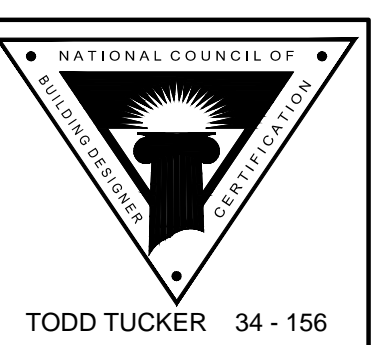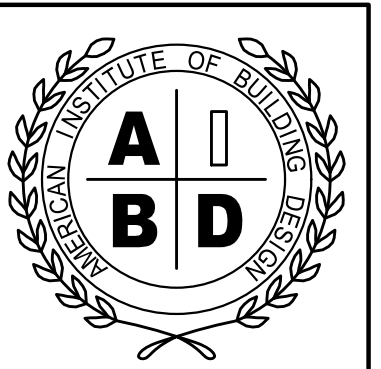

Caviness Land

FRONT ELEVATION

SHEET TITLE:

PLAN NO: CL 21376  
CL 2136

DATE: MAY 2018

REVISION DATE: XX-XX-17 XYZ

|  |  |
|--|--|
|  |  |
|  |  |
SHEET NO: 1





FIELD & REDLINE NOTES

| SPACE DATA            |         |
|-----------------------|---------|
| FIRST FLOOR, HEATED:  | 844 SF  |
| SECOND FLOOR, HEATED: | 1242 SF |
| BONUS ROOM OPTION:    | 240 SF  |
| FRONT PORCH "C":      | 60 SF   |
| FRONT PORCH "K":      | 144 SF  |
| REAR PORCH:           | 120 SF  |
| GARAGE:               | 571 SF  |

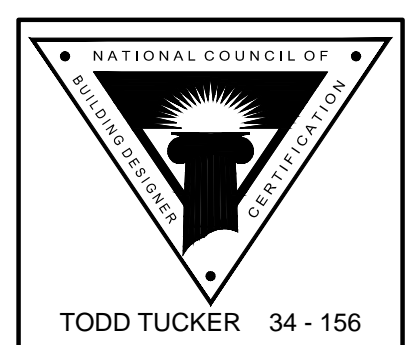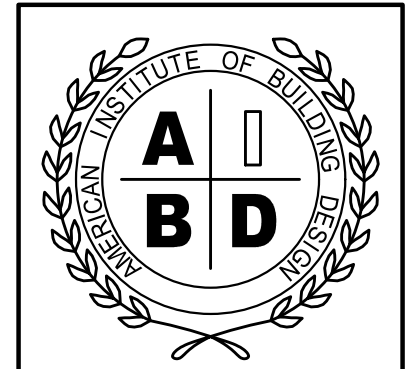

TODD TUCKER 34 - 156  
**FORTIFIED-WISE™ PROFESSIONAL**  
THE INFORMATION IN THESE CONSTRUCTION DOCUMENTS IS FOR THE EXCLUSIVE USE OF THE CLIENT IN CONNECTION WITH THE PROJECT DESCRIBED HEREIN. THE CONTRACTOR SHALL BE RESPONSIBLE FOR OBTAINING ALL NECESSARY PERMITS AND FOR VERIFYING THE ACCURACY OF ALL INFORMATION PROVIDED BY THE CLIENT. THE CONTRACTOR SHALL BE RESPONSIBLE FOR OBTAINING ALL NECESSARY PERMITS AND FOR VERIFYING THE ACCURACY OF ALL INFORMATION PROVIDED BY THE CLIENT. THE CONTRACTOR SHALL BE RESPONSIBLE FOR OBTAINING ALL NECESSARY PERMITS AND FOR VERIFYING THE ACCURACY OF ALL INFORMATION PROVIDED BY THE CLIENT.

**Caviness Land** PLANS  
 SHEET TITLE:


PLAN NO: **CL2376**  
 CL 2136

DATE: **MAY 2018**


REVISION DATE:  
 XX-XX-YY XYZ

|  |  |
|--|--|
|  |  |
|  |  |

SHEET NO:  
**4**

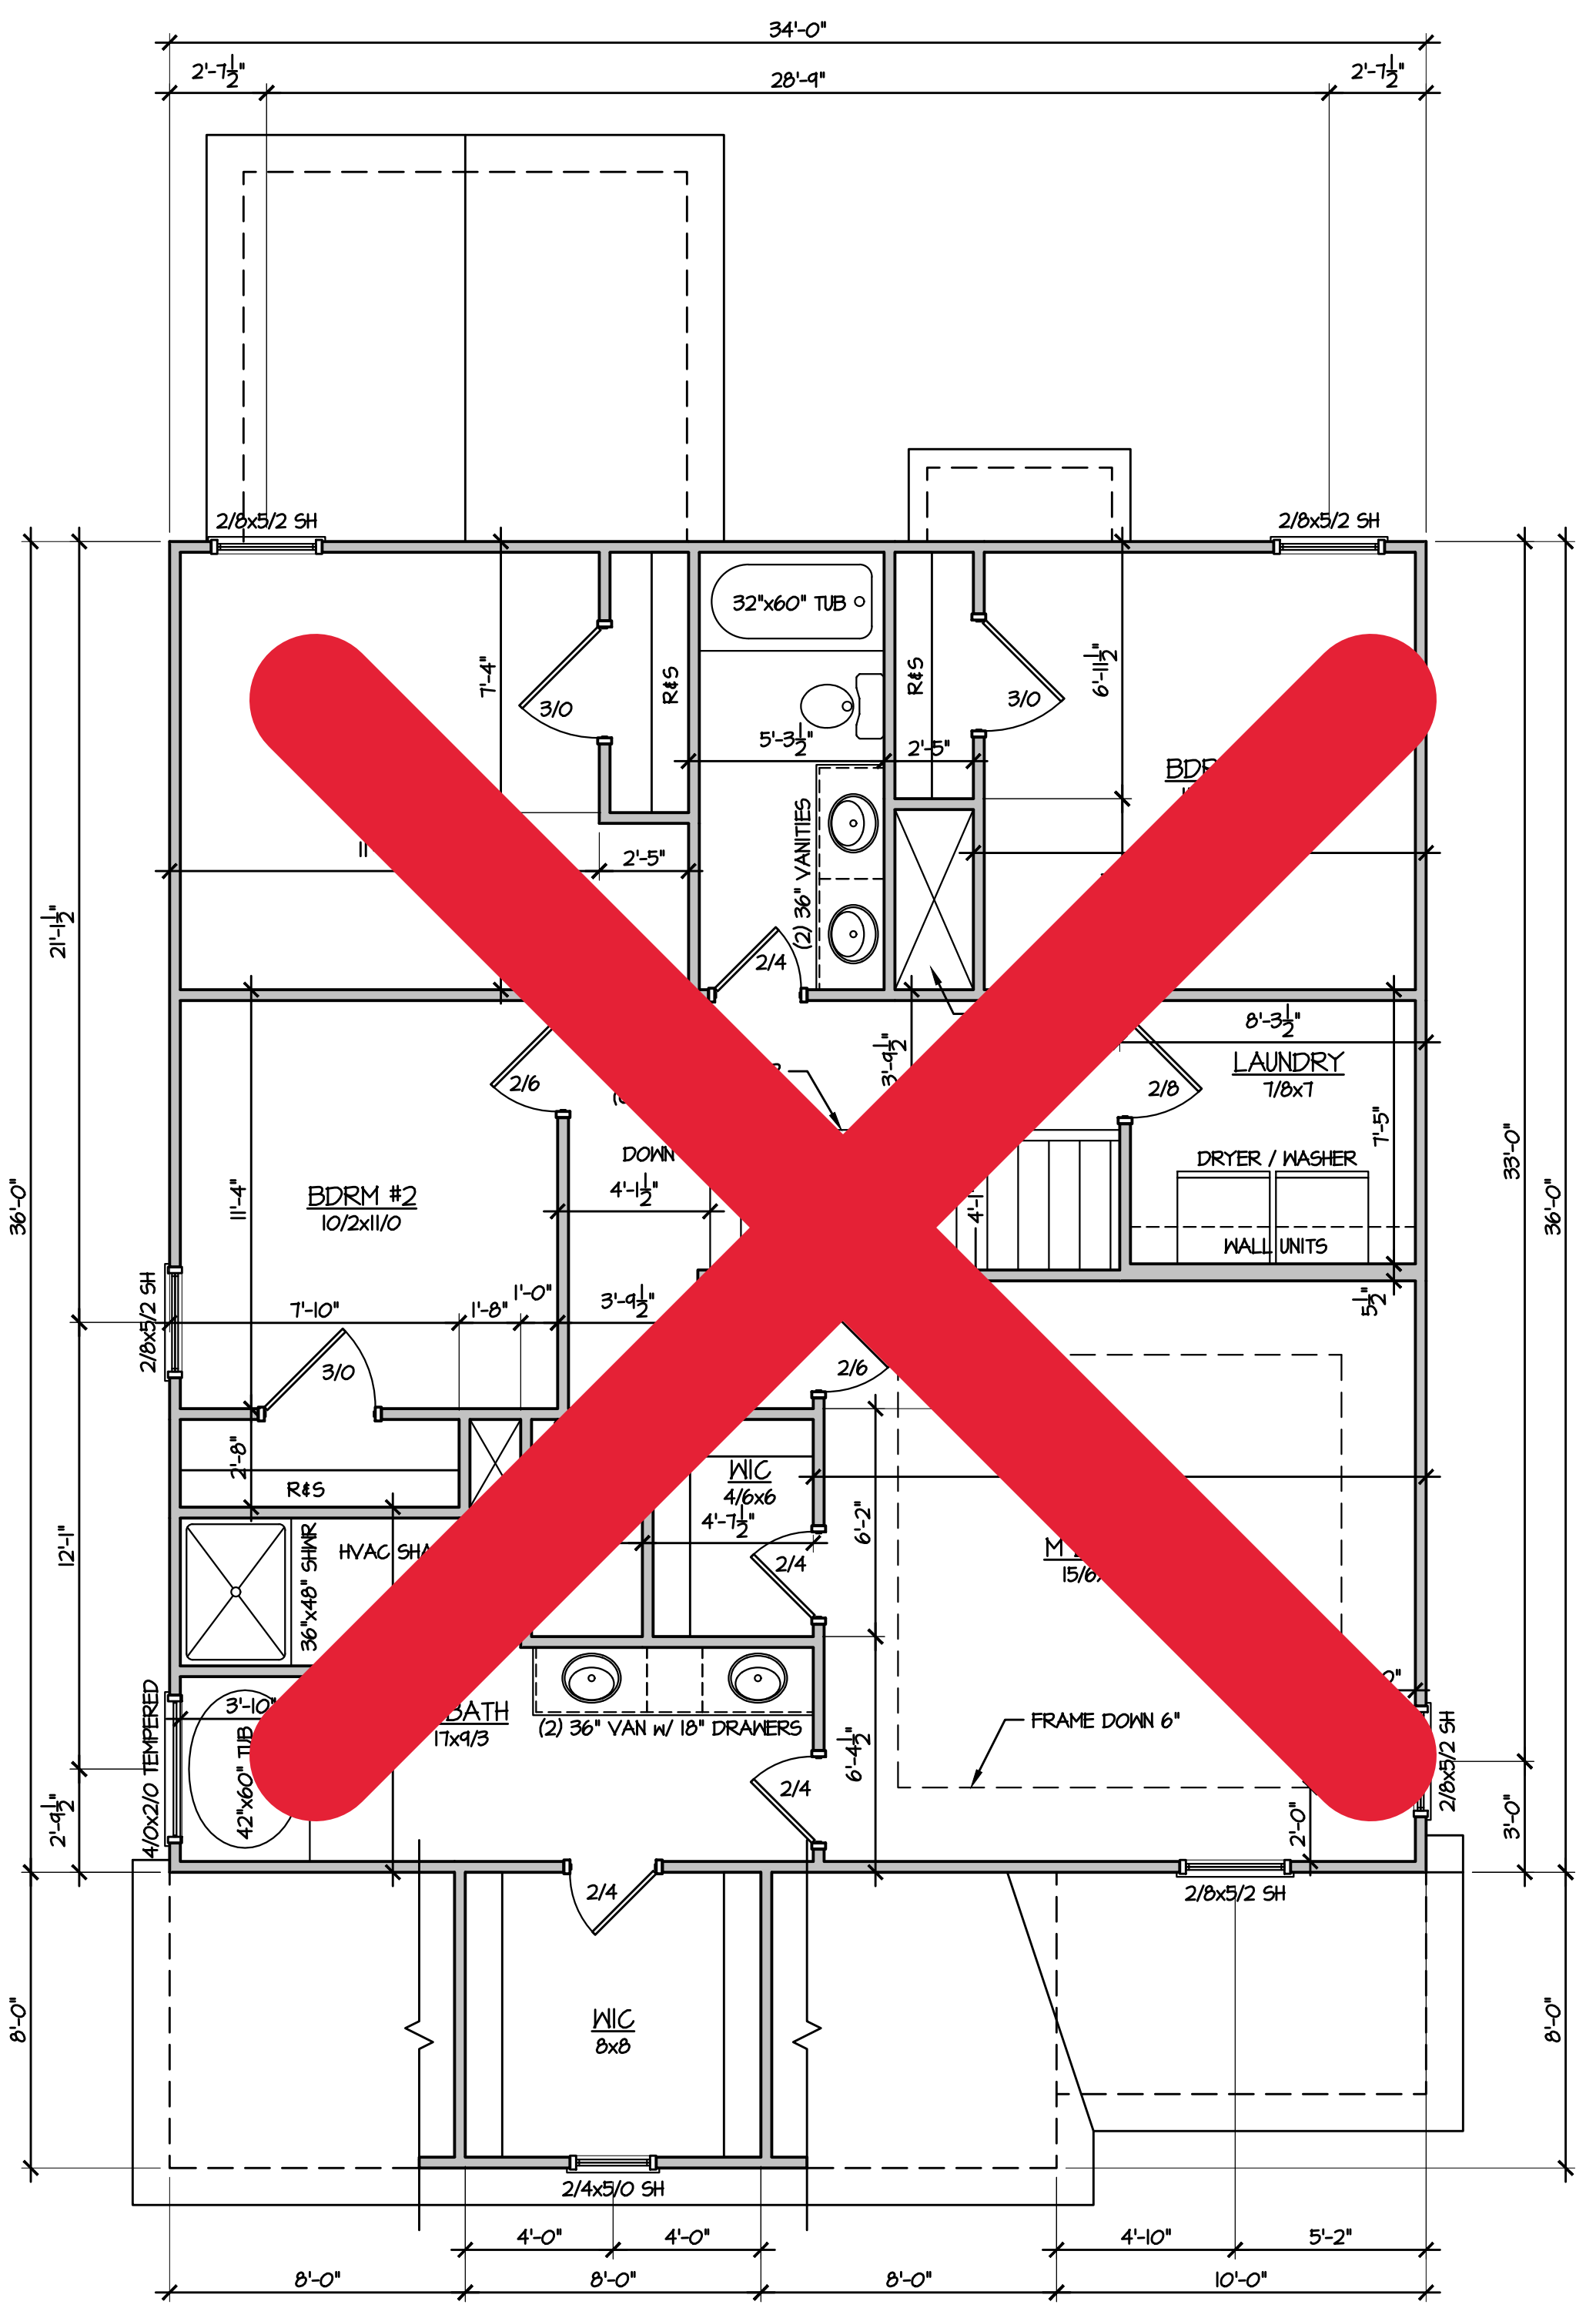


2 SECOND FLOOR PLAN  
 1/4" = 1'-0" (NO BONUS ROOM)

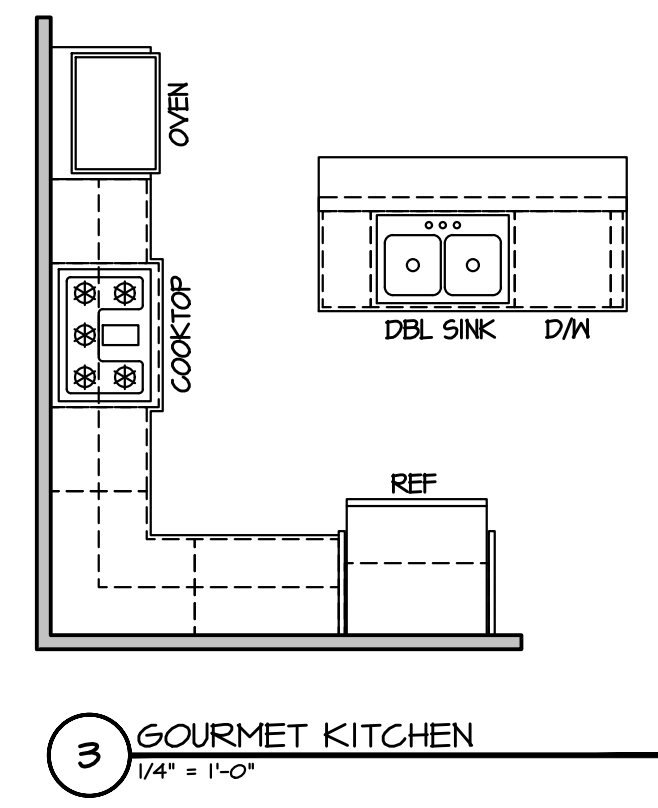

3 GOURMET KITCHEN  
 1/4" = 1'-0"

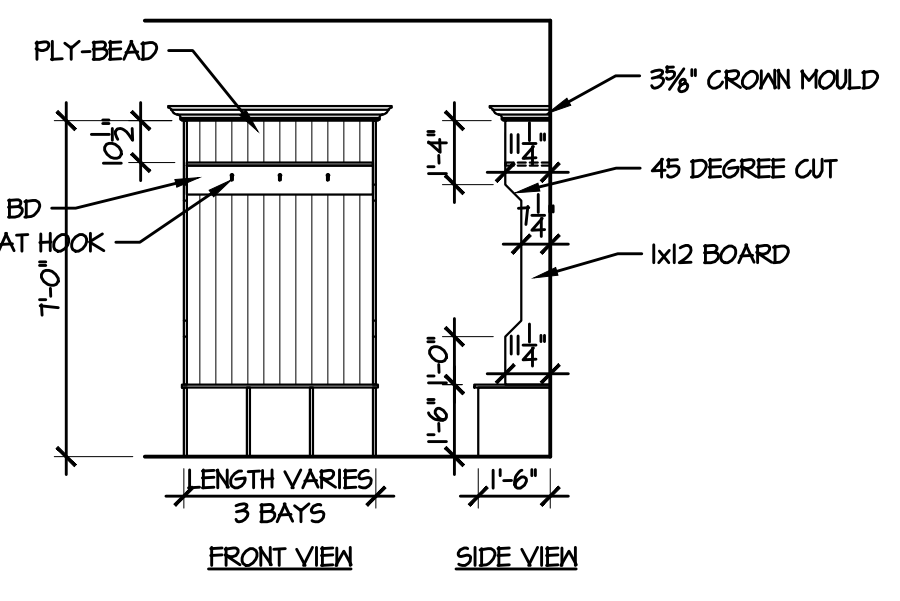

A COAT STATION  
 1/4" = 1'-0" DETAIL

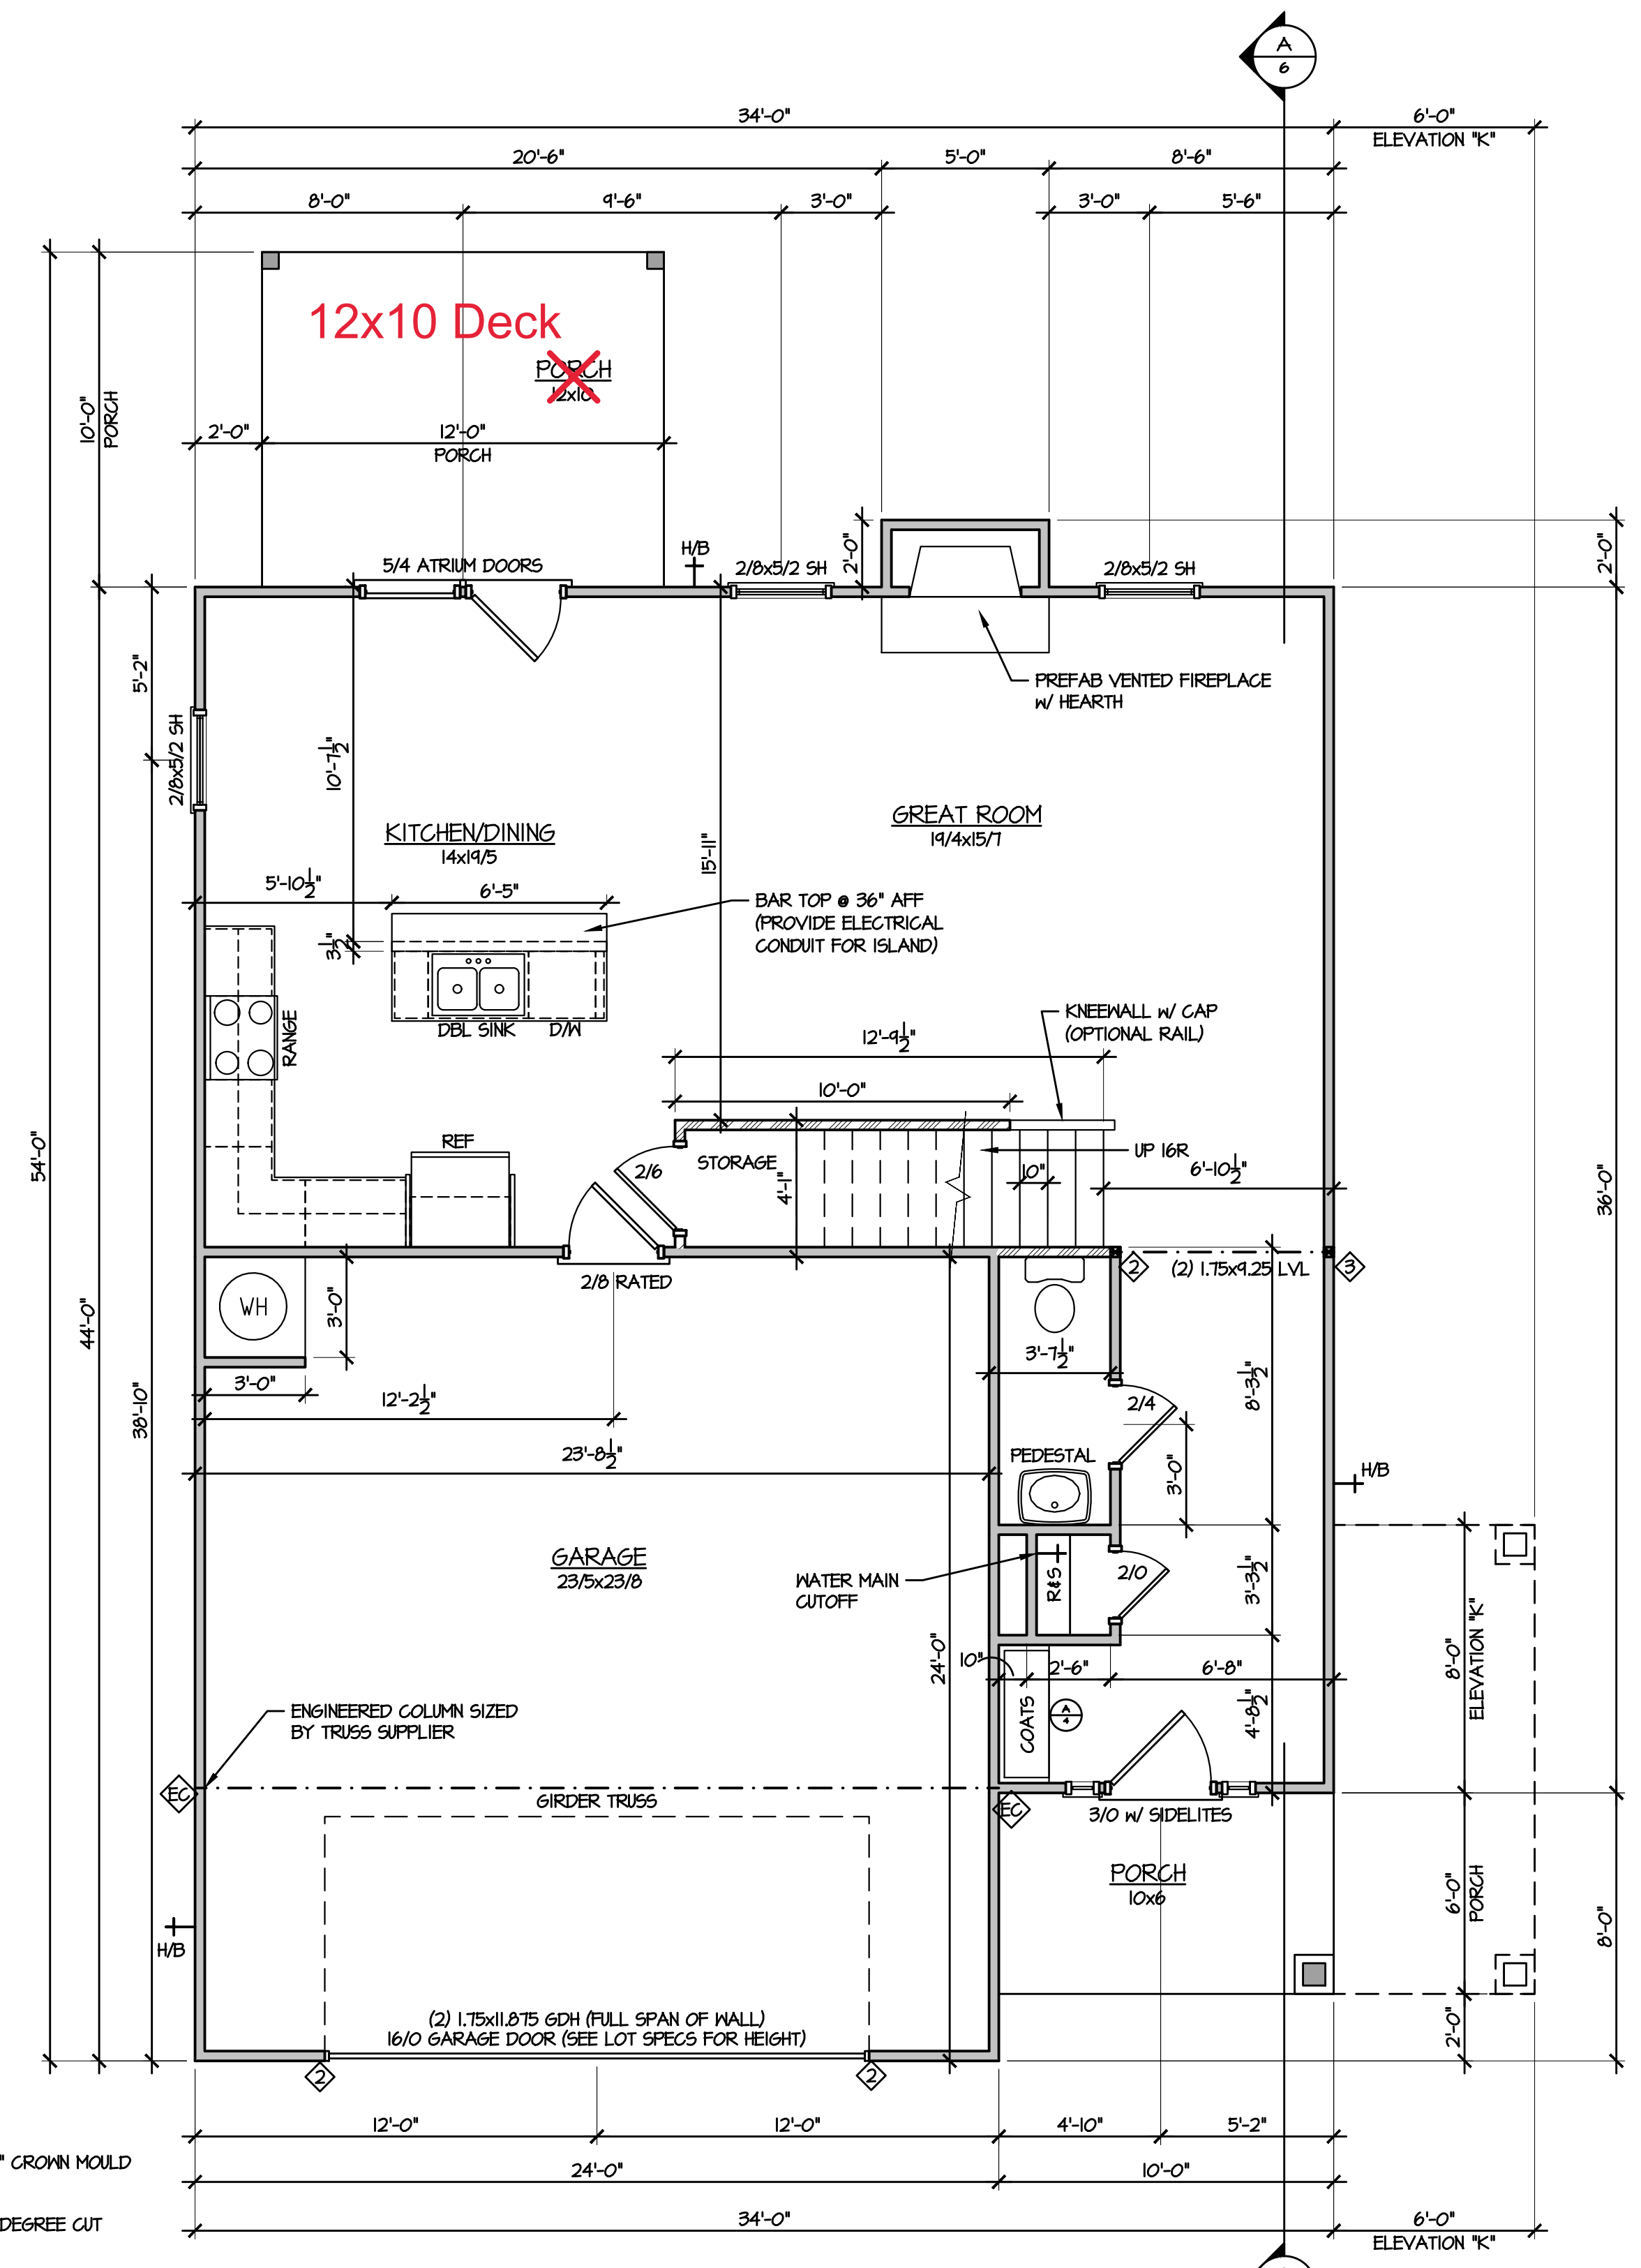


1 FIRST FLOOR PLAN  
 1/4" = 1'-0"










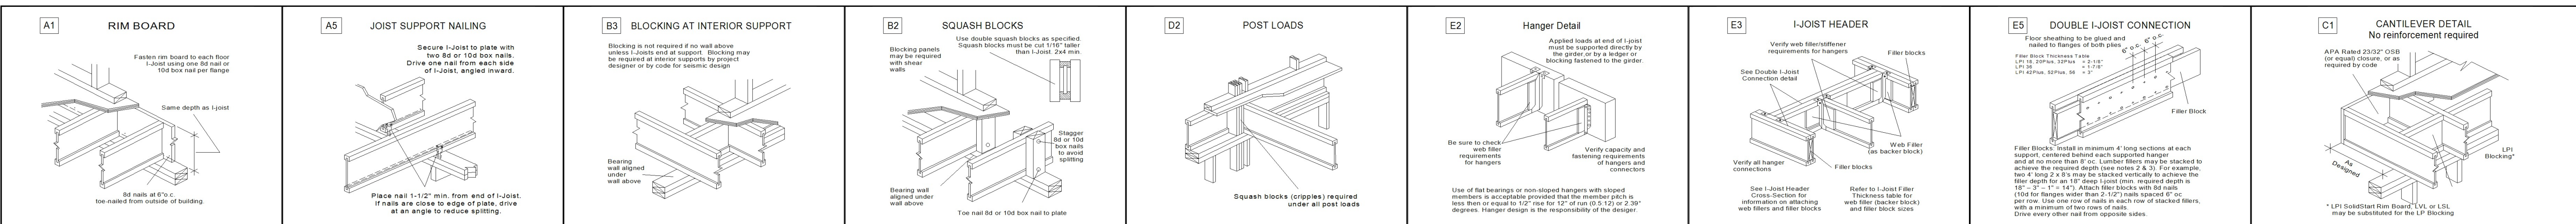


2160 Satellite Blvd., Suite 450  
Duluth, GA 30097  
888-613-5078

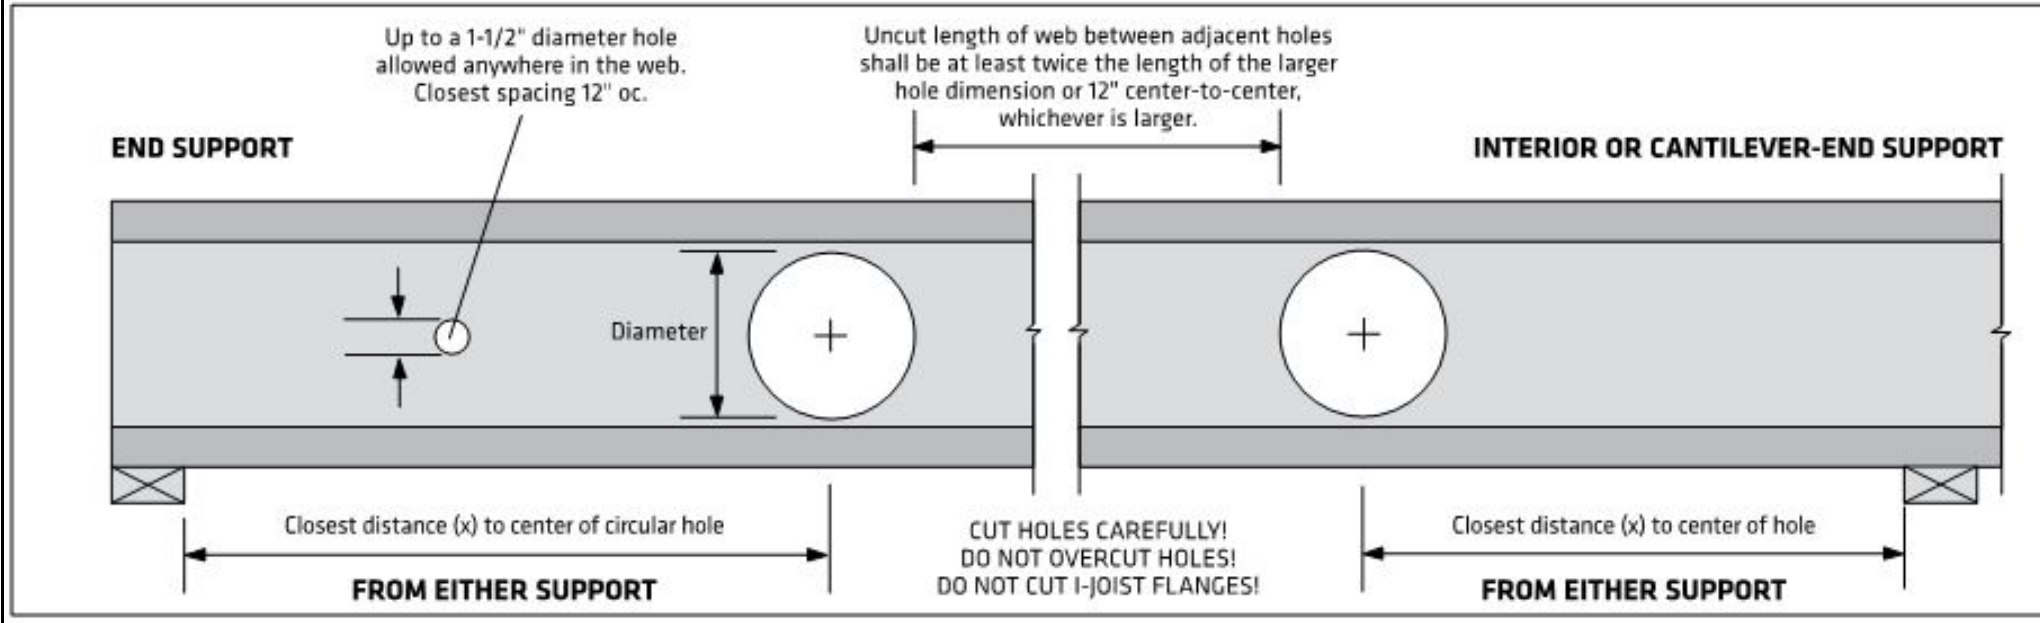

- TO USE:**
- Select the required series and depth.
  - Determine the support condition for the nearest bearing: end support or interior support (including cantilever-end supports).
  - Select the row corresponding to the required Clear Span. For spans between those listed, use the next largest value.
  - Select the column corresponding to the required hole diameter. For diameters between those listed, use the next largest value.
  - The intersection of the Clear Span row and Hole Diameter column gives the minimum distance from the inside face of bearing to the center of a circular hole.
  - Double check the distance to the other support, using the appropriate support condition.

| Depth | Clear Span (ft) | Distance from End Support |       |        |       |        |         | Distance from Interior or Cantilever-End Support |        |        |        |        |        |
|-------|-----------------|---------------------------|-------|--------|-------|--------|---------|--|--------|--------|--------|--------|--------|
|       |                 | Hole Diameter             |       |        |       |        |         | Hole Diameter                                    |        |        |        |        |        |
|       |                 | 2"                        | 4"    | 6"     | 8"    | 10"    | 12"     | 2"   | 4"     | 6"     | 8"     | 10"    | 12"    |
| 14"   | 14'             | 1'-0"                     | 1'-0" | 1'-0"  | 1'-0" | 1'-0"  | 2'-2"   | 1'-0"  | 1'-0"  | 1'-5"  | 2'-7"  | 3'-9"  | -      |
|       | 18'             | 1'-0"                     | 1'-0" | 1'-9"  | 3'-1" | 4'-6"  | -       | 1'-8"  | 2'-10" | 3'-11" | 5'-1"  | 6'-3"  | -      |
|       | 22'             | 1'-5"                     | 2'-9" | 4'-1"  | 5'-6" | 7'-0"  | -       | 4'-2"  | 5'-4"  | 6'-5"  | 7'-7"  | 8'-9"  | -      |
|       | 26'             | 3'-8"                     | 5'-0" | 6'-5"  | 8'-0" | 9'-8"  | -       | 6'-8"  | 7'-10" | 8'-11" | 10'-1" | 11'-4" | -      |
| 16"   | 18'             | 1'-0"                     | 1'-0" | 1'-4"  | 2'-5" | 3'-7"  | 4'-11"  | 1'-6"  | 2'-6"  | 3'-6"  | 4'-6"  | 5'-6"  | 6'-6"  |
|       | 22'             | 1'-4"                     | 2'-5" | 3'-6"  | 4'-9" | 6'-1"  | 7'-5"   | 4'-0"  | 5'-6"  | 6'-0"  | 7'-0"  | 8'-0"  | 9'-0"  |
|       | 26'             | 3'-6"                     | 4'-8" | 5'-11" | 7'-2" | 8'-7"  | 10'-1"  | 6'-6"  | 7'-6"  | 8'-6"  | 9'-6"  | 10'-6" | 11'-9" |
|       | 30'             | 5'-9"                     | 7'-0" | 8'-4"  | 9'-9" | 11'-3" | 12'-10" | 9'-0"  | 10'-0" | 11'-0" | 12'-0" | 13'-2" | 14'-8" |

- DESIGN ASSUMPTIONS:**
- The hole locations listed above are valid for floor joists supporting only uniform loads. The total uniform load shall not exceed 130 plf (e.g., 40 psf Live Load and 25 psf Dead Load spaced 24" oc).
  - Hole location is measured from the inside face of bearing to the center of a circular hole, from the closest support.
  - Clear Span has not been verified for these joists and is shown for informational purposes only! Verify that the joist selected will work for the span and loading conditions needed before checking hole location.
  - The maximum hole depth for circular holes is the I-joist Depth less 4", except the maximum hole depth is 6" for 9'-1/2" LPI joists, and 8" for 11'-7/8" LPI joists.
  - Holes cannot be located in the span where designated "X", without further analysis by a design professional.
- NOTES:**
- Holes may be placed anywhere within the depth of the joist. A minimum 1/4" clear distance is required between the hole and the flanges.
  - Round holes up to 1-1/2" diameter may be placed anywhere in the web.
  - Perforated "knockouts" may be neglected when locating web holes.
  - Holes larger than 1-1/2" are not permitted in cantilevers without special engineering.
  - Multiple holes shall have a clear separation along the length of the joist of at least twice the length of the larger adjacent hole, or a minimum of 12" center-to-center, whichever is greater.
  - Multiple holes may be spaced closer provided they fit within the boundary of an acceptable larger hole. Example: two 3" round holes aligned parallel to the joist length may be spaced 2" apart (clear distance) provided that a 3" high by 8" long rectangle or an 8" diameter round hole are acceptable for the joist depth at that location and completely encompass the holes.
  - For conditions not covered in this table, use LP's design software or contact your local LP® SolidStart® Engineered Wood Products distributor for more information.

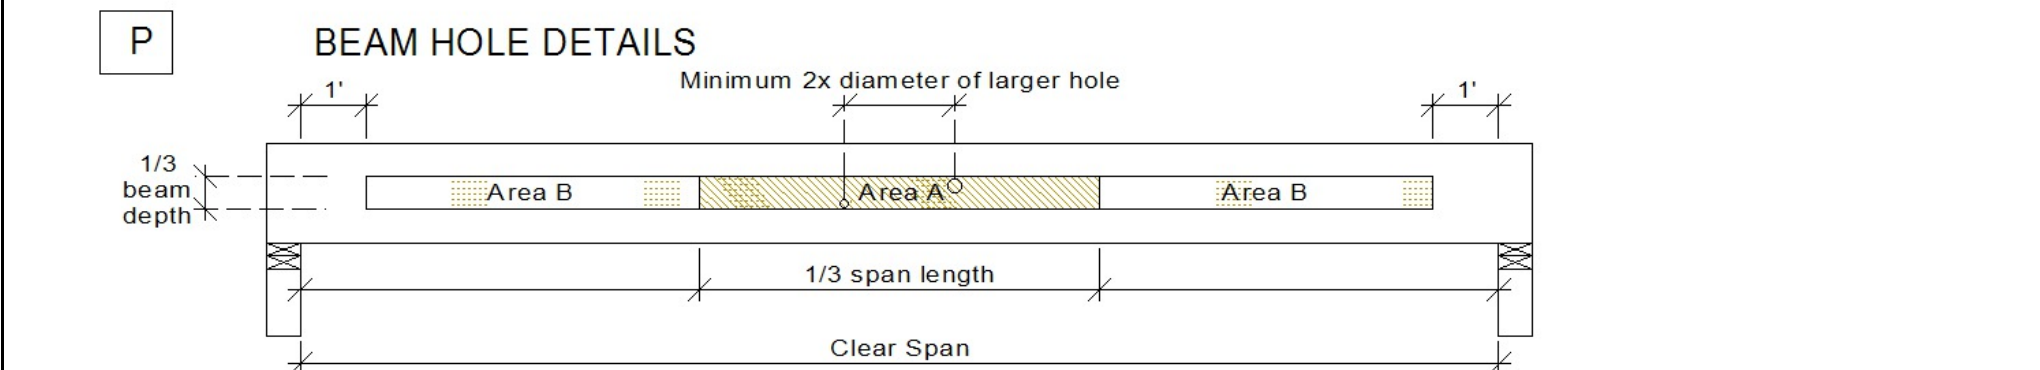


- NOTES:**
- These guidelines apply to uniformly loaded beams selected from the Quick Reference Tables or the Uniform Load Tables or designed with LP's design/specification software only. For all other applications, such as beams with concentrated loads, please contact your LP® SolidStart® Engineered Wood Products distributor for assistance.
  - Round holes can be drilled anywhere in "Area A" provided that: no more than four holes are cut, with the minimum spacing described in the diagram. The maximum hole size is 1-1/2" for depths up to 9'-1/4", and 2" for depths greater than 9'-1/4".
  - Rectangular holes are NOT allowed.
  - DO NOT drill holes in cantilevers without prior approval from the project designer.
  - Other hole sizes and configurations MAY be possible with further engineering analysis. For more information, contact your LP SolidStart Engineered Wood Products distributor.
  - Up to three 3/4" holes may be drilled in "Area B" to accommodate wiring and/or water lines. These holes shall be at least 12" apart. The holes shall be located in the middle third of the depth, or a minimum of 3" from the bottom and top of the beam. For beams shallower than 9'-1/4", locate holes at mid-depth.
  - Protect plumbing holes from moisture.

**Web Stiffeners, Rim & Blocking, Nailing**

| Series     | Depth   | Minimum Thickness | Maximum Height | Nail Size*  | Nail Qty |
|------------|---------|-------------------|----------------|-------------|----------|
| LPI 18     | 9-1/2"  | 23/32"            | 6-3/8"         | 8d (2-1/2") | 3        |
| LPI 20Plus | 10-7/8" | 23/32"            | 8-3/4"         | 8d (2-1/2") | 3        |
| LPI 23Plus | 14"     | 23/32"            | 10-7/8"        | 8d (2-1/2") | 3        |
|            | 16"     | 23/32"            | 12-7/8"        | 8d (2-1/2") | 3        |
| LPI 36     | 17-7/8" | 23/32"            | 8-21/32"       | 8d (2-1/2") | 4        |
|            | 14"     | 23/32"            | 10-7/8"        | 8d (2-1/2") | 5        |
|            | 16"     | 23/32"            | 12-7/8"        | 8d (2-1/2") | 6        |
| LPI 42Plus | 9-1/2"  | 1-1/2"            | 8-3/4"         | 10d (3")    | 3        |
| LPI 52Plus | 14"     | 1-1/2"            | 10-7/8"        | 10d (3")    | 3        |
|            | 16"     | 1-1/2"            | 12-7/8"        | 10d (3")    | 3        |
| LPI 56     | 17-7/8" | 1-1/2"            | 8-3/4"         | 10d (3")    | 4        |
|            | 14"     | 1-1/2"            | 10-7/8"        | 10d (3")    | 5        |
|            | 16"     | 1-1/2"            | 12-7/8"        | 10d (3")    | 6        |

\*Nails may be Box or Common.

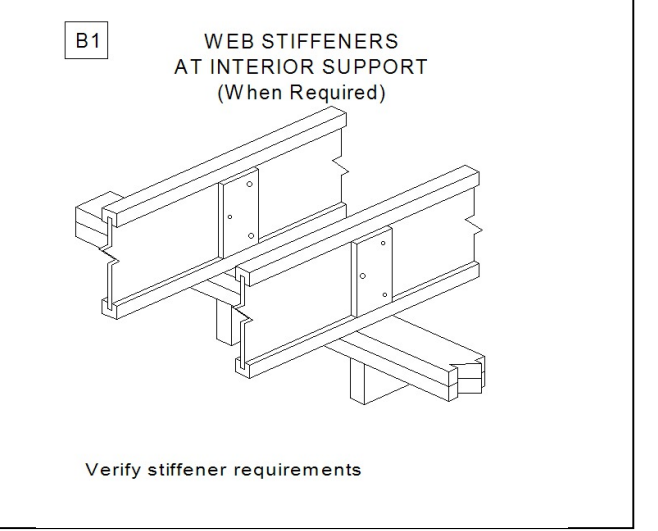

**2nd Flr I Joist (Flush)**

| Label | Description | Width | Depth | Qty | Plies | Pcs | Length |
|-------|-------------|-------|-------|-----|-------|-----|--------|
| J1    | LPI 20 Plus | 2.5   | 14    |     |       | 15  | 16-0-0 |
| J4    | LPI 32 Plus | 2.5   | 14    |     |       | 12  | 20-0-0 |
| J2    | LPI 32 Plus | 2.5   | 14    |     |       | 7   | 18-0-0 |

**LVL/LSL (Flush)**

| Label | Description        | Width | Depth | Qty | Plies | Pcs | Length |
|-------|--------------------|-------|-------|-----|-------|-----|--------|
| FB1   | LP-LVL 2900Fb-2.0E | 1.75  | 14    | 1   | 2     | 2   | 8-0-0  |
| FB3   | LP-LVL 2900Fb-2.0E | 1.75  | 14    |     |       | 1   | 6-0-0  |
| FB2   | LP-LVL 2900Fb-2.0E | 1.75  | 20    | 1   | 4     | 4   | 24-0-0 |

**LVL/LSL (Dropped)**

| Label | Description        | Width | Depth  | Qty | Plies | Pcs | Length |
|-------|--------------------|-------|--------|-----|-------|-----|--------|
| HD2   | LP-LVL 2900Fb-2.0E | 1.75  | 9.25   | 1   | 2     | 2   | 6-0-0  |
| HD1   | LP-LVL 2900Fb-2.0E | 1.75  | 11.875 | 1   | 2     | 2   | 24-0-0 |

**Beam By Others (Dropped)**

| Label | Description | Width | Depth | Qty | Plies | Pcs | Length |
|-------|-------------|-------|-------|-----|-------|-----|--------|
| DB5   | [2x10]      |       |       | 1   | 2     | 2   | 16-0-0 |

**Rim Board**


| Label | Description                 | Width | Depth | Qty | Plies | Pcs | Length |
|-------|-----------------------------|-------|-------|-----|-------|-----|--------|
| R1    | LP APA Rated OSB 1.125 X 14 | 1.125 | 14    |     |       | 12  | 12-0-0 |

**Blocking**

| Label | Description | Width | Depth | Qty | Plies | Pcs    | Length |
|-------|-------------|-------|-------|-----|-------|--------|--------|
| B1    | LPI 20 Plus | 2.5   | 14    |     |       | Varies | 15-0-0 |

**Hanger**

| Label | Pcs | Description      | Skew | Slope | fasteners | Supported Member |
|-------|-----|------------------|------|-------|-----------|------------------|
| H1    | 17  | IUS2.56/14 (Min) |      |       | 12 10d    | fasteners        |

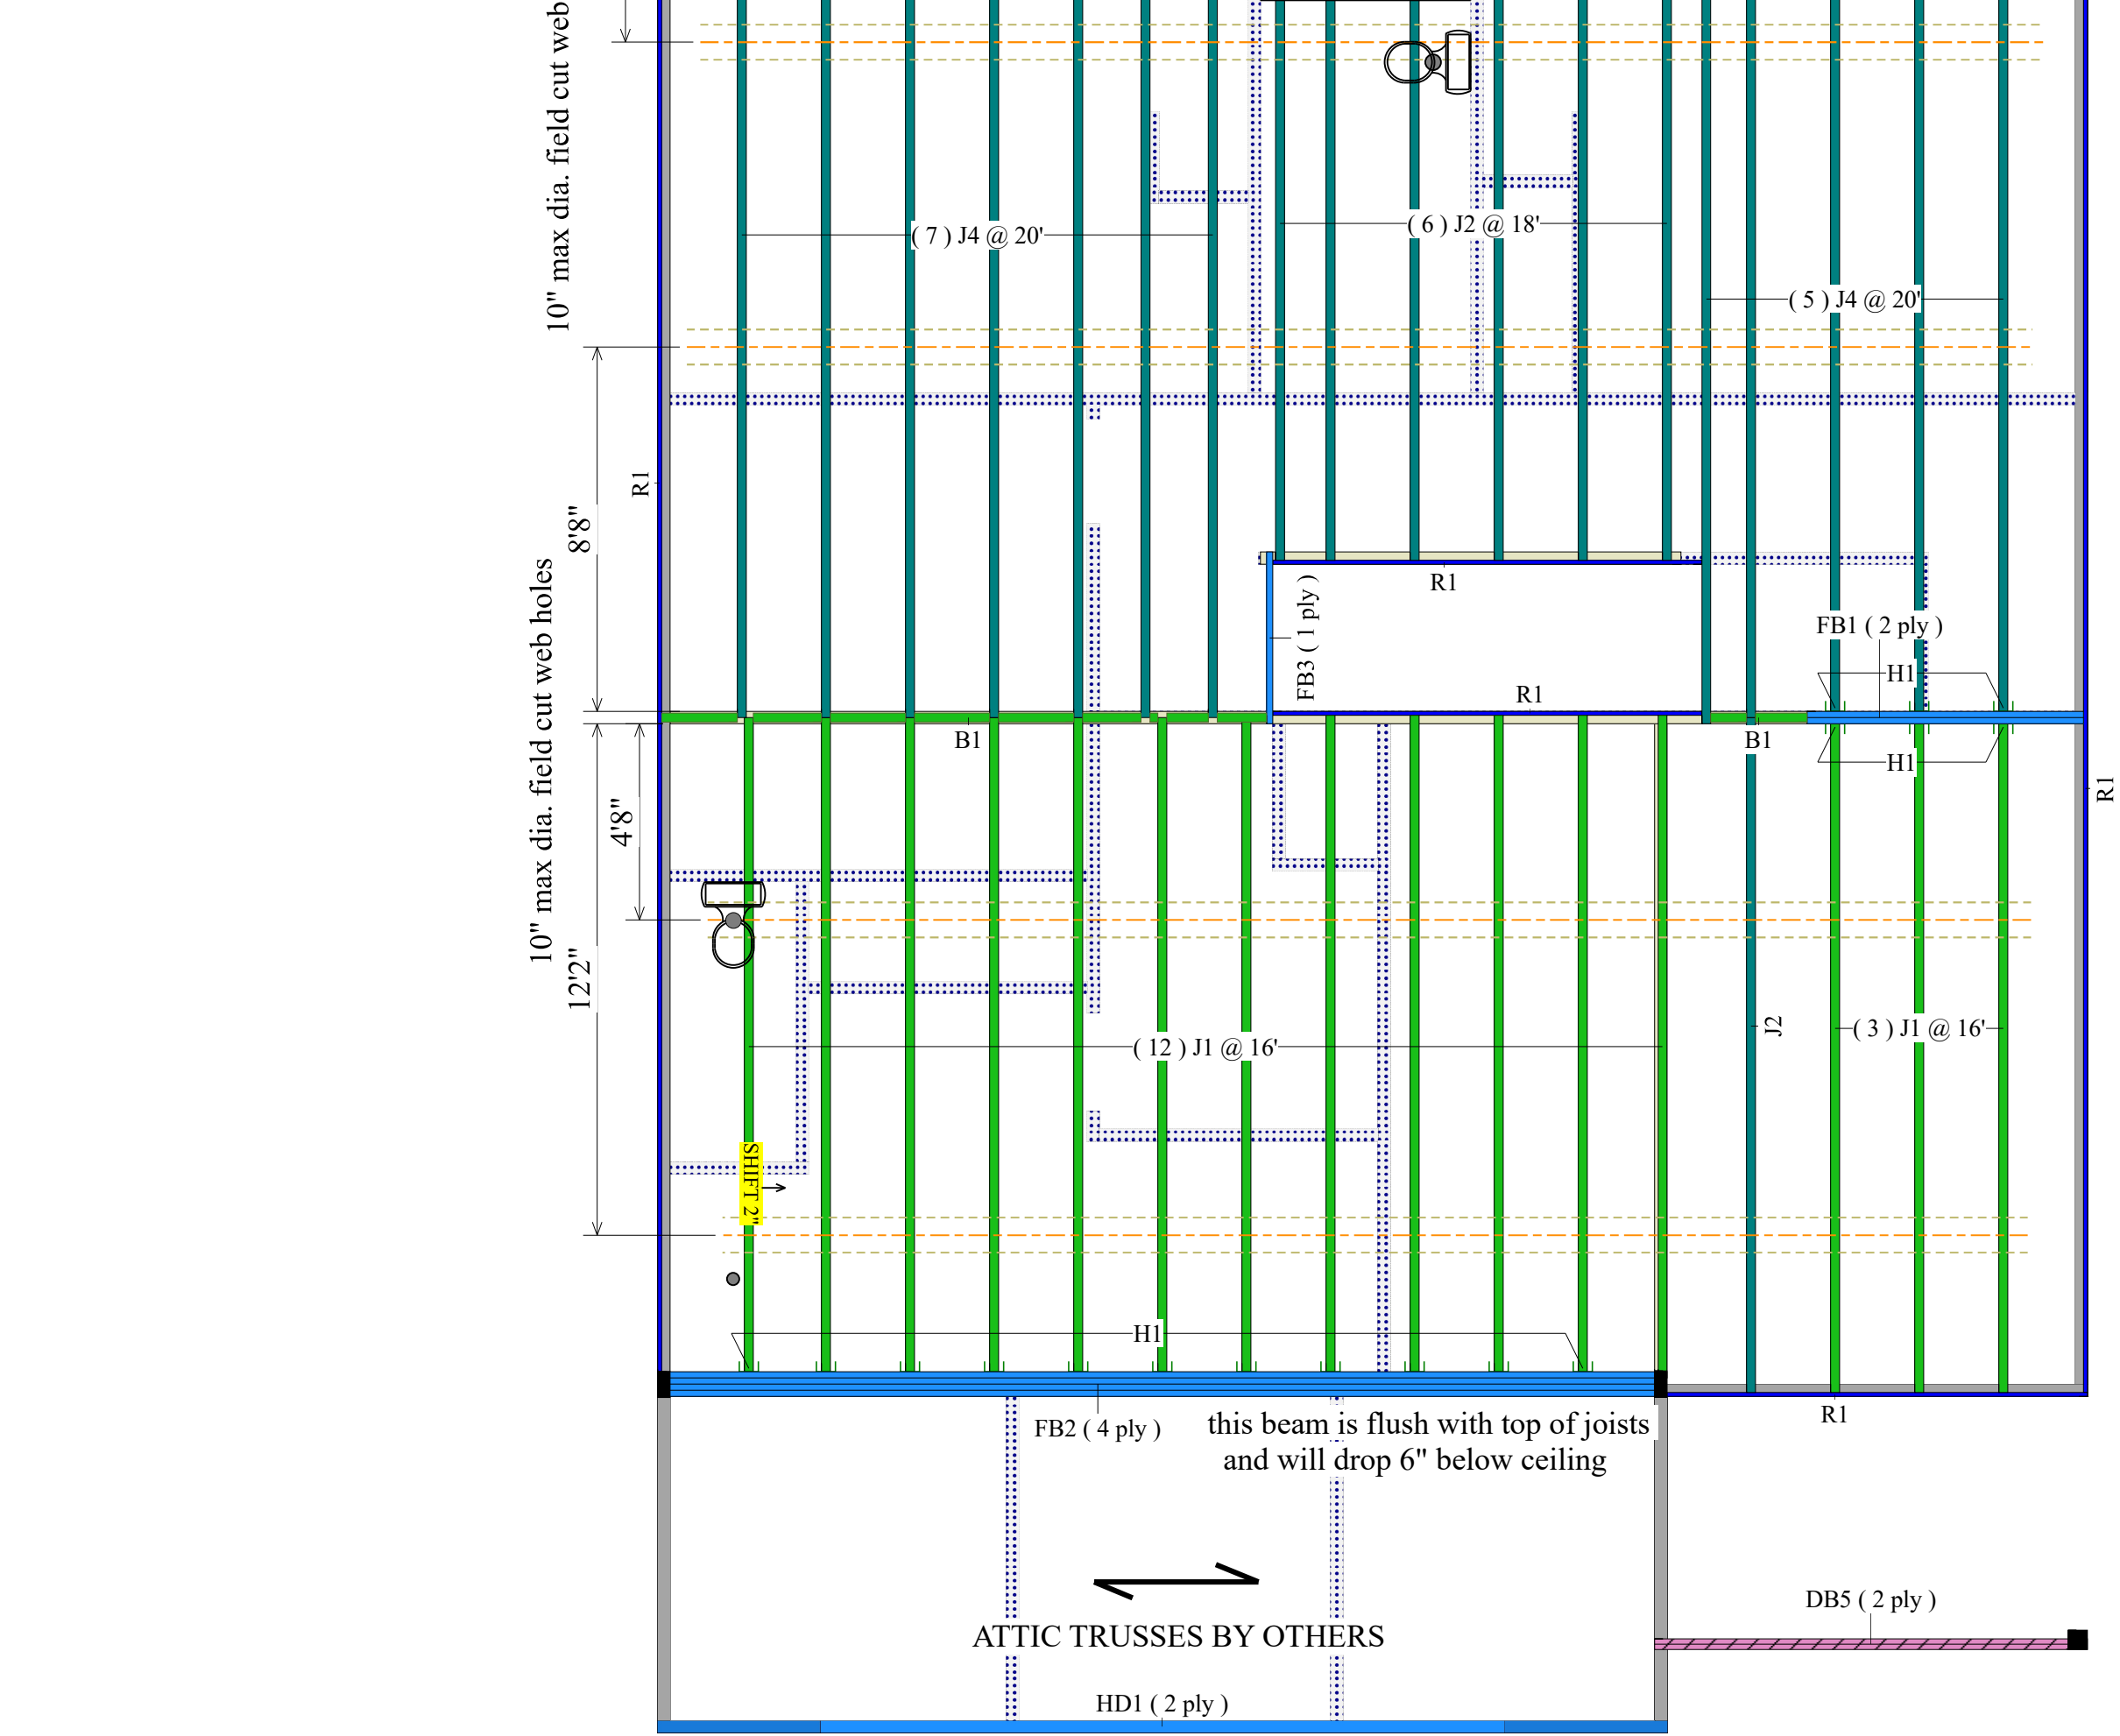

## 2ND FLOOR FRAMING

SCALE: 1/4" = 1'



**Dealer**  
84 Lumber-Fayetteville #2307

**Dealer Address**  
620 Belt Road  
Fayetteville, NC 28301  
(910) 867-9185

**Project**  
CL2376 - 265 Forest - GR

**Created**  
February 20, 2020

**Layout Name**  
CL2376 - 265 Forest - GR

**Description**  
Caviness Land  
CL2376 - 265 Forest - GR

**Designer**  
Kyle Miltzer

**Revised**  
November 23, 2021

**2nd Flr**

| Design Method | ASD (USA)    |
|---------------|--------------|
| Building Code | IBC/IRC 2015 |

**Floor**

| Loads |    |
|-------|----|
| Live  | 40 |
| Dead  | 10 |

**Deflection Joist**

| LL Span L/  | 480 |
|-------------|-----|
| TL Span L/  | 240 |
| LL Cant 2L/ | 240 |
| TL Cant 2L/ | 180 |

**Deflection Flush Girder**

| LL Span L/  | 360 |
|-------------|-----|
| TL Span L/  | 240 |
| LL Cant 2L/ | 240 |
| TL Cant 2L/ | 180 |

**Deflection Dropped Girder**

| LL Span L/  | 360 |
|-------------|-----|
| TL Span L/  | 240 |
| LL Cant 2L/ | 240 |
| TL Cant 2L/ | 180 |

**Deflection Header**

| LL Span L/  | 360 |
|-------------|-----|
| TL Span L/  | 240 |
| LL Cant 2L/ | 240 |
| TL Cant 2L/ | 180 |

**Decking**

| Decking | OSB                           |
|---------|-------------------------------|
|         | 23/32 APA Rated Sturd-I-Floor |

**Fastener**  
Nailed & Glued

**Legend**

- WS In Hanger Label Denotes Web Stiffener
- PS Point Load Support
- Load From Above
- Exterior Bearing Wall
- Interior Bearing Wall
- Non-Bearing Wall
- LP OSB/LSL Rim (Color Varies)
- LPI 18/20 I Joist
- LPI 32 I Joist
- LPI 42/56 I Joist
- Triforce/Open Joist (Color Varies)
- Bailey ProJoist TE Truss
- Dropped Beam (Color Varies By Product)
- Flush Beam (Color Varies By Product)
- Field Framed Pony Wall
- Column

**Important Notes**

**WARNING:** Failure to follow proper procedures for handling, storage and installation could result in unsatisfactory performance, unsafe structures and possible collapse.

These instructions are offered as a guide to good practice in the handling, storage and installation of LP® SolidStart® I-joists, LP SolidStart LVL & LP SolidStart LSL beams. They are, however, solely general recommendations and, in some instances, other or additional precautions may be desirable. In all cases, the procedures used should be as specified by the architect/engineer responsible for the entire building.

This is not intended as a manual for selecting products and assumes that components and details have been specified correctly.

Consult the LP SolidStart I-joist, LP SolidStart LVL & LP SolidStart LSL brochures or contact your LP SolidStart products distributor for assistance.

All rim joists, blocking, connections and temporary bracing must be installed before erectors are allowed on the structure.

No loads other than the weight of the erectors are to be imposed on the structure before it is permanently sheathed.

After sheathing, do not overload joists with construction materials exceeding design loads.

LP SolidStart Joists, LP SolidStart LVL & LP SolidStart LSL beams must be used under dry, covered and well ventilated interior conditions in which the equivalent moisture content in lumber will not exceed 16%.

**Handling & Storage**

Keep LP SolidStart I-joists, LP SolidStart LVL & LP SolidStart LSL beams dry.


- Unload products carefully by lifting. Support the bundles to reduce excessive bowing. Individual products should be handled in a manner which prevents physical damage during measuring, cutting, erection, etc. I-joists should be handled vertically and not flatwise.
- Keep stored in wrapped and strapped bundles, stacked no more than 10' high. Support and separate bundles with 2 x 4 (or larger) stickers spaced no more than 10' apart. Keep stickers in line vertically.
- Product must not be stored in contact with the ground, or have prolonged exposure to the weather.
- Use forklifts and cranes carefully to avoid damaging product.
- Do not use visually damaged product. Call your local LP SolidStart Engineered Wood Products distributor for assistance when damaged products are encountered.



THIS LAYOUT IS INTENDED FOR THE PURPOSE OF TRUSS LOCATION AND PLACEMENT ONLY. REFER TO THE BUILDING PLANS FOR ACTUAL BUILDING CONSTRUCTION.



DEDICATED TO QUALITY AND EXCELLENCE  
 200 EMMETT ROAD  
 DUNN, NORTH CAROLINA 28334  
 PHONE: 910-892-8400

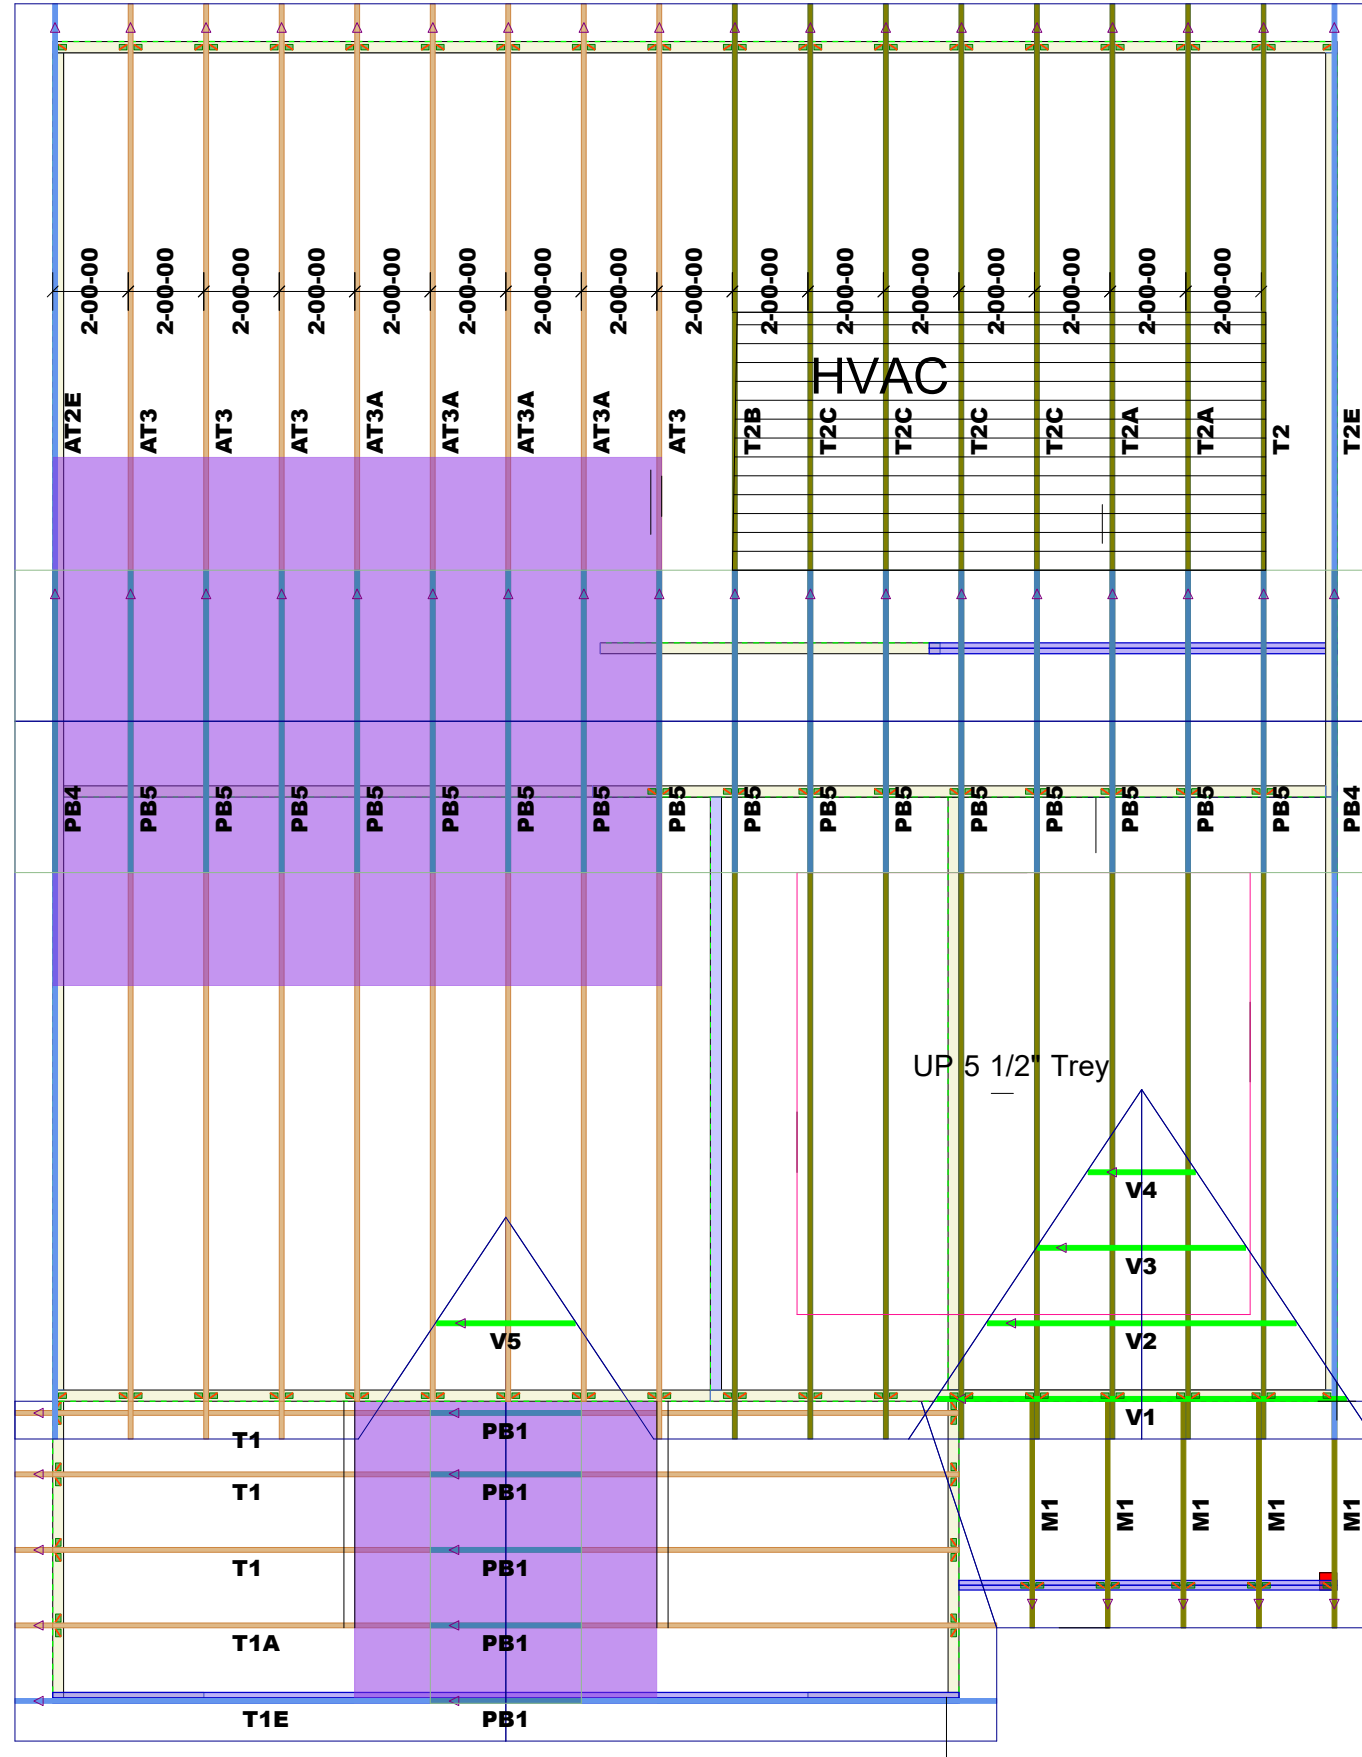

PROJECT: CL 2136 Tray Master CP

CUSTOMER: Caviness Land Development

MODEL: CL 2376 Walk Up CP No Back CP

QUOTE #: 1801412  
 PRINT DATE: 8/20/2019  
 DRAWN BY: Rodney Evans  
 SCALE: N.T.S

TOP LIVE LOAD: 20.0 lb/ft<sup>2</sup>

TOP DEAD LOAD: 10.0 lb/ft<sup>2</sup>

BOTTOM DEAD LOAD: 10.0 lb/ft<sup>2</sup>

WIND SPEED: 130 mph

GENERAL NOTES:

- DO NOT CUT OR MODIFY TRUSSES
- TRUSSES ARE SPACED 24" ON CENTER UNLESS OTHERWISE NOTED
- REFER TO THE INDIVIDUAL TRUSS DESIGN DRAWINGS FOR THE LOCATION OF LATERAL BRACING AND MULTI-PLY CONNECTION REQUIREMENTS.
- PER ANSI TPI 1-2002 THE TRUSS ENGINEER IS RESPONSIBLE FOR TRUSS TO TRUSS CONNECTIONS AND TRUSS PLY TO PLY CONNECTIONS. THIS TRUSS PLAN RECOMMENDS TRUSS TO BEARING CONNECTIONS AND TRUSS TO BEAM CONNECTIONS WHICH SHALL BE REVIEWED BY THE BUILDING DESIGNER. IT IS THE RESPONSIBILITY OF THE BUILDING DESIGNER TO RESOLVE ALL ROOF FORCES ADEQUATELY TO THE FOUNDATION.

|                               |                          |
|-------------------------------|--------------------------|
| 1st Level Roof Area<br>414.35 | 2nd Level Roof Area<br>0 |
|-------------------------------|--------------------------|