
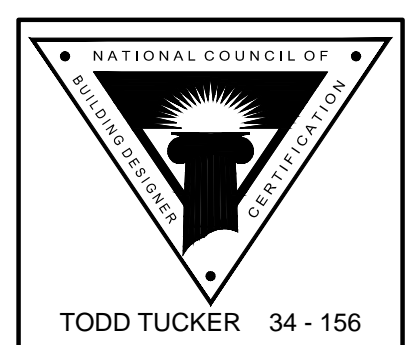


FIELD & REDLINE NOTES

SPACE DATA	
FIRST FLOOR, HEATED:	844 SF
SECOND FLOOR, HEATED:	1242 SF
BONUS ROOM OPTION:	240 SF
FRONT PORCH "C":	60 SF
FRONT PORCH "K":	144 SF
REAR PORCH:	120 SF
GARAGE:	571 SF

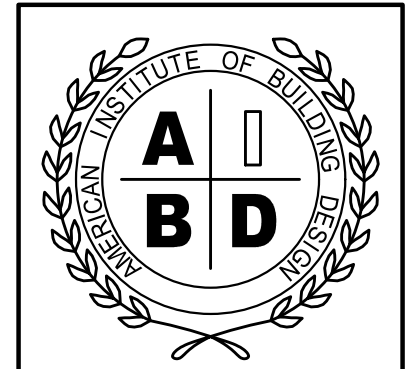

TODD TUCKER 34-156
FORTIFIED-WISE™ PROFESSIONAL
THE INFORMATION IN THESE CONSTRUCTION DOCUMENTS IS FOR THE EXCLUSIVE USE OF THE CLIENT IN CONNECTION WITH THE PROJECT DESCRIBED HEREIN. THE OWNER HAS OBTAINED THE SERVICES OF THE ARCHITECT AND HAS AGREED TO COMPENSATE THE ARCHITECT ACCORDINGLY. THE ARCHITECT HAS CONDUCTED VISUAL GENERAL VERIFICATION OF THE EXISTING CONDITIONS AND THE LOCAL ZONING CODES. IF THE CLIENT DESIRES TO MAKE CHANGES TO THE PROJECT OR TO OBTAIN PERMITS FROM ANY AGENCIES, THE CLIENT SHALL BE RESPONSIBLE FOR OBTAINING ALL NECESSARY PERMITS AND FOR OBTAINING THE SERVICES OF ALL NECESSARY ENGINEERS AND OTHER PROFESSIONALS AS REQUIRED BY THE LOCAL ZONING CODES.

Caviness Land PLANS
 SHEET TITLE:


PLAN NO: **CL2376**
 CL 2136

DATE: **MAY 2018**


REVISION DATE:
 XX-XX-YY XYZ

SHEET NO:


4

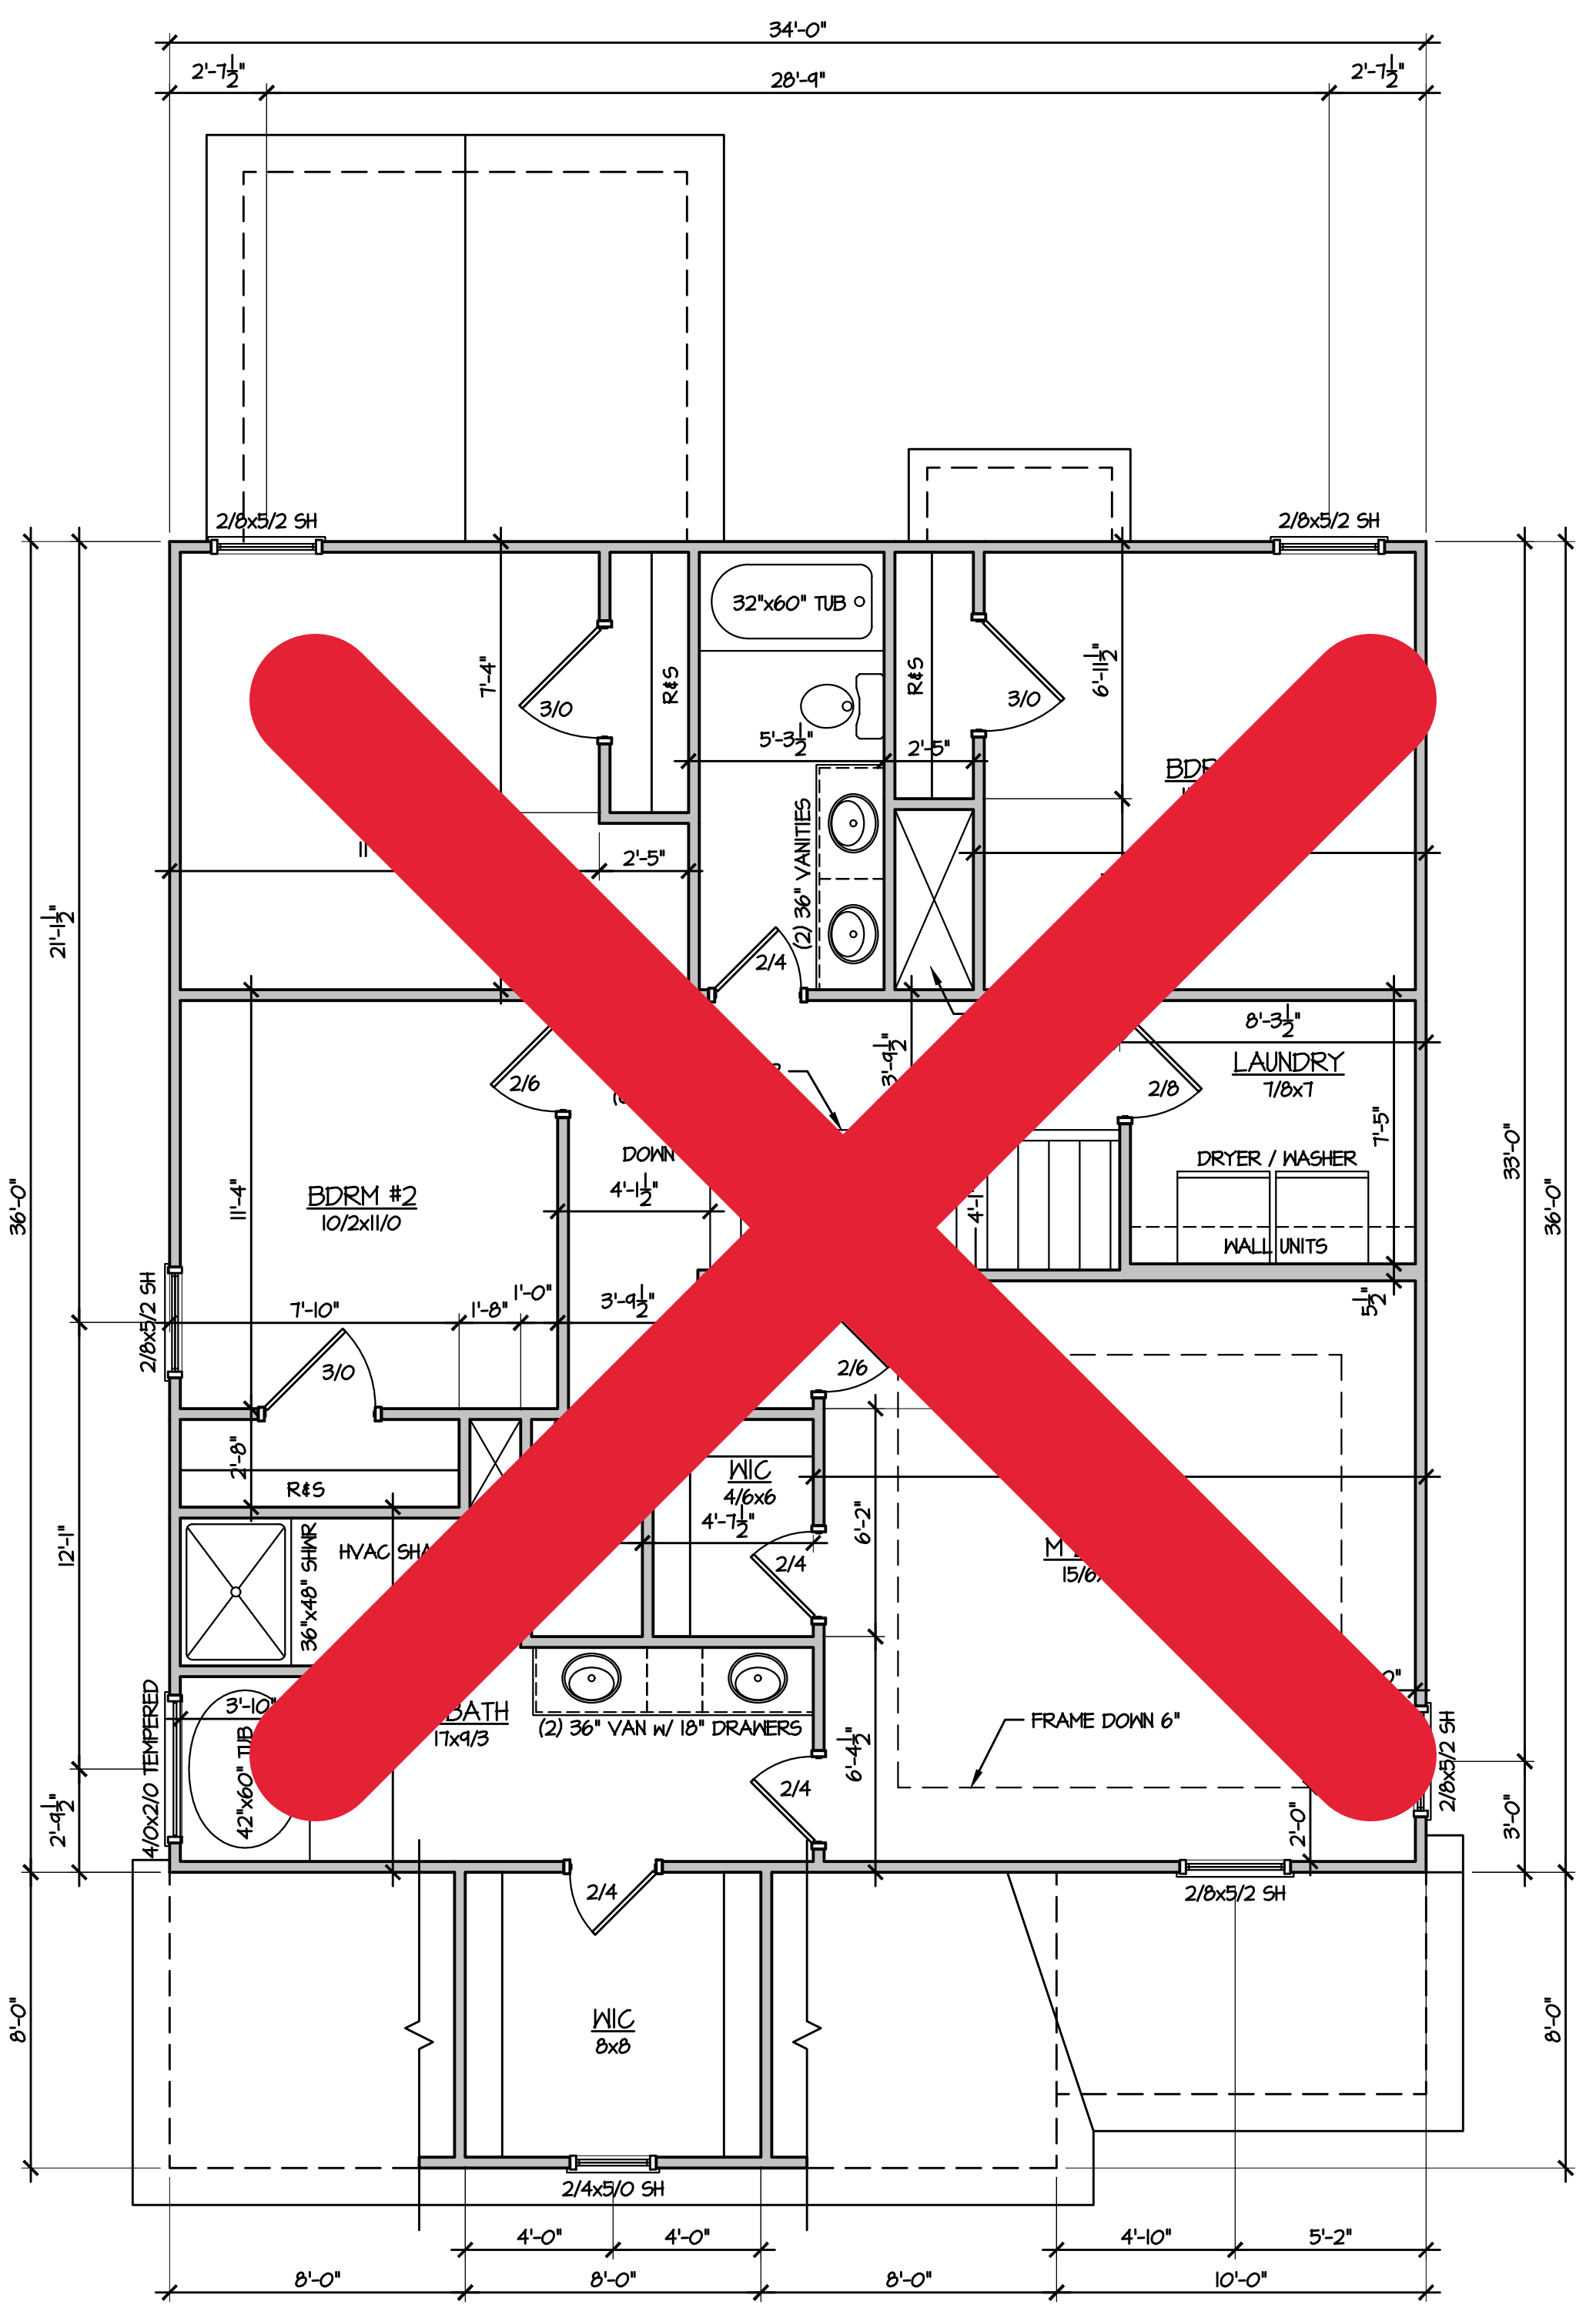


2 SECOND FLOOR PLAN
 1/4" = 1'-0" (NO BONUS ROOM)

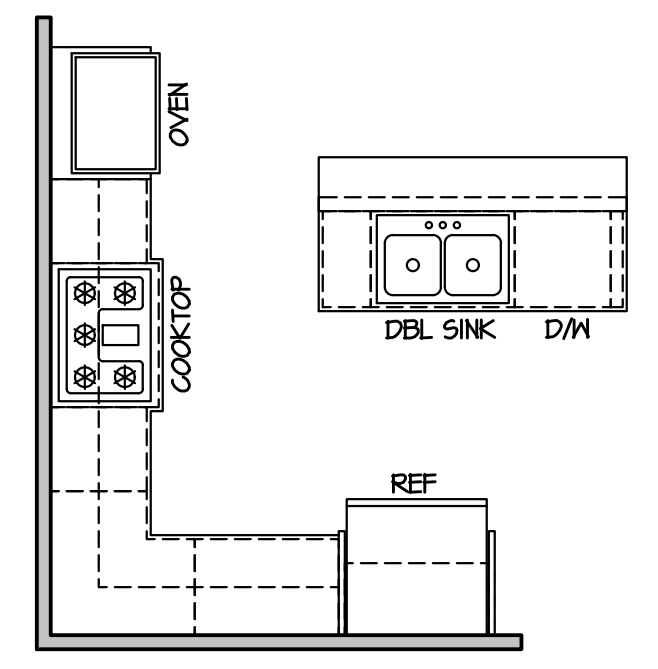

3 GOURMET KITCHEN
 1/4" = 1'-0"

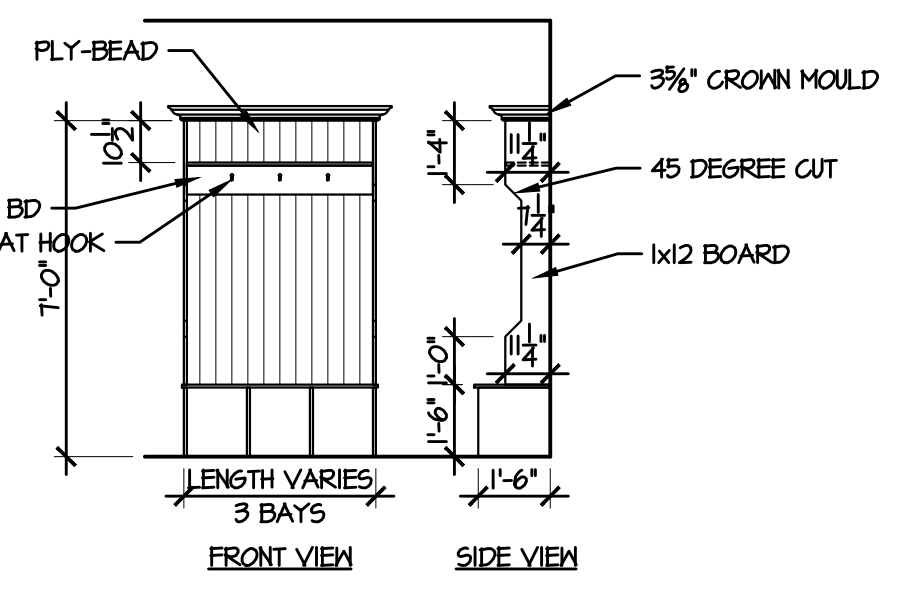

A COAT STATION
 1/4" = 1'-0" DETAIL

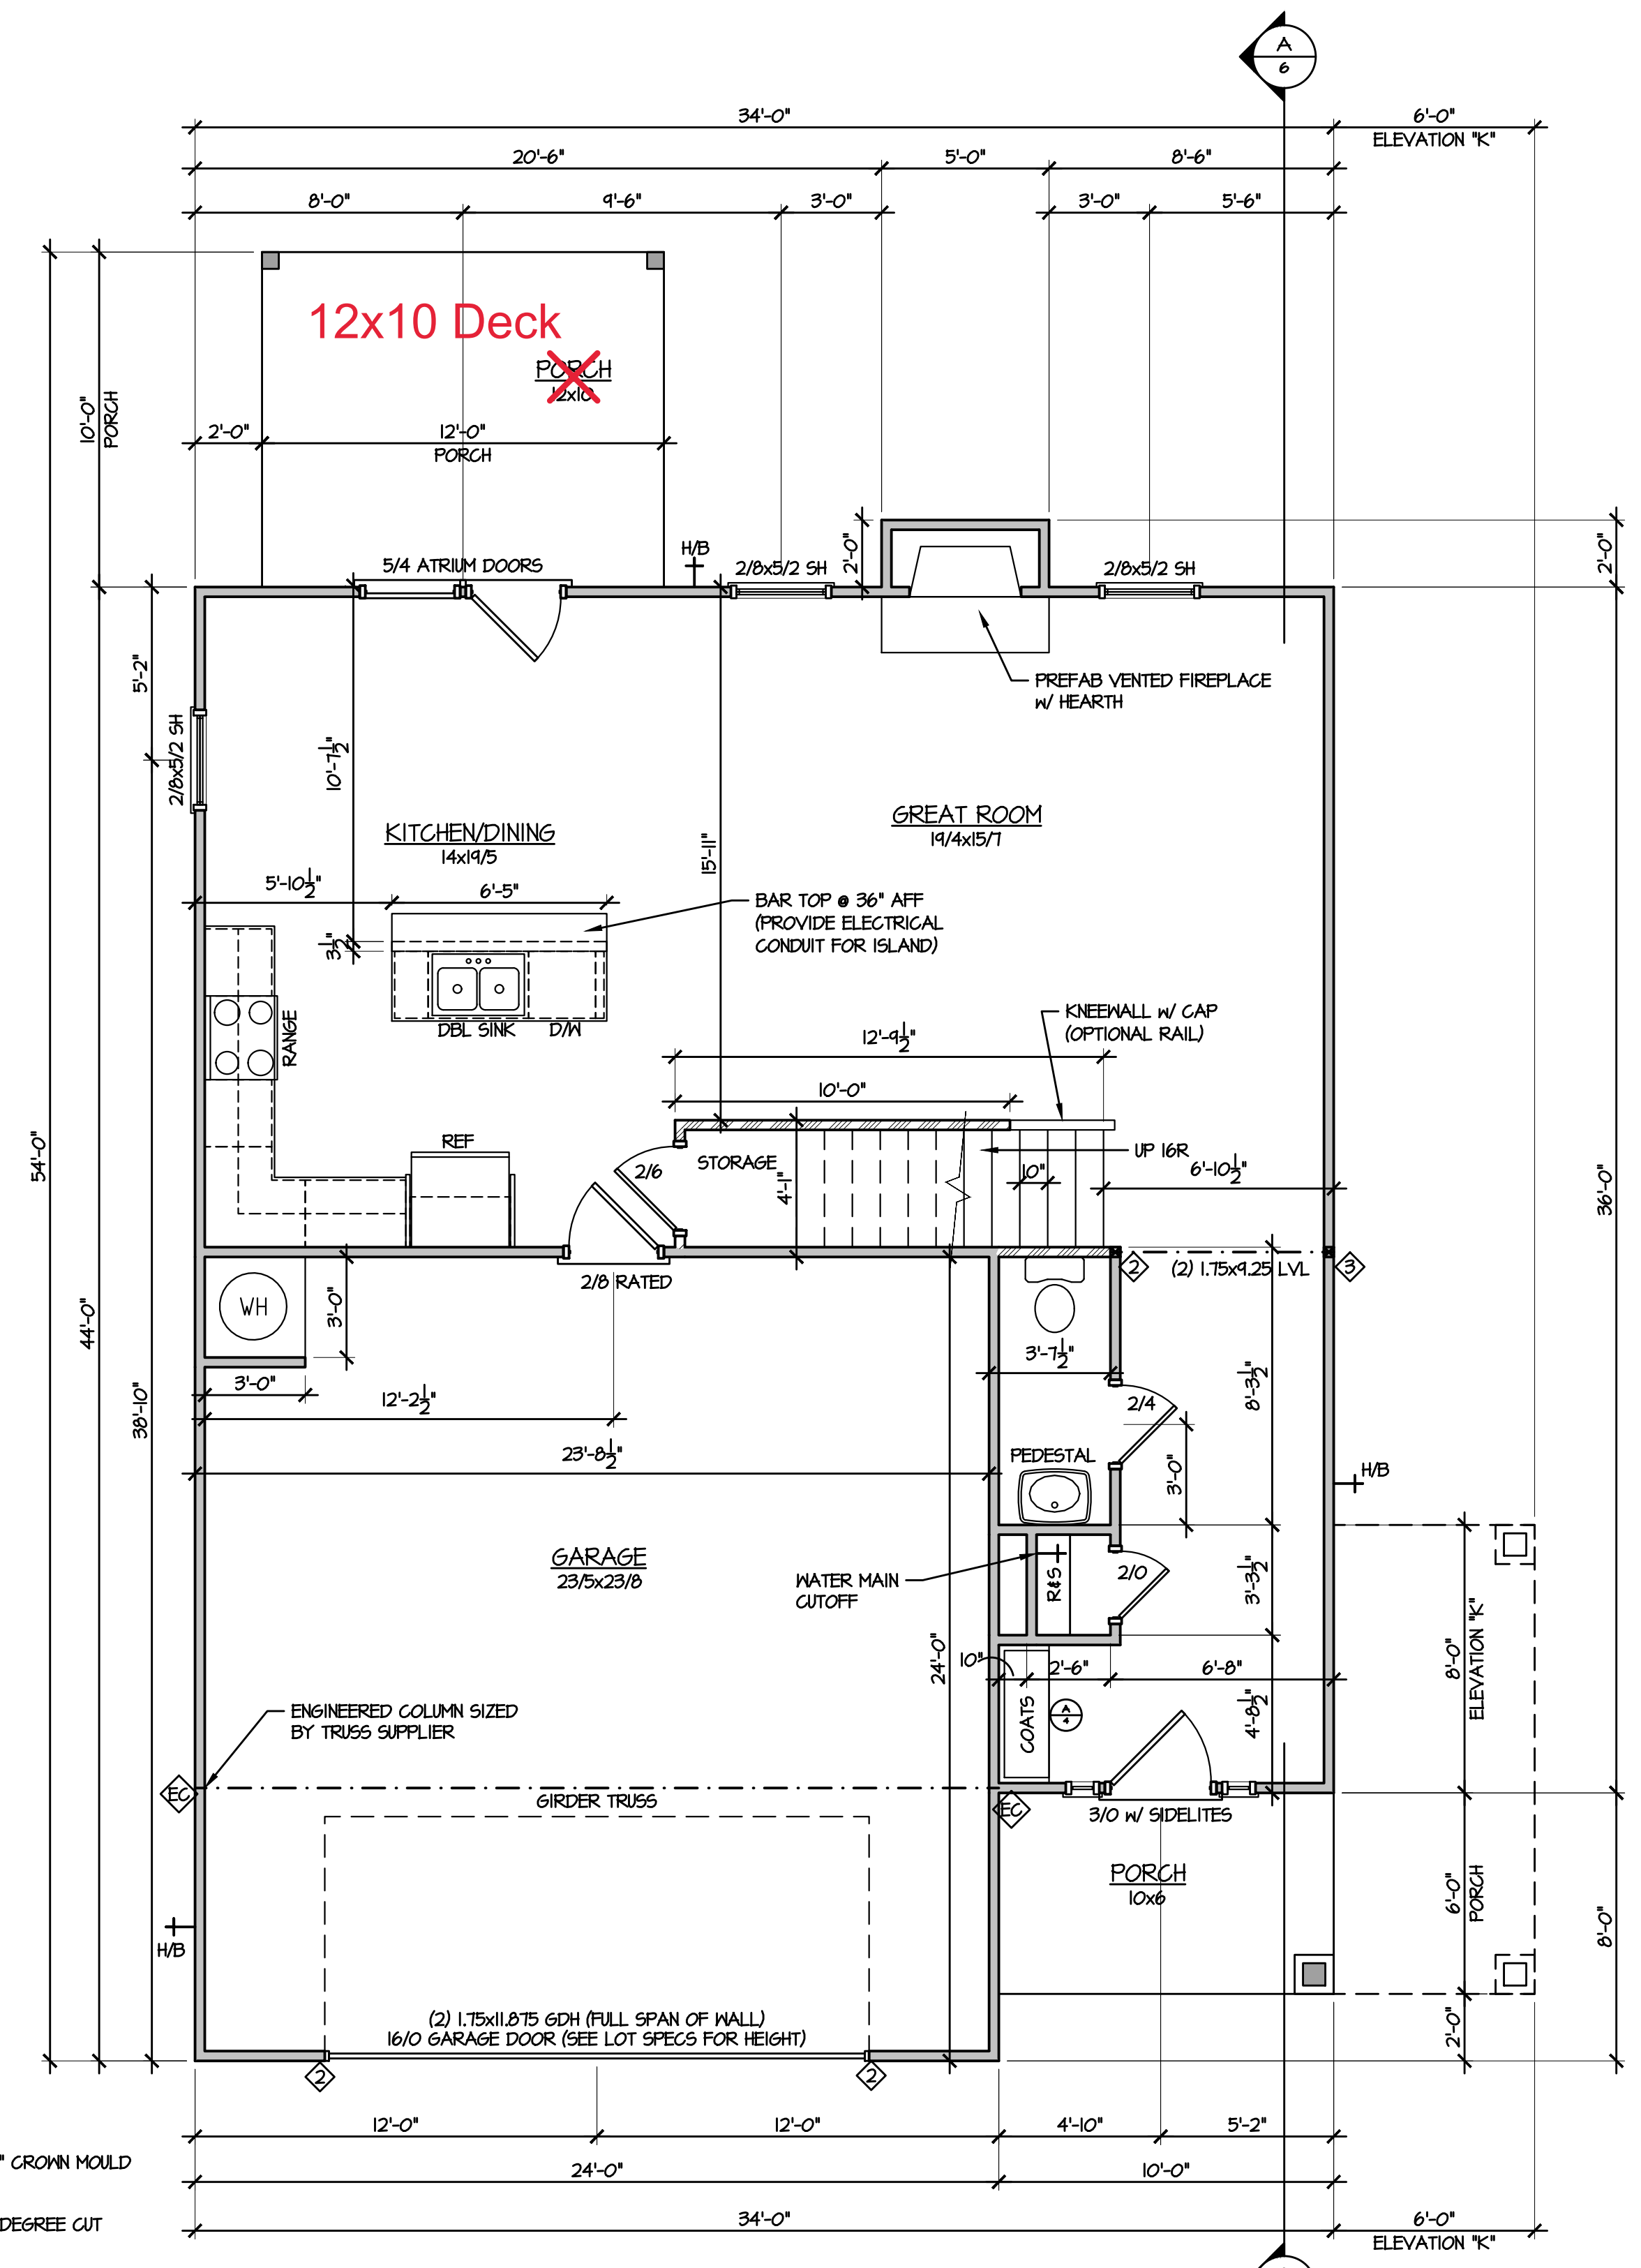

1 FIRST FLOOR PLAN
 1/4" = 1'-0"

