

VICINITY MAP
(NOT TO SCALE)

LINE TABLE		
LINE #	BEARING	DISTANCE
LI	N 88° 56' 38" E	26.15'


CURVE TABLE				
CURVE #	LENGTH	RADIUS	CHORD BEARING	CHORD LENGTH
C1	53.95'	350.00'	S 86° 38' 23" E	53.90'

LEGEND

- IRF IRON ROD FND.
- IPS IRON PIPE SET
- CALCULATED POINT
- ⊞ WATER METER
- CLEANOUT
- YD YARD DRAIN
- ⊞ ELEC. TRANSFORMER
- CABLE BOX
- ⊞ ELEC. BOX
- ⊞ COMM. VAULT


GENERAL NOTES

- DISTANCES DEPICTED HEREON ARE GROUND DISTANCES IN U.S. SURVEY FEET. AREAS COMPUTED USING THE COORDINATE METHOD.
- THIS SURVEY WAS PERFORMED WITHOUT BENEFIT OF CURRENT TITLE REPORT. PROPERTY DEPICTED HEREON MAY BE SUBJECT TO SUCH EASEMENTS, ETC. AS A CURRENT TITLE PACKAGE MAY DISCLOSE.
- PLAT REFERENCE: MAP 2021 PAGES 512-515.
- OFFSETS AND DIMENSIONS DEPICTED HEREON FROM THE PROPERTY LINES TO THE FOUNDATION OR BUILDING LINE ARE NOT INTENDED TO MONUMENT THE PROPERTY LINES AND ARE NOT TO BE USED TO GUIDE OR ASSIST IN THE ERECTION OF FENCES, STRUCTURES, OR ANY OTHER IMPROVEMENTS.
- ADJOINING OWNER INFORMATION TAKEN FROM DEEDS AND MAPS OF RECORD.
- SETBACKS: FRONT - 30'
SIDE - 10'
REAR - 20'
CORNER LOT SIDE - 20'
- PER RECORDED MAP, LOT SHOWN HEREON IS NOT LOCATED WITHIN A SPECIAL FLOOD HAZARD AREA PER F.I.R.M. FLOOD RATE INSURANCE MAP NO. 3720064200J, BEARING AN EFFECTIVE DATE OF 10/3/2006.
- ZONING - RA-30
- DATE OF FIELD SURVEY: 04/18/2022

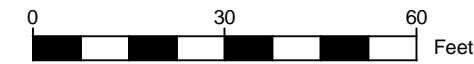

I HEREBY CERTIFY THAT THIS AS-BUILT SURVEY WAS DRAWN UNDER MY DIRECT SUPERVISION FROM AN ACTUAL FIELD-RUN SURVEY AND THAT THERE ARE NO ENCROACHMENTS UNLESS OTHERWISE SHOWN. DEED REFERENCES ARE AS DEPICTED HEREON. THE RATION OF PRECISION OR POSITIONAL ACCURACY IS 1:10,000+ AND THAT THIS PLAT MEETS THE REQUIREMENTS OF THE STANDARD OF PRACTICE FOR LAND SURVEYING IN NORTH CAROLINA (21 NCAC 56, 1600).


 CALEB T. CLAYTON, PLS L-5306
 04/19/22

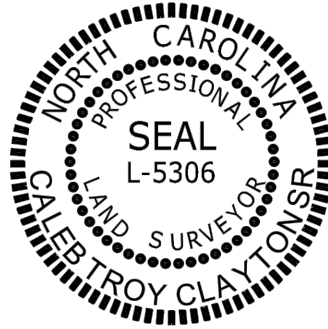

MORRIS & RITCHIE ASSOCIATES OF NC, PC
 ENGINEERS, PLANNERS, SURVEYORS AND LANDSCAPE ARCHITECTS
 FIRM LICENSE: C-4182, G-442
 5605 CHAPEL HILL ROAD, SUITE 112
 RALEIGH, NORTH CAROLINA 27607
 (919) 200-2103
 MRAGTA.COM

FOUNDATION AS-BUILT SURVEY
LOT 150 - #232 HUNTING WOOD DRIVE
PHASE 6 - QUAIL GLEN SUBDIVISION
 BLACK RIVER TWP., HARNETT COUNTY, NORTH CAROLINA

SURVEYED FOR: RYAN HOMES - RALEIGH
 5734 TRINITY ROAD, SUITE 200
 RALEIGH, NC 27607

SCALE: 1"=30'	DATE: 04/19/2022	DRAWN BY: GDM	DESIGN BY:	REVIEW BY: CTC	JOB NO.: 20314
---------------	------------------	---------------	------------	----------------	----------------