

PURCHASER MUST VERIFY ALL DIMENSIONS AND CONDITIONS BEFORE CONSTRUCTION. THE CONTRACTOR SHALL BE RESPONSIBLE FOR OBTAINING ALL NECESSARY PERMITS AND APPROVALS. THE CONTRACTOR SHALL BE RESPONSIBLE FOR OBTAINING ALL NECESSARY PERMITS AND APPROVALS. THE CONTRACTOR SHALL BE RESPONSIBLE FOR OBTAINING ALL NECESSARY PERMITS AND APPROVALS.



Change to 18'x 8' single garage door



SQUARE FOOTAGE	
HEATED	208
UNHEATED	40
TOTAL	248
HEATED FUTURE	40
UNHEATED FUTURE	40
TOTAL FUTURE	80
TOTAL	328



ROOF & FLOOR TRUSSES & BEAMS

Reilly Road Industrial Park
Fayetteville, N.C. 28309
Phone: (910) 864-8787
Fax: (910) 864-4444

Bearing reactions less than or equal to 3000# are deemed to comply with the prescriptive Code requirements. The contractor shall refer to the attached Tables (derived from the prescriptive Code requirements) to determine the minimum foundation size and number of wood studs required to support reactions greater than 3000# but not greater than 15000#. A registered design professional shall be retained to design the support system for any reaction that exceeds those specified in the attached Tables. A registered design professional shall be retained to design the support system for all reactions that exceed 15000#.

Signature
Joe Ciferri

LOAD CHART FOR JACK STUDS


(BASED ON TABLES R502.5(1) & (b))
NUMBER OF JACK STUDS REQUIRED @ EA END OF HEADER/GIRDER

END REACTION (UP TO)	REQ. D. STUDS FOR (1) PLY HEADER	END REACTION (UP TO)	REQ. D. STUDS FOR (1) PLY HEADER	END REACTION (UP TO)	REQ. D. STUDS FOR (1) PLY HEADER
1700	1	2550	1	3400	1
3400	2	5100	2	6800	2
5100	3	7650	3	10200	3
6800	4	10200	4	13600	4
8500	5	12750	5	17000	5
10200	6	15300	6		
11900	7				
13600	8				
15300	9				

COUNTY	Harnett County
ADDRESS	6085 Stewart Road / Broadway, NC
MODEL	1st Floor I-Joists
DATE REV.	3/6/24
DRAWN BY	Joe Ciferri
SALESMAN	Anthony Williams

BUILDER	Signature Home Builders
JOB NAME	6085 Stewart Road
PLAN	Crawl
SEAL DATE	NA
QUOTE #	NA
JOB #	J0324-1346

THIS IS A TRUSS PLACEMENT DIAGRAM ONLY.
These trusses are designed as individual building components to be incorporated into the building design at the specification of the building designer. See individual design sheets for each truss design identified on the placement drawing. The building designer is responsible for temporary and permanent bracing of the roof and floor system and for the overall structure. The design of the truss support structure including headers, beams, walls, and columns is the responsibility of the building designer. For general guidance regarding bracing, consult BCSI-B1 and BCSI-B3 provided with the truss delivery package or online @ sbciindustry.com

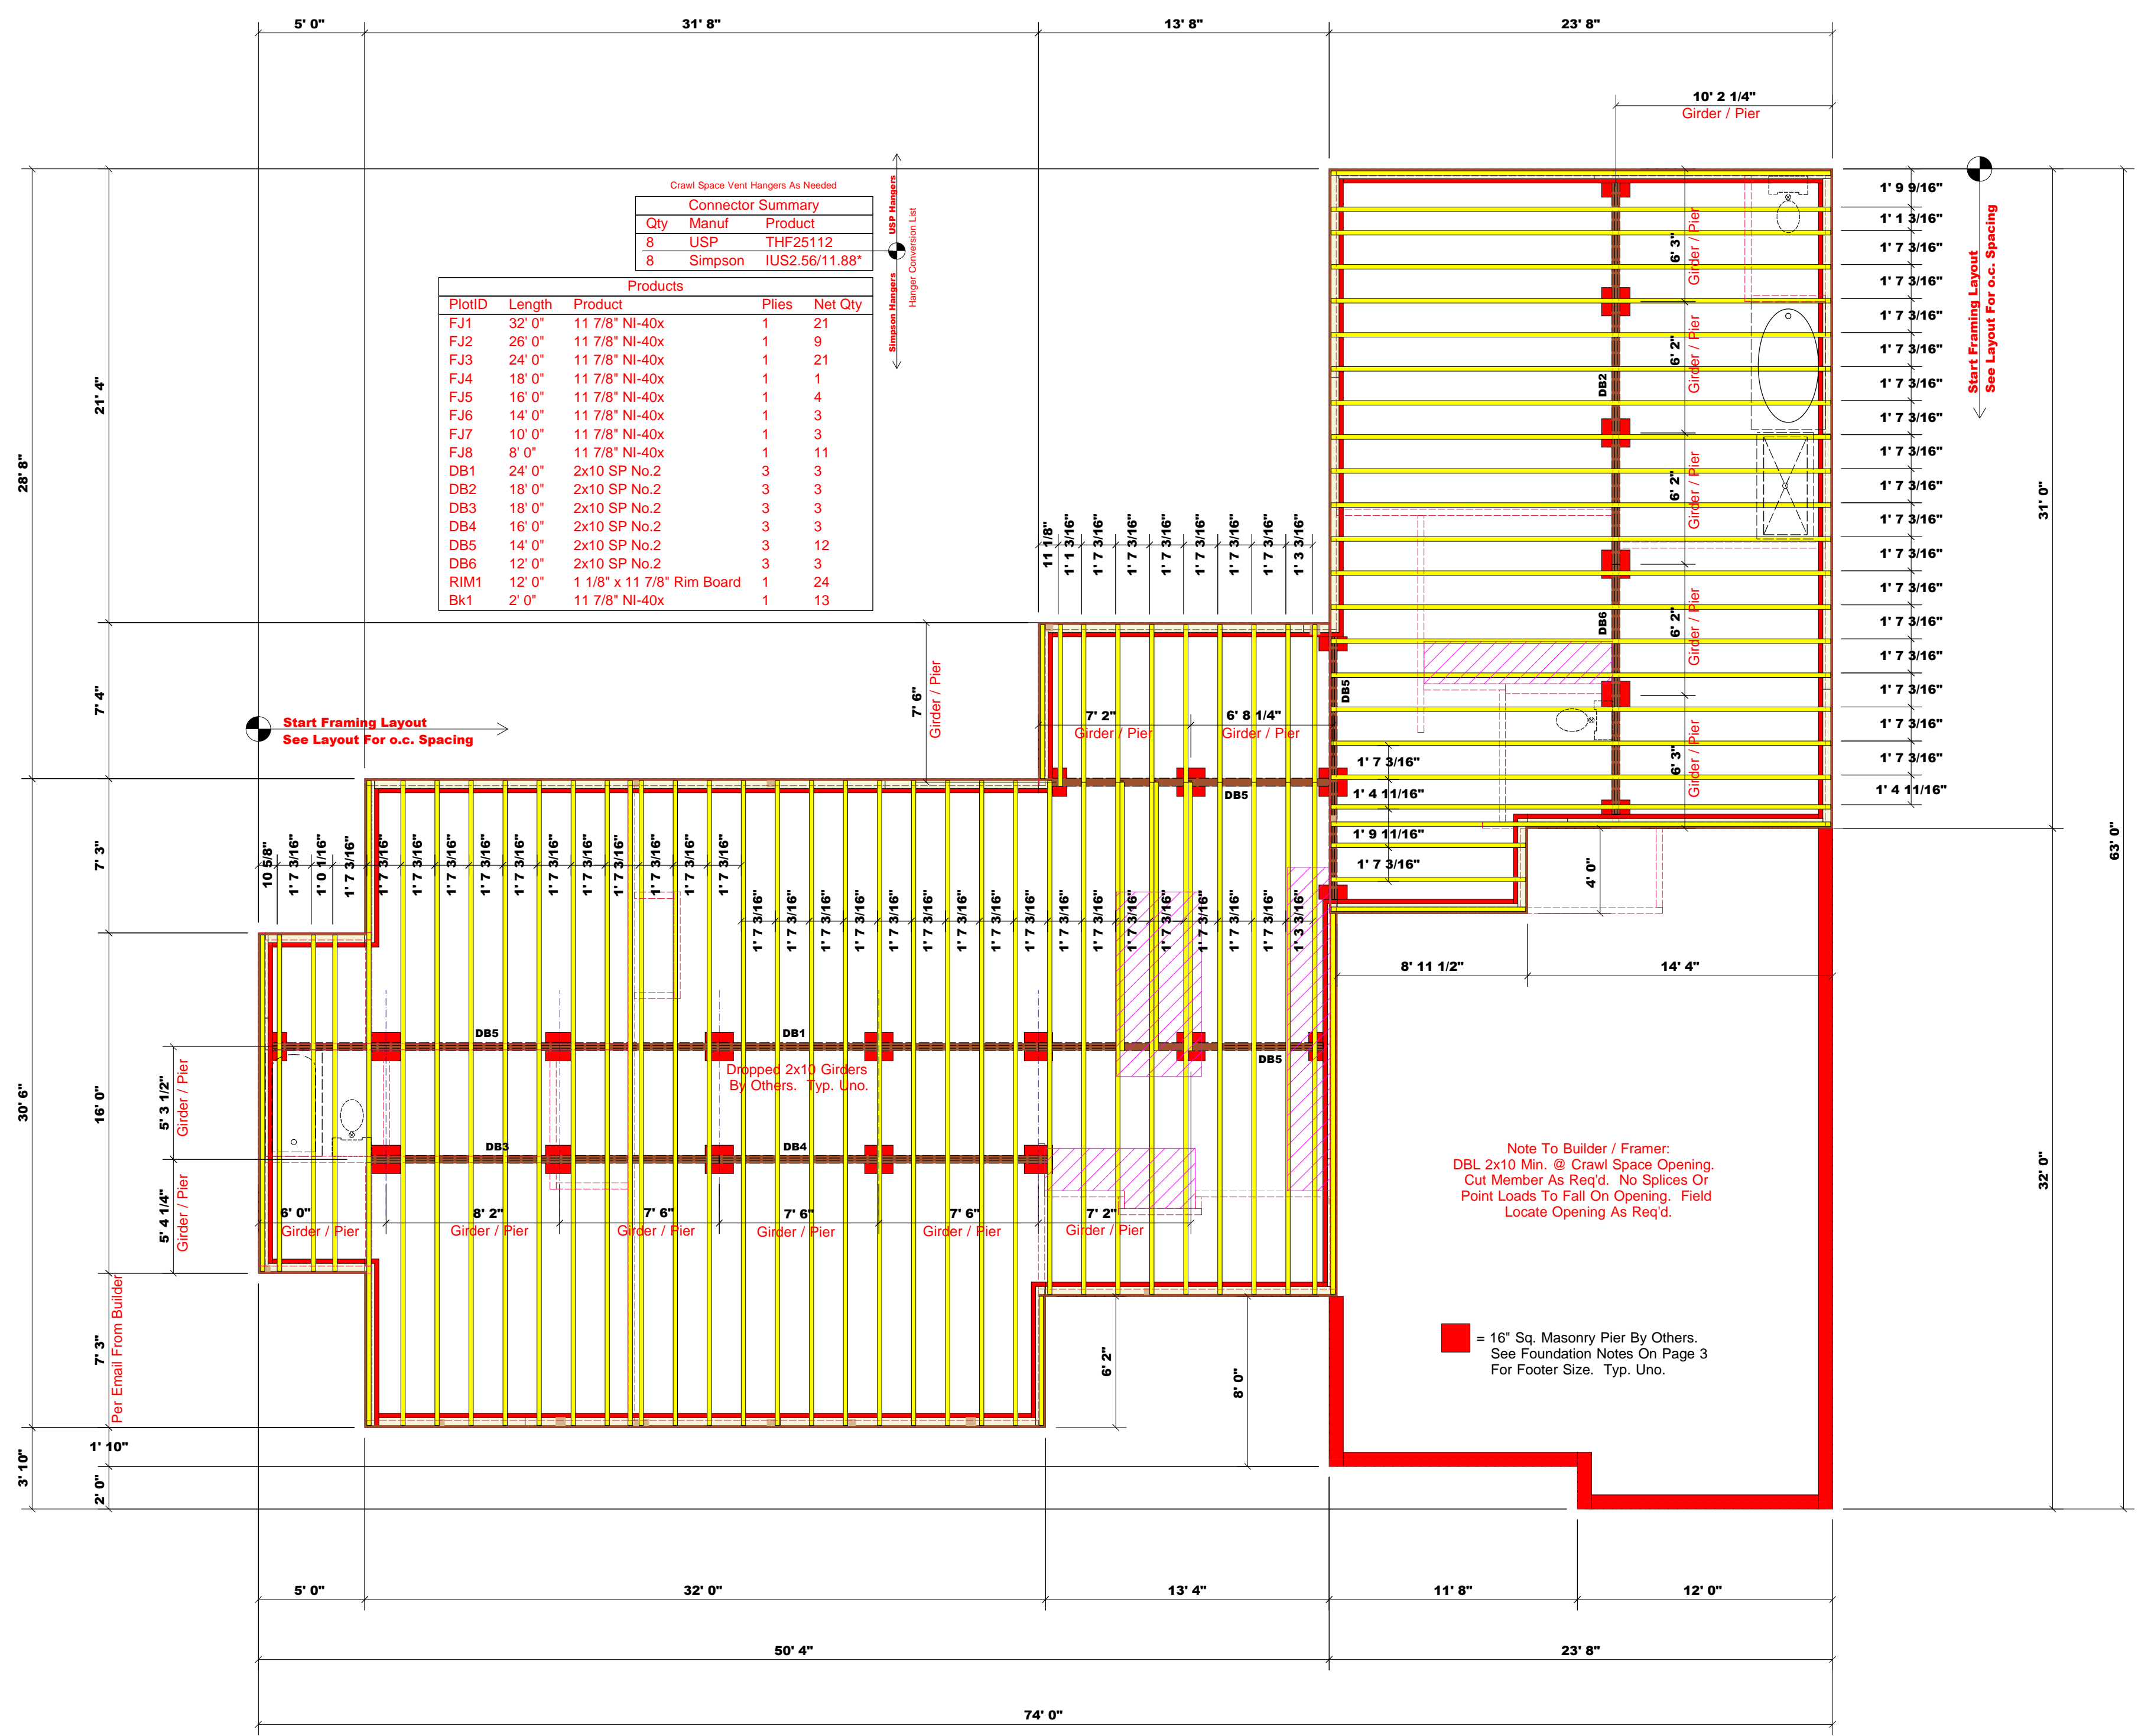

Crawl Space Vent Hangers As Needed

Connector Summary		
Qty	Manuf	Product
8	USP	THF25112
8	Simpson	IUS2.56/11.88*

Products				
PlotID	Length	Product	Plies	Net Qty
FJ1	32' 0"	11 7/8" NI-40x	1	21
FJ2	26' 0"	11 7/8" NI-40x	1	9
FJ3	24' 0"	11 7/8" NI-40x	1	21
FJ4	18' 0"	11 7/8" NI-40x	1	1
FJ5	16' 0"	11 7/8" NI-40x	1	4
FJ6	14' 0"	11 7/8" NI-40x	1	3
FJ7	10' 0"	11 7/8" NI-40x	1	3
FJ8	8' 0"	11 7/8" NI-40x	1	11
DB1	24' 0"	2x10 SP No.2	3	3
DB2	18' 0"	2x10 SP No.2	3	3
DB3	18' 0"	2x10 SP No.2	3	3
DB4	16' 0"	2x10 SP No.2	3	3
DB5	14' 0"	2x10 SP No.2	3	12
DB6	12' 0"	2x10 SP No.2	3	3
RIM1	12' 0"	1 1/8" x 11 7/8" Rim Board	1	24
Bk1	2' 0"	11 7/8" NI-40x	1	13

Truss Placement Plan
SCALE: 3/16" = 1'-0"

STRUCTURAL NOTES

All construction shall conform to the latest requirements of the 2018 North Carolina Residential Building Code, plus all local codes and regulations. This document in no way shall be construed to supersede the code.

JOB SITE PRACTICES AND SAFETY: Haynes Home Plans, Inc. assumes no liability for contractors' professional procedures or safety program. Haynes Home Plans, Inc. takes no responsibility for the contractor's failure to carry out the construction work in accordance with the contract documents. All members shall be framed, anchored, and braced in accordance with good construction practice and loadbearing code.

DESIGN LOADS	TYPE	LIVE LOAD (PSF)	DEAD LOAD (PSF)	DEFLECTION (L/1,000)
Attics without storage	10	10	L/240	
Attics with limited storage	20	10	L/360	
Attics with fixed stairs	40	10	L/360	
Balconies and decks	40	10	L/360	
Fire escapes	40	10	L/360	
Guardrails and handrails	200	—	—	
Guardrail in-fill components	50	10	L/360	
Passenger vehicle garages	30	10	L/360	
Rooms other than sleeping	40	10	L/360	
Sleeping rooms	30	10	L/360	
Stairs	40	10	L/360	
Snow	20	—	—	

FRAMING LUMBER: All non-treated framing lumber shall be SPF #2 (Fb = 875 PSI) or SPF #1 (Fb = 790 PSI) and all treated lumber shall be SYP #2 (Fb = 720 PSI) unless noted other wise.

ENGINEERED WOOD BEAMS: Laminated veneer lumber (LVL) = 110-2600 PSI, Fv=285 PSI, E=1.5e+09 PSI Parallel strand lumber (PSL) = 110-2600 PSI, Fv=285 PSI, E=2.0e+09 PSI Laminated strand lumber (LSL) = 110-2600 PSI, Fv=480 PSI, E=1.5e+09 PSI Install all connections per manufacturer's instructions.

TRUSS AND JOIST MEMBERS: All roof truss and joist layouts shall be prepared in accordance with this document. Trusses and Joists shall be installed according to the manufacturer's specifications. Any change in truss or joist layout shall be coordinated with Haynes Home Plans, Inc.

ROOF SHEATHING: OSB or CDX floor sheathing minimum 1/2" thick for 16' on center joist spacing, minimum 5/8" thick for 24" on center joist spacing, and minimum 3/4" thick for 24" on center joist spacing.

CONCRETE AND SOILS: See foundation notes.

BRACE WALL PANEL NOTES

EXTERIOR WALLS: All exterior walls to be sheathed with CS-WSP or CS-SFB in accordance with section R602.10.3 unless noted otherwise.

CYCLING: All exterior sides of exterior walls and both sides interior walls to have 1/2" gypsum installed. When not using method of gypsum to be fastened per table R602.10.3, Method R602.10.3 shall be fastened per table R602.10.3.

REQUIRED LENGTH OF BRACING: Required brace wall length for each side of the circumferential rectangle at an interpolated length shall be minimum 3/8" OSB or CDX nailed at 6" on center at edges and 12" on center at intermediate supports with 6d common nails or 8d/2" long x 0.113" diameter CS-SFB. Shall be minimum 1/2" structural fiber board installed 3" on center at edges and 3" on center at intermediate supports with 1 1/2" long x 0.113" diameter galvanized roofing nails.

OSB: Interior walls shall be OSB or CDX nailed at 6" on center at edges and 12" on center at intermediate supports with 6d common nails or 8d/2" long x 0.113" diameter CS-SFB. Shall be minimum 1/2" structural fiber board installed 3" on center at edges and 3" on center at intermediate supports with minimum 5d common nails or #6 screws.

PF: Portal frame per figure R602.10.1.

EXTERIOR HEADERS


(2) 2 X 4 WITH 1 JACK STUD EACH END UNLESS NOTED OTHERWISE
 - KING STUDS EACH END PER TABLE BELOW

ROOF SPAN	1	2	3	4	5	6
KING STUDS	1	2	3	4	5	6

INTERIOR HEADERS

- LOAD BEARING HEADERS (2) 2 X 6 WITH 1 JACK STUD AND 1 KING STUD EACH END UNLESS NOTED OTHERWISE

- NON LOAD BEARING HEADERS TO BE LADDER FRAMED

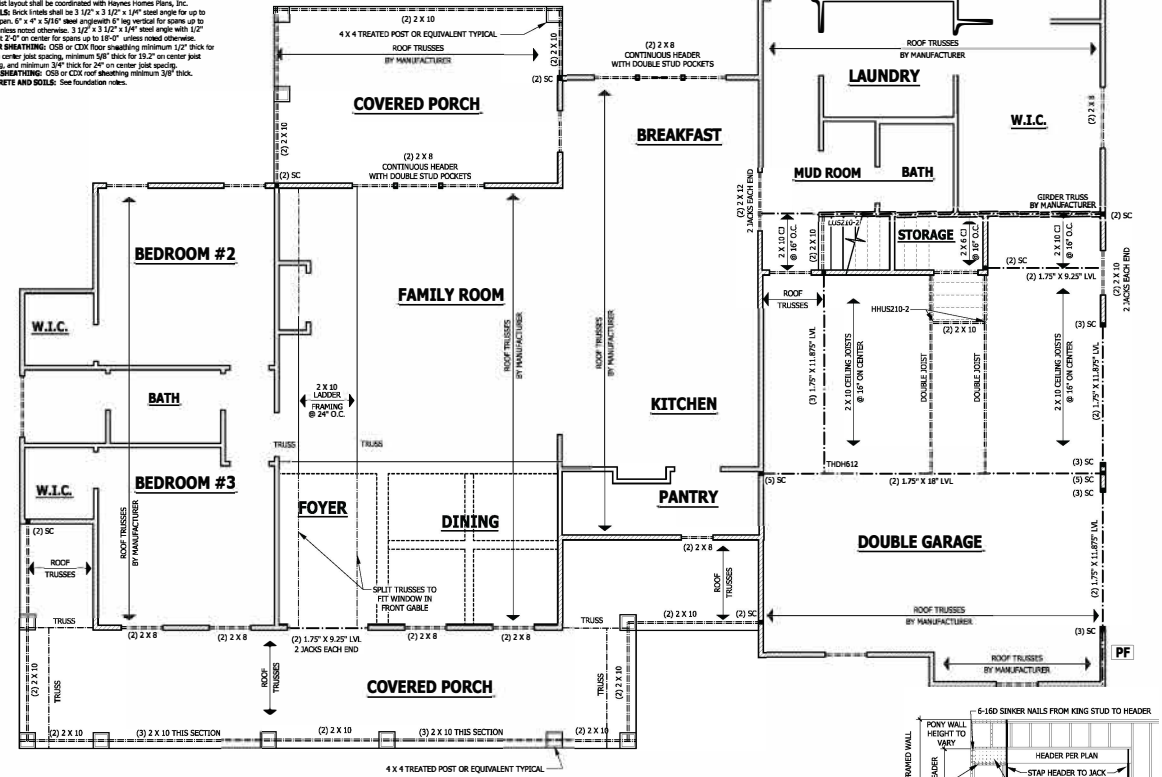

ROOF TRUSS REQUIREMENTS

TRUSS DESIGN: Trusses to be designed and engineered in accordance with these drawings. Any variation with these drawings must be brought to Haynes Home Plans, Inc. attention before construction begins.


ONE WALL AND CEILING HEIGHTS: All trussed knee wall heights and ceiling heights are shown turned down 10" from roof decking for installation of dry wall. Manufacturer fails to erect exceed designated heel heights, finished knee wall heights, or finished ceiling heights shown on these drawings the finished square footage may vary. Any discrepancy must be brought to Haynes Home Plans, Inc. attention so a suitable solution can be reached before construction begins. Any variation due to these conditions not being met is the responsibility of the truss manufacturer.

ANCHORAGE: All required anchors for trusses due to uplift or bearing shall meet the requirements as specified on the truss drawings.

BEARING: All trusses shall be designed for bearing on SPF #2 plates or joists unless noted otherwise.

FIRST FLOOR STRUCTURAL

SCALE 1/4" = 1'-0"

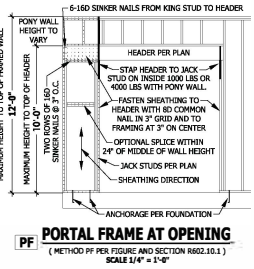

PF PORTAL FRAME AT OPENING
 (METHOD PF PER FIGURE AND SECTION R602.10.1)
 SCALE 1/4" = 1'-0"

purchaser must verify all dimensions and construction details with the contractor. Haynes Home Plans, Inc. assumes no liability for contractor's professional procedures or safety program. Haynes Home Plans, Inc. takes no responsibility for the contractor's failure to carry out the construction work in accordance with the contract documents. All members shall be framed, anchored, and braced in accordance with good construction practice and loadbearing code.

CONCRETE AND SOILS: See foundation notes.

TRUSS AND JOIST MEMBERS: All roof truss and joist layouts shall be prepared in accordance with this document. Trusses and Joists shall be installed according to the manufacturer's specifications. Any change in truss or joist layout shall be coordinated with Haynes Home Plans, Inc.

ROOF SHEATHING: OSB or CDX floor sheathing minimum 1/2" thick for 16' on center joist spacing, minimum 5/8" thick for 24" on center joist spacing, and minimum 3/4" thick for 24" on center joist spacing.

CONCRETE AND SOILS: See foundation notes.

Signature Home Builders, Inc.
 HOME BUILDERS, INC.
 1000 W. HAYNES BLVD. #1000, WAYNESVILLE, NC 27586



SQUARE FOOTAGE

ROOM	AREA	PERCENT
HEATED FLOOR	4017	80.0%
UNHEATED	1000	20.0%
TOTAL	5017	100.0%

FORWARD PLAN VIEW ALL DIMENSIONS AND CONSTRUCTION NOTES SHALL BE TO FACE UNLESS OTHERWISE NOTED. CONTRACTOR SHALL VERIFY ALL DIMENSIONS AND CONSTRUCTION NOTES BEFORE COMMENCING WORK. CONTRACTOR SHALL BE RESPONSIBLE FOR OBTAINING ALL NECESSARY PERMITS AND APPROVALS. CONTRACTOR SHALL BE RESPONSIBLE FOR OBTAINING ALL NECESSARY PERMITS AND APPROVALS. CONTRACTOR SHALL BE RESPONSIBLE FOR OBTAINING ALL NECESSARY PERMITS AND APPROVALS.

STRUCTURAL NOTES

All construction shall conform to the latest requirements of the 2018 North Carolina Residential Building Code, plus all local codes and regulations. This document in no way shall be construed to supersede the code. **JOB SITE PRACTICES AND SAFETY:** Haynes Home Plans, Inc. assumes no liability for contractor practices and procedures or safety program. Haynes Home Plans, Inc. shall not be responsible for the contractor's failure to carry out the contractor's work in accordance with the contract documents. All members shall be framed, anchored, and braced in accordance with good construction practice and the building code.

DESIGN LOADS	LIVE LOAD (PSF)	DEAD LOAD (PSF)	DEFLECTION (L)
Attic without storage	10	10	L/240
Attic with limited storage	20	10	L/360
Attic with floor stairs	40	10	L/360
Balconies and decks	40	10	L/360
Fire escapes	40	10	L/360
Guardrails and handrails	200	—	—
Guardrail in-fill components	50	—	—
Passenger vehicle garages	50	10	L/360
Rooms other than sleeping	40	10	L/360
Sleeping rooms	30	10	L/360
Stairs	40	—	L/360
Stow	20	—	—

FRAMING LUMBER: All non treated framing lumber shall be SPF #2 (D = 25 PSI) or SPF #1 (D = 25 PSI) and all treated lumber shall be SPF #2 (D = 25 PSI) or SPF #1 (D = 25 PSI) and all treated lumber shall be SPF #2 (D = 25 PSI) or SPF #1 (D = 25 PSI) unless noted otherwise.

ENGINEERED WOOD BEAMS: Laminated veneer lumber (LVL) = Fv=2600 PSI, Fw=265 PSI, E=1,810,000 PSI Parallel strand lumber (PSL) = Fv=2600 PSI, Fw=265 PSI, E=1,810,000 PSI Laminated strand lumber (LSL) = Fv=2200 PSI, Fw=400 PSI, E=1,554,000 PSI

TRUSS AND JOIST MEMBERS: All roof truss and joist layouts shall be prepared in accordance with this document. Trusses and joists shall be installed according to the manufacturer's specifications. Any change in truss or joist layout shall be coordinated with Haynes Home Plans, Inc. **LIMITS:** Truss limits shall be 3 1/2" x 1 1/2" x 2" steel angle for up to 6'-0" span, 6" x 4" x 1/2" steel angle with 6" lag vertical for spans up to 6'-0" unless noted otherwise. 3 1/2" x 1 1/2" x 2" steel angle for up to 6'-0" spans at 2'-0" on center for spans up to 18'-0" unless noted otherwise. **FLOOR BRACING:** CDS or CDS floor bracing minimum 1/2" thick for 15' on center just spacing, minimum 5/8" thick for 19' 2" on center just spacing, and minimum 3/4" thick for 24' on center just spacing. **ROOF BRACING:** CDS or CDS roof bracing minimum 3/8" thick. **CONCRETE AND SOILS:** See foundation notes.

ROOF TRUSS REQUIREMENTS

TRUSS DESIGN: Trusses to be designed and engineered in accordance with these drawings. Any variation with these drawings must be brought to Haynes Home Plans, Inc. attention before construction begins. **KNEE WALL AND CEILING HEIGHTS:** All finished knee wall heights and ceiling heights are shown turned down 10° from roof decking for insulation. If for any reason the truss manufacturer fails to meet or exceed designated knee heights, finished knee wall heights, or finished ceiling heights shown on these drawings the finished square footage may vary. Any discrepancy must be brought to Haynes Home Plans, Inc. attention, so a suitable solution can be reached before construction begins. Any variation due to these conditions not being met is the responsibility of the truss manufacturer. **ANCHORAGE:** All required anchors for trusses due to uplift or bearing shall meet the requirements as specified on the truss schematic. **BEARING:** All trusses shall be designed for bearing on SPF #2 joists and ledgers unless noted otherwise. **Plate Heights & Floor Systems:** See elevation pages for plate heights and floor system thicknesses.

EXTERIOR HEADERS

(2) 2 X 6 WITH 1 JACK STUD EACH END UNLESS NOTED OTHERWISE
 - KING STUDS EACH END PER TABLE BELOW
 (KING STUDS) 2 3 4 100

INTERIOR HEADERS


- LOAD BEARING HEADERS (2) 2 X 6 WITH 1 JACK STUD AND 1 KING STUD EACH END UNLESS NOTED OTHERWISE
 - NON LOAD BEARING HEADERS TO BE LADDER FRAMED

WALL THICKNESSES

Exterior walls and walls adjacent to a garage area are drawn as 4" or as noted 2 X 6 are drawn as 4" to include 1/2" sheathing or gypsum. Subtract 1/2" for stud face.
 Interior walls are drawn as 3 1/2" or as noted 2 X 6 are drawn as 3 1/2", and do not include gypsum.

ATTIC ACCESS

SECTION R807
 R807.2 Attic access. An attic access opening shall be provided to attic areas that exceed 400 square feet (37.16 m²) and have a vertical height of 50 inches (1270 mm) or greater. The net clear opening shall not be less than 18 inches (457 mm) by 24 inches (609 mm) by 762 mm) and shall be located in a hallway or other readily accessible location. A 30-inch (762 mm) minimum unobstructed headroom in the attic space shall be provided at some point above the access opening. See Section H1001.1.3 for access requirements where mechanical equipment is located in attics.
 Exceptions:
 1. Covered areas not located over the main structure including porches, areas behind knee walls, dormers, bay windows, etc. are not required to have access.
 2. Full down stair treads, stringers, handrails, and hardware may protrude into the net clear opening.

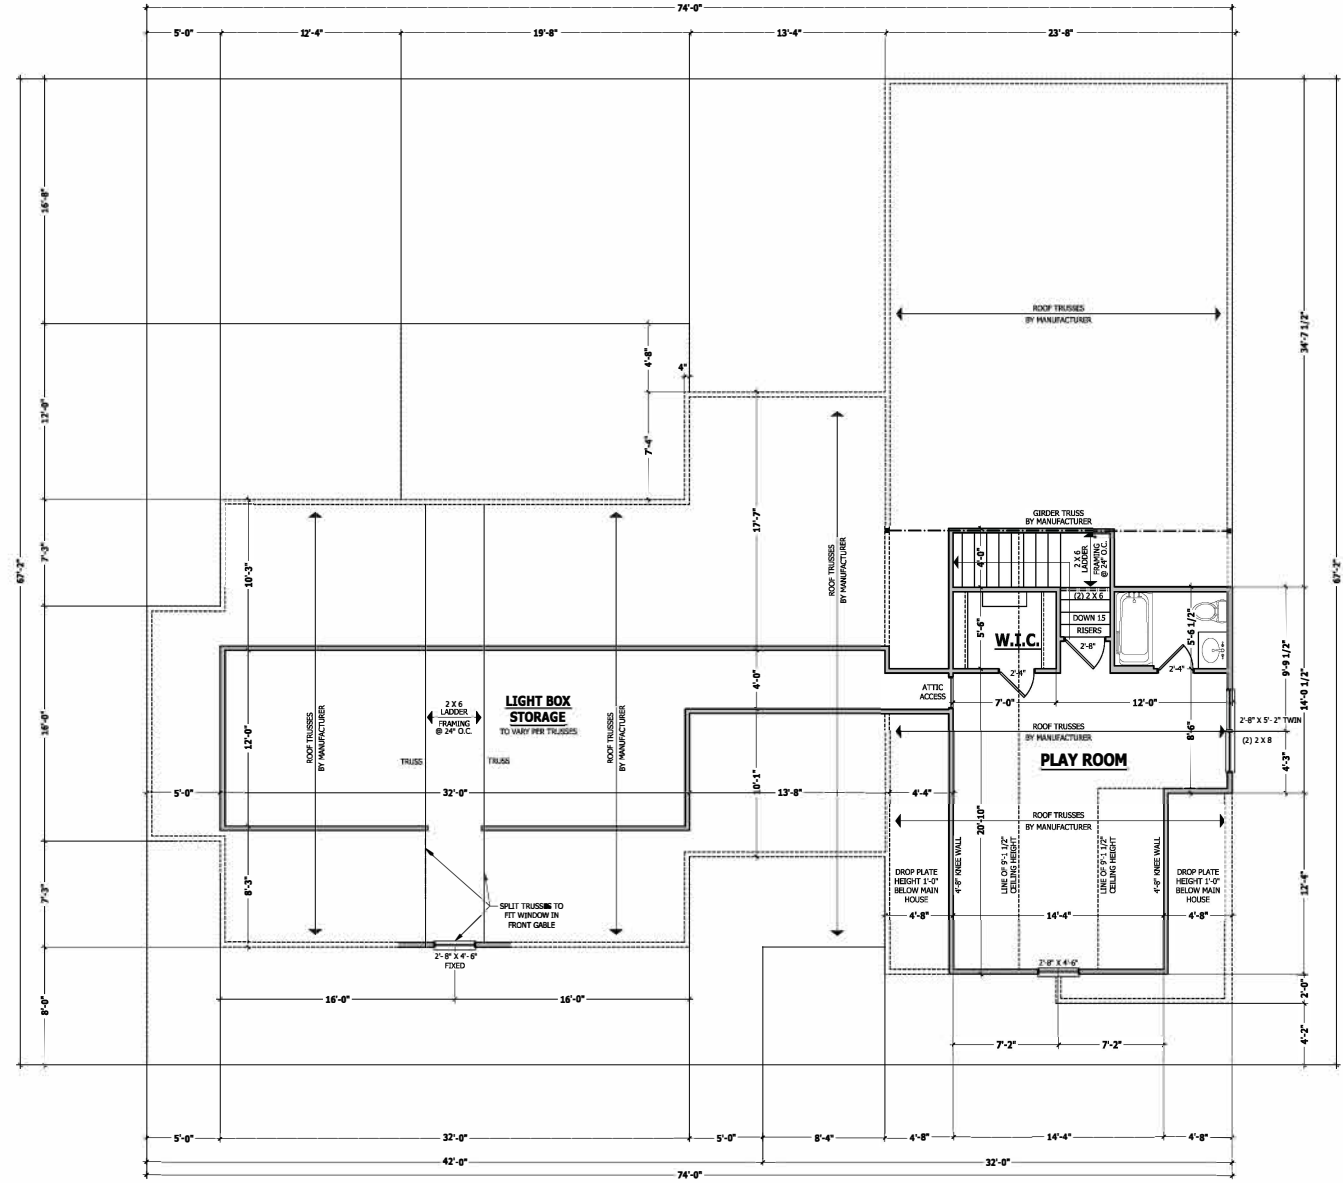

SECOND FLOOR PLAN
 SCALE 1/4" = 1'-0"

SECOND FLOOR PLAN



SQUARE FOOTAGE	
NET FLOOR	208 SQ. FT.
CEILING	40 SQ. FT.
UNHEATED	60 SQ. FT.
NEW FLOOR	208 SQ. FT.
CEILING	40 SQ. FT.
TOTAL	208 SQ. FT.

© Copyright 2019
 Haynes Home Plans, Inc.
12/30/2019
190814B
 PAGE 6 OF 8

Z:\Builder\Signature Home Builders, Inc.\190814B Haynes Residence\190814B Haynes Residence.dwg

ROOF TRUSS REQUIREMENTS

TRUSS DESIGN. Trusses to be designed and engineered in accordance with these drawings. Any variation with these drawings must be brought to Haynes Home Plans, Inc. attention before construction begins.


KNEE WALL AND CEILING HEIGHTS. All finished knee wall heights and ceiling heights are shown turned down 1/2" from roof decking for insulation. If for any reason the truss manufacturer fails to meet or exceed designated knee heights, finished knee wall heights, or finished ceiling heights shown on these drawings the finished square footage may vary. Any discrepancy must be brought to Haynes Home Plans, Inc. attention, so a suitable solution can be reached before construction begins. Any variation due to these conditions not being met is the responsibility of the truss manufacturer.

ANCHORAGE. All required anchors for trusses due to uplift or bearing shall meet the requirements as specified on the truss schematics.

BEARING. All trusses shall be designed for bearing on SIF #2 plates or subject unless noted otherwise.

Plate Heights & Floor Systems. See elevation page(s) for plate heights and floor system thicknesses.

- HEEL HEIGHT ABOVE FIRST FLOOR PLATE
- HEEL HEIGHT ABOVE SECOND FLOOR PLATE

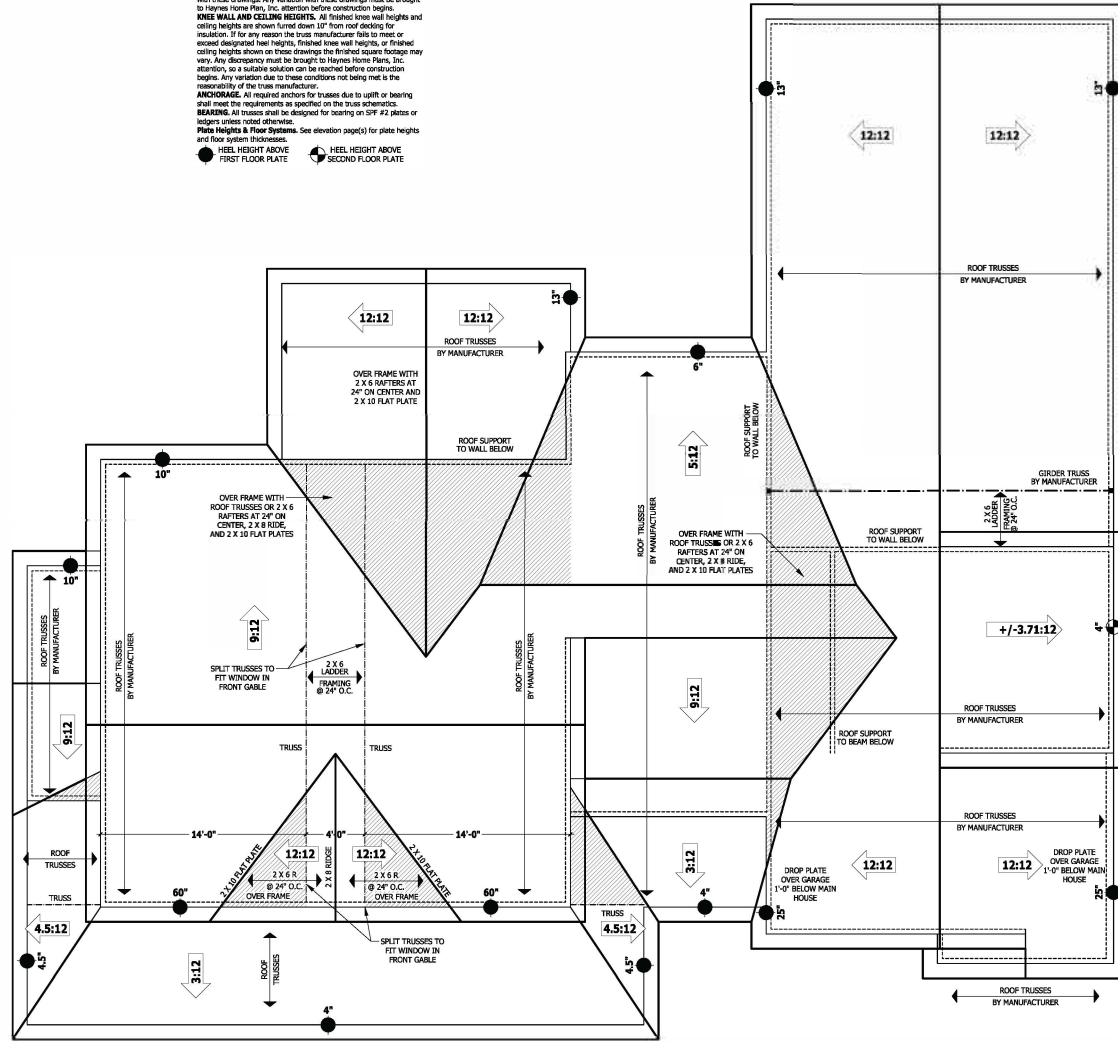

ROOF PLAN
SCALE 1/4" = 1'-0"

PROVIDER HAS MADE ALL NECESSARY CHECKS AND CORRECTIONS. ALL DIMENSIONS ARE GIVEN UNLESS OTHERWISE NOTED. CONTRACTOR SHALL VERIFY ALL DIMENSIONS AND CONDITIONS BEFORE CONSTRUCTION. HAYNES HOME PLANS, INC. IS NOT RESPONSIBLE FOR ANY ERRORS OR OMISSIONS. HAYNES HOME PLANS, INC. IS NOT RESPONSIBLE FOR ANY ERRORS OR OMISSIONS. HAYNES HOME PLANS, INC. IS NOT RESPONSIBLE FOR ANY ERRORS OR OMISSIONS.



SQUARE FOOTAGE	
HEATABLE FLOOR	208 SQ. FT.
UNHEATED FLOOR	418 SQ. FT.
UNHEATED ROOF	63 SQ. FT.
UNHEATED GARAGE	286 SQ. FT.
TOTAL	975 SQ. FT.

