207 Farrah-Shea Way Angier Subdivision Lot 8 Brian-Keith Meadow

꾸	BROOK
ElcJ	m
-	

"	Sheet List Table
Sheet Number	Sheet Title
1.10	COVER
2.10A	MONOLITHIC SLAB FOUNDATION - ELEVATION A
2.108	MONOLITHIC SLAB FOUNDATION - ELEVATION B
2.30A	CRAWL SPACE FOUNDATION - ELEVATION A
2.308	CRAWL SPACE FOUNDATION - ELEVATION B
4.10A	FIRST FLOOR PLAN ELEVATION A
4.108	FIRST FLOOR PLAN ELEVATION B
4.20A	SECOND FLOOR PLAN ELEVATION A
4.20B	SECOND FLOOR PLAN ELEVATION B
5.10A	FRONT AND REAR ELEVATION A
5.11A	LEFT AND RIGHT ELEVATION A
5.10B	FRONT AND REAR ELEVATION B
5.11B	LEFT AND RIGHT ELEVATION B
6.10	BUILDING SECTION
7.10A	ROOF PLAN ELEVATION A
7.10B	ROOF PLAN ELEVATION B
8.10	FIRST FLOOR ELECTRIAL PLANS
8.20	SECOND FLOOR ELECTRIAL PLANS

FOR DOORS AND WINDOWS		
SROSS AREA OF EXTERIOR WALLS	2112	5F
COMINAL AREA OF UNGLAZED DOORS	31.78 SF	5F
NOMINAL AREA OF DOORS WITH GLAZING	35.56	SF.
ADMINAL AREA OF MINDONS	8	S.F.
TOTAL NOMINAL AREA OF DOORS & MINDOMS	258.34 S.F	£5.
6 OF DOOR AND MINDOM OPENINGS	12.00%	5

	OTHER AREAS INDER ROOF.	TOTAL HEATED	SECOND FLOOR	FIRST FLOOR	AREAS:	SQUARE FOOTAGE ANALYSIS
3		5	5	8	SF INSIDE OF STUDS	TAGE
20 175		IBAB SF.	1000 SF.	82 SF.	25 PH	AN.
30 00		155 SE	1080 54	855 SF.	SE OUTSIDE O	SISAT

AREAS:	SCINS SCINS SE	SE OUTSIDE
FIRST FLOOR	812 SF.	. 855 5
SECOND FLOOR	1036 SF.	1080 5
TOTAL HEATED	IBAB SF.	2 8
OTHER AREAS UNDER ROOF:		
6ARAGE	366 SF.	381 9
FRONT PORCH	22 SF.	. 22 9
TOTAL UNDER ROOF	2236 SF.	2338 5
OTHER:		
OPT. BAY	14 SF.	. 18 5
STD. PATIO	9 SF.	9 5
OPT. PATIO	100 SF.	. 100 9

GENERAL NOTES	
•	
STAIR NOTES	

PER IRC 311.5

BUILDER: DOVE HOMES LLC

ORG. DATE: 2021-04-09 REVISIONS:

SOUTHERN YELLOW PINE SPECIFICATION SQUARE SQUARE FEET/FOOT STEE!

FOOTING FOUNDATION FIXED GLASS, GLAZING

RHANG R HEAD DOOR

WALLS: ALL EXTERIOR WALLS CONST. ARE MEASURED AT 4" THICK ACCOUNTING FOR THE STUD AND 12" SHEATHING WITH DOUBLE TOP PLATE. ALL INTERIOR WALLS ARE MEASURED AT 3 12" ACCOUNTING FOR THE STUD ONLY EXCLUDING DRYWALL UND, ALL WALLS BETWEEN THE UNCONDITIONED GARAGE AND THE CONDITIONED HOME SPACE ARE MEASURED AT 3 12" AND THE OUTSIDE EDGE OF THE STUD SHALL BE INJURE WITH THE EDGE OF THE FOUNDATION BELOW ALLOWING THE DRYWALL TO OVERHANG THE FOUNDATION HOUSE TO WALL DAY HOW AREAS SHALL HAVE STUDGS SPACED AT A MINIMUM OF 18" OC. TO ALLOW THE PREMENT INSTALLATION WALL THAT HE HEIGHTS AND WINDOWN THEADER HEIGHTS ARE NOTHED ON THE EXTERIOR ELEVATIONS, ALL DIMENSIONS WILL BE MEASURED FROM THE FRAMING MEMBER AND WILL NOT BELOW THE FOUNDATION HAVE A THE HEIGHTS AND WINDOWN THEADER HEIGHTS ARE NOTHED ON THE EXTERIOR ELEVATIONS, ALL DIMENSIONS WILL BE MEASURED FROM THE FRAMING MEMBER AND WILL NOT BELOW THE FOUNDATION HAVE A THE FOUNDATION HAVE A THE FOUNDATION HAVE AND THE FOUNDATION HAVE A THE FOUNDATION HAVE AND THE FOUNDATION HAVE A THE FOUNDATION HAVE A THE FOUNDATION HAVE AND THE FOUNDATION HAVE AND THE FOUNDATION HAVE A THE FOUNDATION HAVE AND THE FOUNDATION HAVE AND THE FOUNDATION HAVE A THE FOUNDATION HAVE AND THE FOUNDAT

RIOORS: UNLESS OTHERWISE NOTED, THESE PLANS ARE DESIGNED FOR AN ENGINEERED WOODTRUSS SYSTEM, DIRECTION OF TRUSSESSIOISTS ARE NOTED ON THE RECORD PLANS, HOWEVER ACTUAL DEPTH AND SHACINS AND YEAR THE MALL FACILIZED SYAL BRIST FLOOR SYSTEMS (OR BASEJENTS ANDORS CEAM, SPACES COLD DEE CONVENTIONAL FRAMED, ALL CONVENTIONAL FRAMED, BLUST BE IN ACCORDANCE WITH THE BUILDING CODE IT IS ASSUMED THAT THE SUBGOOR WILL BE 34" THICK PLYWOODISHEATHING. OTHER MATERIALS MUST COMPLY WITH BUILDING CODES, FINISHED FLOORS MY OR MAY NOT BE NOTED IN THIS PLAN ACCORDING TO BUILDING THE PREFERENCE. IN ALL CASES, ALL SUBCONTRACTORS SHOULD VERIFY FINISHED MATERIALS WITH THE CONTRACTORBUILDER AS THE ACTUAL MAY DIFFER THE PROVIDER AND THE PROVIDER AS THE ACTUAL MAY DIFFER THE PROVIDER AND THE PROVIDER AND THE PROVIDER AS THE ACTUAL MAY DIFFER THE PROVIDER AND THE PROVIDER AND THE PROVIDER AS THE ACTUAL MAY DIFFER THE PROVIDER AND THE PROVID

FOUNDATIONS; ALL SPREAD & STRIP FOOTINGS SHALL BE SUPPORTED ON SOIL WITH A BEARING CAPACITY OF NOT LESS THAN 2,000 PSF. THIS SHALL BE VERIFED BY A GEOTECHNICAL ENGINEER WHOSE RECOMMENDATIONS SHALL BE STRICTLY ADHERED TO. THE FOOTING SUBGRADE EVALUATION WILL BE PROVIDED AT EACH JOB SITE AND WILL BE AVAILABLE FROM THE TIELD MANAGER.

GENERAL CONSTRUCTION INFORMATION

ABBREVIATIONS

SAVED: AMCBRIDE

THIS SET OF CONSTRUCTION DOCUMENTS WAS PRODUCED BY BUILDERS PLANSOURCE, INC. (BPS), BUILDERS PLANSOURCE, INC. (S 24.12" MULL HEIGHT ARE RECOVED A PRESIDENTIL PLANINASOBATHUS FIRM AND HAS PROVIDED A DRAFTING SERVICE ONLY. THE HOME BUILDERIGENERAL CONTRACTION SHALL BE RESPONSIBLE FOR THE FOLLOWING ATTRIBUTES OF ANY PROLECT ASSOCIATED WITH THIS SET OF CONSTRUCTION DOCUMENTS. (1) APPOINTING ALCIONEDS STRUCTURAL ENGINEER TO VERIFY (USE 14" FLOOR S

9:1 1/2" WALL HEIGHT 15 TREADS AT 10" / 16 RISERS = 124 1/4" - VERIFY ON SITE SYSTEM WITH 3/4" PLYWOOD SUBFLOOR) RISERS = 112 1/4" - VERIFY ON SITE

ANDORS SECIFY ANY OR ALL STRUCTURAL COMPONENTS
INCLUDINS BUT NOT LIMITED TO PAFTERS, TRUSSES, CELLING
JOSTS, ROCA DOSTISSYSTEMS, GRIDERS, SELMS, WILL
BRACINGESEGN, FOLHOLITON WALLS AND FOOTINGS, ETC.
(2) VERIPTING ALL COMPONENTS OF THESE DRAWNASS, PRIOR TO
BEGINNATION FOR THE STRUMENT NOW.

WEIGHT FATURES, MEASUREMENTS, ROOM SIZES, ROOF
PITCHES, MINDOVINDOR BUT FOUNDATIONAL

(3) VERIPTING BUILDING CODE COMPLIANCE TO ALL SPECIFIC
PROPAULIDING TO THE SPECIFIC DATA TO MEET ALL
SPECIFIC CODES, THE BUILDER COMPLIANCE TO ALL SPECIFIC
STATES, HE CAN NOT GUARANTEE OUR PLANS TO MEET ALL
SPECIFIC CODES, THE BUILDER COMPLIANCE TO ALLS FERSISTED AND ACHIEFT OF HERRS SPECAPE STATE TO VERIETY
AND GUARANTEE CODE COMPLIANCE

(4) VERIPTING EACH SPECIFIC LOT CONDITION AND REQUIREMENTS
TO BUSINE POSTITE DURANGE AND COMPLIANCE TO ALL
FEDERAL STATE, AND LOCAL CODES.

BUILDING CODE COMPLIANCE

ALL CONSTRUCTION TO COMPLY WITH LOCAL L CODES AND ORDINANCE CURRENTLY IN USE WITH THE LOCAL JURISDICTION

FOLLOWALL APPLICABLE STATE AND LOCAL CODES.

ONE NORTH CAROLINA STATE SUPPLEMENTS AND AMENDMENTS

APPLICABLE CODES:

CONTRACTOR AND BUILDER SHALL REVIEW CONSTRUCTION. BY USING THESE DRAWING RESPONSIBILITY OF THE BUILDER AND CONT

PRODUCT: SINGLE FAMILY RESIDENCE

CONSTRUCTION TYPE: V-B

RODE: UNLESS OTHERWISE NOTED, THIS PLAN IS DESIGNED FOR AN ENGINEERED ROOF TRUSS SYSTEM, DIRECTION OF TRUSSES ARE NOTED IN THE PLANS HOWEVER THE ACTUAL TRUSS SIZE SPACING MAY VARY ACCORDING TO THE MANUFACTURER RECER TO THE MANUFACTURERS LAYOUTSHOP DRAWINGS FOR ACTUAL REQUIRED TRUSS INFORMATION. BE DONE IN ACCORDING THE THIN THE TRUSS MANUFACTURER AND/OR THE CURRENT SHULDING CODE.

BUILDING CODE.

ROOF SLOPES LESS THAN 4 IN 12, UNDER LAYMENT SHALL CONSIST OF 2 LAYERS OF 15# FELT PAPER.

ROOF SLOPES GREATER THAN 4 IN 12, UNDER LAYMENT SHALL CONSIST OF 1 LAYER OF 15# FELT PAPER.

HORIZONTAL ACCESS DOORS FROM CONDITIONED SPACE TO UNCONDITION SPACES SHALL BE WEATTERSTRIPPED AND INSULATED TO R-10. PULL DOWN STAIRS SHALL BE WEATTERSTRIPPED AND INSULATED WITH A MINIMUM R-S. FULL SIZED DOORS THAT ARE PART OF THE THERMAL ENVELOP AND PROVIDE PASSAGEWAY TO UNCONDITIONED SPACES SHALL BE ONE SIDE HINGED OPAQUE DOORS LESS THAN 24 SQ.FT.

BASEMENT WALLS CONCRETE SLAB-ON-GRADE

CANTILEVER FLOORS
CRAWL SPACE FLOORS NSULATION VALUES CEILINGS

P P P P P 8

ENERGY EFFICIENCY: ENERGY EFFICIENCY COMPUNICE SHALL BE DEMONSTRATED PER A STATE SPECIFIC RESCHECK INDICATING THE REQUIRED INSULATION AND ENERGY EFFICIENCY CERTIFICATE SHALL BE USED TO VERIFY REQUIRED COMPUNICE.

THE STRATION CRITERIA. THE RESCHECK PRODUCED INSPECTION CHECKLIST AND ENERGY EFFICIENCY CERTIFICATE SHALL BE USED TO VERIFY REQUIRED COMPUNICE.

GRAPHIC LEGEND

POUNT / WEIGHT MANUFACTURE MASONRY OPENING MASTER MAXIMUM

EXTERIOR WALLS

INTERIOR WALLS

ELEVATION MATERIALS

STUCCO

W/ BRICK VENEER

OPTIONAL WALL

BRICK VENEER

OPT, DOOR

(HT. AS NOTED)

(HT. AS NOTED)

VINYL SHAKI SIDING AS SPECIFIED

STONE VENEE


2X6 WALL

MINDOW SPECIFICATIONS: U-FACTOR .31, SHGC-.29 DOUBLE GLAZES, LOW E, GBC7/8, ARGON GAS, STRUCTURAL DESIGN PRESSURE RATING ± 35 ALL GLAZING HAZARDOUS IN LOCATION SHALL BE TEMPERED SAFTEY GLASS, ALL SIDELITES AT FRONT DOOR MUST BE TEMPERED. EVERY SLEEPING ROOM SHALL HAVE AT LEAST ONE OPERABLE EMERGENCY ESCAPE AND RESCUE OPENING WITH A MINIMUM NET CLEAR OPENIABLE AREA OF 4 SQUARE FEET, WITH MINIMUM NET CLEAR OPENING HEIGHT OF 22 NICHES AND MINIMUM NET CLEAR OPENING WIDTH OF 20 NICHES, ALSO MUST HAVE A MINIMUM TOTAL GLAZING AREA OF NOT LESS THAN 5 SQUARE FEET ON GROUND FLOOR LEYEL WINDOW AND NOT LESS THAN 5,7 SQUARE FEET IN THE CASE OF AN UPPER STORY WINDOW.

DODGSMINDOMS, ALL DOOR AND WINDOW SIZE, STYLE, AND DESIGN SHOULD BE VERRIED WITH THE BUILDERCONTRACTOR PRIOR TO ORDERING, DOOR AND WINDOW MOTATIONS (TAGS), ARE NOTED IN FEET AND INCHES, THEREFORE THE FIRST TWO INJMESSES REPRESENT THE HOWITH IN FEET AND INCHES, THE LAST TWO INJMESS REPRESENT THE HOWITH IN FEET AND INCHES, THE MAINT, AS SOOD, THE WINDOW IS 3°D WIDE BY 5°D HIED WINDOW IS 3°D WINDOWS, TRANSOM WINDOWS, SHEETROCK OPENINGS, CASED OPENINGS, ETC.

유	
PLAN NAME	PLAN#
BROOKE	RH
COVER	

	_	
_	4	
-		
•		

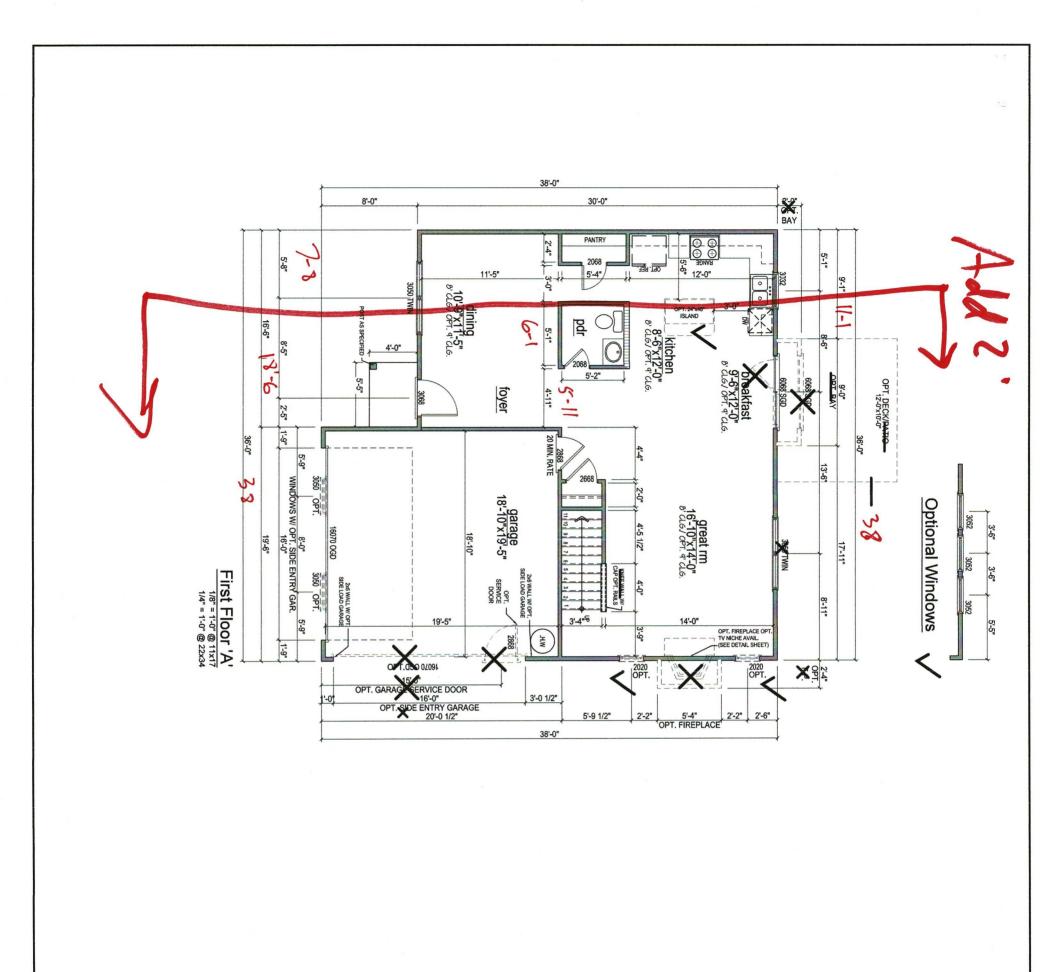

PLAN NOTES

SEE ELEVATIONS FOR WINDOW AND DOOR HEADER HEIGHTS

ALL EXTERIOR WALLS ARE DRAWN AT 4" U.N.O. W/ STUD SPACING AT 16" O.C.

REFER TO PLANS AND ELEVATIONS FOR WALL PLATE HEIGHTS, COVER NOTES CONTAIN STAIR CONST. INFORMATION.

COPYRIGHT INFORMATION

COPYRIGHT INFORMATION

COPYRIGHT OF THE SECTION O


THS RESIDENCE IS NOT DESIGNED FOR A SPECIFIC LOTHERADE CONDITION. IT IS THE BULDEN'S REPONDENTED HAVE SIZE FOUNDATION HALLS, POSTINE DIVANMES, AND GRAVING HAS CAPPLEED AND/OR, INSTALLED IN ACCORDINATE HITH CURRENT. STATE AND LOCAL BULDING CODES.

ALL NIEROR HALLS ARE TO BE HEASURED AT 3 1/2" IMLESS NOTED OTHERWISE EXTERIOR HALLS ARE 4" INLESS OTHERWISE NOTED. SOME THISHED IMITERIALS SICH AS FLOOR CONFRINCS, WALL CONERINGS, AND ANY RELATED TRIM MORK MAY NOT BE FOUND IN THESE PLANS, THESE TIEMS ARE TO BE DETERMINED BY THE BUILDER. ALL CHROLIEN COMPONENTS NELLONS, BIT WIT INFED TO SALD REJORG, EEMS, HE ONTE SELVE PE SALT SALE RESULT PROSE LOSIS SERVIS MELLS TO SALE LE SALE SALE RESULT PE NELCOZOMEZ HITI CARCENT SALE RESULT CONTROL DEL LOSIS TO SALE RE EXPONENTE SALE BLUCHS DI SALEMPARNI A RESULT RESULT PO TO SELVE PE SALE COMPONENTS. BILLOSIS DI MI SOLECE NO, MANTE ANDRECCOMI NO PROVIDED A REVENTE SERVIC ONL' NO SALLI NOT RE HELD LIGHE FOR STRUCTIENA. COMPONENTS FOND MITHER LAS. BILDES FLAKORCE IK. (MANDLANSKLOAM) IS NOT RESPONSELE FOR FINISHED RESUBEKE HETING YOR LOCAL CODES, AN COMSTRUCTIN DETAUS THAT ARE NOT SPELIFICALLY SYMM IN THESE PLAYS SHALL ER COMSTRUCTION IN ACCOUNTER WITH BEIERAL REMAINS PRACTICES THAT MOLD BE FOAND IN SHILLAR COMMITTONS AND MATERIALS ALL CONTRACTOR'S CONSTRUCTION SHALL COMPLY WITH ALL APPLICABLE STATE AND LOCAL BRILDING CODES. BPS (NAM PLOTS IT COM) - GENERAL INFORMATION
ALL CONTRACTORS SHALL REVIEW AND VERIFY ALL DIRECTORS BEFORE BESINNIS ANY
NORK

PLAN# RH BROOKE FIRST FLOOR PLAN ELEVATION A

4.10A

SAVED: AMCBRIDE

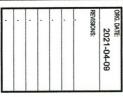

(2) HOSE BIBS SHALL BE INSTALLED, LOCATION TO BE DETERMINED BY PLUMBING CONTRACTOR

VERIFY LOCATION OF HVAC CONDENSOR WITH FIELD MANAGER.


APPLY 172" GYP. BD. ON ALL GARAGE WALLS AND 5/8" TYPE X GYP. BD. ON GARAGE CEILING.

BUILDER: DOVE HOMES LLC

ALL INTERIOR WALLS ARE DRAWN AT 3 1/2" U.N.O. ALL LOAD BEARING WALL CONST. @ 16" O.C. W/ DBL TOP PLATE U.N.O.

ADDRESS: BUILDERS PLANSOURCE, INC. PO BOX 836 KING, NORTH CAROLINA 27021 PHONE: 336-985-0363



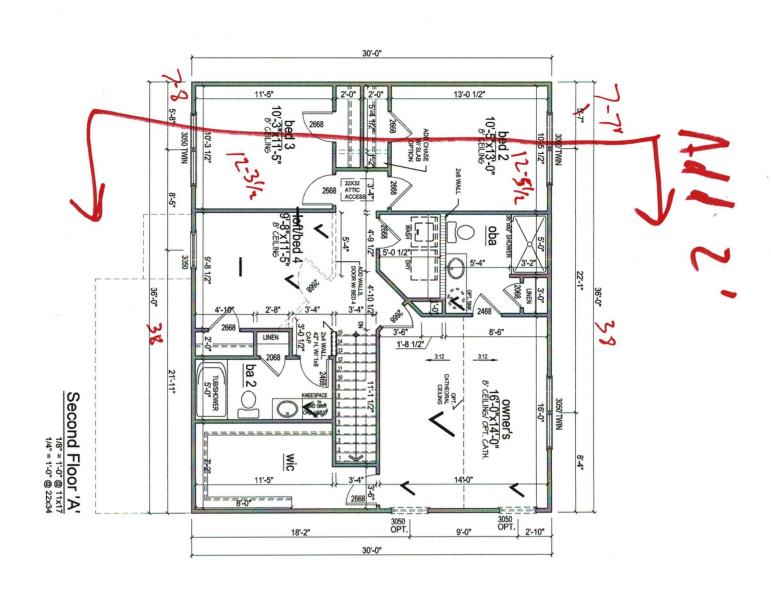

PLAN NOTES

REFER TO PLANS AND ELEVATIONS FOR WALL PLATE HEIGHTS, COVER NOTES CONTAIN STAIR CONST. INFORMATION.

SEE ELEVATIONS FOR WINDOW AND DOOR HEADER HEIGHTS

ALL EXTERIOR WALLS ARE DRAWN AT 4" U.N.O. W/ STUD SPACING AT 16" O.C.

COPYRIGHT INFORMATION

copyright Bill JESS Practicates, list, All Rights Reserved. The sole, metal, or any other abilitation of these drawings to any other organization or party is strictly final fibration alless additional in writing big FS list. This form on produced through the list-base organization and produced which is the sole organization of produced any other lists and organization and organization and organization and organization of produced any to organize the lists of the sole.

ALL NITRIOR WILLS ARE TO BE NEVSURED AT 3 UZ* INLESS NOTED OTHERWISE, EXTERIOR WILLS ARE 4" INLESS OTHERWISE NOTED. SOME FINGHED MATERUALS SICKI AS FLOOR COMPRINES, MALL COMPRINES, AND MY RELATED TRIM MORK MAY NOT BE FOUND IN THESE FLANS, THESE ITEMS ARE TO BE DETERMINED BY THE BUILDER. THS RESIDENCE IS NOT DESIGNED FOR A SPECIFIC LOTICIAUX CONDITION IT IS THE BILLORS'S REPORTBELLTY OF MACE SIZE FONDATION HALLS, POSITIVE DRAINACE, AND GRAVING ARE CORPLETED ADVICE INSTITLED IN ACCORDINACE HITH CURRENT STATE AND LOCAL BILLDING CODES.

ALL STRUTINAL COMPANIOTS NATIONS, BIT NOT LIMITED TO SALD INFORMES, IRANG, HE NATION, VALLET, NAMEDO, MOZESS, PERS, LOPIS, ERANGH NALLI, ETC. SHALL RE SALD NAMED RESPONDED TO THE RECORD NAMED RESPONDED TO THE RECORD NAMED RESPONDED TO THE RESPONDED TO THE SALD COMPANION OF THE SALD LIMITED TO TH ALL CONTRACTOR'S CONSTRUCTION SHALL COMPLY WITH ALL APPLICABLE STATE AND LOCAL BRILDING CODES.

BPS (NUMPLOTS IT.COM) - GENERAL INFORMATION ALL CANTRACTORS SHALL REVEN AND VERBY ALL DIRECTORS BEFORE BEGINNING ANY MORE.

PLAN# RH BROOKE SECOND FLOOR PLAN ELEVATION A

4.20A

SAVED: AMCBRIDE

BUILDER: DOVE HOMES LLC

ALL INTERIOR WALLS ARE DRAWN AT 3 1/2" U.N.O. ALL LOAD BEARING WALL CONST. @ 16" O.C. WI DBL TOP PLATE U.N.O.


(2) HOSE BIBS SHALL BE INSTALLED, LOCATION TO BE DETERMINED BY PLUMBING CONTRACTOR

ORG. DATE: 2021-04-09

VERIFY LOCATION OF HVAC CONDENSOR WITH FIELD MANAGER. APPLY 112" GYP. BD. ON ALL GARAGE WALLS AND 518" TYPE X GYP. BD. ON GARAGE CEILING.

> ADDRESS: BUILDERS PLANSOURCE, INC. PO BOX 836 KING, NORTH CAROLINA 27021 PHONE: 336-985-0363



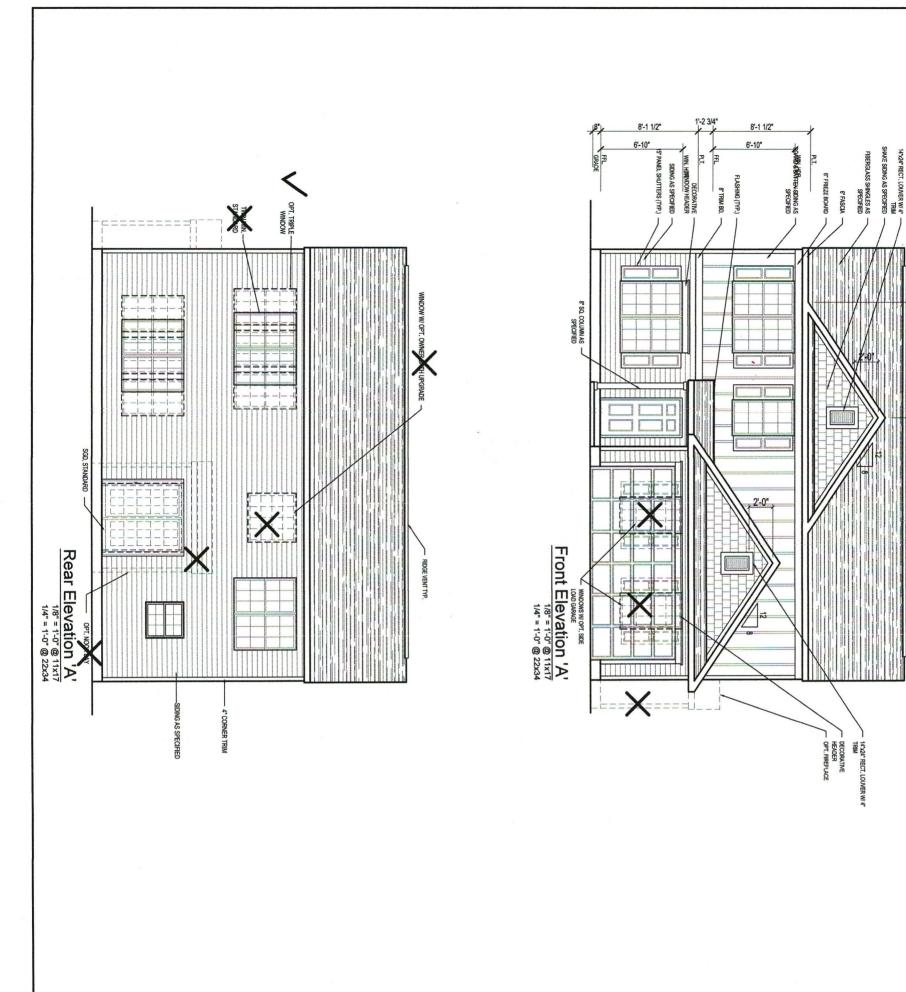

BPS (NAMA DIORS INC. COM) - GENERAL INFORNATION ALL CONTRACTORS SHALL REVEN AND VEREY ALL DIVERSIONS EFFORE ECANNIC ANY NEW.

ALL CONTRACTORS COMENDATION SHALL COPETY WITH ALL APPLICABLE STATE AND COLAN BILLIPSE COPES.

BILLIPSE PLANEAURC, INC. DANIPLANSH COPE IS NOT RESPONSEL FOR RINGHED FREEZONS IN THE CASE THAT TO SALD READOWNERS THAT SHALL SH

4'-6 1/2"

RIDGE VENT TYP.

5.10A

BROOKE	RH	Y
DRAWING:		
FRONT AND REAR	ELEVATION A	









ADDRESS: BUILDERS PLANSOURCE, INC. PO BOX 836 KING, NORTH CAROLINA 27021 PHONE: 336-985-0363



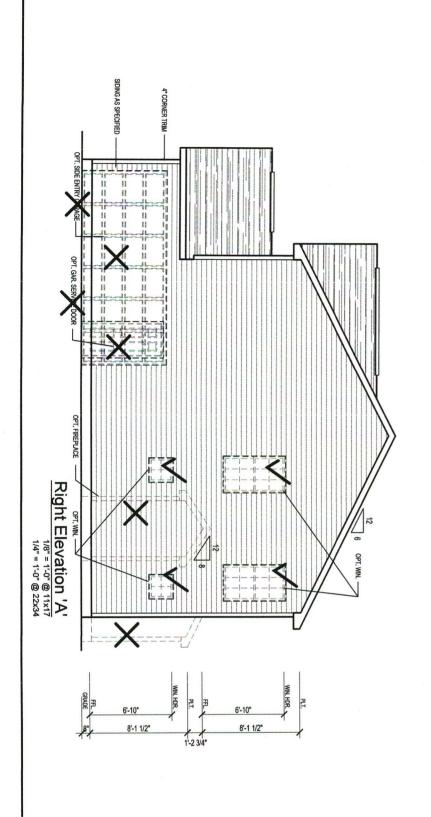

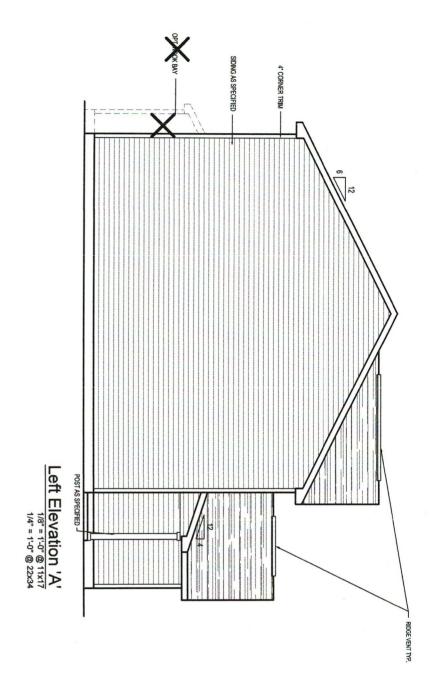

BPS (NIMICIDIS INCLORN) - GENERAL INFORMATION
ALL CONTRACTORS SIMIL RAVEN AND VERRY ALL INFERGORS BEFORE BECANNIK ANY
NOR.

ALL CONTRACTORS SIMIL RAVEN AND VERRY ALL INFERGORS BEFORE BECANNIK ANY
NOR.

ALL CONTRACTORS CONSTRUCTION SIMIL CONFLY WITH ALL APPLICABLE STATE AND
BALDESS FLAVENAGE IN CONFLAVENCY AND SIMIL RECORDING SIMIL FOR SIMILER
BALDESS FLAVENAGE IN CONFLAVENCY AND SIMIL CONFIDENCE IN MARKED
BALDESS FLAVENAGE IN CONFLAVENCY AND SIMIL AND SIMILER SIMILE

PLAN NAME
BROOKE
DRAWING:
LEFT AND RIGHT ELEVATION A


SAVED: AMCBRIDE	IN	APPROVED BY:		DRAWN BY:						
-----------------	----	--------------	--	-----------	--	--	--	--	--	--

2021-04-09

BUILDER:
DOVE HOMES LLC
.
.





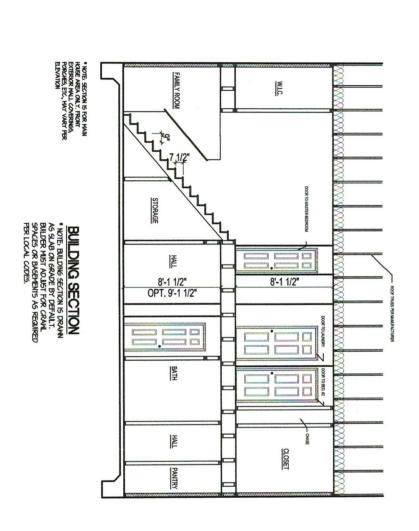

BPS (NAW PICROSIC COM) - GENERAL, INFORMATION
ALL CONTRACTORS SHALL REVEN AND YEARY ALL. DIRECTORS BEFORE BECAMBE ANY MORE.

ALL CONTRACTORS SHALL REVEN AND YEARY ALL. DIRECTORS BEFORE BECAMBE ANY MORE.


ALL CONTRACTORS CONSTRUCTORS SHALL COPELY WITH ALL APPLICABLE FOR FRISHED BECAMBE FERTHER FOR FRISH BELLOW LOCKEL, WHITE ALL AND COPELLOW BE CONSTRUCTION BETWEEN THE FRISH FRISH BELLOW LOCKED BY SHALL CONSTRUCTION BETWEEN THE SHALL CONSTRUCTION BETWEEN THE SHALL CONSTRUCTION BETWEEN THE SHALL CONSTRUCTION BY SHALL CONSTRUCTION BETWEEN THE SHALL CONSTRUCTION BY SHALL


PRAN NAME
BROOKE
DRAWING:
BUILDING SECTION



PLAN#

RH

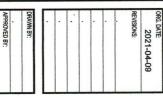


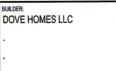



PHONE: 336-985-0363



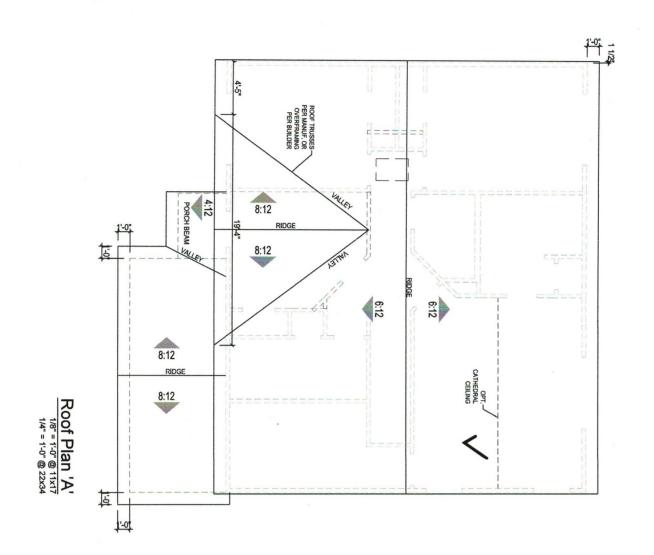

ATTIC VENTILATION

1258 SQ.FT. OF CLG. /300 = 4,19 REQ.

1258 SQ.FT. OF CLG. /300 = 1,19 REQ.

1258 SQ.FT. PER FT. 48-17 x .125 = (5,77)

SQ.FT. VENT = .052 SQ.FT. PER FT. 307-47 x .082 = (5,60)

101AL SQ.FT. VENTILATION PROVIDED (11.37)

7.10A

PLAN# PLAN NAME **BROOKE** RH ROOF PLAN ELEVATION A

SAVED: AMCBRIDE

BUILDER: DOVE HOMES LLC

ADDRESS: BUILDERS PLANSOURCE, INC. PO BOX 836 KING, NORTH CAROLINA 27021

COPYRIGHT INFORMATION

COPYRIGHT INFORMATION

COPYRIGHT BELDES Parkenva, Inc. All Regist Reserved. The sale, relaid or any other abilitation of these distribution of prices a surface produced under congression or prices a surface produced with the parkens of the surface produced and the surface produced with the prices of the surface produced with the line of the surface produced with the line of the substitution of the su



BILDES PLANGANCE, IN. (MANTELANERIC COM 5 NOT RESPONSED FOR FRIENDS
RESUBELE RETIRE YORK LOCAL COMES, MY CONSTRUCTION DEFINED THAT ARE NOT
SECRETALLY SHARM IN THESE PLANS SHALL BE CONSTRUCTION IN CONSTANCE THAT
BERGIL PRANSE PRACTICES THAT HOLLD BE TONG IN SHELL ACCIDITION AND
MINISTELL.

ALL CONTRACTOR'S CONSTRUCTION SHALL COMPLY MITH ALL APPLICABLE STATE AND LOCAL BRILDING CODES. BPS (NAM PIONSITE COM) - GENERAL INFORMATION ALL CONTRACTORS SHALL REVIEW AND VERREY ALL DIFFLECOE BESINNING ANY MORE.


ALL STRUMENT, CAPPORTES BY LUDING BIT MOT LIMITED TO SOLD READERS, BEWING HE WHITES, WALLES GRAVE BY THE LOCKEST SAME WAS LIST OF SHALL BE LOOK COPES. IT WALLES THE DESCRIPTION OF THE BULLERS TO MESHAPPININ A RESERVED DAMA THE SHALL BY THE BULLERS TO MESHAPPININ A RESERVED WAS LIST OF THE SHALL BY TH

ALL NIBBOR MALLS ARE TO BE KEASURED AT 3 UZ WALES NOTED OTHERWISE EXTERIOR MALLS ARE 4" WALES OTHERWISE NOTED. SOME PANSHED HATERUALS SUCH AS FLOOR COVERNAS, MALL COVERNAS, AND ANY RELATED TRAM MORK MAY NOT BE FOUND IN THESE FLANS, THESE TEMS AND TO BE DETERMINED BY THE BUILDER.

THIS RESIDENCE IS NOT DESIGNED FOR A SPECIFIC LOTISANCE CONDITION. IT IS THE BILLDRES REPORTISED TO MAKE SIZE FOUNDATION MALLS, ROSTING DRAINAGE, AND GRADING MACCORDINGE THE AND/OR INSTALLED IN ACCORDINGE MIT CARRENT. STATE AND LOCAL BILLDRIG CODES.

2021-04-09

FAX: 336-985-0884

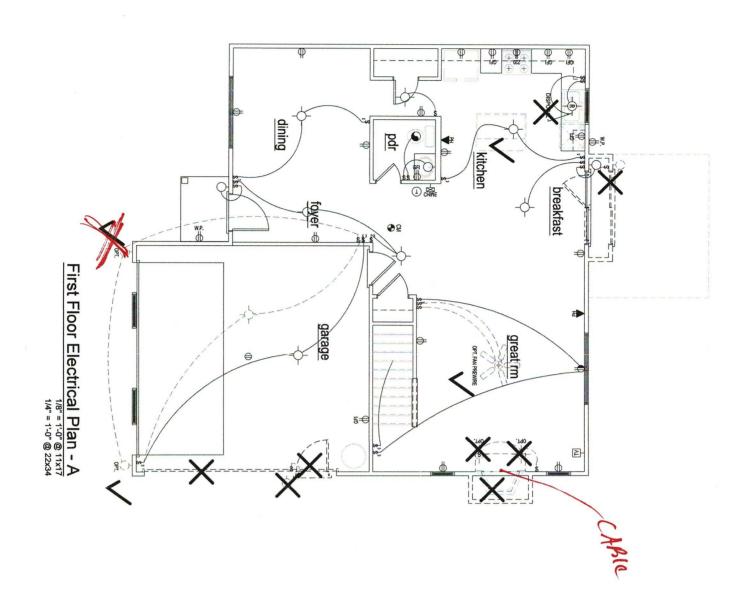

A MINIMAM OF 75 PERCENT OF ALL THE LAMPS IN PERMANENTLY INSTALLED LIGHTING FIXTURES SHALL BE HIGH-EFFICACY LAMPS, (M104.1)ELECTRICAL LAYOUTS ARE PROVIDED AS A GENERAL SUIDE AND ACTUAL LAYOUT MAY VARY, IN ALL CASES THE ELECTRICAL SUBCONTRACTOR IS RESPONSIBLE FOR COMPUANCE WITH LOCAL STATE, AND INATIONAL CODES. **⊕**& NOTE: OVERHEAD LIGHTS, PHONE OUTLETS, TV CABLE OUTLETS AND RECESSED LIGHTING MAY NOT BE INCLUDED STANDARD BY THE BUILDER, PLEASE CONSULT WITH THE BUILDER TO DETERMINE WHAT APPLICABLE STANDARDS APPLY IN THIS HOME. ISTALL AFCI OUTLETS IN REQUIRED LOCATIONS PER THE NATIONAL ELECTRICAL CODE 8 0 **₫ ELECTRICAL LEGEND** (- FLOURESCENT LIGHT THREE-WAY SWITCH FOUR-WAY SWITCH NOTE: - "L" DENOTES LED FIXTURE PENDANT LIGHT CEILING FAN ELEC. PANEL BOX CABLE TELEVISION SMOKE DETECTOR - SMOKE/CAREON MONOXIDE DETECTOR RECESSED LIGHT CEILING FIXTURE TELEPHONE FLOOR DUPLEX RECEPTACLE CEILING DUPLEX RECEPTACLE 220 RECEPTACLE GROUND FAULT DUPLEX RECEPTACLE WATERPROOF GFI RECEPTACLE SPLIT-WIRED DUPLEX RECEPTACLE DUPLEX RECEPTACLE SINGLE POLE SWITCH DOOR CHIME SCONCEWALL LIGHT EXHAUST FAN RECESSED DIRECTIONAL LIGHT EXHAUST FAN W/ LIGHT - 9 8 € Θ •

PLAN# RH BROOKE FIRST FLOOR ELECTRIAL PLANS

2021-04-09

BUILDER:

ADDRESS: BUILDERS PLANSOURCE, INC. PO BOX 836 KING, NORTH CAROLINA 27021 PHONE: 336-985-0363

COPYRIGHT INFORMATION

COPYRIGHT INFORMATION

ABSTRAIN of base drawing, it. All Rights Reserved. The sole, rend, or all other
abstrain of base drawing to any other corporation or purity is sticilly in-middled lenses
adherized in writing a IRFS in. This form so produced through to imitated any seement with
ESF, therefore adherized to puriticate to adherized and destrate the pian on Researcy to
ball multiple incere. Any other adjunctions or elederation to orother balds to provide a
ball multiple incere. Any other adjunctions or elederation to orother balds to provide a
ball multiple incere. Any other adjunctions or elederation to orother balds to provide a
ball multiple incere. Any other adjunctions or elederation to orother balds to provide a
ball multiple incere. Any other adjunctions of the sole.

THS RESIDENCE IS NOT DESIGNED FOR A SPECIFIC LOTISANJE CONDITION. IT IS THE BULDRES, RESPONSIBILITY TO MAKE SIDE FOUNDATION INLLS, ROSTINE DRAINAGE, AND GRAVING MAKE CAPPLEIDD AND/OR, INSTALLED IN ACCORDINACE MITH CURRENT STATE AND LOCAL BULDING CODES. ALL NIEROR HALLS ARE TO BE NEASHED AT 3 UZ WLESS KOTED OTHERWISE EXTERIOR HALLS ARE 4" INLESS OTHERWISE KOTED. SOME THISHED MATERIALS SICH AS FLOOR CONFRINCS, WALL CONERINGS, AND ANY RELATED TRIM MORK MAY NOT BE FOUND IN THESE PLANS, THESE TIENS ARE TO BE DETERMINED BY THE BUILDER.



ALL CONTRACTOR'S CONSTRUCTION SHALL COMPLY WITH ALL APPLICABLE STATE AND LOCAL BALDING CODES. EPS (NAMA DICASING COM) - GENERAL INFORMATION ALL CANTRACTORS SHALL REVEN AND VERIFY ALL DIRECTORS BEFORE BESINNING NAY FORK.


BILDES FLAKORCE, IK., (MAFILANSK.COM) IS NOT RESPONSBLE FOR FINISHED RESUBENC BETING YORK LOCAL COMES, ANY COMSTRUCTION BETALS THAT ARE NOT SPECIFICALLY SHAME IN THESE PLANS SHALL DE COMSTRUCTION IN CONSOLVANCE THAT SHEEPAL FRANSIS PRACTICES THAT MOLD THE FOADO IN SHALLAR COMMICHS AND YATERALS.

ALL STRUCTURAL COMPANENTS MALLOWS, BIT WIT LIMITED 10 SOLD HAUSES, BEN'S, HE PONTERS, WALLEY RAFFES, MORTS PERSO, DISTS, REWISH MALLOWS, BIT C. SAMLE BEIND ROWS, MIT WASHINGTON, BIT WASHINGT


8.10

SAVED: AMCBRIDE

DOVE HOMES LLC

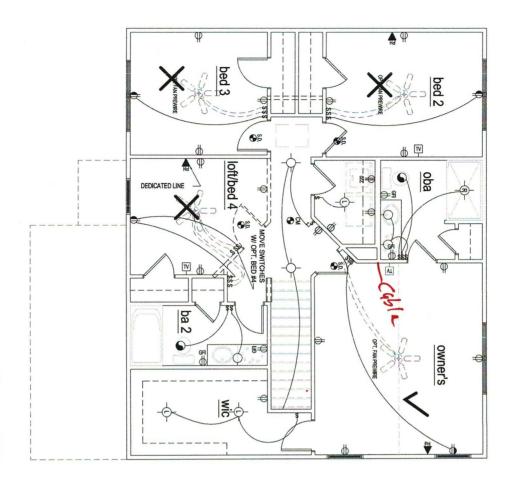



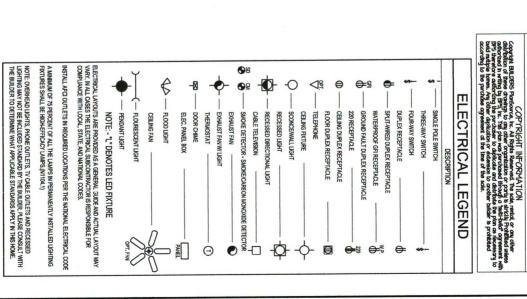


PLAN NAME PLAN#

BROOKE RH

DRAWING:

8.20 SECOND FLOOR ELECTRIAL PLANS

PPROVED BY: JJT SAVED: AMCBRIDE	JJT SAVED: AMC
N BY:	DRAWN BY:

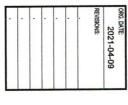

BUILDER: DOVE HOMES LLC .





BPS (NYMY PLOTSING COM) - GENERAL INFORMATION ALL CANTRACTORS SHALL RAYEN AND YERFY ALL DARBOAS BEFORE BESINNES ANY ALL CANTRACTORS CASESTRUCTION SHALL COMPLY WITH ALL APPLICABLE STATE AND COCAL BILLING CODES.

BILDES FLAKONZE IK. (MAFILANSKZOM) IS INT REPOKRET FOR FINSHED RESIDEKE RETING YOR LOZAL (OZES. MI COMSTRUTINI DETAUS TIMI, MER INT PELFALLY SYMM IN EKEE PLAKS SYMLE ELOMBROTION IN KOZOMAKE MINI BEBUL FRAMIS PRACINZS TIMI POLID TE FOND IN SHILAR COMTIONS AND MATERIALS.

AL STRUTINAL COMPANIES KLUDIK, BIT WIT IMITED TO SALD BELODE, BENK HE ANTEN AL TENDE AL ROCK PICK, DE SALW KLUSI EN EN EL SALW KLUSI EN EL SALW KLUSI EN EL SALW KLUSI EN EL SALW EN EL SALW KLUSI EN EL SALW COMPANIE EN EL SALW

20.4, -21.3	19.9, -20.7	19.2,-20.0	ZONE 3 16.7, -21.0 17.3, -22.1 16.2, -22.3 16.7, -23.3 20NE 4 18.2, -19.0 19.2, -20.0 19.9, -20.7 20.4, -21.3	ZONE 4
18.7, -23.5	18.2, -22.9	17.5,-22.1	ZONE 2 16.7, -21.0 17.5, -22.1 18.2, -22.9 18.7, -23.5	ZONE 2
18.7,-20.2	18.2,-19.6	17.5,-18.9	16.7,-18.0 17.5,-18.9 18.2,-19.6 18.7,-20.2	ZONE 1
40'1"-45'	35'1"-40'	30'1"-35'	MEAN ROOF HT. UP TO 30' 30'1"-35' 35'1"-40' 40'1"-45'	MEAN ROOF HT.

00

00

8.7. Basic Structural System (check one)

Bearing Wall

Building Frame

Moment Frame

Dual w/ Special Moment Fram

Dual w/ Intermediate R/C or

Dual w/ Intermediate R/C or Special Steel

Dual w/ Special Moment Frame

8.6.1. $V_X = 8.6.2$. $V_Y = 8.6.2$

8.8. Arch/Mech Components Anchored 8.9. Lateral Design Control: Seismic Assumed Soil Bearing Capacity

Wind ⊠

2000psf



STRUCTURAL PLANS PREPARED FOR:

BROOKE

PROJECT ADDRESS: OWNER: John Dove 2516 Brook Crossing Circle Raleigh, NC 27606

DESIGNER:

King, North Carolina 27021 Builders Plansource, Inc. PO Box 836

These drawings are to be coordinated with the architectural, mechanical, plumbing, electrical, and civil drawings. This coordination is not the responsibility of the structural engineering of record (SER). Should any discrepancies become apparent, the contractor shall notify SUMMIT Engineering, Laboratory and Testing, P.C. before construction begins.

PLAN ABBRIVATIONS:

AB	Anchor Bolt	000	On Center
ACI	American Concrete Institute	PCF	Pounds per Cubic Foot
ASCE	American Society of Civil Engineers	PCI	Pounds per Cubic Inch
AFA	American Fiberboard Association	PSF	Pounds per Square Foot
AFF	Above Finished Floor	PSI	Pounds per Square Inch
AISC	American Institute for Steel Construction	PT	Pressure Treated
APA	American Plywood Association	SC	Stud Column
AWS	American Welding Society	SER	Structural Engineer of Record
2	Ceiling Joist	S	Single Joist
CLR	Clear	SPF	Spruce Pine Fir
DBL	Double	SST	Simpson Strong Tie
D	Double Joist	ST	Single Truss
DSP	Double Stud Pocket	STD	Standard
ΕA	Each	SYP	Southern Yellow Pine
33	Each End	U	Triple Joist
EOS	Edge of Slab	TOF	Top of Footing
WEW	Each Way	TSP	Triple Stud Pocket
HDG	Hot Dipped Galvanized	TYP	Typical
NDS	Nation Design Spec. for Wood	ONO	Unless Noted Otherwise
SIN	Not to Scale	WWF	Welded Wire Fabric


_														
S8.0	\$7.0	\$6.0	S5.0	\$4.0	\$3.0	S2.0	S1.0b	S1.0c	S1.0s	S1.0m	CS3	CS2	CS1	Sheet No.
Second Floor Bracing Plan	First Floor Bracing Plan	Basement Bracing Plan	Roof Framing Plan	Second Floor Framing Plan	First Floor Framing Plan	Basement Framing Plan	Basement Foundation	Crawl Space Foundation	Stem Wall Foundation	Monolithic Slab Foundation	Revision Log	Specifications Continued	Cover Sheet, Specifications, Revisions	Description

WWW.SUMMIT-COMPANIES.COM

FAX: 704.504.1125

REVISION LIST.

EVISION LIST:			
Revision No.	Date	Project No.	Description

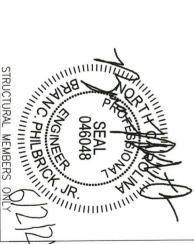

PROJECT # 2672.T0416

DATE 06/1/2021

REFER TO COVER SHEET FOR A COMPLETE LIST OF REVISIONS

ORIGINAL INFORMATION

SCALE: 1/8"=1'-0" DATE: 06/1/2021 DRAWN BY: KVW PROJECT #: 2672.T0416 CHECKED BY: BCP

CURRENT DRAWING CLIENT

PROJECT

Brooke - RH

Coversheet

John Dove 8626 Macedonia Lake Dr Cary, NC 27578

SUMMIT SUMIT SUMMIT SUMMIT SUMMIT SUMMIT SUMMIT SUMMIT SUMMIT SUMMIT SUM ATION WILLIAM

3575 CENTRE CIRCLE FORT MILL, SC 29715 OFFICE: 704.504.1717

SHEET LIST:

STRUCTURAL MEMBERS ON

GENERAL STRUCTURAL NOTES: 1. The design profession-1

be considered the same entity.

The structure is only stable in its completed form. The structure. No other party may revise, alter, or delete any structural aspects of these construction documents without written permission of SUMMIT Engineering, Laboratory & Testing, P.C. (SUMMIT) or the SER. For the purposes of this project. The SER bears the responsibility of the primary structural elements and the performance of this The design professional whose seal appears on drawings is the structural engineer of record (S these construction documents the SER and SUMMIT shall on these I (SER) for

during construction to stabilize the structure. The SER is not responsible for construction sequences, contractor shall provide all required temporary bracing

methods, or techniques in connection with the construction of this structure. The SER will not be held responsible for documents, should any non-conformities occur. the contractor's failure to conform to the contract

any construction begins. The shop drawings will be reviewed for overall compliance as it relates to the structural design of this project. Verification of the shop drawings for dimensions, or for actual field conditions, is not the responsibility of the SER or SUMMIT. Verification of assumed field conditions is not the responsibility of the SER. The contractor shall verify the field conditions for accuracy and report any discrepancies to SUMMIT before construction begins. Any structural elements or details not fully developed on the construction drawings shall be completed under the direction of a licensed professional engineer. These shop drawings shall be submitted to SUMMIT for review before

5

The SER is not responsible for any secondary structural elements or non-structural elements, except for the

FOUNDATIONS:

1. Foundatio elements specifically noted on the structural drawings. This structure and all construction shall conform to all applicable sections of the international residential code. All structural and all construction shall conform to all applicable sections of the 2018 North Carolina Residential Code (NCRC) and any local codes or restrictions.

Foundations shall be constructed in accordance with chapter 4 of the 2018 NC Residential Code (Special consideration shall be given to chapter 45 in wind zones 130 mph and above.)

2

Footing sizes are based on a presumptive soil bearing capacity of 2000 PSF. The contractor is solely responsible for verifying the suitability of the site soil conditions at the time of construction.

3

responsibility of the owner or the contractor. Should adverse soil condition be encountered the SER must Maximum depth of unbalanced fill against masonry walls to be as specified in section R404.1 of the 2018 NCRC. The structural engineer has not performed a subsurface investigation. Verification of this assumed value is the contacted before proceeding.

The bottom of all footings shall extend below the frost line for the region in which the structure is to be constructed. However, the bottom of all footings shall be a minimum of 12" below grade.

Any fill shall be placed under the direction or recommendation of a licensed professional engineer. The resulting soil shall be compacted to a minimum of 95% maximum dry density.

mil polyethylene membrane if placement of concrete not occur within 24 hours of excavation. Excavations of footings shall be lined temporarily with a 6

No concrete shall be placed against any subgrade containing water, ice, frost, or loose material. Each crawl space pier shall bear in the middle third of its respective footing and each girder shall bear in the middle third of the pier. Pilasters to be bonded to the perimeter

Crawl space to be graded level and clear of all debris. Proved foundation waterproofing and drain with positive

slope to outlet as required by site conditions. Energy efficiency compliance and insulation of the structure to be in accordance with chapter 11 of the

the same size/spacing

as the horizontal reinforcement

bends, or corner bars with

12.

STRUCTURAL STEEL: 1. Structural steel

Structural steel shall be fabricated and erected in accordance with the American Institute of Steel Construction "Code of Standard Practice for Steel Buildings Resistance Factor Design" latest editions. and Bridges" and the manual of Steel Construction "Load

unless otherwise noted. All steel shall have a minimum yield stress (F_y) of 36

American Welding Society's Structural Welding Code AWS D1.1. Electrodes for shop and field welding shall be class E70XX. All welding shall be performed by a certified welder per the above standards. Welding shall conform to the latest edition of the

CONCRETE Concrete shall have a normal weight aggregate and a minimum compressive strength (f.) at 28 days of 300 psi, unless noted otherwise on the plan.

Concrete shall be proportioned, mixed, and placed in accordance with the latest editions of ACI 318: "Building Code Requirements for Reinforced Concrete" and ACI 301: "Specifications for Structural Concrete for Buildings"

elements exposed to freeze/thaw cycles and deicing chemicals. Air entrainment amounts (in percent) shall be within -1% to +2% of target values as follows:

3.1. Footings: 5% Air entrained concrete must be used for all structural

3

Exterior Slabs: 5%

No admixtures shall be added to any structural concrete without written permission of the SER.

accordance with ACI 302.1R-96: "Guide for Concrete Slab and Slab Construction Concrete slabs—on—grade shall be constructed in

The concrete slab—on—grade has been designed using a subgrade modulus of k=250 pci and a design loading of 200 psf. The SER is not responsible for differential settlement, slab cracking or other future defects resulting from unreported conditions not in accordance with the above assumptions.

exterior slabs-on-grade at a maximum of 10'-0" unless Control or saw cut joints shall be spaced in interior slabs—on—grade at a maximum of 15'-0" O.C. and in noted otherwise.

Control or saw cut joints shall be produced using conventional process within 4 to 12 hours after the slab has been finished. Reinforcing steel may not extend through a control joint. Reinforcing steel may extend through a saw cut joint

9. 10.

All welded wire fabric (W.W.F.) for concrete slabs-on-grade shall be placed at mid-depth of slab. The W.W.F. shall be securely supported during the concrete

CONCRETE REINFORCEMENT:

fibers containing no reprocessed olefin materials and specifically manufactured for use as concrete secondary increase in impact capacity, increased abrasion resistance, and residual strength. Fibrous concrete reinforcement, or fibermesh, specified concrete slabs—on-grade may be used for control of cracking due to shrinkage and thermal Fibermesh reinforcing to be 100% virgin polypropylene expansion/contraction, lowered water migration, an

Application of fibermesh per cubic yard of concrete shall equal a minimum of 0.1% by volume (1.5 pounds per reinforcement.

Fibermesh shall comply with ASTM C1116, any local building code requirements, and shall meet or exceed the

industry standard.

Steel reinforcing bars shall be new billet steel conforming to ASTM A615, grade 60.

Detailing, fabrication, and placement of reinforcing steel shall be in accordance with the latest edition of ACI 315:

5

"Manual of Standard Practice for Detailing Concrete

Horizontal footing and wall reinforcement shall be continuous and shall have 90° bends, or corner b

Lap reinforcement as required, a minimum of 40 bar diameters for tension or compression unless otherwise with a class B tension splice. Splices in masonry shall be a minimum of 48

Where reinforcing steel is required vertically, dowels shall be provided unless otherwise noted.

10 FRAMING: Where reinforcing dowels are required, they shall be equivalent in size and spacing to the vertical reinforcement. The dowel shall extend 48 bar diameters vertically and 20 bar diameters into the footing.

otherwise noted, all wood framing members are designed to be Southern-Yellow-Pine (SYP) #2. LVL or PSL engineered wood shall have the following Solid sawn wood framing members shall conform to the specifications listed in the latest edition of the "National Design Specification for Wood Construction" (NDS). Unless

minimum design values: 2.1. E = 1,900,000 psi

2.

Fb = 2600 psi Fv = 285 psi Fc = 700 psi

Wood in contact with concrete, masonry, or earth shall be pressure treated in accordance with AWPA standard C-15. All other moisture exposed wood shall be treated in accordance with AWPA standard C-2

Nails shall be common wire nails unless otherwise noted. Lag screws shall conform to ANSI/ASME standard B18.2.1-1981. Lead holes for lag screws shall be in

4.0

B18.2.1—1981. Lead holes for lag screws shall be in accordance with NDS specifications.

All beams shall have full bearing on supporting framing members unless otherwise noted.

be placed at each end of the header. King studs shall be continuous. Exterior and load bearing stud walls are to be 2x4 SYP #2 @ 16" 0.C. unless otherwise noted. Studs shall be window/door openings. continuous from the sole plate to the double top plate. Studs shall only be discontinuous at headers for A minimum of one king stud shall

be continuous to the foundation or beam. The column shall be properly blocked at all floor levels to ensure Individual studs forming a column shall be attached with one 10d nail @ 6" O.C. staggered. The stud column shall proper load transfer.

shall be bolted together with (2) rows of 1/2" diameter through bolts staggered @ 24" O.C. unless noted otherwise. Min. edge distance shall be 2" and (2) bolts shall be located a min. 6" from each end of the beam. Multi-ply beams shall have each ply attached with (3) 12d nails @ 12" 0.C. Flitch beams, 4-ply beams and 3-ply side loaded beams

WOOD TRUSSES:

1. The wood to discrepancies between the truss/joist layouts and the the design of the wood trusses. The SER shall assume no responsibility for the correctness for the structural design for the wood trusses. SUMMIT shall be notified by the truss manufacturere/fabricator or the client of any The wood truss manufacturer/fabricator is responsible for no

sealed structural plans prior to the start of construction. The wood trusses shall be designed for all required loadings as specified in the local building code, the ASCE Standard "Minimum Design Loads for Buildings and Other Structures." (ASCE 7-10), and the loading requirements shown on these specifications. The truss drawings shall be coordinated with all other construction documents and provisions provided for loads shown on these drawings including but not limited to HVAC equipment, piping, and architectural fixtures attached to the trusses. plate connections and uplift connections are the All girder truss to girder truss connections, truss to top responsibility of the wood truss manufacturer/fabricator

The trusses shall be designed, fabricated, and erected in accordance with the latest edition of the "National Design Specification for Wood Construction." (NDS) and "Design Specification for Metal Plate Connected Wood Trusses truss manufacturer shall provide adequate bracing

bar

trusses shall be per the EXTERIOR WOOD FRAMED DEC Any chords or truss webs shown on these drawings have been shown as a reference only. The final design of the manufacturer.

through code references D STRUCTURAL PANELS: Decks are to be framed codes and as referenced

wood sheathing shall bear the

applicable APA standards.
All structurally required we mark of the APA.

3.

long direction perpendicular to framing, unless noted on these drawings. Refer local building codes Wood wall sheathing shall comply with the requirements of for more information. for or the appropriate state as indicated yfer to wall bracing notes in plan set Sheathing shall be applied with the

rating consistent with the framing st edge support by use of plywood clip unless otherwise noted. Panel end jo framing. Apply building paper over the required by the state Building Code. Roof sheathing shall be AP or 2. Roof sheathing shall Sheathing shall be applied with the long direction perpendicular to framing. Sheathing shall have a span rating consistent with the framing spacing. Use suitable edge support by use of plywood clips or lumber blocking supports and attached to its supporting roof framing (1)—8d CC nail at 6" O.C. at panel edges and at 12 O.C. in panel field unless otherwise noted on the plans. Panel end joints shall occur over paper over the sheathing as to its supporting roof framing with APA rated sheathing exposure 1 be continuous over two

Wood floor sheathing shall be APA rated sheathing exposure 1 or 2. Attach sheathing to the sheathing framing with 1/1 framing with (1)-8d CC ringshank nail at 6° O edges and at 12" O.C. in panel field unless ot noted on the plans. Sheathing shall be applied rating consistent with the framing spacing. Use suitable edge support by use of T&G plywood or lumber blocking unless otherwise noted. perpendicular to framing paper over the sheathing as Panel end joints shall occur over in panel field unless otherwise sheathing to its supporting ringshank nail at 6" O.C. at panel Sheathing shall have a span

Sheathing shall have a Juilding Code.

1/8" gap at panel ends and in accordance with the APA.

Fabrication and placement of structural fiberboard sheathing shall be in accordance with the applicable AFA

bracing, both temporary and permanent, shall be shown on the shop drawings. Also, the shop drawings shall show the required attachments for the trusses. Recommendations for Handling, Installing, and Bracing Metal Plate Connected Wood Trusses" (HIB-91). This information in accordance with "Commentary and

in accordance with local building or construction details.

WWW.SUMMIT-COMPANIES.COM

OFFICE: 704.504.1717 3575 CENTRE CIRCLE FORT MILL, SC 29715

FAX: 704.504.1125

shall be in accordance with the APA Design/Const Guide "Residential and Commercial," and all other Fabrication and placement of structural wood sheathing with the APA Design/Construction

SUMMIT SUMIT SUMMIT SUMMIT SUMMIT SUMMIT SUMMIT SUMMIT SUMMIT SUMMIT SUM

ATION WILLIAM

framing. Apply building required by the state B


edges as recommended i

STRUCTURAL FIBERBOARD PANE

1. Fabrication and i

standards.

3 Fiberboard wall sheathing shall comply with the requirements of local building codes for the appropriate state as indicated on these drawings. Refer to wall bracing notes in plan set for more information. Sheathing shall have a 1/8" gap at panel ends and Sheathing shall have a 1, edges are recommended in accordance with the AFA

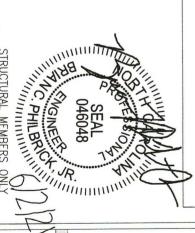

PROJECT Brooke - RH


CURRENT DRAWING DATE: 06/1/2021 Coversheet CLIENT John Dove 8626 Macedonia Lake Dr Cary, NC 27578

CHECKED BY: BCP DRAWN BY: KVW SCALE: 1/8"=1'-0" PROJECT #: 2672,T0416

ORIGINAL INFORMATION PROJECT # 06/1/2021 DATE

REFER TO COVER SHEET FOR A COMPLETE LIST OF REVISIONS

STRUCTURAL MEMBERS ON

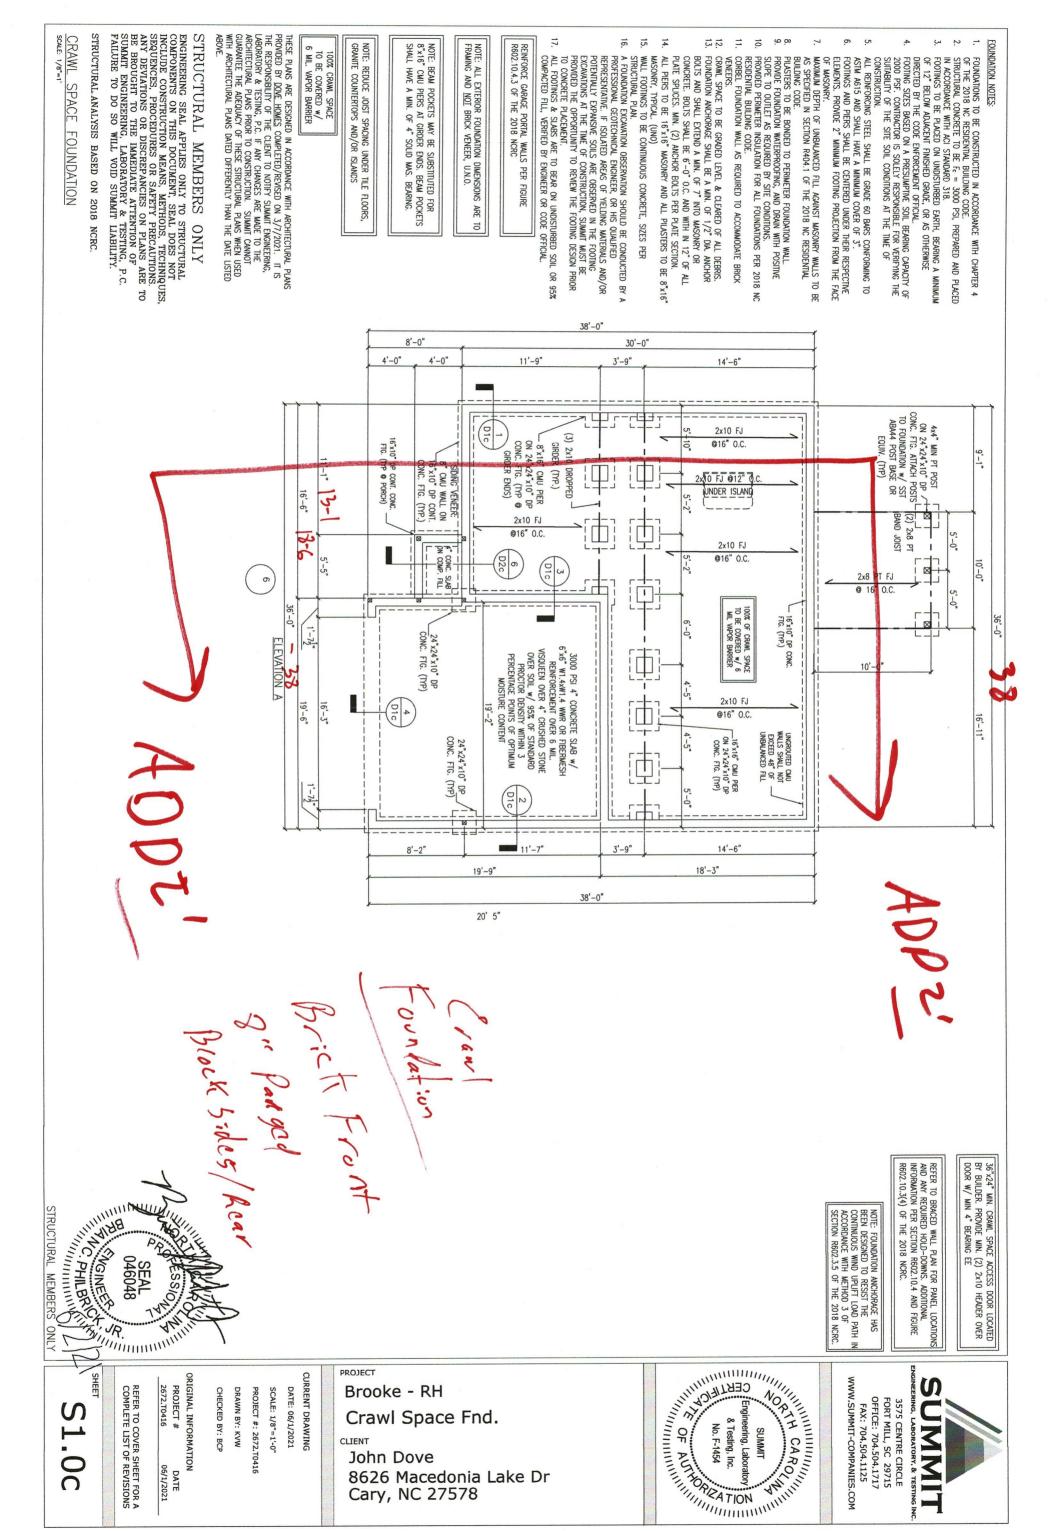

CONSTRUCTION SHALL CONFORM TO 2018 NC RESIDENTIAL BUILDING

GENERAL STRUCTURAL NOTES:

CONTRACTOR SHALL VERIFY ALL DIMENSIONS. CONTRACTOR SHALL COMPLY WITH THE CONTENTS OF THE DRAWING FOR THIS SPECIFIC PROJECT. ENGINEER IS NOT RESPONSIBLE FOR ANY DEVATIONS FROM

COLUMN AT EACH END UNLESS NOTED OTHÉRWISE.

7. FOUNDATION ANCHORAGE SHALL BE CONSTRUCTED PER NC RESIDENTIAL BULDING CODE 2018 SECTION 403.1.6. 1/2" DIA BOLTS SPACED AT 6'-0" CENTERS WITH A 7" MINIMUM EMBEDMENT INTO MASONRY OR CONCRETE. ANCHOR BOLTS SHALL BE 12" FROM THE END OF EACH PLATE SECTION. MINIMUM (2) ANCHOR BOLTS PER PLATE SECTION.

8. POSITIVE AND NEGATIVE WALL CLADDING DESIGN VALUES FOR 100 MPH, CATEGORY B, AND MRH 30 FEET OR LESS ARE 18.2 AND 24.0

10.

RESPECTIVELY.

CONTRACTOR TO PROVIDED LOOKOUTS WHEN CEILING JOISTS SPAN
PERPENDICULAR TO RAFTERS.

FUTCH BEAMS, 4-PLY LVIS AND 3-PLY SIDE LOADED LVIS SHALL BE
BOLTED TOGETHER WITH 1/2" DIA. THRU BOLTS SPACED AT 24" O.C.

(MAX) STAGGERED. MIN. EDGE DISTANCE SHALL BE 2" AND (2) BOLTS
SHALL BE LOCATED A MINIMUM 6" FROM EACH END OF THE BEAM. SCREWS MAY BE SUBSTITUTED PER MANUFACTURER'S

SPECIFICATIONS.

ALL NON-LOAD BEARING HEADERS SHALL BE (1) FLAT 2x4 SYP #2, DROPPED. FOR NON-LOAD BEARING HEADERS EXCEEDING 8"-0" IN WIDTH AND/OR WITH MORE THAN 2"-0" OF CRIPPLE WALL ABOVE, SHALL BE (2) FLAT 2x4 SYP #2, DROPPED (U.N.O.).

STEEL ANGLES TO HAVE MIN. 4" BEARING ONTO BRICK AT EACH END. ALL HEADERS WHERE BRICK IS USED, TO BE: LINTEL SCHEDULE:

L5x3-1/2x5/16" L3x3x1/4" L5x3"x1/4" L5x3-1/2"x5/16" ROLLED OR EQUAL ARCHED COMPONENT.

NOTE: JOIST & BEAM SIZES SHOWN ARE MINIMUMS. BUILDER MAY INCREASE DEPTH FOR EASE OF CONSTRUCTION.

TWO STORY WALL NOTE (BALLOON FRAMING):
2x4 STUDS @ 12" O.C. OR 2x6 STUDS @ 16" O.C.
w/ CROSS BRACING @ 6'-0" O.C. VERTICALLY.

NOTE: SHADED WALLS INDICATED LOAD BEARING WALLS.

THESE PLANS ARE DESIGNED IN ACCORDANCE WITH ARCHITECTURAL PLANS PROVIDED BY <u>DOVE HOMES</u> COMPLETED/REVISED ON 3/7/2021. IT IS THE RESPONSIBILITY OF THE CLEINT TO NOTIFY SUMMIT ENGINEERING, LABORATORY & TESTING, P.C. IF ANY CHANGES ARE MADE TO THE ARCHITECTURAL PLANS PRIOR TO CONSTRUCTION. SUMMIT CANNOT GUARANTEE THE ADEQUACY OF THESE STRUCTURAL PLANS WHEN USED WITH ARCHITECTURAL PLANS DATED DIFFERENTLY THAN THE DATE LISTED ADDRESS.


STRUCTURAL MEMBERS ONLY

ENGINEERING SEAL APPLIES ONLY TO STRUCTURAL COMPONENTS ON THIS DOCUMENT, SEAL DOES NOT INCLUDE CONSTRUCTION MEANS, METHODS, TECHNIQUES, SEQUENCES, PROCEDURES OR SAFETY PRECAUTIONS.

ANY DEVIATIONS OR DISCREPANCIES ON PLANS ARE TO BE BROUGHT TO THE IMMEDIATE ATTENTION OF SUMMIT ENGINEERING, LABORATORY & TESTING, P.C. FAILURE TO DO SO WILL VOID SUMMIT LIABILITY.

STRUCTURAL ANALYSIS BASED ON 2018 NCRC

FLOOR FRAMING PLAN

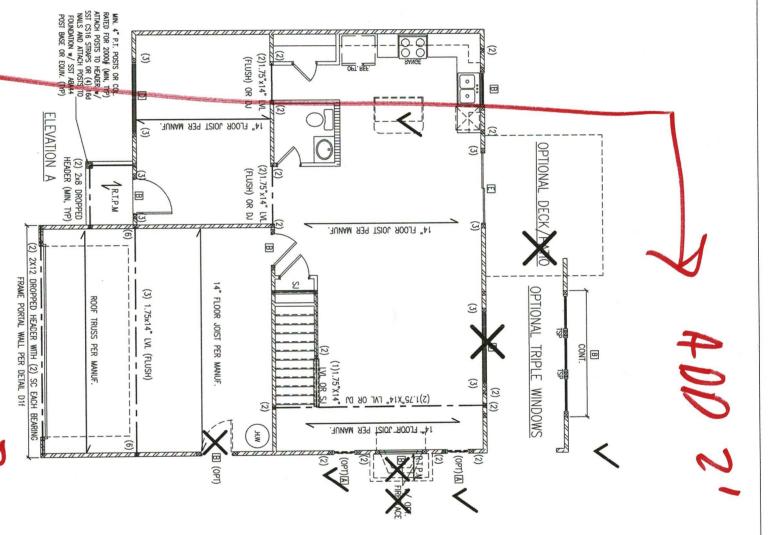

KING STUD

REQUIREMENTS ABOVE DO NOT APPLY TO PORTAL FRAMED OPENINGS

LESS THAN 3'-0"
3'-0 TO 4'-0"
4'-0" TO 8'-0"
8'-0" TO 12'-0"
12'-0" TO 16'-0"


OPENING WIDTH

KING

STUD

REQUIREMENTS


END)

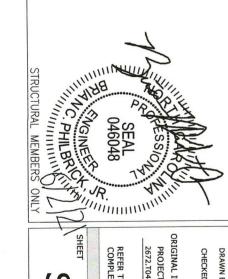

PROJECT

Brooke - RH First Floor Framing Plan

John Dove 8626 Macedonia Lake Dr Cary, NC 27578

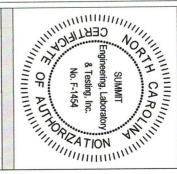

NOTES:

1. HEADER SIZES SHOWN ON PLANS ARE MINIMUMS. GREATER HEADER SIZES MAY BE USED FOR EASE OF CONSTRUCTION.

2. ALL HEADERS TO BE DROPPED UNLESS NOTED OTHERWISE.

3. STUD COLUMNS NOTED ON PLAN OVERRIDE STUD COLUMNS USTED ABOVE UNLESS NOTED OTHERWISE.

= G

(3) (3) 2x8

(3) (2)

2x12 2x10 ш D 0 В

(2)

7-1/4" LSL/LML

(3) 2x6

(2) 2x10 (2) 2x12

(3) (2) (2) (2)

(2) 2x8 (2) 2x6

FAX: 704.504.1125	OFFICE: 704.504.1717	FORT MILL, SC 29715	3575 CENTRE CIRCLE	ENGINEERING, LABORATORY, & TESTING I	SUMMIT	

TAG

SIZE SCHEDULE

JACKS (EE)

 Ξ

HEADER

CURRENT DRAWING DATE: 06/1/2021 SCALE: 1/8"=1'-0" DRAWN BY: KVW CHECKED BY: BCP PROJECT #: 2672.T0416

DRIGINAL INFORMATION PROJECT # 06/1/2021 DATE

REFER TO COVER SHEET FOR A COMPLETE LIST OF REVISIONS

NOTES:


1. HEADER SIZES SHOWN ON PLANS ARE MINIMUMS. GREATER HEADER SIZES MAY BE USED FOR EASE OF CONSTRUCTION.

2. ALL HEADERS TO BE DROPPED UNLESS NOTED OTHERWISE.

3. STUD COLUMNS NOTED ON PLAN OVERRIDE STUD COLUMNS LISTED ABOVE UNLESS NOTED OTHERWISE.

4. KING STUDS SHALL BE FRAMED PER TABLE R602.3(5) SUBNOTE & UNLESS NOTED OTHERWISE. NOTE: SHADED WALLS. TWO STORY WALL NOTE (BALLOON FRAMING): 2x4 STUDS @ 12" O.C. OR 2x6 STUDS @ 16" O.C. w/ CROSS BRACING @ 6'-0" O.C. WERTICALLY: NOTE: JOIST & BEAM SIZES SHOWN ARE MINIMUMS. BUILDER MAY INCREASE DEPTH EASE OF CONSTRUCTION. STEEL ANGLES TO HAVE MIN. BRICK AT EACH END. $\Theta\Theta\Theta\Theta$ LINTEL SCHEDULE: ALL HEADERS WHERE BRICK IS USED, LINTEL (U.N.O.) L5x3-1/2x5/16" L3x3x1/4" L5x3"x1/4" L5x3-1/2"x5/16" ROLLED OR EQUAL ARCHED COMPONENT. WALLS INDICATED LOAD BEARING (2) 9-1/4" LSL/LVL (3) 2x10 (3) 2x12 (2) 2x12 (3) 2x8 (3) 2x6 BEARING 10 FOR BE:

ROOF TRUSSES PER MANUF 0 A 0 ROOF TRUSSES PER MANUF.

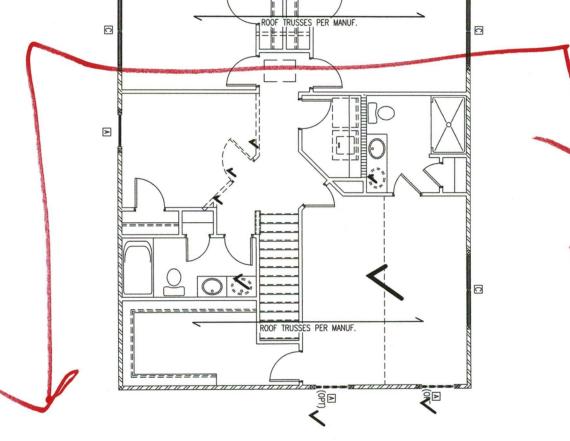

HILLIAN WOINERS ON STRUCTURAL MEMBERS JA AMILIA

REFER TO COVER SHEET FOR A COMPLETE LIST OF REVISIONS

ORIGINAL INFORMATION

CHECKED BY: BCP DRAWN BY: KVW PROJECT #: 2672.T0416 SCALE: 1/8"=1'-0"

PROJECT #

06/1/2021

DATE

STRUCTURAL ANALYSIS BASED ON 2018 NCRC.

FRAMING

ENGINEERING SEAL APPLIES ONLY TO STRUCTURAL COMPONENTS ON THIS DOCUMENT, SEAL DOES NOT INCLUDE CONSTRUCTION MEANS, METHODS, TECHNIQUES, SEQUENCES, PROCEDURES OR SAFETY PRECAUTIONS. ANY DEVIATIONS OR DISCREPANCIES ON PLANS ARE TO BE BROUGHT TO THE IMMEDIATE ATTENTION OF SUMMIT ENGINEERING, LABORATORY & TESTING, P.C. FAILURE TO DO SO WILL VOID SUMMIT LIABILITY.

STRUCTURAL MEMBERS ONLY

ALL ELEVATIONS


THESE PLANS ARE DESIGNED IN ACCORDANCE WITH ARCHITECTURAL PLANS PROVIDED BY <u>DOVE HOMES</u> COMPLETED/REVISED ON 3/7/2021. IT IS THE RESPONSIBILITY OF THE CLIENT TO NOTITY SLIMMIT ENGINEERING, LABORATORY & TESTING, P.C. IF ANY CHANGES ARE MADE TO THE ARCHITECTURAL PLANS PRIOR TO CONSTRUCTION. SUMMIT CANNOT GUARANTEE THE ADEQUACY OF THESE STRUCTURAL PLANS WHEN USED WITH ARCHITECTURAL PLANS DATED DIFFERENTLY THAN THE DATE LISTED ABOVE.

PROJECT

CURRENT DRAWING DATE: 06/1/2021

Brooke - RH Second Floor Framing Plan

John Dove 8626 Macedonia Lake Dr Cary, NC 27578

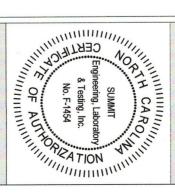

WWW.SUMMIT-COMPANIES.COM 3575 CENTRE CIRCLE FORT MILL, SC 29715 OFFICE: 704.504.1717 FAX: 704.504.1125

B A

2 (2) (2) 2x6 SIZE SCHEDULE

2×10 2x8

3 2 2 2

3 2 2 3

2.

HEADER

JACKS (EE)

ROOF FRAMING PLAN

STRUCTURAL MEMBERS ONLY ENGINEERING SEAL APPLIES ONLY TO STRUCTURAL COMPONENTS ON THIS DOCUMENT, SEAL DOES NOT INCLUDE CONSTRUCTION MEANS, METHODS, TECHNIQUES, SEQUENCES, PROCEDURES OR SAFETY PRECAUTIONS. ANY DEVIATIONS OR DISCREPANCIES ON PLANS ARE TO BE BROUGHT TO THE IMMEDIATE ATTENTION OF SUMMIT ENGINEERING, LABORATORY & TESTING, P.C. FAILURE TO DO SO WILL VOID SUMMIT LIABILITY.

STRUCTURAL ANALYSIS BASED ON 2018 NCRC.

THESE PLANS ARE DESIGNED IN ACCORDANCE WITH ARCHITECTURAL PLANS PROVIDED BY <u>DOVE HOMES</u> COMPLETED/REVISED ON 3/7/2021. IT IS THE RESPONSIBILITY OF THE CLIENT TO NOTIFY SUMMIT ENGNEERING, LABORATIORY & TESTING, P.C. IF ANY CHANGES ANDE TO THE ARCHITECTURAL PLANS PRIOR TO CONSTRUCTION. SUMMIT CANNOT GUARANTEE THE ADEQUACY OF THESE STRUCTURAL PLANS WHEN USED WITH ARCHITECTURAL PLANS DATED DIFFERENTLY THAN THE DATE LISTED ABOVE.

REFER TO DETAIL 5/D3F FOR EYEBROW, RETURN OR SHED ROOF FRAMING REQUIREMENTS. (TYP FOR ROOFS PROTRUDING MAXIMUM 24" FROM STRUCTURE)

TRUSS UPLIFT CONNECTOR SCHEDULE

MAX. UPLIFT ROOF TO WALL FLOOR TO FLOOR TO FAID

600 LBS H2.5A FER WALL SHEATHING & FRSTENERS
1200 LBS (2) H2.5A CS16 (END = 117) DITZZ
1450 LBS HTS20 (2) CS16 (END = 117) DITZZ
2000 LBS (2) MTS20 (2) CS16 (END = 117) HTT4

3685 LBS (2) MTS20 (2) CS16 (END = 117) HTT4

3685 LBS (2) HTS20 (2) CS16 (END = 117) HTT4

3685 LBS (2) HTS20 RE SWPSON STRONG-TIE EQUIVALENT PRODUCTS WAY BE USED FARE SWPSON STRONG-TIE EQUIVALENT PRODUCTS WAY BE USED FARE TOR SYP §7 GRAVE HUJBERS, BEFER TO TRUSS LYOUT PRE WANGETORS SPECIFICATIONS.

3. BEFER TO TRUSS LYOUT PRE WANGETORS SPECIFICATIONS.
3. AND TRUSS CONNECTIONS. CONNECTIONS SPECIFICATIONS.
4. CONTACT SULMIT FOR REQUIRED CONNECTORS WHEN LOADS EXCEED THOSE LISTED ABOVE.
4. CONTACT SULMIT FOR REQUIRED CONNECTORS WHEN LOADS EXCEED MOTE: TRISS JUPIT LOADS SHALL BE DETERMINED PER TRISS MANUFACTURER IN ACCORDANCE WITH SECTION RROZ.11.1.1 WALL SHEARING AND FASTENERS HAVE BEEN DESCRIBED TO RESIST WIND UPLIT LOAD PAIT IN ACCORDANCE WITH METHOD 3 OF SECTION RROZ.3.5 OF THE ZOTIO MERCE, REFER TO BRACED WALL PLANS FOR SHEATHING AND FASTENER REQUIREMENTS.

2 7045 8933
3 9622 12439
4 12189
GROER TRUSS PLYS SHOWN ARE FOR ILLUSTRATION ONLY.
PLEASE REFER TO TRUSS LAYOUT DRAWNINGS PROVIDED BY
TRUSS MANUF. FOR ACTUAL NUMBER OF PLYS REG'D.

NOTE: ROOF TRUSSES SHALL BE SPACED TO SUPPORT FALSE FRAMED DORMER WALLS (UNO)

OF PLYS

) TBE, STP \$2 TOP PLATE

24 WALL

5134

7702

10269

H BE, STP \$2 TOP PLATE

9622

12189

2x6 WALL 7013 10519 14025


MAX.

REACTION (LBS)

NOTE: 1ST PLY OF ALL SHOWN GIRDER TRUSSES
TO ALIGN WITH INSIDE FACE OF WALL (UNO)

ROOF TRUSSES PER MANUF. PER MANUF. VALLEY SET TRUSS

SPAN BY MANUF. ROOF TRUSSES PER MANUF ROOF TRUSSES PER MANUF.

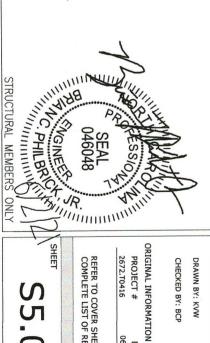

PROJECT # 2672.T0416 REFER TO COVER SHEET FOR A COMPLETE LIST OF REVISIONS


PROJECT

SCALE: 1/8"=1'-0" DATE: 06/1/2021

DRAWN BY: KVW PROJECT #: 2672.T0416 **ELEVATION A**

CURRENT DRAWING Brooke - RH Roof Framing Plan

John Dove 8626 Macedonia Lake Dr Cary, NC 27578

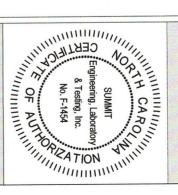

WWW.SUMMIT-COMPANIES.COM 3575 CENTRE CIRCLE FORT MILL, SC 29715 OFFICE: 704.504.1717 FAX: 704.504.1125

OR EQUIVALENT PER TABLE R702.3.5 CS-WSP WSP 뫆 88 WOOD STRUCTURAL PANEL WOOD STRUCTURAL PANEL WOOD STRUCTURAL PANEL GYPSUM BOARD REQUIRED BRACED 7/16" 3/8" 3/8" THICKNESS 1/2" WALL PER FIGURE R602.10.1 6d COMMON NAILS @ 6" O.C. 6d COMMON NAILS @ 6" O.C. 5d COOLER NAILS

@ 7" O.C. PANEL CONNECTIONS @ PANEL EDGES REQUIRED CONNECTION O INTERMEDIATE SUPPORTS PER FIGURE R602.10.1 6d COMMON NAILS @ 12" O.C. 5d COOLER NAILS**

@ 7" O.C. 6d COMMON NAILS @ 12" O.C.

- WALLS SHALL BE DESIGNED IN ACCORDANCE WITH SECTION R602.10 FROM THE 2018 NORTH CAROLINA RESIDENTIAL CODE WITH AMENDED PERMANENT
- RULES.

 2. WALLS ARE DESIGNED FOR SEISMIC ZONES A-C AND ULTIMATE WIND SPEEDS OF 130 MPH.

 3. BRACING MATERIALS, METHODS AND FASTENERS SHALL BE IN ACCORDANCE WITH TABLE R602.10.1

 4. ALL BRACED WALL PANELS SHALL BE FULL WALL HEIGHT AND SHALL NOT EXCEED 10 FEET FOR ISOLATED PANEL METHOD AND 12 FEET FOR CONTINUOUS SHEATHING METHOD WITHOUT ADDITIONAL ENGINEERING

FIRST FLOOR BRACING

 Ξ

SUMMIT SUMMIT A TESTING INC. F-1454

No. F-1454

No. F-1454

ATION WILLIAM

- REFER TO ARCHITECTURAL PLAN FOR DOOR/WINDOW OPENING SIZES.

 THE INTERIOR SIDE OF EXTERIOR WALLS AND BOTH SIDES OF INTERIOR WALLS SHALL BE SHEATHED CONTINUOUSLY WITH MINIMUM 1/2" GYPSUM BOARD
- FOR CONTINUOUS SHEATHING METHOD, EXTERIOR WALLS SHALL BE SHEATHED ON ALL SHEATHABLE SURFACES INCLUDING INFILL AREAS BETWEEN BRACED WALL PANELS, ABOVE AND BELOW WALL OPENINGS, AND ON GABLE END
- FLOORS SHALL NOT BE CANTILEVERED MORE THAN 24" BEYOND THE FOUNDATION OR BEARING WALL BELOW WITHOUT ADDITIONAL ENGINEERING
- A BRACED WALL PANEL SHALL BE LOCATED WITHIN 12 FEET OF EACH CORNER OF EACH ELEVATION VIEW OF THE HOUSE OR EACH END OF THE CORNERS AND BRACED WALL LINE INTERSECTIONS SHALL BE CONSTRUCTED IN ACCORDANCE WITH SECTION R602.10.3(5)
- ADEQUATE CONTINUOUS LOAD PATHS FOR TRANSFER OF BRACING LOADS AND UPUFT LOADS SHALL COMPLY WITH SECTION R602.10.4

 MASONRY OR CONCRETE STEM WALLS WITH A LENGTH OF 48" OR LESS SUPPORTING A BRACED WALL PANEL SHALL BE DESIGNED IN ACCORDANCE WITH FIGURE R602.10.4.3

 BRACED WALL PANEL CONNECTIONS TO FLOOR/CELING SHALL BE CIRCUMSCRIBED RECTANGLES.

 THE EDGE DISTANCE BETWEEN BRACED WALL PANELS SHALL NOT EXCEED 21 FEET.

14.

12.

= 10.

- CONSTRUCTED IN ACCORDANCE WITH SECTION R602.10.4.4.
 BRACED WALL PANEL CONNECTIONS TO ROOF SHALL BE CONSTRUCTED IN ACCORDANCE WITH SECTION R602.10.4.5.
 CRIPPLE WALLS AND WALK OUT BASEMENT WALLS SHALL BE DESIGNED IN ACCORDANCE WITH SECTION R602.10.4.6
 BALLOON FRAMED WALLS SHALL DESIGNED IN ACCORDANCE WITH SECTION R602.10.4.8 WITH A MAXIMUM LENGTH OF 20 FEET.
 PORTIAL WALLS SHALL BE DESIGNED IN ACCORDANCE WITH FIGURE R602.10.1

8 17. 16.

- ON SCHEMATIC, SHADED WALLS INDICATE BRACED WALL PANELS. ABBREVIATIONS:

20.

GB = GYPSUM BOARD CS-XXX = CONT. SHEATHED PF = PORTAL FRAMED WSP = WOOD STRUCTURAL PANEL ENG = ENGINEERED SOLUTION

THESE PLANS ARE DESIGNED IN ACCORDANCE WITH ARCHITECTURAL PLANS PROVIDED BY <u>DOVE HOMES</u> COMPLETED/REVISED ON 3/7/2021. IT IS THE RESPONSIBILITY OF THE CLIENT TO NOTIFY SUMMIT ENGINEERING, LABORATORY & TESTING, P.C. IF ANY CHANGES ARE MADE TO THE ARCHITECTURAL PLANS PRIOR TO CONSTRUCTION. SUMMIT CANNOT CHARGENTE THE ADEQUACY OF THESE STRUCTURAL PLANS WHEN USED WITH ARCHITECTURAL PLANS DATED DIFFERENTLY THAN THE DATE LISTED DOWN

RE

STRUCTURAL MEMBERS


ENGINEERING SEAL APPLIES ONLY TO STRUCTURAL COMPONENTS ON THIS DOCUMENT, SEAL DOES NOT INCLUDE CONSTRUCTION MEANS, METHODS, TECHNIQUES, SEQUENCES, PROCEDURES OR SAFETY PRECAUTIONS. ANY DEVIATIONS OR DISCREPANCIES ON PLANS ARE TO BE BROUGHT TO THE IMMEDIATE ATTENTION OF SUMMIT ENGINEERING, LABORATORY & TESTING, P.C. FAILURE TO DO SO WILL VOID SUMMIT LIABILITY.

STRUCTURAL ANALYSIS BASED ON 2018 NCRC. FLOOR BRACING PLAN

ONLY LEFT HOUSE RIGHT

INSTALL HOLD-DOWNS FOR BRACED WALL END CONDITIONS PER SECTION R602.10.4 AND FIGURE R602.10.3(4) OF THE 2018 NCRC.

NOTE: WALL SHEATHING AND FASTENERS HAVE BEEN DESIGNED TO RESIST THE WIND UPLIFT LOAD PATH IN ACCORDANCE WITH METHOD 3 OF SECTION R602.3.5.

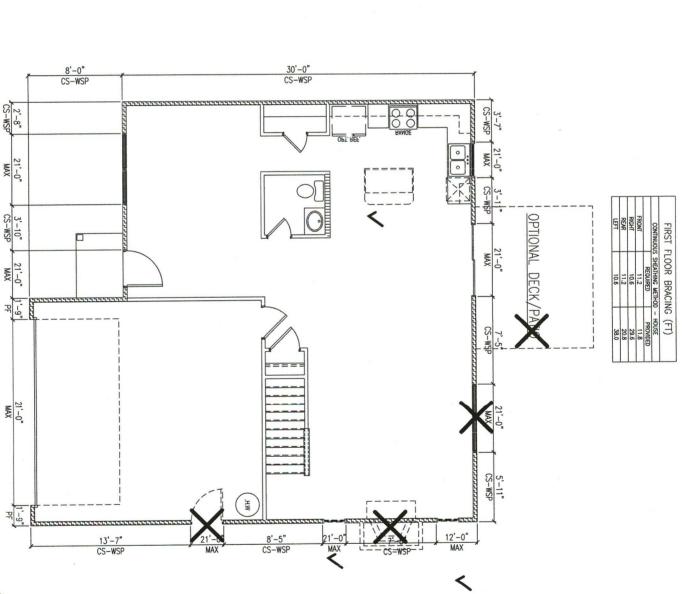

ALL ELEVATIONS MEMBER MEMBER HILL OF PHILBRICH JA AMILIA

DRIGINAL INFORMATION

DRAWN BY: KVW

PROJECT #

PROJECT

DATE: 06/1/2021

SCALE: 1/8"=1'-0" ROJECT #: 2672.T0416

CURRENT DRAWING Brooke - RH First Floor Bracing Plan

John Dove 8626 Macedonia Lake Dr Cary, NC 27578

REFER TO COVER SHEET FOR A COMPLETE LIST OF REVISIONS



WWW.SUMMIT-COMPANIES.COM

	REQUIR	ED BRACED WA	REQUIRED BRACED WALL PANEL CONNECTIONS	SNO
			REQUIRE	REQUIRED CONNECTION
METHOD	MATERIAL	MIN. THICKNESS	@ PANEL EDGES	@ INTERMEDIATE SUPPORTS
CS-WSP	WOOD STRUCTURAL PANEL	3/8"	6d COMMON NAILS @ 6" O.C.	6d COMMON NAILS @ 12" O.C.
89	GYPSUM BOARD	1/2"	5d COOLER NAILS** @ 7" O.C.	5d COOLER NAILS** © 7" 0.C.
WSP	WOOD STRUCTURAL PANEL	3/8"	6d COMMON NAILS @ 6" O.C.	6d COMMON NAILS @ 12" O.C.
PF	WOOD STRUCTURAL PANEL	7/16"	PER FIGURE R602.10.1	PER FIGURE R602.10.1
**OR EQUIVAL	**OR EQUIVALENT PER TABLE R702.3.5	.5		

RULES.
WALLS ARE DESIGNED FOR SEISMIC ZONES A-C AND ULTIMATE WIND SPEEDS OF 130 MPH.

LEFT

HOUSE

RIGHT

REAR

FRONT

- BRACING MATERIALS, METHODS AND FASTENERS SHALL BE IN ACCORDANCE WITH TABLE RROZ.10.1

 MITH TABLE RROZ.10.1

 ALL BRACED WALL PANELS SHALL BE FULL WALL HEIGHT AND SHALL NOT EXCED 10 FEET FOR ISOLATED PANEL METHOD AND 12 FEET FOR CONTINUOUS SHEATHING METHOD WITHOUT ADDITIONAL ENGINEERING CALCULATIONS.
- REFER TO ARCHITECTURAL PLAN FOR DOOR/WINDOW OPENING SIZES.

 THE INTERIOR SIDE OF EXTERIOR WALLS AND BOTH SIDES OF INTERIOR WALLS SHALL BE SHEATHED CONTINUOUSLY WITH MINIMUM 1/2" GYPSUM BOARD
- FLOORS SHALL NOT BE CANTILEVERED MORE THAN 24° BEYOND THE FOUNDATION OR BEARING WALL BELOW WITHOUT ADDITIONAL ENGINEERING FOR CONTINUOUS SHEATHING METHOD, EXTERIOR WALLS SHALL BE SHEATHED ON ALL SHEATHABLE SUPERACES INCLUDING INFILL AREAS BETWEEN BRACED WALL PANELS, ABOVE AND BELOW WALL OPENINGS, AND ON GABLE END WALLS.
- CALCULATIONS.

 CALCULATIONS.

 CORNERS AND BRACED WALL LINE INTERSECTIONS SHALL BE CONSTRUCTED IN ACCORDANCE WITH SECTION R802.10.3(5)

 A BRACED WALL PANEL SHALL BE LOCATED WITHIN 12 FEET OF EACH CORNER OF EACH ELEVATION VIEW OF THE HOUSE OR EACH END OF THE CIRCUMSCRIBED RECTANGLES.
- CIRCUMSCRIBED RECTANGLES.

 THE EDGE DISTANCE BETWEEN BRACED WALL PANELS SHALL NOT EXCEED 21 FEET.

 ADEQUATE CONTINUOUS LOAD PATHS FOR TRANSFER OF BRACING LOADS AND UPLIFT LOADS SHALL COMPLY WITH SECTION R602.10.4

 MASONRY OR CONCRETE STEM WALLS WITH A LENGTH OF 48* OR LESS SUPPORTING A BRACED WALL PANEL SHALL BE DESIGNED IN ACCORDANCE WITH FIGURE R602.10.4.3

12.

=

14.

- 15. BRACED WALL PANEL CONNECTIONS TO FLOOR/CELLING SHALL BE CONSTRUCTED IN ACCORDANCE WITH SECTION R602.104.4.

 16. BRACED WALL PANEL CONNECTIONS TO ROOF SHALL BE CONSTRUCTED IN ACCORDANCE WITH SECTION R602.104.5.

 17. CRIPPLE WALLS AND WALK OUT BASEMENT WALLS SHALL BE DESIGNED IN ACCORDANCE WITH SECTION R602.104.6

 18. BALLOON FRAMED WALLS SHALL DESIGNED IN ACCORDANCE WITH SECTION R602.104.8 WITH A MAXIMUM LENGTH OF 20 FEET.

 19. PORTAL WALLS SHALL BE DESIGNED IN ACCORDANCE WITH FIGURE R602.10.1

17.

16.

8.

- ON SCHEMATIC, SHADED WALLS INDICATE BRACED WALL PANELS. ABBREVIATIONS:

20.

GB = GYPSUM BOARD CS-XXX = CONT. SHEATHED PF = PORTAL FRAMED WSP = WOOD STRUCTURAL PANEL ENG = ENGINEERED SOLUTION

THESE PLANS ARE DESIGNED IN ACCORDANCE WITH ARCHITECTURAL PLANS PROVIDED BY <u>DOVE HOMES</u> COMPLETED/REVISED ON 3/7/2021. IT IS THE RESPONSBILITY OF THE CLEINT TO NOTIFY SUMMIT ENGINEERING, LABORATORY & TESTING, P.C. IF ANY CHANGES ARE MADE TO THE ARCHITECTURAL PLANS PRIOR TO CONSTRUCTION. SUMMIT CANNOT CHARGENTE THE ADEQUACY OF THESE STRUCTURAL PLANS WHEN USED WITH ARCHITECTURAL PLANS DATED DIFFERENTLY THAN THE DATE LISTED DADAGE.

STRUCTURAL MEMBERS ONLY

ENGINEERING SEAL APPLIES ONLY TO STRUCTURAL COMPONENTS ON THIS DOCUMENT, SEAL DOES NOT INCLUDE CONSTRUCTION MEANS, METHODS, TECHNIQUES, SEQUENCES, PROCEDURES OR SAFETY PRECAUTIONS. ANY DEVIATIONS OR DISCREPANCIES ON PLANS ARE TO BE BROUGHT TO THE IMMEDIATE ATTENTION OF SUMMIT ENGINEERING, LABORATORY & TESTING, P.C. FALLURE TO DO SO WILL VOID SUMMIT LIABILITY.

STRUCTURAL ANALYSIS BASED ON 2018 NCRC.


BRACED WALL NOTES: WALLS SHALL BE DESIGNED IN ACCORDANCE WITH SECTION R602.10 FROM THE 2018 NORTH CAROLINA RESIDENTIAL CODE WITH AMENDED PERMANENT




BRACING

 $\widehat{\Xi}$



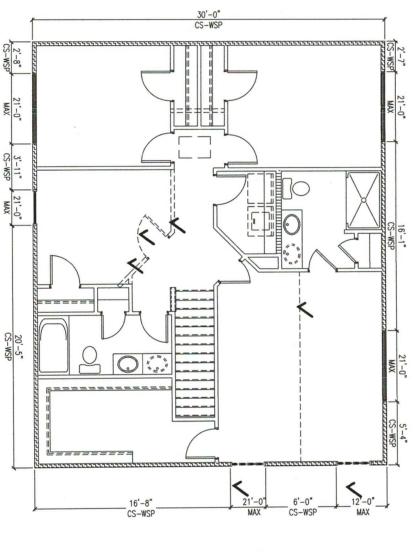

ALL ELEVATIONS

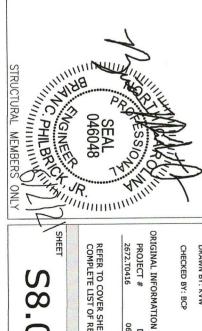

DRAWN BY: KVW

CHECKED BY: BCP

SCALE: 1/8"=1'-0" DATE: 06/1/2021


PROJECT #: 2672.T0416

REFER TO COVER SHEET FOR A COMPLETE LIST OF REVISIONS **S8.0**


PROJECT


CURRENT DRAWING Brooke - RH Second Floor Bracing Plan


John Dove 8626 Macedonia Lake Dr Cary, NC 27578

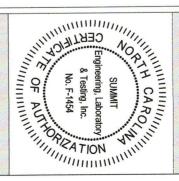

WWW.SUMMIT-COMPANIES.COM 3575 CENTRE CIRCLE FORT MILL, SC 29715 OFFICE: 704.504.1717 FAX: 704.504.1125

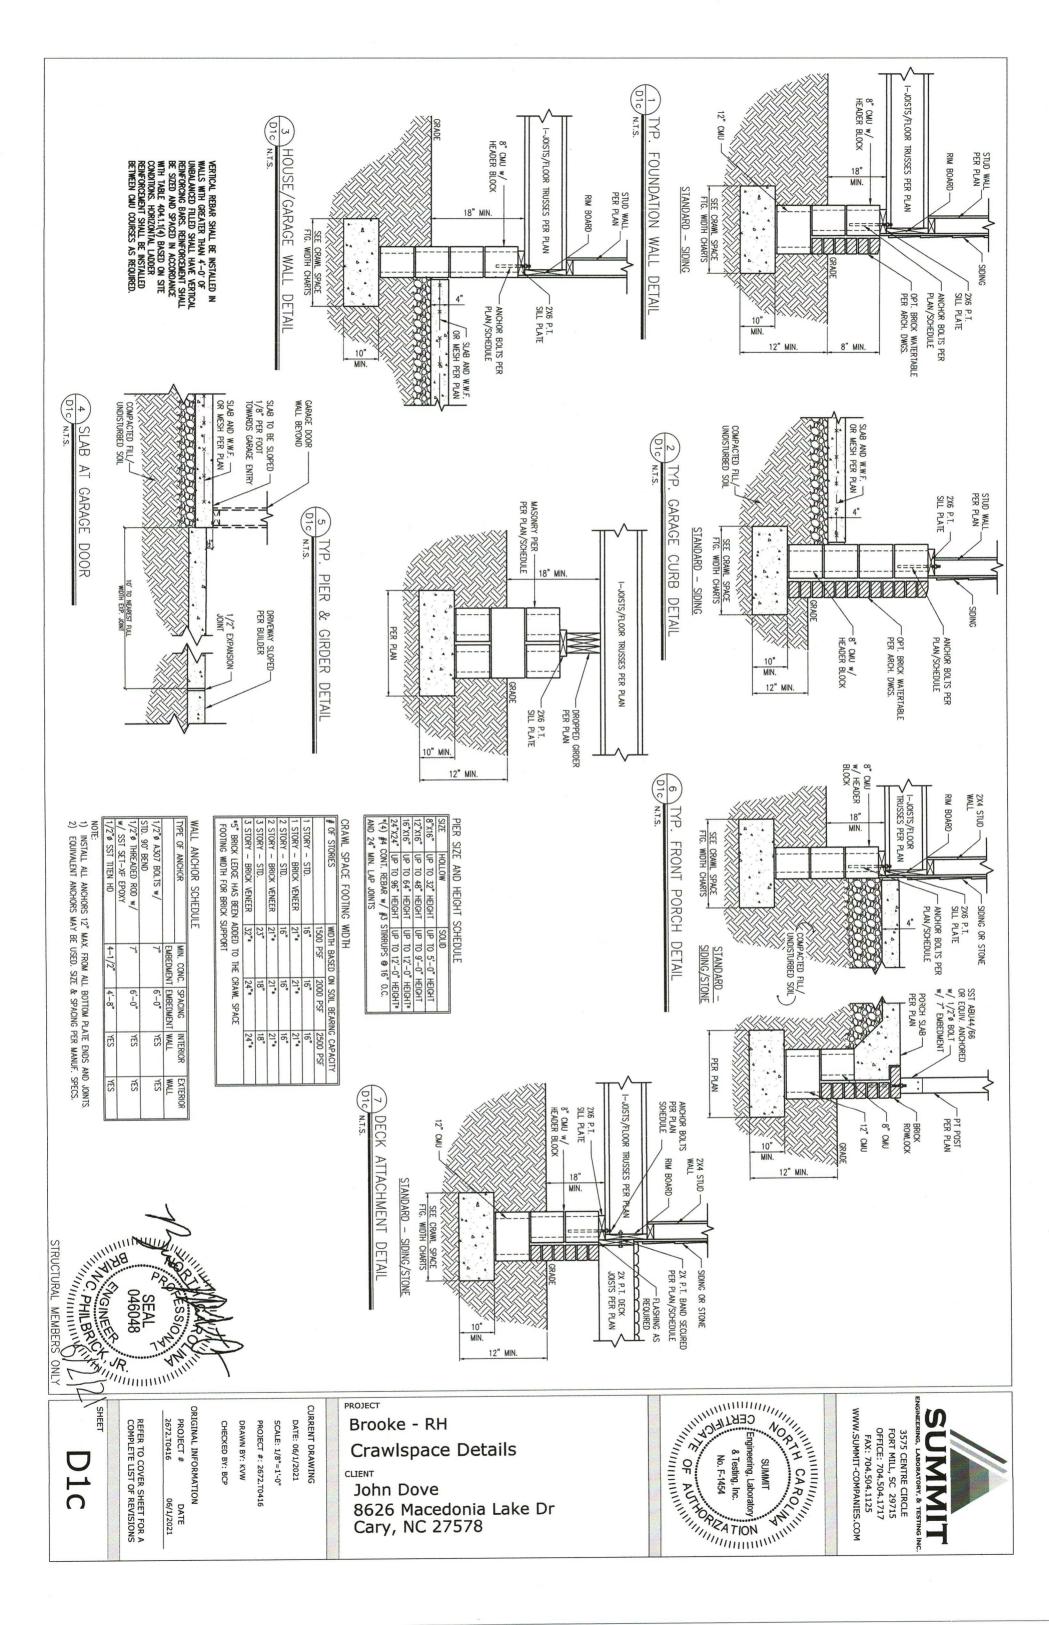

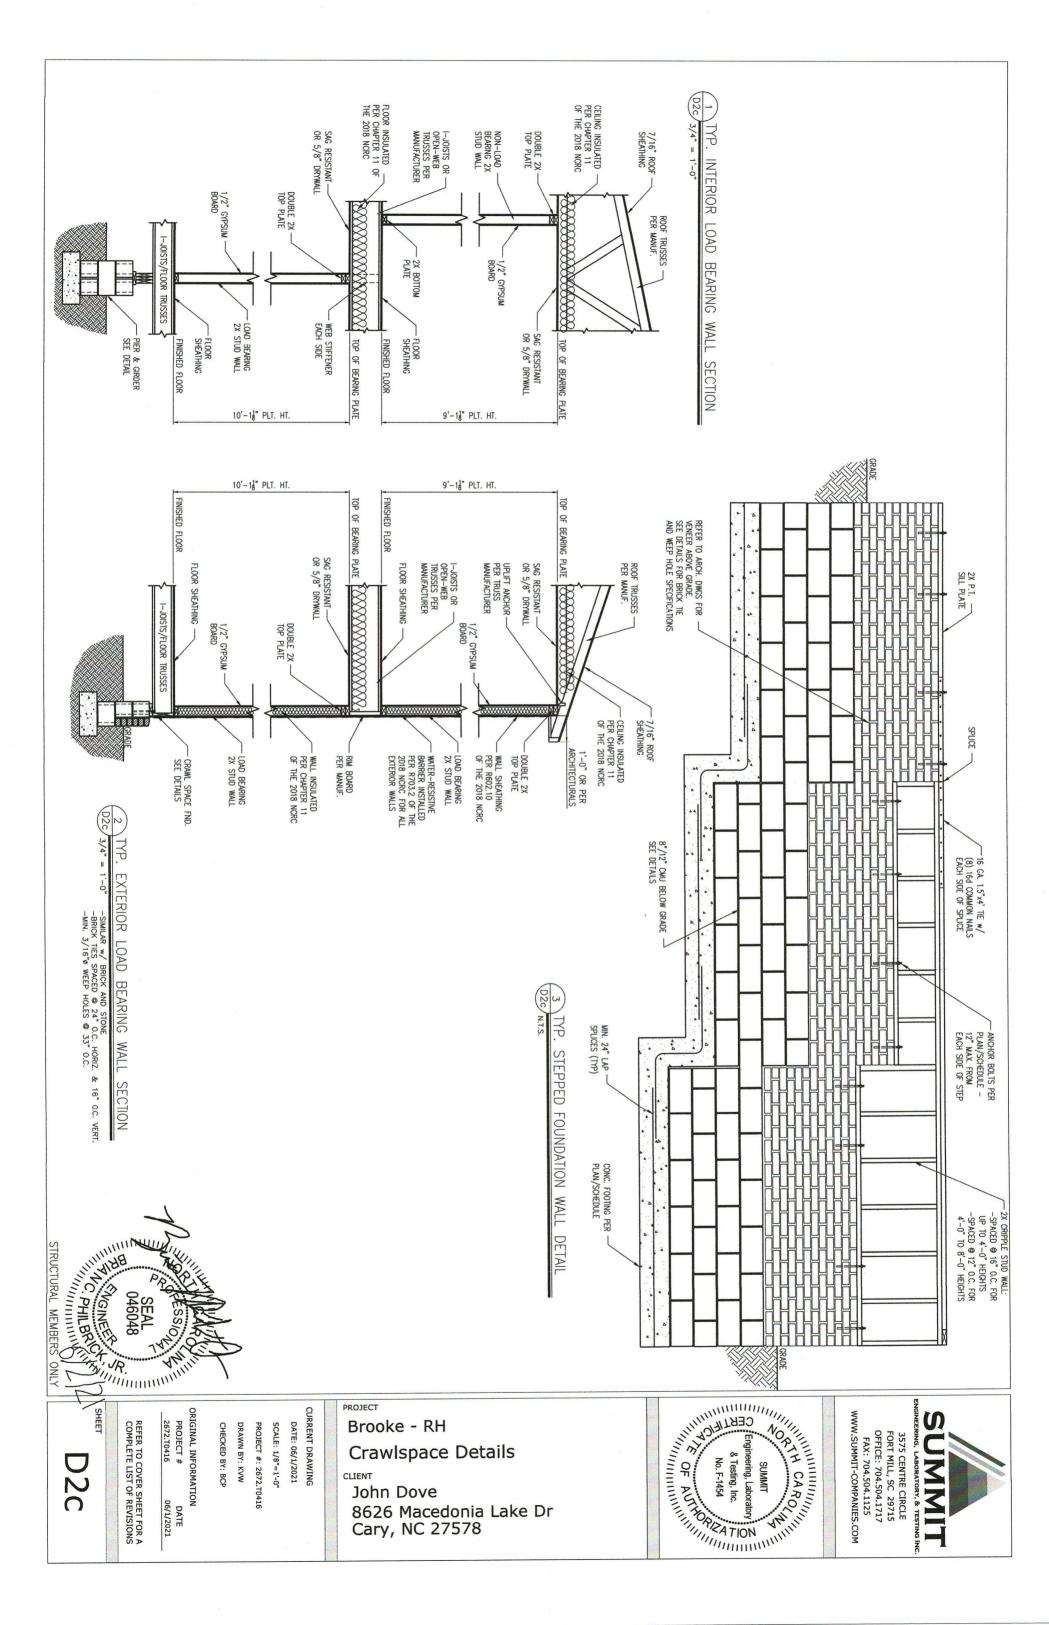

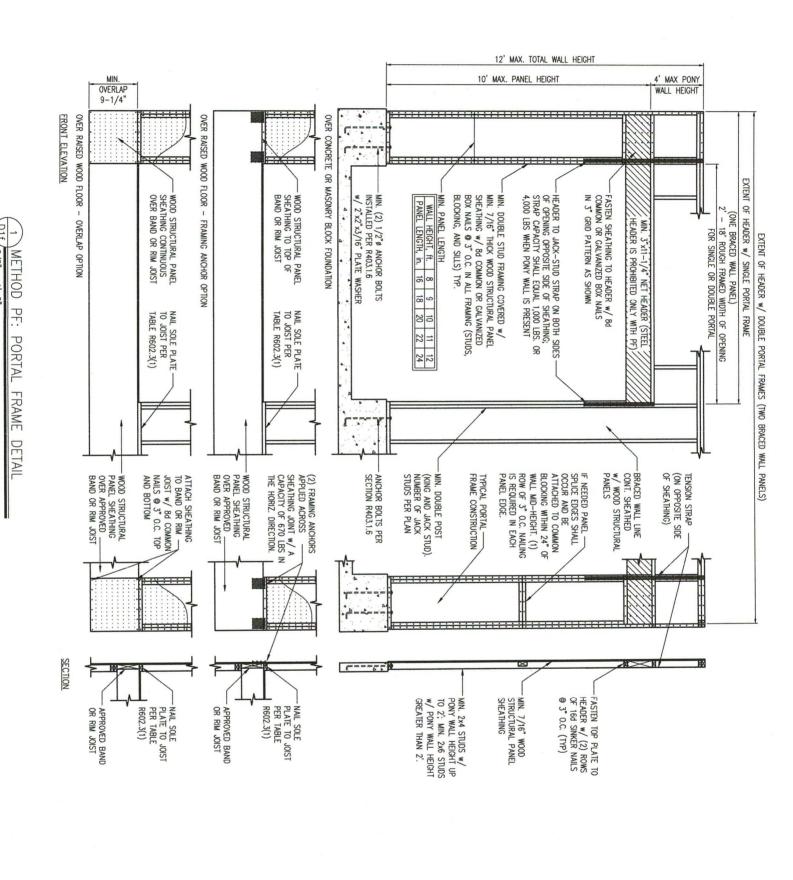

SEAL PARTIES OF STATE OF STATE


ORIGINAL INFORMATION PROJECT # 2672.T0416 DATE: 06/1/2021 REFER TO COVER SHEET FOR A COMPLETE LIST OF REVISIONS CHECKED BY: BCP DRAWN BY: KVW SCALE: 1/8"=1'-0" ROJECT #: 2672,T0416 DATE 06/1/2021

PROJECT


CURRENT DRAWING


Brooke - RH Framing Details


John Dove 8626 Macedonia Lake Dr Cary, NC 27578

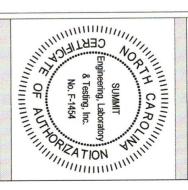



OFFICE: 704.504.1717 FAX: 704.504.1125 WWW.SUMMIT-COMPANIES.COM 3575 CENTRE CIRCLE FORT MILL, SC 29715

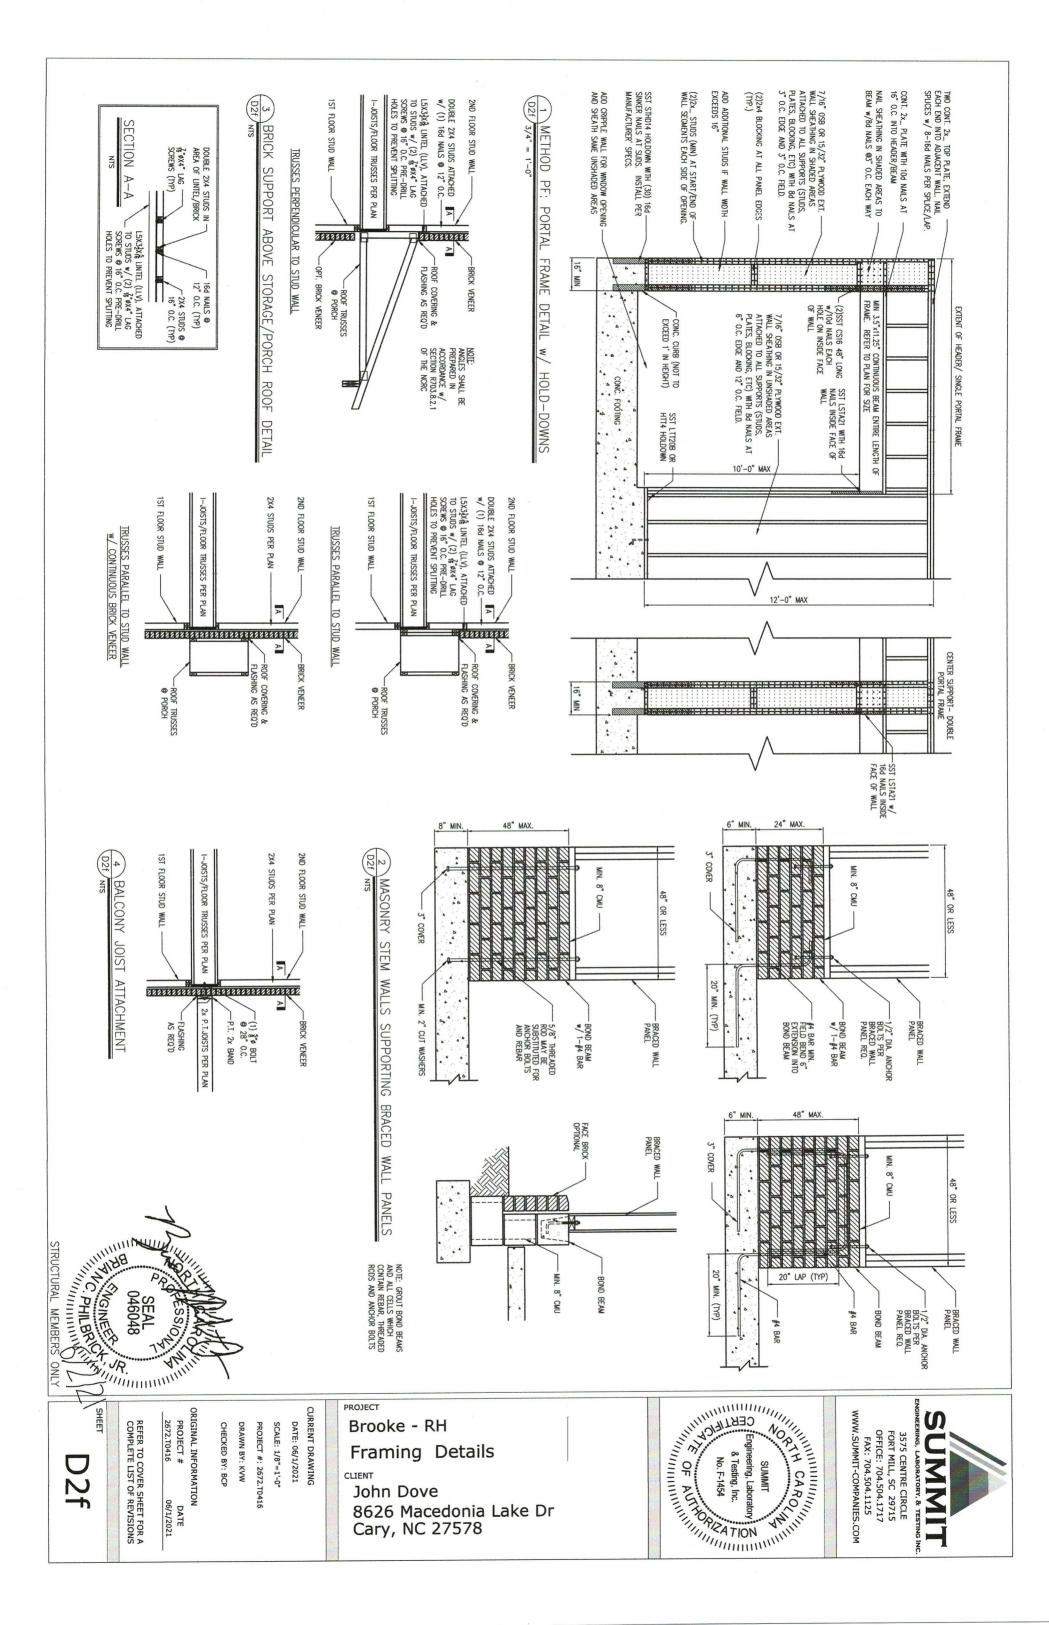

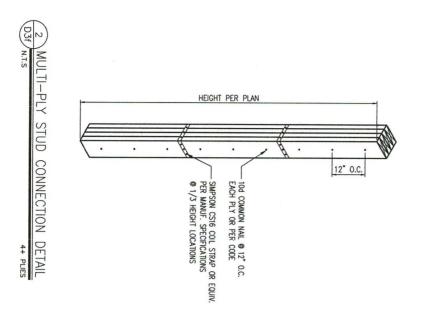

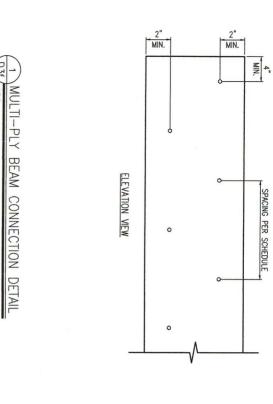

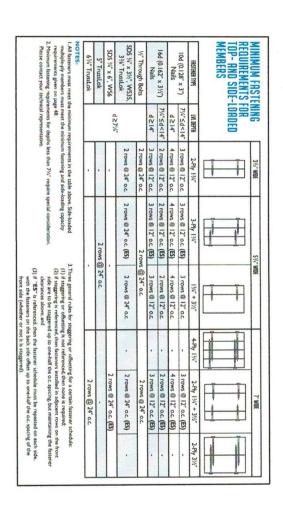

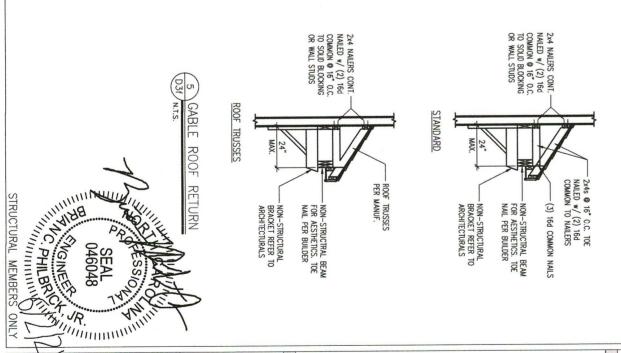

ORIGINAL INFORMATION

CHECKED BY: BCP DRAWN BY: KVW PROJECT #: 2672.T0416

PROJECT # 2672,T0416

DATE 06/1/2021

REFER TO COVER SHEET FOR A COMPLETE LIST OF REVISIONS

PROJECT


CURRENT DRAWING

DATE: 06/1/2021

SCALE: 1/8"=1'-0"

Brooke - RH Framing Details

John Dove 8626 Macedonia Lake Dr Cary, NC 27578

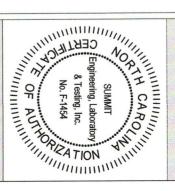

WWW.SUMMIT-COMPANIES.COM 3575 CENTRE CIRCLE FORT MILL, SC 29715 OFFICE: 704.504.1717 FAX: 704.504.1125