




NO STONE ON COLUMNS OR ACROSS


STEM WALL w/ PARGE COAT



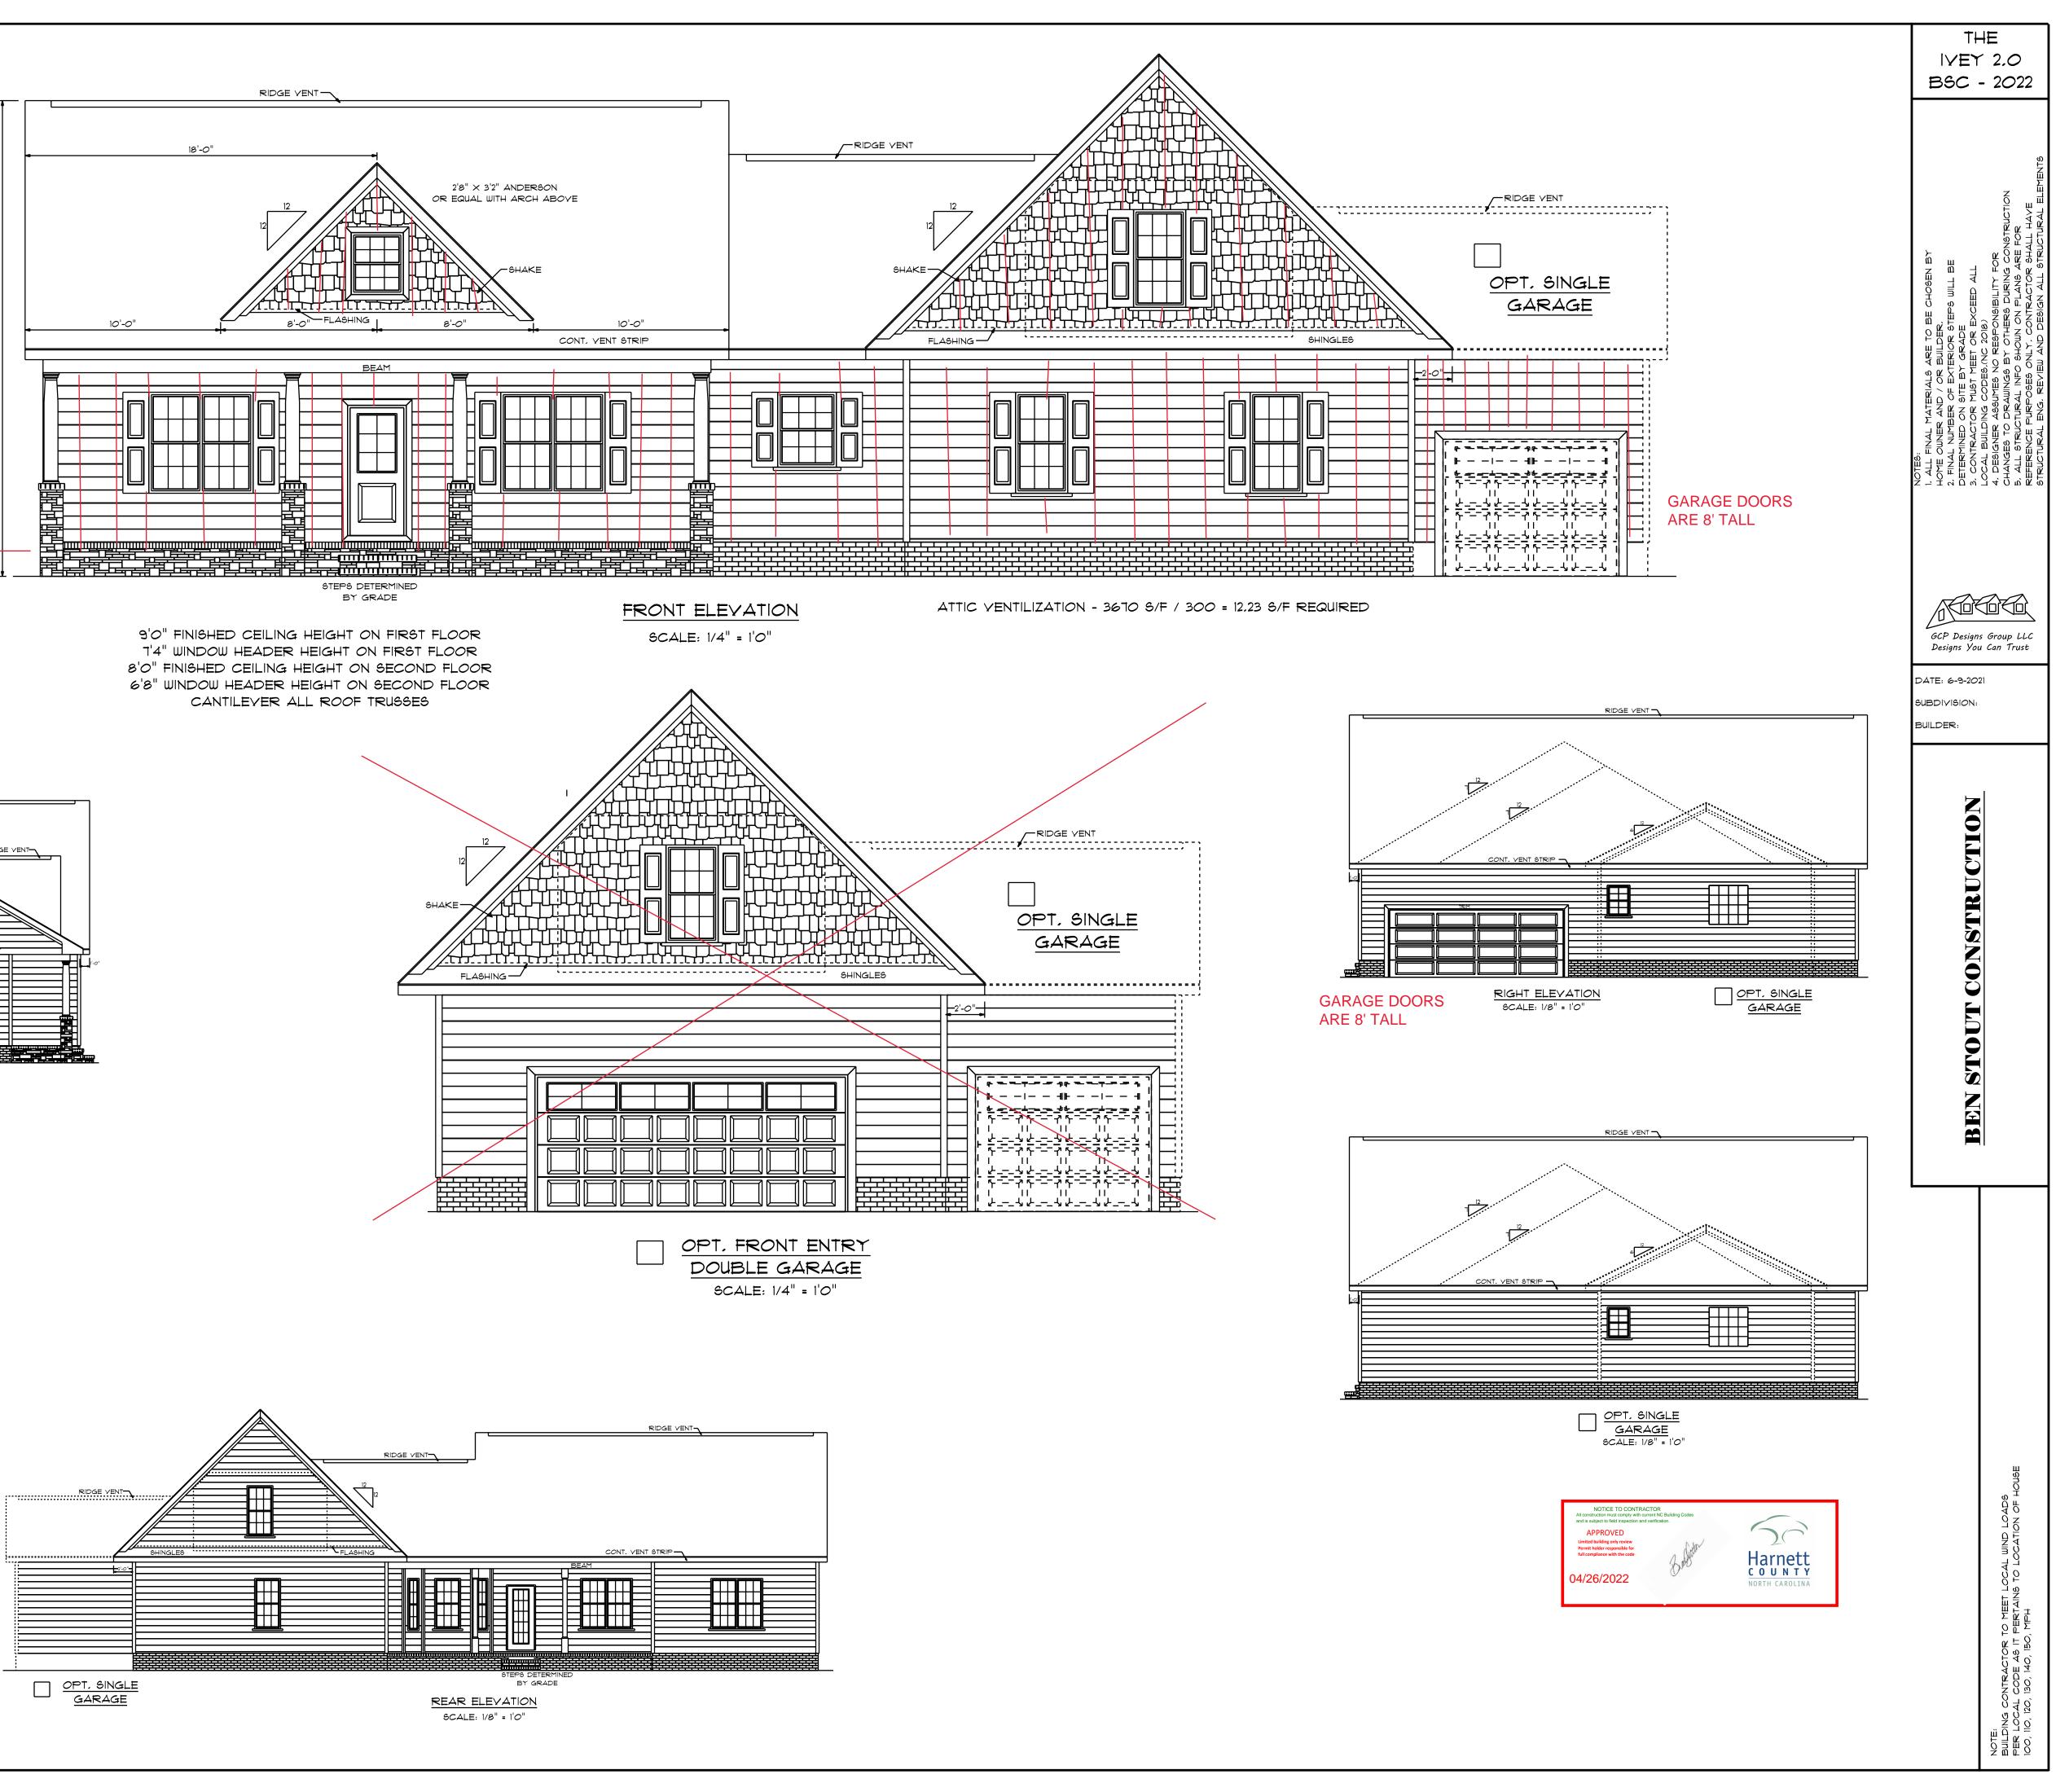

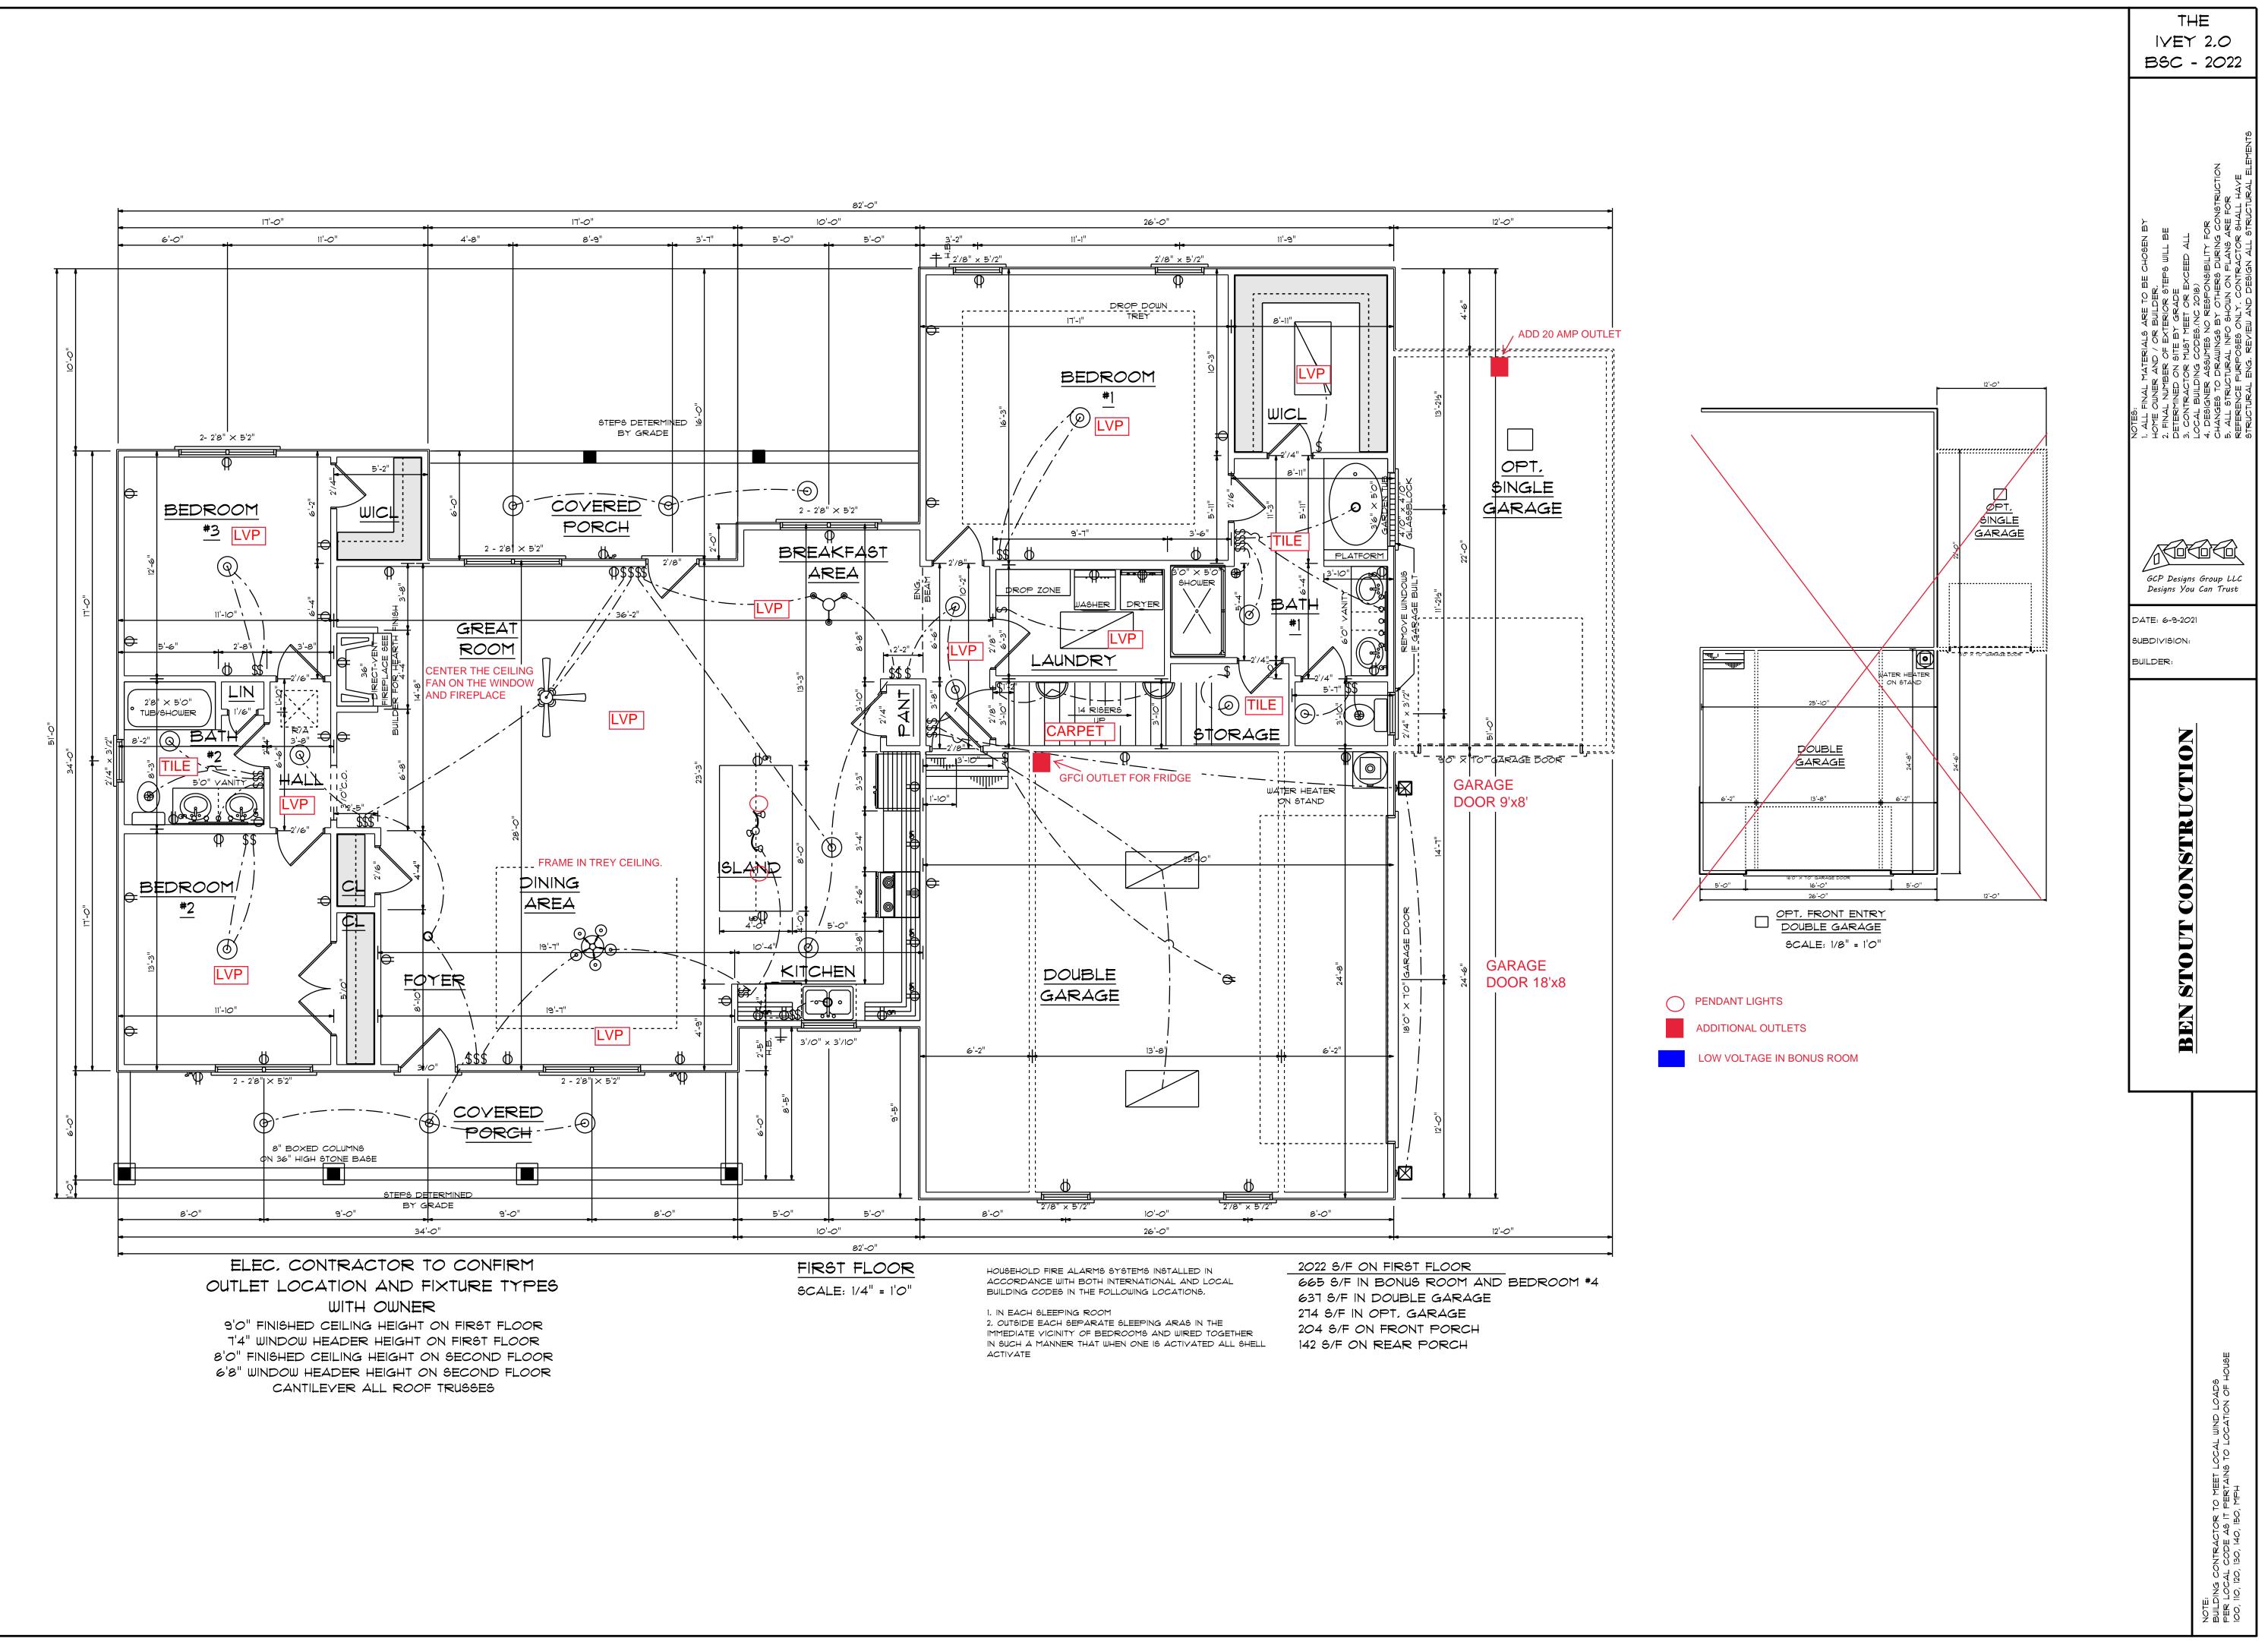


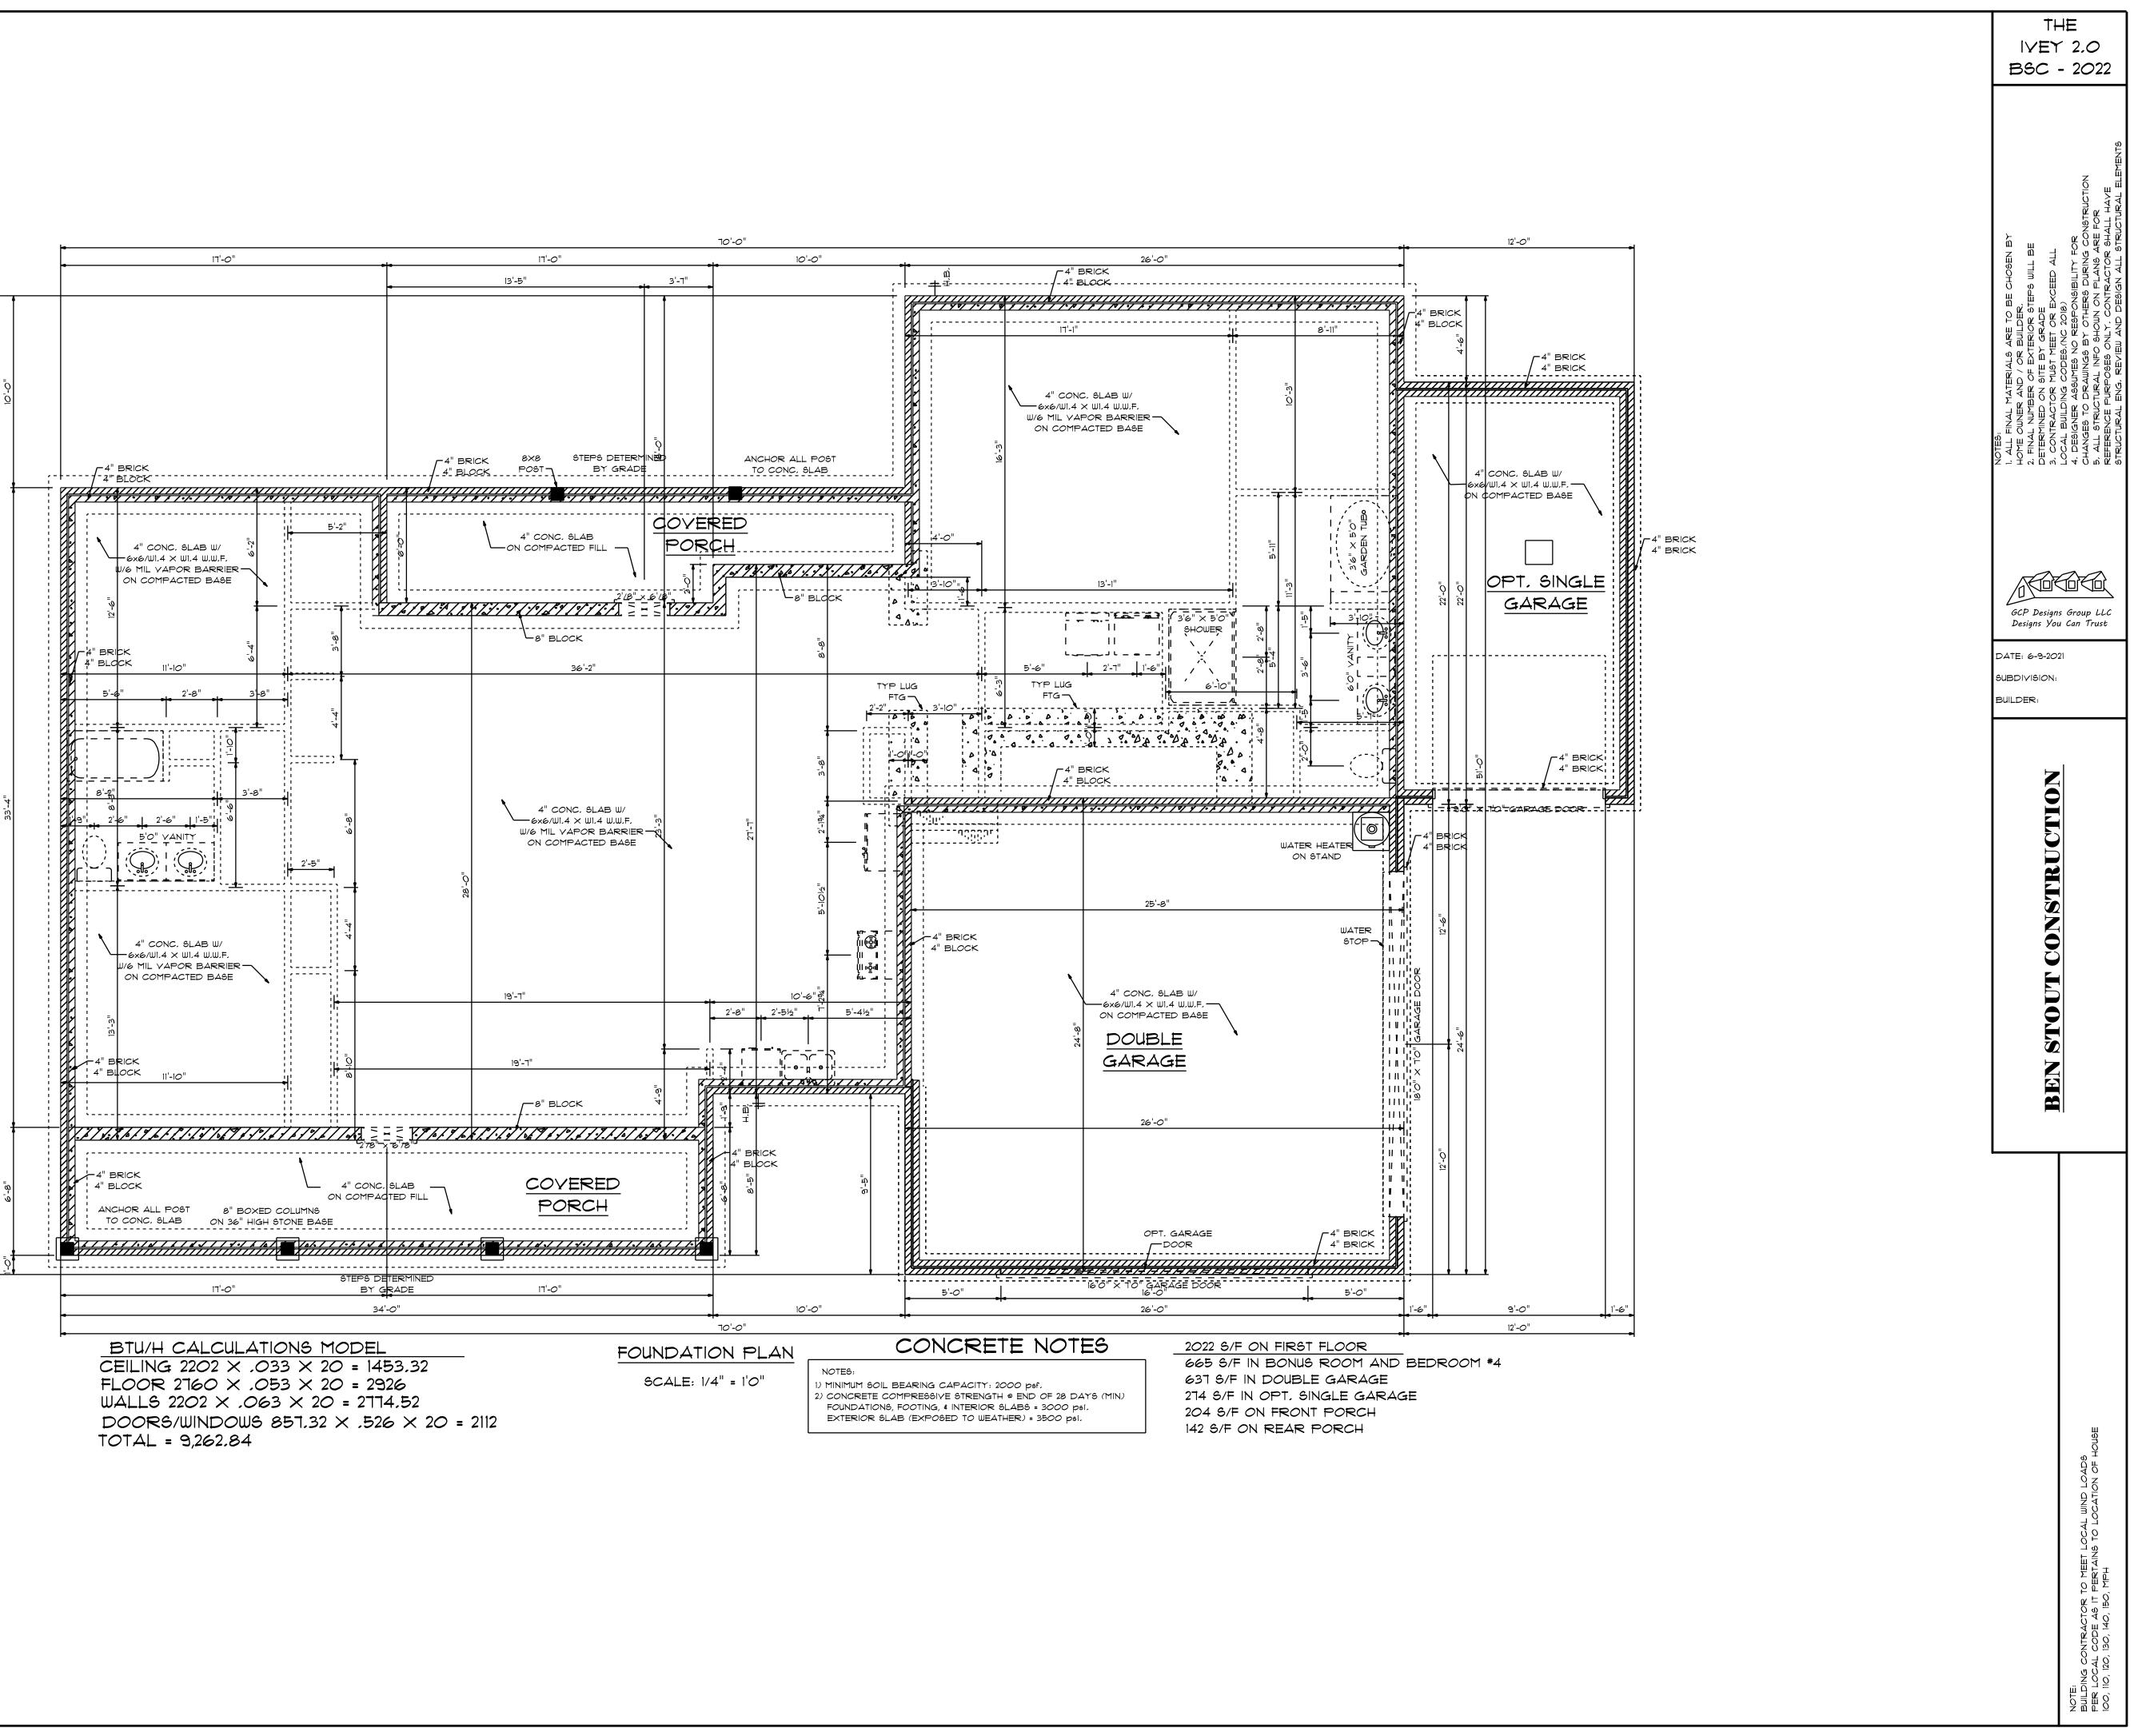

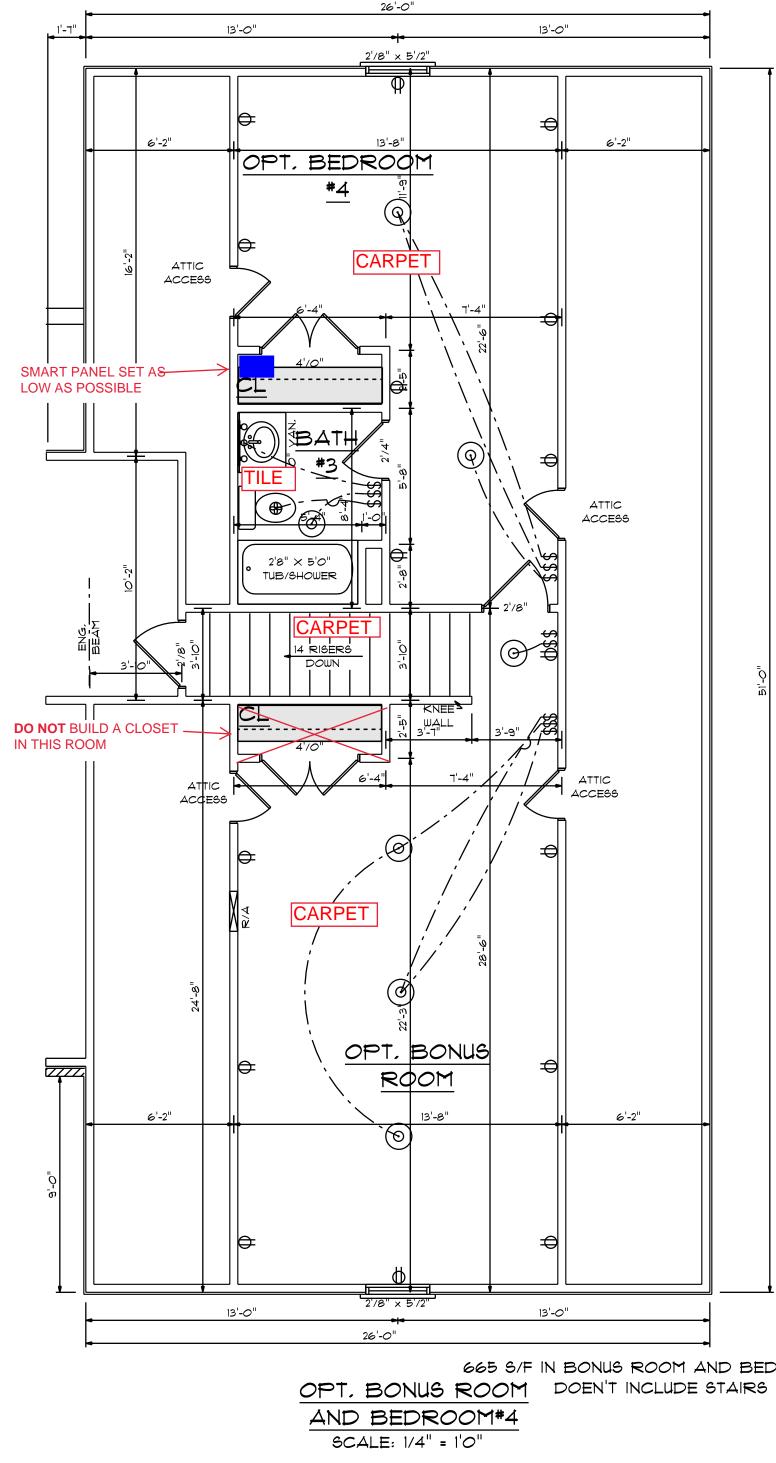



ELEC, CONTRACTOR TO CONFIRM OUTLET LOCATION AND FIXTURE TYPES WITH OWNER

665 S/F IN BONUS ROOM AND BEDROOM #4

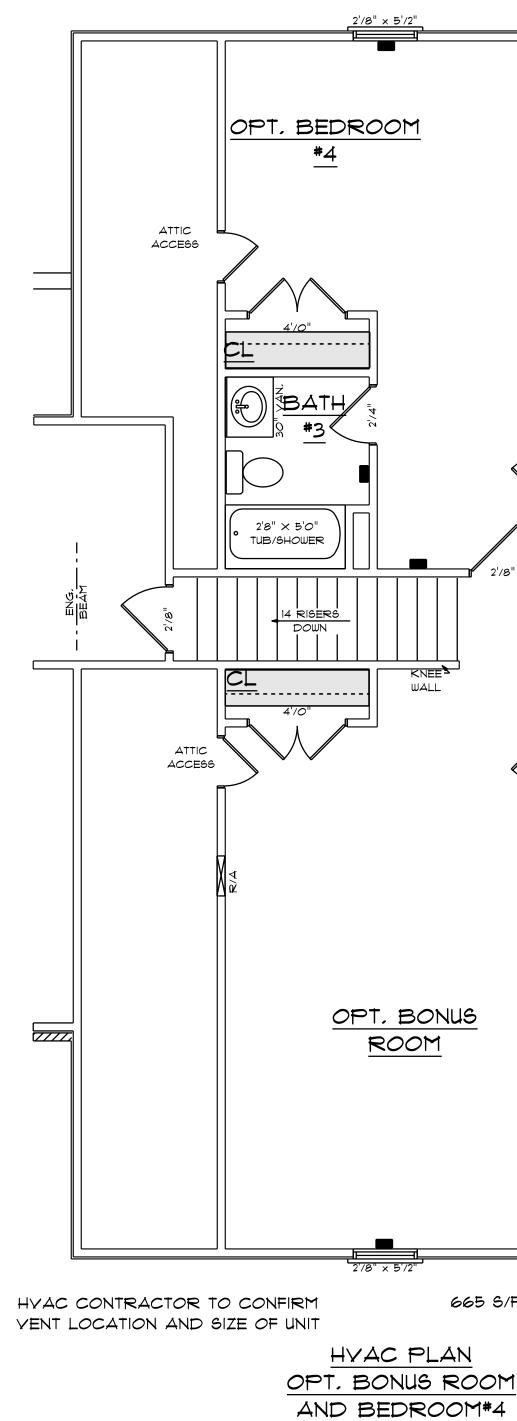

SCALE: 1/4" = 1'0"

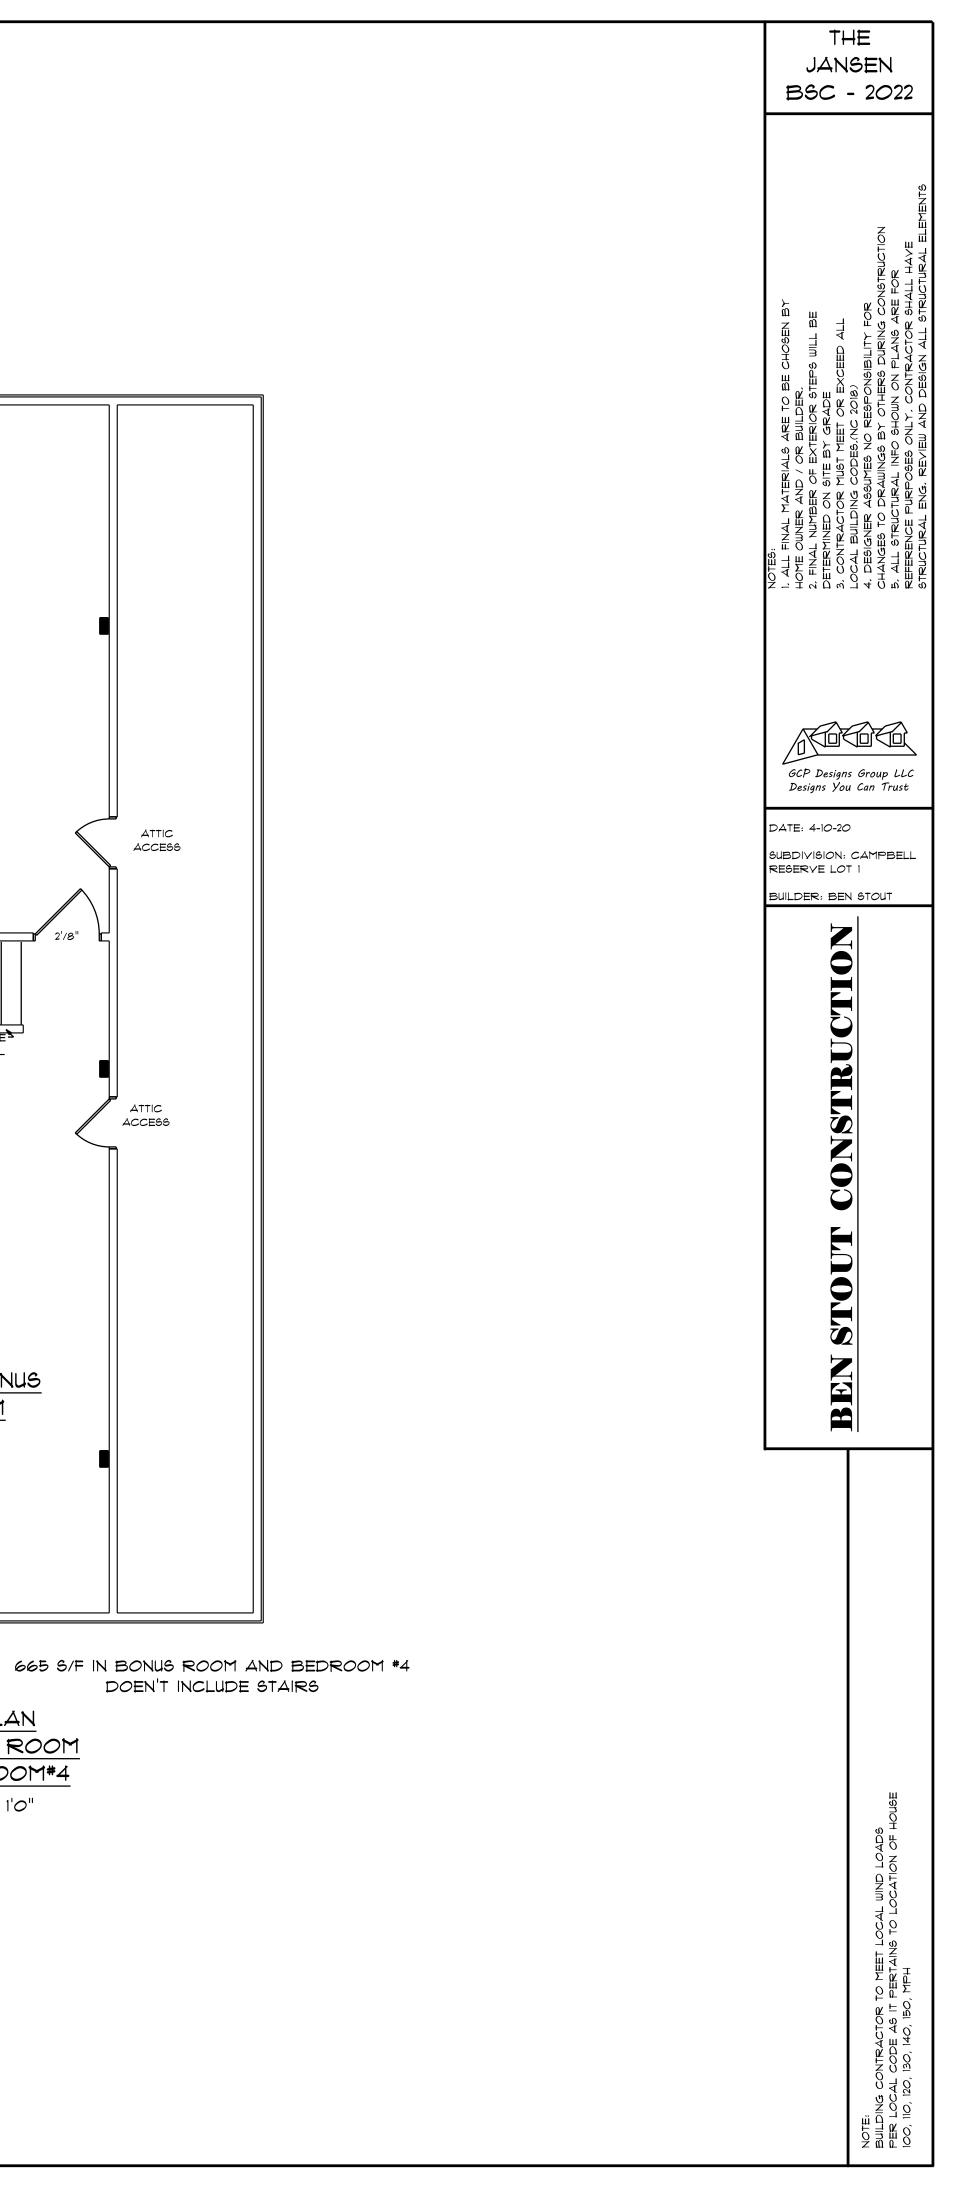


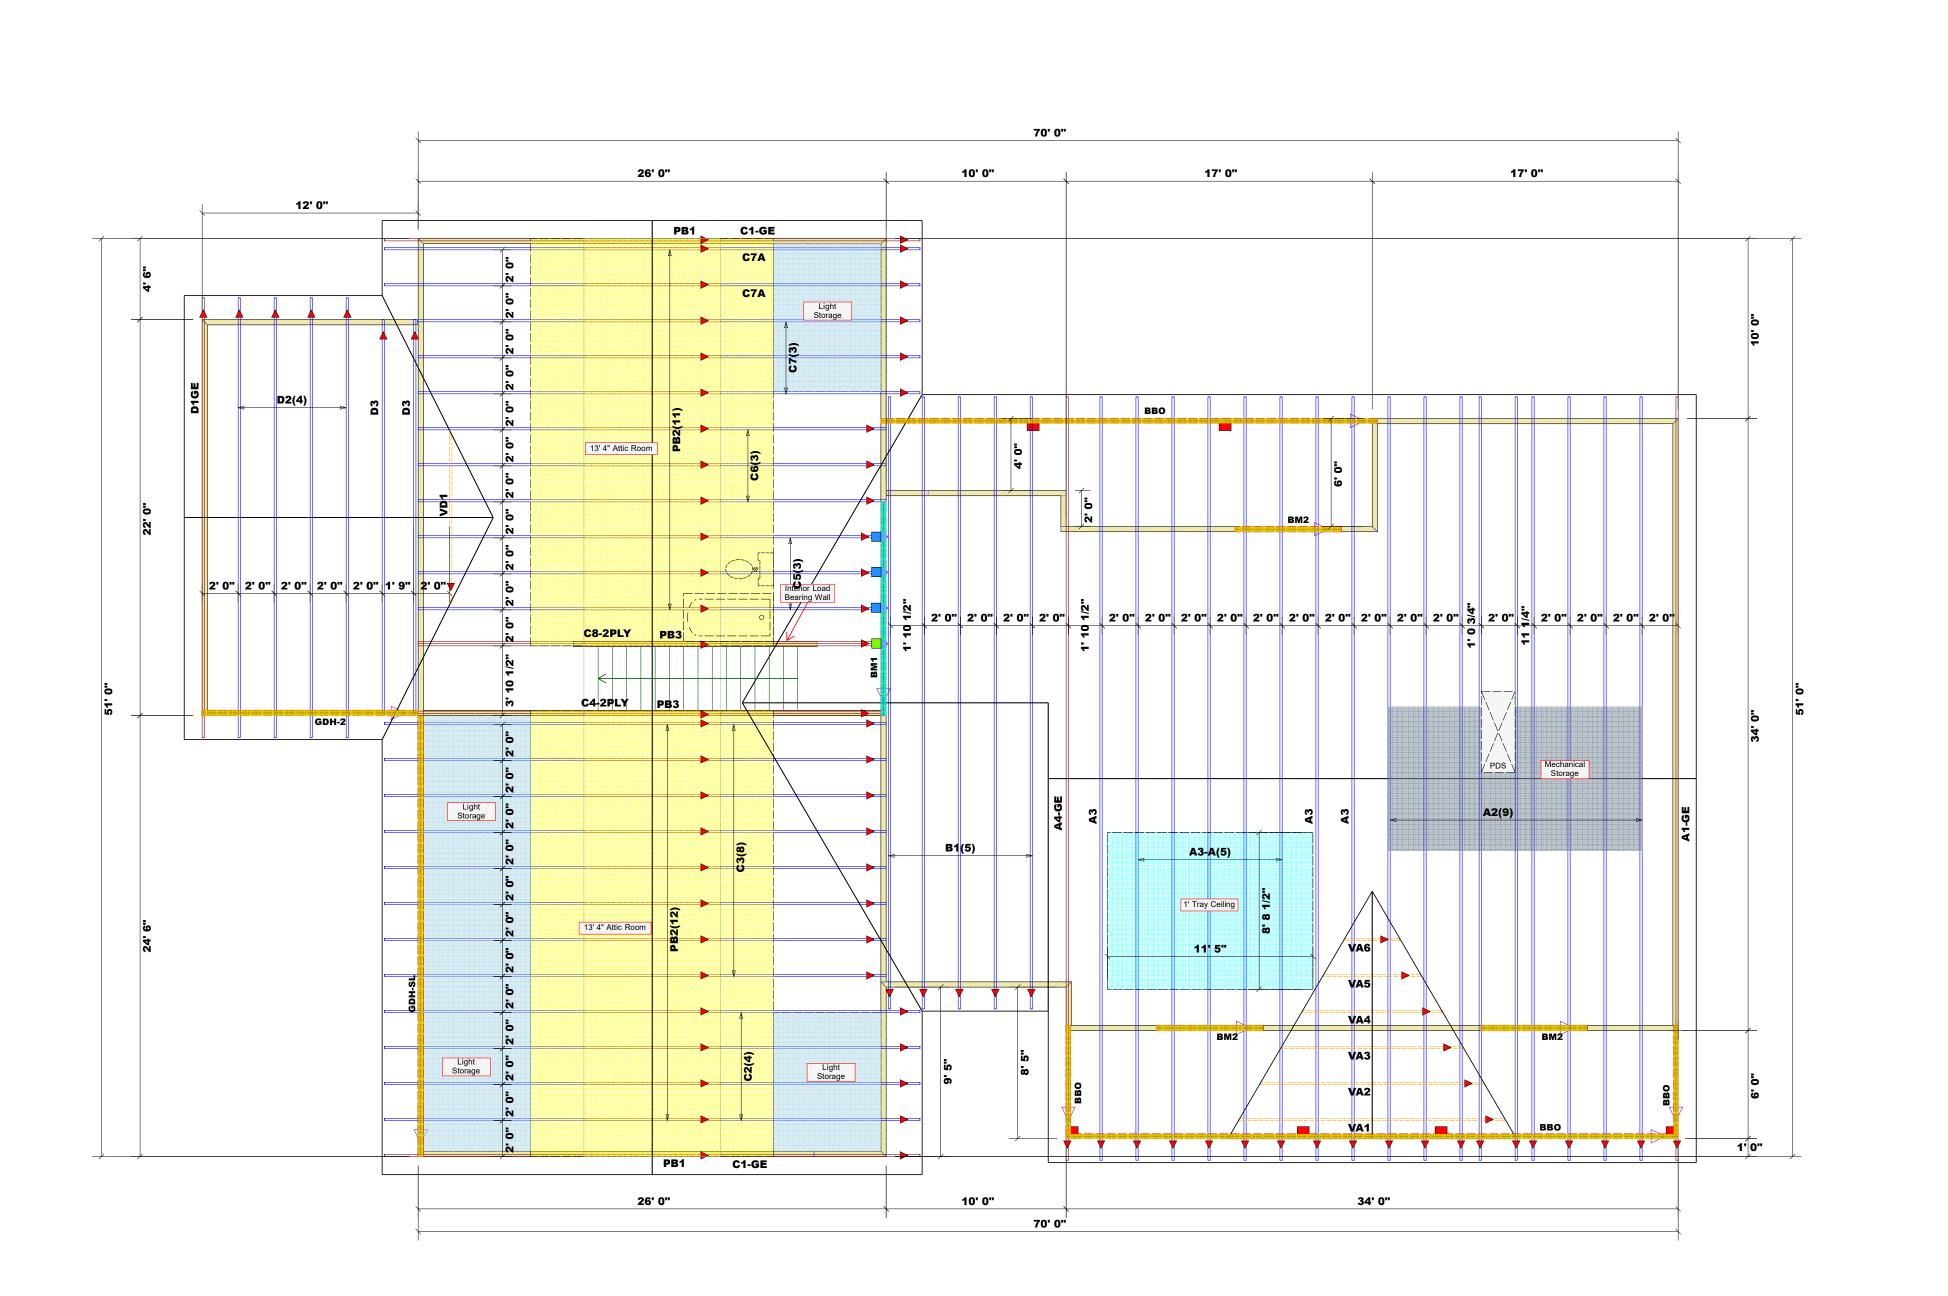

<pre>Indicates Left End of Truss</pre>	All Walls Shown Are Considered Load Bearing	Hatch Legend Light Storage
(Reference Engineered Truss Drawing) Do Not Erect Trusses Backwards	Roof Area = 4697.04 sq.ft.	Tray Ceiling
Truss Placement Plan	Ridge Line = 136.89 ft. Hip Line = 0 ft. Horiz. OH = 208.11 ft.	Drop Beam
Scale: 3/16"=1'	Raked OH = 233.87 ft. Decking = 161 sheets	Mechanical Storage

					Products					
Plo	tID	Lengt	h Pro	duct			Plies	Net Qty	Fab	Туре
BM	2	6' 0"	1-3	/4"x 9	9-1/4" LVL Kerto	o-S	2	6	FF	
BM	1	12' 0"	1-3	/4"x ′	11-7/8" LVL Ker	to-S	2	2	FF	
GD	H-2	12' 0"	1-3	/4"x ′	11-7/8" LVL Ker	to-S	2	2	FF	
GD	H-SL	25' 0"	1-3	/4"x 2	23-7/8" LVL Ker	to-S	2	2	FF	
		Conne	ctor Info	rmati	ion	N	ail Info	ormation		
Sym	Proc	duct	Manuf	Qty	Supported Member	Hea	ader	Truss		
	HUS	526	USP	3	BM1	16d/3	3-1/2"	16d/3-1/2"		
	THD	26-2	USP	1	Varies	16d/3	3-1/2"	10d/3"		

			~	<b>CI</b> 00F	-	
R	eilly R Fayet Phon	oad Ir	ndustr , N.C. 0) 864		'k	
deemed requirem attached requirem size and reactions 15000# retained reaction Tables retained	to comply nents. The Tables ( nents ) to number of s greater A register to design that exce	y with the e contract derived f determin of wood s than 3000 red desig n the sup eds thos ed design the sup	e prescrip tor shall r rom the p e the min studs req D# but no n profess port syste e specifie n profess port syste	I to 3000# tive Code refer to the prescriptivi imum fou- uired to s t greater t ional sha em for any ed in the a ional shal em for all	e e ve Code indation upport than II be y attached	
Signatu	°e		l Bag	gge <del>ll</del> gett	-	
	(BASED	ON TABLE	- ES R502.5(1	CK STL		
NOLLOY 24 (0 L AN) 1700 3400 5100 6800 8500 10200 11900 13600 15300	вед развидать     1     2     3     4     5     6     7     8     9     9	HEADER N (L a) 2550 5100 7650 10200 12750	G     C     C     C       G     F     E     C     C       G     F     C     C     C       G     F     C     C     C	NOTICE AND	00 1 00 2 00 3 00 4	
Harnett	D Spartan Ridge	Roof	4/20/2022	DRAWN BY Neil Baggett	Marshall Naylor	
CITY / CO. Harnett	ADDRESS	MODEL	DATE REV.	DRAWN BY	SALES REP.	
Ben Stout Real Estate	D Spartan Ridge	Ivey 2.0/ BSC-2022 w/SL & 3rd Car	6/9/2021	Quote #	J0421-2234	
BUILDER	JOB NAME	PLAN	<b>SEAL DATE</b> 6/9/2021	QUOTE #	JOB #	
These t compor design See ind identifie designe for the support and col designe consult	russes ar nents to b at the spo ividual de ed on the er is respo ent bracin overall st t structur umns is t er. For ge BCSI-B1	S PLACEN re designe ecification asign she placemen onsible for ng of the ructure. T e includim the respon neral guid and BCS	ed as ind prated int n of the b ets for ea nt drawin or tempor roof and The desig ng header nsibility of dance reg il-B3 prov	GRAM ON ividual buo o the buil uilding du ch truss g. The bu ary and floor sys floor s	ilding ding esigner. design ilding tem and russ , walls, ding racing, the	

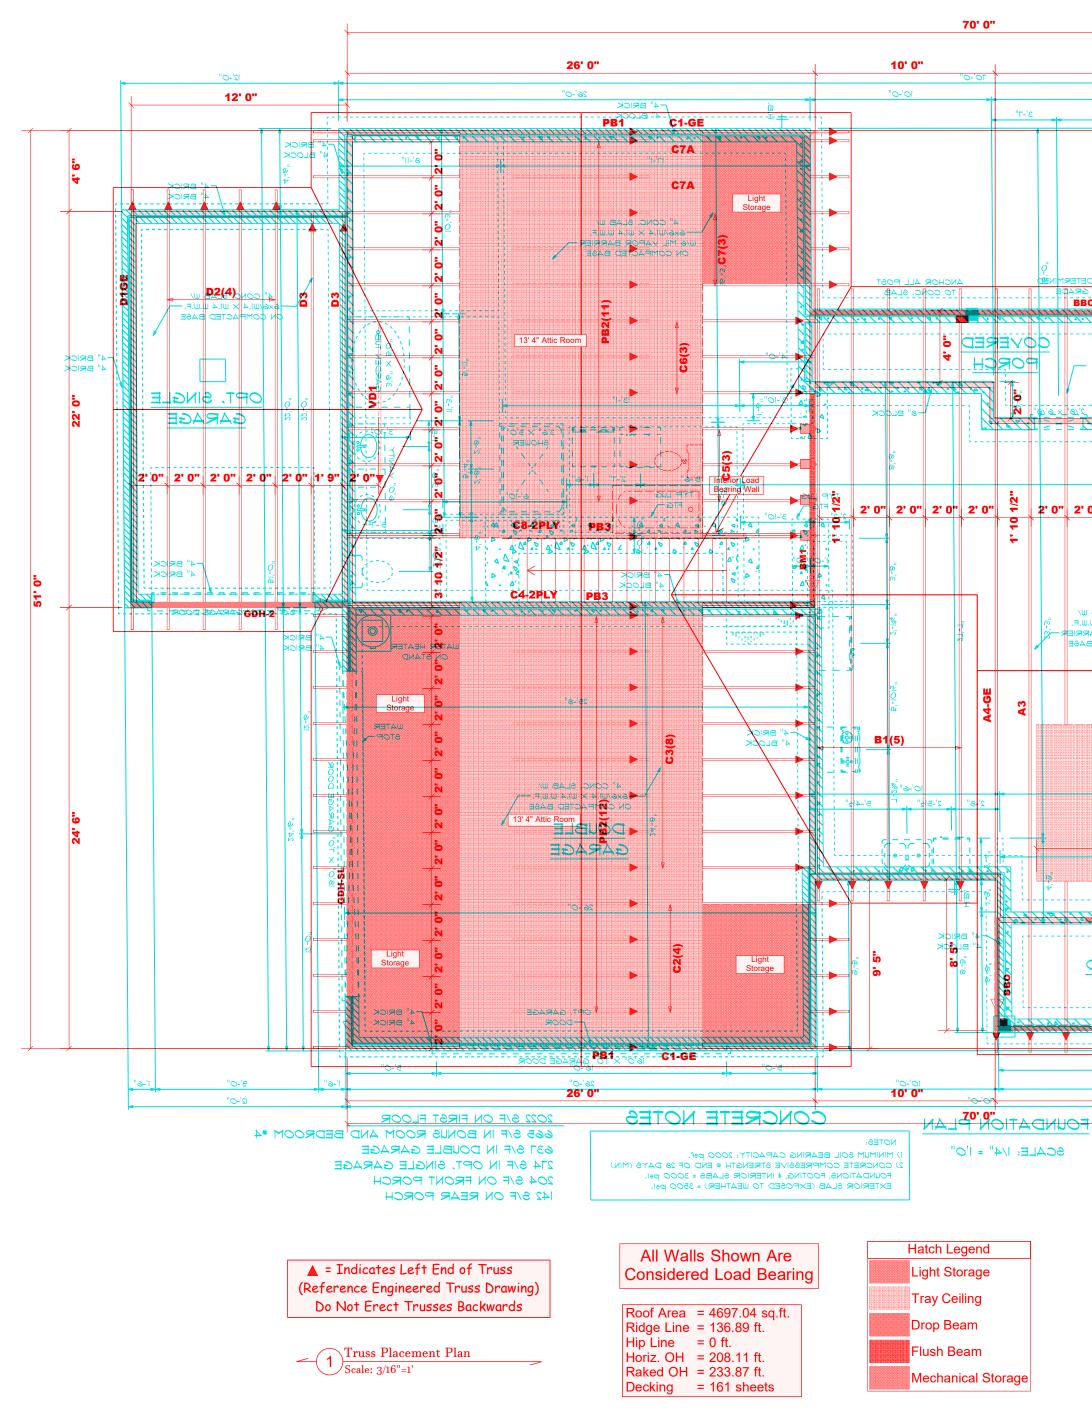

	17' <b>0</b> "										17	0"							
	"0-'TI '	' <del>3</del> -'81			_	-					"0-	'п				-			
89⊒⊺8 ∰	8X4 1 ~ TêO	-			Π		1	Π	Π	Π		Π	1	фіяа	"èffa		" 0 <u>0</u>		
							,											-/	-
. SLAB Sted Fill	" СОИС. СОМРАС			.0			-2"		-	0	— 93	1.4 W.W.F R BARR	CONC, 9 /WI,4 X U L VAPOF	axa M a/W	/				
 			BM2					======				ED BAS	DMPAC		12-40"				
⊃CK 36'-2"	-8" BL						(	ນ ກັ		† 0			" <del>0</del> 1-'11	nck Cck	-'4" BR 4" BLC				
2' 0"	2' 0'	2' 0"	2' 0'	" 2' (	)" 2'	' <b>0"</b>	2' 0'	2' 0"	0	"8-'8 <b>2</b>	<b>.</b>	2"0	<b>2' 0</b> "	2'0	)" <mark>2'0</mark>				
											0 -'  								
NC, SL4 4 × WI,4	4" C0 6×6/W1									\ <u>"8-</u>	.7 Q	1 1 1 1 1 1 1 1 1 1 1 1 1 1 1 1 1 1 1	2 1;    2'-6"				+- CC	10-1 <del>2</del> 1-01	
APOR	6 MIL V ON COM	ί '					<i>w</i>	2'-5"		/ / / PDS	5		пиду "o lanical rage	2				ſ	ò
			<b>38</b> O.		A3		-			A2(	:==: 9)	j <b>u</b> .25				A1-GE			
Щ							17. 17.					.4 w.w.⊨	<b>сонс. s</b> /wi.4 ×  w L ∨ АРФ	exe-		W.			
1' Tray	<u>y Ceiling</u>	8 <mark>12-11</mark>				$\land$					Ξ	ED B46	TDA9MO:	ON C					
11	' 5''	<b>60</b> F- 81			VAG									RICK .OCK					
ock	-8" BLC	╄			VA5		••••						<u>   -  0 </u>						
	BM2				VA4		2'78		<u>}</u>			BM2						_	-
ERE RCH				<u>_</u> -		<b>F</b> BA	4" CON COMP	 чие вдее			(08"	8	LL POST	RICK _OCK HOR A			0		<b>b</b>
					VA1							BBO						<i>(</i> 1'0	
	"0-'TI	U	U	<u> </u>		94'-0			u	u	"(	о-'гі	U	u	U				
				(			E												
					6 .52	320 14	' = 2' = 2T	× 20 20	<ε ×	05. 063	. × >.	60 ) 22 X	R 21 6 22C	00. 4114	zω Π≟				
						97	Proc		БЛ		84	262.	W\89 <u>e = -</u>	<u>TA</u>					
	PlotI BM2 BM1		Length 6' 0" 12' 0"	1-3 1-3	3/4"x ^	1-7	/8" LVI	Kerto-S - Kerto-	S	Plies 2 2	6 2		Fab 1 FF FF	уре					
	GDH GDH	I-SL	12' 0" 25' 0"	1-3	3/4"x 2	23-7		_ Kerto- _ Kerto-	S	2	2		FF FF						
	Sym	Produ		Manuf	Qty	S	upporte Membe	r	Hea		Т	russ							
		HUS2		USP USP	3 1		BM1 Varies			-1/2" -1/2"		/3-1/2" )d/3"							

			Te		
	RUS eilly R Fayet Phon	DF & SES toad I teville e: (91	<b>&amp; FL</b> <b>&amp; B</b> ndustr e, N.C. 0) 864-4	EAN ial Par 28309 -8787	<b>/\S</b> ˈk
deemed requirem attached requirem size and reaction 15000#. retained reaction Tables. retained	to comply nents. The Tables ( number of s greater A register to design that exce A register to design s that exce	y with the contract determine of wood than 300 red design the sup red design the sup red design the sup red design the sup	in or equa e prescriptor shall r from the p ne the min studs req 10# but no gn profess oport syste se specific n profess oport syste 00#.	tive Code efer to the prescriptivi imum fou- uired to s ional shate ional shat	e eve Code indation upport than II be v ttached I be
	AD CHA	ART F	l Bag	CK STL	IDS
		CK STUDS	gray fermion   0 1   0 2   0 3   0 4   0 5		00     00     00     00       8EQ'D STUDS FOR     (4) PLY HEADER
Harnett	D Spartan Ridge	Roof	4/20/2022	DRAWN BY Neil Baggett	SALES REP. Marshall Naylor
<b>CITY / CO</b> . Harnett	ADDRESS	MODEL	DATE REV.	DRAWN BY	SALES REP.
Ben Stout Real Estate	JOB NAME D Spartan Ridge	Ivey 2.0/ BSC-2022 w/SL & 3rd Car	6/9/2021	Quote #	J0421-2234
BUILDER	JOB NAME	PLAN	<b>SEAL DATE</b> 6/9/2021	QUOTE #	JOB #
These t compor design See ind identifie designe perman for the support and col designe consult	nents to b at the spo ividual de ed on the er is respo ent bracin overall st structure umns is t er. For gen BCSI-B1	re design be incorp ecification esign sho placeme placeme onsible f ng of the ructure. e includi the respondent neral gui and BC	MENT DIA med as indi ioorated into on of the b eets for ea ont drawing or tempor- a roof and The desig ng header onsibility of dance reg SI-B3 prov r online @	ividual bu o the buil uilding do the truss g. The bu ary and floor sys n of the t s, beams of the buil parding br ided with	ilding ding asigner. design ilding tem and russ , walls, ding acing, the