# SOUTHPORT

# SOUTHPORT REVISION LIST - STRUCTURAL:

- . COMBINED WILMINGTON AND WILMINGTON II PLANS, (2-18)
- 2. ADDED BRICK OPTION ON SECOND FLOOR. (2-18)
- . CALLED OUT SERIES/SPACING OF L-JOISTS ON BASEMENT. (2-18)
- 2018 NCRC UPDATE (6-19)
- 5. 2018 SC IRC (2-15-20)
- 6. ADDED ELEVATION A.2 (BRICK WATERTABLE W/ SIDING ABOVE) & ELEVATION A.3 (STONE WATERTABLE W/ SIDING ABOVE). (2-15-20)

# SOUTHPORT REVISION LIST - ARCHITECTURAL:

#### AUGUST 01, 2021

- CREATED ELEVATIONS TO BE IN STANDARDS WITH OTHER PLANS (SEE SHEETS A-1 THROUGH A-3,5)
- 2. CHANGED COLUMNS ON ELEVATIONS TO STANDARD COLUMNS
- 3. CHANGED GARAGE DOORS TO REPRESENT STANDARD GARAGE DOOR FOR EACH ELEVATION
- 4. FIXED COVERED PORCH TO KEEP COLUMNS FROM OVERLAPPING EDGE OF CONCRETE
- 5. REMOVED GRIDS FROM TRANSOMS ABOVE FRONT DOOR
- ADDED NOTE FOR GARAGE DOOR "GARAGE DOOR PER SPECIFICATIONS AND GLASS INSERT (TOP PANEL ONLY)"
- 7. MOVED ROOF PLANS TO SHEETS A-8 & A-8,1
- 3. CREATED SLAB INTERFACE PLAN (SEE SHEET A4 THROUGH A4.2)
- 9. MOVED ALL OPTIONS OFF BASE PLAN AND PLACED ON SEPARATE SHEET
- 10. ADDED NOTE FOR FLUSH COUNTERTOP ON ISLAND
- 11. CHANGED PATIO SIZE TO STANDARD 12'X10'
- 12: ADDED OPTIONAL GAS LINE
- 13. CHANGED KITCHEN LAYOUT
- 14. ADDED 2ND HOSE BIB
- 15. CALLED OUT "45" WALL WITH CAP" AS STANDARD
- CHANGED ALL EXTERIOR WALLS FROM 2X6 TO 2X4 EXCEPT WHERE SHADED
- 7. ADDED NOTE "OPT. REF."
- 18. REMOVED NUMBERS ON STAIRS
- ADDED NOTE "OPT. W/
- 20. ADDED NOTE "WASHER ALWAYS TO BE LOCATED TO THE LEFT OF DRYER
- 21. VERIFIED VENTILATION AND LIGHT REQUIREMENTS AT OWNER'S BEDROOM MEETS CODE (11-01-20)
- 22. SQUARE FOOTAGES ARE UPDATED AND CHANGED DUE TO MOVEMENT OF WALLS FROM 2X6 TO 2X, TO KEEP JOGS IN ROOMS,
  - EXTERIOR WALL MOVED MEANING ROOF LINES HAVE CHANGED
- 23. SQUARE FOOTAGE OF COVERED PORCH CHANGED DUE TO KEEPING COLUMNS FROM OVERLAPPING CONCRETE EDGE
- 24. CREATED PARTIAL PLANS FOR B & C ELEVATIONS (FLOOR, SLAB, & ELECTRICAL)
- 25. REMOVED ALL WALL OUTLETS
- 26. REMOVED ALL PHONE OUTLETS
- 27. REMOVED ALL TV OUTLETS
- 8. PLACED STANDARD 3 BULB LIGHT IN KITCHEN
- 9. VERIFIED COACH LIGHT LOCATIONS (SEE ELEVS, FOR DIMS.)
- 30. PLACED DASHED FANS WHERE APPLICABLE WITH NOTE "STD, LIGHT, OPT, FAN/LT PREWIRE"
- UPDATED ELECTRICAL KEY
- VERIFIED CO2 DETECTOR LOCATIONS
- 33. SHOWED PENDANT LIGHTS AS OPTIONAL
- 34. SHOWED CAN LIGHTS IN KITCHEN AND FAMILY ROOM AS "OPTIONAL CAN LIGHTS"
- PLACED OPTIONAL FLOOD LIGHTS
- 36. PLACED OPTIONAL FLOOR OUTLET IN FAMILY ROOM
- 7. PLACED CALCULATIONS FOR SOFFIT AND RIDGE VENT REQUIREMENTS
- 38. UPDATED STAIR LAYOUT TO KEEP MAIN WALL AT KITCHEN FROM MOVING WHEN OPTIONAL BASEMENT SELECTED.

HOMES

201104


**COVER SHEET** 

H HOMES


NCKCR5

DATE SEPTEMBER 16, 2015
REV. AUGUST 01, 2021
DRAWN BY:
ENGINEERED BY:

CS

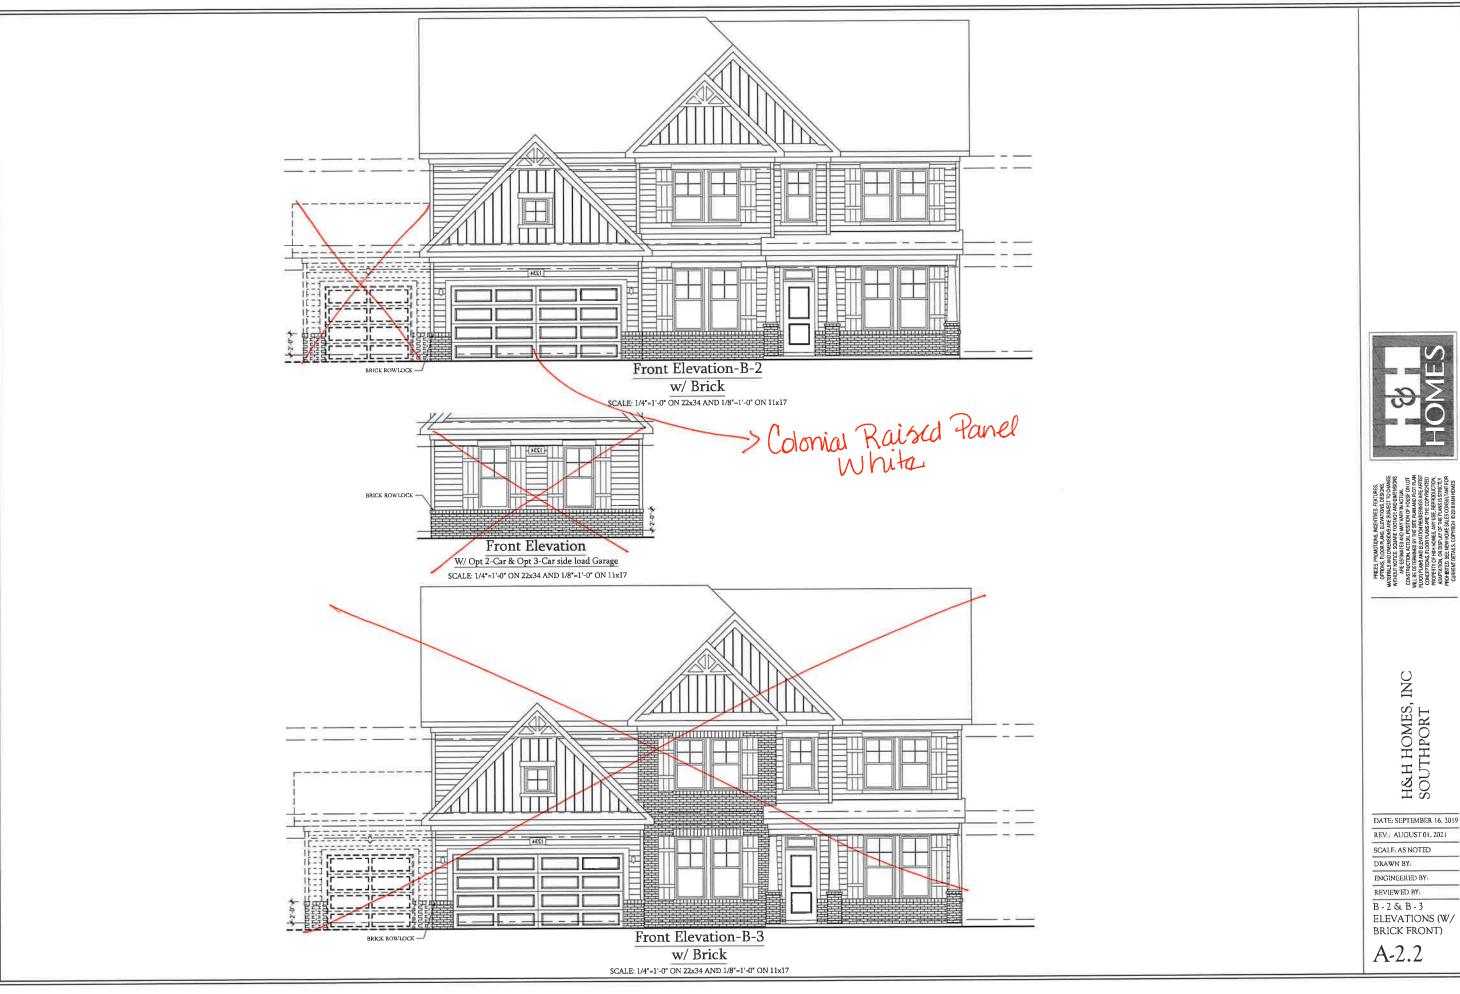



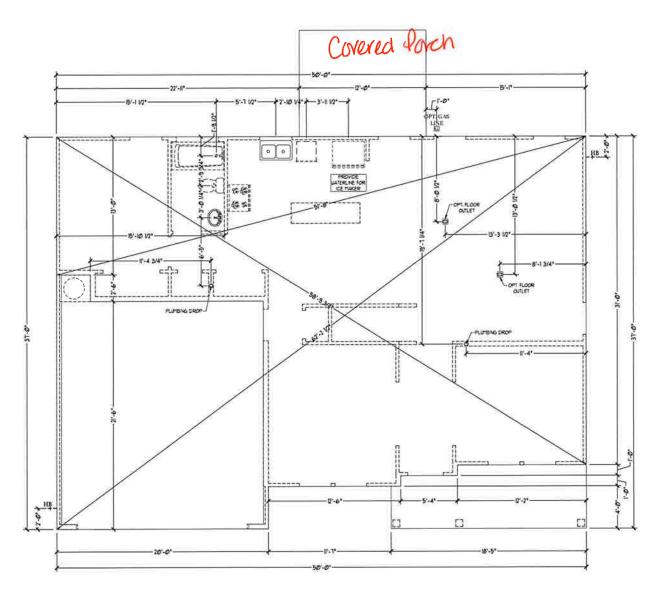

 $\underbrace{Slab\ Interface\ Plan}_{SCALE:\ 1/4"=1"-0"\ ON\ 22x34\ AND\ 1/8"=1"-0"\ ON\ 11x17}$ 



H&H HOMES, INC SOUTHPORT

DATE: SEPTEMBER 16, 2019


REV: AUGUST 01, 2021


SCALE: 1/4"=1'0" DRAWN BY

ENGINEERED BY:

REVIEWED BY:

SLAB INTERFACE PLAN

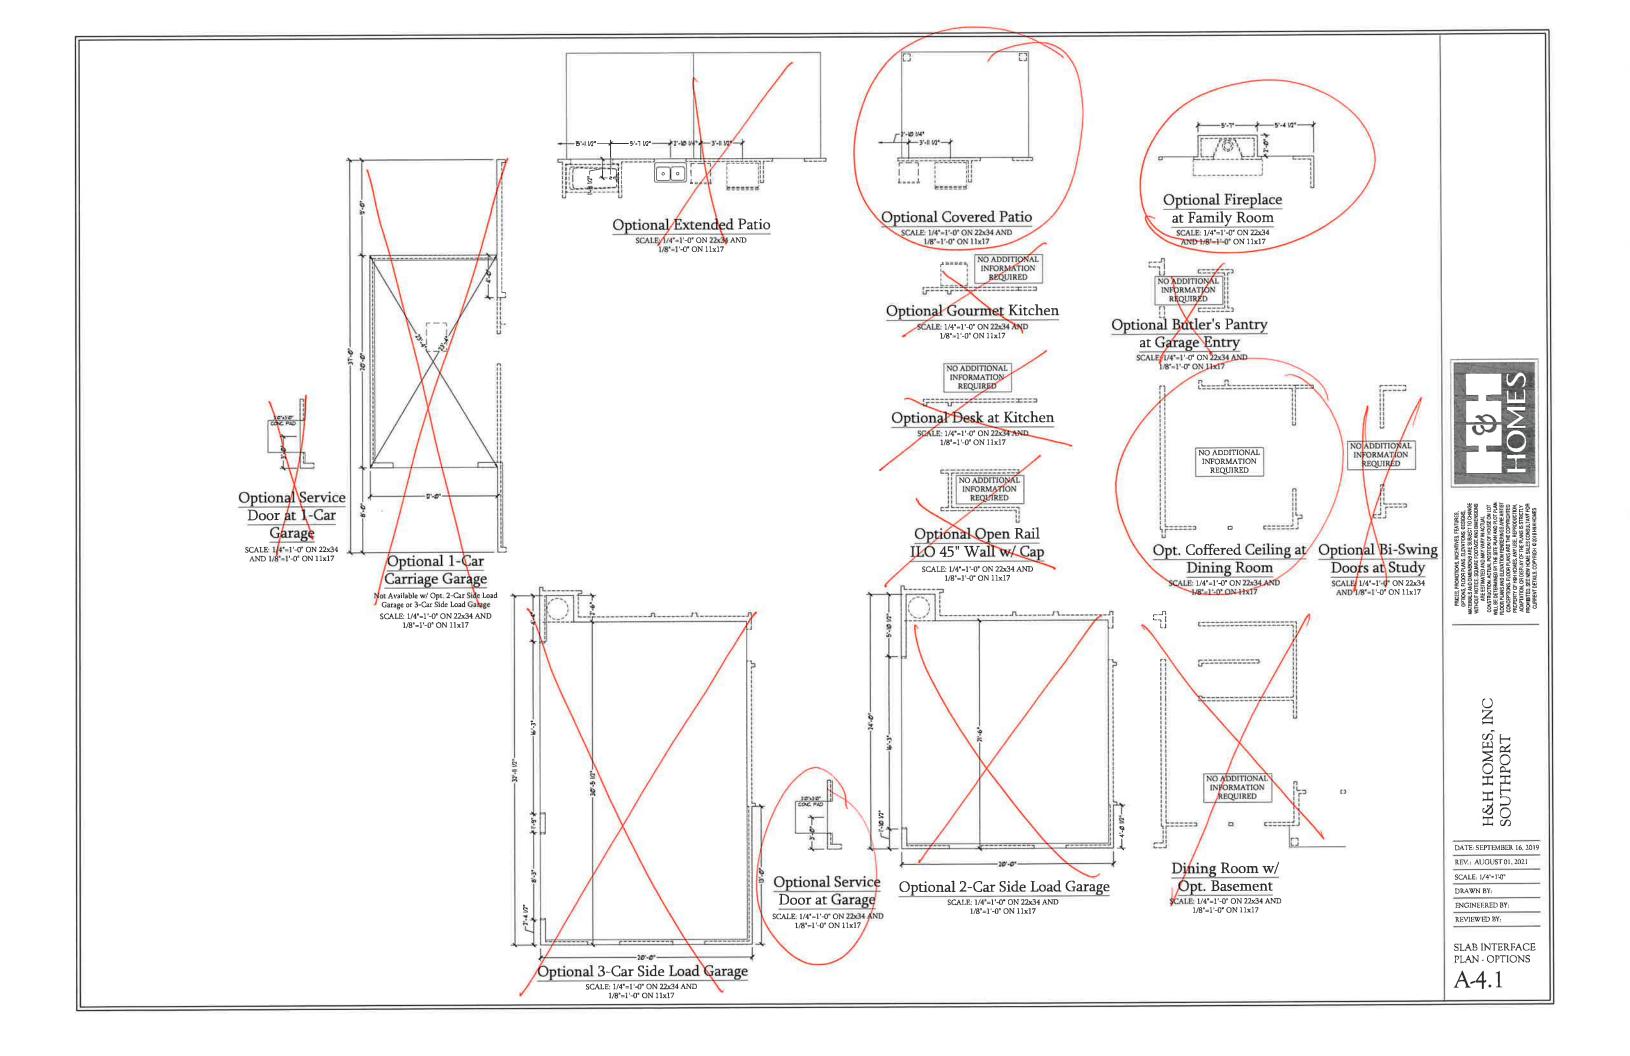

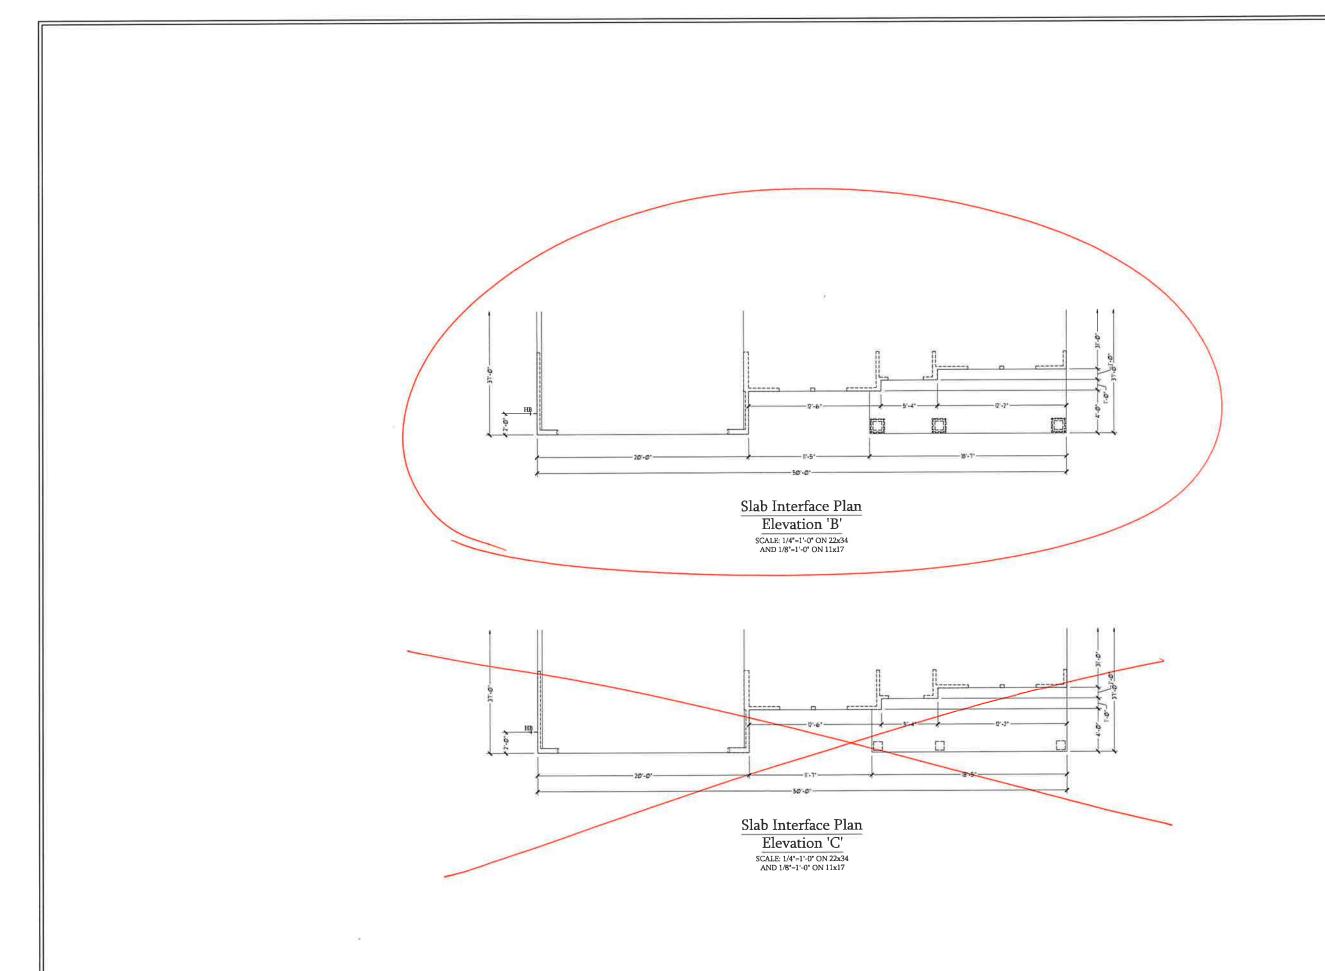



H&H HOMES, INC SOUTHPORT

DATE: SEPTEMBER 16, 2019 REV.: AUGUST 01, 2021


SCALE: 1/4"=1'-0"

DRAWN BY:

ENGINEERED BY: REVIEWED BY:

SLAB INTERFACE PARTIAL PLANS

A-4.2

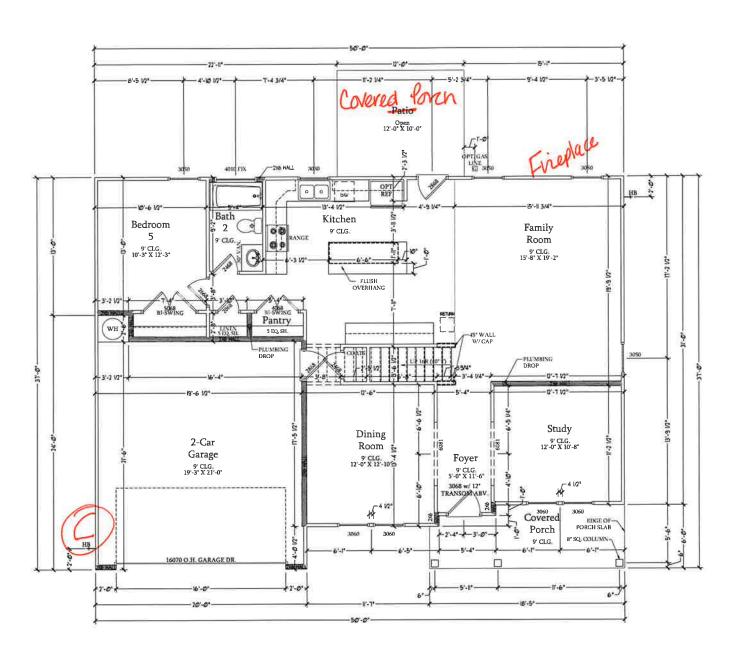

First Floor Plan SCALE: 1/4"-1"-0" ON 22x34 AND 1/8"-1"-0" ON 11x17 | SQUARE FOOTAGE | 100 SQUARE FOOTAGE FOOTA

SQUARE FOOTAGE W BRIC	K VENEER
Ist FLOOR.	1321 5Q FT
2nd FLOOR	1,626 SQ FT
TOTAL:	7,941 SQ FT
GARAGE:	43Ø 5Q FT
FRONT PORCH:	104 50 FT
PATIO:	120 50 FT
OPT BASEMENT:	13TI 5Q. FT
IN FLOOR OPTIONS	
OPTIONAL FIREFLACE	5 50 FT
IN FLOOR W OF T. BASEMENT	25 SQ FT
2nd FLOOR OPTIONS	
2nd FLOOR W OPT, BASEMENT	25 SQ FT
INHEATED OFTIONS	
OPT 1-CAR GARAGE	258 SQ. F1
OPT 3-CAR GARAGE	636 SQ FI
OPT COVERED PATIO	170 90 FI
OPT EXTENDED PATIO	120 5Q F



H&H HOMES, INC SOUTHPORT


DATE: SEPTEMBER 16, 2019 REV.: AUGUST 01, 2021


SCALE: 1/4"-1"0"

DRAWN BY:

ENGINEERED BY:

FIRST FLOOR PLAN

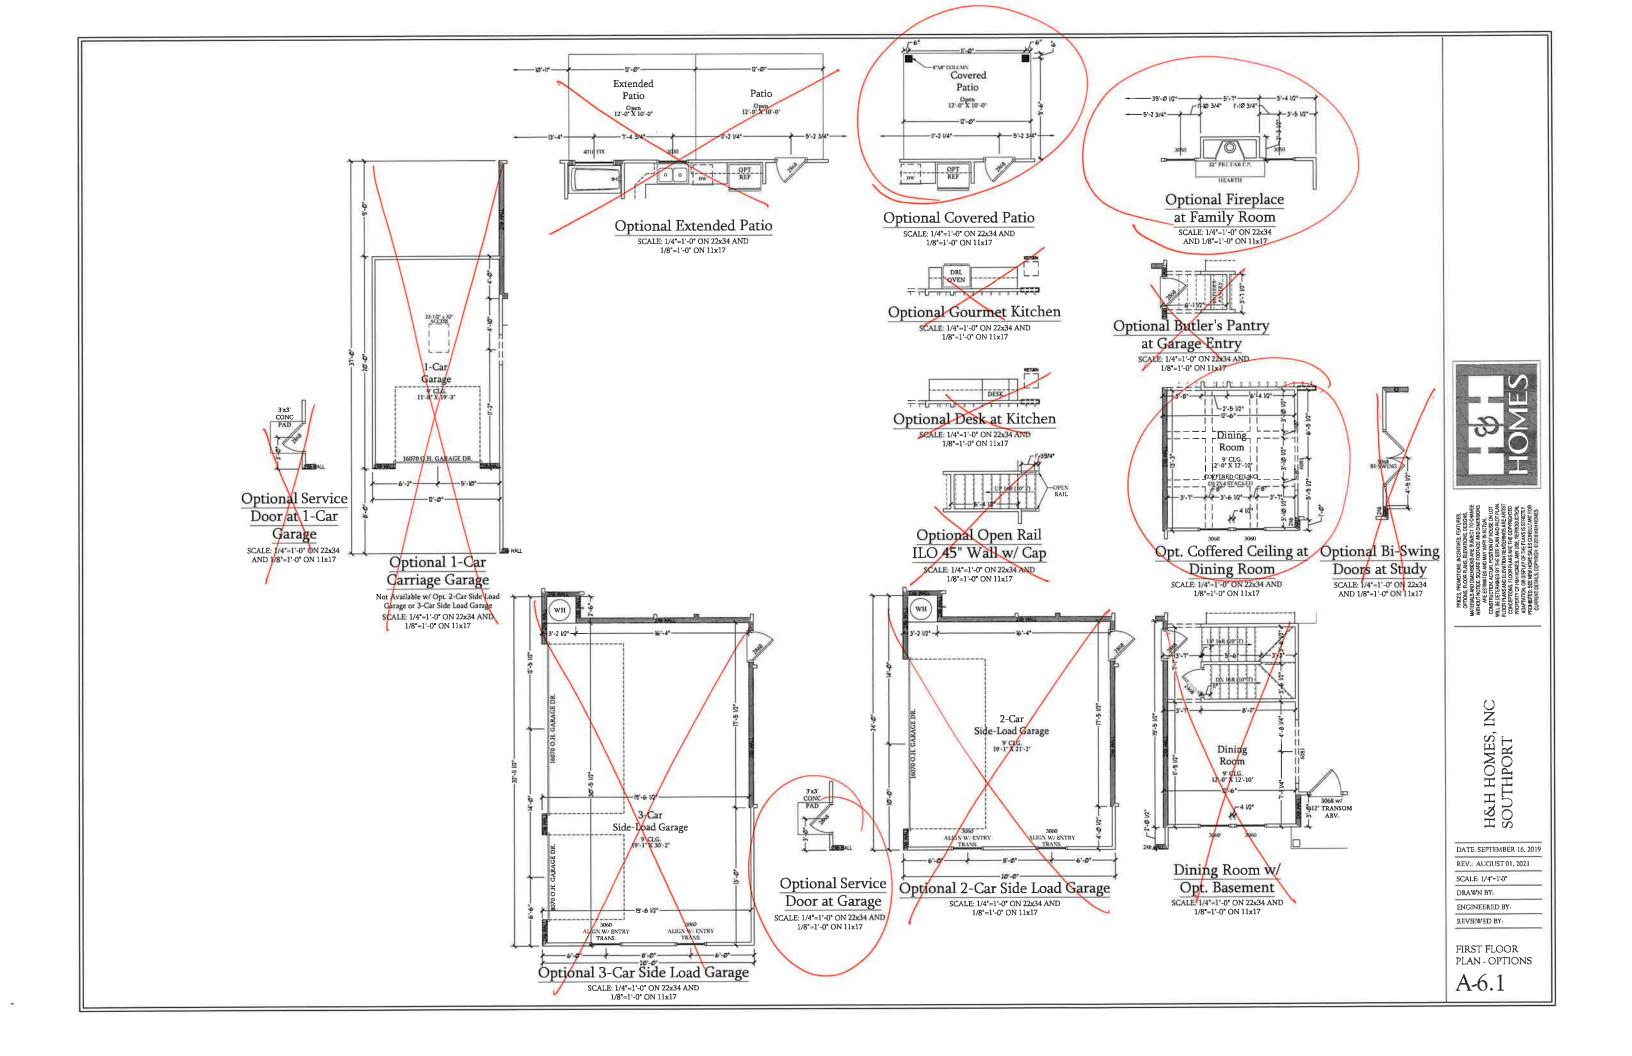

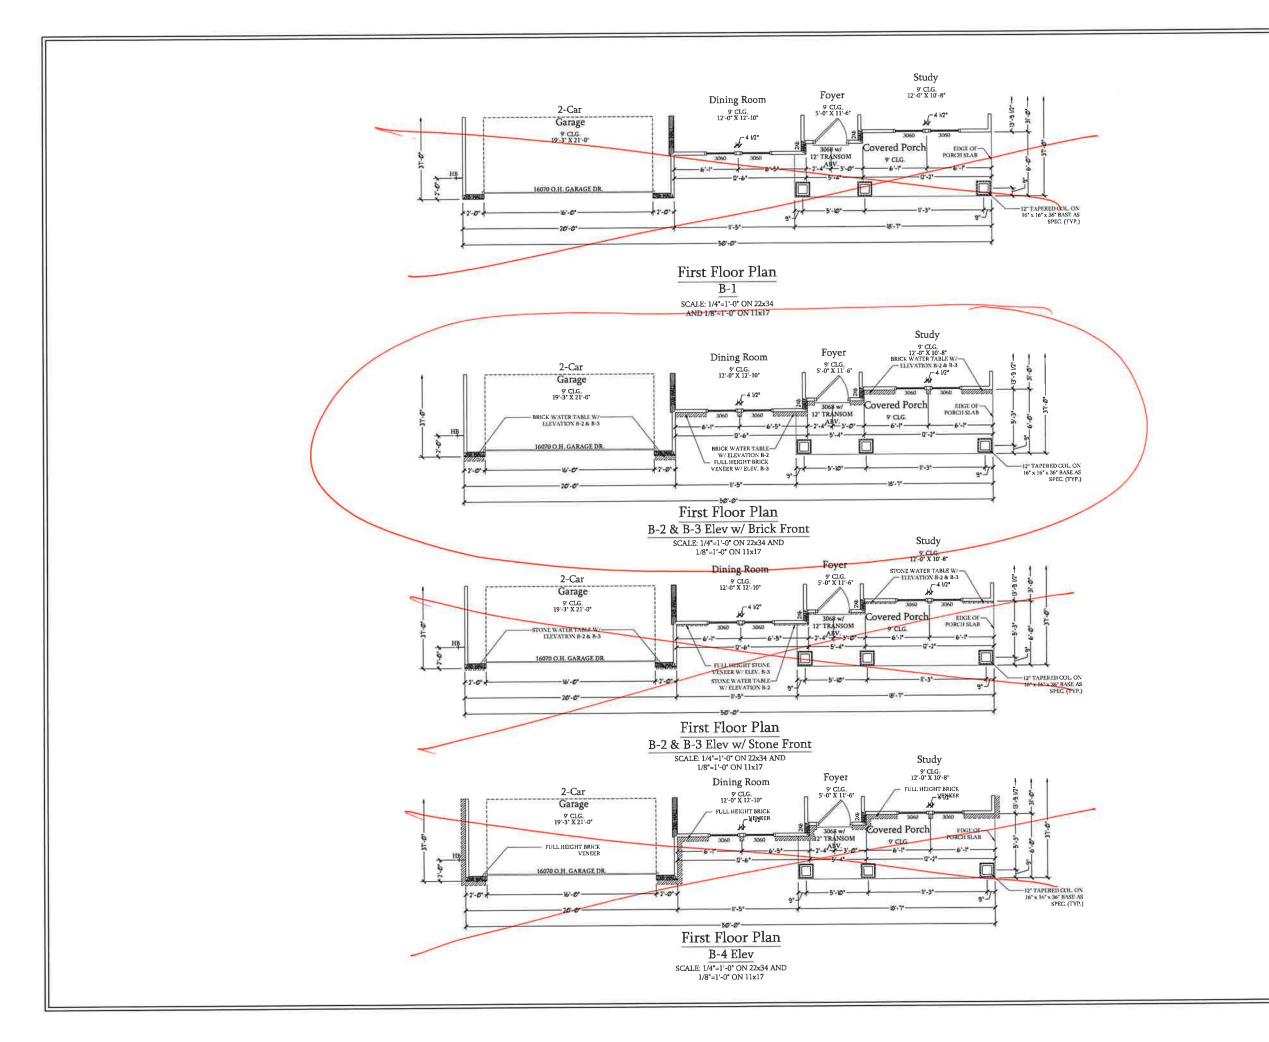



TOTAL SECURIOR ESTATIONS

TOTAL SECURIOR ESTATION

TOTAL SECURIOR

H&H HOMES, INC SOUTHPORT

DATE: SEPTEMBER 16, 2019

REV.: AUGUST 01, 2021

SCALE: 1/4"=1'-0"


DRAWN BY:

ENGINEERED BY:

REVIEWED BY:

B ELEVATION FIRST FLOOR PARTIAL PLANS

A-6.3

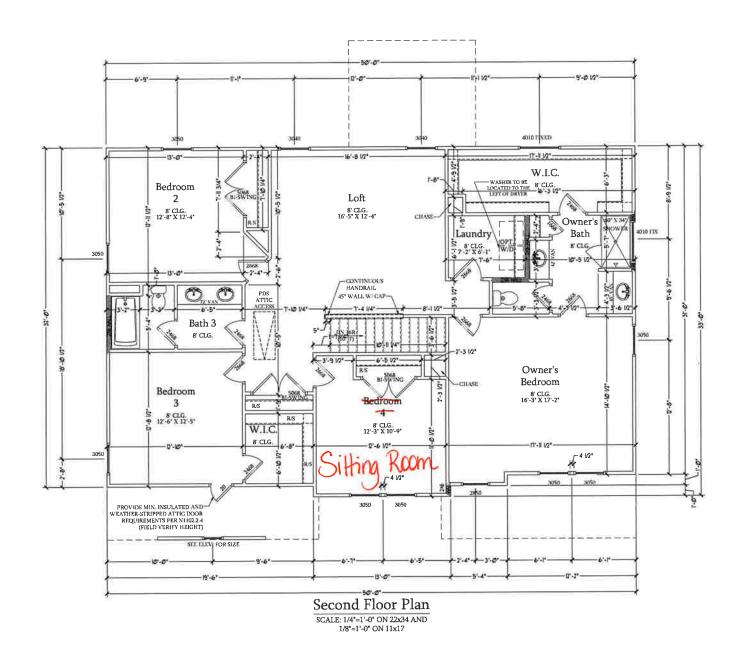



OFTINGS TOOR PLANS THE PARKNINGS SEGIES.

WITCH THE STATE TO THANKS THE STATE THANKS THE STATE THANKS THE STATE THANKS THE STATE THANKS THE TO T

H&H HOMES, INC SOUTHPORT

DATE: SEPTEMBER 16, 2019 REV: AUGUST 01, 2021


SCALE: 1/4"=1'-0"


DRAWN BY

ENGINEERED BY:

REVIEWED BY:

SECOND FLOOR PLAN

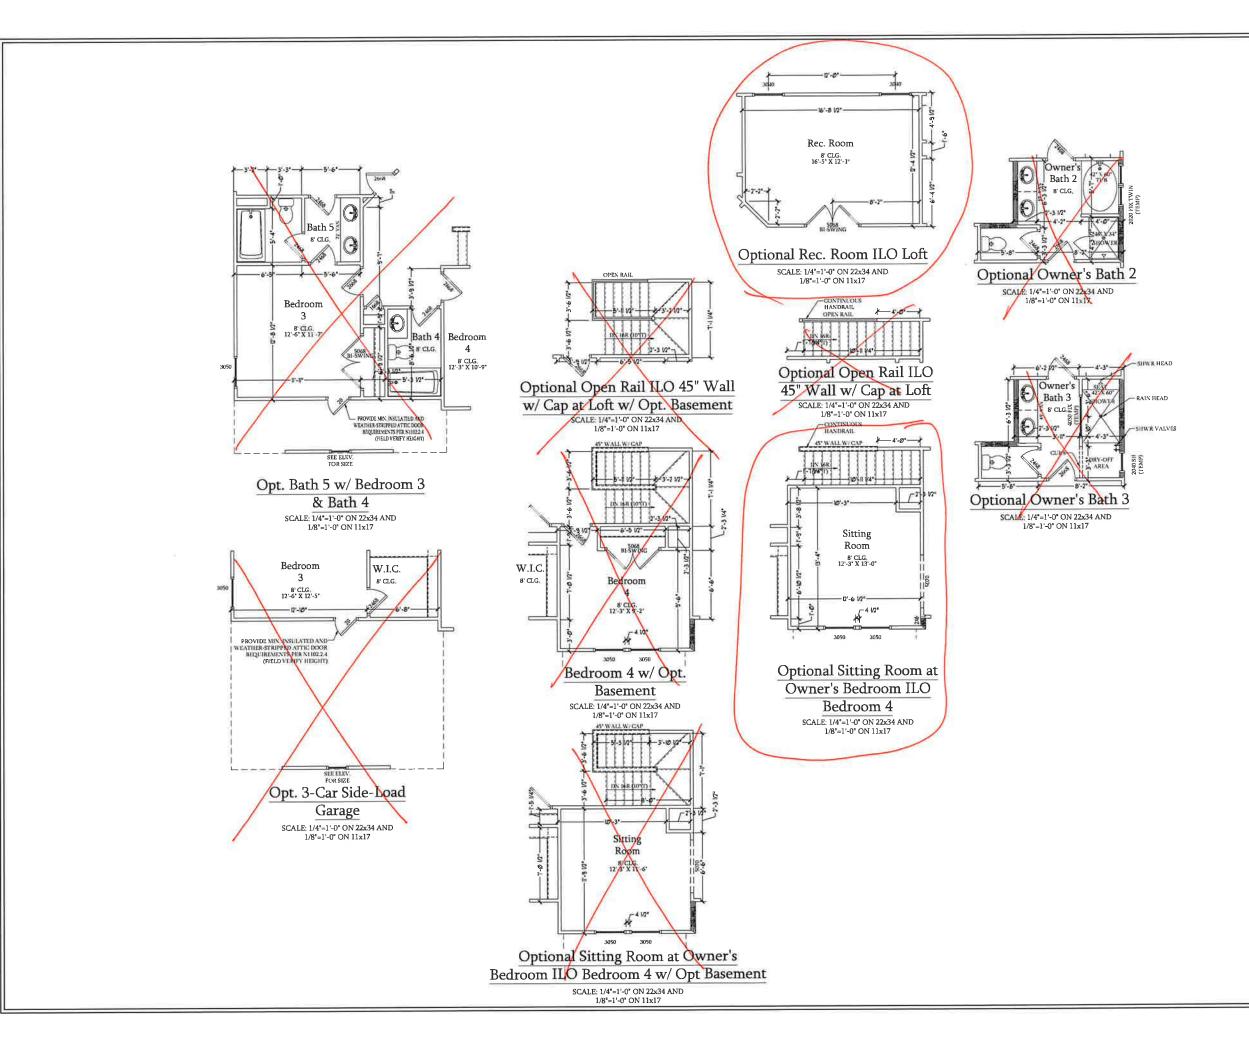

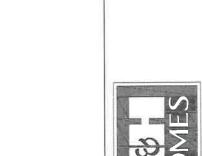

THE STATE OF THE ALL STATES OF

H&H HOMES, INC SOUTHPORT

DATE: SEPTEMBER 16, 2019
REV.: AUGUST 01, 2021

SCALE: 1/4"=1'-0"


DRAWN BY:

DRAWN BY: ENGINEERED BY:

REVIEWED BY:

SECOND FLOOR PLAN - OPTIONS

A-7.1

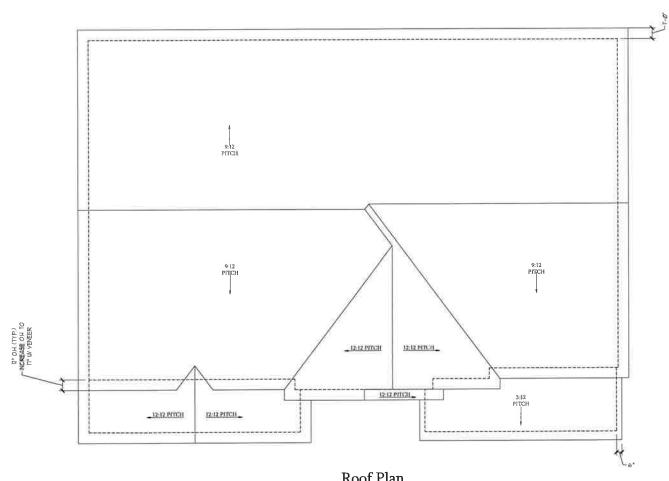

TOTAL UNDER ROOF AREA:

VENTING AREA REQUIRED:

TOTAL REQUIREMENTS:

LOWER: 2.66

LOWER: 2.66

LOWER AREA VENTING

SOFFIT VENT

SIZE:

PER UNIT: # UNITS: PROVIDED:

- .041 SF/LF 70-0\* 2.87

LOWER AREA VENTING

RIDGE VENT

SIZE:

PER UNIT: # UNITS: PROVIDED:

- .125 SF/LF 49-0\* 6.125

UPPER AREA PROVIDED

TOTAL AREA PROVIDED

SOFFIT AND RIDGE VENT

10.162

Roof Plan Elevation A & B SCALE: 1/4\*=1\*-0\* ON 22x34 AND 1/8\*=1\*-0\* ON 11x17



H&H HOMES, INC SOUTHPORT

DATE: SEPTEMBER 16, 2019

REV,: AUGUST 01, 2021


SCALE: 1/4"=1'-0"


DRAWN BY:

ENGINEERED BY:

REVIEWED BY:

ELEVATIONS A & B ROOF PLAN

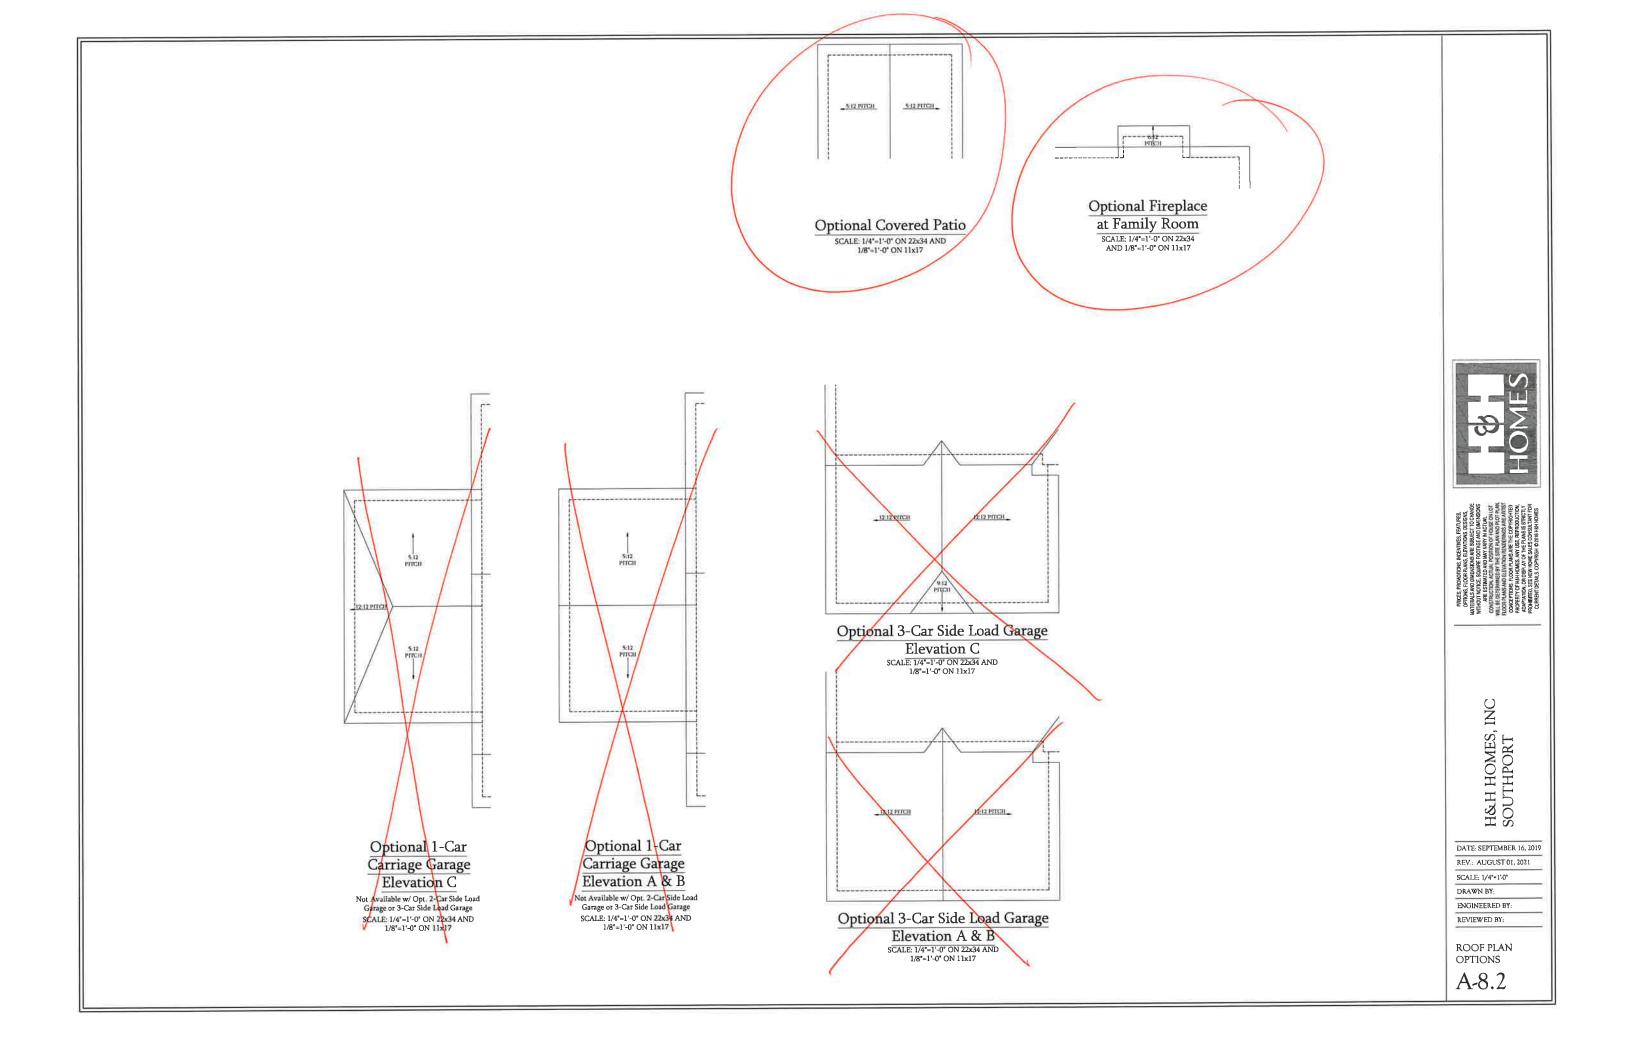

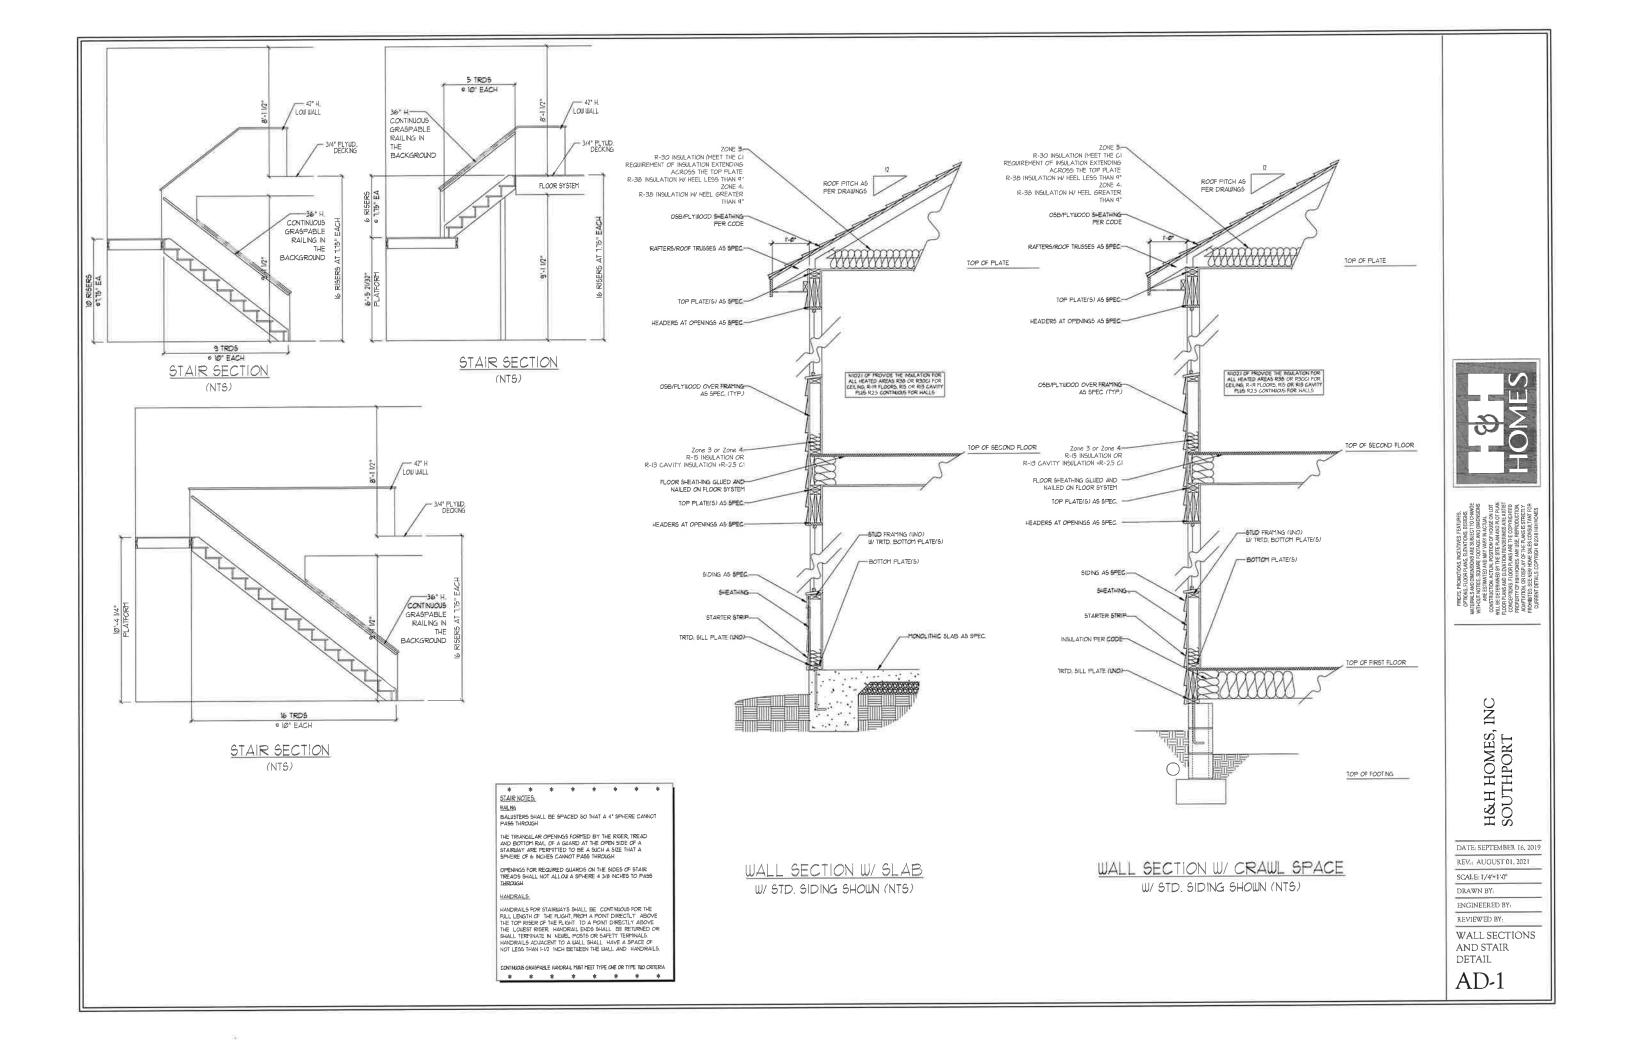

#### ELECTRICAL LEGEND

- ⇒ 120V OUTLET
- 120V GFI OUTLET
- 120V SWITCHED OLITLEI
- 4-PLEX 0 FLOOR MOUNTED 120V

- WEATHERPROOF
- 220V OUTLET

- SPECIAL PURPOSE (240 V, ETC.)
- ሷ WALL MOUNT LIGHT
- CEILING MOUNT LIGHT
- PENDANT LIGHT
- $\Diamond$ RECESSED CAN LIGHT MINI CAN LIGHT
- $\bigcirc$ EYEBALL LIGHT
- FLUORESCENT LIGHT UNDERCABINET LIGHT
- FLOOD LIGHT

- 3-WAY SWITCH 4-WAYSWITCH
- DIMMER SWITCH
- W TELEPHONE
- TV-TV CONNECTION CONDUIT FOR COMPONENT WIRING
- SPEAKER
- COMBO SMOKE/ CARBON MONOXIDE DETECTOR **%**
- SD 110 V SMOKE DETECTOR
- EXHAUST FAN






ELECTRICAL NOTES:

## PROVIDE AND INSTALL GROUND FAULT CIRCUIT-INTERRUPTERS (G.F.L.) AS INDICATED ON PLANS OR AS ITEM NO. 4 AND 5 BELOW INDICATED.

- UNLESS OTHERWISE INDICATED, INSTAIL
  SWITCHES AND RECEPTACLES ACT'HE
  FOLLOWING IBIGHTS ABOVE PINISHED FLOOR:
  SWITCHES. ... 42\*
  OUTLETS. ... 14\*
  TELEPHONE ... 14\* (UNLESS ABV
  COUNTERTOO)
  TELEVISION ... 14\*

- ALL SMOKE DETECTORS SHALL BE HARDWIRED INTO AN ELECTRICAL POWER SOURCE AND SHALL BE EQUIPPED WITH A MONITORED BATTERY BACKUP, PROVIDE AND INSTALL LOCALLY CERTIFIED SMOKE DETECTORS.
- ALL 15A AND 20A RECEPTACLES IN SLEEPING ROOMS, FAMILY ROOMS, DINING ROOMS, LIVING ROOMS, PARLORS, LIBRARIES, DENS, SUNROOMS, RECREATION ROOMS, CLOSETS, HALLWAYS, AND SIMILAR AREAS WILL REQUIRE A COMBINATION
  TYPE A.F.C.I. DEVICE AND TAMPER-PROOF
  RECEPTACLES.
- ALL 15A AND 20A 120V RECEPTACLES LOCATED IN THE GARAGE AND UTILITY ROOMS SHALL BE G.F.C.I. PROTECTED (G.F.I).
- 5. IT IS THE RESPONSIBILITY OF THE LICENSED ELECTRICIAN TO ENSURE THAT ALL ELECTRICAL WORK IS IN FULL COMPLIANCE WITH ALL APPLICABLE LOCAL STANDARDS, CODES, AND ORDINANCES,
- 7. EVERY BUILDING HAVING A FOSSIL-FUEL-BURNING HEATER OR APPLIANCE, FIREPLACE, OR AN ATTACHED GARAGE SHALL HAVE AN OPERATION AL CARBON MONOXIDE DETECTIOR INSTALLED WITHIN 10 FEET OF EACH ROOM USED FOR SLEEPING PURPOSES.
- J ALARMS SHALL RECEIVE THEIR PRIMARY POWER PROM THE BUILDING WIRING WHEN SUCH WIRING IS SERVED FROM THE LOCAL POWER LITHLITY, SUCH ALARMS SHALL HAVE BATTERY BACKUP, COMBINATION SMOKECARBON MONOXIDE, ALARMS SHALL BE LISTED OR LABELED BY A NATIONALLY RECOGNIZED TESTING LABORATORY.

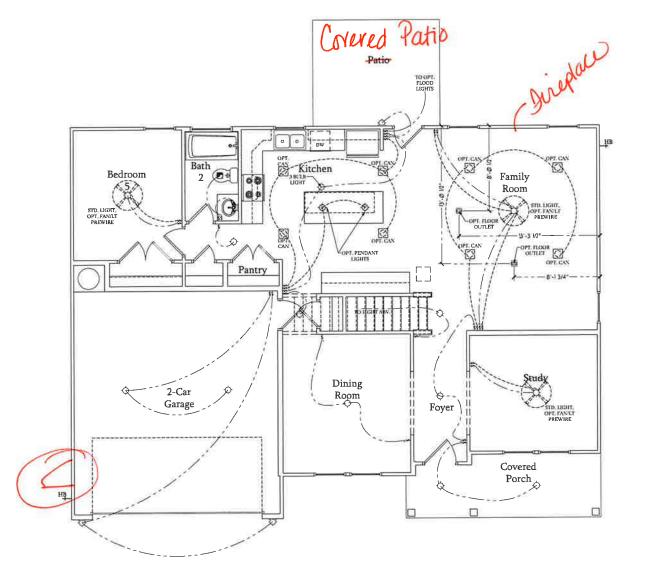

First Floor Plan SCALE: 1/4"=1'-0" ON 22x34 AND 1/8"=1'-0" ON 11x17



H&H HOMES, INC SOUTHPORT

DATE: SEPTEMBER 16, 2019 REV : AUGUST 01, 2021

SCALE: 1/4"=1'-0"


DRAWN BY:


ENGINEERED BY:

REVIEWED BY:

FIRST FLOOR ELECTRICAL

PLAN E-1

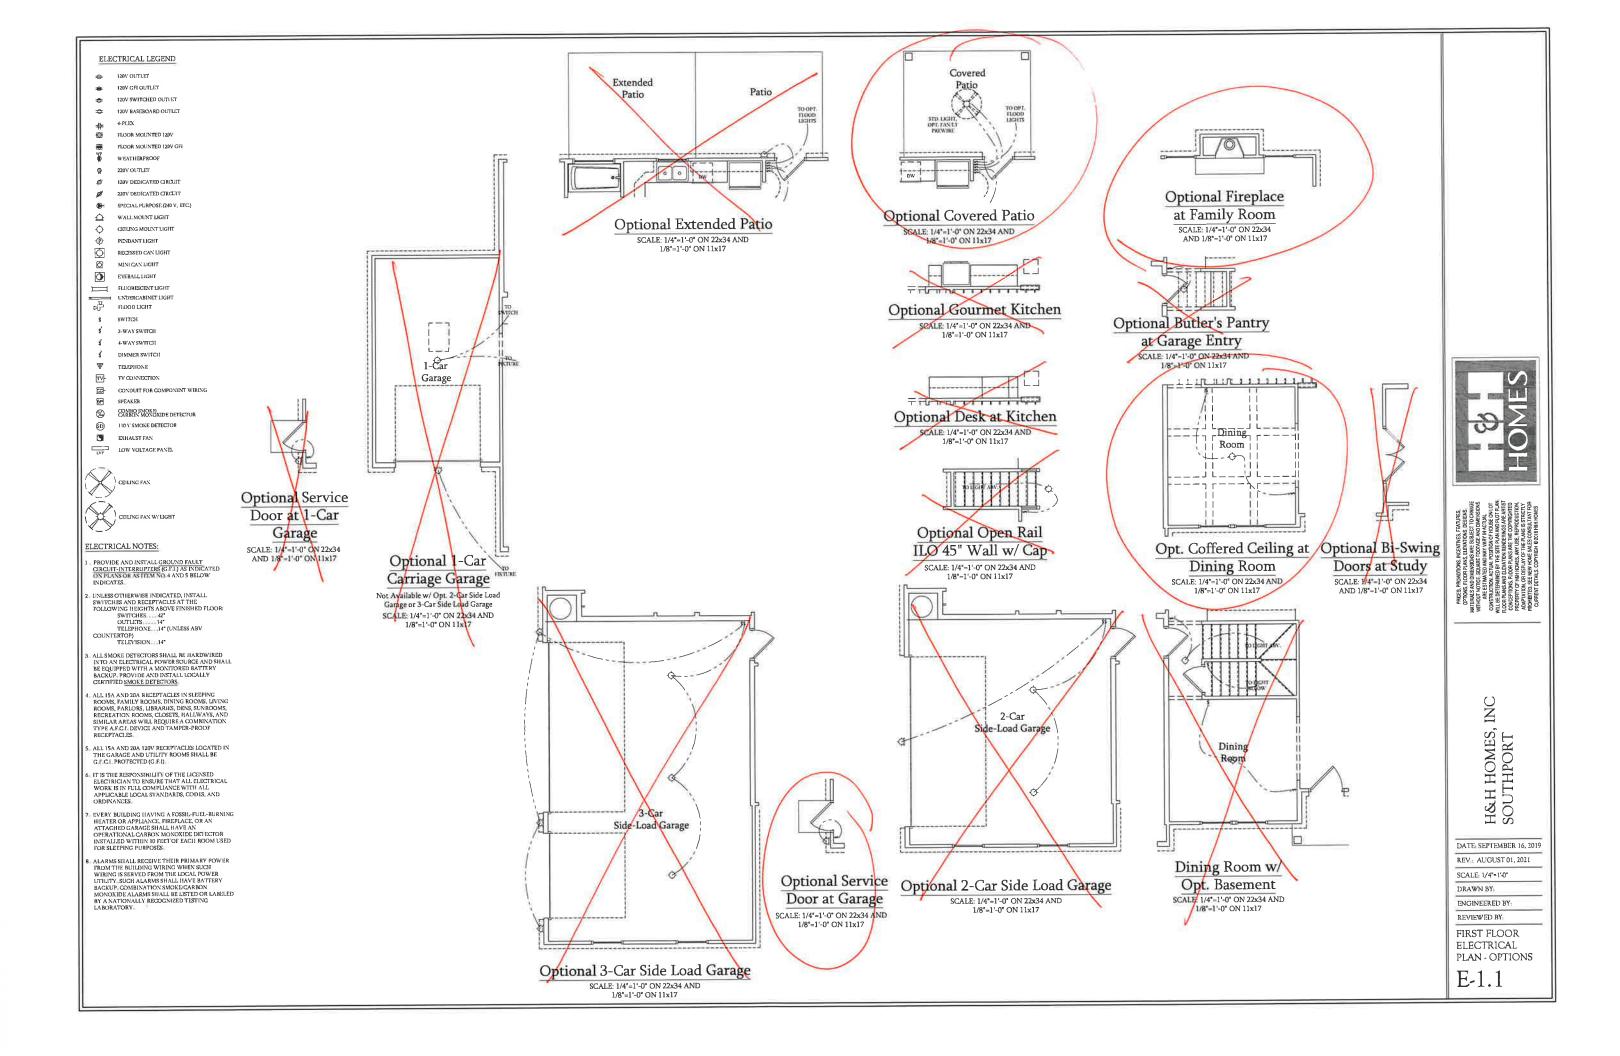

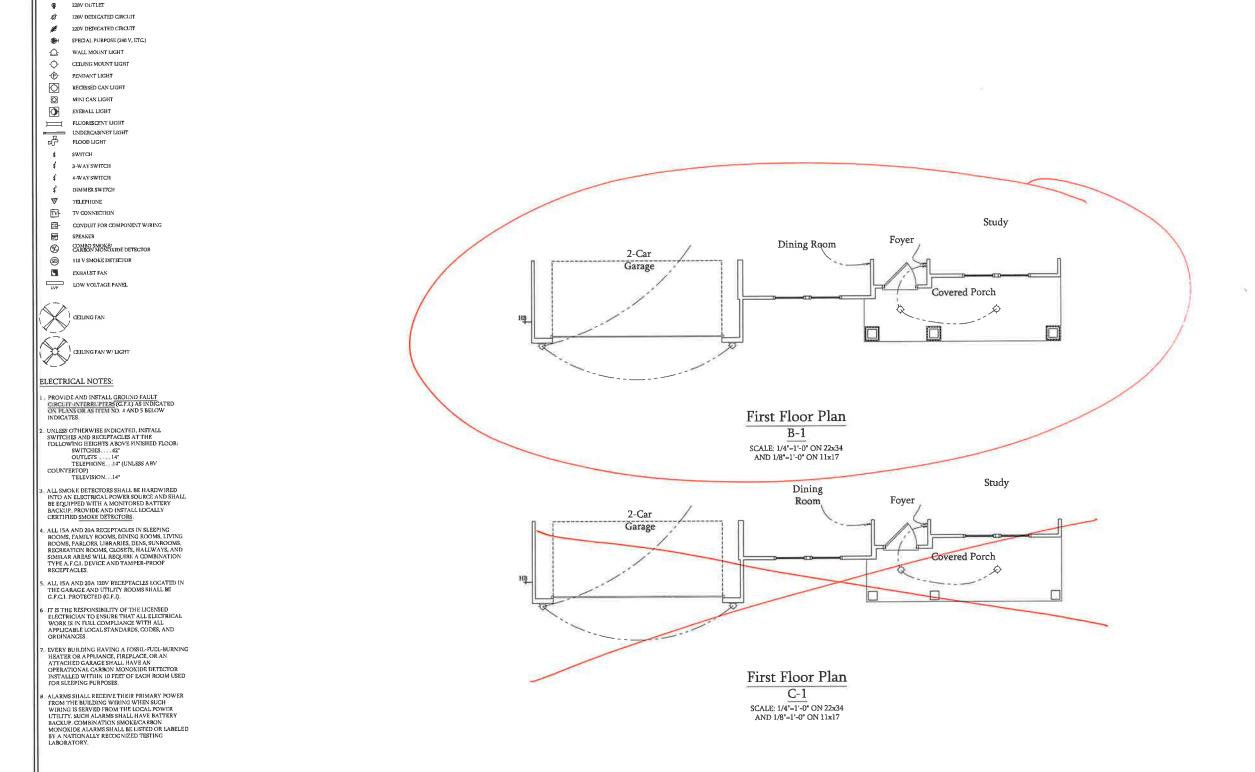

ELECTRICAL LEGEND ⇒ 120V OUTLET ■ 120V GFI OUTLET 126V SWITCHED OUTLET 120V BASEBOARD OUTLET 4-PLEX

> FLOOR MOUNTED 120V FLOOR MOUNTED 120V GFI WEATHERPROOF

<del>=</del>



H&H HOMES, INC SOUTHPORT

DATE: SEPTEMBER 16, 2019 REV: AUGUST 01, 2021

SCALE: 1/4"=1'-0"

DRAWN BY:

ENGINEERED BY

REVIEWED BY:


FIRST FLOOR ELECTRICAL PARTIAL PLANS

E-1.2

#### ELECTRICAL LEGEND ⇒ 120V OUTLET ⇒ 120V GFI OUTLET 120V BASEBOARD OUTLET 4-PLEX FLOOR MOUNTED 120V FLOOR MOUNTED 120V GFI WEATHERPROOF 126V DEDICATED CIRCUIT 220V DEDICATED CIRCLIT SPECIAL PURPOSE (240 V, ETC.) CEILING MOUNT LIGHT PENDANT LIGHT RECESSED CAN LIGHT Ø MINI CAN LIGHT EYEBALL LIGHT FLUORESCENT LIGHT UNDERCABINET LIGHT FLOOD LIGHT SWITCH \$ 3-WAYSWITCH \$ 4-WAYSWITCH DIMMER SWITCH TELEPHONE TV- TV CONNECTION CONDUIT FOR COMPONENT WIRING **⊡**-SPEAKER COMBO SMOKE/ CARRON MONOXIDE DETECTOR 110 V SMOKE DETECTOR EXHAUST FAN LOW VOLTAGE PANEL CEILING FAN W/ LIGHT

#### ELECTRICAL NOTES:

- PROVIDE AND INSTALL GROUND FAULT GIRCUIT-INTERRUPTERS (C.F.I.) AS INDICATED ON PLANS OR AS ITEM NO. 4 AND 5 BELOW INDICATES
- 2. UNLESS OTHERWISE INDICATED, INSTALL,
  SWITCHES AND RECEPTACLES AT THE
  POLLOWING IEIGHTS ABOVE FINISHED FLOOR:
  SWITCHES ... ... 42'
  OUTLETS ... ... 42'
  TELEPHONE ... 14' (UNLESS ABV
  COUNTERTOP)
  TELEVISION... ... 14'
- 3 ALL SMOKE DETECTORS SHALL BE HARDWIRED INTO AN ELECTRICAL POWER SOURCE AND SHALL BE EQUIPPED WITH A MONTTORED BATTERY BACKUP PROVIDE AND INSTALL LOCALLY CERTIFII'D SMOKE DETECTORS.
- 4. ALL 15A AND 20A RECEPTACLES IN SLEEPING ROOMS, FAMILY ROOMS, DINING ROOMS, LIVING ROOMS, PABLORS, LIBRARIES, DENS, SUNROOMS, RECERATION ROOMS, CLOSETS, HALLWAYS, AND SIMILAR AREAS WILL REQUIRE A COMBINATION TYPE A.F.C. L. DEVICE AND TAMPER-PROOF RECEPTACLES.
- 5. ALI, 15A AND 20A 120V RECEPTACLES LOCATED IN THE GARAGE AND UTILITY ROOMS SHAIJ, BE G.F.C.I. PROTECTED (G.F.I).
- 6. IT IS THE RESPONSIBILITY OF THE LICENSED ELECTRICIAN TO ENSURE THAT ALL ELECTRICAL WORK IS IN FULL COMPLIANCE WITH ALL APPLICABLE LOCAL STANDARDS, CODES, AND ORDINANCES.
- 7. EVERY BUILDING HAVING A FOSSIL-FUEL-BURNING HACTER OR APPLIANCE. FIREPLACE. OR AN ATTACHER OR ARGAE SHALL HAVE AN OPERATIONAL CARBON MONOXIDE DETECTOR INSTALLED WITHIN 10 FEET OF EACH ROOM USED FOR SLEEPING PURPOSES.
- A ALAMS SHALL RECIPLY THEIR PRIMARY POWER
  PROM THE BUILDING WIRING WHEN SLCTI
  WIRING IS SER' EL AND SHALL HAVE BATTERY
  BACKUP, COMBINATION SHALL BE LISTED OR LABELED
  BY A NATIONALLY RECOGNIZED TESTING
  LABORATORY.

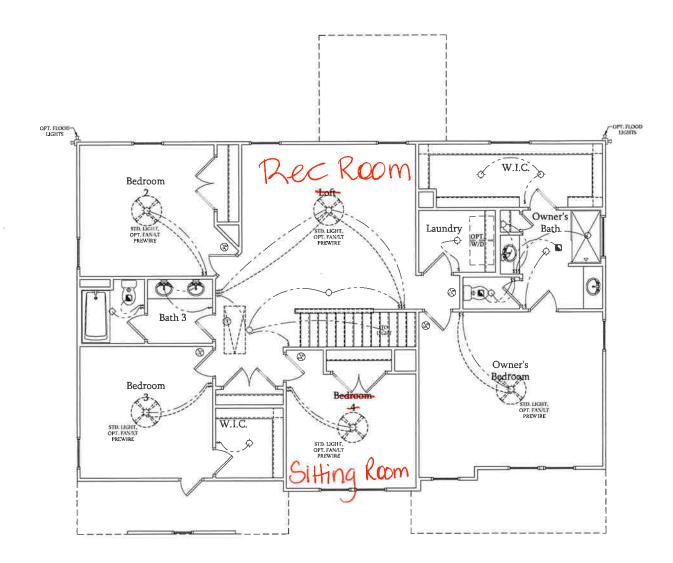

#### Second Floor Plan

SCALE: 1/4"=1'-0" ON 22x34 AND 1/8"=1'-0" ON 11x17



MITTERS SENSET TO CHANGE THE CONTROL OF THE CONTROL

H&H HOMES, INC SOUTHPORT

DATE: SEPTEMBER 16, 2019
REV.: AUGUST 01, 2021


SCALE: 1/4"=1'-0"

DRAWN BY: ENGINEERED BY:

REVIEWED BY:

SECOND FLOOR ELECTRICAL PLAN

E-2

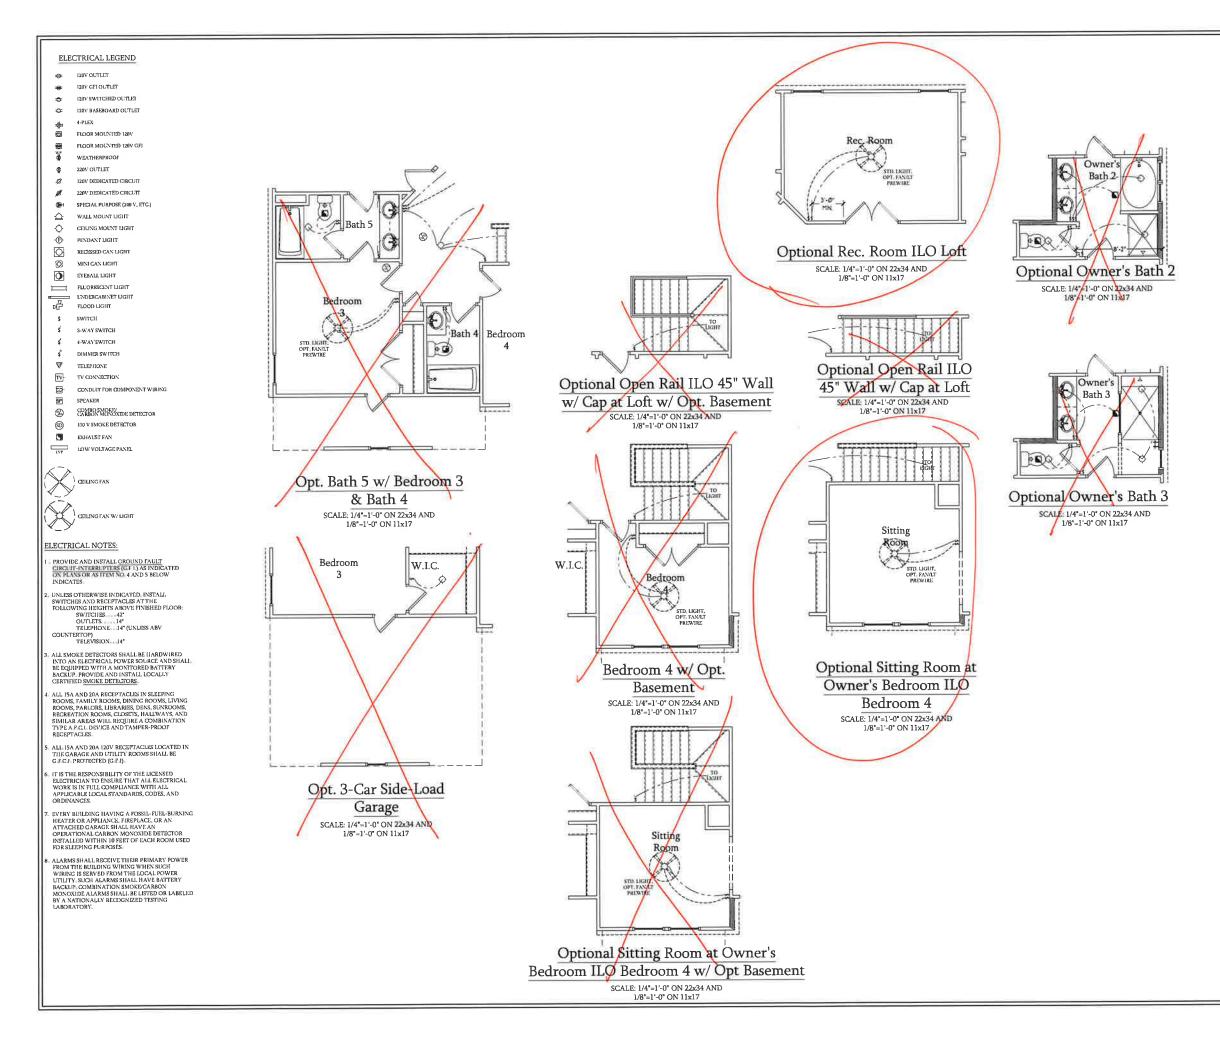



OPTINGS A CORP AND SET ENTANDS OF DESIGNED
WINDOWN AND DIMENSION OF STATE OF THE SET OF DESIGNED
WINDOWN SET OF STATE OF STATE OF SET O

H&H HOMES, INC SOUTHPORT

DATE: SEPTEMBER 16, 2019 REV.: AUGUST 01, 2021

REV.: AUGUST 01,

SCALE: 1/4"=1'-0"

DRAWN BY:

ENGINEERED BY:

REVIEWED BY:

SECOND FLOOR ELECTRICAL PLAN - OPTIONS

E-2.1

11/2/2021

LINTEL SCHEDULE FOR BRICKMATURAL STONE SUPPORT			
LENGTH (FT.) SIZE OF LINTEL			
UP TO 4 FT. L 3 1/2 x 3 1/2 x 1/2			
4-8	L 5 x 3 1/2 x 5/16 LLV		
8 AND GREATER	L 6 x 4 x 5/l6 LLV		

#### BRICK SUPPORT NOTES:

nd KT FNG CATH A H Homes/Spulboort/Spulboort GL Structural 10 21 dwg. 11/2/2021 10 45 46 AM, Whintey Boylon, JS Thomostan Engineering Inc.

- RICK SUPPORT NOTES.

  LINTEL SCHEDULE APPLIES TO ALL
  OPENNESS IN BRICK VENEER (MO.). SEE
  ARCH DIBGS, FOR SIZE AND LOCATION OF
  OPENNESS.

  (ILLY) = LONG LEG VERTICAL
  LENGTH \* CLEAR OPENNES
  BYBED ALL ANGLE IRONS YIN 4" EACH
  SIDE INTO VENEER TO PROVIDE BEARING.
  OPEN ALL MEADERS B" AND GREATER
  IN LENGTH, ATTACH STEEL ANGLE TO
  FEADER W" 1/2" LAG SCREWS \* 12" OC.
  STAGGSERD.
- HEADER W //2" LAG SCREUS ® 12" OC.
  STAGGERED.
  FOR ALL BRICK SUPPORT ® ROOF LINES,
  FASTEN (12" x W BLOCKING BETWEEN
  STUDS W (4) 12d NAILS PER PLY, FASTEN
  A 6" x 4" x 506" STEEL ANGLE TO (2)" 1 x
  W BLOCKING W (7) 12" LAG SCREUS ® 12"
  OC. STAGGERED. SEE SECTION R103321
  OF THE 2018 NORG FOR ADDITIONAL
  BRICK SUPPORT INFORMATION
  PRECAST REINFORCED CONCRETE
  LINTLES ENGINEERED BY OTHERS MAY BE
  USED IN LIEU OF STEEL LINTELS.

#### NOTE:

BCI 45006-18 JOISTS MAY BE USED IN LIEU OF TJI 110 JOISTS AT THE DEPTH AND SPACING NOTED ON THE PLAN.

#### BRACED WALL DESIGN NOTES:

- BRACED WALL DESIGN FER SECTION R6/02/0 OF THE NORC
- BRACED WALL DESIGN FER SECTION REGITION OF THE NORC 2019 EDITION C5-USP REFERS TO "CONTINUOUS SHEATHING WOOD STRUCTUREAL PAYELS" CONTRACTOR IS TO INSTALL 1/6" O'SB ON ALL EXTERIOR WALLS ATTACHED W 6d NAILS SHACED 6" OC. ALONS PANEL EDGES AND 1" OC. IN THE FIELD. 12" (MIN) GYPSUM WALL BOARD" CONTRACTOR IS TO INSTALL 1/2" (MIN) GYPSUM WALL BOARD" WHERE NOTED IN THE PLANS. FASTEN GB WITH 1/14" SCREWED OR 1 15/4" NAILS SPACED TO OLD ALONS PANEL EDGES AND IN THE FIELD INCLUDING TOP AND BOTTOM PLATES.

  BRACED WALL DESIGN APPLIED IN WIND ZOUES UP TO 15/4 MINH FOR HIGH WIND ZONES, BRACE WALLS ARE TO BE CONSTRUCTED IN ACCORDANCE WITH CHAPTER 45 OF THE NORC 2018 EDITION. SEE NOTES AND DETAIL SHEETS FOR ADDITIONAL BRACED WALL BRACED WALL BRACE

- FER SECTION R6021046 OF THE 2018 NCRC, THE AMOUNT OF BRACING REQUIRED ON THE WALK OUT BASEFENT WALLS EXCEEDS THE AMOUNT OF BRACING ON THE WALL ABOVE
- EALERIA THE MITCHAIL OF DRAWING ON THE WALL ABOVE MULTIPLED BY A FACTOR OF US, SHEATH ALL EXTERIOR WALLS WITH TIME OSS SHEATHING ATTACHED WITH 8d NAILS AT 6" OC. ALONG PANEL EDGES AND IZ" OC. IN THE FIELD.

#### STRUCTURAL NOTES:

- ALL FRAMING LUMBER TO BE 9 SFF (UNO) ALL TREATED LUMBER TO BE 9 SYP (UNO)

  INSTALL AN EXTRA JOIST WINDER WALLS PARALLEL TO FLOOK JOISTS WHERE MOVED ON THE PLANS.

  WINDOW AND DOOR HEADERS TO BE SUFFORTED W (1)

  JACK STUD AND (I) KNS STUD EA END (UNO). SEE TABLE REØJ.15 FOR ADDITIONAL KING STUD

  REQUIREPHENTS.
- TABLE R6/07.15 FOR ADDITIONAL KING 51UD RECUIREFINITS.

  5. SOLARES DENOTE DONT LOADS WHICH RECUIRE SOLID BLOCKING TO GIRDER OR FOUNDATION. SUPPORT UNSPECIFIED FT. LOADS ALONG FRAMED WALLS W (2) STIDS (NA).

  5. ALL LOAD BEARING HEADERS TO BE (3) 2 x Ø (UNO)

  5. STEP BASEMENT FON DOWN TO 2 x 6 ° 6" OC. WALL WHERE GRADE FEMTITS.

  1. ALL LOAD BEARING NITERIOR WALLS TO BE 2 x 4 ° 12"

  (C) CO 2 x 4 ° 16" OC. (UNO)

- ALL LOAD BEARING NIENCK WALLS TO BE 2 X 4 \* W.

  OC. OR ? X 6 \* NE ° O.C. (NO.)

  FOR HIGH WIND ZONES, ALL EXTERIOR WALLS TO BE SHATHED WITH JOINTS


  BLOCKED AND SECURED WITH BE NAILS AT 3 \* O.C.

  ALONS EDGES AND 6 \* CO.R. IN THE FIELD.

  FOR HIGH WIND ZONES, SECURE ALL EXTERIOR WALL.
- FOR HIGH WIND ZONES, SECURE ALL EXTERIOR WALL SHEATHING PARELS TO DOLUBLE TOP PLATES, BANDS, JOISTS, AND GIRDERS WITH (2) ROWS OF BAI NAILS STAGGERED AT 3° OC. PANELS SHALL EXTEND (2° BEYOND CONSTRUCTION JOINTS AND SHALL OVERLAP GIRDERS AND DOUBLE SILL FLATES THEIR RILL DEPTH.
- IO ALL 4 × 4 POSTS SHALL BE ANCHORED TO SLABS W/ ), ALL 4 4 POSTS SHALL BE ANCHORED TO SLABS W SMPSON ABUA POST BASES (OR EGUAL) (MNO). ALL 4 x 4 AND 6 x 6 POSTS TO BE INSTALLED WITH JOB LB CAPACITY UPLIFT CONDECTORS AT TOP (INC) REFER TO NOTES AND DETAIL SHEETS FOR ADDITIONAL
- STRUCTURAL INFORMATION

## TABLE R6Ø2.75 MINIMUM NUMBER OF RULL HEIGHT STUDS AT EACH END OF HEADERS IN EXTERIOR WALLS

HEADER SPAN	MAXIMIM STUD SPACING (INCHE6) (PER TABLE R6013(5)		
(HEE1)	16	24	
UP TO 3"	18	1	
4'	1	16	
8'	1	2	
12'	5	. 3	
16'	6	4	

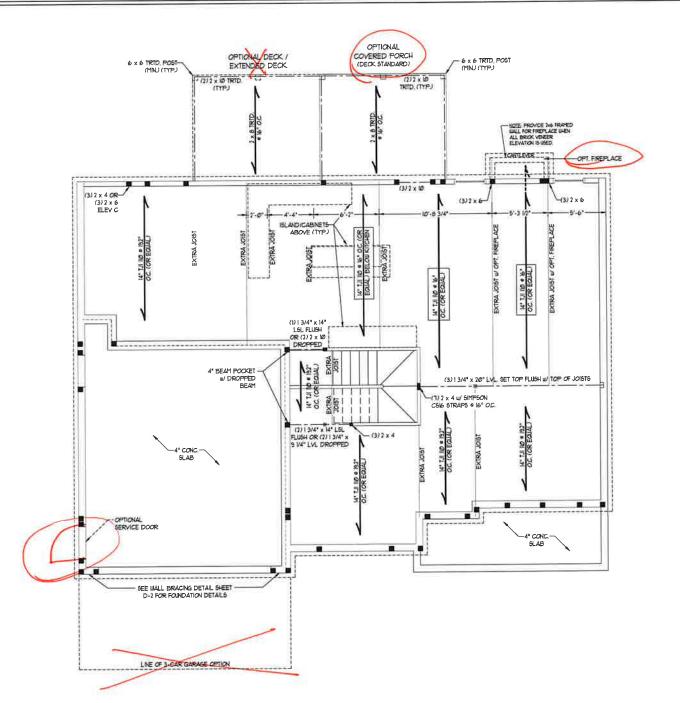

0 N C C 227605 ENGINEERING, I 606 WADE VE, SUTE 104 RALEGIA, NC. 276 11 ONLE, (919) 789-9919 FAX. (919) 789-9921

SOUTHPORT H&H HOMES

DATE: NOVEMBER 2, 2021

SCALE: 1/4" = 1'0"

DRAWN BY: H&H HOMES ENGINEERED BY: WFB

> SHEET: 5 OF 9 S-2 FIRST FLOOR

#### BRACED UAL DESIGN NOTES

- BRACED WALL DESIGN PER SECTION REGISIO OF THE NORC 2018 ED TON. CS-UBB REFERS TO "CONTINUOUS SHEATHING WOOD STRUCTURAL PANELS" CONTRACTOR IS TO INSTALL TWO" OSB ON ALL EXTERIOR WALLS AT ACKED W BO MAILS SPACED 6" CSB REFERS TO "GYOSIM BOARD" CONTRACTOR 6 TO INSTALL 12" MIN.) GYPSIM JUALL BOUND WHERE NOTED ON THE PLANS FASTEN GB UTH 114" SCREWS OR 15/8" NAILS SPACED 1" OC ALONG PANEL EDGES AND NITHE FIELD INCLUDING TOP AND BOTTOM PLATES.
- ALONG PANEL EDGES AND NITHE FILED INCLIDES 10°F AND BOTTOM PLATES.

  BRACED WALL DES GN APPLIED IN UND ZONES UP TO 13° MPHFOR HIGH WIND ZONES SPACE WALLS ARE TO BE CONSTRUCTED 
  IN ACCORDANCE WITH CHAPTER 45 OF THE NORG ZONE EDITION 
  SEE NOTES AND DETAIL SHEETS FOR ADDITIONAL BRACED 
  WALL INFORMATION.

#### SRACED WALL DESIGN

#### RECTANGLE A SIDE IA (FRONT LOAD) YETHOD: C5-WSP/FF

NOTE: ALL EXTERIOR WALLS AND ATTIC WALLS ARE TO BE 2 x 6 9 16" RECTANGLE B SIDE IS MET-OD P=/CS-USP TOTAL REGUIRED LENGT- 2.85' TOTAL FROVIDED LENGT- 6 O.C. (UNO), 2 x 4 @ 16" O.C. EXTERIOR 2 x 4 @ 24" O.C. (UNO).

(2) 2 x 10 CONT.

DINING ROOM W/ OPTIONAL BASEMENT

LINTEL SCHEDULE FOR BRICKNATURAL STONE SUPPORT			
LENGTH (FT.) SIZE OF LINTEL			
UP TO 4 FT L 3 1/2 x 3 1/2 x 1/4			
4-8 L 5 x 3 1/2 x 5/16 LLV			
8 AND GREATER L 6 x 4 x 5/16 LLV			

#### BRICK SUPPORT NOTES

- LINTEL SCHEDULE APPLIES TO ALL OPENINGS IN BRICK VENEER (UNO), SEE ARCH DUGG, FOR SIZE AND LOCATION OF (LLV) = LONG LEG VERTICAL
- (LLV): LONG LES VERTICAL
  LEMENT: ELERA OPENNE
  LEMENT ALL ANGLE IRONS MIN. 4" EACH
  SIDE INTO VENEER TO PROVIDE BEARING
  FOR ALL HEADENG 8:0" AND GREATER
  IN LEMENT, ATTACH STEEL ANGLE TO
  HEADER IV 10" LAG SCREUS 6: 12" O.C.
  STANCEREDER.
- STAGGERED.
  FOR ALL BRICK SUPPORT & ROOF LINES, FASTEN (2) 2 x 10 BLOCKING BETWEEN STUDS w/ (4) 12d NAILS PER PLY, FASTEN A 6" x 4" x 5/16" STEEL ANGLE TO (2) 2 > A 6" x 4" x 5/6" 5TEEL ANGLE TO (3) 2 x
  0 BLOCKING w/ (2) 1/2" LAG SCREUS 9 2"
  O.C. STAGGERED, SEE SECTION R10938.1
  OF THE 2010 NORC FOR ADDITIONAL
  BRICK SUPPORT INFORTATION
  PRECAST REMPORCED CONCRETE
  NUTEL & DIAGREDISCU
- LINTELS ENGINEERED BY OTHERS MAY BE USED IN LIEU OF STEEL LINTELS.


#### STRUCTURAL NOTES:

- ALL FRAMING LUMBER TO BE SFF 12 (UNO). ALL TREATED LUMBER TO BE 51P 12 (UNO) ALL LOAD BEARING HEADERS TO BE (2) 2 x 6
- WINDOW AND DOOR HEADERS TO BE SUPPORTED W (1) JACK STUD AND (1) KING STUD EA END (UNO.). SEE TABLE R602.15 FOR ADDITIONAL KING STUD REQUIREMENTS. SQUARES DENOTE POINT LOADS WHICH REQUIRE
- SOLID BLOCKING TO GIRDER OR FOUNDATION. SOLID BLOCKING TO GIRDER OR FOUNDATION.
  ALL SQUARES TO BE (3) PUIDS (IMO).
  FOR HIGH WIND ZONES, ALL EXTERIOR WALLS TO
  BE SHEATHED WITH 1/16" OSB SHEATHING WITH
  JOINTS BLOCKED AND SCURED WITH 8d NAILS
  AT 3" O.G. ALONG EDGES AND 6" O.C. IN THE
- FIGL.
  FOR HIGH WIND ZONES, SECURE ALL EXTERIOR
  WALL SHEATHING PANELS TO DOUBLE TOP
  PLATES, BANDS, JOISTS, AND GIRDERS WITH (2) ROUG OF 8d NAILS STAGGERED AT 3" O.C. PANELS SHALL EXTEND 12" BEYOND CONSTRUCTION JOINTS AND SHALL OVERLAP GIRDERS AND DOUBLE SILL PLATES THEIR FULL
- ALL 4 x 4 POSTS SHALL BE ANCHORED TO SLABS w/ SIMPSON ABU44 POST BASES (OR EQUAL) AND 6 x 6 POST5 w/ ABU66 POST EQUAL) AND 6 x 6 POSTS W ABUSE POSTS BASES (OR EQUAL) (MOX, ALL 4 x 4 AND 6 x 6 POSTS TO BE INSTALLED WITH 100 LB CAPACITY UPLIFT CONNECTORS AT TOP (MOX) FOR FIBERS, ASS, ALIENTA, OR COLUMN ENG. BY OTHERS, SECURE TO SLAB W (2) METAL ANGLES
- UNISHE 2" COLL SCREUE, FASTEN ANGLES TO COLUMNS W 1/4" THROUGH BOLTS W NUTS AND WASHERS, LOCATE ANGLES ON OPPOSITE SIDES OF COLUMN, THROUGH BOLTS THUST BE INSTALLED PRIOR TO SETTING COLUMN
- REFER TO NOTES AND DETAIL SHEETS FOR ADDITIONAL STRUCTURAL INFORMATION

"TSP" INDICATES TRIPLE STUD POCKET BETWEEN WINDOW WITS.

TABLE R602.73 MINIMUM NUMBER OF FULL HEIGHT STUDS

AT EACH END	OF HEADERS IN E		
HEADER SPAN (FEET)	MAXIMUM STUD SPACING (INCHES (PER TABLE R6023(5)		
(FEE+/	6	24	
UP TO 3"	-1	18.	
4	2	10	
8	3	2	
12"	5	3	
16"	6	4	

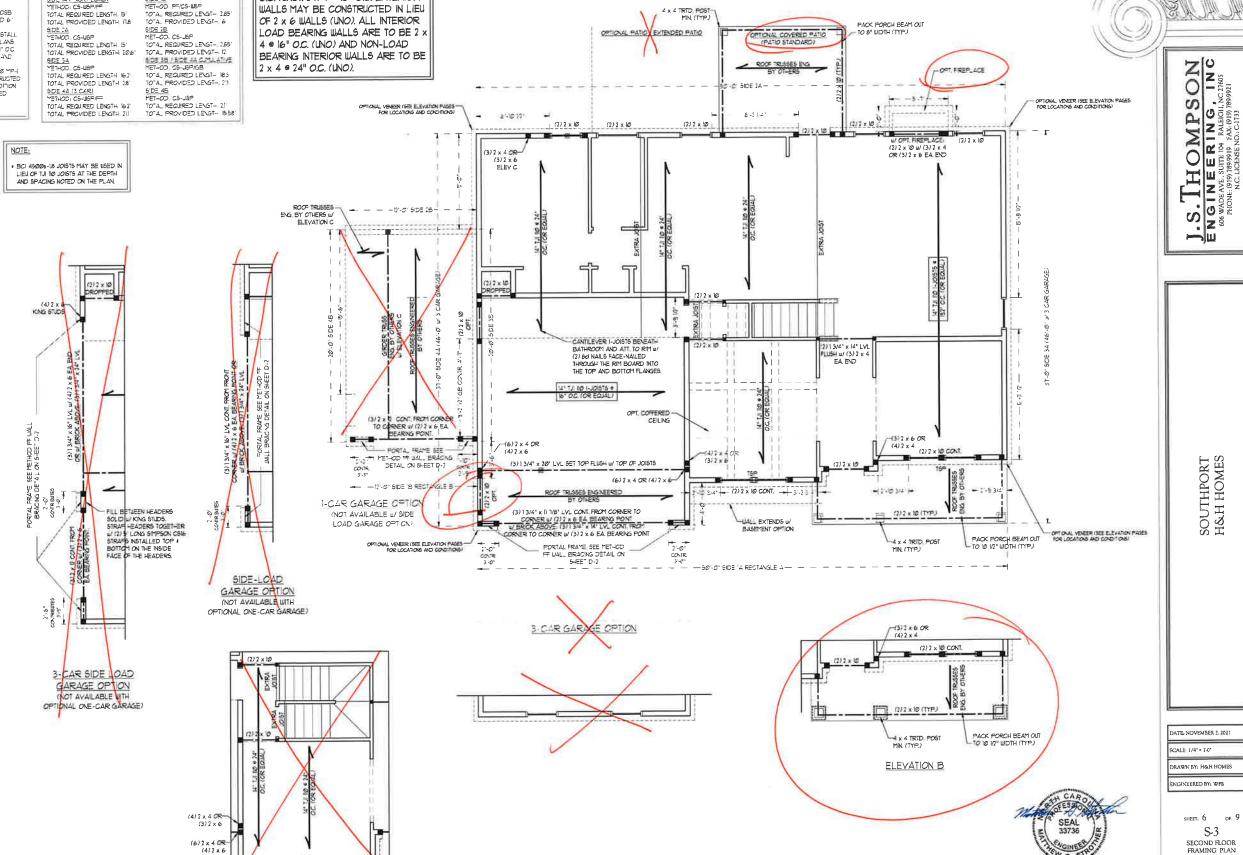

#### BRACED JAL DESIGN NOTES.

- BRACED WALL DESIGN PER SECTION R60210 OF THE NORC
- BRACED MAIL, DESIGN PER SECTION R662/80 OF THE NORC 20/8 EDITION
  STRUCTURAL PANELS! CONTRACTOR 5 TO NOTAL 1/86 OSS
  ON ALL EXPERIOR MAIL, SATTACHED W 56 NAILS SPACED 6\*
  OC. ALONS PANEL BOGGS AND 1" OC IN THE FIELD.
  SO REFERS TO "SYPERM BOARD" CONTRACTOR 15 TO INSTALL 1/8? (MIN) GYPS/Y MAIL, BOARD WHERE "JOTED ON THE PLANS FASTEN GE UTH 1/4" SCREWG OR 15/8" NA \_5 SPACED " OC ALONS PANEL BOGGS AND IN THE FIELD CALIDNAY DAY OF AND BOTTOM PLATES.

  BRACED MAIL, DESIGN APPLIED IN UND ZONES P TO 36 MPH POR HIGH MIND ZONES, BRACE MAILS ARE TO BE CONSTRUCTION ALCORDANCE UTH CHATTER 45 OF THE NORC 20/8 EDITION SEE NOTES AND DETAIL SHEETS FOR ADDITIONAL BRACED MAIL INFORTATION.

- PER SECTION R60210/32 OF THE 10/8 NORC, THE AMOUNT OF BRAICING ON THE SECOND FLOOR EXCEEDS THE AMOUNT REQUIRED FOR THE FIRST FLOOR AND NO BRACED WALL ANALYSIS IS REQUIRED
- ANALITOR IS RECURRED

  S-EAT-ALL EXTERIOR WALLS JTH "/6" OSB 5-EAT-ING

  ATTACHED WITH 80 WALLS AT 6" OS, ALONG PAVEL EDGES AND

  L" OC, IN THE FIELD

LINTEL SCHEDULE FOR BRICKNATURAL STONE SUPPORT			
LENGTH (FT.) SIZE OF LINTEL			
UP TO 4 FT. 1.3 1/2 x 3 1/2 x 1/4			
4-8 L 5 x 3 1/2 x 5/16 LLV			
B AND GREATER L 6 x 4 x 5/16 LLV			

#### BRICK SUPPORT NOTES

- LINTEL SCHEDULE APPLIES TO ALL OPENINGS IN BRICK VENEER (UNO), SEE ARCH DUGS, FOR SIZE AND LOCATION OF

- ARCH DULGE, FOR SIZE AND LOCATION OF OFENINGS (LLV) = LONG LEG VERTICAL LENGTH = CLEAR OFENING FUEDE ALL NAKILE IRONG YIN 4" EACH SIDE NITO VENEER TO PROVIDE BEARNAG FOR ALL HEADERS 8"-0" AND GREATER NLENGTH, ATTACH STEEL ANGLE TO HEADER WIN" LAG SCREUS 9 12" OC. STAGGEDER WIN" LAG SCREUS 9 12" OC.
- STAGGERED. FOR ALL BRICK SUPPORT & ROOF LINES, FOR ALL BRICK SUPPORT & ROOF LINES, FASTEN (2) × 10 BLOCKINS BETWEEN STUDS W (4) 12d NAILS PER PLY, FASTEN A 6" x 4" x 5/16" STEEL ANGLE TO (2) 2 x 10 BLOCKING W (2) 10" LAG SCREUS & 0" OC STAGGERED, SEE SECTION R103821 OF THE 200 HORE FOR ADDITIONAL BRICK SUPPORT INFORMATION PRECAST REINFORCED CONCRETE LINTELS DEVINEERED BY OTHERS MAY BE USED IN LIEU OF STEEL LINTELS.

#### STRUCTURAL NOTES:


- ALL FRAMING LUMBER TO BE SPF 12 (UNO). ALL TREATED LUMBER TO BE SYP 12 (UNO) ALL LOAD BEARING HEADERS TO BE (2) 2 x 6 (LNO)
- WINDOW AND DOOR HEADERS TO BE SUPPORTED #/ (1) JACK STUD AND (1) KING STUD EA. END (UNO.). SEE TABLE R6/27.15 FOR ADDITIONAL KING STUD REQUIREMENTS.
- SQUARES DENOTE POINT LOADS WHICH RECUIRE SOLID BLOOKING TO GIRDER OR FOUNDATION ALL SQUARES TO BE (2)
- FOR HEATHED WITH TIME OSB SHEATHING WITH JOINTS BLOCKED AND SECURED WITH 8d NAILS AT 3" O.C. ALONG EDGES AND 6
- OC. N THE FIELD
  FOR HIGH WIND ZONES, SECURE ALL
  EXTERIOR WALL SHEATHING PANELS TO
  DOUBLE TOP PLATES, BANDS, JOISTS, AND GIRDERS WITH (2) ROUS OF Bd NAILS STAGGERED AT 3" O.C. PANELS SHALL STAGESTRED AT 3" OF PARKED STALL
  EXTEND IN BEYOND CONSTRUCTION JOINTS
  AND SHALL OVERLAP GIRDERS AND
  DOUBLE SILL PLATES THEIR FULL DEPTH.
- REFER TO NOTES AND DETAIL SHEETS FOR ADDITIONAL STRUCTURAL INFORMATION

"TSP" INDICATES TRIPLE STUD POCKET BETUEEN WINDOW UNITS,


TABLE R602,75
MINIMUM NUMBER OF FULL HEIGHT STUDS
AT EACH END OF HEADERS IN EXTERIOR WALLS


HEADER SPAN	MAXMUM STUD SPACING (INCHES) (PER TABLE R6023(5)		
(FEET)	W	24	
UP TO 3"	1	1	
4'	2	- 1	
8'	3	2	
121	5	3	
16'	6	4	


\*NOTE: ALL EXTERIOR WALLS AND ATTIC WALLS ARE TO BE 2 x 6 9 16" O.C. (UNO). 2 x 4 € 16" O.C. EXTERIOR WALLS MAY BE CONSTRUCTED IN LIEU OF 2 x 6 WALLS (UNO). ALL INTERIOR LOAD BEARING WALLS ARE TO BE 2 x 4 @ 16" O.C. (UNO) AND NON-LOAD BEARING INTERIOR WALLS ARE TO BE 2 x 4 @ 24" O.C. (UNO).

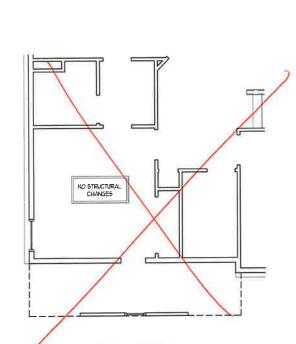


OPTIONAL BATH 5 W/ BEDROOM 3 AND BATH 4

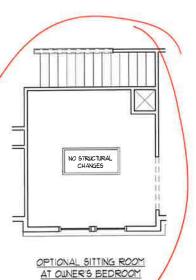

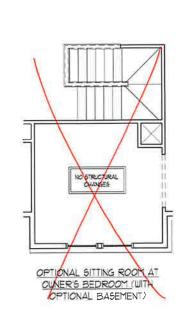

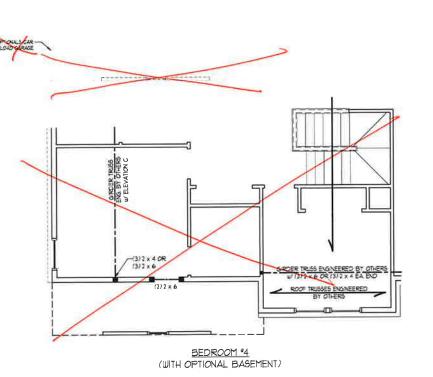

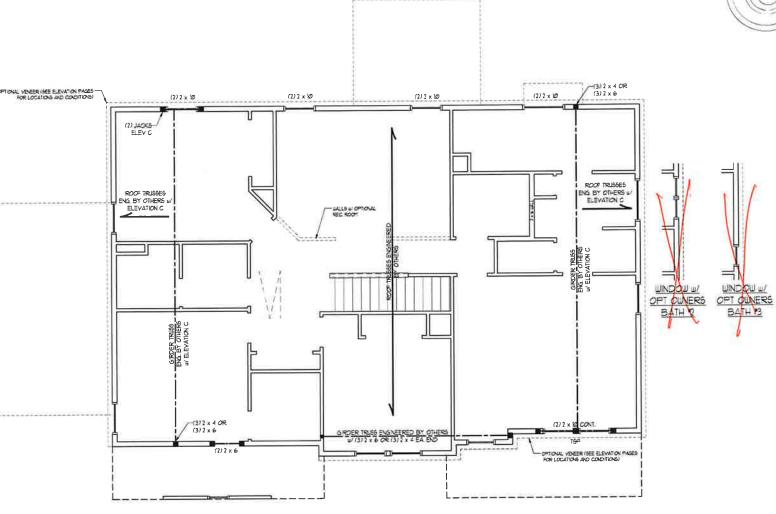



SOUTHPORT H&H HOMES

KARKARAKARAKE

227605 921

S. 1. NC 2

COMPS.
ERING.
SUITE 104 RAUGH.
TOPSON PAX (919) 78
TORSON PAX (919) 78

ENGINE 806 WADE AVE., SUI

DATE: NOVEMBER 2, 2021 SCALE: 1/4" = 1'-0" DRAWN BY: H&H HOMES

ENGINEERED BY: WFB

SHEET: 7 OF 9

CEILING FRAMING PLAN

GET ONAL COVERED PATO OPT, FIREPLACE:--X & RAFTERS • 16" OC TRUSS SUPPORT


#### BRICK SUPPORT NOTE:

- L FASTEN (2) 2 × 10 BLOCKING BETILEEN WALL STILDS W (4) 12d NAILS FER PLY, FASTEN A 6" x 4" x 5/16" STEEL ANSLE TO (2) 2 x 10 BLOCKING W (2) 10" LOS SCREWS \* 12" OC, STAGGERED SEE SECTION R (10) 32.1 OF THE 200 NORCE FOR ADDITIONAL BRICK SUPPORT INFORMATION 2. WHERE ROOF 6.0 PES EXCEED 1-12, INSTALL 3" x 3" x 14" STEEL PLATE STOPS AT 24" OC PER SECTION R (10) 322 OF THE NORTH CAROLINA RESIDENTIAL CODE, 2018 EDITION.

#### STRUCTURAL NOTES:

- STRUCTURAL NOTES:

  1. ALL FRAMING LUMBER TO BE 2
  5FF (UNO).
  2. CIRCLES DENOTE (3) 2 x 4 POSTS
  FOR ROOF SUPPORT.
  3. FRAME DOWNTER WALLS ON TOP
  OF DOUBLE OR TRIPLE RAFTERS.
  4. HIP ST-LCTS ARE TO BE STACED
  A MIN. OF 8-0°, FASTED
  MEMBERS WITH THREE ROUS OF
  IZM NAILS 9 % "O.C. (MYD)
  5. STICK RAME OVER-FRAMED
  ROOF SECTIONS W 12 x 8 RIDGES,
  2 x 6 RAFTERS 9 16" O.C. AND
  FLAT 1 x 10 VALLET'S OR USE
  VALLEY TRUSSES.
  6. FASTEN RAFTER SOR TRUSSES WITH
  SIMPSON R25A HURSICANE TIES 9
  32" O.C. MAX. PASS HURSICANE
  TIES THROUGH NOTCH IN ROOF
  SHEATHING, EACH RAFTER IS TO
  BE FASTENED TO THE FLAT
  VALLEY WITH A MIN. OF (6) 12d
  TOE NAILS.
  1. REFER TO SECTION R8021 OF THE
  2018 NICKE FOR REGISTED UPLET
  RESISTANCE AT RAFTERS AND
  THESSES.
  6. REFER TO NOTIES AND DETAIL
  SHEETS FOR ADDITIONAL
  STRUCTURAL INFORMATION.

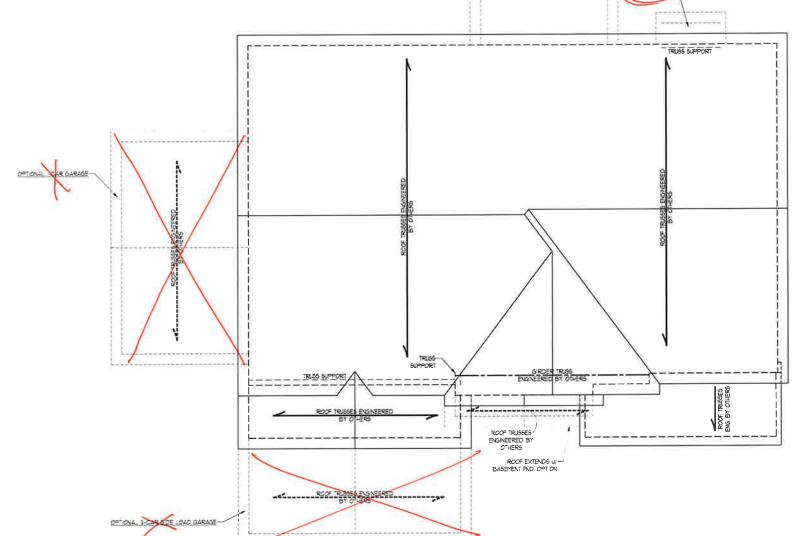

ELEVATIONS A & B



ENGINEERING, INC
606 WADDE AVE. SUTE 104 RALEQUI. NC. 11(619) 189-9919
N.C. LICENSENO; C. 1733

STATES STATES STATES


SOUTHPORT H&H HOMES


DATE: NOVEMBER 2, 2021


SCALE: 1/4" - 1'-0"

DRAWN BY: H&H HOMES


SHEET 8 OF 9 S-5a ROOF FRAMING PLAN

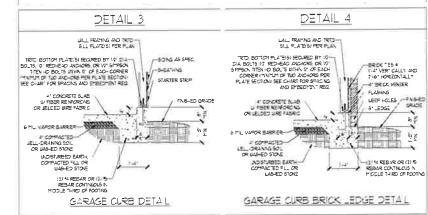

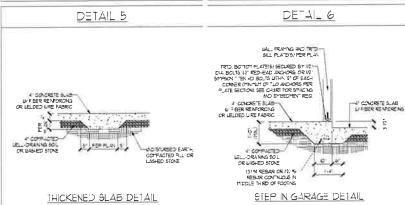

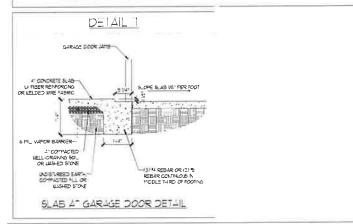


#### STEMWALL DETAILS

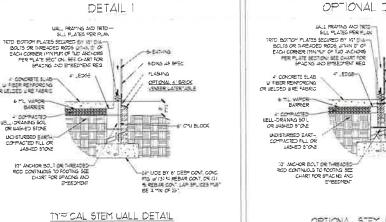


### DETAIL 2 LALL FRAMS AND INSTA SL. PLATES FER PLAN FOT DEOTTON PLATES FER PLAN BOLTS OR "HEADER ROOK MITHAN IN P EACH CORRES (MINING TO MICHOSE PER PLATE SECTION) SEE CHAPF FOR PACING AND PHECKEV FEQ THE CONTRACT AND 2-6- HORIZOGRALLY CONTRACT CONT 4" 15005-BARRIER WELL-DRAINING SOIL OR WAS-ED STONE INDISTURBED EARTH-COMPACTED FLL OR STONE CENERUL IT MO-OR BOLL OR THE ADED-HOD CONTINUES TO FOO ING SEE CHART FOR SPACING AND DIRECTION HY UDE BY IN DEEP CONT. COIC FOR UP ON MINESAR CONT OR DI SIREBAR CONT. LAP SPLICES MUST BE AIMN OF 25".

(\_/ OPTIONAL WATERTABLE)

TYPICAL STEM JALL FAD. W/ BRICK DETAIL

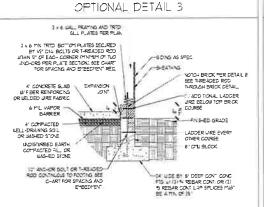

OPTIONAL STEM WALL FND. DETAIL W/ CURB & GARAGE

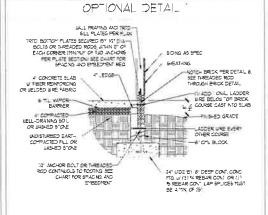

OPTIONAL STEY WALL DETAIL


DETAIL 3 BILL PRAMING AND TRID-SILL PLATES FER PLAN TRID BOTTOM PLATES SECURED BY 70 014-BOL'S OR THREADED RODS LITHIN IP OF EACH CORNER (MINTMI) OF TUD ANCHORS FER PLATE SECTIONS SEE CHART FOR SPACING AND BYBEDMENT REQ. SIDING AS SPEC SHEATHING 4" CONCRETE SLAB-W FRER RENFORCING OR JELDED WIRE FABRIC 6 ML VARDE SARRIER - NE-ED GRADE LEL\_-DRAINING SOIL OR WASHED STONE UND STURBED EARTH COMPACTED FILL OR LASHED STONE IG" ANCHOR BOLT OR "MEADING SEE ROD CONTINUOUS TO FOOTING SEE CHART FOR SPACING AND 24' WIDE ST 8" DEEP CONT CONC FTG W (3) "4" REBAR CONT OR (7) "5" REBAR CONT, LAP SPL CES MUST BE 4 MM OF 25"

TYP CAL STEM WALL PND. DETAIL W/ CURB & GARAGE

DETAIL 4

SILL PLATES PER PLAN	S BRICK TIES 9
TO BOTTOM PLATES SECURED BY UT DATED BOD STORY THE STORY THE STORY OF THE ACCUPANCE FOR PLATE SECURON SEE SHART FOR SPECIAL PLATE SEED SENTERS	1-1 VERTICALLY AND 1-4 HORIZONTALLY BRICK VENEER
# CONCRETE IL #3 UF FIBER REINFORCING OR LIELDED LINEE FABRIC	-UEEM HOLES
6 ML_VAPOR BARRIER	4
1' COMPASTED  JE_L-DRANNASOL  OR UAS-ED 5707E	_ADDER MRE EVER
MORRISO EVAL- COLOCATO L'IT OS	OTHER COURSE OTHER COURSE
10' ANCHOR BOLT OR THE AGED	MIDE BY 6" DEEP CONT CONC
CHART FOR SPACING AND EMBEDMENT	TO 1/31 M REBAR CONT OR (2)  5 REBAR CONT, LAP SPLICES MUST BE A MIN. OF 25

TYPICAL STEM WALL FAD DETAIL W/ BRICK AND CLRB & GARAGE

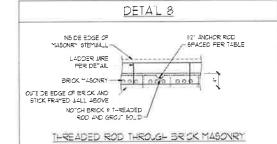

MASONRY STEMWALL SPECIFICATIONS

WALL HEIGHT (FEET)	MASONRY WALL TYPE			
	8' CMJ	4" ERICK AND 4" CMJ	4" BRICK AND 6" CMU	2' CM3
2 AND BELOW	UNGROUTED	GROUT BOLID	LNGROUTED	UNGROUTED
<u>\$</u>	UNGROUTED	GROUT SOLID	NRSONED	UNGROUTED
4	GROUT SOLID	GROUT SOLID #/ *4 REBAR 6 48' OC	GROJT SOLID	GROJT SOLID W/ *4 REBAR # 64" OC
5	GROJT SO_ D w/ 44 REBAR 9 36' OC	NOT APPLICABLE	GROL" SOLID W *4 REBAR \$ 36" OC	GROJT SOLID W/ *4 REBAR # 64" OC
6	GROJT 50_ D u/ *4 REBAR 6 241 0 C	NOT APPLICABLE	GROUT SOLID U/ *4 REBAR © 24" O.C.	GROJT SOLID w/ "4 REBAR © 64" O.C.
T AND GREATER	ENGINEERED DESIGN BASED ON SITE CONDITIONS			

STRUCTURAL NOTES

I WALL HEIGHT MEASURED FROM TOP OF FOOTING TO "OP OF THE WALL.

2. TIE MULTIPLE J'THES TOGETHER WITH LADDER WIRE AT "6" OC YERTICALL".

3. CHART APPLICABLE FOR HOUSE FOUNDATION COULT ENGINEER FOR DESIGN OF GARAGE ROUNDATION NOT COMMON TO HOUSE.

5. BACKFILL OF LIEAR 5" / "6" WASHED STONE IS ALLOWABLE.

5. BACKFILL OF LIEAR TO RESANCE OR SAMD - GRAVEL MIXTURE SOLDS (45 FSF/FT BELOU GRADE).

CLASSIFIED AS GROUP I ACCORDING TO UNITED SOLD SCLASSIFICATION SYSTEM IN ACCORDANCE.

UITH THE TRIBET OF THE 10/B INTERNATIONAL RESIDENTIAL CODE ARE ALLOWABLE.

6. FREE \$1.45 FST \$200." AND FROM IT BASE OF "HE 10/B INTERNATIONAL RESIDENTIAL CODE.

MINIMITY 2" LAS PELICE LENGTH.

1. COCATE REBAR IN CENTER OF FOUNDATION WALL.

5. WHERE REGUIRED, I'LL BLOCK SOLD JUTH "YES" S'MORTAR OR 3000 PS GROUT, USE OF "LOU LIFT GROUTING METHOD REQUIRED WHEN "ILLING WALLS WITH GROUT AT HEIGHTS OF 5" AND GREATER.

ANCH	HOR SPACING AND EMBEL	OMENT - STEM WALL
JIND ZONE	14∅ ~≃H	150 MP-1
5=4CING	-9" OC L/ DOUBLE SILL PLATE W/ 2" x 2" x 1/8" WASHERS	"-6" OC W/ DOUBLE SILL PLATE
E~BEDMENT	RODS CONTINUOUS FROM FOOTING UP THROUGH SILL PLATE W/ T' MIN CONCRETE EMBEDMENT	RODS CONTINUOUS FROM FOOTING U THROUGH 5 LL PLATE W/ T'' MN CONCRETE EMBEDMENT

ANCHO	OR SPACING AND EMBED	MENT MONO SLAB
JIND ZONE	140 >=4	150 MP-I
5=ACING	6'-0' OC W DBL SILL PLATE OR 1'-3" OC W SINSLE SILL PLATE W 2' x 2' x 1/8' WASHERS	6'-8" O.C. W/ DBL 51L PLATE CR 1-6" O.C. W/ SINGLE SILL PLATE W/
EYBEDMEN"	1"	90



SON INC 27605 789-9921 EERING,
SUITE 104 RALEGIL;
789,9919 PAX; (919) TR S. THO

**—**|Ш

SPEED WIND E DESIGN ' MPH ULTIMATE I FOUNDATION D MPH - 150

DATE NOVEMBER 14, 2018 SCALE: NTS DRAWN BY: JST NGINEERED BY: JES

140

D-1 FOUNDATION DETAILS

#### GENERAL WALL BRACING NOTES:

- WALL BRACING DESIGNED IN ACCORDANCE WITH CHAPTER 6 AND CHAPTER 45 OF THE 2018 NO RESIDENTIAL BUILDING


- LIMILL BRACING DESIGNED IN ACCORDANCE UITH CHAPTER 6 AND CHAPTER 45 OF THE 2018 NC RESIDENTIAL BUILDING CODE (NORC). TABLES AND FIGURES REFERENCED ARE REPORT THE 2018 NCRC.


  5. SEE THIS SHEET FOR GENERAL DETAILS, REFER TO THE 2018 NCRC FOR ADDITIONAL INFORMATION AS NEEDED.


  5. SEE STRUCTURAL SHEETS FOR BRACED WALL LOCATIONS, DIMENSIONS, HOLD DOUN TYPE AND LOCATIONS, AND ANY SPECIAL NOTES OR RECURPENIES.


  4. ALL EXTERIOR WALLS ARE TO BE SHEATHED WITH 1/6\* OSB WITH BLOCKING AT ALL SHEATHING JOINTS AND 8d NAILS AT 3\* OC. ALONS EDGES AND 6\* OC. IN THE FIELD UNLESS NOTED OTHERWISE.


  5. SECURE ALL EXTERIOR WALLS HEATHING PANELS TO DOUBLE TOP FLATES, BAND JOISTS, AND GIRDERS WITH (2) ROUS OF BUILDING STRUCTURE AND SHALL SYMPHOLD AT 3\* OC. PANELS SHALL EXTENIOR DE CONSTRUCTION JOINTS AND SHALL OVERLAP GENERAL AND SHALL DEPTH.
- GIRDERS AND SILL PLATES THEIR RILL DEPTH.
  6. ALL EXTERIOR WALLS TO BE SHEATHED ON NSIDE FACE WITH 1/2" GYPSUM BOARD PER TABLE R102.35 (UNO).

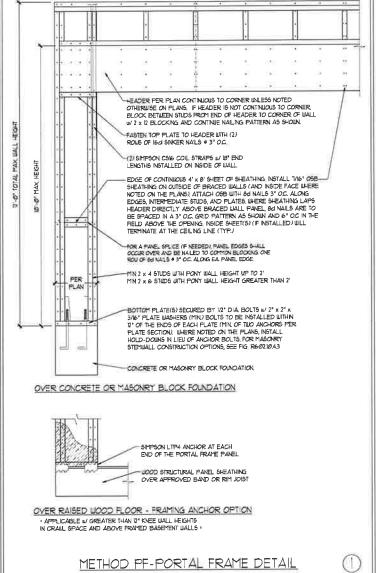


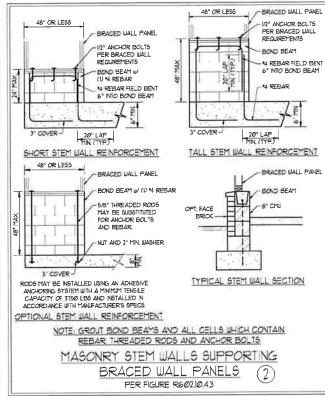


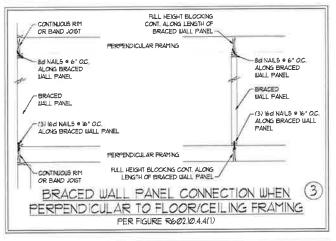


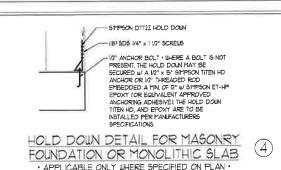

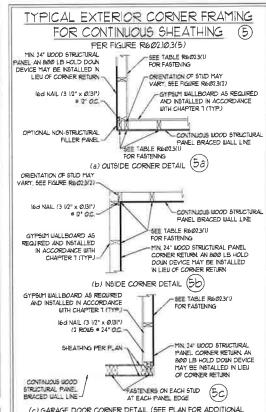

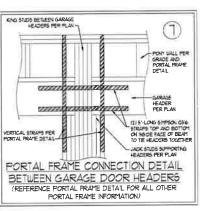

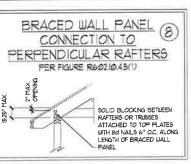


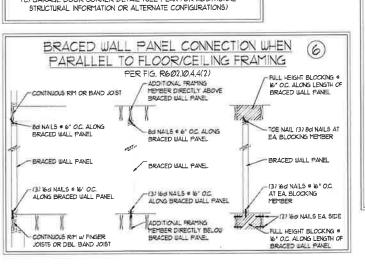

This sealed page is to be used in conjunction with a full plan set engineered by J.S. Thompson Engineering, Inc.

only. Use of this individual scaled page within

architectural pages or shop drawings by others is a punishable offense under N.C. Statute § 89C23

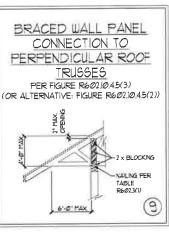

BRACED WALL NOTES AND DETAILS AND PF DETAIL

S 0 0 Z 02 工世 S ш

70

SPEED DESIGN WIND S S AND DETAILS MPH ULTIMATE I BRACING NOTES MPH - 150 WALL I 140

DATE: NOVEMBER 14, 2018 CALE: 1/4" = 1'.0"

DRAWN BY: JST

ENGINEERED BY: 1ST

D-2

#### GENERAL NOTES

- ENGINEER'S SEAL APPLIES ONLY TO STRUCTURAL COMPONENTS INCLIDING ROOF RAFTER'S, HIPS, VALLEYS, RIDGES, FLOORS, WALLS, BEAMS, HEADER'S, COLUMNS, CANTILEVERS, OFFSET LOAD BEARING WALLS, PIER'S, GIRDER SYSTEM AND FOOTING, ENGINEER'S SEAL DOES NOT CERTIFY DIMENSIONAL ACCURACY OF ARCHITECTURAL LAYOUT INCLIDING ROOF. ENGINEER'S SEAL DOES NOT APPLY TO 1-JOIST OR FLOOR/ROOF TRUSS
- 2. ALL CONSTRUCTION SHALL CONFORM TO THE LATEST REQUIREMENTS OF THE NORTH CAROLINA RESIDENTIAL CODE (NCRC), 2018 EDITION, PLUS ALL LOCAL CODES AND REGULATIONS. THE STRUCTURAL ENGINEER IS NOT RESPONSIBLE FOR AND WILL NOT HAVE CONTROL OF, CONSTRUCTION MEANS, TECHNIQUES, SEQUENCES OR PROCEDURES, OR SAFETY PRECAUTIONS AND PROGRAMS IN CONNECTION WITH THE CONSTRUCTION ILLORY NOR WILL THE ENGINEER BE RESPONSIBLE FOR THE CONTRACTORS FAILURE TO CARRY OUT THE CONSTRUCTION WORK IN ACCORDANCE
- 3. STRUCTURAL DESIGN BASED ON THE PROVISIONS OF THE NORC, 2018 EDITION (R301.4 R301.7)

DESIGN CRITERIA:	LIVE LOAD (PSF)	DEAD LOAD (PSF)	DEFLECTION (IN)
ATTIC WITH LIMITED STORAGE	20	ю	L/240 (L/360 w/ BRITTLE FINISHES)
ATTIC WITHOUT STORAGE	10	10	L/36Ø
DECK5	40	ro o	L/360
EXTERIOR BALCONIES	40	ю	L/360
FIRE ESCAPES	40	10	L/36Ø
HANDRAILS/GUARDRAILS	200 LB OR 50 (PLF)	10	L/36Ø
PASSENGER VEHICLE GARAGE	50	ø	L/3 <del>6</del> Ø
ROOMS OTHER THAN SLEEPING ROOM	40	ю	L/36Ø
SLEEPING ROOMS	3Ø	10	L/360
5TAIRS	40	10	L/360
WND LOAD	(BASED ON TABLE RSØ12)	(4) WIND ZONE AND EXPOSURE	)
GROUND SNOW LOAD: Pa	20 (PSF)		

- I-JOIST SYSTEMS DESIGNED WITH 12 PSF DEAD LOAD AND DEFLECTION (IN) OF L/48/0
- FLOOR TRUSS SYSTEMS DESIGNED WITH IS PSF DEAD LOAD
- 4. FOR 15 AND 120 MPH WIND ZONES, FOUNDATION ANCHORAGE IS TO COMPLY WITH SECTION R40316 OF THE NCRC, 2016 EDITION. FOR 130 MPH, 140 MPH. AND 150 MPH WIND 70NES FOUNDATION ANCHORAGE IS TO COMPLY WITH SECTION 4504 OF THE NORC. 2018 EDITION
- 5. ENERGY EFFICIENCY COMPLIANCE AND INSULATION VALUES OF THE BUILDING TO BE IN ACCORDANCE WITH CHAPTER II OF THE NCRC, 2018 EDITION.

#### FOOTING AND FOUNDATION NOTES

- FOUNDATION DESIGN BASED ON A MINIMUM ALLOWABLE BEARING CAPACITY OF 2000 PSF, CONTACT GEOTECHNICAL ENGINEER IF BEARING
- 2. FOR ALL CONCRETE SLABS AND FOOTINGS, THE AREA WITHIN THE FERMITTER OF THE BUILDING ENVELOPE SHALL HAVE ALL VEGETATION, TOP SOIL AND FOREIGN MATERIAL, THE PROVED. FILL HATERIAL SHALL BE FREE OF VEGETATION AND FOREIGN MATERIAL. THE FILL SHALL BE COPRACTED TO A SENIE INFORM SUPPORT OF THE SLAB, AND EXCHED THE PROVED, THE FILL DEPTHS SHALL NOT EXCEED 74" FOR CLEAN SAND OR GRAVEL A 2" THICK BASED COURSE CONSISTING OF CLEAN GRADED SAND OR GRAVEL HAVING SOIL BE FLACED, A BASE COURSE IS NOT SEQUEED LEFT A CONCRETE SLAB IS NOTATED ON BALL FOR ARAPEL HAVING SOILS CLASSIFIED AS GROUP, I ACCORDING TO THE INTER SOIL CLASSIFICATION SYSTEM IN ACCORDINACE WITH TABLE RAPSL OF THE NORC, 2018 EDITION.
- 3. PROPERLY DEWATER EXCAVATION PRIOR TO POURING CONCRETE WHEN BOTTOM OF CONCRETE SLAS IS AT OR BELOW WATER TABLE. APPLICABLE, 3/4" - 1" DEEP CONTROL JOINTS ARE TO BE SAUED WITHIN 4 TO 12 HOURS OF CONCRETE FINISHING AND WALL LOCATIONS HAVE BEEN MARKED, ADJUST WHERE NECESSARY.
- 4. CONCRETE SHALL CONFORM TO SECTION RADIZ OF THE NORC, 2006 EDITION. CONCRETE REINFORCING STEEL TO BE ASTM A6/5 GRADE 60. BELDED WRE FARRY TO BE ASTM A6/5. HANTAN A HINMIM CONCRETE COVER AROUND REINFORCING STEEL OF 3" IN FOOTINGS AND 1/0" IN \$4.865, FOR POWED CONCRETE WALLS CONCRETE COVER FOR REINFORCING STEEL PERASURED FROM THE INSIDE FACE OF THE WALL SHALL. NOT BE LESS THAN 1/1, CONCRETE COVER FOR REINFORCING STEEL PERASURED FROM THE OUTSIDE FACE OF THE WALL NOT BE LESS THAN 1/1/2" FOR "5 BARS OR SMALLER, AND NOT LESS THAN 2" FOR "6 BARS OR LARGER.
- 5. MASONRY UNITS TO CONFORM TO ACE 530/ASCE 5/TMS 402, MORTAR SHALL COMFORM
- 6. THE UNSUPPORTED HEIGHT OF MASONRY PIERS SHALL NOT EXCEED FOUR TIMES THEIR LEAST DIPENSION FOR UNFILLED HOLLOW CONCRETE MASONRY UNITS AND TEN TIMES THEIR LEAST DIPENSION FOR SOLID OR SOLID FILLED PIERS, PERS MAY BE FILLED SOLID WITH CONCRETE OR TYPE HY OR 5 MORTIAR PIERS AND WALLS SHALL BE CAPPED WITH 8" OF SOLID WITH ASONRY.
- THE CENTER OF EACH OF THE PIERS SHALL BEAR IN THE MIDDLE THIRD OF IT'S RESPECTIVE FOOTING, EACH GIRDER SHALL BEAR IN THE MIDDLE THIRD OF THE PIERS.
- 8. ALL CONCRETE AND MASONRY FOUNDATION WALLS ARE TO BE CONSTRUCTED IN ACCORDANCE ALL CONCRETE AND MASOMRY FOUNDATION WALLS ARE TO BE CONSTRUCTED IN ACCORDANCE WITH THE PROVISIONS OF SECTION READ OF THE NORCE, 2018 EDITION OR IN ACCORDANCE WITH ACI 318, ACI 323, NCTA TRE68-A OR ACE 530/ASCE 5/THS 402. MASOMRY FOUNDATION WALLS ARE TO BE REINFORCED FOR TABLE READ-WITH REMAINING, READ-WITH PROVISION OF THE NORCE, 2019 EDITION. CONCRETE FOUNDATION WALLS ARE TO BE REINFORCED FER TABLE READ-WITH SECTION WALLS ARE TO BE REINFORCED FER TABLE READ-WITH SECTION WALLS AT 16.7 O.2 × 6 FRAMED WALLS AT 16.7 O.2 WHERE GRADE FERMITS (UND).

This scaled page is to be used in conjunction with a full plan set engineered by J.S. Thompson Engineering, Inc. only. Use of this individual sealed page within architectural pages or shop drawings by others is a punishable offense under N.C. Statute § 89C-23

#### FRAMING NOTES

- ALL FRAMING LUMBER SHALL BE 12 SPF MINIMUM (Fib = 815 PS), Fv = 315 PS), E = 16000000 PSI) UNLESS NOTED OTHERWISE (UNO), ALL TREATED LUMBER SHALL BE 12 SYP MINIMUM (Pb = 915 PS), Fv = 115 PSI, E = 16000000 PSI) WILESS NOTED OTHERWISE (UND).
- 2. LAMINATED VENEER LIMBER (LVL) SHALL HAVE THE FOLLOWING MINIMUM PROPERTIES: Po =2600 PSI, Fv = 285 PSI, E = 18000000 PSI, LAMINATED STRAND LIMBER (LSL.) SHALL HAVE THE FOLLOWING MINIMUM PROPERTIES: Pb = 2325 PSI, Fv = 310 PSI, E = 650000 PSI. PARALLEL STRAND LUMBER (PSL) UP TO 1" DEPTH SHALL HAVE THE FOLLOWING HINMUM PROPERTIES: FC = 2500 PSI, E = 1000000 PSI, PARALLEL STRAND LUMBER (PSL) MORE THAN 1" DEPTH SHALL HAVE THE FOLLOWING MINIMUM PROPERTIES: FC = 2900 PSI, E = 20000000 PSI, INSTALL ALL CONNECTIONS PER MANUFACTURER'S SPECIFICATIONS,
- 5 STRUCTURAL STEEL SHALL CONFORM TO THE FOLLOWING ASTM SPECIFICATIONS

W AND WT SHAPES: CHANNELS AND ANGLES: A5TM A992 PLATES AND BARS: A5TM A36 HOLLOW STRUCTURAL SECTIONS: ASTM A500 GRADE B ASTM A53, GRADE B, TYPE E OR 5

4. STEEL BEAMS SHALL BE SUPPORTED AT EACH BID WITH A MINIMUM BEARING LENGTH OF 3 1/2" AND FULL FLANGE WIDTH (INO). PROVIDE SOLID BEARING FROM BEAM SUPPORT TO FOUNDATION. BEAMS SHALL BE ATTACHED AT THE BOTTOM FLANGE TO EACH SUPPORT AS FOLLOUS (LNO)

(2) 1/2" DIA, x 4" LONG LAG SCREUS A WOOD FRAMING (2) I/2" DIA y 4" DEDGE ANCHORS B. CONCRETE C. MASONRY (FULLY GROUTED) (2) I/2" DIA x 4" LONG SIMPSON TITEN HD ANCHORS

LATERAL SUPPORT IS CONSIDERED ADECUATE PROVIDING THE JOISTS ARE TOE NAILED TO THE 2x NAILER ON TOP OF THE STEEL BEAM, AND THE 2x NAILER IS SECURED TO THE TOP OF THE STEEL BEAM w/ (2) ROUS OF SELF TAPPING SCREUG 6 (6" O.C., OR (2) ROUS OF I/2" DIAMETER BOLTS . IF 1/2" BOLTS ARE USED TO FASTEN THE NAILER, THE STEEL BEAM SHALL BE FABRICATED W (2) ROUS OF 9/16" DIAMETER

- 5. SQUARES DENOTE POINT LOADS WHICH REQUIRE SOLID BLOCKING TO GIRDER OR FOUNDATION, SHADED SQUARES DENOTE POINT LOADS FROM ABOVE WHICH REQUIRE SOLID BLOCKING TO SUPPORTING MEMBER BELOW.
- ALL LOAD BEARING HEADERS TO CONFORM TO TABLE R602.7(1) AND R602.7(2) OF THE NORC, 2018 EDITION OR BE (2) 2 x 6 WITH (1) JACK AND (1) KING STUD EACH END (UNO), UNICHEVER IS GREATER ALL HEADERS TO BE SECURED TO EACH JACK STUD WITH (4) 8d NAILS ALL BEAMS TO BE SUPPORTED WITH (2) STUDS AT EACH BEARING POINT (UNO). INSTALL KING STUDS PER SECTION R602.15 OF THE NORTH
- 1 ALL BEAMS HEADERS OR GIRDER TRUSSES PARALLEL TO WALL ARE TO BEAR FULLY ON (1) JACK OR (2) STUDS MINIMUM OR THE NUMBER OF JACKS OR STIDDS NOTED. ALL BEAMS OR GIRDER TRUSSES PERPENDICULAR TO WALL AND SUPPORTED BY (3) STUDS OR LESS ARE TO HAVE I VI" MINIMUM BEARING (IND.). ALL BEAMS OR GIRDER TRUSSES PERPENDICULAR TO WALL AND SUPPORTED BY MORE THAN (3) STUDS OR OTHER NOTED COLUMN ARE TO BEAR FULLY ON SUPPORT COLUMN FOR ENTIRE WALL DEPTH (UNO), BEAM ENDS THAT BUTT INTO ONE ANOTHER ARE TO EACH BEAR EQUAL LENGTHS (UNO).
- 8. FLITCH BEAMS SHALL BE BOLTED TOGETHER USING 1/2" DIAMETER BOLTS (ASTM A3ØT) WITH WASHERS PLACED AT THREADED END OF BOLT, BOLTS SHALL BE SPACED AT 24" CENTERS (MAXIMUM), AND STAGGERED AT TOP AND BOTTOM OF BEAM (2" EDGE DISTANCE), WITH (2) BOLTS LOCATED AT 6" FROM EACH END (UNO).
- 9. ALL I-JOIST OR TRUSS LAYOUTS ARE TO BE IN COMPLIANCE WITH THE OVERALL DESIGN SPECIFIED ON THE PLANS. ALL DEVIATIONS ARE TO BE BROUGHT TO THE ATTENTION OF THE ENGINEER OF RECORD PRIOR TO INSTALLATION.
- W. BRACED WALL PANELS SHALL BE CONSTRUCTED ACCORDING TO THE NORTH CAROLINA RESIDENTIAL CODE 2018 EDITION WALL BRACING CRITERIA, THE AMOUNT, LENGTH, AND LOCATION OF BRACING SHALL COMPLY WITH ALL APPLICABLE TABLES IN SECTION R602 10.
- PROVIDE DOUBLE JOIST UNDER ALL WALLS PARALLEL TO FLOOR JOISTS, PROVIDE SUPPORT UNDER ALL WALLS PARALLEL TO FLOOR TRUSSES OR 1-JOISTS PER MANUFACTURER'S SPECIFICATIONS. INSTALL BLOCKING BETWEEN JOISTS OR TRUSSES FOR POINT LOAD SUPPORT FOR ALL POINT LOADS ALONG OFFSET LOAD LINES.
- POR ALL HEADERS SUPPORTING BRICK VENEER THAT ARE LESS THAN 8'-Ø' IN LENGTH, REST A 6" x 4" x 5/6" STEEL ANGLE WITH 6" MINIMUM EMBEDMENT AT SIDES FOR BRICK SUPPORT (UNO). FOR ALL HEADERS 6'-Ø" AND GREATER IN LENGTH, BOLT A 6" x 4" x 5/6" STEEL ANGLE TO HEADER HITH 10" LAG SCREUG AT 12" OC STAGGERED FOR BRICK SUPPORT, FOR ALL BRICK SUPPORT AT ROOF LINES, BOLT A 6" X 4" X 5/16" STEEL ANGLE TO (2) 2 x 10 BLOCKING INSTALLED w/ (4) 12d NAILS EA PLY BETWEEN WALL STUDS WITH (2) ROUS OF V2" LAG SCREWS AT 12" O.C. STAGGERED AND IN ACCORDANCE WITH SECTION RT03.82.1 OF THE NORG, 2018 EDITION.
- B. FOR STICK FRAMED ROOFS: CIRCLES DENOTE (3) 2 x 4 POSTS FOR ROOF MEMBER SUPPORT. HIP SPLICES ARE TO BE SPACED A MINIMUM OF 8-0" FASTEN MEMBERS WITH THREE ROUS OF I'M NAILS AT IO" OC FRAME DOR"ER WALLS ON TOP OF DOUBLE OR TRIPLE RAFTERS AS
- 14. FOR TRUSSED ROOFS: FRAME DORMER WALLS ON TOP OF 2 x 4 LADDER FRAMING AT 24" O.C. BETWEEN ADJACENT ROOF TRUSSES. STICK RAME OVER-FRAMED ROOF SECTIONS WITH 2 x 8 RIDGES, 2 x 6 RAFTERS AT 16" O.C. AND FLAT 2 x 10 VALLEYS (LINO).
- IS ALL 4 V A AND 4 V A POSTS TO BE INSTALLED WITH 100 LB CAPACITY UPLIET CONNECTORS TOP AND BOTTOM (UNO.) POSTS MAY BE SECURED USING ONE STIFFSON HIS O'R LITST, UPLIFT CONNECTOR FASTENED TO THE BAND AT THE BOTTOM AND THE BEAM AT THE TOP OF EACH POST. ONE IS SECTION OF SHIPSON CSIC COIL. STRAPPING WITH (8) 84 HOG NAULS AT EACH END MAY BE USED IN LIEU OF EACH TUIST. STRAP IF DESIRED. FOR MASONRY OR CONCRETE FOUNDATION USE SIMPSON POST BASE,

S ERING, UITE 104 RALEIGH, 189,9919 FAX, (919) 78 工一 z ء التا • قا လ ဂြန္န

SPEED - 150 MPH ULTIMATE DESIGN WIN: STANDARD STRUCTURAL NOTES 140 MPH

DATE: NOVEMBER 14, 2018

SCALE 1/4" - 100"

DRAWN BY: JES NGINEERED BY: JST

S-0

STRUCTURAL NOTES