

LIST OF SYMBOLS


	SECTION MARK		DATUM ELEVATION
	DETAIL MARK		SLOPE UP 12:12
	TITLE MARK		EARTH
	INTERIOR BEARING WALL		INSULATION
	NUMBER OF GANG STUDS IN WALL		

TABLE OF CONTENTS


1	ELEVATIONS
2	ELEVATIONS
3	FOUNDATION PLAN
4	1st FLOOR PLAN
5	2nd FLOOR PLAN
E1	1st FLOOR ELECTRICAL PLAN
E2	2nd FLOOR ELECTRICAL PLAN

SPACE DATA


FIRST FLOOR, HEATED:	1444 SF
SECOND FLOOR, HEATED:	1418 SF
TOTAL HEATED:	2862 SF
GARAGE:	
3rd CAR GARAGE OPTION:	514 SF
FRONT PORCH:	266 SF
REAR PORCH:	96 SF
	154 SF

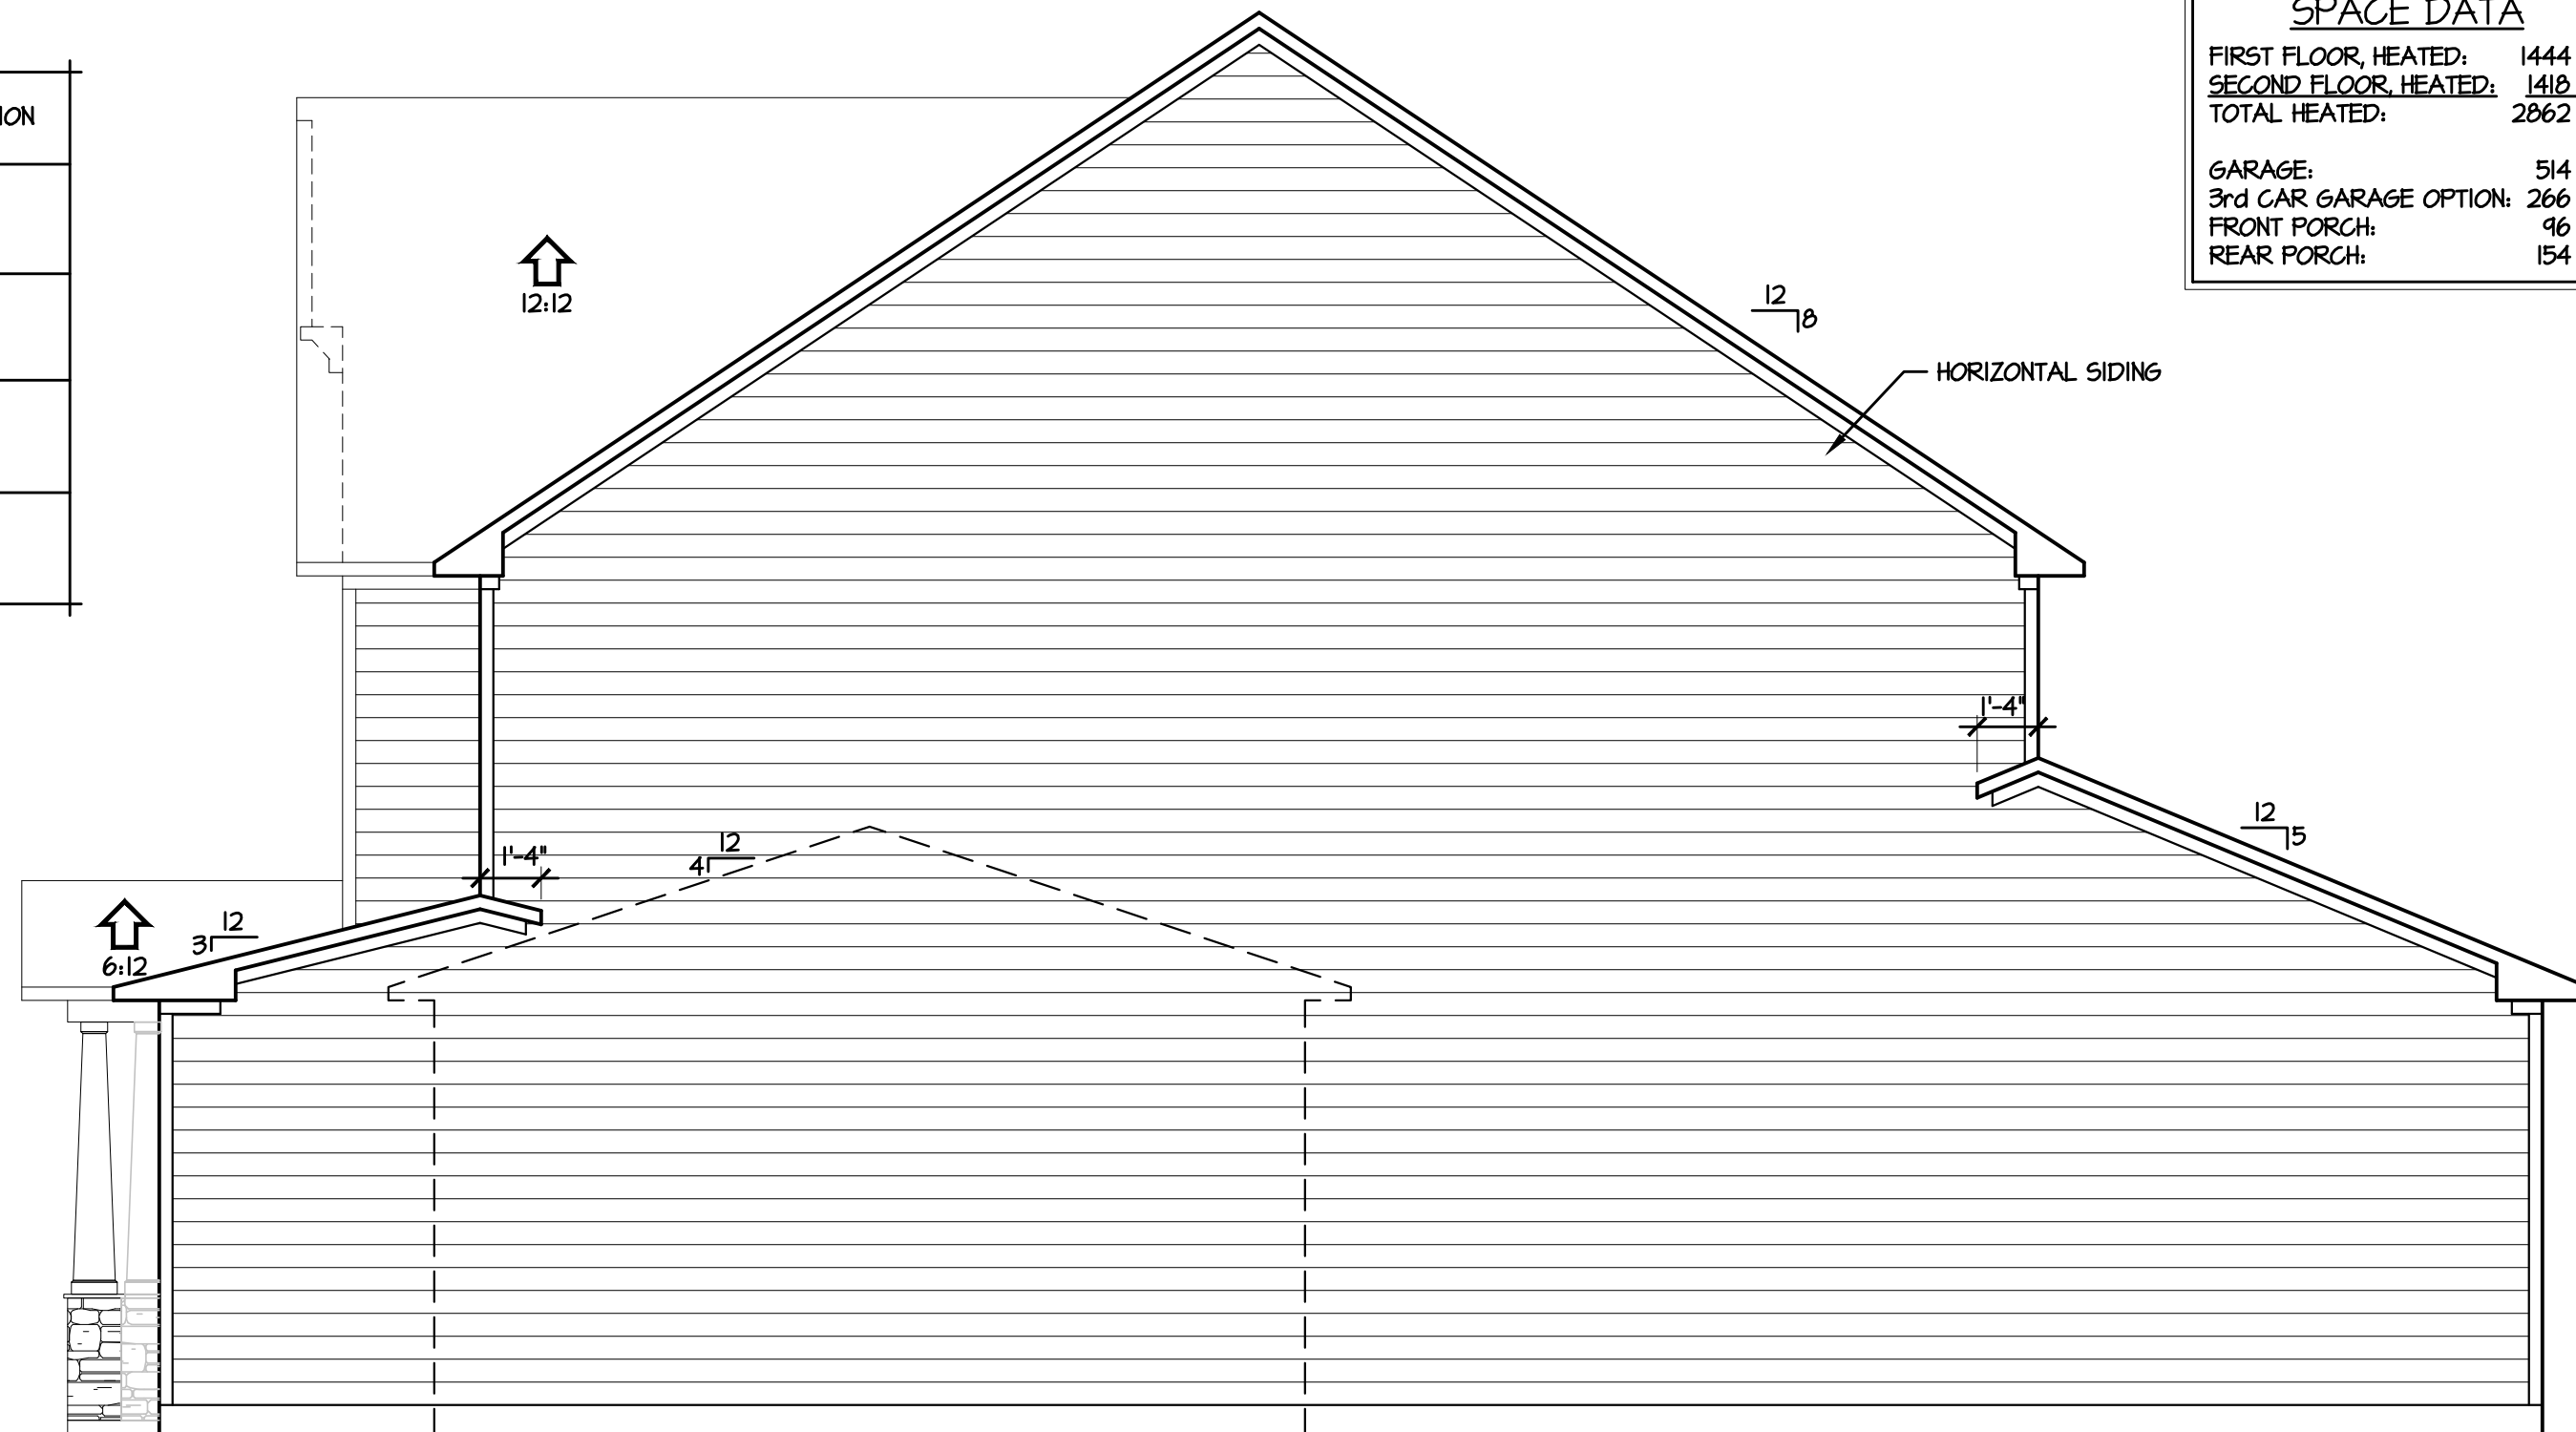

2 RIGHT SIDE ELEVATION
1/4" = 1'-0"
OPTIONAL 3rd CAR GARAGE

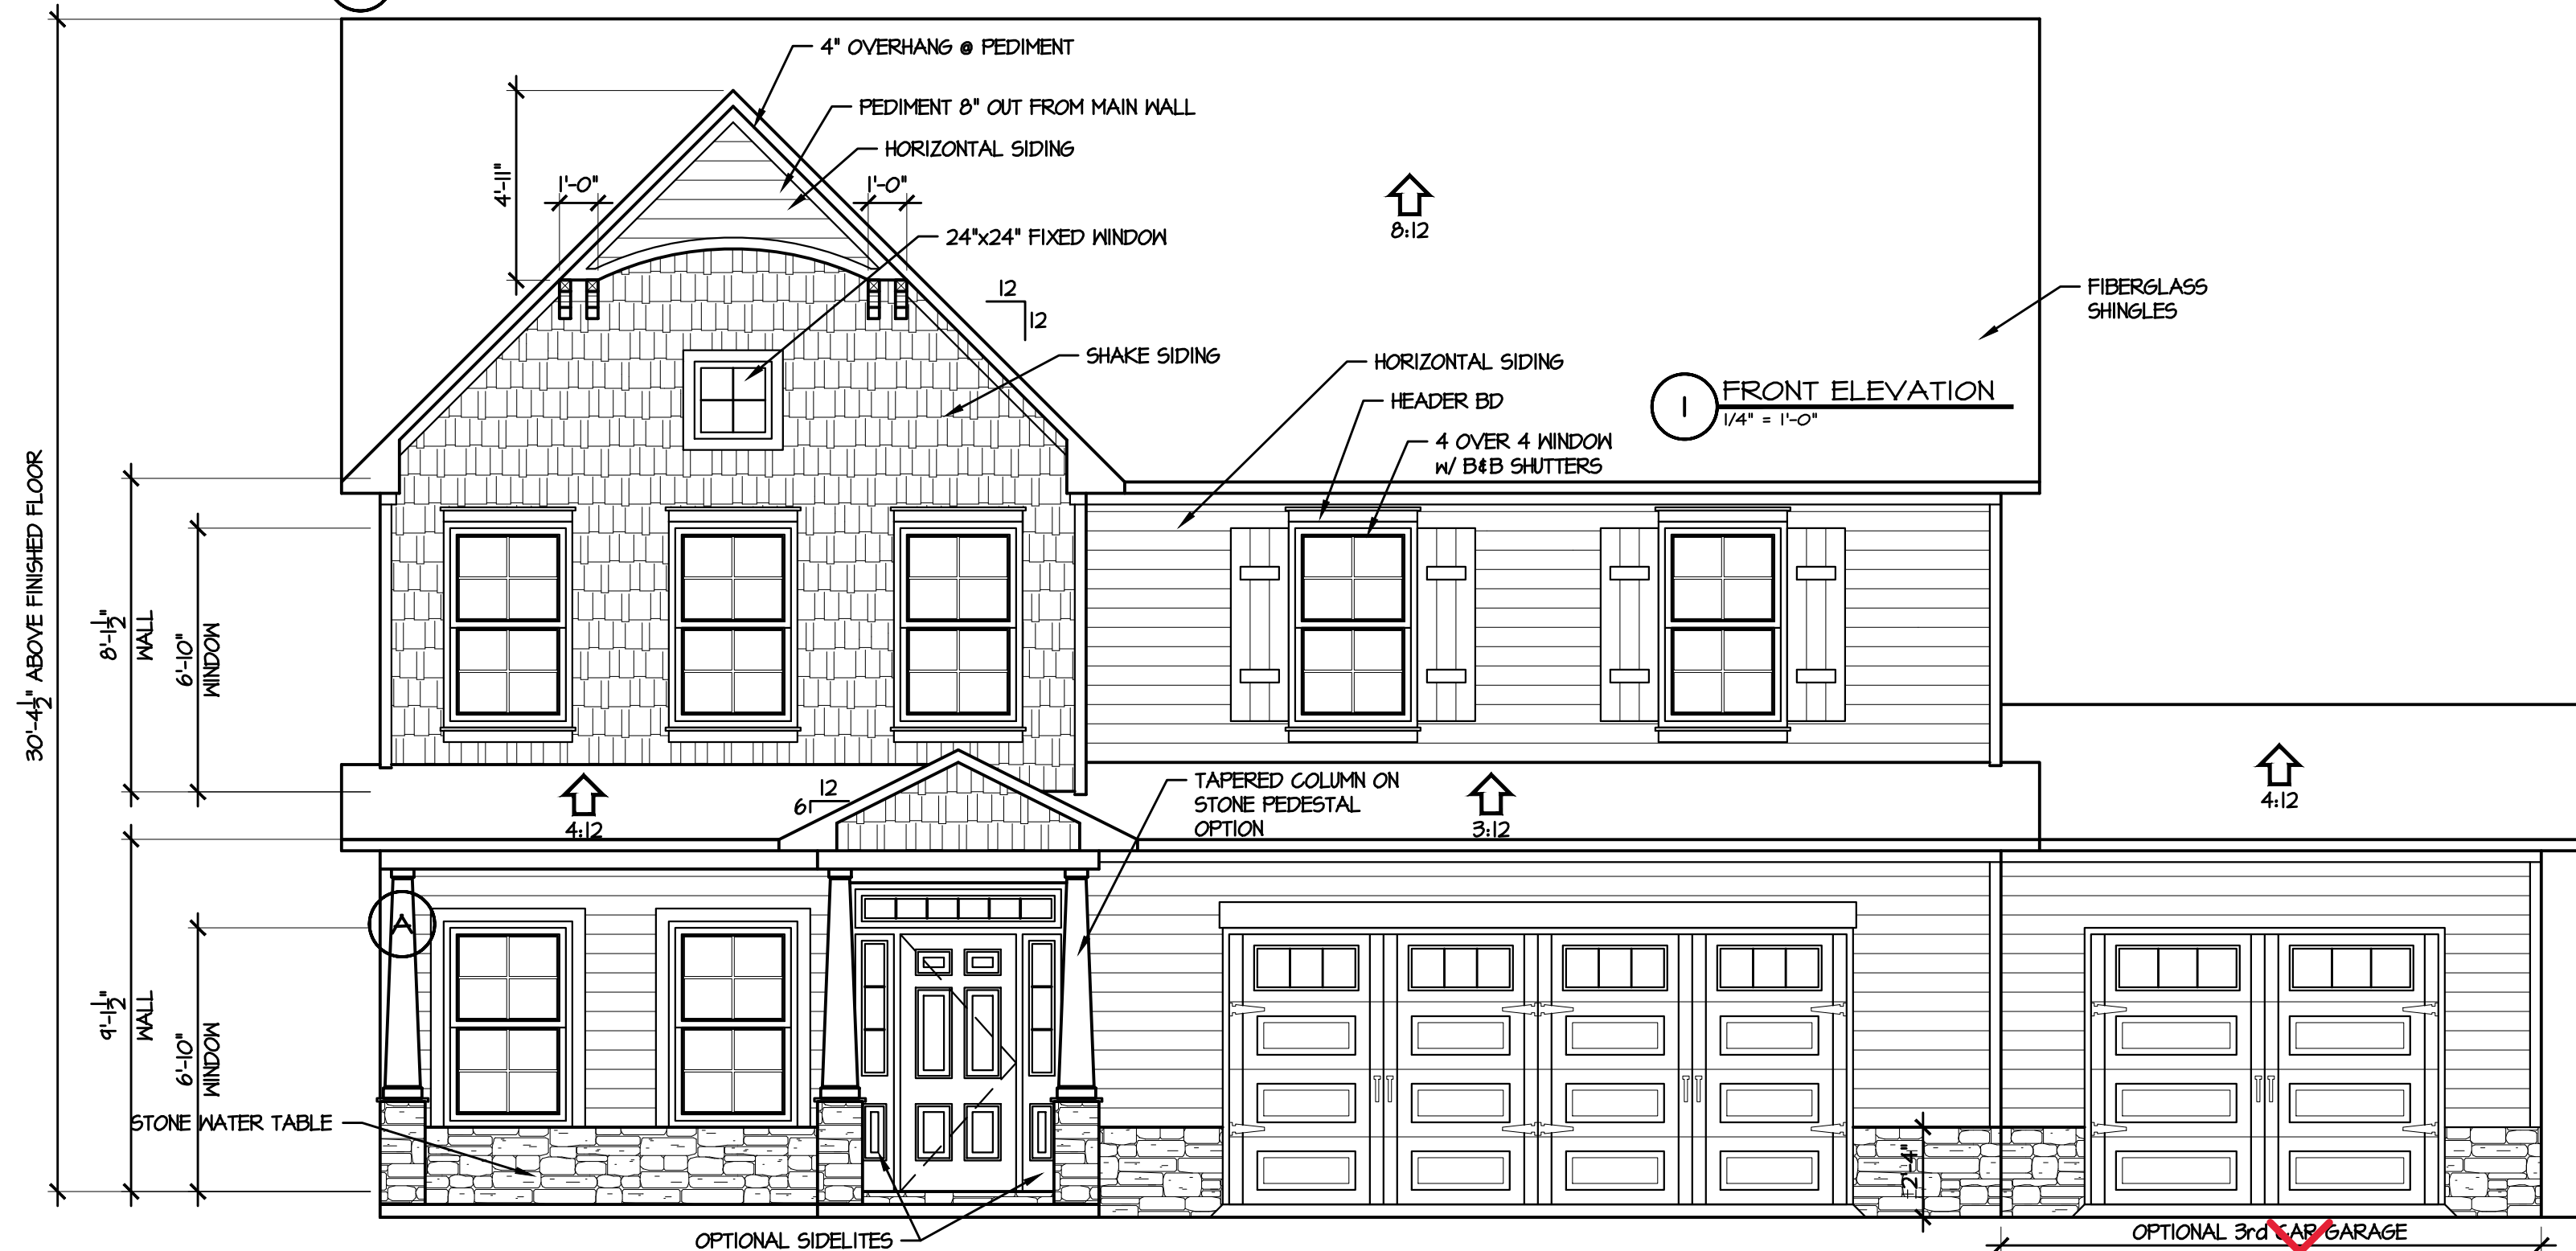

1 FRONT ELEVATION
1/4" = 1'-0"

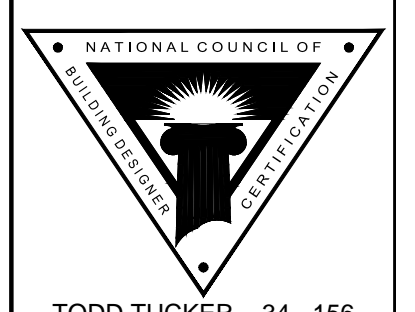

TODD TUCKER 34 - 156

© 2019 CavLand
1041-B Robeson St
Fayetteville, NC 28305
Office: 910-339-6330
Fax: 910-339-6333

CL 2862

ELEVATIONS

SCALE:
AS NOTED

DATE:
APRIL 2019

PLAN:
CL 2862

LOT NO:


SHEET NO:

1

LIST OF ABBREVIATIONS

ACCESS AFF	ACCESS TO ATTIC OR CRAWL SPACE ABOVE FLOOR	DW EQ	DISH WASHER EQUAL	POCKET DOOR PERFORATED	T.C. TOP	TOP CHORD TOP OF WALL TRANSOM TYPICAL
BDRM BM	BEDROOM BEAM	FDN FV	FOUNDATION FOUNDATION VENT	PLATE PRESSURE TREATED FOR EXPOSURE	TRANS TYP	
CAB CJ	CABINETS / CABINETRY CONTROL JOINT	GL HB	GLASS (DOOR) HOSE BIB	POINT LOAD (SOLID BLOCK) ROD & SHELF (CLOSETS)	UN	UNLESS OTHERWISE NOTED
CL	CENTERLINE	HDR HVAC	DOOR / WINDOW / OPENING HEADER HEATING, VENTING & AIR CONDITION	REFRIGERATOR REINFORCEMENT	V.B. VAN	VAPOR BARRIER VANITY
CHU COL	CONCRETE MASONRY UNIT CLEAR OPENING	KWALL LVL	KNEEWALL LAMINATED VENEER LUMBER	ROOM	W W	WIDE WITH
CONC CSMT	COLUMN CASEMENT	MANF MAS	MANUFACTURED MASONRY	SEGMENTED SHOWER	#SP	NUMBER OF STUD POCKETS @ WINDOW/DOOR JAMB
DBL DIAM	DOUBLE DIAMETER	NIC OC	NOT IN CONTRACT ON CENTER	SPECIFICATION / SPECIFIED SQUARE		
DH/SH DN	DOUBLE HING / SINGLE HING WINDOW DOWN	OPNG	OVERHANG OPENING	SIMPSON STRONG-TIE OR EQUAL SUB-FLOOR		
DP	DEEP			SOUTHERN YELLOW PINE		


1 REAR ELEVATION
1/4" = 1'-0"

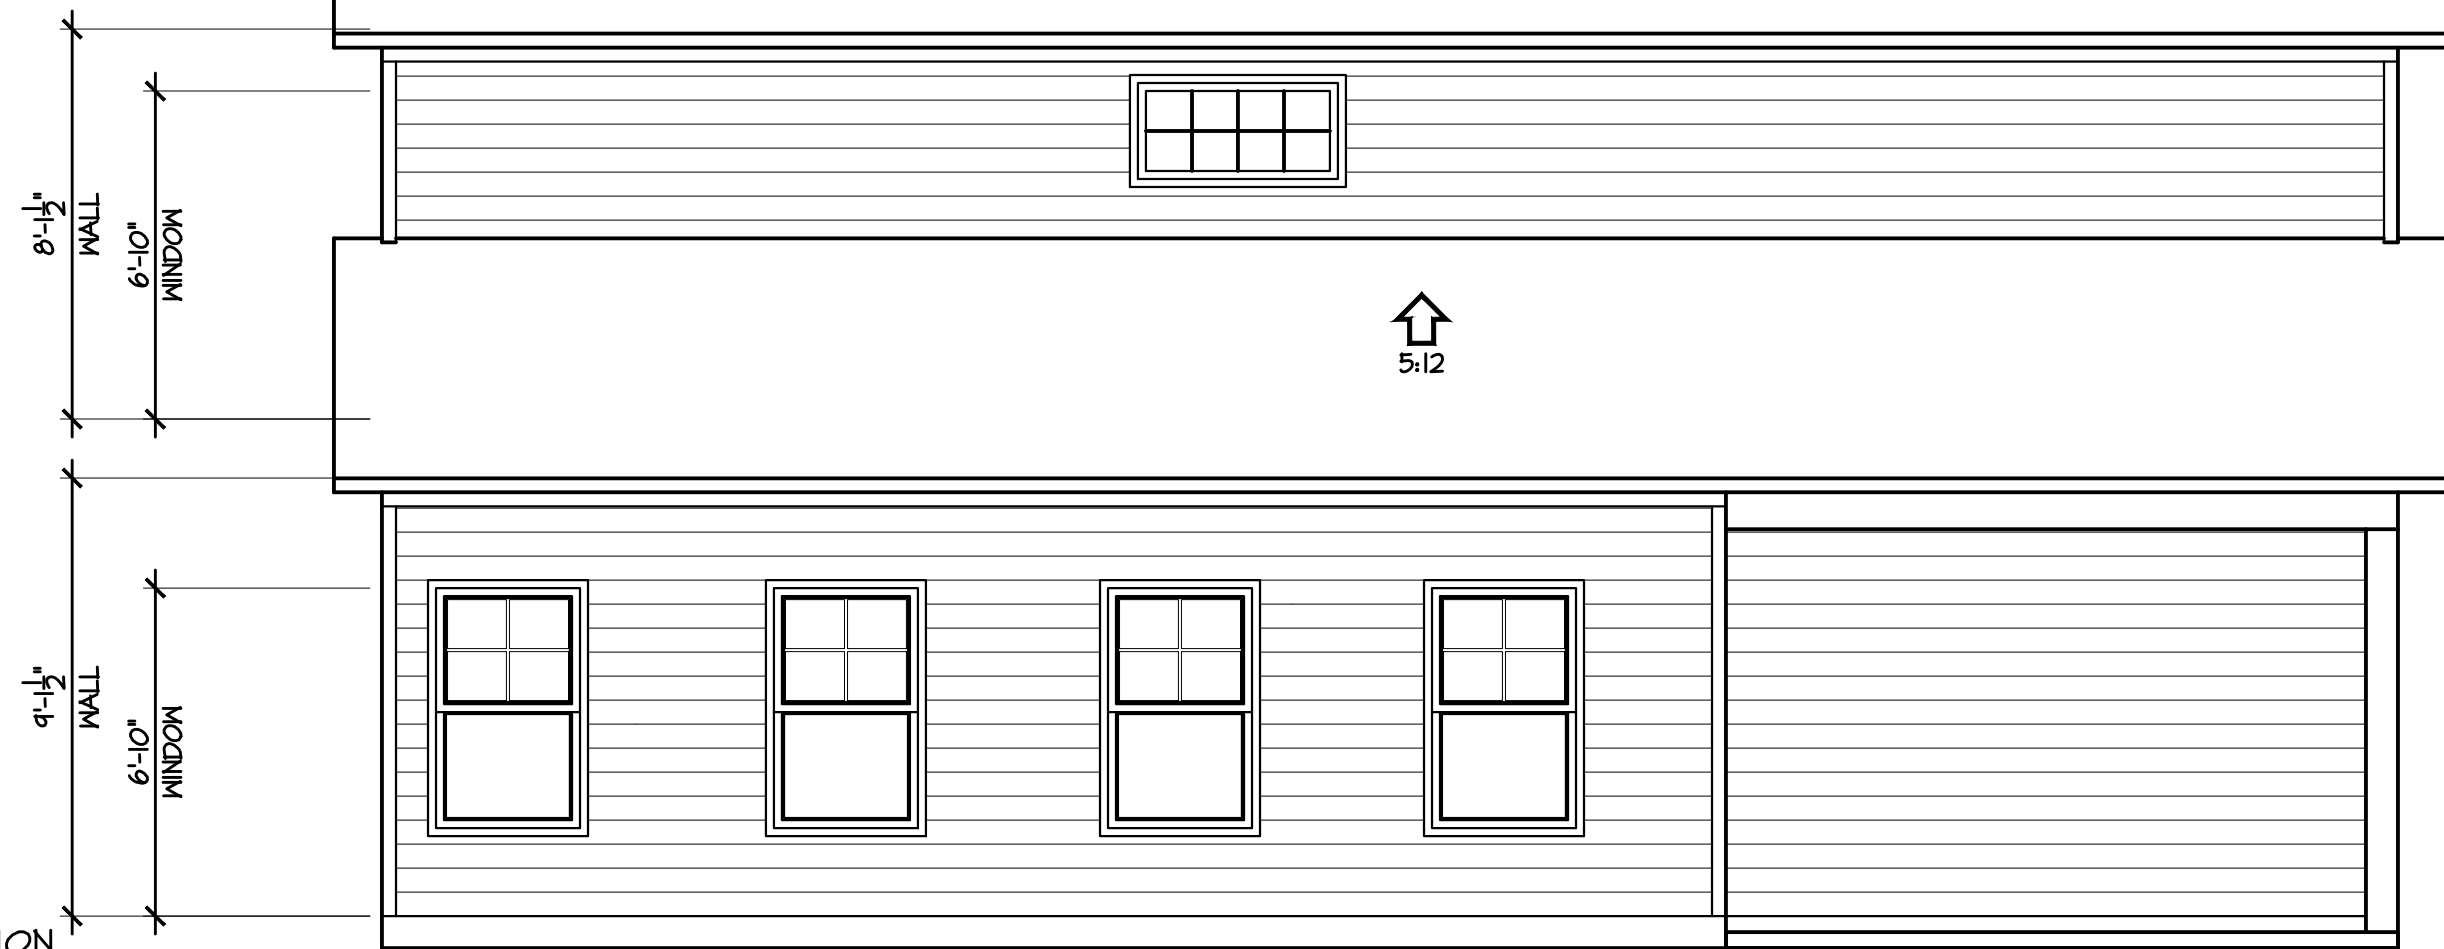

2 LEFT SIDE ELEVATION
1/4" = 1'-0"





SPACE DATA	
FIRST FLOOR, HEATED:	1444 SF
SECOND FLOOR, HEATED:	1418 SF
TOTAL HEATED:	2862 SF
GARAGE:	
3rd CAR GARAGE OPTION:	514 SF
FRONT PORCH:	266 SF
REAR PORCH:	96 SF
	154 SF

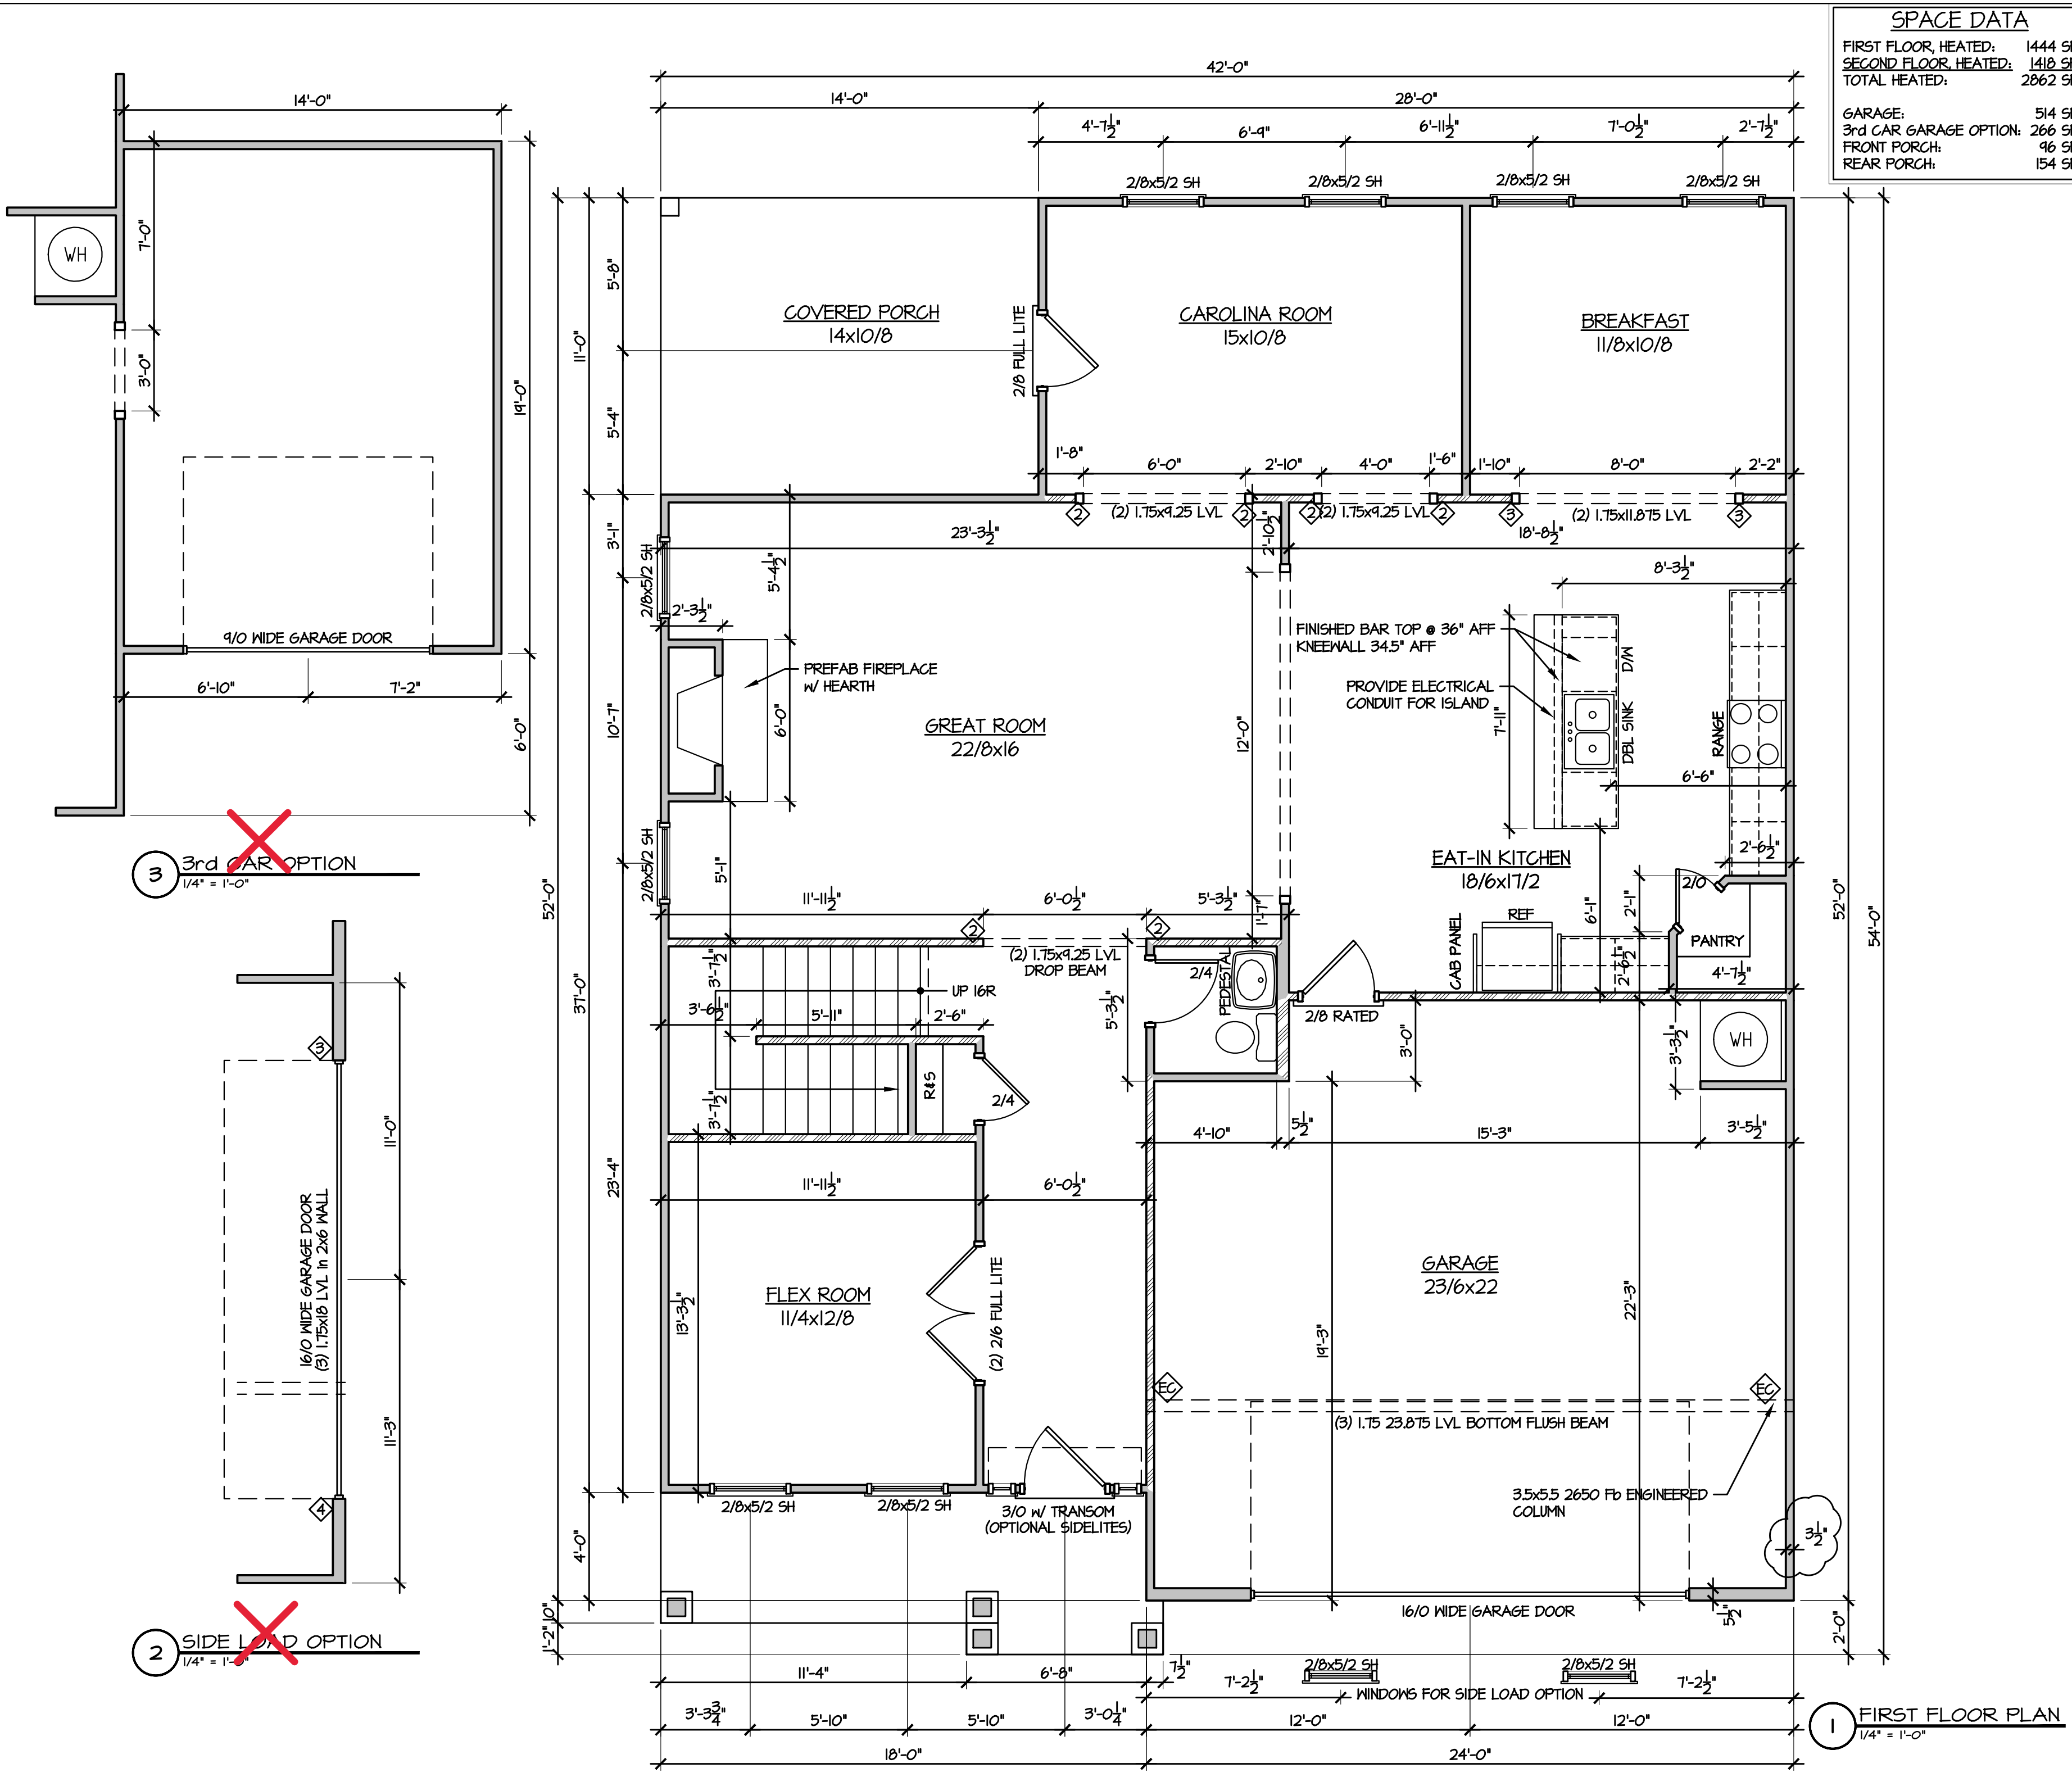

3 ~~3rd CAR OPTION~~
1/4" = 1'-0"

2 ~~SIDE LOAD OPTION~~
1/4" = 1'-0"

1 FIRST FLOOR PLAN
1/4" = 1'-0"

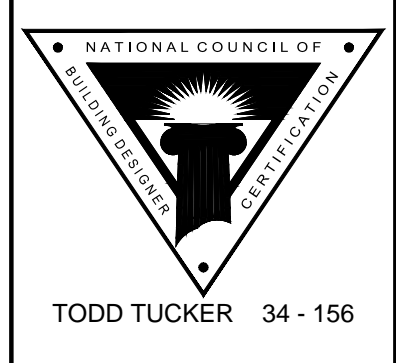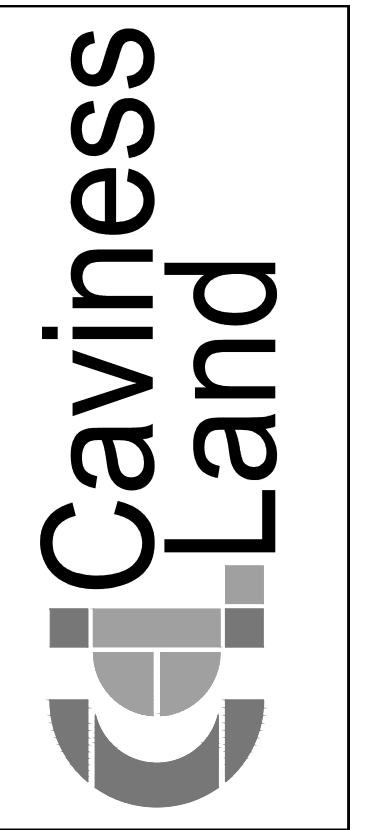

© 2019 CavLand
1041-B Robeson St
Fayetteville, NC 28305
Office: 910-339-6330
Fax: 910-339-6333

CL 2862
FIRST FLOOR PLAN

SCALE:
AS NOTED

DATE:
APRIL 2019

PLAN:
CL 2862

LOT NO:

SHEET NO:

4

