
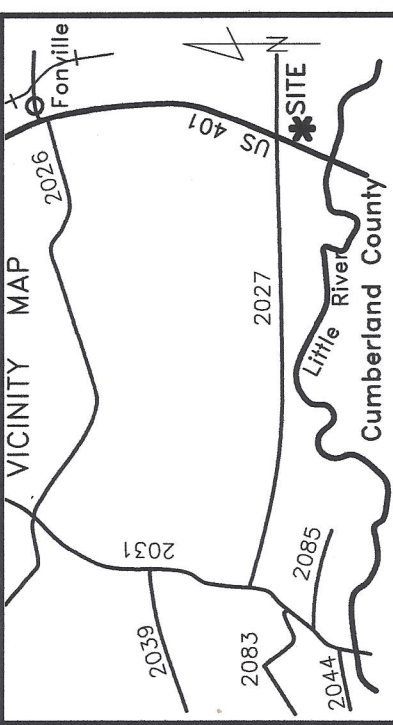


Note:
 Foundation Location based upon nails set in concrete footing for brick masons on May 13th, 2023. As-built dimensions of foundation confirmed on this date.

- LEGEND:**
- Subject Boundary Line
 - Adjoining Boundary Line
 - R/W Right-of-Way Line
 - C/L Centerline
 - Minimum Building Line
 - Survey tie lines
 - △ CP Calculated Point
 - ERB Existing Iron ReBar with Cap
 - ERBC Existing Iron ReBar Below/Above Grade
 - BG/AG Minimum Building Setback
 - MBS

FEMA FLOOD HAZARD STATEMENT
 The subject property shown on this plat is located within the FEMA "Zone X" (Minimal Flood Risk) Area as shown on FIRM Number: 3720056400K
 Effective date: 1/5/2007

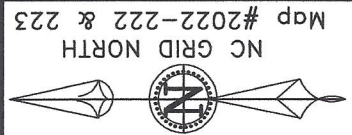

249 Rainy Beck Way., Erwin
 Lot 53, Williams Farm Subdivision
 Map #2022-222 & 223
 ~ Foundation Survey ~
Signature
Home Builders, Inc.

Stewart's Creek Twp. Harnett County
 Scale: 1" = 50' Date: 5/25/2023

Surveyed & Mapped By
STREAMLINE
LAND SURVEYING, Inc.
 NC FIRM C-1898
 870 NC 55 W, Coats, N.C. 27521
 Phone: 910-897-7715

I hereby certify that the foundation location shown hereon is correct in relation to property lines of record.
 NOTE: The purpose of this survey is to locate the newly constructed foundation.
 Other features, fixtures, encumbrances and indications of use may be revealed by a complete site survey.



NOT FOR RECORDATION