



**FRONT ELEVATION**  
1/4" = 1'-0"

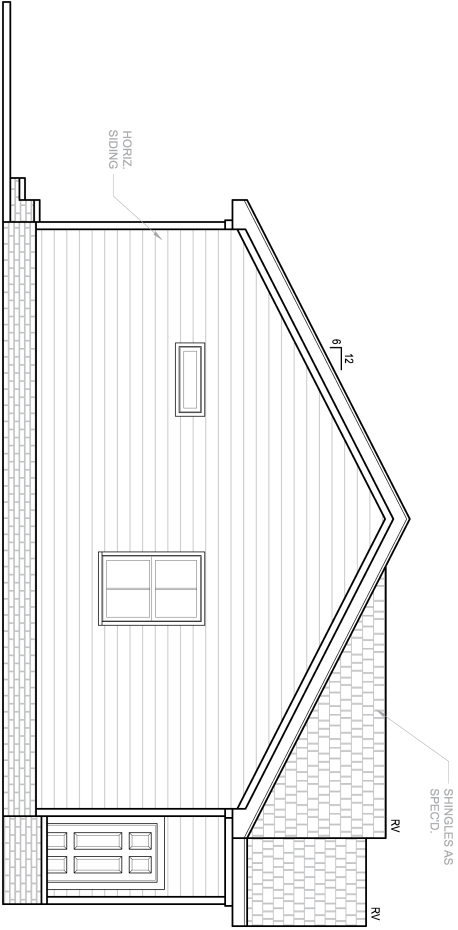

**LEFT ELEVATION**  
1/4" = 1'-0"

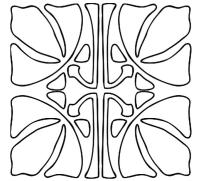


FAMILY BUILDING CO.




CIDER HOUSE STUDIO, INC.  
424 E. MAIN ST.  
CLAYTON, NC 27520  
919.624.4776




LOT 21 CHARTRES ST.

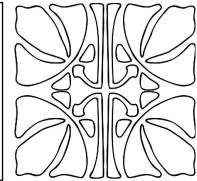


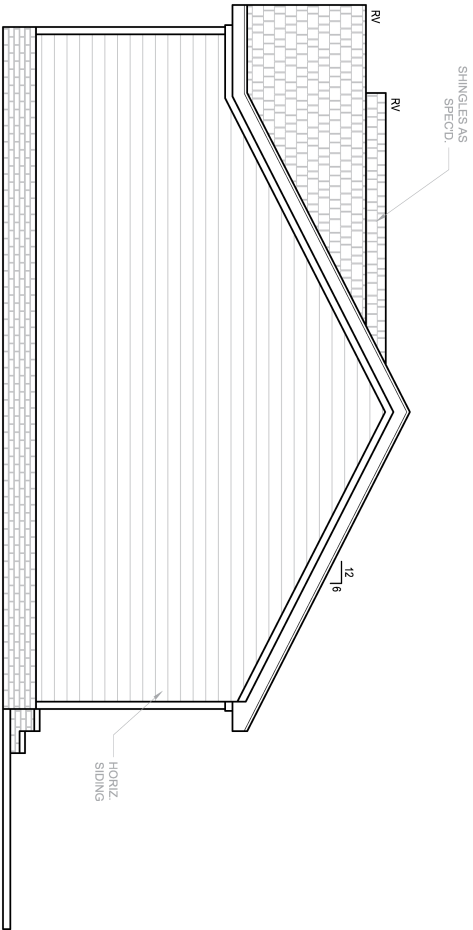

**RIGHT ELEVATION**  
 1/4" = 1'-0"

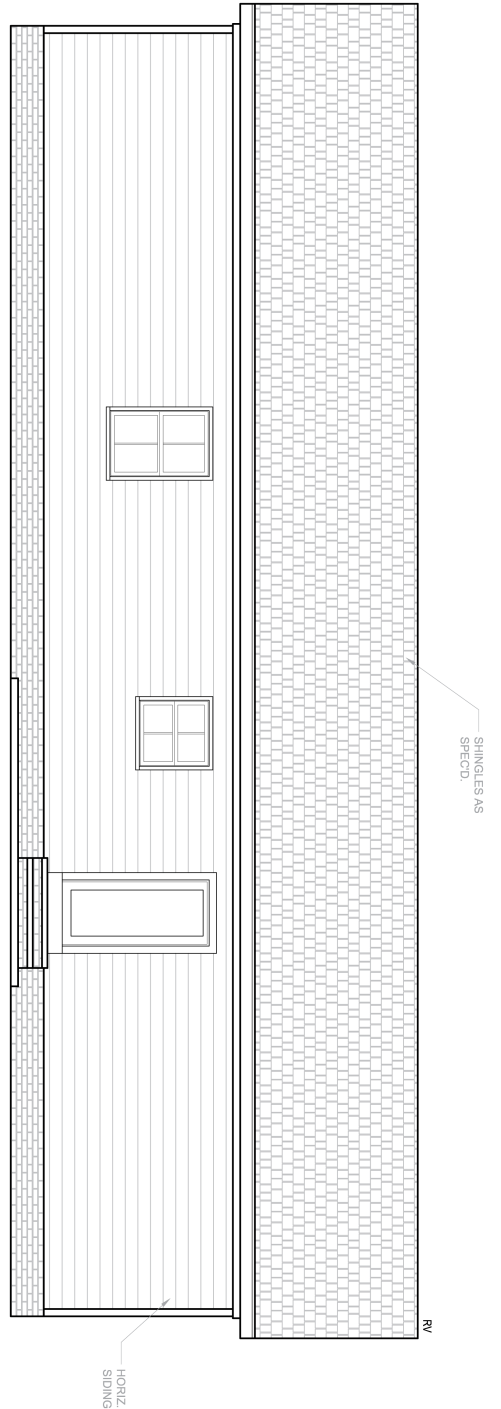

**REAR ELEVATION**  
 1/4" = 1'-0"

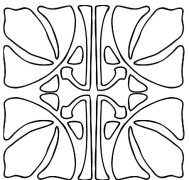


FAMILY BUILDING CO.




CIDER HOUSE STUDIO, INC.  
 424 E. MAIN ST.  
 CLAYTON, NC 27520  
 919.624.4776



LOT 21 CHARTRES ST.

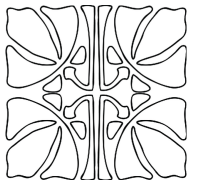




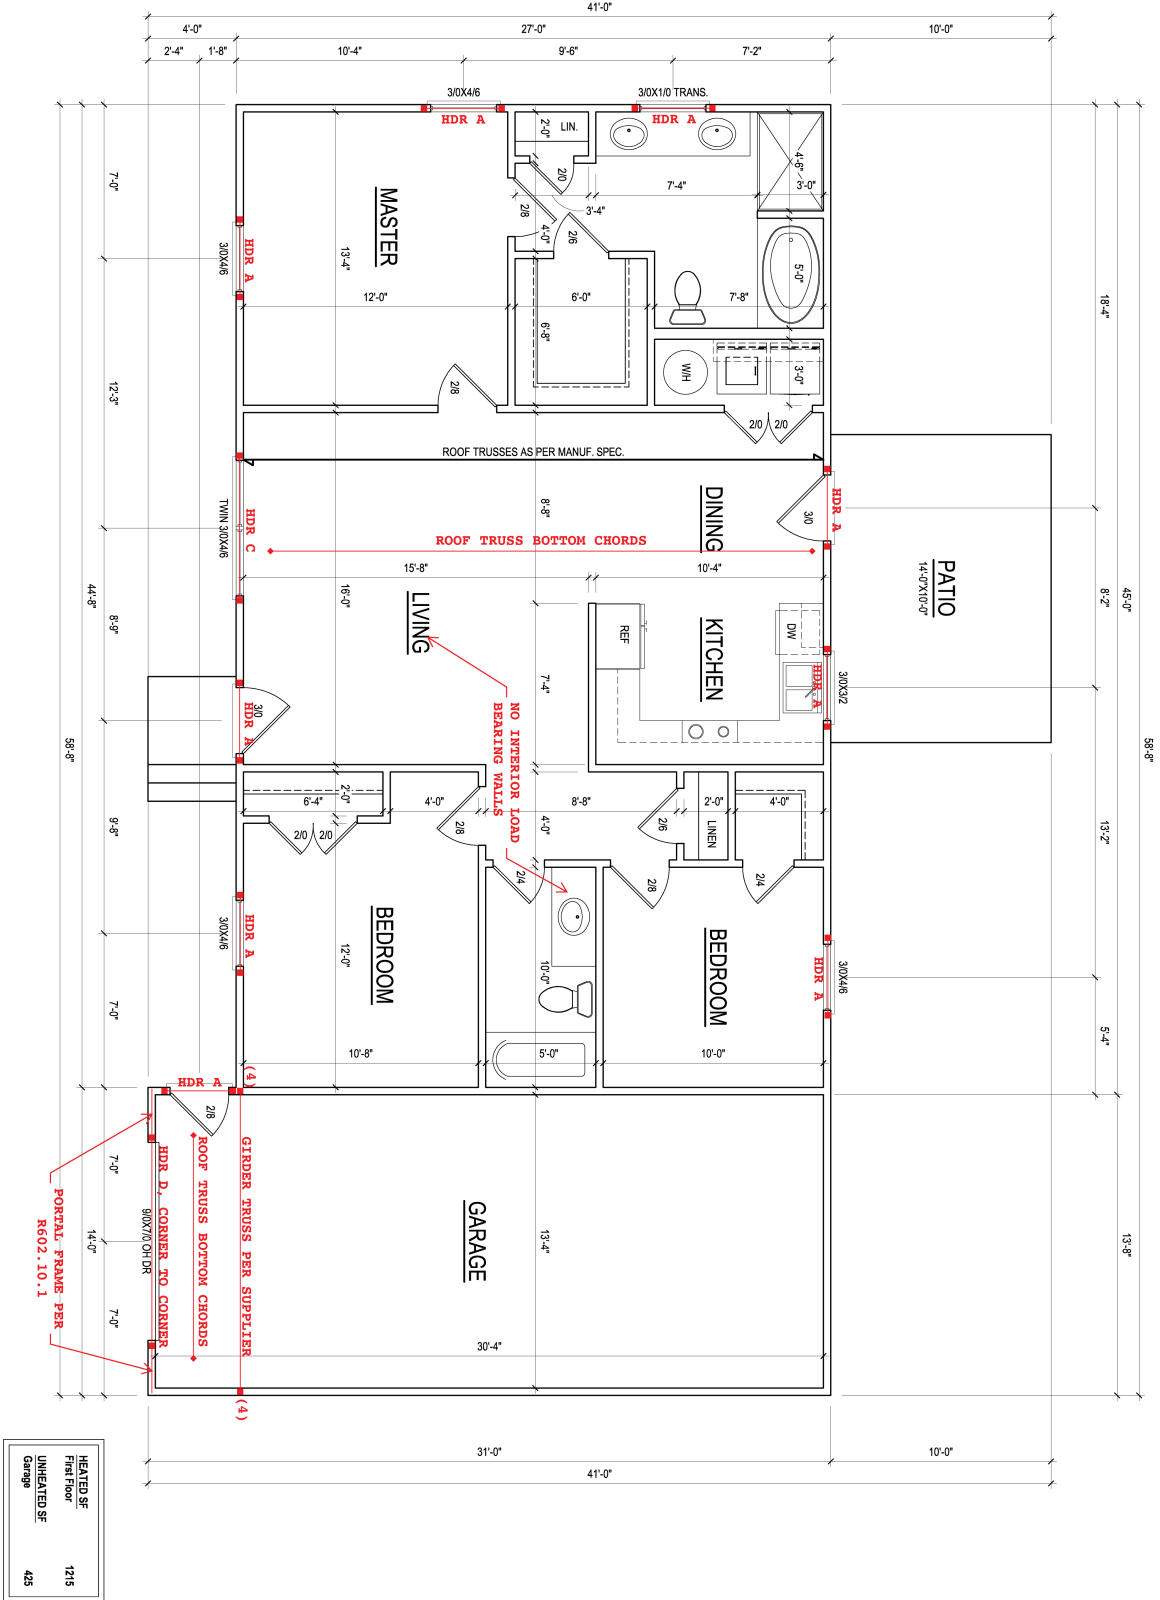

**FIRST FLOOR PLAN**  
 1/4" = 1'-0"  
 CEILING HGT. = 8'-0"

ALL LUMBER TO BE #2 SPF LINO  
 ALL WALLS TO BE 4" THICK

HEATED SF	1215
FIRST FLOOR	
UNHEATED SF	425
Garage	

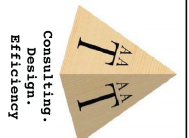

**A. A. Takla Engineering, PLLC**

718 Arnette Ave.  
 Durham, NC 27701

NC Firm License # P-1446

Andy A. Takla, PE  
 Andy@taklaengineering.com  
 NC PE# 313-423-0470  
 313-423-0470



PE SEAL APPLIES TO STRUCTURAL NOTES ONLY

**Chartres St. Lot 21**  
**Fuquay Varina, NC**  
**Family Building Co.**

Job Number:  
 0448-22

**S2**



Consulting.  
Design.  
Efficiency

**A. A. Takla  
Engineering, PLLC**

718 Arnette Ave.  
Durham, NC 27701

NC Firm License # P-1446

Andy A. Takla, PE  
AndyTakla@AATaklaEng.com  
NC PE License # 030695  
919-423-9470




PE SEAL APPLIES TO  
STRUCTURAL NOTES ONLY

**Chartres St. Lot 21  
Fuquay Varina, NC  
Family Building Co.**

**Job Number:  
0448-22**

**S3**

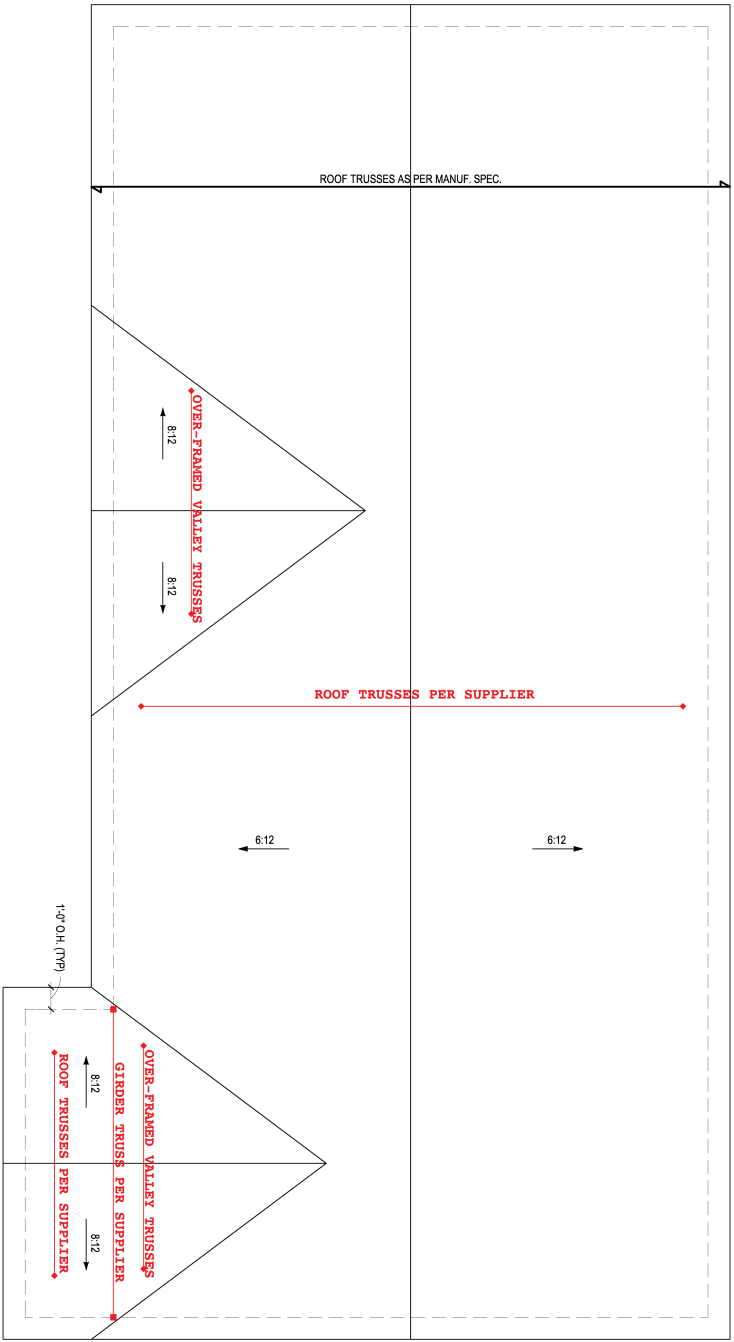

**ROOF PLAN**

1/4" = 1'-0"

ALL LUMBER TO BE #2 SPF UNO  
BUILDER MAY USE ROOF TRUSSES TRUSS DESIGN LAYOUT AND  
ENGINEERING TO BE PROVIDED BY TRUSS MANUFACTURER

- General Plan Reading Notes:**
- Engineer's notes are in red, blue or green ink for clarity and are in Courier Type font.
  - With regards to structural information, these notes shall take precedence over any other structural information.
  - Red check marks (✓), if present, indicate structural information which has been reviewed and approved by engineer.
  - Noted dimensions shall take precedence.

- General Construction Notes:**
- All temporary shoring, means and methods are the responsibility of the contractor.
  - All dimensions in the field.
  - Engineer assumes no responsibility for safety of project delivery.
  - Any questions pertaining to structural components should be immediately brought to the attention of engineer.
  - Limitations: Services provided are in accordance with the standard of practice for structural engineering and within the limits imposed by scope, schedule and budget.
  - Sequencing, shoring, means and methods of construction are considered beyond the scope of this design.

- Foundation Notes:**
- Assumed soil load bearing capacity = 2000 PSF
  - Minimum 28 day f'c of concrete = 3000 PSI
  - Foundations to be built in accordance with NCCRC 2018, CH 4
  - 16"-in s shall be (2) 16" long #4 epoxy bonded dowels half embedded mid-depth into existing footings. If no footing exists, omit tie-in
  - Install anchor bolts per R403.1.6.
  - All slabs shall be minimum 4" thick, 3000 psi concrete slab on 4" of #57 sub-base. If slab is used in an interior or garage application, install 6 mil vapor retarder and 10/10 6x6 welded wire fabric.
  - All slabs shall be on compacted fill or fill depth self consolidated structural fill (stone) (at porches, garages and stem wall slabs)
  - Max unreinforced, unbalanced condition of any CMU wall shall be 36"
  - Top course of all foundation walls and piers shall have solid caps. Any slab stem walls shall be filled solid.
  - All piers shall be in the middle 1/3rd of the footing. Min 2 footing projection at each side. Max projection shall be the depth of the footing.

- Lintel Schedule for Brick/Natural Stone Veneer**
- | Length (ft) | Size                 |
|-------------|----------------------|
| Up to 4     | L 3.5 X 3.5 X 1/2    |
| 4-8         | L 5 X 3.5 X 5/16 L1V |
| Over 8      | L 6 X 4X 5/16 L1V    |
- Notes:**
- Provide at least 3" bearing on brick at each end.
  - Headers 8" or longer, attach to header w/ 1/2" lag screws @ 12" o.c. staggered.
  - For all brick support & roof lines, fasten (2)2x10 blocking between studs w/ (4) 12d nails per ply. Fasten a 6"x4"x5/16" angle to (2)2x10 blocking w/ (2) 1/2" lag screws @ 12" o.c. staggered. See Section R703.8.2.1 (NCCRC 2018) for additional reference.

- Footings Schedule:**
- A = 16"x16"x8"  
 B = 20"x20"x8"  
 C = 24"x24"x10"  
 D = 30"x30"x12"  
 E = 36"x36"x12"  
 F = 40"x40"x12" w/ (3) #4 EW  
 G = 48"x48"x12" w/ (4) #4 EW
- \*All rebar in footings to have 3' cover from sides, bottoms and other parallel rebar.


- Header Schedule:**
- A = 2x6 w/ (1) Jack @ EE UON  
 B = 2x8 w/ (2) Jack @ EE UON  
 C = 2x10 w/ (2) Jack @ EE UON  
 D = 2x12 w/ (3) Jack @ EE UON  
 E = 9 1/4" LVL w/ (3) JS @ EE UON  
 F = 11 7/8" LVL w/ (3) JS @ EE UON
- \* Headers in 2x4 shall be 2 ply  
 \* Headers in 2x6 shall be 3 ply  
 \* Stud size shall match width of wall.

- King Stud Schedule:**
- 0'-3" wide = 1 @ EE UON  
 3'-6" wide = 2 @ EE UON  
 6'-9" wide = 3 @ EE UON
- \*Stud size shall match width of wall.

- Abbreviations:**
- CONC Concrete  
 CONTN Continuous  
 C.U.J. Calling Joists  
 CMU Conc Masonry Unit  
 CS-WSP Sheathing per R602.10.3  
 DIA Diameter  
 DBL Double  
 DJ / DR Double Joist / Rafter  
 EQ Equal  
 ES Each End  
 F3 Floor Joist  
 FND Foundation  
 FT Floor Truss  
 FTG Footing  
 GB Gypsum Board (shear wall)  
 GRT Glider  
 HDR Header  
 HD Holddowns  
 HB Load Bearing Wall  
 MANUF Manufacturer  
 MNS Not To Scale  
 O.C. On Center  
 O-F Over-framed (roof)  
 PP Portal Frame  
 PL Point Load  
 P-T Pressure Treated  
 R.T. Roof Truss  
 SC Stud  
 SIM Stair  
 SGR S-saggered  
 SUP Supplier  
 TYP Typical  
 UON Unless Otherwise Noted



- Lateral Bracing:**
1. Unless otherwise noted, lateral bracing is found sufficient and compliant with minimum requirements set forth in NCCRC 2018 Table R602.10.2 provided all exterior walls are sheathed at the exterior per CS-WSP, R602.10.3 which includes 2x4 (min) studs at 16" o.c. sheathed with 7/16" OSB w/ (1)8d nail at 6" o.c. edge and (1)8d nail at 12" o.c. field. Any additional requirements will be specifically dictated on the plans by indicating required length of CS-WSP at each designated braced wall lines.
- All girted Portal Frame (P-F) shall be compliant with R602.10.1. Core reference can be found on this page.
  - All locations noted with "800# HB" shall be 800 lbs min capacity. Many specific holddowns are available, builder may select a model that fits the geometry of the application. Builder also install CS6 straps fully populated with 10d nails extending no less than 12" above and below the interface intended to hold down; Most commonly this is at the bottom of studs; strap should be centered on the bottom plate and extend to the hand below; Builder may install straps on either exterior or interior face of wall.
  - Walls noted as GB shall be framed in accordance with R602.10.2

- Framing Notes:**
- Floor joists, ceiling joists and rafters sized for SFR #2 or better except exterior wood deck joists. Wall Framing maybe SFR #2 or SFR #2.
  - (X) = Number of 2x4/2x6 studs supporting beams. Size of studs to match stud schedule in remainder of wall UONO. Strap all stud columns of 4 or more with (3) horiz. CS22 straps.
  - LVL Beams shall be 1.75" wide per ply; (FP) = 2600 psi.
  - All floor framing per NCCRC 2018 CH 5.
  - All wall framing per NCCRC 2018 CH 6.
  - If applicable I-joists and floor truss framing per supplier's specifications and layout.
  - If applicable, all structural steel shall be ASTM A-36; Fy= 36 KSI. All weld material shall be 70 KSI material.
  - All welds to be installed by a certified AWS welder.
  - All side loaded steel beams should be packed out with dbl 2x material and bolted thru to web with 1/2" dia thru bolts at 24" o.c. staggered.
  - Install double joist under all walls parallel with joists. Typically, interior load bearing walls (LBB) are shown hatched in red. Neatly girders and beams should be assumed to be directly supporting these DBMS.
  - Beams of 3 ply or more with any side loaded members shall be fastened with 1/2" dia bolts at 16" o.c. staggered w/ 2" min edge distance from top/bottom edge UON. 2 ply LVBs shall be fastened with (4) #9 3" wood screws at 16" o.c. All beam bearings shall be no less than 3". All other bearing to be 2" min.
  - All hangers shall be standard, appropriately sized face mounted UON. High capacity hangers will be load rated on plans; Consult Simpson catalog or local supplier. Install hardware per manufacturer guidelines.

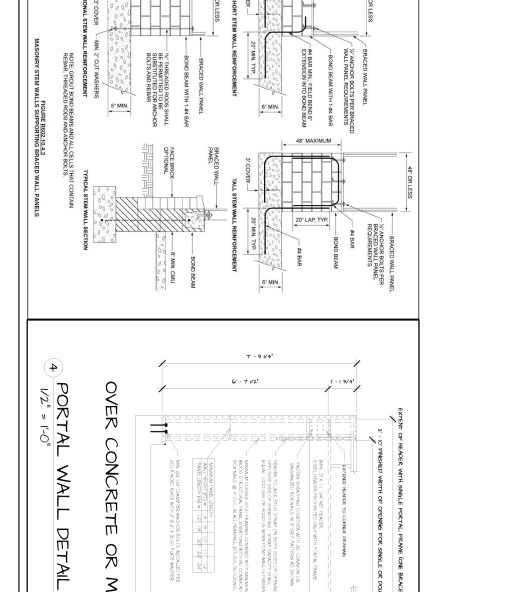

- POUR AND DECK SPECIFIC**
- Foundation Notes:**
- 2000 PSF soil load bearing capacity
  - Minimum 28 day f'c of concrete = 3000 PSI
  - Foundations to be built in accordance with NCCRC 2018, CH 4
- Wood Deck Notes:**
- All lumber to be pressure treated SYP No.2 or better.
  - Band attachments to be installed per NCCRC 2018, Appendix M (AM 104.1(1)) OR 1/2" x 3" Ledgerlocks @ spacing noted on plans.
  - Install lateral bracing or embed interior handrails per AM11.1
  - Max Post Headings per AM 108.1
  - Stair Stringers per AM 110.1
  - Footings that do not directly support roof posts may be solid-precast concrete or CMU provided size complies with plans and is embedded at least 12" into roof structure shall be cast in place.

- Screened-In/Covered Porch Notes:**
- Posts to be attached to footings, slab or CMU piers using AN14 or Abutle post base (or applicable size) OR (2) Simpson Gal clips OR Simpson all fasteners to headers w/ #2 clips
  - Uplift for posts to headers, posts to bands and bands to lower posts may be either (2) Simpson ICF4, (2) Simpson Gal clips or (2) 1/2" diameter, 5" long Ledgerlocks
  - Each side of posts shall be provided 5/8" width w/ (2) 1/2" diameter thru or lag bolts
- Roof Framing Notes:**
- All roof framing shall be in accordance with NCCRC 2018, CH 9 or better.
  - All lumber to be SFR OR SFR No.2 or better.
  - Sheath with 7/16" OSB w/ #4 nails at 6" o.c. edge and 12" o.c. field. Collar ties may be omitted with either 2x4" long CS22 ridge strapping or (2) L10 clips at 32"
  - Where no structural ridge is provided, install 2x4 rafter ties spaced at 32" o.c. at bottom 1/3rd of rafters, attach w/ (4) 10 @ ER

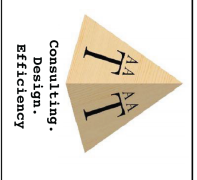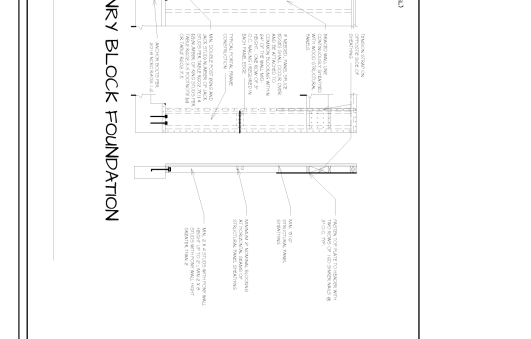

**A. A. Takla Engineering, PLLC**

718 Arnette Ave.  
 Durham, NC 27701

NC Firm License # P-1446

Andy A. Takla, PE  
 andy@aatakla.com  
 NC PE License # 050695  
 919-453-0470



PE SEAL APPLIES TO STRUCTURAL NOTES ONLY

Chartres St. Lot 21  
 Fuquay Varina, NC  
 Family Building Co.

Job Number:  
 0448-22

STRUCTURAL NOTES PAGE