

434

435


436



ROSLYN WAY  
PRIVATE R/W


*Charlie T. Carpenter*  
7/6/23

THIS IS AN AS-BUILT  
SURVEY ONLY. THIS  
SURVEY IS NOT FOR  
THE CONVEYANCE OF  
PROPERTY AND DOES  
NOT NECESSARILY  
MEET G.S. 47-30  
AS AMENDED NOR  
WAS IT INTENDED TO.

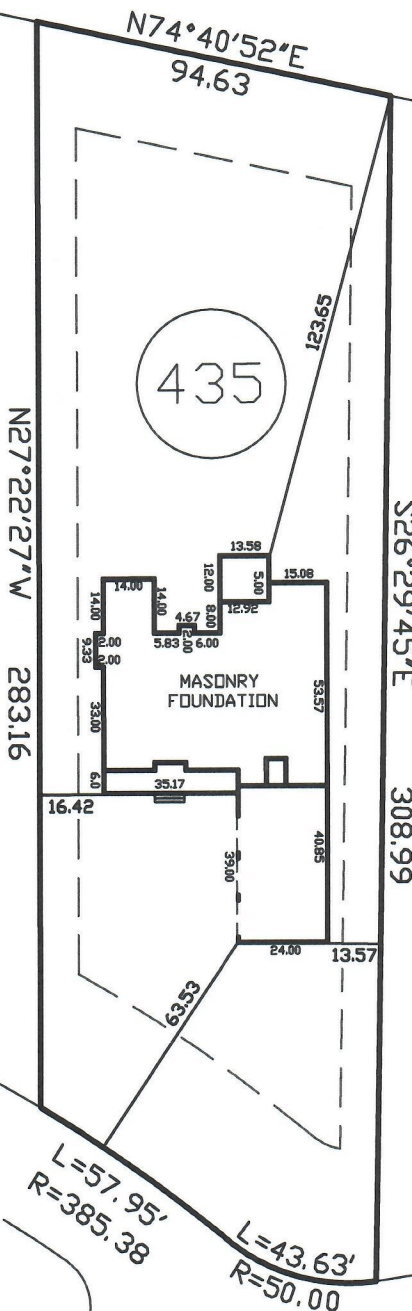

BARONS RUN  
PRIVATE R/W

Charlie T. Carpenter, P.L.S.  
Professional Land Surveyor

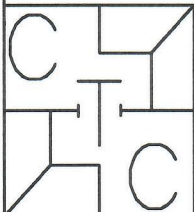

1940 Juniper Church Road  
Four Oaks, NC 27524  
(919) 320-5281  
plschuck30@yahoo.com

FOUNDATION SURVEY FOR:

RED ROCK BUILDERS

PIN 0506-61-8137.000  
PARCEL ID 01053510 0100 07  
LOT 435 ANDERSON CREEK CLUB S/D  
PB2004 PG1138  
6/9/23  
1"=50'

75 ROSLYN WAY  
SPRING LAKE, NC 28390