NOTICE TO CONTRACTOR **APPROVED** 05/18/2023

NUIE:

MONO SLAB - STONE TO RUN TO THE BOTTOM OF WINDOW STEM WALL - STONE TO FOUNDATION HEIGHT ONLY

# PLANS DESIGNED TO THE **2018 NORTH CAROLINA STATE RESIDENTIAL BUILDING CODE**

MEAN ROOF HEIGHT 25'-8	"	HEIGHT TO	RIDGE 30'-0"
CLIMATE ZONE	ZONE 3A	ZONE 4A	ZONE 5A
FENESTRATION U-FACTOR	0.35	0.35	0.35
SKYLIGHT U-FACTOR	0.55	0.55	0.55
GLAZED FENESTRATION SHGC	0.30	0.30	0.30
CEILING R-VALUE	38 or 30ci	38 or 30ci	38 or 30ci
WALL R-VALUE	15	15	19
FLOOR R-VALUE	19	19	30
* BASEMENT WALL R-VALUE	5/13	10/15	10/15
** SLAB R-VALUE	0	10	10
* CRAWL SPACE WALL R-VALUE	5/13	10/15	10/19
* "10/13" MEANS R-10 SHEATHING INS	ULATION OR R-13 C	AVITY INSULATION	

\*\* INSULATION DEPTH WITH MONOLITHIC SLAB 24" OR FROM INSPECTION GAP TO BOTTOM OF FOOTING; INSULATION DEPTH WITH STEM WALL SLAB 24" OR TO BOTTOM OF FOUNDATION WALL

DESIGNED FOR WIND SPEED OF 120 MPH, 3 SECOND GUST (93 FASTEST MILE) EXPOSURE "B"								RE "B"	
	COMPONENT	& CLA	DDING	DESIG	NED FO	R THE	FOLLO	WING	LOADS
	MEAN ROOF	UP T	O 30'	30'-1"	TO 35'	35'-1"	TO 40'	40'-1"	TO 45'
	ZONE 1	14.2	-15.0	14.9	-15.8	15.5	-16.4	15.9	-16.8
	ZONE 2	14.2	-18.0	14.9	-18.9	15.5	-19.6	15.9	-20.2
	ZONE 3	14.2	-18.0	14.9	-18.9	15.5	-19.6	15.9	-20.2
	ZONE 4	15.5	-16.0	16.3	-16.8	16.9	17.4	17.4	-17.9
	7∩NF 5	15.5	-20 N	16.3	-21 N	16.9	-21.8	17 4	-22 4

DESIGNED FOR WIN	D SPEED	OF 130 MF	PH, 3 SECO	ond Gust	(101 FAS	TEST MILE	E) EXPOSU	IRE "B"
COMPONENT	& CLA	DDING	DESIG	NED FO	R THE	<b>FOLLO</b>	WING I	LOADS
MEAN ROOF	UP T	O 30'	30'-1"	TO 35'	35'-1"	TO 40'	40'-1"	TO 45'
ZONE 1	16.7	-18.0	17.5	-18.9	18.2	-19.6	18.7	-20.2
ZONE 2	16.7	-21.0	17.5	-22.1	18.2	-22.9	18.7	-23.5
ZONE 3	16.7	-21.0	17.5	-22.1	18.2	-22.9	18.7	-23.5
ZONE 4	18.2	-19.0	19.1	-20.0	19.8	-20.7	20.4	-21.3
ZONE 5	18.2	-24.0	19.1	-25.2	19.8	-26.2	20.4	-26.9

# **AIR LEAKAGE**

# Section N1102.4

N1102.4.1 Building thermal envelope. The building thermal envelope shall be durably sealed with an air barrier system to limit infiltration. The sealing methods between dissimilar materials shall allow for differential expansion and contraction. For all homes, where present, the following shall be caulked, gasketed, weather stripped or otherwise sealed with an air barrier material or solid material consistent with Appendix E-2.4 of this code: 1. Blocking and sealing floor/ceiling systems and under knee walls

open to unconditioned or exterior space. 2. Capping and sealing shafts or chases, including flue shafts.

3. Capping and sealing soffit or dropped ceiling areas.

# **ROOF VENTILATION**

**R806.1 Ventilation required.** Enclosed *attics* and enclosed rafter spaces formed where ceilings are applied directly to the underside of roof rafters shall have cross ventilation for each separate space by ventilating openings protected against the entrance of rain or snow. Ventilation openings shall have a least dimension of 1/16 inch (1.6 mm) minimum and 1/4 inch (6.4 mm) maximum. Ventilation openings having a least dimension larger than 1/4 inch (6.4 mm) shall be provided with corrosion-resistant wire cloth screening, hardware cloth, or similar material with openings having a least dimension of 1/16 inch (1.6 mm) minimum and 1/4 inch (6.4 mm) maximum. Openings in roof framing members shall conform to the requirements of Section R802.7.

**R806.2 Minimum area.** The total net free ventilating area shall not be less than 1/150 of the area of the space ventilated except that reduction of the total area to 1/300 is permitted provided that at least 50 percent and not more than 80 percent of the required ventilating area is provided by ventilators located in the upper portion of the space to be ventilated at least 3 feet (914 mm) above the eave or cornice vents with the balance of the required ventilation provided by eave or cornice vents. As an alternative, the net free cross-ventilation area may be reduced to 1/300 when a Class I or II vapor retarder is installed on the warm-in-winter side of the ceiling. Exceptions:

1. Enclosed attic/rafter spaces requiring less than 1 square foot (0.0929 m2) of ventilation may be vented with continuous soffit ventilation only. 2. Enclosed attic/rafter spaces over unconditioned space may be vented with continuous soffit vent only.

SQUARE FOOTAGE OF ROOF TO BE VENTED = 1558 SQ.FT. NET FREE CROSS VENTILATION NEEDED:

WITHOUT 50% TO 80% OF VENTING 3'-0" ABOVE EAVE = 10.39 SQ.FT. WITH 50% TO 80% OF VENTING 3'-0" ABOVE EAVE; OR WITH CLASS I OR II VAPOR RETARDER ON WARM-IN-WINTER SIDE OF CEILING = 5.16 SQ.FT.

# **GUARD RAIL NOTES**

R312.1 Where required. Guards shall be located along open-sided walking surfaces, including stairs, ramps and landings, that are located more than 30 inches (762 mm) measured vertically to the floor or *grade* below at any point within 36 inches (914 mm) horizontally to the edge of the open side. Insect screening shall not be considered as a *guard*.


**R312.2 Height.** Required *guards* at open-sided walking surfaces, including stairs, porches, balconies or landings, shall be not less than 36 inches (914 mm) high measured vertically above the adjacent walking surface, adjacent fixed seating or the line connecting the leading edges of the treads.

# Exceptions:

- 1. Guards on the open sides of stairs shall have a height not less than 34 inches (864 mm) measured vertically from a line connecting the leading edges of the treads.
- 2. Where the top of the *guard* also serves as a handrail on the open sides of stairs, the top of the *guard* shall not be not less than 34 inches (864 mm) and not more than 38 inches (965 mm) measured vertically from a line connecting the leading edges of the treads.
- walking surface to the required *quard* height which allow passage of a sphere 4 inches (102 mm)in diameter. Exceptions: 1. The triangular openings at the open side of a stair, formed by the riser, tread

**R312.3 Opening limitations.** Required *guards* shall not have openings from the


- and bottom rail of a *guard*, shall not allow passage of a sphere 6 inches (153 mm) in diameter. 2. *Guards* on the open sides of stairs shall not have openings which allow
- passage of a sphere 4 3/8 inches (111 mm) in diameter.

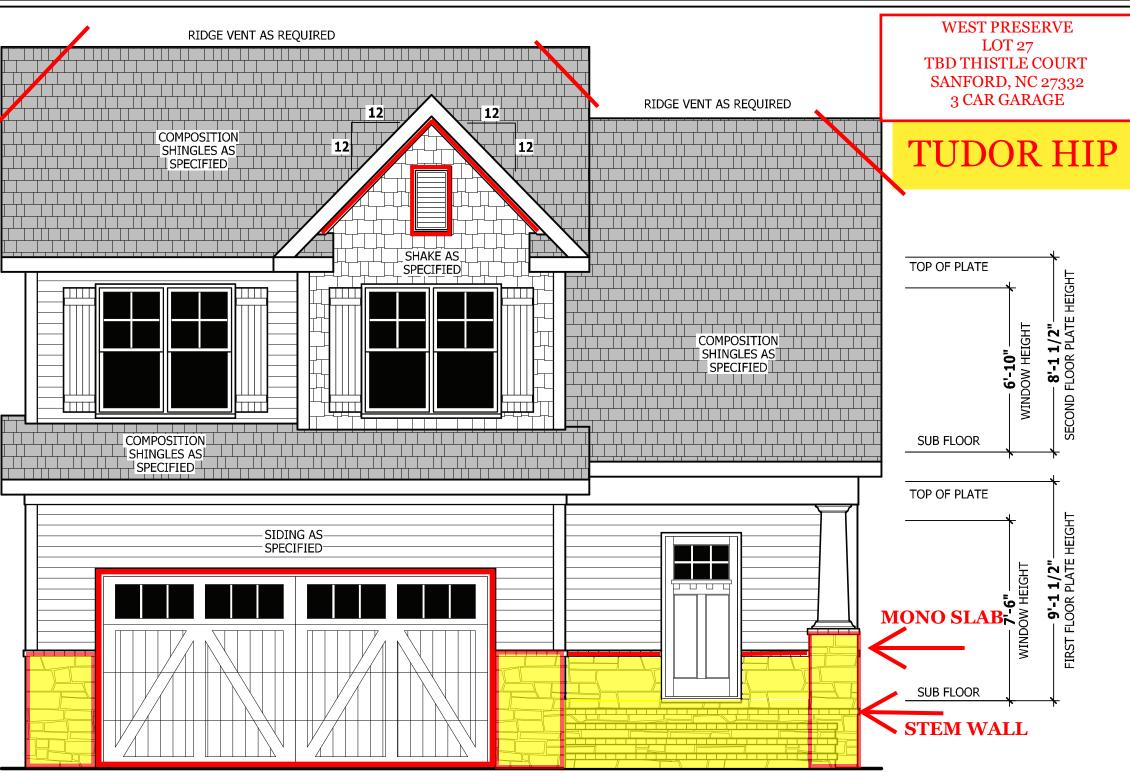

# **FRONT ELEVATION**

**PARGE** 

RAIL AS NEEDED

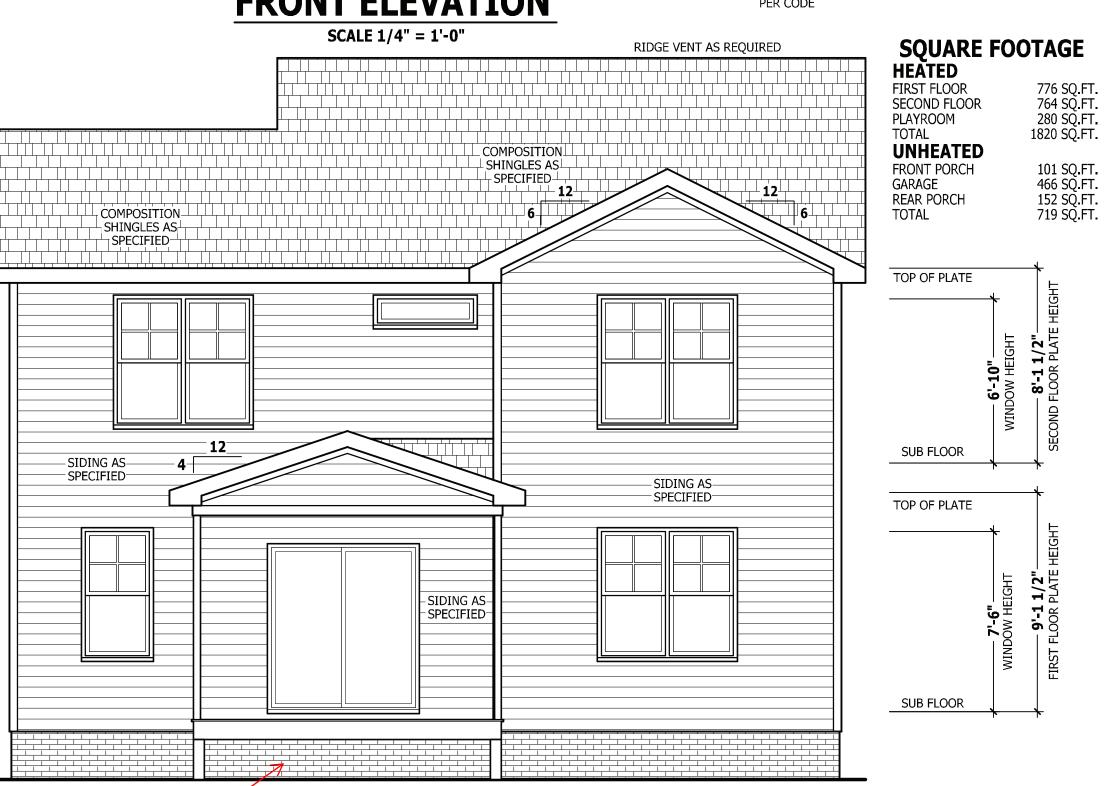

SCALE 1/4" = 1'-0"

PURCHASER MUST VERIFY ALL EFORE CONSTRUCTION BEGINS HAYNES HOME PLANS, INC. ASSUMES NO LIABILITY FOR CONTRACTORS PRACTICES AND

CODES AND CONDITIONS MAY DESIGNER ARCHITECT OR GINEER SHÓULD BE CONSULTED

BEFORE CONSTRUCTION. THESE DRAWING ARE NSTRUMENTS OF SERVICE AND

AS SUCH SHALL REMAIN PROPERTY OF THE DESIGNER

**ELEVATIONS** STON REAR GA 뿟 **∞ FRONT** 

SQUARE FOOTAGE HEATED

FIRST FLOOR SECOND FLOOR PLAYROOM TOTAL
UNHEATED
FRONT PORCH GARAGE REAR PORCH TOTAL

© Copyright 2016 Haynes Home Plans, Inc.

5/19/2020 181035B

**REAR ELEVATION** PAGE 1 OF 8

PURCHASER MUST VERIFY ALL DIMENSIONS AND CONDITIONS EFORE CONSTRUCTION BEGINS HAYNES HOME PLANS, INC. ASSUMES NO LIABILITY FOR CONTRACTORS PRACTICES AND

> CODES AND CONDITIONS MAY VARY WITH LOCATION. A LOCAL DESIGNER, ARCHITECT OR NGINEER SHOULD BE CONSULTED

BEFORE CONSTRUCTION. THESE DRAWING ARE INSTRUMENTS OF SERVICE AND AS SUCH SHALL REMAIN PROPERTY OF THE DESIGNER.

**ELEVATIONS** 

STON **RIGHT** GA 뿓 య LET

 SQUARE FOOTAGE

 HEATED
 776 SQ.FT.

 FIRST FLOOR
 764 SQ.FT.

 SECOND FLOOR
 764 SQ.FT.

 PLAYROOM
 280 SQ.FT.

 TOTAL
 1820 SQ.FT.

 UNHEATED
 FRONT PORCH

 FRONT PORCH
 101 SQ.FT.

 GARAGE
 466 SQ.FT.


 REAR PORCH
 152 SQ.FT.

 TOTAL
 719 SQ.FT.

© Copyright 2016
Haynes Home Plans, Inc.

5/19/2020 181035B

PAGE 2 OF 8

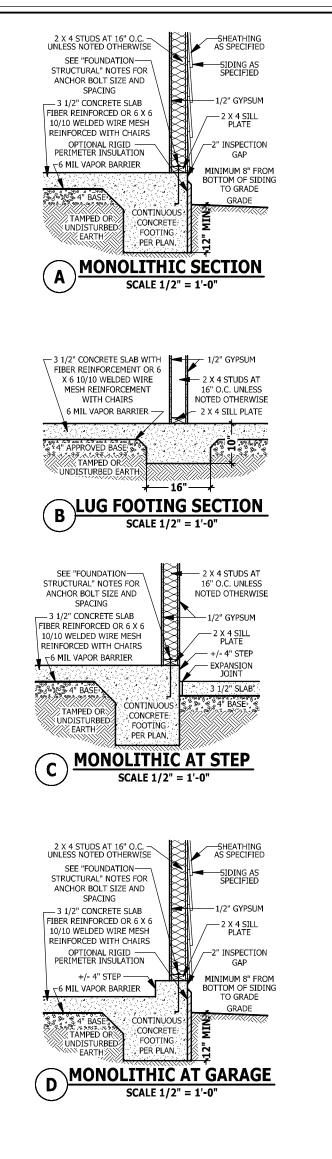

# **FOUNDATION STRUCTURAL**

115 to 130 mph wind zone (1 1/2 to 2 1/2 story) **CONTINUOUS FOOTING:** 16" wide and 8" thick minimum. 20" wide

minimum at brick veneer. Must extended 2" to either side of supported wall. **GIRDERS:** (3) 2 X 10 girder unless noted otherwise. PIERS: 16" X 16" piers with 8" solid masonry cap on 30" X 30" X 10"


concrete footing with maximum pier height of 64" with hollow masonry and 160" with solid masonry. **POINT LOADS:** designates significant point load and should have solid

blocking to pier, girder or foundation wall. **115 and 120 MPH ANCHORS BOLTS:** 1/2" diameter anchor bolts embedded minimum 7", maximum 6'-0" on center, within 12" of plate ends, and minimum two anchor bolts per plate.

**130 MPH ANCHORS BOLTS:** 1/2" diameter anchor bolts embedded minimum 15", maximum 4'-0" on center, within 12" of plate ends, and minimum two anchor bolts per plate.

**CONCRETE:** Concrete shall have a minimum 28 day strength of 3000 psi and a maximum 5" slump. Air entrained per table 402.2. All concrete shall be in accordance with ACI standards. All samples for pumping shall be taken from the exit end of the pump.

**SOILS:** Allowable soil bearing pressure assumed to be 2000 PSF. The contractor must contact a geotechnical engineer and a structural engineer if unsatisfactory subsurface conditions are encountered. The surface area adjacent to the foundation wall shall be provided with adequate drainage, and shall be graded so as to drain surface water away from foundation walls.

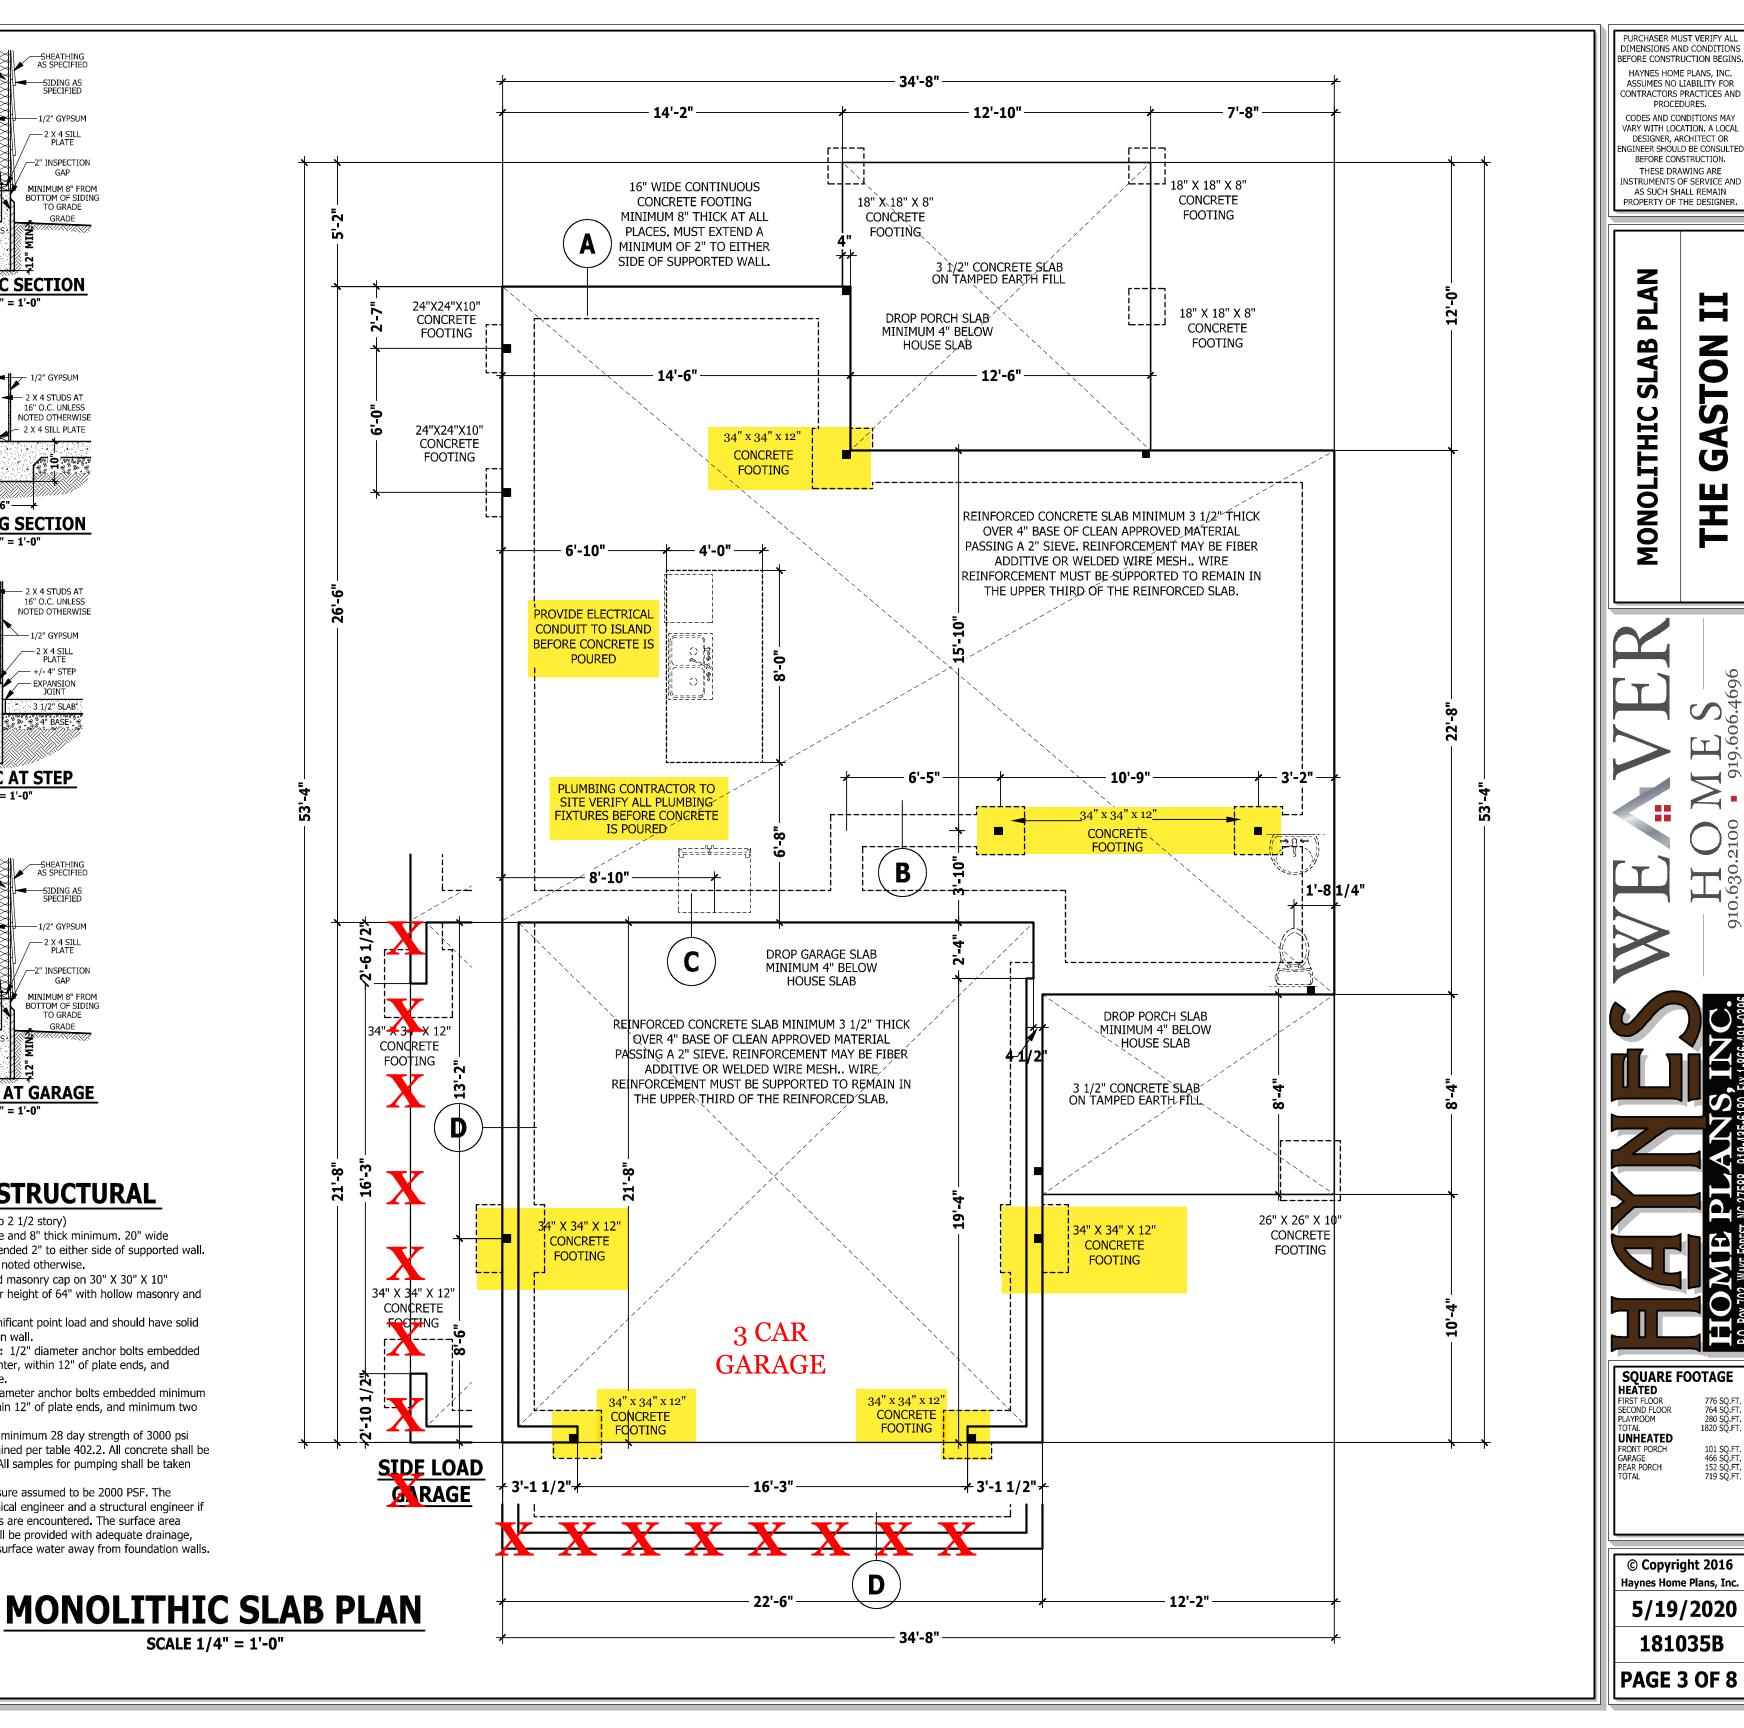

PURCHASER MUST VERIFY ALL EFORE CONSTRUCTION BEGINS HAYNES HOME PLANS, INC.

ASSUMES NO LIABILITY FOR CONTRACTORS PRACTICES AND

CODES AND CONDITIONS MAY VARY WITH LOCATION. A LOCAL DESIGNER, ARCHITECT OR NGINEER SHOULD BE CONSULTED

BEFORE CONSTRUCTION.

THESE DRAWING ARE

NSTRUMENTS OF SERVICE AND

PROPERTY OF THE DESIGNER

STON

5

**光** 

© Copyright 2016

Haynes Home Plans, Inc.

5/19/2020

181035B

4

SLA

ONOLITHIC

# **ATTIC ACCESS**

**R807.1 Attic access.** An attic access opening shall be provided to attic areas that exceed 400 square feet (37.16 m2) and have a vertical height of 60 inches (1524 mm) or greater. The net dear opening shall not be less than 20 inches by 30 inches (508 mm by 762 mm) and shall be located in a hallway or other readily accessible location. A 30-inch (762 mm) minimum unobstructed headroom in the attic space shall be provided at some point above the access opening. See Section M1305.1.3 for access requirements where mechanical equipment is located in attics

# **Exceptions:**

1. Concealed areas not located over the main structure including porches, areas behind knee walls, dormers, bay windows, etc. are not required to have access.

2. Pull down stair treads, stringers, handrails, and hardware may protrude into the net clear opening.

# **WALL THICKNESSES**

Exterior walls and walls adjacent to a garage area are drawn as 4" or as noted 2 X 6 are drawn as 6" to include 1/2" sheathing or gypsum. Subtract 1/2" for

**Interior walls** are drawn as 3 1/2" or as noted 2 X 6 are drawn as 5 1/2", and do not include gypsum.

# **DWELLING / GARAGE SEPARATION**

# **REFER TO SECTIONS R302.5, R302.6, AND R302.7**

exposed sides of all stairways.

**WALLS.** A minimum 1/2" gypsum board must be installed on all walls supporting floor/ceiling assemblies used for separation required by this section. **STAIRS.** A minimum of 1/2" gypsum board must be installed on the underside and

**CEILINGS.** A minimum of 1/2" gypsum must be installed on the garage ceiling if there are no habitable room above the garage. If there are habitable room above the garage a minimum of 5/8" type X gypsum board must be installed on the garage ceiling. **OPENING PENETRATIONS.** Openings between the garage and residence shall be equipped with solid wood doors not less than 1 3/8 inches (35 mm) in thickness, solid or honeycomb core steel doors not less than 1 3/8 inches (35 mm) thick, or 20-minute

**DUCT PENETRATIONS.** Ducts in the garage and ducts penetrating the walls or ceilings separating the *dwelling* from the garage shall be constructed of a minimum No. 26 gage (0.48 mm) sheet steel or other *approved* material and shall have no openings

**OTHER PENETRATIONS.** Penetrations through the separation required in Section R302.6 shall be protected as required by Section R302.11, Item 4.

# **EXTERIOR WINDOWS AND DOORS**

# **SECTION R612**

**R612.1 General.** This section prescribes performance and construction requirements for exterior windows and doors installed in walls. Windows and doors shall be installed and flashed in accordance with the fenestration manufacturer's written installation instructions. Window and door openings shall be flashed in accordance with Section R703.8. Written installation instructions shall be provided by the fenestration manufacturer for each window

**R612.2 Window sills.** In *dwelling* units, where the opening of an operable window is located more than 72 inches (1829 mm) above the finished *grade* or surface below, the lowest part of the clear opening of the window shall be a minimum of 24 inches (610 mm) above the finished floor of the room in which the window is located. Operable sections of windows shall not permit openings that allow passage of a 4 inch (102 mm) diameter sphere where such openings are located within 24 inches (610 mm) of the finished floor. Exceptions:

1. Windows whose openings will not allow a 4-inch diameter (102 mm) sphere to pass through the opening when the opening is in its largest opened position. 2. Openings that are provided with window fall prevention devices that comply with Section

3. Openings that are provided with fall prevention devices that comply with ASTM F 2090. 4. Windows that are provided with opening limiting devices that comply with Section R612.4. **R612.3 Window fall prevention devices.** Window fall prevention devices and window guards, where provided, shall comply with the requirements of ASTM F 2090.

# **SQUARE FOOTAGE** HEĂTED

GARAGE REAR PORCH


TOTAL

FIRST FLOOR SECOND FLOOR 764 SQ.FT. PLAYROOM 280 SQ.FT. 1820 SQ.FT. **UNHEATED** 101 SQ.FT. 466 SQ.FT. FRONT PORCH

152 SQ.FT.

719 SQ.FT.

FIRST FLOOR PLAN

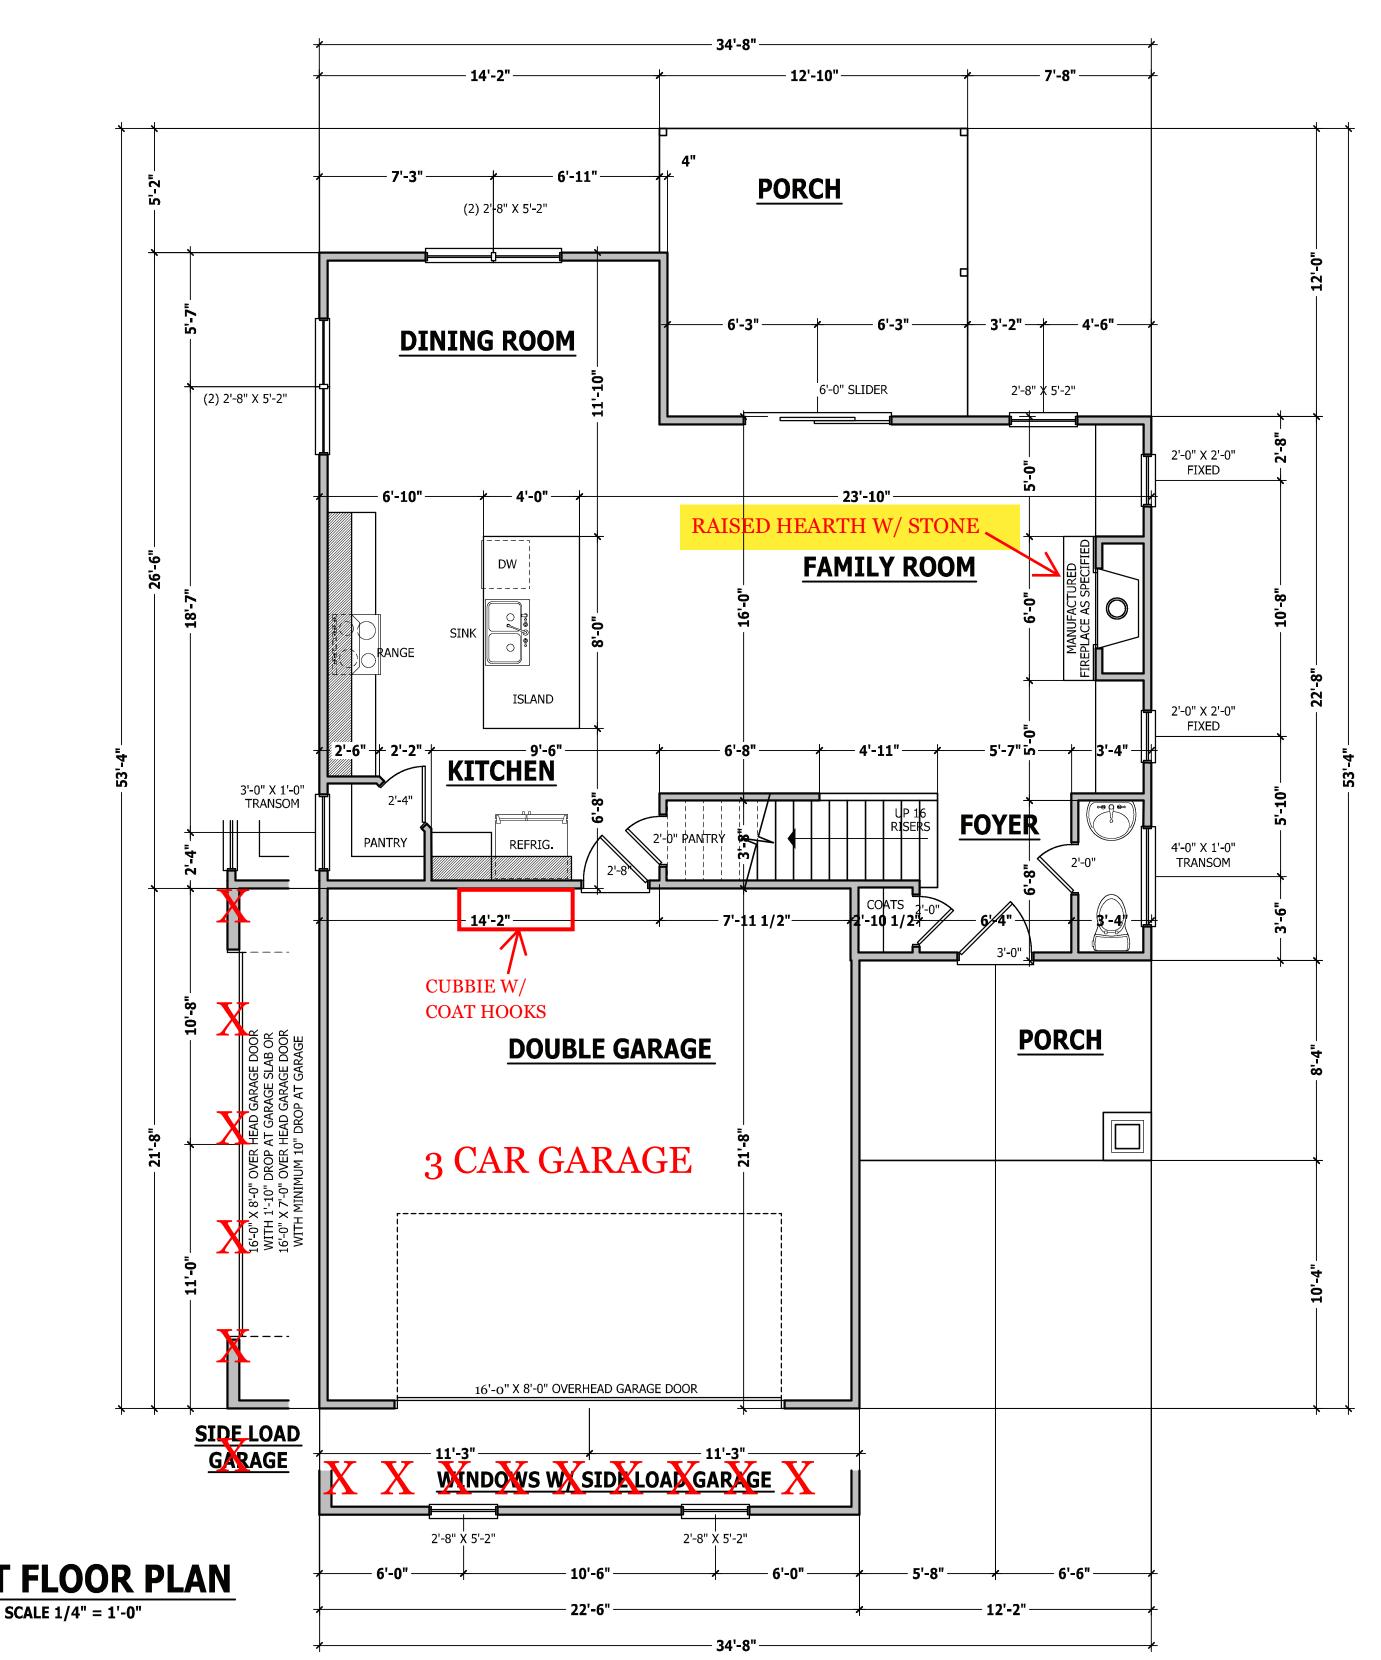

PURCHASER MUST VERIFY ALL EFORE CONSTRUCTION BEGINS HAYNES HOME PLANS, INC. ASSUMES NO LIABILITY FOR CONTRACTORS PRACTICES AND

CODES AND CONDITIONS MAY DESIGNER, ARCHITECT OR IGINEER SHOULD BE CONSULTED BEFORE CONSTRUCTION.

THESE DRAWING ARE NSTRUMENTS OF SERVICE AND AS SUCH SHALL REMAIN

PROPERTY OF THE DESIGNER.

**PLAN** STON FLOOR GA **FIRST** 뿐

 SQUARE FOOTAGE

 HEATED

 FIRST FLOOR
 776 SQ.FT

 SECOND FLOOR
 764 SQ.FT

 PLAYROOM
 280 SQ.FT

 TOTTAL
 1820 SQ.FT

 UNHEATED
 FRONT PORCH
 101 SQ.FT

 GABAGE
 466 SQ.FT

GARAGE REAR PORCH TOTAL

© Copyright 2016 Haynes Home Plans, Inc

5/19/2020 181035B

PAGE 4 OF 8

**JOB SITE PRACTICES AND SAFETY:** Haynes Home Plans, Inc. assumes no liability for contractors practices and procedures or safety program. Haynes Home Plans, Inc. takes no responsibility for the contractor's failure to carry out the construction work in accordance with the contract documents. All members shall be framed, anchored, and braced in accordance with good construction practice and the building code.

•	_		
DESIGN LOADS	LIVE LOAD	DEAD LOAD	DEFLECTION
USE	(PSF)	(PSF)	(LL)
Attics without storage	10		L/240
Attics with limited storage	20	10	L/360
Attics with fixed stairs	40	10	L/360
Balconies and decks	40	10	L/360
Fire escapes	40	10	L/360
Guardrails and handrails	200		
Guardrail in-fill components	50		
Passenger vehicle garages	50	10	L/360
Rooms other than sleeping	40	10	L/360
Sleeping rooms	30	10	L/360
Stairs	40		L/360
Snow	20		

**FRAMING LUMBER:** All non treated framing lumber shall be SPF #2 (Fb = 875 PSI) or SYP #2 (Fb = 750 PSI) and all treated lumber shall be SYP #2 (Fb = 750 PSI) unless noted other wise.

## **ENGINEERED WOOD BEAMS:**

Laminated veneer lumber (LVL) = Fb=2600 PSI, Fv=285 PSI, E=1.9x106 PSI Parallel strand lumber (PSL) = Fb=2900 PSI, Fv=290 PSI, E=2.0x106 PSI Laminated strand lumber (LSL) Fb=2250 PSI, Fv=400 PSI, E=1.55x106 PSI Install all connections per manufacturers instructions.

TRUSS AND I-JOIST MEMBERS: All roof truss and I-joist layouts shall be prepared in accordance with this document. Trusses and I-joists shall be installed according to the manufacture's specifications. Any change in truss or I-joist layout shall be coordinated with Haynes Homes Plans, Inc. LINTELS: Brick lintels shall be 3 1/2" x 3 1/2" x 1/4" steel angle for up to 6'-0" span. 6" x 4" x 5/16" steel angle with 6" leg vertical for spans up to 9'-0" unless noted otherwise. 3 1/2" x 3 1/2" x 1/4" steel angle with 1/2" bolts at 2'-0" on center for spans up to 18'-0" unless noted otherwise. FLOOR SHEATHING: OSB or CDX floor sheathing minimum 1/2" thick for 16" on center joist spacing, minimum 5/8" thick for 19.2" on center joist spacing, ROOF SHEATHING: OSB or CDX roof sheathing minimum 3/8" thick. CONCRETE AND SOILS: See foundation notes.

# **BRACE WALL PANEL NOTES**

**EXTERIOR WALLS:** All exterior walls to be sheathed with CS-WSP or CS-SFB in accordance with section R602.10.3 unless noted otherwise.

**GYPSUM:** All interior sides of exterior walls and both sides interior walls to have 1/2" gypsum installed. When not using method GB gypsum to be fastened per table R702.3.5. Method GB to be fastened per table R602.10.1.

**REQUIRED LENGTH OF BRACING:** Required brace wall length for each side of the circumscribed rectangle are interpolated per table R602.10.3. Methods CS-WSP and CS-SFB contribute their actual length. Method GB contributes 0.5 it's actual length. Method PF contributes 1.5 times its actual length. **HD:** 800 lbs hold down hold down device fastened to the edge of the brace wall panel closets to the corner.

# Methods Per Table R602.10.1

Z:\Builder\Weaver Development Company, Inc\200128B Gaston II\200128B

CS-WSP: Shall be minimum 3/8" OSB or CDX nailed at 6" on center at edges and 12" on center at intermediate supports with 6d common nails or 8d(2 1/2" long x 0.113" diameter).

CS-SFB: Shall be minimum 1/2" structural fiber board nailed at 3" on center at edges and 3" on center at intermediate supports with 1 1/2" long x 0.12" diameter galvanized roofing

**GB:** Interior walls show as GB are to have minimum 1/2" gypsum board on both sides of the wall fastened at 7" on center at edges and 7" on center at intermediate supports with minimum 5d cooler nails or #6 screws. **PF:** Portal fame per figure R602.10.1

# **ROOF TRUSS REQUIREMENTS**

TRUSS DESIGN. Trusses to be designed and engineered in accordance with these drawings. Any variation with these drawings must be brought to Haynes Home Plan, Inc. attention before construction begins.

KNEE WALL AND CEILING HEIGHTS. All finished knee wall heights and ceiling heights are shown furred down 10" from roof decking for insulation. If for any reason the truss manufacturer fails to meet or exceed designated heel heights, finished knee wall heights, or finished ceiling heights shown on these drawings the finished square footage may vary. Any discrepancy must be brought to Haynes Home Plans, Inc. attention, so a suitable solution can be reached before construction begins. Any variation due to these conditions not being met is the reasonability of the truss manufacturer.

**ANCHORAGE.** All required anchors for trusses due to uplift or bearing shall meet the requirements as specified on the truss schematics. **BEARING.** All trusses shall be designed for bearing on SPF #2 plates or ledgers unless noted otherwise.

**Plate Heights & Floor Systems.** See elevation page(s) for plate heights and floor system thicknesses.

# **EXTERIOR HEADERS**


- (2) 2 X 6 WITH 1 JACK STUD EACH END UNLESS NOTED OTHERWISE - KING STUDS EACH END PER TABLE BELOW

| HEADER SPAN | < 3' | 3'-4' | 4'-8' | 8'-12' | 12'-16' | KING STUD(S) | 1 | 2 | 3 | 5 | 6 |


# **INTERIOR HEADERS**

- LOAD BEARING HEADERS (2) 2 X 6 WITH 1 JACK STUD AND 1 KING STUD EACH END UNLESS NOTED OTHERWISE

- NON LOAD BEARING HEADERS TO BE LADDER FRAMED

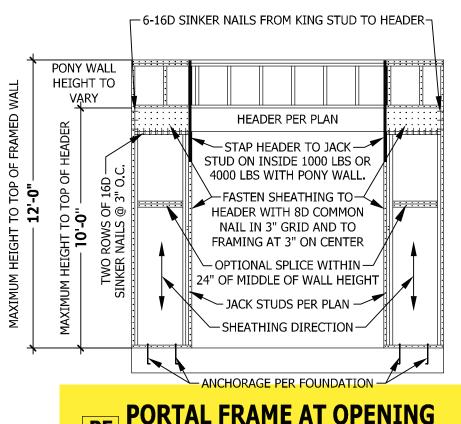

SCALE 1/4" = 1'-0"

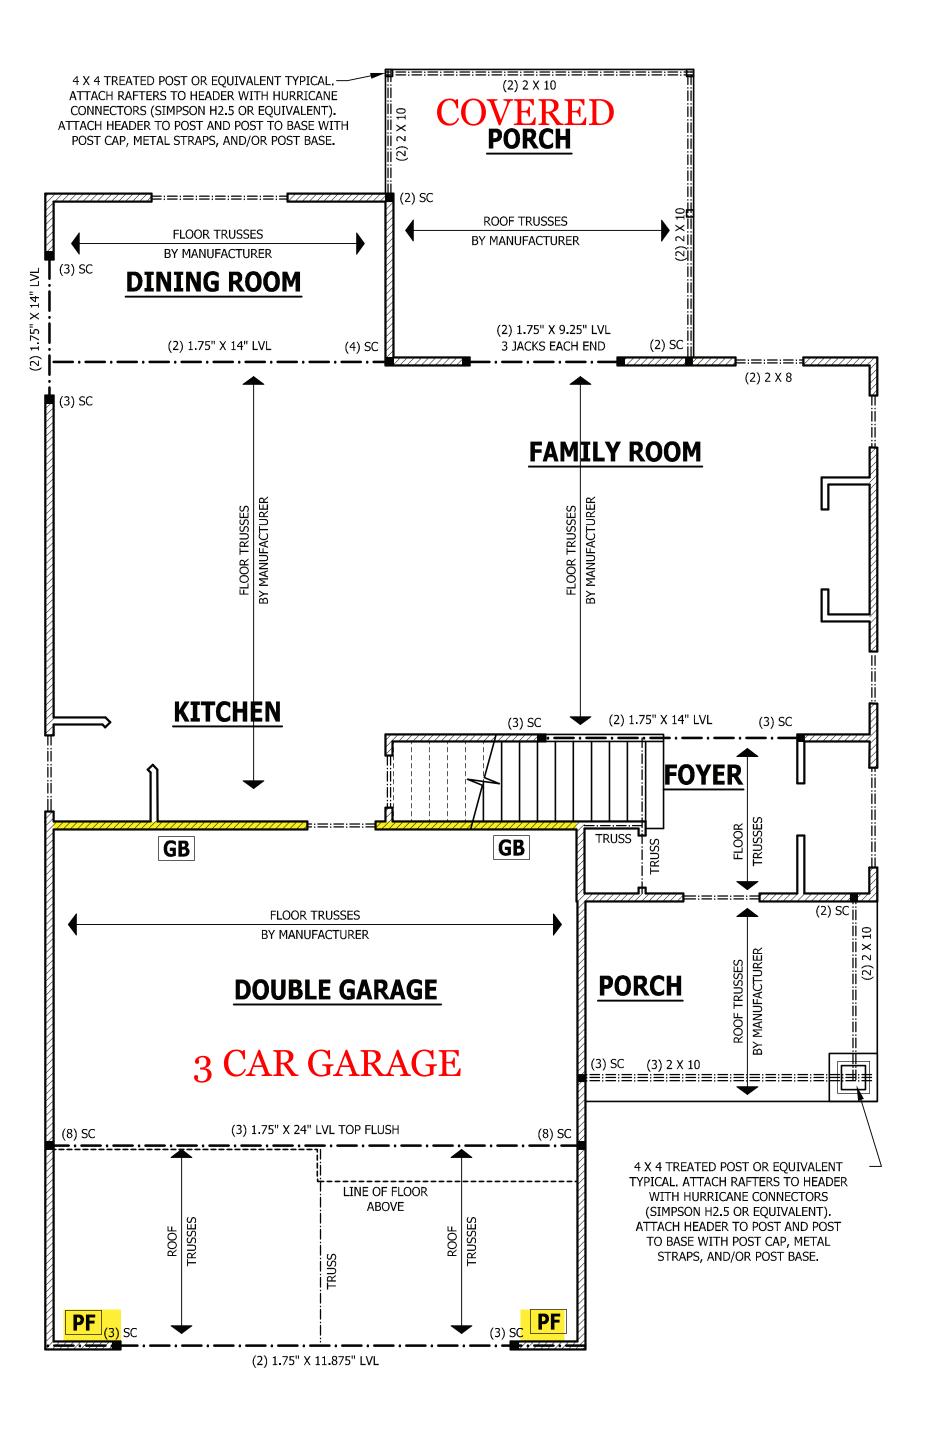

FIRST FLOOR STRUCTURAL

SCALE 1/4" = 1'-0"

PURCHASER MUST VERIFY ALL
DIMENSIONS AND CONDITIONS
BEFORE CONSTRUCTION BEGINS
HAYNES HOME PLANS, INC.
ASSUMES NO LIABILITY FOR
CONTRACTORS PRACTICES AND
PROCEDURES.

CODES AND CONDITIONS MAY VARY WITH LOCATION. A LOCAL DESIGNER, ARCHITECT OR ENGINEER SHOULD BE CONSULTED BEFORE CONSTRUCTION.

THESE DRAWING ARE
INSTRUMENTS OF SERVICE AND
AS SUCH SHALL REMAIN

INSTRUMENTS OF SERVICE AND
AS SUCH SHALL REMAIN
PROPERTY OF THE DESIGNER.

FIRST FLOOR STRUCTURAL
THE GASTON II

WE WE E

HOME S

910.630.2100 • 919.606.4696



 SQUARE FOOTAGE

 HEATED
 776 SQ.F

 FIRST FLOOR
 776 SQ.F

 SECOND FLOOR
 764 SQ.F

 PLAYROOM
 280 SQ.F

 TOTAL
 1820 SQ.F

 UNHEATED
 FRONT PORCH
 101 SQ.F

 GARAGE
 466 SQ.F

 REAR PORCH
 152 SQ.F

 TOTAL
 719 SQ.F

© Copyright 2016

5/19/2020

181035B

PAGE 5 OF 8

be construed to supersede the code. JOB SITE PRACTICES AND SAFETY: Haynes Home Plans, Inc. assumes no liability for contractors practices and procedures or safety program. Haynes Home Plans, Inc. takes no responsibility for the contractor's failure to carry out the construction work in accordance with the contract documents. All members shall be framed, anchored, and braced in accordance with good construction practice and the building code.

DESIG	SN L	OAD

•			
DESIGN LOADS	LIVE LOAD	DEAD LOAD	DEFLECTION
USE	(PSF)	(PSF)	(LL)
Attics without storage	10	10	L/240
Attics with limited storage	20	10	L/360
Attics with fixed stairs	40	10	L/360
Balconies and decks	40	10	L/360
Fire escapes	40	10	L/360
Guardrails and handrails	200		
Guardrail in-fill components	50		
Passenger vehicle garages	50	10	L/360
Rooms other than sleeping	40	10	L/360
Sleeping rooms	30	10	L/360
Stairs	40		L/360
Snow	20		

FRAMING LUMBER: All non treated framing lumber shall be SPF #2 (Fb = 875 PSI) or SYP #2 (Fb = 750 PSI) and all treated lumber shall be SYP #2 (Fb = 750 PSI) unless

Laminated veneer lumber (LVL) = Fb=2600 PSI, Fv=285 PSI, E=1.9x106 PSI Parallel strand lumber (PSL) = Fb=2900 PSI, Fv=290 PSI, E=2.0x106 PSI Laminated strand lumber (LSL) Fb=2250 PSI, Fv=400 PSI, E=1.55x106 PSI

Install all connections per manufacturers instructions.

layouts shall be prepared in accordance with this document. Trusses and I-joists shall be installed according to the manufacture's specifications. Any change in truss or I-joist layout shall be coordinated with Haynes Homes Plans, Inc. **LINTELS:** Brick lintels shall be 3 1/2" x 3 1/2" x 1/4" steel angle for up to 6'-0" span. 6" x 4" x 5/16" steel angle with 6" leg vertical for spans up to 9'-0" unless noted otherwise. 3 1/2" x 3 1/2" x 1/4" steel angle with 1/2" bolts at 2'-0" on center for spans up to 18'-0" unless noted otherwise.

FLOOR SHEATHING: OSB or CDX floor sheathing minimum 1/2" thick for 16" on center joist spacing, minimum 5/8" thick for 19.2" on center joist spacing, and minimum 3/4" thick for 24" on center joist spacing.

**CONCRETE AND SOILS:** See foundation notes.

# **ATTIC ACCESS**

**SECTION R612** 

# **SECTION R807**

**R807.1 Attic access.** An attic access opening shall be provided to attic areas that exceed 400 square feet (37.16 m2) and have a vertical height of 60 inches (1524 mm) or greater. The net clear opening shall not be less than 20 inches by 30 inches (508 mm by 762 mm) and shall be located in a hallway or other readily accessible location. A 30-inch (762 mm) minimum unobstructed headroom in the attic space shall be provided at some point above the access opening. See Section M1305.1.3 for access requirements where mechanical equipment is located in attics.

# **Exceptions:**

1. Concealed areas not located over the main structure including porches, areas behind knee walls, dormers, bay windows, etc. are not required to have access.

2. Pull down stair treads, stringers, handrails, and hardware may protrude into the net clear opening.

# **EXTERIOR HEADERS**

- (2) 2 X 6 WITH 1 JACK STUD EACH END **UNLESS NOTED OTHERWISE**
- KING STUDS EACH END PER TABLE BELOW HEADER SPAN < 3' 3'-4' 4'-8' 8'-12' 12'-16' KING STUD(S) 1 2 3 5 6

# **INTERIOR HEADERS**

- LOAD BEARING HEADERS (2) 2 X 6 WITH 1 JACK STUD AND 1 KING STUD EACH END
- **UNLESS NOTED OTHERWISE** - NON LOAD BEARING HEADERS TO BE LADDER FRAMED

# **ROOF TRUSS REQUIREMENTS**

TRUSS DESIGN. Trusses to be designed and engineered in accordance with these drawings. Any variation with these drawings must be brought to Haynes Home Plan, Inc. attention before construction begins. KNEE WALL AND CEILING HEIGHTS. All finished knee wall heights and ceiling heights are shown furred down 10" from roof decking for insulation. If for any reason the truss manufacturer fails to meet or exceed designated heel heights, finished knee wall heights, or finished ceiling heights shown on these drawings the finished square footage may vary. Any discrepancy must be brought to Haynes Home Plans, Inc. attention, so a suitable solution can be reached before construction begins. Any variation due to these conditions not being met is the reasonability of the truss manufacturer.

**ANCHORAGE.** All required anchors for trusses due to uplift or bearing shall meet the requirements as specified on the truss schematics. **BEARING.** All trusses shall be designed for bearing on SPF #2 plates or ledgers unless noted otherwise.

**Plate Heights & Floor Systems.** See elevation page(s) for plate heights and floor system thicknesses.

# WALL THICKNESSES

Exterior walls and walls adjacent to a garage area are drawn as 4" or as noted 2 X 6 are drawn as 6" to include 1/2" sheathing or gypsum. Subtract 1/2" for

Interior walls are drawn as 3 1/2" or as noted 2 X 6 are drawn as 5 1/2", and do not include gypsum.

**ON UPPER STORY PER** 

R602.10.3.2 (5) & (6)

# 2'-8" X 5'-2" TWIN **ROOF TRUSSES** Y MANUFACTURER MASTER BEDROOM 4'-0" X 1'-0" 2'-8" X 5'-2" TWIN TRANSOM (2) 2 X 10 (2)2 X 10 GIRDER TRUSS 2 JACKS EACH END 2 JACKS EACH END BY MANUFACTURER · 14'-2" 2'-4' **PLAY ROOM** W.I.C. 2 X 6 WALL 4'-0" X 1'-0" TRANSOM MASTER SET AT 7'-5" SHOWER **BATH HEADER HEIGHT** 2'-6" 4'-0" X 1'-0" RAIL OR HALF WALL LINEN TRANSOM SET AT 7'-5" **HEADER HEIGHT STORAGE** - HATCHED WALLS INDICATED LOAD 6'-6 1/2"-- 2'-6"<del>| |</del> 2'-4" <del>| | |</del> 3'-0" <del>- |</del> 5'-10" -BEARING AND EXTERIOR 2'-3 1/2" WALLS WHERE HEADERS MUST BE INSTALLED. BEDROOM #2 BEDROOM #3 ------**GIRDER TRUSS** BY MANUFACTURER -ROOF TRUSSES 2'-8" X 5'-2" TWIN 2'-8" X 5'-2" TWIN (2) 2 X 12 2 JACKS EACH END \_\_\_\_\_\_ **BRACING NOT SHOWN**

**SECOND FLOOR PLAN** 

**SCALE 1/4" = 1'-0"** 

· 11'-2" -

12'-2"

PURCHASER MUST VERIFY ALL EFORE CONSTRUCTION BEGINS HAYNES HOME PLANS, INC. ASSUMES NO LIABILITY FOR CONTRACTORS PRACTICES AND

CODES AND CONDITIONS MAY DESIGNER, ARCHITECT OR IGINEER SHOULD BE CONSULTED

BEFORE CONSTRUCTION. THESE DRAWING ARE NSTRUMENTS OF SERVICE AND AS SUCH SHALL REMAIN PROPERTY OF THE DESIGNER.

PLAN

STON FLOOR GA SECOND 뽀

SQUARE FOOTAGE HEATED FIRST FLOOR SECOND FLOOR TOTAL UNHEATED REAR PORCH TOTAL

© Copyright 2016

Haynes Home Plans, Inc 5/19/2020

181035B

PAGE 6 OF 8

# **EXTERIOR WINDOWS AND DOORS**

**R612.1 General.** This section prescribes performance and construction requirements for exterior windows and doors installed in walls. Windows and doors shall be installed and flashed in accordance with the fenestration manufacturer's written installation instructions. Window and door openings shall be flashed in accordance with Section R703.8. Written installation instructions shall be provided by the fenestration manufacturer for each window

**R612.2 Window sills.** In *dwelling* units, where the opening of an operable window is located more than 72 inches (1829 mm) above the finished *grade* or surface below, the lowest part of the clear opening of the window shall be a minimum of 24 inches (610 mm) above the finished floor of the room in which the window is located. Operable sections of windows shall not permit openings that allow passage of a 4 inch (102 mm) diameter sphere where such openings are located within 24 inches (610 mm) of the finished floor.

1. Windows whose openings will not allow a 4-inch diameter (102 mm) sphere to pass through the opening when the opening is in its largest opened position.


2. Openings that are provided with window fall prevention devices that comply with Section 3. Openings that are provided with fall prevention devices that comply with ASTM F 2090.

4. Windows that are provided with opening limiting devices that comply with Section R612.4. **R612.3 Window fall prevention devices.** Window fall prevention devices and window guards, where provided, shall comply with the requirements of ASTM F 2090.

noted other wise. **ENGINEERED WOOD BEAMS:** 

TRUSS AND I-JOIST MEMBERS: All roof truss and I-joist

ROOF SHEATHING: OSB or CDX roof sheathing minimum

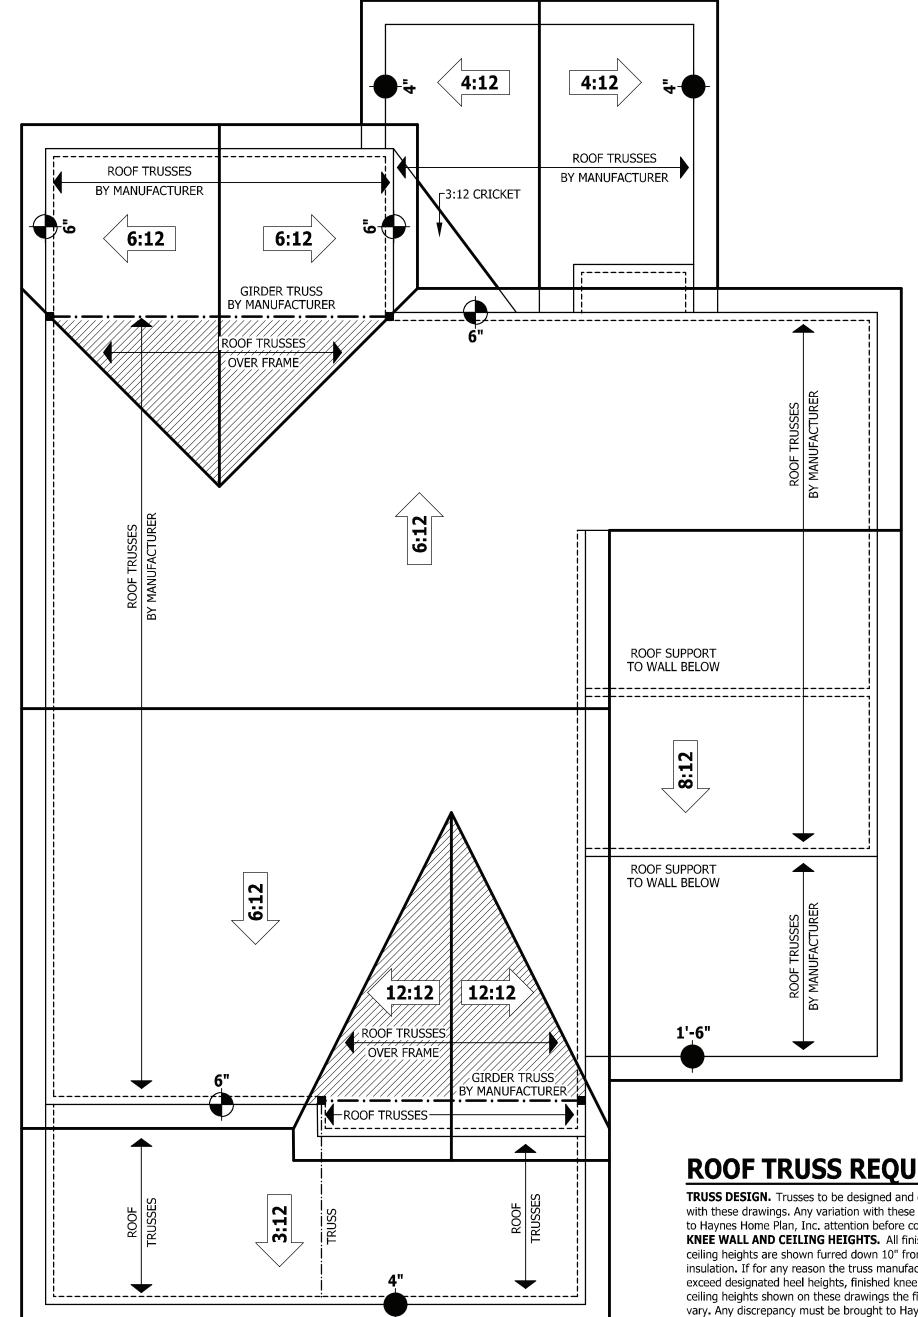

**ROOF PLAN** SCALE 1/4" = 1'-0"

# **ROOF TRUSS REQUIREMENTS**

**TRUSS DESIGN.** Trusses to be designed and engineered in accordance with these drawings. Any variation with these drawings must be brought to Haynes Home Plan, Inc. attention before construction begins. KNEE WALL AND CEILING HEIGHTS. All finished knee wall heights and ceiling heights are shown furred down 10" from roof decking for insulation. If for any reason the truss manufacturer fails to meet or exceed designated heel heights, finished knee wall heights, or finished ceiling heights shown on these drawings the finished square footage may vary. Any discrepancy must be brought to Haynes Home Plans, Inc. attention, so a suitable solution can be reached before construction begins. Any variation due to these conditions not being met is the reasonability of the truss manufacturer.

**ANCHORAGE.** All required anchors for trusses due to uplift or bearing shall meet the requirements as specified on the truss schematics. **BEARING.** All trusses shall be designed for bearing on SPF #2 plates or ledgers unless noted otherwise. Plate Heights & Floor Systems. See elevation page(s) for plate heights

and floor system thicknesses.

HEEL HEIGHT ABOVE FIRST FLOOR PLATE

HEEL HEIGHT ABOVE SECOND FLOOR PLATE

PURCHASER MUST VERIFY ALL DIMENSIONS AND CONDITIONS EFORE CONSTRUCTION BEGINS HAYNES HOME PLANS, INC. ASSUMES NO LIABILITY FOR CONTRACTORS PRACTICES AND

CODES AND CONDITIONS MAY DESIGNER, ARCHITECT OR NGINEER SHOULD BE CONSULTED BEFORE CONSTRUCTION.

THESE DRAWING ARE INSTRUMENTS OF SERVICE AND AS SUCH SHALL REMAIN PROPERTY OF THE DESIGNER.

**ROOF PLAN** 

GASTON

뿓

 SQUARE FOOTAGE

 HEATED
 776 SQ.FT.

 FIRST FLOOR
 764 SQ.FT.

 SECOND FLOOR
 764 SQ.FT.

 PLAYROOM
 280 SQ.FT.

 TOTAL
 1820 SQ.FT.

 UNHEATED
 FRONT PORCH
 101 SQ.FT.


 GARAGE
 466 SO.FT.


GARAGE REAR PORCH TOTAL

© Copyright 2016 Haynes Home Plans, Inc.

5/19/2020 181035B

PAGE 7 OF 8

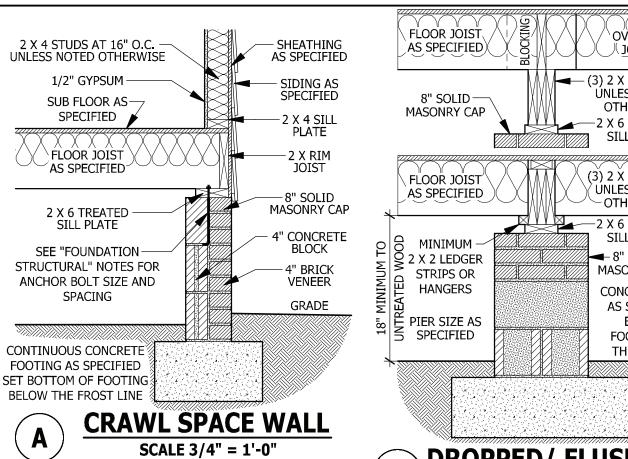

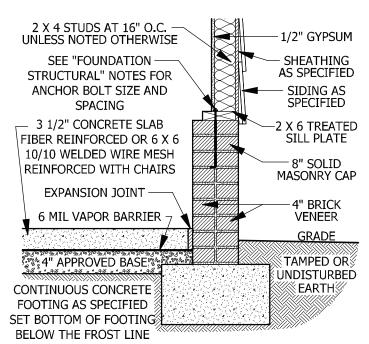

**GARAGE STEM WALL** 



# SCALE 3/4" = 1'-0" **DECK STAIR NOTES**

**SECTION AM110** 

AM110.1 Stairs shall be constructed per Figure AM110. Stringer spans shall be no greater than 7 foot span between supports. Spacing between stringers shall be based upon decking material used per AM107.1. Each Stringer shall have minimum 3 1/2 inches between step cut and back of stringer. If used, suspended headers shall shall be attached with 3/8 inch galvanized bolts with nuts and washers to securely support stringers at the top.

# **DECK BRACING**

AM109.1 Deck bracing. Decks shall be braced to provide lateral stability. The following are acceptable means to provide lateral stability.

AM109.1.1. When the deck floor height is less than 4'-0" above finished grade per Figure AM109 and the deck is attached to the structure in accordance with Section AM104, lateral bracing is not required.


AM109.1.2. 4 x 4 wood knee braces may be provided on each column in both directions. The knee braces shall attach to each post at a point not less than 1/3 of the post length from the top of the post, and the braces shall be angled between 45 degrees and 60 degrees from the horizontal. Knee braces shall be bolted to the post and the girder/double band with one 5/8 inch hot dipped galvanized bolt with nut and washer at both ends of the brace per Figure AM109.1

**AM109.1.3.** For freestanding decks without knee braces or diagonal bracing, lateral stability may be provided by embedding the post in accordance with Figure AM109.2


and the following:								
POST SIZE	MAX TRIBUTARY AREA	MAX. POST HEIGHT	EMBEDMENT DEPTH	CONCRETE DIAMETER				
4 X 4	4 X 4 48 SF		2'-6"	1'-0"				
6 X 6	120 SF	6'-0"	3'-6"	1'-8"				

**AM109.1.4.** 2 x 6 diagonal vertical cross bracing may be provided in two perpendicular directions for freestanding decks or parallel to the structure at the exterior column line for attached decks. The 2 x 6's shall be attached to the posts with one 5/8 inch hot dipped galvanized bolt with nut and washer at each end of each bracing member per Figure AM109.3.


AM109.1.5. For embedment of piles in Coastal Regions, see Chapter 45.

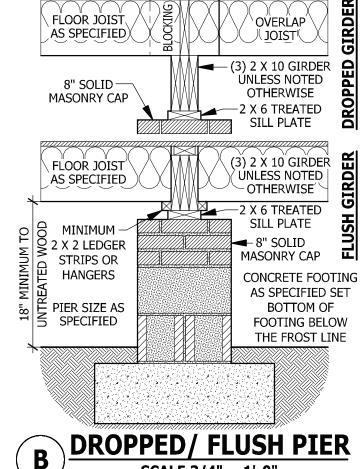

# **SCALE 3/4" = 1'-0"**

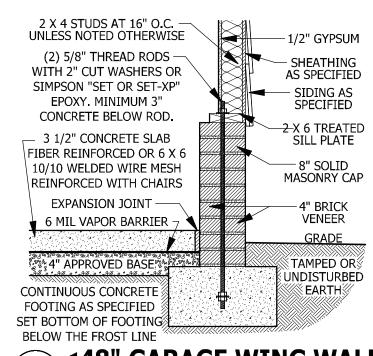

# <48" GARAGE WING WALL SCALE 3/4" = 1'-0"

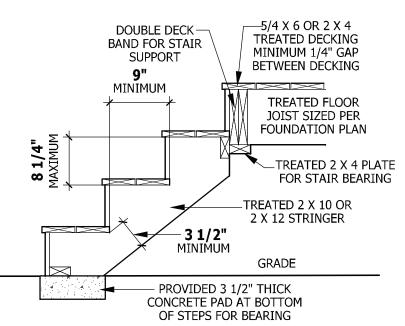

# FIGURE AM110 TYPICAL DECK STAIR DETAIL

SCALE 3/4" = 1'-0"

STONE VEENER

AS SPECIFIED

VAPOR BARRIER

-WEEP SCREED

MINIMUM 4" TO

GROUND OR 2"

←TO PAVEMENT

GRADE

SHEATHING AS SPECIFIED

AS SPECIFIED

LATH-

SEE FOUNDATION

FOR FOUNDATION

**DETAILS** 

**WEEP SCREED** 


SCALE 3/4" = 1'-0"

# **WEEP SCREEDS**


All weep screeds and stone veneer to be installed per manufactures instructions and per the 2012 North Carolina Residential Building code.

**R703.6.2.1 -** A minimum 0.019-inch (0.5 mm) (No. 26 galvanized sheet gage), corrosion-resistant weep screed or plastic weep screed, with a minimum vertical attachment flange of 31/2 inches (89 mm) shall be provided at or below the foundation plate line on exterior stud walls in accordance with ASTM C 926. The weep screed shall be placed a minimum of 4 inches (102 mm) above the earth or 2 inches (51 mm) above paved areas and shall be of a type that will allow trapped

water to drain to the exterior of the shall cover and terminate on the attachment flange of the weep screed.

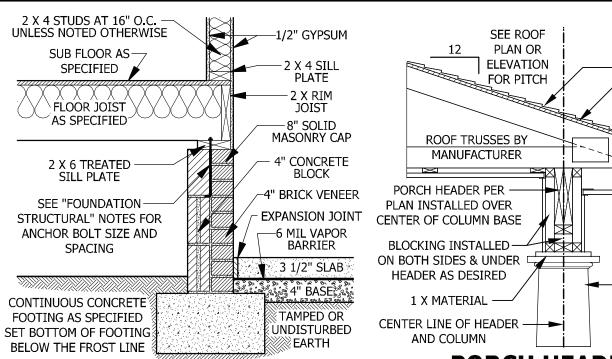

**CRAWL SPACE AT GARAGE** SCALE 3/4" = 1'-0"

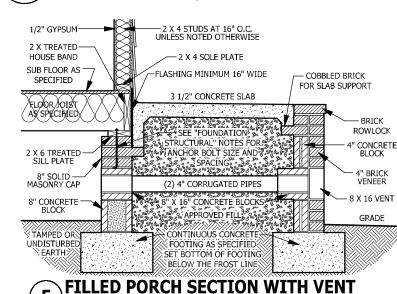

NITH (2) 1/2" HOT-DIPPED GALVANIZED BOLTS 5/4 X 6 OR 2 X 4 TREATED DECKING MINIMUM 1/4" GAP BETWEEN DECKING FLASHING TREATED GIRDER AS SPECIFIED FOUNDATION PLAN OR TREATED 2 X 2 LEDGER 5/8" HOT-DIPPED GALVANIZED BOLTS AT 1'-8" O.C. MINIMUM 2 AS SPECIFIED 1/2" FROM EDGE WITH (3) 120 GALVANIZED NAILS AT 6" O.C **GRADE** FOOTING SIZED PER FOUNDATION PLAN SET BOTTOM OF FOOTING BELOW

> DECK ATTACHMENT SCALE 1/2" = 1'-0"

# **SMOKE ALARMS**

**R314.1 Smoke detection and notification.** All smoke alarms shall be listed in accordance with UL 217 and installed in accordance with the provisions of this code and the household fire warning equipment provisions of NFPA 72.

**R314.2 Smoke detection systems.** Household fire alarm systems installed in accordance with NFPA 72 that include smoke alarms, or a combination of smoke detector and audible notification device installed as required by this section for smoke alarms, shall be permitted. The household fire alarm system shall provide the same level of smoke detection and alarm as required by this section for smoke alarms. Where a household fire warning system is installed using a combination of smoke detector and audible notification device(s), it shall become a permanent fixture of the occupancy and owned by the homeowner. The system shall be monitored by an approved supervising station and be maintained in accordance with

**Exception:** Where smoke alarms are provided meeting the requirements of Section R314.4.

R314,3 Location. Smoke alarms shall be installed in the following


1. In each sleeping room.

2. Outside each separate sleeping area in the immediate vicinity of the bedrooms.

3. On each additional *story* of the *dwelling*, including *basements* and habitable attics (finished) but not including crawl spaces, uninhabitable (unfinished) attics and uninhabitable (unfinished) attic-stories. In *dwellings* or *dwelling units* with split levels and without an intervening door between the adjacent levels, a smoke alarm installed on the upper level shall suffice for the adjacent lower level provided that the lower level is less than one full story below the upper level.

When more than one smoke alarm is required to be installed within in such a manner that the actuation of one alarm will activate all of the alarms in the individual unit.

**R314.4 Power source.** Smoke alarms shall receive their primary power from the building wiring when such wiring is served from a building. The weather-resistant barrier shall commercial source, and when primary power is interrupted, shall lap the attachment flange. The exterior lath receive power from a battery. Wiring shall be permanent and without a disconnecting switch other than those required for overcurrent protection. Smoke alarms shall be interconnected.

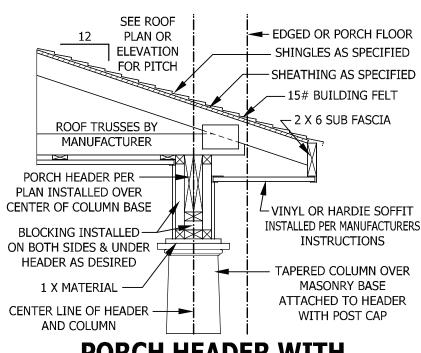

# **PORCH HEADER WITH TAPERED COLUMN**

**SCALE 3/4" = 1'-0"** 

# **CARBON MONOXIDE ALARMS**

R315.1 Carbon monoxide alarms. In new construction, dwelling units shall be provided with an approved carbon monoxide alarm installed outside of each separate sleeping area in the immediate vicinity of the bedroom(s) as directed by the alarm manufacturer,

R315.2 Where required in existing dwellings. In existing dwellings, where interior alterations, repairs, fuel-fired appliance replacements, or additions requiring a permit occurs, or where one or more sleeping rooms are added or created, carbon monoxide alarms shall be provided in accordance with Section

R315.3 Alarm requirements. The required carbon monoxide alarms shall be audible in all bedrooms over background noise levels with all intervening doors closed. Single station carbon monoxide alarms shall be listed as complying with UL 2034 and shall be installed in accordance with this code and the manufacturer's installation instructions.

# **STAIRWAY NOTES**

R311.7.2 Headroom. The minimum headroom in all parts of the stairway shall not be less than 6 feet 8 inches (2032 mm) measured vertically from the sloped line adjoining the tread nosing or from the floor surface of the landing or platform on that portion of the stairway.

**R311.7.4 Stair treads and risers.** Stair treads and risers shall meet the requirements of this section. For the purposes of this section all dimensions and dimensioned surfaces shall be exclusive of carpets, rugs or runners. R311.7.4.1 Riser height. The maximum riser height shall be 8 1/4 inches (210 mm). The riser shall be measured vertically between leading edges of the adjacent treads.

R311.7.4.2 Tread depth. The minimum tread depth shall be 9 inches (229 mm). The tread depth shall be measured horizontally between the vertical planes of the foremost projection of adjacent treads and at a right angle to the tread's leading edge. Winder treads shall have a minimum tread depth of 9 inches (229 mm) measured as above at a point 12 inches (305 mm) from the side where the treads are narrower. Winder treads shall have a minimum tread depth of 4 inches (102 mm) at any point.

R311.7.4.3 Profile. The radius of curvature at the nosing shall be no greater than 9/16 inch (14 mm). A nosing not less than 3/4 inch (19 mm) but not more than 1 1/4 inches (32 mm) shall be provided on stairways with solid

**R311.7.7 Handrails.** Handrails shall be provided on at least one side of each continuous run of treads or flight with four or more risers.

**R311.7.7.1 Height.** Handrail height, measured vertically from the sloped plane adjoining the tread nosing, or finish surface of ramp slope, shall be not less than 34 inches (864 mm)and not more than 38 inches (965 mm).

1. The use of a volute, turnout or starting easing shall be allowed over the lowest tread.


2. When handrail fittings or bendings are used to provide continuous transition between flights, the transition from handrail to guardrail, or used at the start of a flight, the handrail height at the fittings or bendings shall be permitted to exceed the maximum height.

R311.7.7.2 Continuity. Handrails for stairways shall be continuous for the full length of the flight, from a point directly above the top riser of the flight to a point directly above the lowest riser of the flight. Handrail ends shall be returned or shall terminate in newel posts or safety terminals. Handrails an individual *dwelling* unit the alarm devices shall be interconnected adjacent to a wall shall have a space of not less than 11/2 inch (38 mm) between the wall and the handrails.

# Exceptions:

1. Handrails shall be permitted to be interrupted by a newel post. 2. The use of a volute, turnout, starting easing or starting newel shall be allowed over the lowest tread.

3. Two or more separate rails shall be considered continuous if the termination of the rails occurs within 6 inches (152 mm) of each other. If transitioning between a wall-mounted handrail and a guardrail/handrail, the wall-mounted rail must return into the wall.

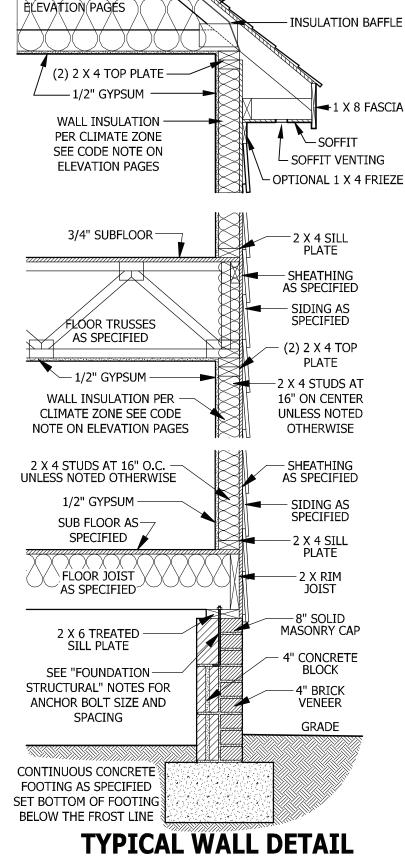

PITCH PER ROOF PLAN

OR ELEVATIONS

ROOF INSULATION


PER CLIMATE ZONE

SEE CODE NOTE ON

- SHINGLES AS SPECIFIED

—15# BUILDING FELT

-SHEATHING AS SPECIFIED

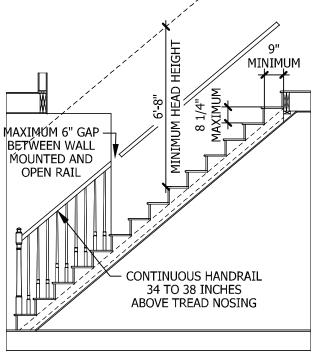

SCALE 3/4" = 1'-0"

TYPICAL STAIR DETAIL

SQUARE FOOTAGE FIRST FLOOR SECOND FLOOR PLAYROOM

TOTAL UNHEATED

PURCHASER MUST VERIFY ALL

EFORE CONSTRUCTION BEGINS

HAYNES HOME PLANS, INC.

ASSUMES NO LIABILITY FOR CONTRACTORS PRACTICES AND

CODES AND CONDITIONS MAY

ARY WITH LOCATION, A LOCAL

DESIGNER, ARCHITECT OR

BEFORE CONSTRUCTION.

THESE DRAWING ARE

NSTRUMENTS OF SERVICE AND

AS SUCH SHALL REMAIN

PROPERTY OF THE DESIGNER.

STON

Ú

里

S

DETAIL

**TYPICAL** 


IGINEER SHÓULD BE CONSULTEI

REAR PORCH TOTAL © Copyright 2016

laynes Home Plans, Inc. 5/19/2020

PAGE 8 OF 8

181035B

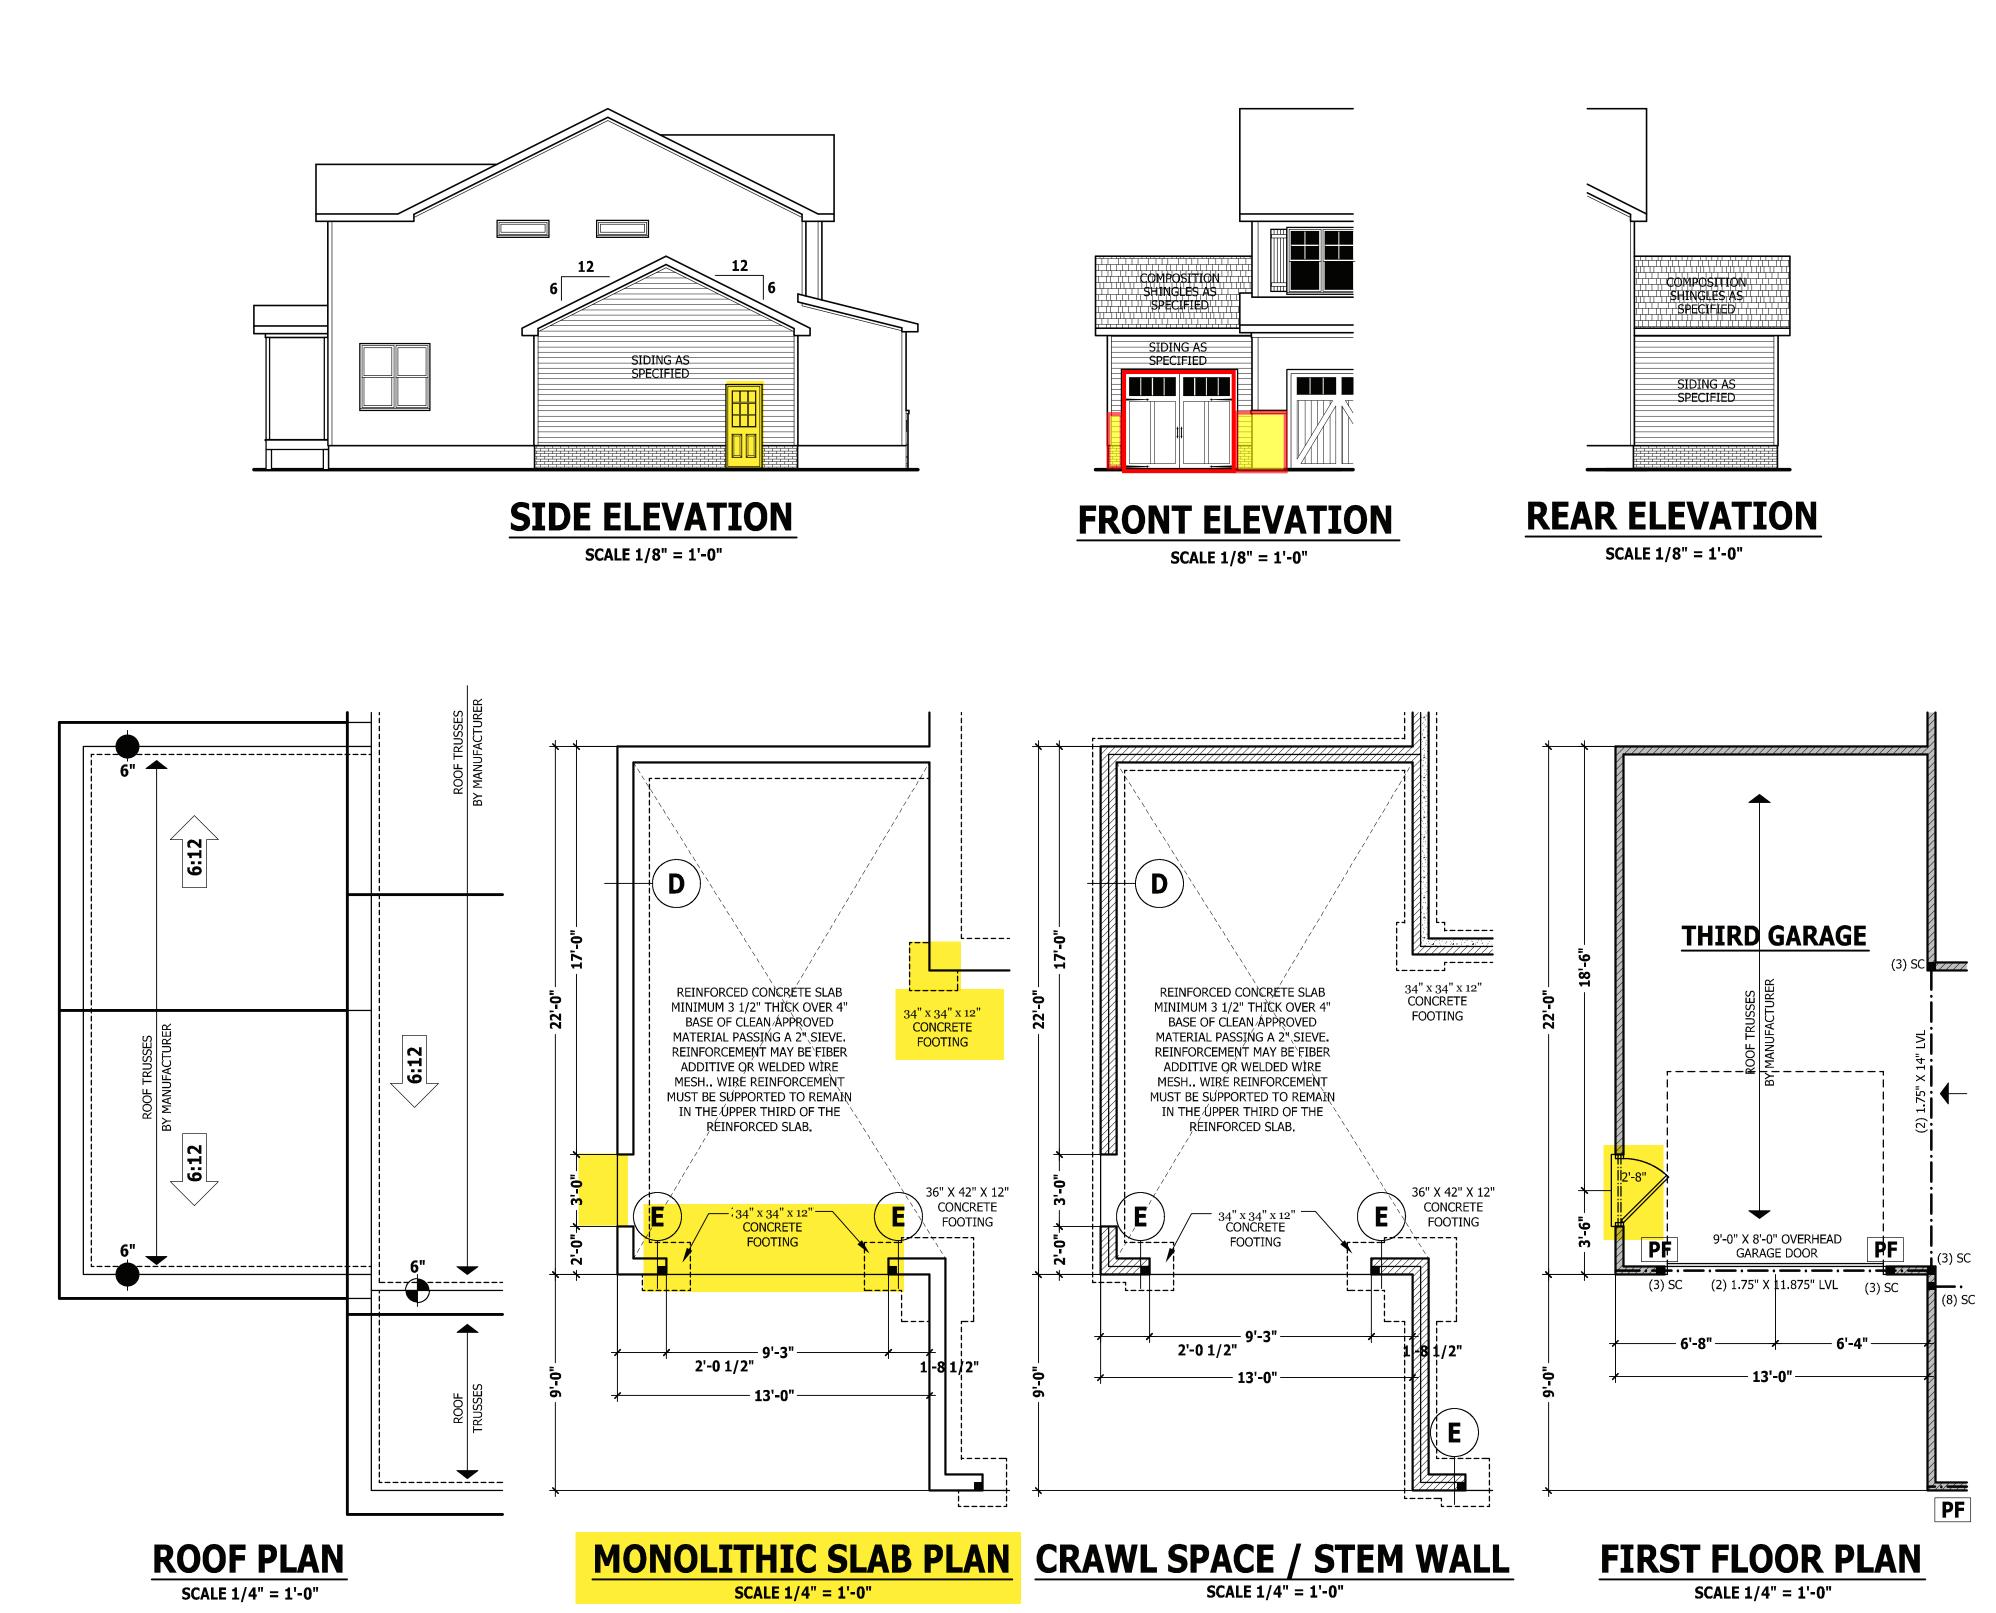

Z:\Builder\Weaver Development Company, Inc\200128B Gaston II\200128B Gaston II Left.aec

PURCHASER MUST VERIFY ALL EFORE CONSTRUCTION BEGINS HAYNES HOME PLANS, INC. ASSUMES NO LIABILITY FOR CONTRACTORS PRACTICES AND

> CODES AND CONDITIONS MAY DESIGNER, ARCHITECT OR NGINEER SHOULD BE CONSULTED BEFORE CONSTRUCTION.

THESE DRAWING ARE INSTRUMENTS OF SERVICE AND AS SUCH SHALL REMAIN PROPERTY OF THE DESIGNER.

CAR

**THIRD GASTON** LOAD 품 **FRONT** 

 SQUARE FOOTAGE

 HEATED
 776 SQ.FT

 FIRST FLOOR
 776 SQ.FT

 SECOND FLOOR
 764 SQ.FT

 PLAYROOM
 280 SQ.FT

 TOTAL
 1820 SQ.FT


 UNHEATED
 FRONT PORCH

 FRONT PORCH
 101 SQ.FT

 GARAGE
 466 SQ.FT

© Copyright 2016 Haynes Home Plans, Inc. 5/19/2020 181035B

**ADDENDUM** 

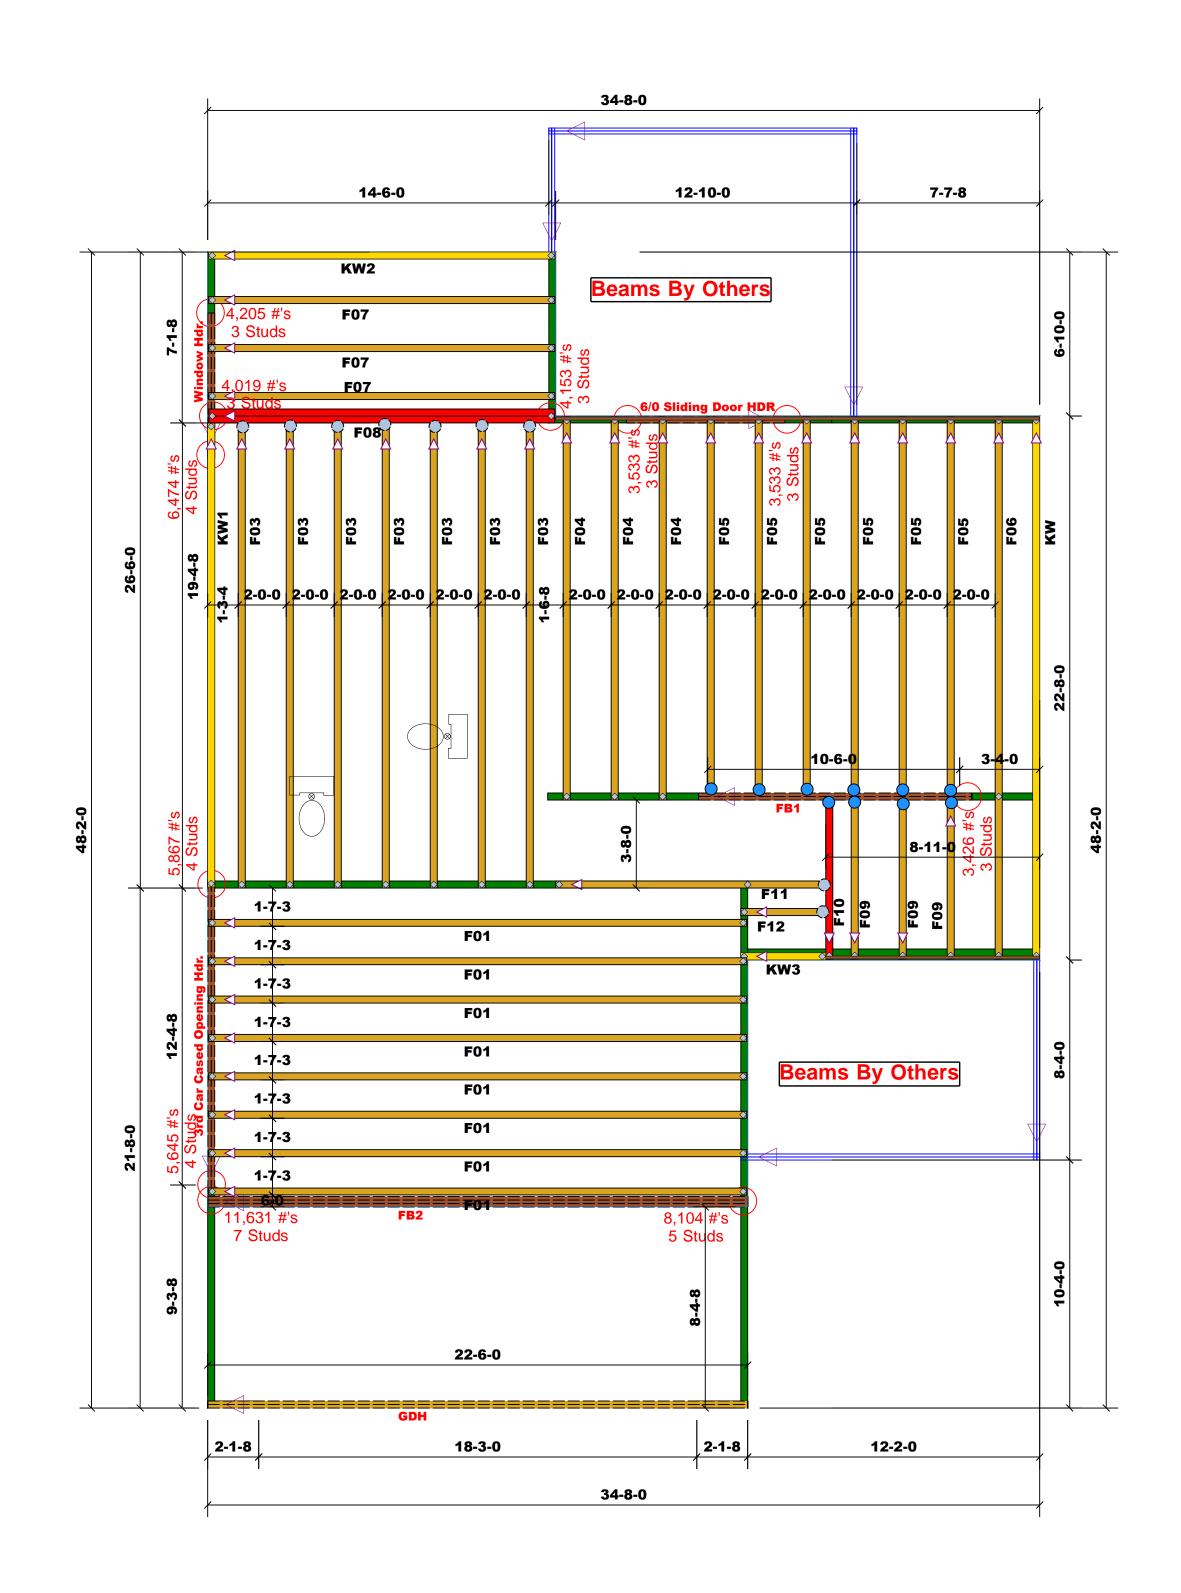

All Truss Reactions are Less than 3,000 lbs. Unless Noted Otherwise.

-- Denotes Reaction Greater than 3,000 lbs.

Reaction / # of Studs

HUS410	USP	10	NA	16d/3-1/2"	16d/3-1/2"
MSH422	USP	9	Varies	10d/3"	10d/3"

		Products			
PlotID	Length	Product	Plies	Net Qty	Fa
6/0 Sliding Door HDR	7-00-00	1-3/4"x 9-1/4" LVL Kerto-S	2	2	FF
GDH	23-00-00	1-3/4"x 14" LVL Kerto-S	2	2	FF
3rd Car Cased Opening Hdr.	13-00-00	1-3/4"x 14" LVL Kerto-S	2	2	FF
FB1	12-00-00	1-3/4"x 14" LVL Kerto-S	2	2	FF
Window Hdr.	7-00-00	1-3/4"x 14" LVL Kerto-S	2	2	FF
FB2	23-00-00	1-3/4"x 23-7/8" LVL Kerto-S	3	3	FF

# Truss Placement Plan SCALE: 1/4"=1'


= Indicates Left End of Truss
(Reference Engineered Truss Drawing)
Do NOT Erect Truss Backwards

LO	AD (	CHAF	RT FO	RЈ	ACK.	STUD	S
	•		N TABLES				
NUI	NBER C		STUDS P HEADER/			A END OF	
END REACTION (UP TO)	REQ'D STUDS FOR (2) PLY HEADER		END REACTION (UP TO)	REQ'D STUDS FOR (3) PLY HEADER		END REACTION (UP TO)	REQ'D STUDS FOR (4) PLY HEADER
1700	1		2550	1		3400	1
3400	2		5100	2		6800	2
5100	3		7650	3		10200	3
6800	4		10200	4		13600	4
8500	5		12750	5		17000	5
10200	6		15300	6			
11900	7						
13600	8						
15300	9						

		SCALL. 1/4	<b>-</b> 1	50140
BUILDER	Weaver Development Co. Inc.	COUNTY	Harnett	THIS IS A TRUSS PLACEMENT DIAGRAM ONLY.  These trusses are designed as individual building components to be incorporated into the building design at the specification of the building designer. See individual design sheets for each truss design identified on the placement drawing. The building designer
JOB NAME	Lot 27 West Preserve	ADDRESS	Thistle Court	is responsible for temporary and permanent bracing of the roof and floor system and for the overall structure. The design of the truss support structure including headers, beams, walls, and columns is the responsibility of the building designer. For general guidance regarding bracing, consult BCSI-B1 and BCSI-B3 provided with the truss delivery package
PLAN	Gaston II (181035B) Tudor 3 Car	MODEL	Floor	or online @ sbcindustry.com  Bearing reactions less than or equal to 3000# are deemed to comply with the prescriptive Code requirements. The contractor shall refer to the attached Tables
SEAL DATE	N/A	DATE REV.	/ /	( derived from the prescriptive Code requirements ) to determine the minimum foundation size and number of wood studs required to support reactions greater than 3000# but not greater than 15000#. A registered design professional shall be retained to design the support system for any reaction that exceeds those
QUOTE#	Quote #	DRAWN BY	Marshall Naylor	specified in the attached Tables. A registered design professional shall be retained to design the support system for all reactions that exceed 15000#.
JOB#	J0123-0239	SALESMAN	Lenny Norris	Signature Marshall Naylor



Phone: (910) 864-8787 Fax: (910) 864-4444

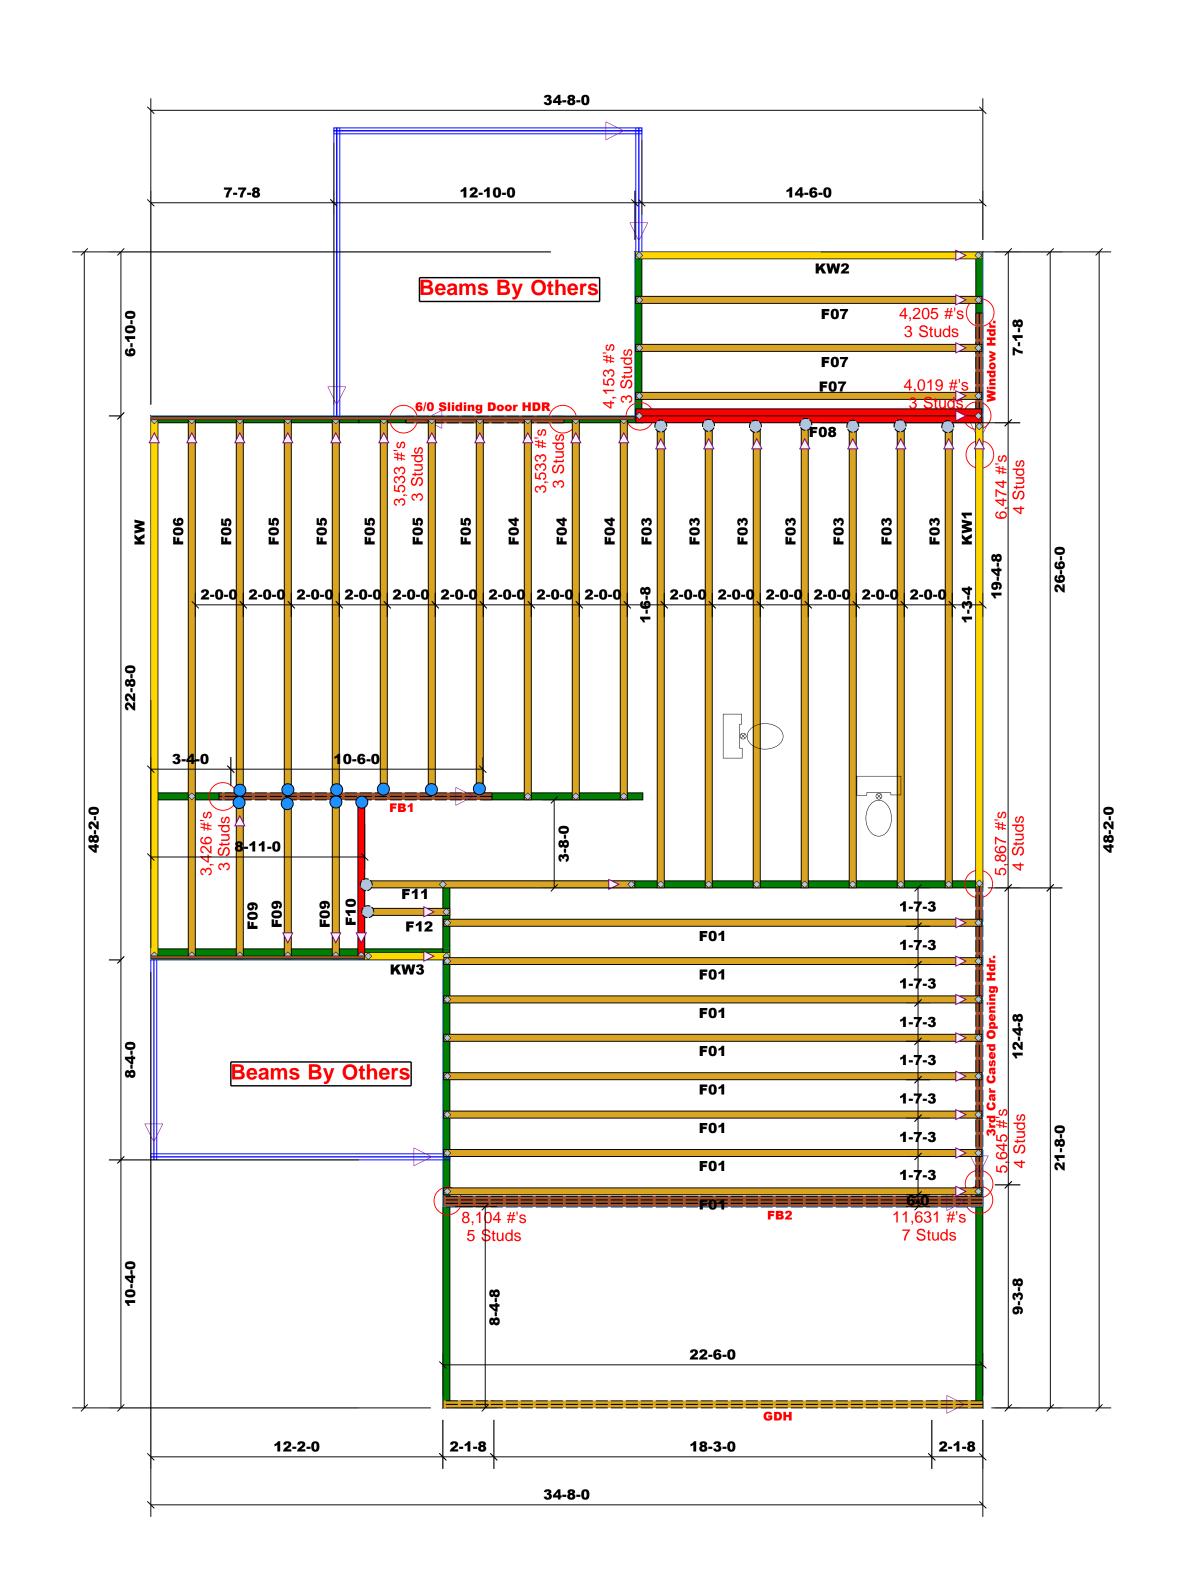

All Truss Reactions are Less than 3,000 lbs. Unless Noted Otherwise.

-- Denotes Reaction Greater than 3,000 lbs.

Reaction / # of Studs

	HUS410	USP	10	NA	16d/3-1/2"	16d/3-1/2"
	MSH422	USP	9	Varies	10d/3"	10d/3"

		Products			
PlotID	Length	Product	Plies	Net Qty	Fab
6/0 Sliding Door HDR	7-0-0	1-3/4"x 9-1/4" LVL Kerto-S	2	2	FF
GDH	23-0-0	1-3/4"x 14" LVL Kerto-S	2	2	FF
3rd Car Cased Opening Hdr.	13-0-0	1-3/4"x 14" LVL Kerto-S	2	2	FF
FB1	12-0-0	1-3/4"x 14" LVL Kerto-S	2	2	FF
Window Hdr.	7-0-0	1-3/4"x 14" LVL Kerto-S	2	2	FF
FB2	23-0-0	1-3/4"x 23-7/8" LVL Kerto-S	3	3	FF

# Truss Placement Plan SCALE: 1/4"=1'


= Indicates Left End of Truss
(Reference Engineered Truss Drawing)
Do NOT Erect Truss Backwards

_								
_	LO	AD (	CHAR	T FO	RЈ	ACK :	STUD	S
		(B	ASED O	N TABLES	5 R502.	.5(1) & (E	o))	
	NUMBER OF JACK STUDS REQUIRED @ EA END OF HEADER/GIRDER							
	END REACTION (UP TO)	REQ'D STUDS FOR (2) PLY HEADER		END REACTION (UP TO)	REQ'D STUDS FOR (3) PLY HEADER		END REACTION (UP TO)	REQ'D STUDS FOR (4) PLY HEADER
	1700	1		2550	1		3400	1
	3400	2		5100	2		6800	2
	5100	3		7650	3		10200	3
	6800	4		10200	4		13600	4
	8500	5		12750	5		17000	5
	10200	6		15300	6			
	11900	7						
	13600	8						
	15300	9						

		SCALL. 1/4	=1	5014
BUILDER	Weaver Development Co. Inc.	COUNTY	Harnett	THIS IS A TRUSS PLACEMENT DIAGRAM ONLY.  These trusses are designed as individual building components to be incorporated into the building design at the specification of the building designer. See individual design sheets for each truss design identified on the placement drawing. The building designer
JOB NAME Lot 27 West Preserve		ADDRESS	Thistle Court	is responsible for temporary and permanent bracing of the roof and floor system and for the overall structure. The design of the truss support structure including headers, beams, walls, and columns is the responsibility of the building designer. For general guidance regarding bracing, consult BCSI-B1 and BCSI-B3 provided with the truss delivery package
PLAN	Gaston II (181035B) Tudor 3 Car	MODEL	Floor	or online @ sbcindustry.com  Bearing reactions less than or equal to 3000# are deemed to comply with the prescriptive Code requirements. The contractor shall refer to the attached Tables
SEAL DATE N/A		DATE REV.	/ /	( derived from the prescriptive Code requirements ) to determine the minimum foundation size and number of wood studs required to support reactions greater than 3000# but not greater than 15000#. A registered design professional shall be retained to design the support system for any reaction that exceeds those
QUOTE#	Quote #	DRAWN BY	Marshall Naylor	specified in the attached Tables. A registered design professional shall be retained to design the support system for all reactions that exceed 15000#.
JOB#	J0123-0239	SALESMAN	Lenny Norris	Signature Marshall Naylor



Reilly Road Industrial Park Fayetteville, N.C. 28309 Phone: (910) 864-8787 Fax: (910) 864-4444

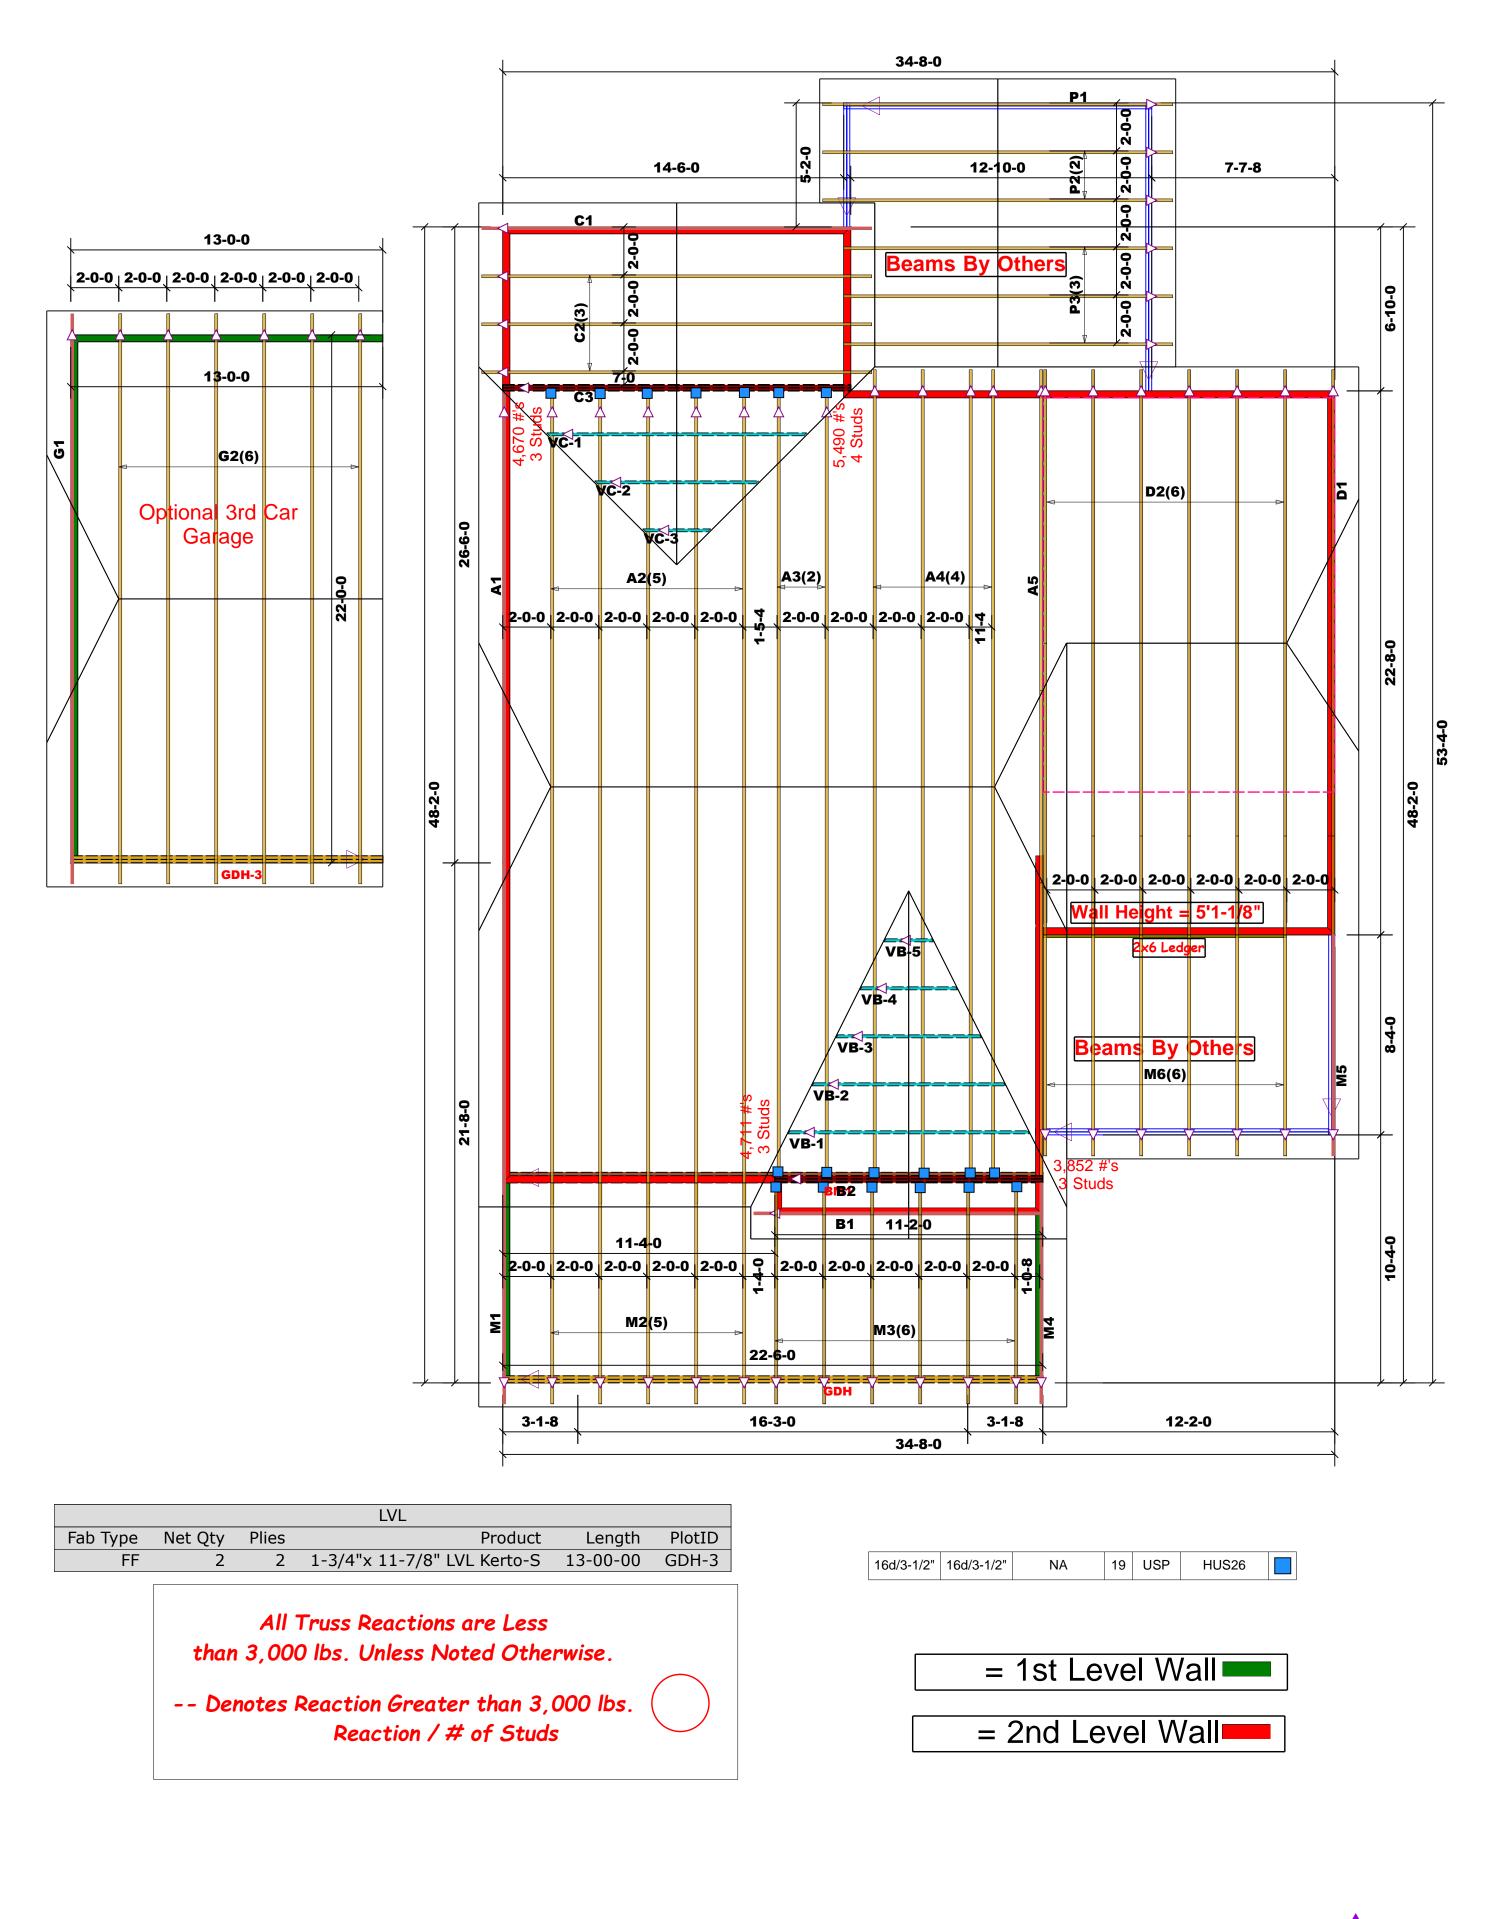

# Truss Placement Plan SCALE: NTS

= Indicates Left End of Truss
(Reference Engineered Truss Drawing)
Do NOT Erect Truss Backwards

LO	AD (	CHAF	RT FO	RЈ	ACK :	STUD	s		
	(B	ASED O	N TABLES	5 R502.	5(1) & (t	o))			
NU	NBER C		F JACK STUDS REQUIRED @ EA END O HEADER/GIRDER						
END REACTION (UP TO) REQ'D STUDS FOR (2) PLY HEADER			END REACTION (UP TO) REQ'D STUDS FOR (3) PLY HEADER			END REACTION (UP TO)	REQ'D STUDS FOR (4) PLY HEADER		
1700	1		2550	1		3400	1		
3400	2		5100	2		6800	2		
5100	3		7650	3		10200	3		
6800	4		10200	4		13600	4		
8500	5		12750	5		17000	5		
10200	6		15300	6					
11900	7								
13600	8								
15300	9								

				_
BUILDER	Weaver Development Co. Inc.		Harnett	THIS IS These to the build sheets for
JOB NAME Lot 27 West Preserve		ADDRESS	Thistle Court	is responsible the over walls, an regardin
PLAN	Gaston II (181035B)	MODEL	Roof	Bearing prescrip
SEAL DATE	N/A	DATE REV.	/ /	( derive foundat than 30 be retai
QUOTE#		DRAWN BY	Marshall Naylor	specifie retained
JOB#	J0123-0238	SALESMAN	Lenny Norris	

THIS IS A TRUSS PLACEMENT DIAGRAM ONLY.


These trusses are designed as individual building components to be incorporated into he building design at the specification of the building designer. See individual design heets for each truss design identified on the placement drawing. The building designer is responsible for temporary and permanent bracing of the roof and floor system and for he overall structure. The design of the truss support structure including headers, beams, ralls, and columns is the responsibility of the building designer. For general guidance grading bracing, consult BCSI-B1 and BCSI-B3 provided with the truss delivery package ronline @ sbcindustry.com

The specific provided with the truss delivery package ronline package is the provided with the truss delivery package ronline package is the provided with the truss delivery package ronline package is the provided with the truss delivery package ronline package is the provided with the truss delivery package ronline package

Bearing reactions less than or equal to 3000# are deemed to comply with the prescriptive Code requirements. The contractor shall refer to the attached Tables ( derived from the prescriptive Code requirements ) to determine the minimum foundation size and number of wood studs required to support reactions greater than 3000# but not greater than 15000#. A registered design professional shall be retained to design the support system for any reaction that exceeds those specified in the attached Tables. A registered design professional shall be retained to design the support system for all reactions that exceed 15000#.



Phone: (910) 864-8787 Fax: (910) 864-4444

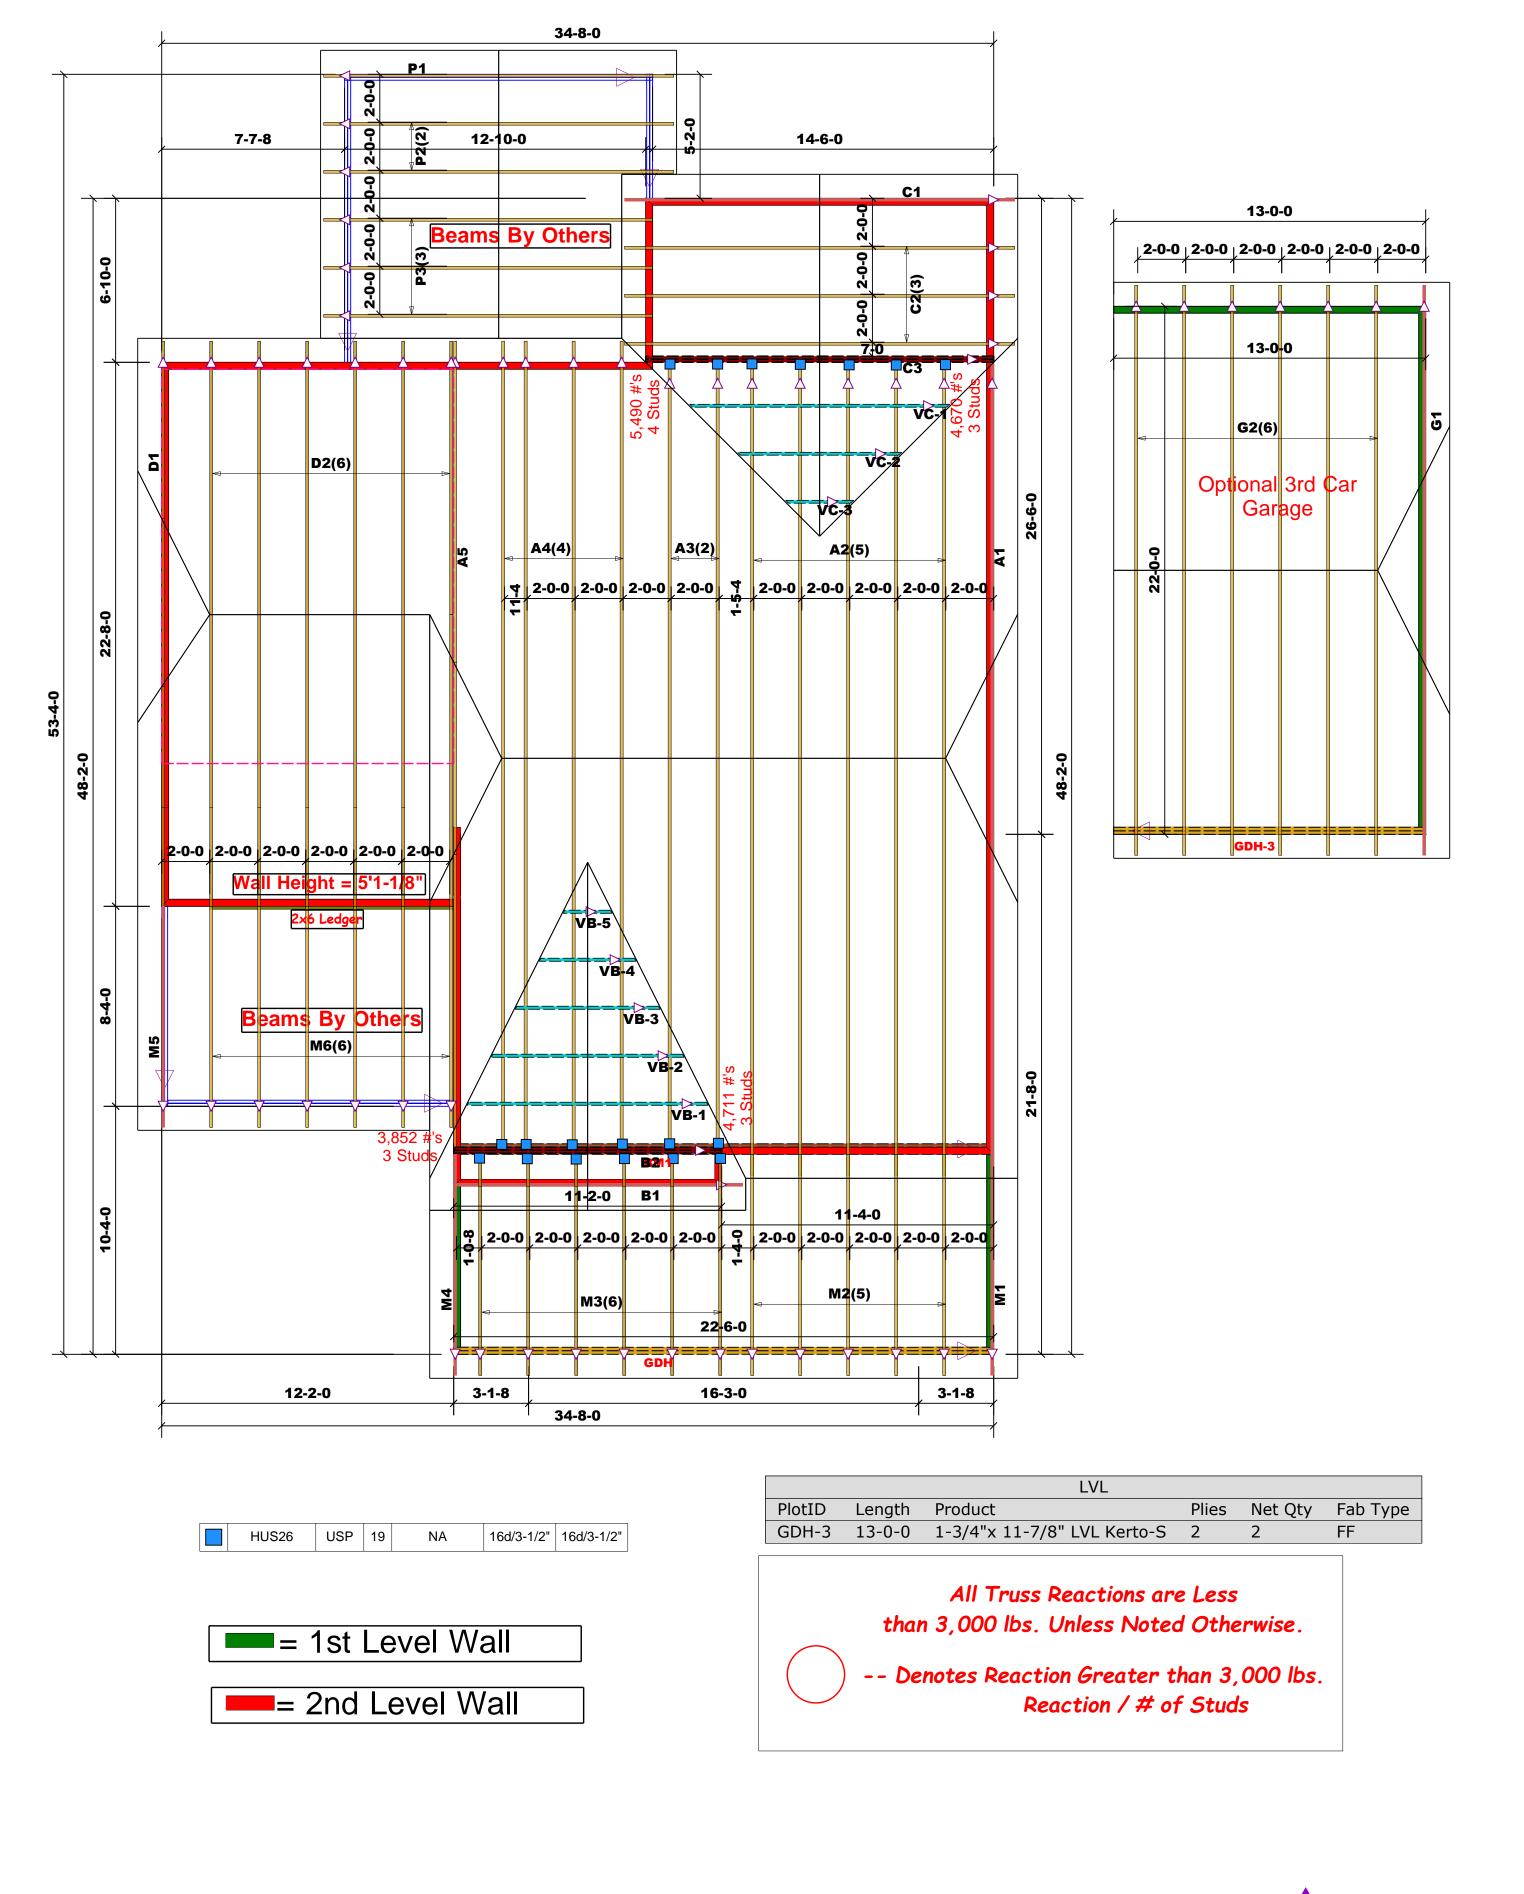

# Truss Placement Plan **SCALE: NTS**

= Indicates Left End of Truss (Reference Engineered Truss Drawing) Do NOT Erect Truss Backwards

	(R	ASED O	N TABLES	S R502	5(1) & (1	2))	
NU	•	OF JACK	STUDS	EQUIP	ED @ E		:
			HEADER/		₹		
NOIL:	JDS FOR EADER		NOIL:	JDS FOR EADER		NOILS	JDS FOR
END REACTION (UP TO)	REQ'D STUDS FOR (2) PLY HEADER		END REACTION (UP TO)	REQ'D STUDS FOR (3) PLY HEADER		END REACTION (UP TO)	REQ'D STUDS FOR (4) PLY HEADER
1700	1		2550	1		3400	1
3400	2		5100	2		6800	2
5100	3		7650	3		10200	3
6800	4		10200	4		13600	4
8500	5		12750	5		17000	5
.0200	6		15300	6			
1900	7						
3600	8						
15300	9						

					_
	BUILDER	Weaver Development Co. Inc.		Harnett	THIS Thes the be
JOB NAME Lot 27 West Preserve		ADDRESS	Thistle Court	is res the o walls regar	
	PLAN	Gaston II (181035B)	MODEL	Roof	Beari
	SEAL DATE	N/A	DATE REV.	/ /	( deri found than be re
	QUOTE#		DRAWN BY	Marshall Naylor	speci retair
	JOB#	J0123-0238	SALESMAN	Lenny Norris	

HIS IS A TRUSS PLACEMENT DIAGRAM ONLY.

Marshall Naylor



Fayetteville, N.C. 28309 Phone: (910) 864-8787 Fax: (910) 864-4444



Project: Address:

Weaver Homes

Gaston II (181035B)

Date: 1/17/2023

Input by: Marshall Naylor Job Name: Gaston II (181035B)


Project #:

Kerto-S LVL FB2

1.750" X 24.000"

3-Ply - PASSED

Level: Level

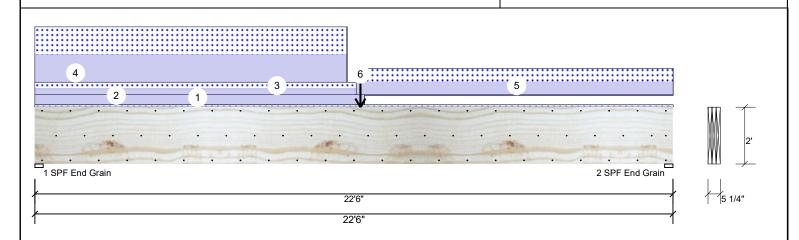

Member	Information
Type:	Girder

Plies: Moisture Condition: Dry Deflection LL: 480 Deflection TL: 360

Importance: Normal - II Temp <= 100°F Temperature:

Application: Floor Design Method: ASD **Building Code:** IBC 2012

Load Sharing: Yes Deck:

Not Checked

### Reactions UNPATTERNED lb (Uplift)

Brg	Direction	Live	Dead	Snow	Wind	Const
1	Vertical	225	6536	5095	0	0
2	Vertical	225	4429	3676	0	0

Page 1 of 3

# **Bearings**

End Grain

Bearing Length Dir. Cap. React D/L lb Total Ld. Case Ld. Comb. 1 - SPF 3.500" Vert 6536 / 5095 11631 L End Grain 4429 / 3676 8104 L D+S 2 - SPF 3.500" Vert

### **Analysis Results**

•						
Analysis	Actual	Location	Allowed	Capacity	Comb.	Case
Moment	65477 ft-lb	11'5 3/4"	131295 ft-lb	0.499 (50%)	D+S	L
Unbraced	65477 ft-lb	11'5 3/4"	65512 ft-lb	0.999 (100%)	D+S	L
Shear	10076 lb	2'3 1/2"	30912 lb	0.326 (33%)	D+S	L
LL Defl inch	0.226 (L/1171)	11'1 11/16"	0.552 (L/480)	0.410 (41%)	S	L
TL Defl inch	0.501 (L/528)	11' 7/8"	0.735 (L/360)	0.682 (68%)	D+S	L

#### **Design Notes**

- 1 Provide support to prevent lateral movement and rotation at the end bearings. Lateral support may also be required at the interior bearings by the building code.
- 2 Fasten all plies using 3 rows of 10d Box nails (.128x3") at 12" o.c. Maximum end distance not to exceed 6".
- 3 Refer to last page of calculations for fasteners required for specified loads.
- 4 Girders are designed to be supported on the bottom edge only.
- 5 Top loads must be supported equally by all plies.
- 6 Top must be laterally braced at a maximum of 4' 3/8" o.c.
- 7 Bottom must be laterally braced at end bearings.
- 8 Lateral slenderness ratio based on single ply width

I	ID	Load Type	Location	Trib Width	Side	Dead 0.9	Live 1	Snow 1.15	Wind 1.6	Const. 1.25	Comments
ı	1	Tie-In	0-0-0 to 22-6-0	0-6-0	Far Face	15 PSF	40 PSF	0 PSF	0 PSF	0 PSF	1' Floor
ı	2	Part. Uniform	0-0-0 to 11-7-8		Тор	120 PLF	0 PLF	0 PLF	0 PLF	0 PLF	Wall
ı	3	Part. Uniform	0-0-0 to 11-4-0		Near Face	79 PLF	0 PLF	79 PLF	0 PLF	0 PLF	M2
ı	4	Part. Uniform	0-0-0 to 11-0-0		Тор	341 PLF	0 PLF	341 PLF	0 PLF	0 PLF	A2

Continued on page 2...

#### Notes

Calculated Structured Designs is responsible only of the structural adequacy of this component based on the design criteria and loadings shown. It is the responsibility of the customer and/or the contractor to ensure the component suitability of the intended application, and to verify the dimensions and loads.

- Dry service conditions, unless noted otherwise
   LVL not to be treated with fire retardant or corrosive
- Handling & Installation
- LVL beams must not be out or drilled
  Refer to manufacturer's product information
  regarding installation requirements, multi-ply
  fastening details, beam strength values, and code
  approvals
  Damaged Beams must not be used

- Design assumes top edge is laterally restrained
  Provide lateral support at bearing points to avoid
  lateral displacement and rotation
- For flat roofs provide proper drainage to prevent ponding

This design is valid until 11/3/2024

Metsä Wood 301 Merritt 7 Building, 2nd Floor Norwalk, CT 06851 (800) 622-5850 www.metsawood.com/us

Manufacturer Info







Weaver Homes

Project:

Address: Gaston II (181035B) Date: 1/17/2023

Input by: Marshall Naylor Job Name: Gaston II (181035B) Page 2 of 3


Project #:

Kerto-S LVL FB2

1.750" X 24.000"

3-Ply - PASSED

Level: Level

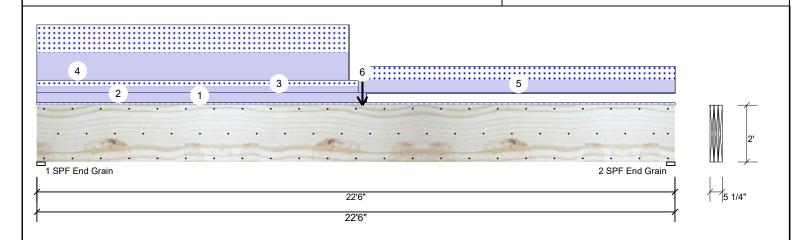

Continued	.Continued from page 1										
ID	Load Type	Location	Trib Width	Side	Dead 0.9	Live 1	Snow 1.15	Wind 1.6	Const. 1.25	Comments	
5	Part. Uniform	11-4-0 to 22-6-0		Near Face	164 PLF	0 PLF	164 PLF	0 PLF	0 PLF	M3	
6	Point	11-5-12		Тор	2293 lb	0 lb	2293 lb	0 lb	0 lb	B2	
	Bearing Length	0-3-8									
	Self Weight				28 PLF						

### Notes

Calculated Structured Designs is responsible only of the structural adequacy of this component based on the design criteria and loadings shown. It is the responsibility of the customer and/or the contractor to ensure the component suitability of the intended application, and to verify the dimensions and loads.

Dry service conditions, unless noted otherwise
 LVL not to be treated with fire retardant or corrosive

## Handling & Installation

Handling & Installation

1. IVI. beams must not be cut or drilled

2. Refer to manufacturer's product information regarding installation requirements, multi-ply fastening details, beam strength values, and code approvals

3. Damaged Beams must not be used

4. Design assumes top edge is laterally restrained

5. Provide lateral support at bearing points to avoid lateral displacement and rotation

For flat roofs provide proper drainage to prevent ponding

This design is valid until 11/3/2024

Metsä Wood 301 Merritt 7 Building, 2nd Floor Norwalk, CT 06851 (800) 622-5850 www.metsawood.com/us

Manufacturer Info







Weaver Homes

Project:

Address: Gaston II (181035B) Date: 1/17/2023

Input by: Marshall Naylor Job Name: Gaston II (181035B) Page 3 of 3


Project #:

Kerto-S LVL FB<sub>2</sub>

1.750" X 24.000"

3-Ply - PASSED

Level: Level

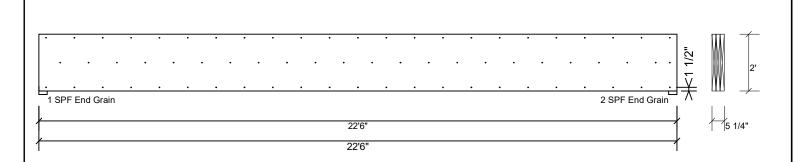

### Multi-Ply Analysis

Fasten all plies using 3 rows of 10d Box nails (.128x3") at 12" o.c.. Nail from both sides. Maximum end distance not to exceed

Capacity	77.4 %
Load	218.7 PLF
Yield Limit per Foot	282.4 PLF
Yield Limit per Fastener	94.1 lb.
Yield Mode	IV
Edge Distance	1 1/2"
Min. End Distance	3"
Load Combination	D+S
Duration Factor	1.15

### Notes

Calculated Structured Designs is responsible only of the structural adequacy of this component based on the design criteria and loadings shown. It is the responsibility of the customer and/or the contractor to ensure the component suitability of the intended application, and to verify the dimensions and loads.

- Dry service conditions, unless noted otherwise
   LVL not to be treated with fire retardant or corrosive

## Handling & Installation

- Handling & Installation

  1. IVI beams must not be cut or drilled

  2. Refer to manufacturer's product information regarding installation requirements, multi-ply fastening details, beam strength values, and code approvals

  3. Damaged Beams must not be used

  4. Design assumes top edge is laterally restrained

  5. Provide lateral support at bearing points to avoid lateral displacement and rotation

For flat roofs provide proper drainage to prevent ponding

This design is valid until 11/3/2024

Metsä Wood 301 Merritt 7 Building, 2nd Floor Norwalk, CT 06851 (800) 622-5850 www.metsawood.com/us

Manufacturer Info







Address:

Project:

Date: 1/17/2023

Input by: Marshall Naylor Job Name: Gaston II (181035B)

Project #:

Kerto-S LVL FB1


1.750" X 14.000"


Weaver Homes

Gaston II (181035B)

2-Ply - PASSED

Level: Level

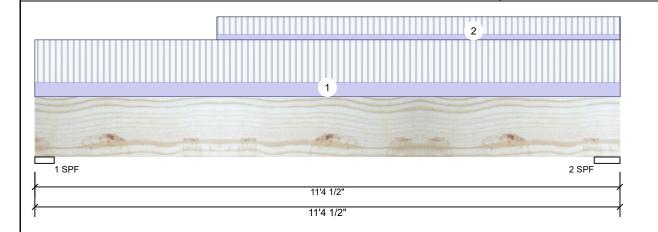

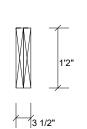

Page 1 of 1

#### Member Information

Type:	Girder
Plies:	2
Moisture Condition:	Dry
Deflection LL:	480
Deflection TL:	360
Importance:	Normal - II
Temperature:	Temp <= 100°F

Application: Floor Design Method: ASD **Building Code:** IBC 2012

Load Sharing: No Deck: Not Checked

Reactions	UNPATTERNED I	b (Uplift)

Brg	Direction	Live	Dead	Snow	Wind	Const
1	Vertical	2129	771	0	0	0
2	Vertical	2523	904	0	0	0

### **Bearings**

Bearing Length	Dir.	Cap. I	React D/L lb	Total	Ld. Case	Ld. Comb.
1 - SPF 4.500"	Vert	43%	771 / 2129	2899	L	D+L
2 - SPF 6.000"	Vert	38%	904 / 2523	3426	L	D+L

#### Analysis Results

Analysis	Actual	Location	Allowed	Capacity	Comb.	Case
Moment	8168 ft-lb	5'9 3/16"	26999 ft-lb	0.303 (30%)	D+L	L
Unbraced	8168 ft-lb	5'9 3/16"	10268 ft-lb	0.795 (80%)	D+L	L
Shear	2421 lb	9'8 1/2"	10453 lb	0.232 (23%)	D+L	L
LL Defl inch	0.090 (L/1419)	5'8 3/16"	0.266 (L/480)	0.338 (34%)	L	L
TL Defl inch	0.122 (L/1044)	5'8 3/16"	0.354 (L/360)	0.345 (34%)	D+L	L

### **Design Notes**

- 1 Provide support to prevent lateral movement and rotation at the end bearings. Lateral support may also be required at the interior bearings by the building code.
- 2 Girders are designed to be supported on the bottom edge only.
- 3 Multiple plies must be fastened together as per manufacturer's details.
- 4 Top loads must be supported equally by all plies.
- 5 Top must be laterally braced at end bearings.
- 6 Bottom must be laterally braced at end bearings.
- 7 Lateral slenderness ratio based on single ply width.

ID	Load Type	Location	Trib Width	Side	Dead 0.9	Live 1	Snow 1.15	Wind 1.6	Const. 1.25	Comments
1	Uniform			Тор	106 PLF	318 PLF	0 PLF	0 PLF	0 PLF	F5
2	Part. Uniform	3-6-8 to 11-4-8		Тор	44 PLF	132 PLF	0 PLF	0 PLF	0 PLF	F9
	Self Weight				11 PLF					

#### Notes

Calculated Structured Designs is responsible only of the structural adequacy of this component based on the design criteria and loadings shown. It is the responsibility of the customer and/or the contractor to ensure the component suitability of the intended application, and to verify the dimensions and loads.

- Dry service conditions, unless noted otherwise
   LVL not to be treated with fire retardant or corrosive
- Handling & Installation
- Handling & Installation

  1. UVI beams must not be cut or drilled

  2. Refer to manufacturer's product information regarding installation requirements, multi-ply fastening details, beam strength values, and code approvals

  3. Damaged Beams must not be used

  4. Design assumes top edge is laterally restrained

  5. Provide lateral support at bearing points to avoid lateral displacement and rotation

- 6. For flat roofs provide proper drainage to prevent ponding

This design is valid until 11/3/2024

Metsä Wood 301 Merritt 7 Building, 2nd Floor Norwalk, CT 06851 (800) 622-5850 www.metsawood.com/us

Manufacturer Info







Weaver Homes

Project:


Address: Gaston II (181035B) Date: 1/17/2023


Input by: Marshall Naylor Job Name: Gaston II (181035B)

Project #:

6/0 SLIDER **Kerto-S LVL** 1.750" X 9.250" 2-Ply - PASSED

Level: Level

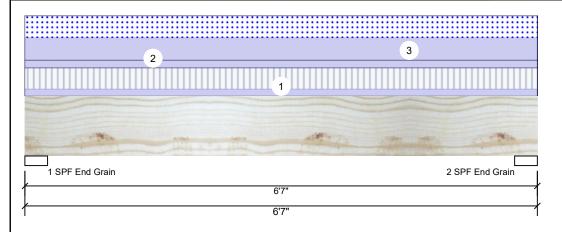

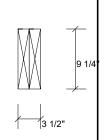

Total Ld Case Ld Comb

Page 1 of 1

#### Member Information

Type:	Girder
Plies:	2
Moisture Condition:	Dry
Deflection LL:	480
Deflection TL:	360
Importance:	Normal - II
Temperature:	Temp <= 100°F

Application: Floor Design Method: ASD **Building Code:** IBC 2012 Load Sharing: No Deck: Not Checked

Read	ctions UNP					
Brg	Direction	Live	Dead	Snow	Wind	Const
1	Vertical	1060	1887	1113	0	0
2	Vertical	1060	1887	1113	0	0

#### Analysis Results

Analysis	Actual	Location	Allowed	Capacity	Comb.	Case
Moment	5009 ft-lb	3'3 1/2"	14423 ft-lb	0.347 (35%)	D+0.75(L+S)	L
Unbraced	5009 ft-lb	3'3 1/2"	10451 ft-lb	0.479 (48%)	D+0.75(L+S)	L
Shear	2387 lb	1' 3/4"	7943 lb	0.300 (30%)	D+0.75(L+S)	L
LL Defl inch	0.042 (L/1741)	3'3 1/2"	0.153 (L/480)	0.276 (28%)	0.75(L+S)	L
TL Defl inch	0.091 (L/807)	3'3 1/2"	0.204 (L/360)	0.446 (45%)	D+0.75(L+S)	L

### **Bearings** Bearing Length Dir.

Dearing	Longui	DII.	Cap. I	Cact D/L ib	iotai	Lu. Casc	Lu. Comb.
1 - SPF End Grain	3.500"	Vert	34%	1887 / 1629	3516	L	D+0.75(L+S)
2 - SPF End Grain	3.500"	Vert	34%	1887 / 1629	3516	L	D+0.75(L+S)

Can React D/L lh

### **Design Notes**

- 1 Provide support to prevent lateral movement and rotation at the end bearings. Lateral support may also be required at the interior bearings by the building code.
- 2 Girders are designed to be supported on the bottom edge only.
- 3 Multiple plies must be fastened together as per manufacturer's details.
- 4 Top loads must be supported equally by all plies.
- 5 Top must be laterally braced at end bearings.

Self Weight

- 6 Bottom must be laterally braced at end bearings.
- 7 Lateral slenderness ratio based on single ply width.

ID	Load Type	Location	Trib Width	Side	Dead 0.9	Live 1	Snow 1.15	Wind 1.6	Const. 1.25	Comments
1	Uniform			Тор	108 PLF	322 PLF	0 PLF	0 PLF	0 PLF	F4
2	Uniform			Тор	120 PLF	0 PLF	0 PLF	0 PLF	0 PLF	WALL
3	Uniform			Тор	338 PLF	0 PLF	338 PLF	0 PLF	0 PLF	A4

7 PLF

#### Notes

Calculated Structured Designs is responsible only of the structural adequacy of this component based on the design criteria and loadings shown. It is the responsibility of the customer and/or the contractor to ensure the component suitability of the intended application, and to verify the dimensions and loads.

- Dry service conditions, unless noted otherwise
   LVL not to be treated with fire retardant or corrosive
- Handling & Installation
- LVL beams must not be out or drilled
  Refer to manufacturer's product information reguriding installation requirements, multi-ply fastening details, beam strength values, and code approvals
  Damaged Beams must not be used
- Design assumes top edge is laterally restrained
  Provide lateral support at bearing points to avoid
  lateral displacement and rotation
- 6. For flat roofs provide proper drainage to prevent ponding

This design is valid until 11/3/2024

Metsä Wood 301 Merritt 7 Building, 2nd Floor Norwalk, CT 06851 (800) 622-5850 www.metsawood.com/us

Manufacturer Info





Project:

Address: Gaston II (181035B) Date: 1/17/2023

Input by: Marshall Naylor Job Name: Gaston II (181035B) Page 1 of 1

Wind

0

O

D+S

Snow

952

1052

2772 L

Const

0


0

Project #:

2 - SPF 3.000"

End Grain Vert

Kerto-S LVL Front GDH 1.750" X 14.000" 2-Ply - PASSED Level: Level

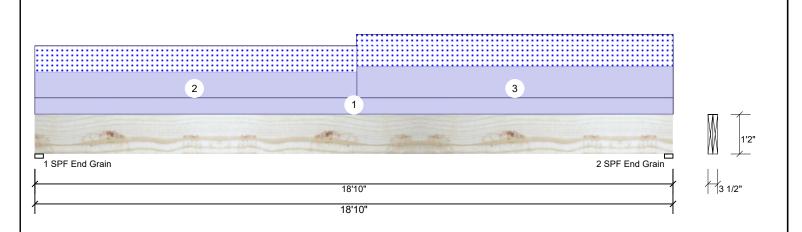

#### Member Information Reactions UNPATTERNED Ib (Uplift) Type: Girder Application: Floor Live Brg Direction Dead Plies 2 Design Method: ASD Vertical 0 1619 1 Moisture Condition: Dry **Building Code:** IBC 2012 O 1720 2 Vertical Deflection LL: 480 Load Sharing: No Deflection TL: 360 Deck: Not Checked Importance: Normal - II Temperature: Temp <= 100°F Rearings

Analysis Results	5
------------------	---

Analysis						
Analysis	Actual	Location	Allowed	Capacity	Comb.	Case
Moment	12090 ft-lb	9'8 7/8"	31049 ft-lb	0.389 (39%)	D+S	L
Unbraced	12090 ft-lb	9'8 7/8"	12128 ft-lb	0.997 (100%)	D+S	L
Shear	2353 lb	17'5"	12021 lb	0.196 (20%)	D+S	L
LL Defl inch	0.184 (L/1202)	9'6 3/16"	0.461 (L/480)	0.399 (40%)	S	L
TL Defl inch	0.491 (L/451)	9'5 13/16"	0.615 (L/360)	0.798 (80%)	D+S	L

### **Design Notes**

1 Provide support to prevent lateral movement and rotation at the end bearings. Lateral support may also be required at the interior bearings by the building code.

Location

0-0-0 to 9-6-0

9-6-0 to 18-10-0

- 2 Girders are designed to be supported on the bottom edge only.
- 3 Multiple plies must be fastened together as per manufacturer's details.
- 4 Top loads must be supported equally by all plies.
- 5 Top must be laterally braced at a maximum of 8'7 13/16" o.c.
- 6 Bottom must be laterally braced at end bearings.

Load Type

Part. Uniform

Part. Uniform

Uniform

7 Lateral slenderness ratio based on single ply width

Dearings	•						
Bearing	Length	Dir.	Сар.	React D/L lb	Total	Ld. Case	Ld. Comb.
1 - SPF End Grain	3.000"	Vert	29%	1619 / 952	2571	L	D+S

1720 / 1052

Dead 0.9 Live 1 Snow 1.15 Wind 1.6 Const. 1.25 Comments 60 PI F 0 PI F 0 PI F 0 PI F 0 PI F wall 0 PLF 0 PLF 96 PLF 0 PLF 96 PLF M2 117 PLF 0 PI F 0 PLF

11 PLF Self Weight

Trib Width

Side

Top

Top

qoT

#### Notes

ID

2

3

Calculated Structured Designs is responsible only of the structural adequacy of this component based on the design criteria and loadings shown. It is the responsibility of the customer and/or the contractor to ensure the component suitability of the intended application, and to verify the dimensions and loads.

Dry service conditions, unless noted otherwise
 LVL not to be treated with fire retardant or corrosive

## Handling & Installation

LVL beams must not be cut or drilled
Refer to manufacturer's product information
regarding installation requirements, multi-ply
fastening details, beam strength values, and code
approvals

Damaged Beams must not be used

Design assumes top edge is laterally restrained
Provide lateral support at bearing points to avoid
lateral displacement and rotation

This design is valid until 11/3/2024

Manufacturer Info 6. For flat roofs provide proper drainage to prevent ponding

117 PLF

Metsä Wood 301 Merritt 7 Building, 2nd Floor Norwalk, CT 06851 (800) 622-5850 www.metsawood.com/us

Comtech, Inc. 1001 S. Reilly Road, Suite #639 Fayetteville, NC USA 28314 910-864-TRUS





0 PLF

М3



Project:


Address: Gaston II (181035B) Date: 1/17/2023


Input by: Marshall Naylor Job Name: Gaston II (181035B)

Project #:

Window Hdr. **Kerto-S LVL** 1.750" X 14.000" 2-Ply - PASSED

Level: Level

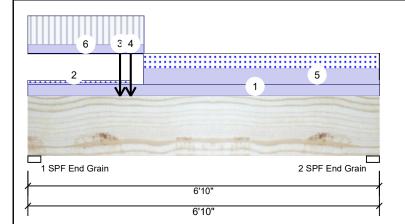

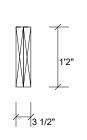

Page 1 of 2

#### Member Information

Type: Girder Plies 2 Moisture Condition: Dry Deflection LL: 480 Deflection TL: 360 Importance: Normal - II Temperature: Temp <= 100°F

Application: Floor Design Method: ASD **Building Code:** IBC 2012 Load Sharing: No Deck: Not Checked Reactions UNPATTERNED Ib (Uplift) Wind Brg Direction Live Dead Snow Const Vertical 2861 3387 1990 0 0 1 873 1906 O 0 2 Vertical 1168

# Analysis Results

Analysis Actual Location Allowed Comb. Case Capacity 11172 ft-lb 2' 31049 ft-lb 0.360 (36%) D+0.75(L+S) L Moment Unbraced 11172 ft-lb 2' 15767 ft-lb 0.709 (71%) D+0.75(L+S) L 6407 lb 1'5" 12021 lb 0.533 (53%) D+0.75(L+S) L Shear LL Defl inch 0.033 (L/2343) 2'7 5/8" 0.161 (L/480) 0.205 (20%) 0.75(L+S) L TL Defl inch 0.067 (L/1165) 2'8 7/8" 0.215 (L/360) 0.309 (31%) D+0.75(L+S) L

# **Bearings**

Bearing Length Dir. Cap. React D/L lb Total Ld. Case Ld. Comb. D+0.75(L+S) 1 - SPF 3.000" Vert 3387 / 3638 7025 I End Grain 1906 / 1531 3437 L D+0.75(L+S)

End Grain

2 - SPF 3.000"

Vert

### **Design Notes**

- 1 Provide support to prevent lateral movement and rotation at the end bearings. Lateral support may also be required at the interior bearings by the building code.
- 2 Girders are designed to be supported on the bottom edge only.
- 3 Multiple plies must be fastened together as per manufacturer's details.
- 4 Top loads must be supported equally by all plies.
- 5 Top must be laterally braced at end bearings.
- 6 Bottom must be laterally braced at end bearings.
- 7 Lateral slenderness ratio based on single ply width.

ID	Load Type	Location	Trib Width	Side	Dead 0.9	Live 1	Snow 1.15	Wind 1.6	Const. 1.25	Comments	
1	Uniform			Тор	120 PLF	0 PLF	0 PLF	0 PLF	0 PLF	WALL	
2	Tie-In	0-0-0 to 2-0-0	1-0-0	Тор	20 PSF	0 PSF	20 PSF	0 PSF	0 PSF	2' ROOF	
3	Point	1-9-8		Тор	1040 lb	3115 lb	0 lb	0 lb	0 lb	F08	
	Bearing Length	0-3-8									
4	Point	2-0-0		Тор	2385 lb	0 lb	2385 lb	0 lb	0 lb	C3	
	Bearing Length	0-3-8									

Continued on page 2...

#### Notes

Calculated Structured Designs is responsible only of the structural adequacy of this component based on the design criteria and loadings shown. It is the responsibility of the customer and/or the contractor to ensure the component suitability of the intended application, and to verify the dimensions and loads.

- Dry service conditions, unless noted otherwise
   LVL not to be treated with fire retardant or corrosive
- Handling & Installation
- LVL beams must not be cut or drilled Refer to manufacturer's product information regarding installation requirements, multi-ply fastening details, beam strength values, and code
- Damaged Beams must not be used
- Design assumes top edge is laterally restrained
  Provide lateral support at bearing points to avoid
  lateral displacement and rotation
- 6. For flat roofs provide proper drainage to prevent ponding

Metsä Wood 301 Merritt 7 Building, 2nd Floor Norwalk, CT 06851 (800) 622-5850 www.metsawood.com/us

Manufacturer Info

Comtech, Inc. Comtech, Inc. 1001 S. Reilly Road, Suite #639 Fayetteville, NC USA 28314 910-864-TRUS



This design is valid until 11/3/2024 CSD DESIGN



Project: Address:

Gaston II (181035B)


Date: 1/17/2023


Input by: Marshall Naylor Job Name: Gaston II (181035B)

Project #:

Window Hdr. **Kerto-S LVL** 1.750" X 14.000" 2-Ply - PASSED

Level: Level

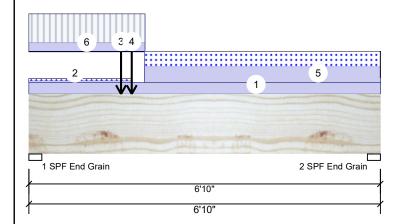

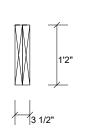

Page 2 of 2

Continued	from	nage	1

ID	Load Type	Location	Trib Width	Side	Dead 0.9	Live 1	Snow 1.15	Wind 1.6	Const. 1.25	Comments	
5	Part. Uniform	2-3-0 to 6-10-0		Тор	160 PLF	0 PLF	160 PLF	0 PLF	0 PLF	C2	
6	Part. Uniform	2-3-0 to 0-0-0		Тор	97 PLF	300 PLF	0 PLF	0 PLF	0 PLF	F07	
	Self Weight				11 PLF						

### Notes

Calculated Structured Designs is responsible only of the structural adequacy of this component based on the design criteria and loadings shown. It is the responsibility of the customer and/or the contractor to ensure the component suitability of the intended application, and to verify the dimensions and loads.

Dry service conditions, unless noted otherwise
 LVL not to be treated with fire retardant or corrosive

Handling & Installation

Handling & Installation

1. IVI. beams must not be cut or drilled

2. Refer to manufacturer's product information regarding installation requirements, multi-ply fastening details, beam strength values, and code approvals

3. Damaged Beams must not be used

4. Design assumes top edge is laterally restrained

5. Provide lateral support at bearing points to avoid lateral displacement and rotation

For flat roofs provide proper drainage to prevent ponding

Metsä Wood 301 Merritt 7 Building, 2nd Floor Norwalk, CT 06851 (800) 622-5850 www.metsawood.com/us

Manufacturer Info





Project:


Address: Gaston II (181035B) Date: 1/17/2023


Input by: Marshall Naylor Job Name: Gaston II (181035B)

Project #:

1.750" X 11.875" GDH-3 **Kerto-S LVL** 2-Ply - PASSED

Level: Level

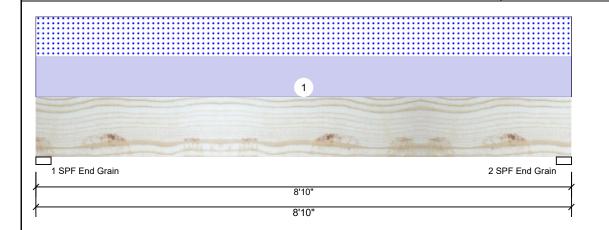

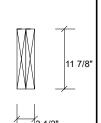

Page 1 of 1

N	10	mh	or	Info	rm	atio	n
I١	леі	mb	er	INTC	rm	atio	om

Type: Girder Plies: 2 Moisture Condition: Dry Deflection LL: 480 Deflection TL: 360 Importance: Normal - II Temperature: Temp <= 100°F Application: Floor Design Method: ASD **Building Code:** IBC 2012 Load Sharing: No Deck:

Not Checked

	PATTERNE	D lb (	(Uplift)	
<u>.</u>	 	_		_

Brg	Direction	Live	Dead	Snow	Wind	Const
1	Vertical	0	1145	1104	0	0
2	Vertical	0	1145	1104	0	0

### **Analysis Results**

Analysis	Actual	Location	Allowed	Capacity	Comb.	Case
Moment	4554 ft-lb	4'5"	22897 ft-lb	0.199 (20%)	D+S	L
Unbraced	4554 ft-lb	4'5"	10675 ft-lb	0.427 (43%)	D+S	L
Shear	1627 lb	1'2 7/8"	10197 lb	0.160 (16%)	D+S	L
LL Defl inch	0.036 (L/2845)	4'5 1/16"	0.211 (L/480)	0.169 (17%)	S	L
TL Defl inch	0.073 (L/1397)	4'5 1/16"	0.282 (L/360)	0.258 (26%)	D+S	L

### **Bearings**

Bearing Length Dir. Cap. React D/L lb Total Ld. Case Ld. Comb. 1 - SPF 3.000" 1145 / 1104 D+S Vert 2249 L End Grain 1145 / 1104 2249 L D+S 2 - SPF 3.000" Vert 26% End Grain

### **Design Notes**

- 1 Provide support to prevent lateral movement and rotation at the end bearings. Lateral support may also be required at the interior bearings by the building code.
- 2 Girders are designed to be supported on the bottom edge only.
- 3 Multiple plies must be fastened together as per manufacturer's details.
- 4 Top loads must be supported equally by all plies.
- 5 Top must be laterally braced at end bearings.
- 6 Bottom must be laterally braced at end bearings.
- 7 Lateral slenderness ratio based on single ply width.

ID Load Type Trib Width Side Dead 0.9 Comments Location Live 1 Snow 1.15 Wind 1.6 Const. 1.25 1 Uniform Top 250 PLF 0 PLF 250 PLF 0 PLF 0 PLF

> Self Weight 9 PLF

#### Notes

Calculated Structured Designs is responsible only of the structural adequacy of this component based on the design criteria and loadings shown. It is the responsibility of the customer and/or the contractor to ensure the component suitability of the intended application, and to verify the dimensions and loads.

- Dry service conditions, unless noted otherwise
   LVL not to be treated with fire retardant or corrosive

## Handling & Installation

- LVL beams must not be cut or drilled Refer to manufacturer's product information regarding installation requirements, multi-ply fastening details, beam strength values, and code approvals Damaged Beams must not be used
- Design assumes top edge is laterally restrained Provide lateral support at bearing points to avoid lateral displacement and rotation

For flat roofs provide proper drainage to prevent ponding

Metsä Wood 301 Merritt 7 Building, 2nd Floor Norwalk, CT 06851 (800) 622-5850 www.metsawood.com/us

Comtech, Inc. 1001 S. Reilly Road, Suite #639 Fayetteville, NC USA 28314 910-864-TRUS



Manufacturer Info