

HTE# _____

Harnett County Department of Public Health

No. 26591

PERMIT # SFD 2306-0030

Operation Permit

New Installation Septic Tank Nitrification Line Repair Expansion

PROPERTY LOCATION: 2777 Lemuel Block Rd (SR 1125)

Name: (owner) Onsite Homes SUBDIVISION _____ LOT # _____

System Installer: Yellow Dog Registration # _____


Basement with plumbing: Garage Number of Bedrooms 4

Type of Water Supply: Community Public Well Distance from well _____ feet

System Type: Type III G Types V and VI Systems expire in 5 years.

(In accordance with Table V a) Owner must contact Health Department 6 months prior to expiration for permit renewal.

This system has been installed in compliance with applicable North Carolina General Statutes, Rules for Sewage Treatment and Disposal, and all conditions of the Improvement Permit and Construction Authorization.

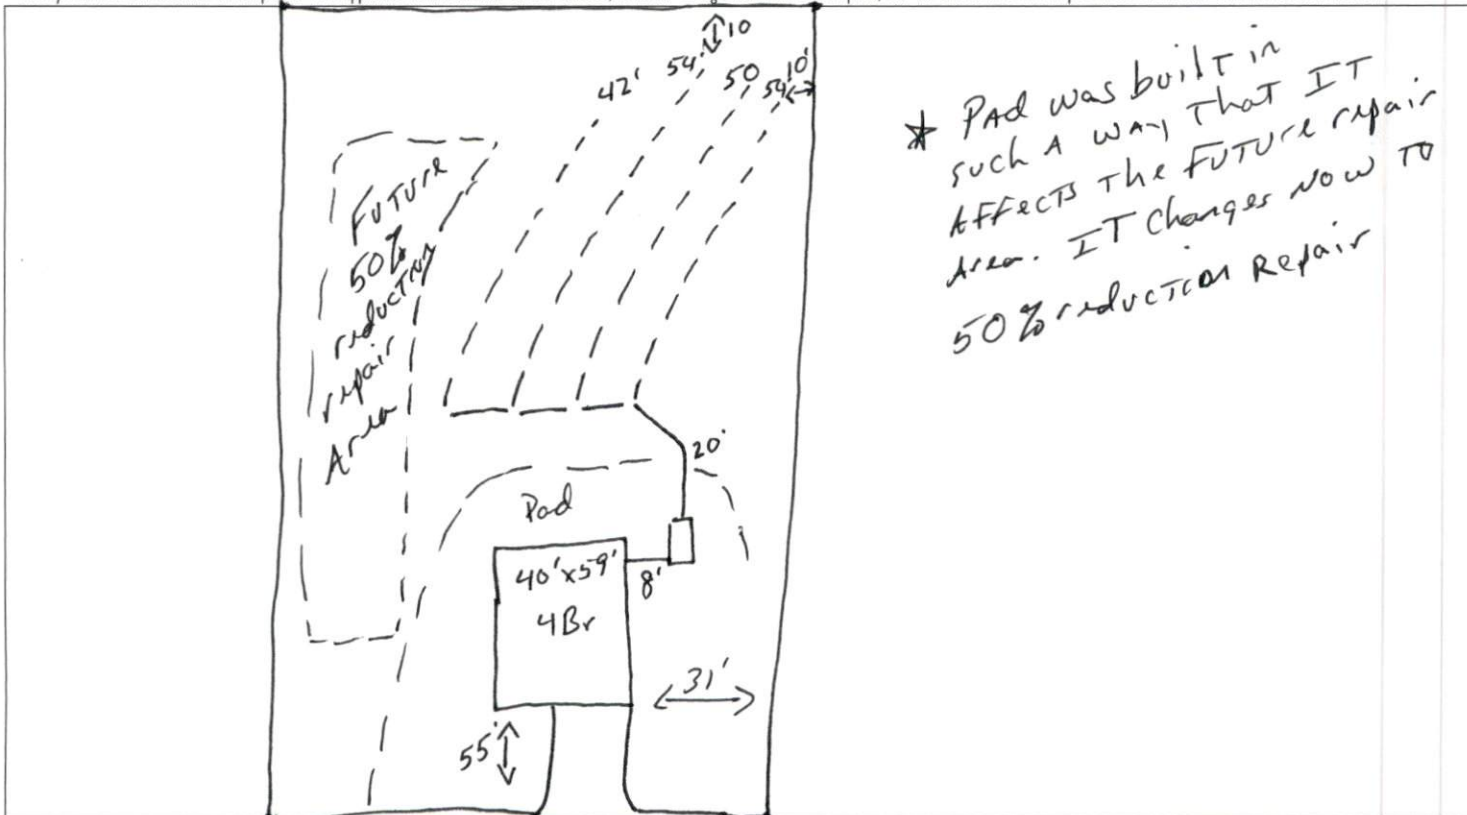

* Pad was built in such a way that IT AFFECTS THE FUTURE repair Area. IT changes now TO 50% reduction repair

PERMIT CONDITIONS:

I. Performance: System shall perform in accordance with Rule .1961.

II. Monitoring: As required by Rule .1961.

III. Maintenance: As required by Rule .1961. Other: _____

Subsurface system operator required? Yes No

If yes, see attached sheet for additional operation conditions, maintenance and reporting.

IV. Operation: _____

V. Other: _____

D-Box Pump Alarm H2O Line PWR Line

Following are the specifications for the sewage disposal system on the above captioned property.

Type of system: Conventional Other 25% reduction IQU Septic Tank: 1000 gallons Pump Tank: _____ gallons

Subsurface Drainage Field No. of ditches 1 exact length of each ditch 200 feet width of ditches 3 feet depth of ditches 22 inches

French Drain Required: _____ Linear feet

Authorized State Agent Mel RETH Date 4-9-24