

VICINITY MAP
 ~ 15 Jones Creek Ln., Lillington ~
 Lot 1, Jones Creek Meadows
 Map #2023-266 & 267


~ Foundation Survey ~
Signature Home Builders Inc.

Upper Little River Twp. - Harnett County
 Scale: 1" = 50' Date: Aug. 21, 2023

Surveyed & Mapped By
STREAMLINE LAND SURVEYING, Inc.
 NC FIRM C-1898
 870 NC 55 W, Coats, N.C. 27521
 Phone: 910-897-7715

I hereby certify that the foundation location shown hereon is correct in relation to property lines of record.
 NOTE: The purpose of this survey is to locate the newley constructed foundation.
 Other features, fixtures, encumbrances and indications of use may be revealed by a complete site survey.

NOT FOR RECORDATION

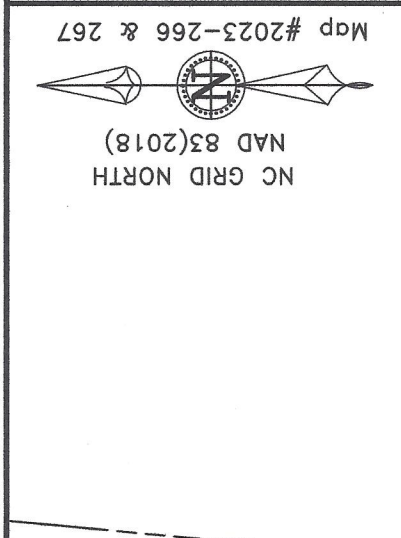

Impervious Surface Limit:
 9,501 SF per lot

Note:
 Foundation Location based upon nails set in concrete footing for brick masons on August 16th, 2023. As-built dimensions of foundation confirmed on this date.

0 25' 50' 100'
 GRAPHIC SCALE

LEGEND:

- Subject Boundary Line
- Adjoining Boundary Line
- - - R/W Right-of-Way Line
- - - C/L Centerline
- - - Minimum Building Line
- - - Survey tie lines
- - - Calculated Point
- - - Existing Re-Bar Stake
- - - Below/Above Grade
- - - Fire Hydrant
- - - Water Meter
- - - Water Valve
- - - Sanitary Sewer Clean-Out
- - - Telephone Pedestal

▲ CP
 ERB
 BG/AG
 FH
 WM
 WV
 SS
 TP

