

Harnett County Department of Public Health

PERMIT # SFD 2308-0195

Operation Permit

New Installation Septic Tank Nitrification Line Repair Expansion

PROPERTY LOCATION: 262 Hook Drive, Fuquay

Name: (owner) Paramount Homes Inc SUBDIVISION Cotton Farms LOT # 12

System Installer: Jwind Cardenas

Basement with plumbing: Garage Number of Bedrooms 4


Type of Water Supply: Community Public Well Distance from well _____ feet

System Type: 25% Reduction Type III (b) EZ Flow Types V and VI Systems expire in 5 years.

(In accordance with Table V a)

Owner must contact Health Department 6 months prior to expiration for permit renewal.

This system has been installed in compliance with applicable North Carolina General Statutes, Rules for Sewage Treatment and Disposal, and all conditions of the Improvement Permit and Construction Authorization.

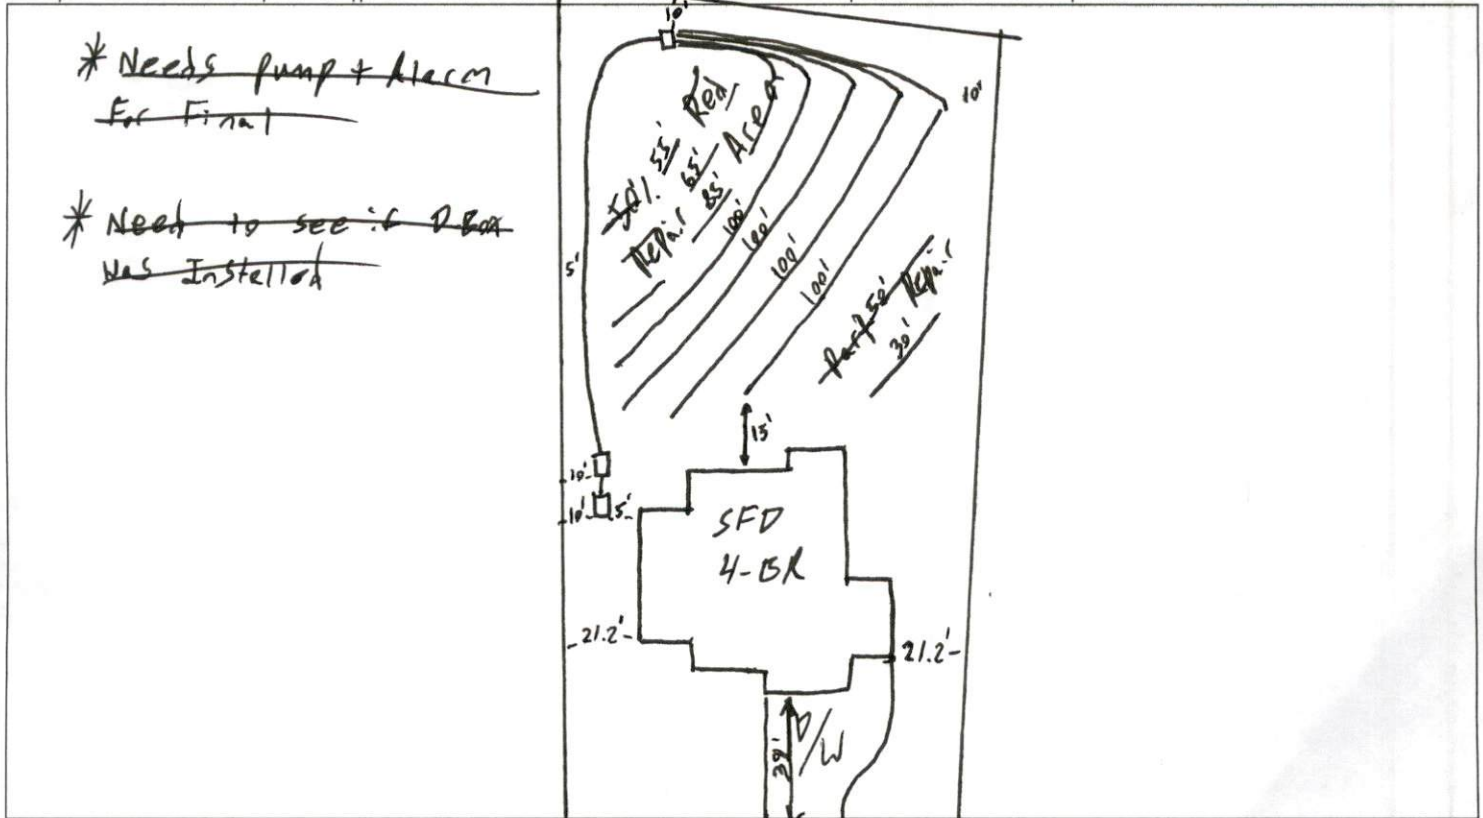

** Needs pump + Alarm For Final*

** Need to see if D-Box was installed*

PERMIT CONDITIONS:

- I. Performance: System shall perform in accordance with Rule .1961.
- II. Monitoring: As required by Rule .1961.
- III. Maintenance: As required by Rule .1961. Other: _____
Subsurface system operator required? Yes No
If yes, see attached sheet for additional operation conditions, maintenance and reporting.
- IV. Operation: _____
- V. Other: _____

D-Box Pump Alarm H2O Line PWR Line

Following are the specifications for the sewage disposal system on the above captioned property.

Type of system: Conventional Other Type III (b) EZ Flow Septic Tank: 1,000 gallons Pump Tank: 1,000 gallons
Subsurface No. of exact length width of depth of
Drainage Field ditches 4 of each ditch 100' feet ditches 3 feet ditches 15"-16" inches
French Drain Required: _____ Linear feet

Authorized State Agent [Signature] REHS Date 7-29-24