


Reese Construction LLC
D.B. 3912, Page 977
Map #2023-200

R L Johnson Family
D.B. 2503, Page 668
Map #2008-381

Southern Tide Homes
D.B. 4200, Page 1504
Map #2023-200

NC Grid NAD 83(2011)
DB2023, Page 200-207

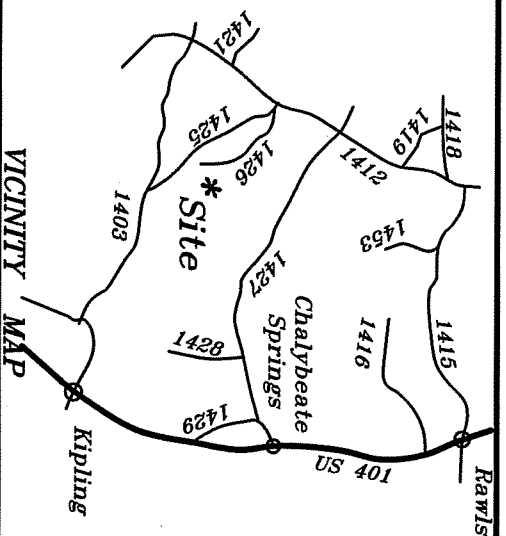

VICINITY MAP

143 Hook Dr. Fuguyay Varina, NC
Lot #23 Cotton Farms Ph 1
Map Number 2023-200
PIN: 0643-36-4306

Surveyed & Mapped for:
Southern Tide Homes
Clayton Roberts

11917 NC HWY 210 Benson, NC 27504
Hector's Creek Twp. Harnett County
Scale: 1" = 40' Date: 2-6-2024

Surveyed & Mapped By
STANCI & ASSOCIATES
Professional Land Surveyor, P.A. C-0831
P.O. Box 730, Angier, N.C. 27501
919-639-2133 919-639-2602 (FAX)
stancilsurvey@gmail.com

SEAL OF THE PROFESSIONAL LAND SURVEYOR
NORTH CAROLINA
THOMAS LESTER STANCI
NOT FOR RECORDATION

Lester Stancil & Associates, P.L.S.,P.A.

98 E. Depot St.
 PO Box 730
 Angier, NC 27501

Invoice

Date	Invoice #
2/6/2024	2023-0289

Bill To
Clayton Roberts Southern Tide Homes 11917 NC Hwy. 210 Benson, NC 27504

P.O. No.	Terms	Project
		Lot 23, Cotton Farm...

Hours	Rate	Date	Description	Amount
1	50.00	8/28/2023	Mapping & Computation site plan	50.00
3.5	125.00	9/1/2023	Surveying lot survey, stake bldg. env.	437.50
0.5	90.00	9/5/2023	Mapping & Computation edit/reduce raw data, translate/rotate. [;pt utilities, etc.	45.00
4	125.00	1/2/2024	Surveying stake for footings	500.00
0.25	90.00	1/2/2024	Mapping & Computation point map etc. to stake for footings	22.50
0.25	90.00	1/3/2024	Mapping & Computation ck. save stakes for footings	22.50
2	125.00	2/6/2024	Surveying as built foundation; set irons	250.00
1.25	90.00	2/6/2024	Mapping & Computation point map & download for fdtn. survey	112.50

Total		\$1,440.00
Payments/Credits		\$0.00
Balance Due		\$1,440.00

Phone #
919-639-2133