## Harnett County Department of Public Health

	namete sound, population of rapid	
PERMIT # SFDZ		
	New Installation ≥ Septic Tank ≥ Nitrification Line □ Repair □ Expansi  PROPERTY LOCATION: 257 Bucon 4.11 Pd (SR 1291)	on
	PROPERTY LOCATION: 237 Blacon 4,11 Rd (SR 1291)	+
	New Home Inc SUBDIVISION Duncars Cruck LOT # 19	-
System Installer:	g: Garage Number of Bedrooms 4 (8people)	
Basement with plumbin Type of Water Supply:		
System Type:	Types V and VI Systems expire in 5 years.	
(In accordance with Tal		
This system has been installe	d in compliance with applicable North Carolina General Statutes, Rules for Sewage Treatment and Disposal, and all conditions of the Improvement Permit and Construction Authorization.	
7	FUTUR 25% SYSTEM INSTALLED on 2-9-2  M. Obborn  Ludy Total Drain line  240' Total Drain line  Length	4
	60'	
	V	
PERMIT CONDITIONS:	Beacon Hill	
<ol> <li>Performance:</li> <li>Monitoring:</li> </ol>	System shall perform in accordance with Rule .1961. As required by Rule .1961.	
III. Maintenance:	As required by Rule .1961. Other:	
	Subsurface system operator required? Yes  No	
W O ··	If yes, see attached sheet for additional operation conditions, maintenance and reporting.	
IV. Operation:		
V. Other:		
×	D-Box	Lin
	fications for the sewage disposal system on the above captioned property.  Conventional $\bigcirc$ Other $25\%$ reduction $\bigcirc$ $\bigcirc$ $\bigcirc$ Septic Tank: $\bigcirc$ gallons Pump Tank: $\bigcirc$ gallons of exact length width of depth of ditches $\bigcirc$ of each ditch $\bigcirc$ feet ditches $\bigcirc$ feet ditches $\bigcirc$ inches	ns
French Drain Required:	Linear feet	

Authorized State Agent Mol de 145

Duncann's Creek - Lot #19
4-Bedroom - 480 gallon/day Septic Design
257 Beacon Hill Road - Lillington NC
New Homes, Inc.

Harnett County PIN: 0630-24-4081

"As Built" - Revision

\*Not a Survey Sketched from a plot plan supplied by owner

System: Gravity to D-Box

Lines: 1-4 (240')

0.6 LTAR

24" Max Trench Bottom Accepted Status System Repair: Gravity to D-Box

Lines: 5-7 (240') 0.6 LTAR


24" Max Trench Bottom Accepted Status System

\*\*1000 Gallon Septic and Pump Tank
Tank and trenches to be located minimum of 10'
from any property line and minimum of 5'
from any building foundation.

\*Do Not Cut, Fill, or Alter Drainfield or Repair Area

\*Comply with all setbacks

\*Contact local health dept. and/or Alex Adams prior to or during installation with any questions or concerns.

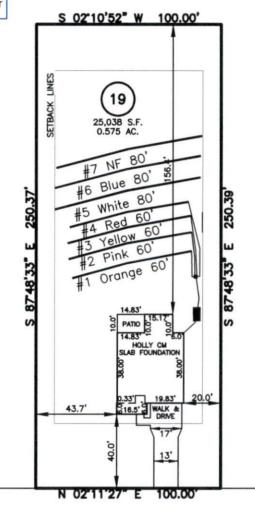

BEACON HILL ROAD 50' PUBLIC R/W

Adams
Soil Consulting
919-414-6761
Job #1769
9-25-23

