## CAROLINA SEASONS K3 - 279 PONDEROSA TRAIL, CAMERON

ELEVATION NOTES:
GRADE ELEVATIONS SHOWN DO NOT NECESSARILY REFER TO THIS OR ANY OTHER LOT. THEY ARE
FOR DIAGRAMMATIC PURPOSES ONLY AND MAY VARY. BUILDER IS RESPONSIBLE FOR ADAPTING THIS PLAN
TO SUIT THE EXISTING TOPOGRAPHY OF THE SITE.

ROOF VENTILATION TO BE DETERMINED BY BUILDER AS PER CODE.

ALL EGRESS OR RESCUE WINDOWS FROM SLEEPING ROOMS MUST HAVE A MIN.
NET CLEAR OPENING OF 4.0 SQ FT. THE MIN NET CLEAR OPENING HEIGHT
DIMENSION SHALL BE 22". THE MIN NET CLEAR OPENING WIDTH SHALL BE 20".

EACH EGRESS WINDOW FROM SLEEPING ROOMS MUST HAVE A SILL HIGHT OF
NO MORE THAN 44" FROM THE FLOOR. ALL WINDOW SIZES ARE NOMINAL AND
ARE TO BE VERIFIED WITH MANUFACTURER FOR AVAILABILITY AND CONFORMITY
TO STATE AND LOCAL CODE REQUIREMENTS.

PORCHES, BALCONIES, OR RAISED FLOOR SURFACES LOCATED MORE THAN 30"
ABOVE THE FLOOR OR GRADE BELOW SHALL HAVE GUARDRAILS NOT LESS THAN
32" IN HEIGHT.

I ASSUME NO RESPONSIBILITY FOR ANY DISTANCES AFTER START OF CONSTRUCTION.

CONTRACTOR/BUILDER SHALL CONSULT WITH HOME OWNER ON ALL INTERIOR AND EXTERIOR MOLDINGS, TRIMS, COLORS, FINISHES, CABINET LAYOUTS, AND MANUFACTORS BEFORE CONSTRUCTION BEGINS.


ALL BEAMS AND FRAMING MEMBERS ARE SIZED BY OTHERS.


1.1 This plan has been drawn to comply with the 2018 NC Building Code


1.2 Minimum Design Loads for Building and Other Structures ASCE 7-9B Roof Dead Load 3 Roof Live Load 20 PSF 4 Typical Floor Dead Load 10 PSF 5 Floor Live Loads 5.1 Rooms other than sleeping rooms 40 PSF 5.2 Sleeping Rooms 30 PSF 5.3 Stairs 40 PSF 5.4 Decks 40 PSF 5.5 Exterior Balconies 60 PSF 6 Wind Loads 6.1 Ultimate Design Wind Speeds 15 MPH 6.2 Wind Importance Factor, IW 1.00 6.3 Exposure B 6.4 Walls (Component and Cladding) 25 PSF 6.5 Roofs (Component and Cladding) 6.5.1 Roof Slopes 2.25/12 to 7/12 34.8 PSF 6.5.2 Roof Slopes 7/12 to 12/12 21 PSF

It is the sole responsibility of the Contractor and/or Builder to conform to all standards, provisions, requirements, methods of construction and uses of materials provided in buildings and/or structures as required by NC Uniform Building Code, Local Agencies and in accordance with good engineering practices. Verify all dimensions prior to construction.

CRH HOMES RETAINS TITLE AND
OWNERSHIP OF ALL PLANS, THESE PLANS CAN NOT BE COPIED
OR REPRODUCED, THESE PLANS CAN NOT BE BUILT BY
ANYONE BUILDER OTHER THAN CRH HOMES

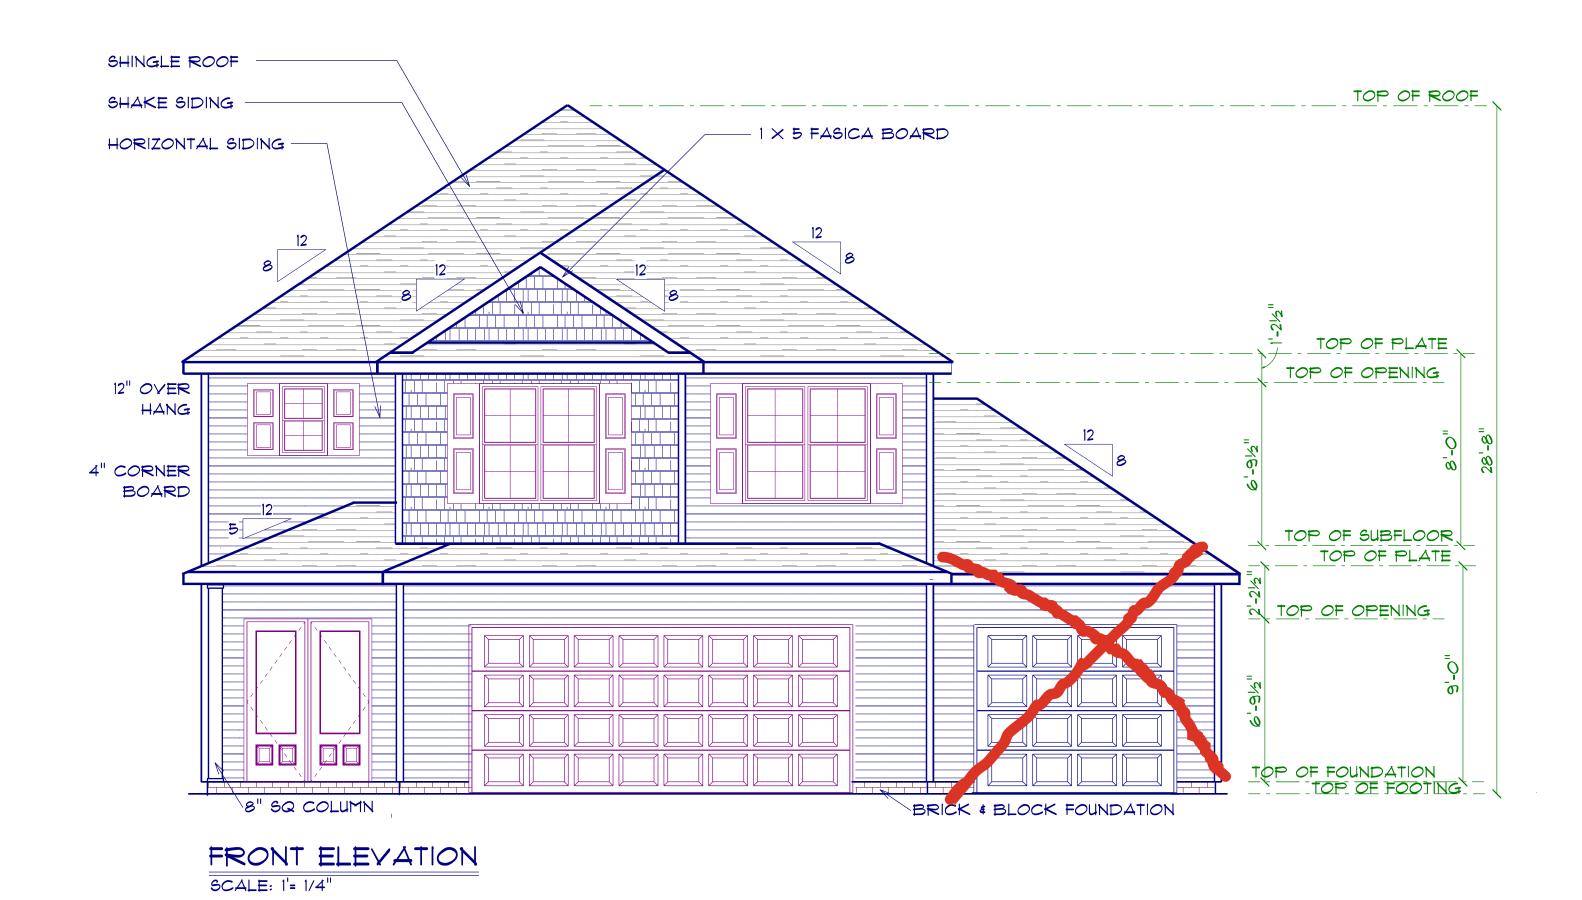


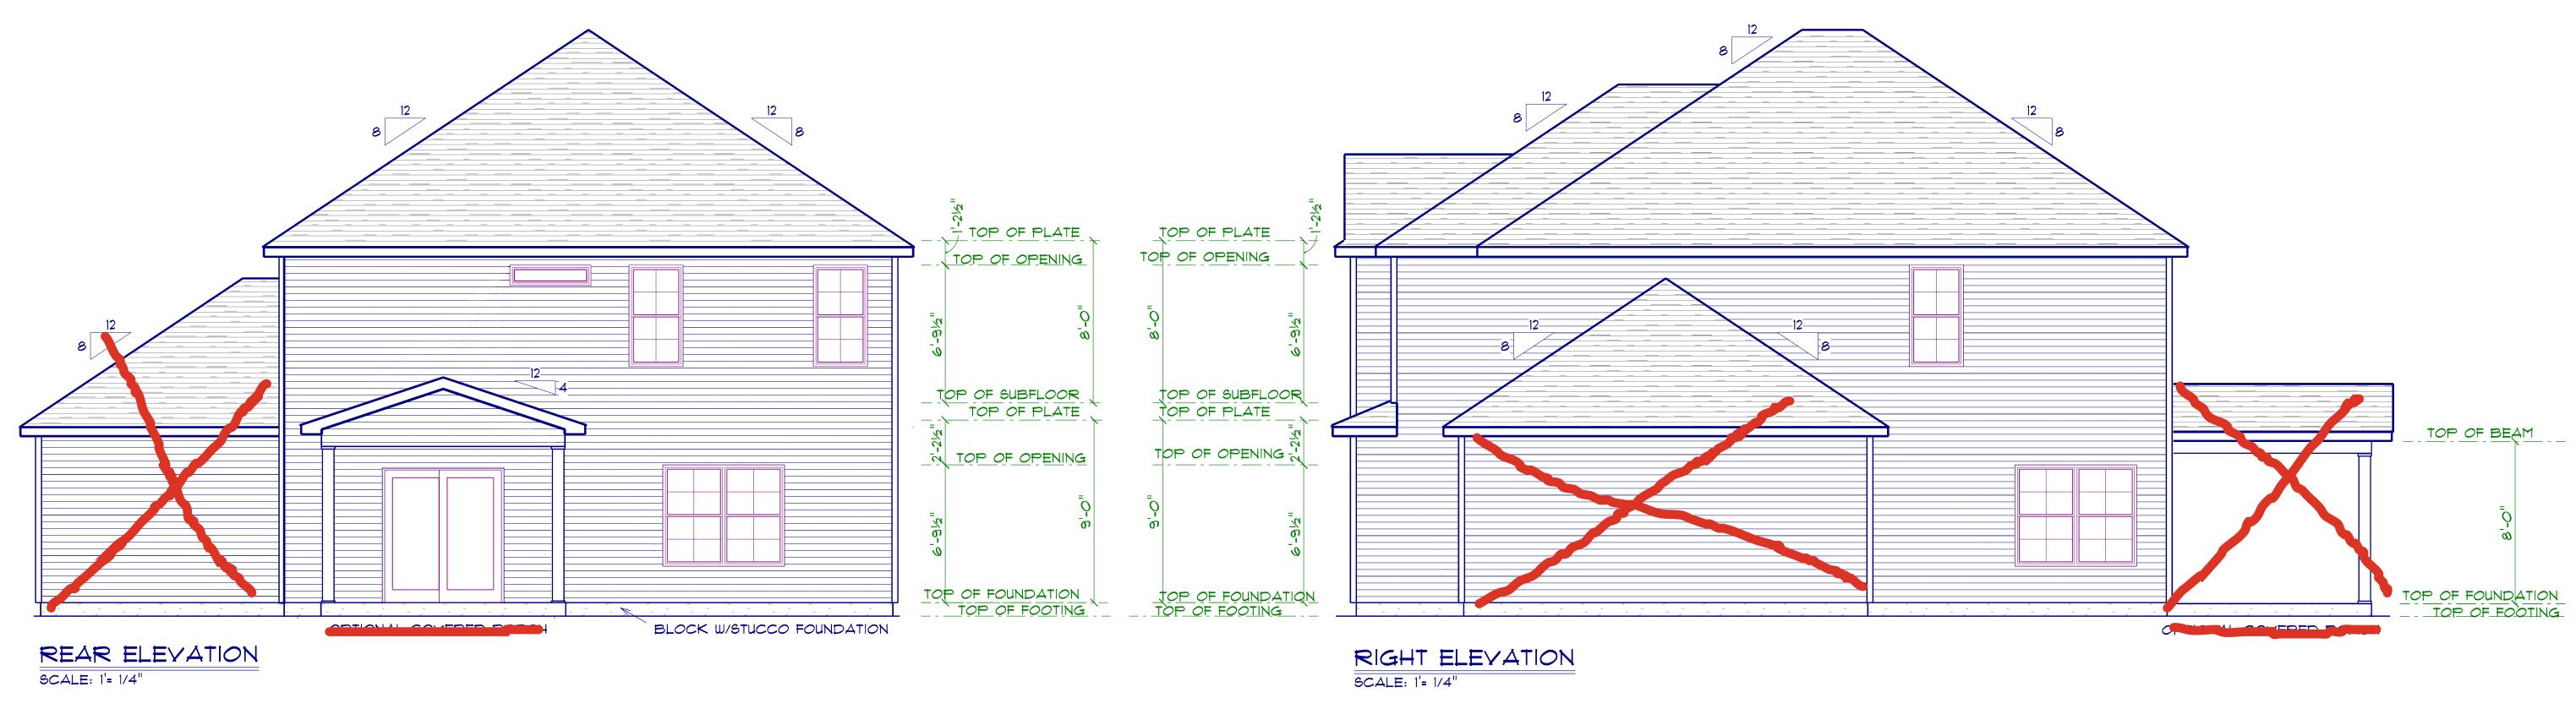

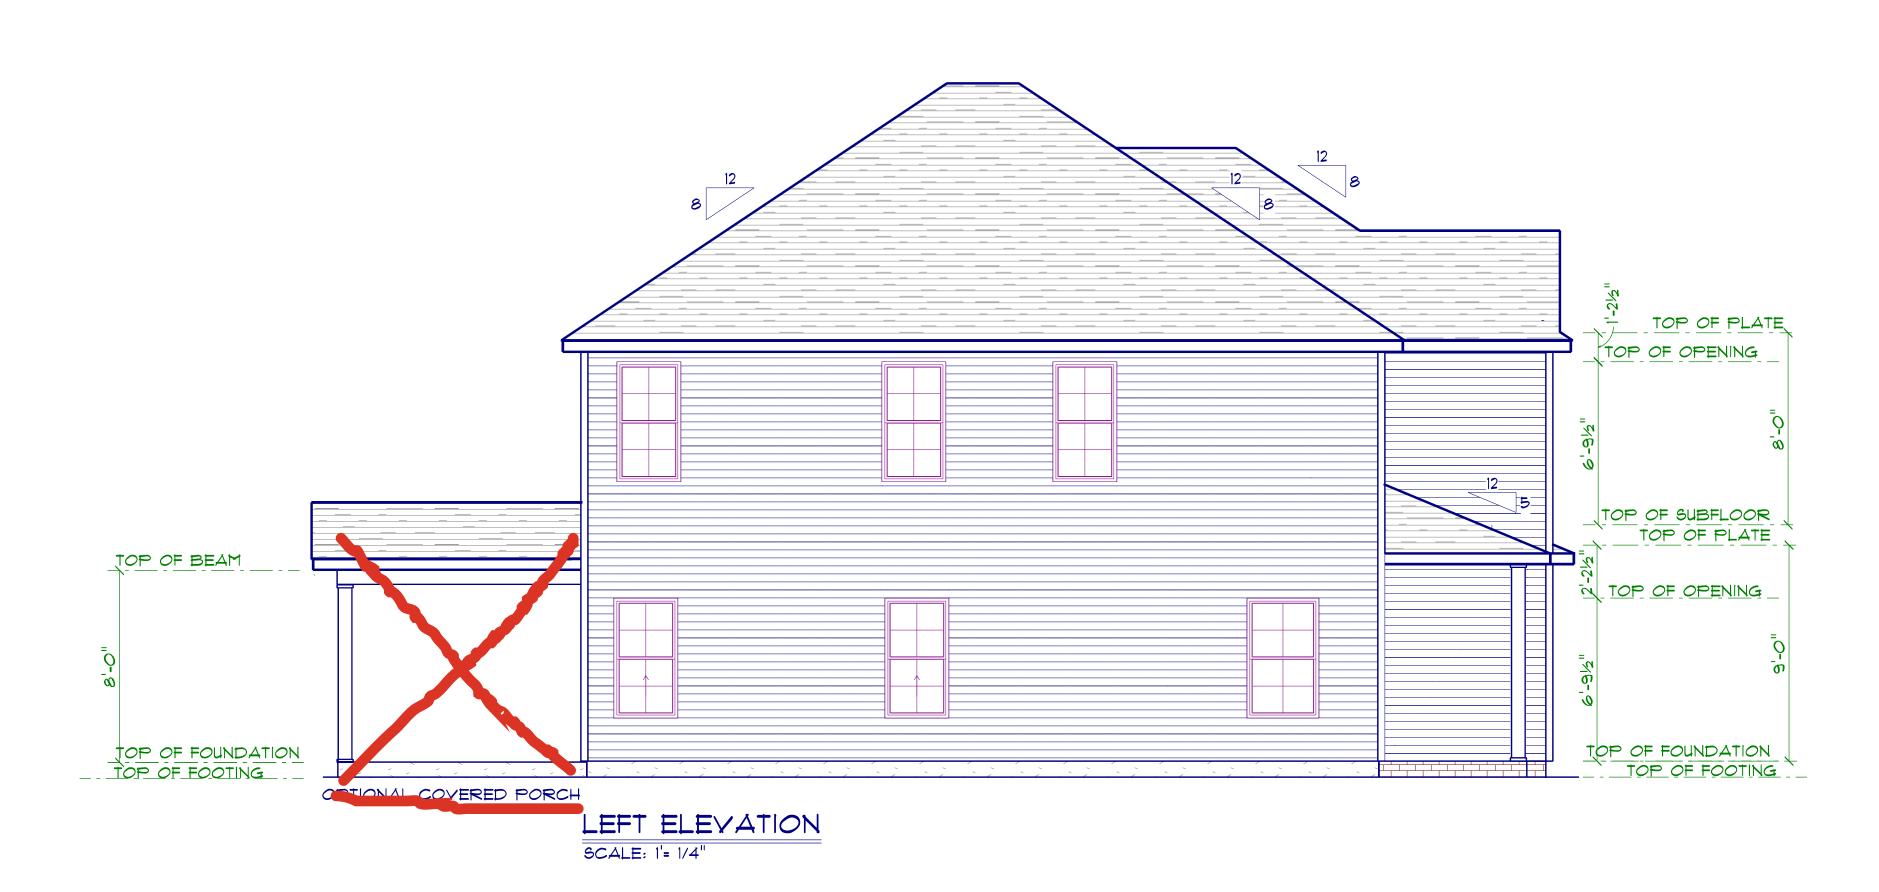


CRH HOMES RETAINS TITLE AND
OWNERSHIP OF ALL PLANS. THESE PLANS CAN NOT BE COPIED
OR REPRODUCED. THESE PLANS CAN NOT BE BUILT BY
ANYONE BUILDER OTHER THAN CRH HOMES

## STEM WALL FOUNDATION Detail not to scale

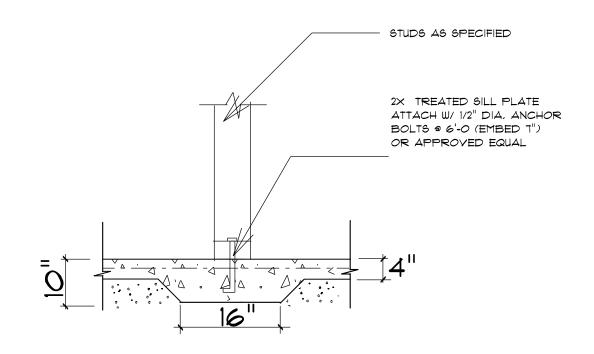

## TYPICAL THICKENED SLAB

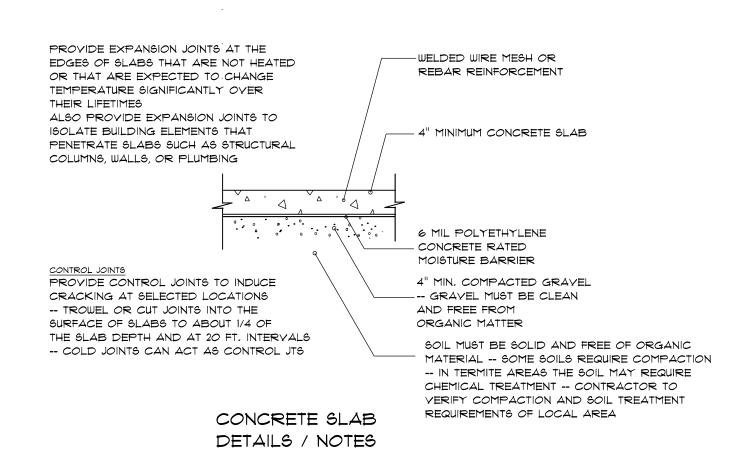

FOUNDATION NOTES:
ALL FOOTINGS SHALL BEAR ON ORIGINAL UNDISTURBED SOIL.
THE 28 DAY COMPRESSIVE STRENGTH OF ALL FOOTINGS IS 3000 PSI

PROVIDE WATER PROOFING AND PERIMETER DRAINS AS REQUIRED.


FOUNDATION CONCRETE MIX TO HAVE 1-1/2" MAX AGGREGATE SIZE. CONCRETE
FILL MIX TO HAVE 1/2" MAX AGGREGATE SIZE.

FOOTING WIDTHS ARE BASED ON A LOAD-BEARING SOIL CAPACITY OF 2000 PSI.

PROVIDE 6 MIL POLY VAPOR BARRIER TO COVER GROUND SURFACE IN CRAWL SPACE

ALL ANCHOR BOLTS TO BE 12" LONG, 1/2" DIA. A36 UNO ANCHOR BOLTS SHALL BE SPACE AT A MAX OF 6' OC AND NO MORE THAN 1' FROM EA CORNER.


Termite Soil Treatment: Treat entire slab area soil or crawl space surface before vapor barrier is installed and slab is poured with a state approved termiticide. Termiticide should be applied by a licensed and certified pest control professional by the state of North Carolina.

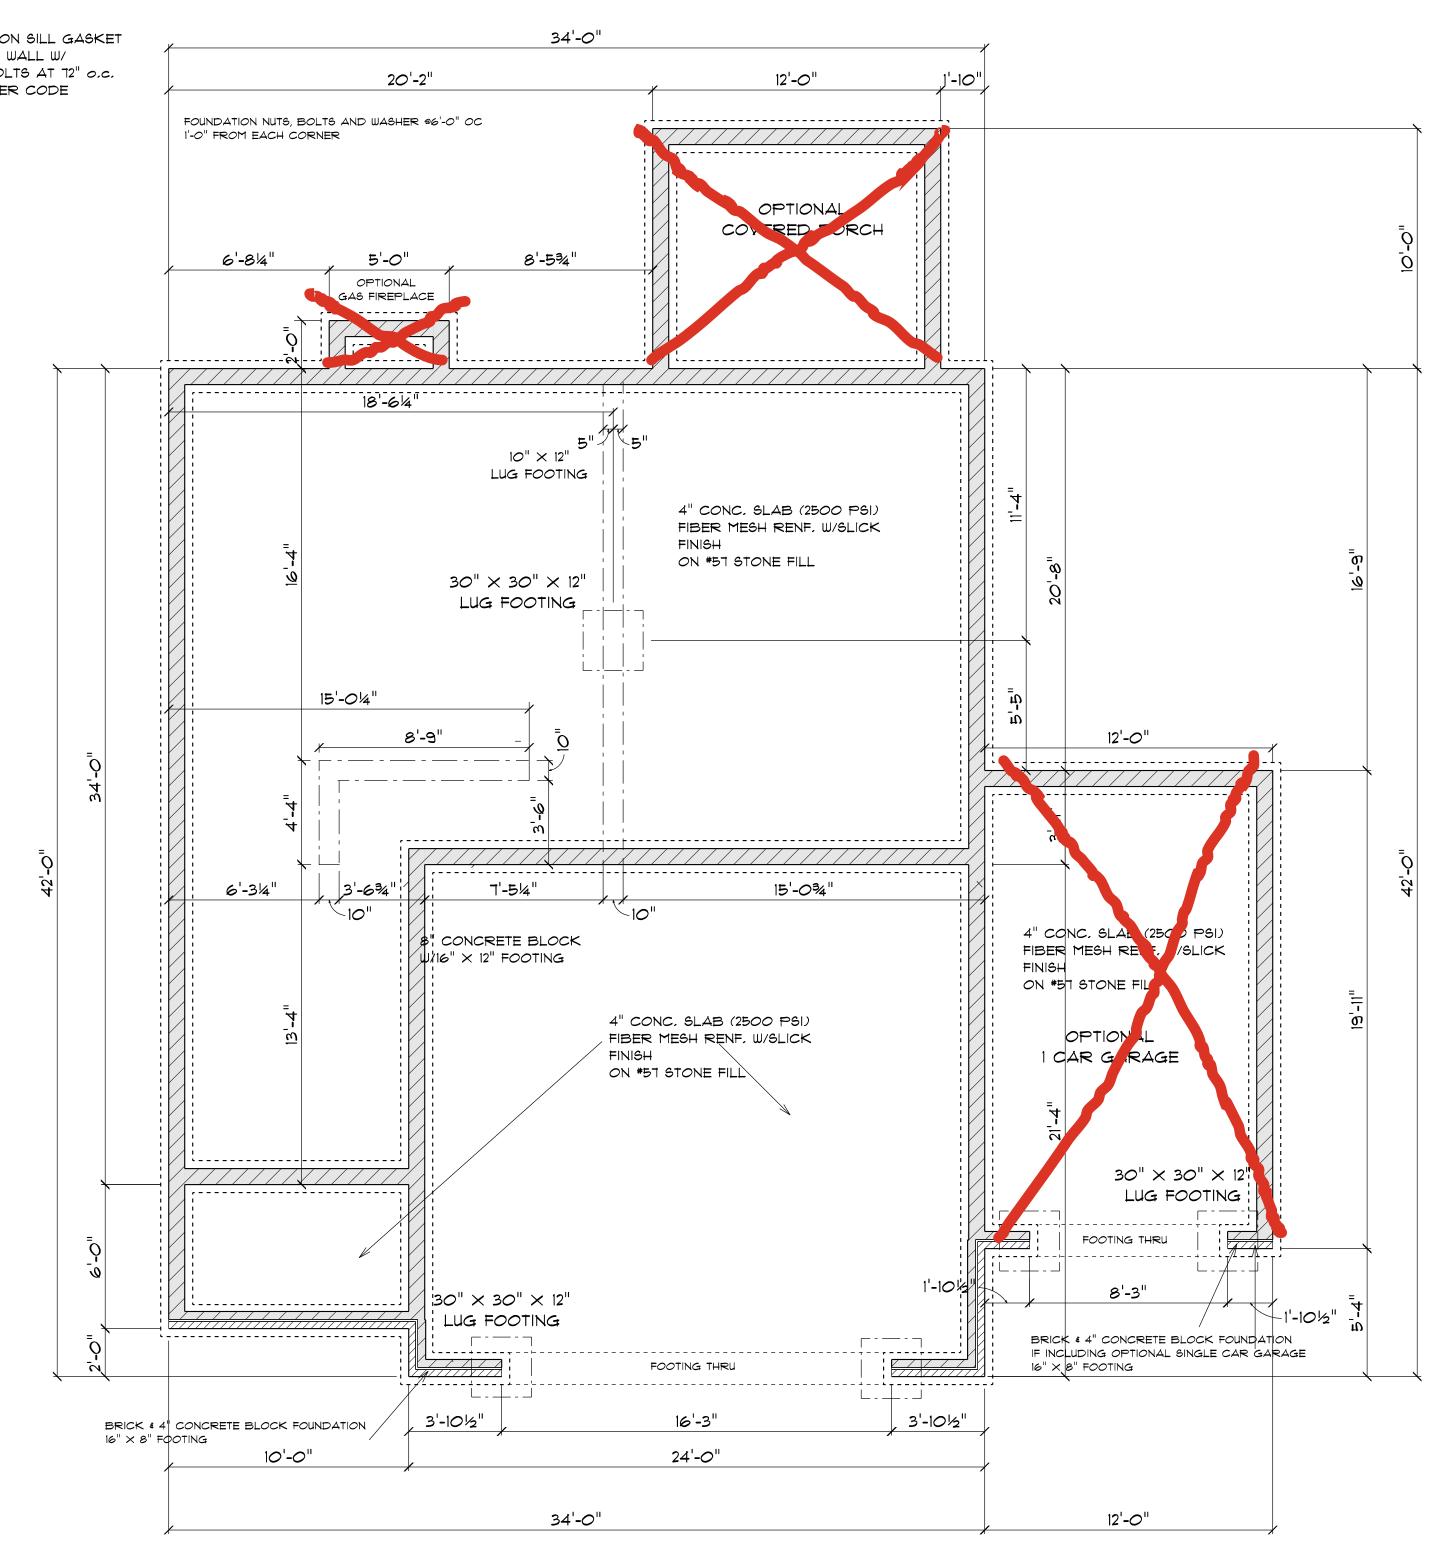

## FOUNDATION PLAN


SCALE: 1'= 1/4"

CRH HOMES RETAINS TITLE AND
OWNERSHIP OF ALL PLANS, THESE PLANS CAN NOT BE COPIED
OR REPRODUCED, THESE PLANS CAN NOT BE BUILT BY
ANYONE BUILDER OTHER THAN CRH HOMES

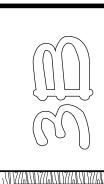

THE LINCO

STEM WALL FOUNDATION

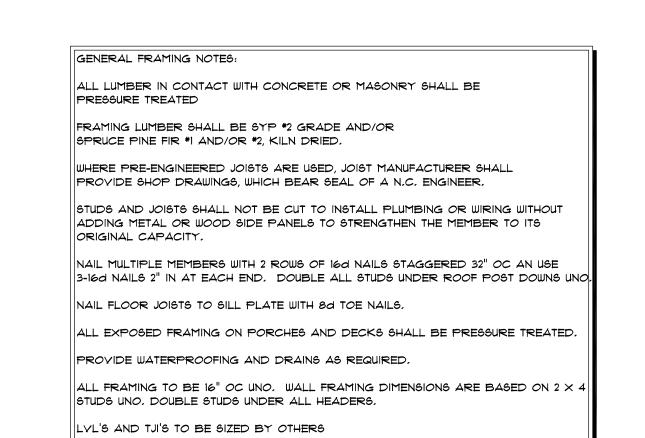

OPENING SCHEDULE					
SIZE	COUNT	LIBRARY NAME	R.O. WIDTH	R.O. HEIGHT	
6'-0"	1	Exterior Door\Patio	72"	80-1/2"	
2'-8" x 5'-0"	5	Window\Single Hung	32"	60"	
2'-8" x 5'-0" Twin	1	Window\Single Hung	64-1/2"	60"	

	OPENING SCHEDULE	LYL'S AND TJI'S TO BE SIZED BY OTHERS	34'-0"
	SIZE COUNT LIBRARY NAME R.O. WIDTH R.O. HEIGHT	EXTERIOR WALLS IN LIVING AREAS ARE 2 X 4	20'-2" 12'-0" 1'-10"
	2'-8" x 5'-0" 7 Window\Single Hung 32" 60"		*
	2'-0" x 3'-0" 1 Window\Single Hung 24" 36"		
	2'-8" x 5'-0" Twin 2 Window\Single Hung 64-1/2" 60"		
	4'-0" x 1'-0"		
			OPTIONAL COVERED
	34'-0"		3'-2" 3'-614" 5'-0" 3'-614" 3'-2"
	2'-5½" 11'-3½" 2'-5¾" 2'-6"	15'-3¼"	
		· 	2'-8" × 5'-0"
<u> </u>	2'-8" × 5'-0"		
\frac{\varphi}{2a}	= 0		OPTIONAL GAS FIREPLACE
	15'-714"	2'-0"	
		7,-314,	
=_	MASTER SUITE		
=    -   ~-			
		$\left[\begin{array}{c c} \dot{o} & 4 \\ \hline \end{array}\right] \left[\begin{array}{ccc} \dot{a} & 74 \\ \hline \end{array}\right]$	
		×	SOLUMN COLUMN TO THE PART OF T
	$\vec{v}$		
		PLAY ROOM	8'-4"   6'-2½"   6'-2½"   17CLIEN
	ENASE CHASE	=	TO BOTOLOGICAL STREET OF THE S
	ATTIC	$\begin{bmatrix} \overline{\omega} \\ \overline{d} \end{bmatrix}$ $=$ $\begin{bmatrix} -\frac{4}{7} \\ \overline{d} \end{bmatrix}$	
	ACCESS	14'-1134"  IF ADDING 3RD GARAGE BAY	
		ELIMINATE THIS WINDOW	-4
= 4			
6-'24 	4'-8" 42" HGHT WALL 28'-9" 20'-234	" 8'-6¼" × O -7 7 7 7 7 7 7 7 7 7 7 7 7 7 7 7 7 7	8'-4 7/16"   12'-2 15/16"   12'-2 15/16"   7
,   20			
-4	2'-4"		
<u> </u>	BATH > /		
		\\\\\\\\\\\\\\\\\\\\\\\\\\\\\\\\\\\\\\	GARAGE  ONTIONAL  1 CAR GARAGE
		8'-64"	6'-6" m 3-2 17 16"
= 4			
	9'-3½" 4'-2"	À =	39-8 1/16"   31-5"   23'-5"   1/16"   1/2"
		="4"	
		BEDROOM #2 -4   -4   -4   +	
<del>\</del>	BEDROOM #3		5'-0" 4'-101/2"
	11'-1¼"	11'-1134"	
			$\left\  \left\  \frac{C}{Z_i} \right\  \right\  = \left\  $
			-\frac{\alpha}{\sigma}
<i>a</i>			DEC COLUMN BEAM
		2'-8" x 5'-0" Twin	DEC. COLUMN
<u> </u>			4'-0"   4'-0"   4'-0"
	3'-9½" 6'-2½" 5'-9" 5'-11"	6'-0½" 6'-3½"	10'-0"
	10'-0"	<del></del>	34'-0"
	24-0		F

2ND FLOOR PLAN

SCALE: 1'= 1/4"

AREA SCHEDULE NAMEAREAHeated1302.4 sq ft.


34'-0"

1ST FLOOR PLAN SCALE: 1'= 1/4"

CRH HOMES RETAINS TITLE AND				
WNERSHIP OF ALL PLANS, THESE PLANS CAN NOT BE COPIED				
OR REPRODUCED. THESE PLANS CAN NOT BE BUILT BY				
ANYONE BUILDER OTHER THAN CRH HOMES				


AREA SCHEDULE				
AREA	NAME			
841.2 sq ft.	Heated			
505.8 sq ft.	Garage			
244.5 sq ft.	Optional 1 Car Garage			
58.3 sq ft.	Covered Porch			
120 sq ft.	Opt Covered Porch			

THE LINCOLN RIGHT GARAGE

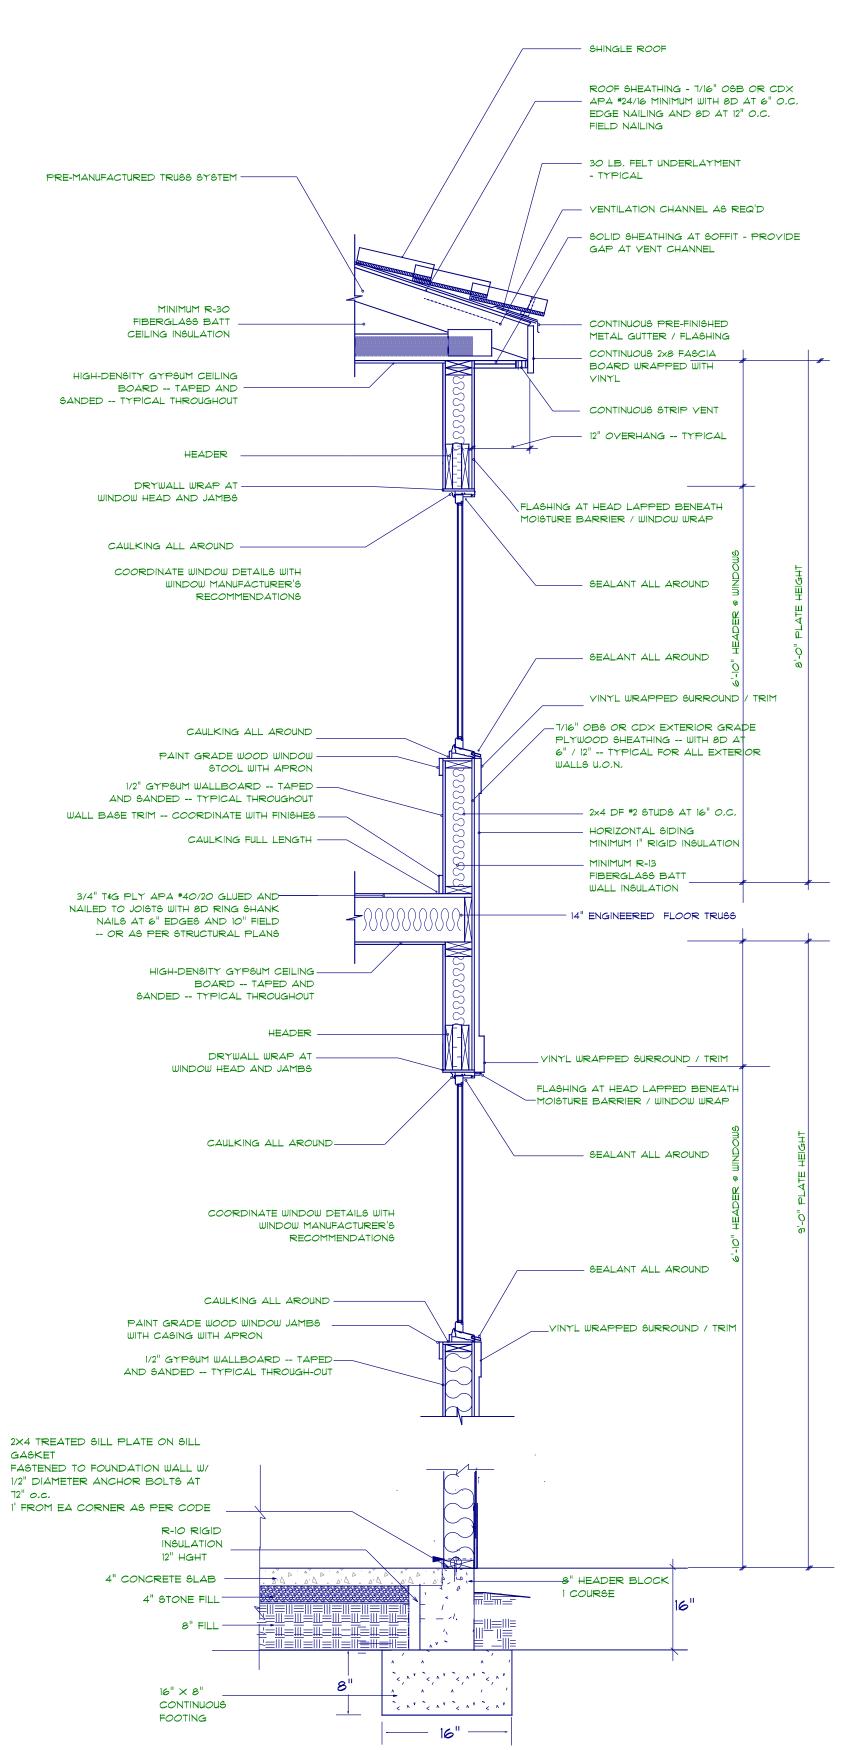

2x4 WITH 8" BLOCK STEM WALL FOUNDATION not to scale

CRH HOMES RETAINS TITLE AND
OWNERSHIP OF ALL PLANS. THESE PLANS CAN NOT BE COPIED
OR REPRODUCED. THESE PLANS CAN NOT BE BUILT BY
ANYONE BUILDER OTHER THAN CRH HOMES

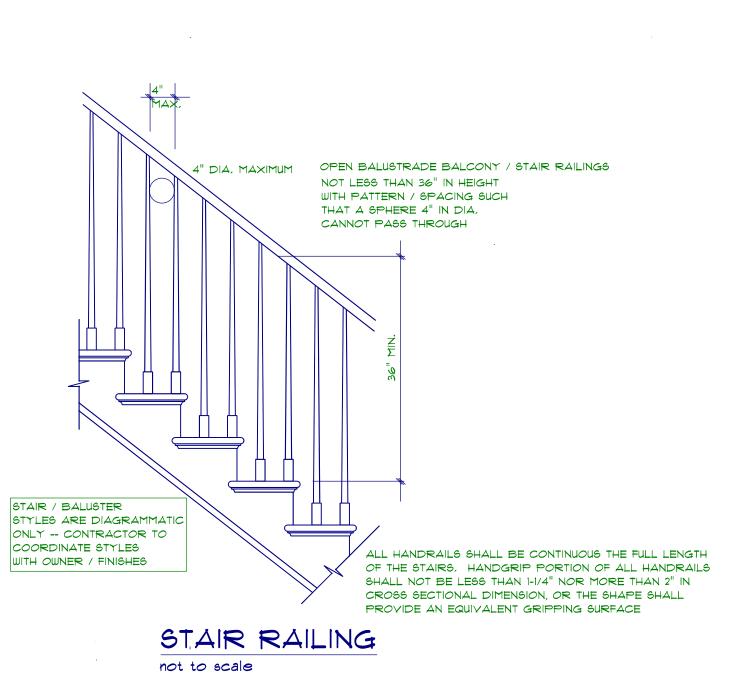

TYPICAL 2x4 WALL:

TAPED & SANDED

TAPED & SANDED

2x4 STUDS @ 16" o.c.

1/2" DRYWALL

1/2" DRYWALL





TRUSSES, BRACINGS, BRIDGING AND CONNECTORS ARE TO BE DESIGNED BY THE TRUSS MANUFACTURER.

IDENTIFY LUMBER BY OFFICIAL GRADE MARKINGS.


DO NOT CUT OR REMOVE CHORDS OR OTHER TRUSS MEMBERS.
DO NOT NOTCH OR DRILL TRUSS MEMBERS.

WHERE PRE-ENGINEERED ROOF TRUSSES ARE USED, TRUSS
MANUFACTURER SHALL PROVIDE SHOP DRAWINGS, WHICH BEAR SEA
OF A N. C. REGISTERED ENGINEER.

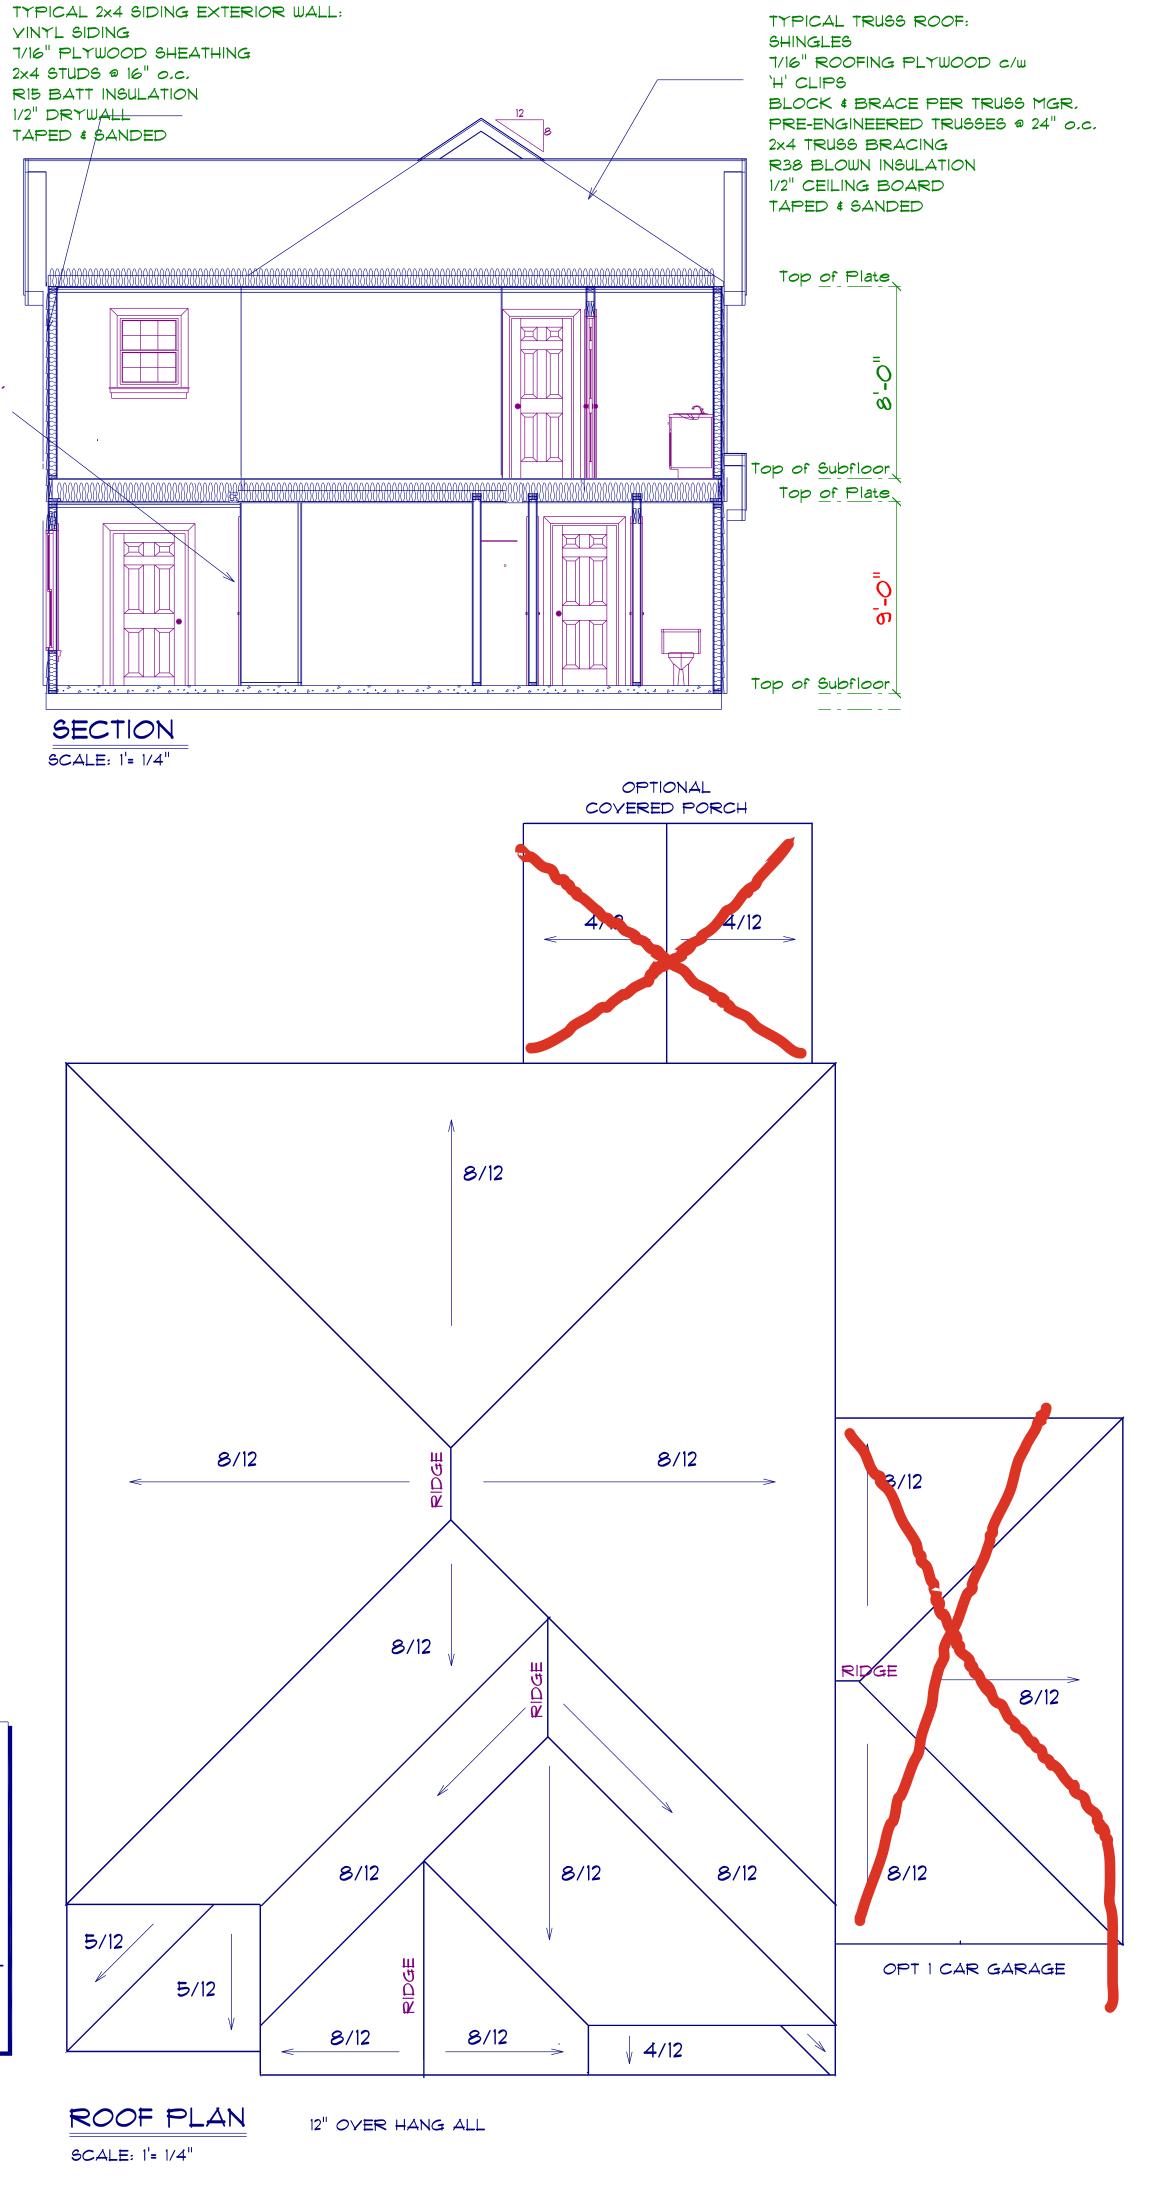

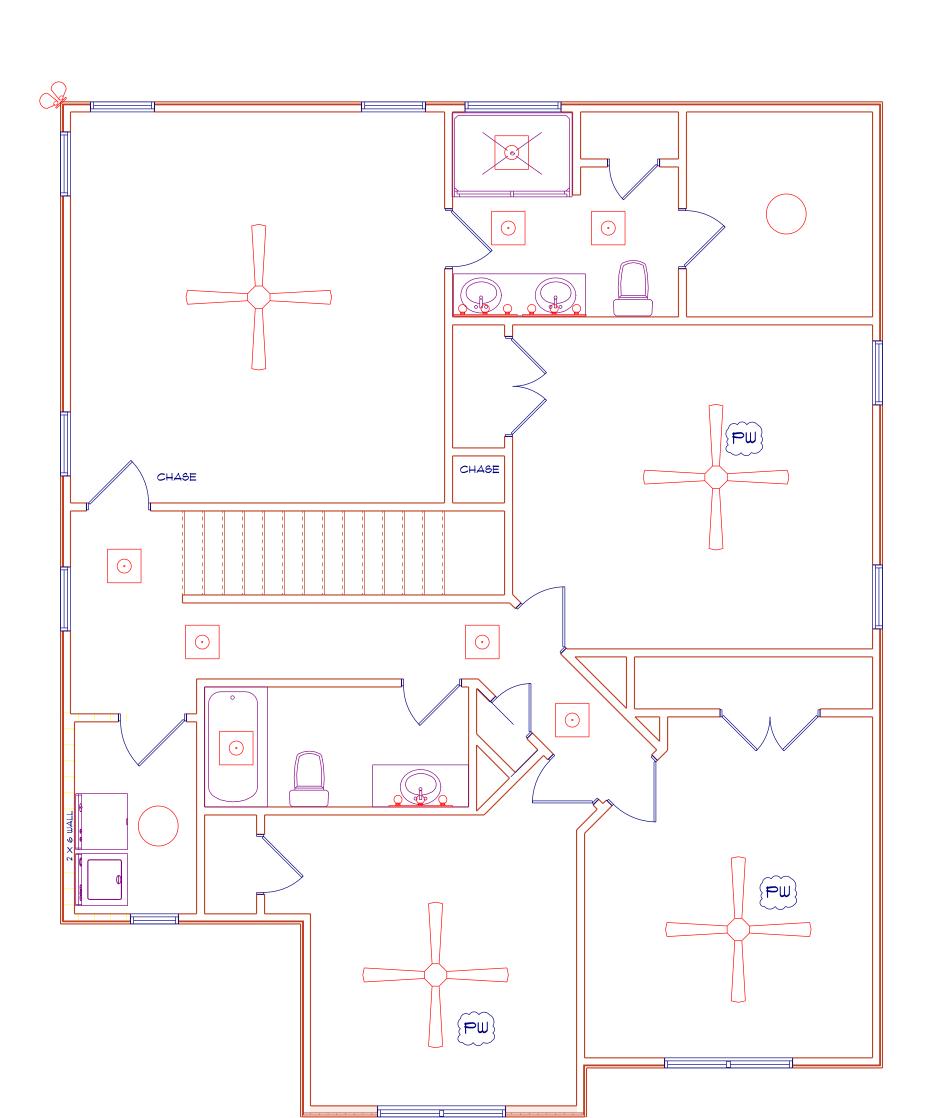

ELECTRICAL LEGEND				
ELECTRICAL	COUNT	SYMBOL		
ceiling fan	2			
10" led	8			
7" led	17	$\odot$		
foyer light	1			
dinning room light	1			
coach light	3			
exterior over head	1			
flood light	3	QD		
vanity bar light	4	000		
wall sconce				
pendant light	2			

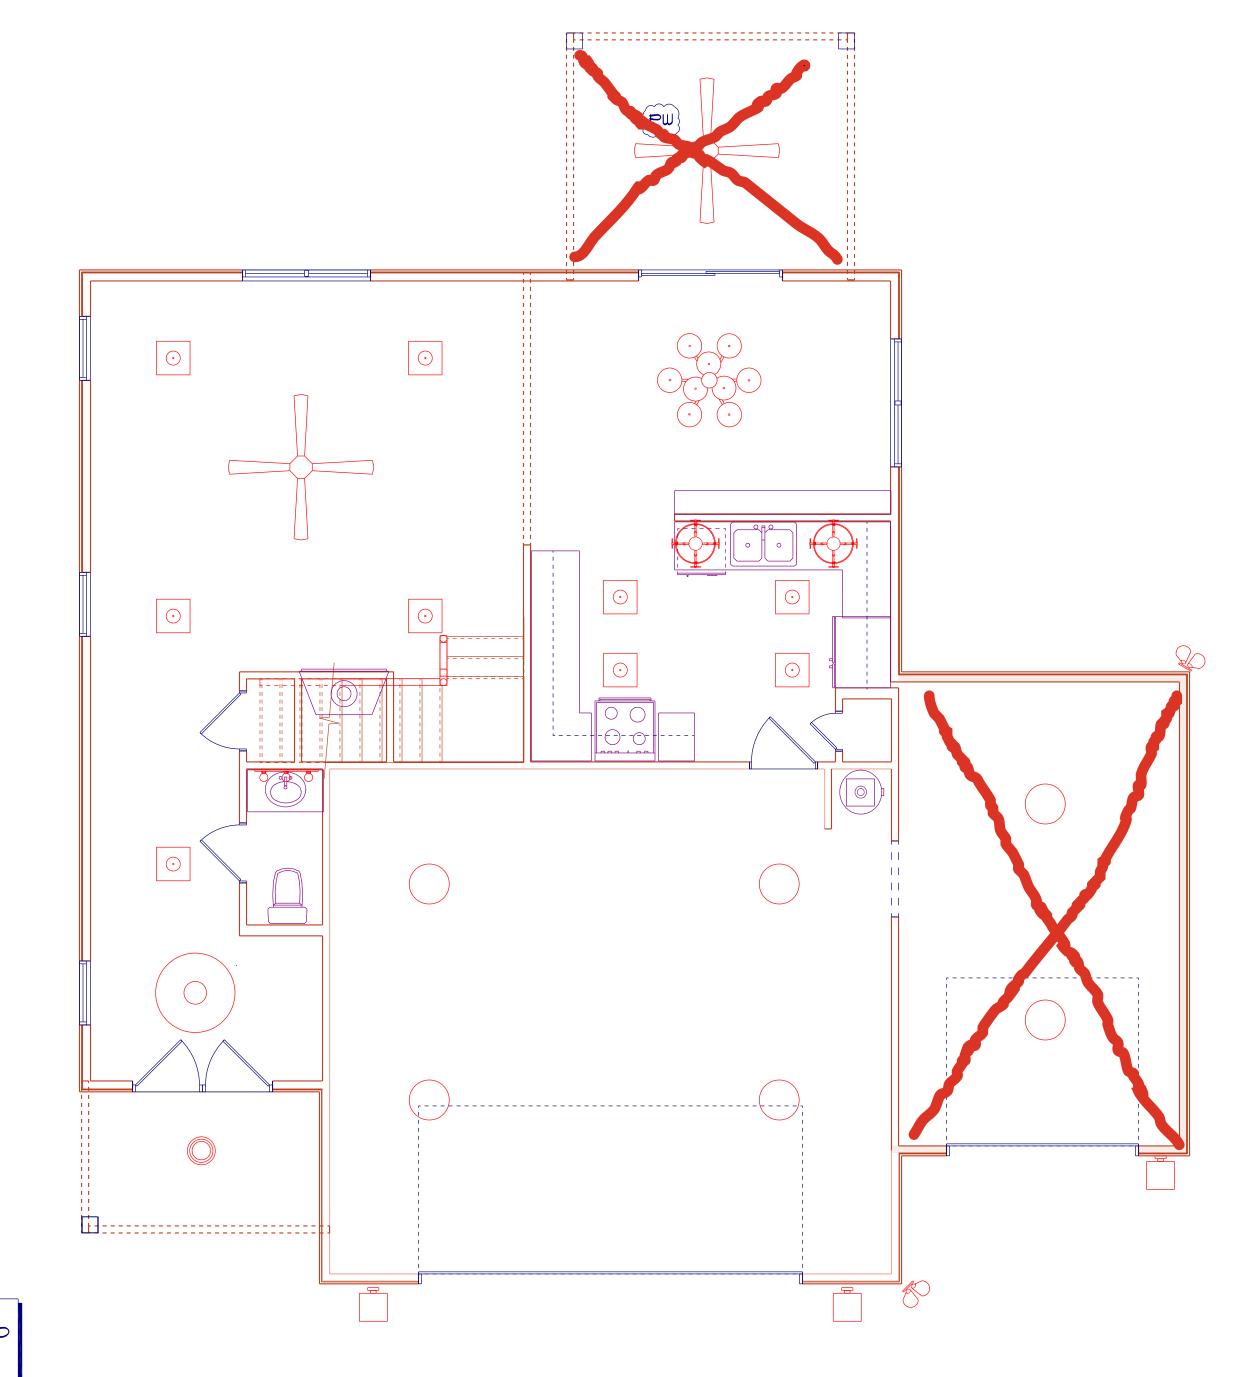

CRH HOMES RETAINS TITLE AND
OWNERSHIP OF ALL PLANS. THESE PLANS CAN NOT BE COPIED
OR REPRODUCED. THESE PLANS CAN NOT BE BUILT BY
ANYONE BUILDER OTHER THAN CRH HOMES

Diane Rives Designs	6205 Mockingbird Lane Sanford, N.C. 21332	golfwoman@charter.net		
SCALE: 1'= 1/4"	DRAWN BY:	DATE: 4/28/2024		