

# BRADLEY

# HARRINGTON PLACE

## LOT 0024



PLAN ID 120121.0901

# 110 VILLAGE TRAIL SUITE 215 WOODSTOCK, GA. 30188

# DRAWING INDEX

---

A0.0	COVER SHEET
A1.1	FRONT ELEVATIONS
A2.1	SIDE & REAR ELEVATIONS
A3.1	SLAB FOUNDATIONS
A5.1	FIRST FLOOR PLANS AND OPTIONS
A6.1	ROOF PLANS
A7.2	ELECTRICAL PLANS
A8.1	TRIM LOCATION LAYOUT

# **GOVERNMENTAL CODES & STANDARDS**

HOME TO BE BUILT TO CONFORM TO ALL APPLICABLE LOCAL CODES, PRACTICES AND STANDARDS

# **BUILDING CODE ANALYSIS / DESIGN CRITERIA**

HOME TO BE BUILT TO MEET OR EXCEED ALL LOCAL CODES AND DESIGN CRITERIA

AREA TABULATION	
FIRST FLOOR	1770
TOTAL	1770
GARAGE	396
FRONT PORCH (COVERED)	20
REAR PATIO W/EXT. FAMILY RM OPTION	136

# HARRINGTON PLACE

## LOT 0024

BY:	CH:
DATE:	02/12/2024
FAÇADE OPT: C	
PLAN ID: C	
FND:	ELEV:
ALL	C
PAGE NO:	A1.1




ELEVATIONS
FRONT ELEVATION
BRADLEY

SMITH DOUGLAS HOMES  
110 VILLAGE TRAIL  
SUITE 115  
WOODSTOCK, GA 30188  
[www.smithdouglas.com](http://www.smithdouglas.com)

SMITH DOUGLAS HOMES  
expressly reserves its  
property rights in these  
plans and drawings.  
These plans and related  
drawings are not to be  
reproduced without written  
consent from SMITH  
DOUGLAS HOMES.

BY:	CH:
TJJ	AW
DATE:	02/12/2024
FAÇADE OPT: C	
PLAN ID: C	
FND:	ELEV:
ALL	C
PAGE NO:	A1.1

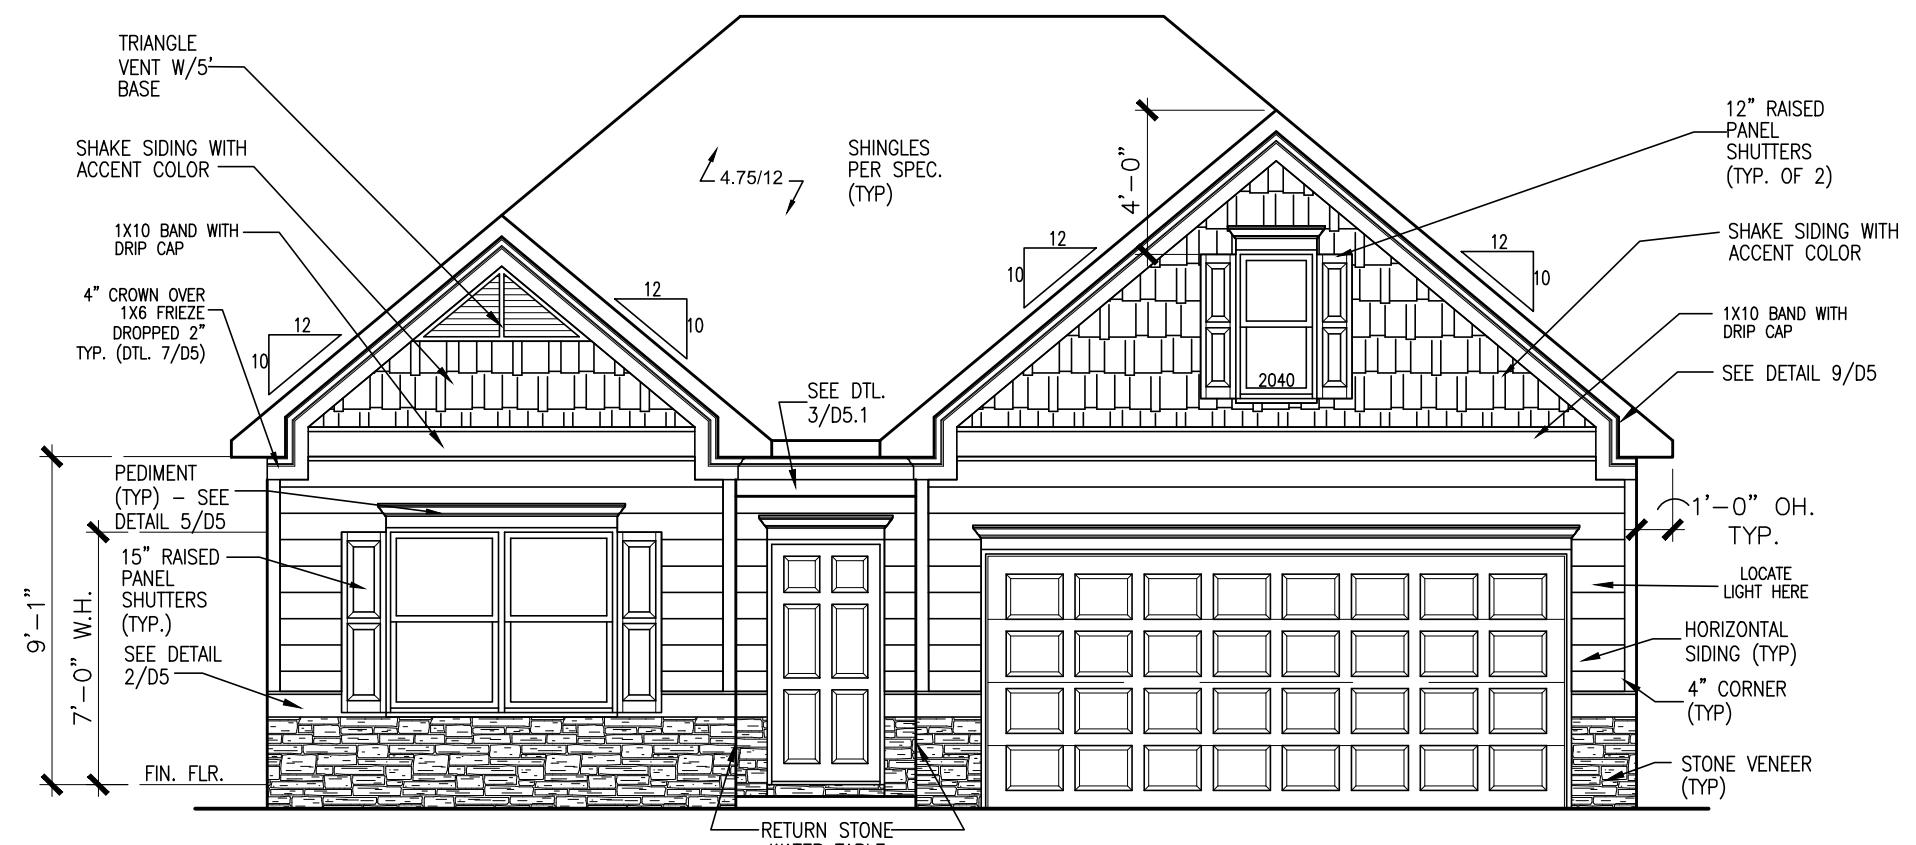

FRONT ELEVATION "C"


SCALE: 3/16"=1'-0"

ALL NON-MASONRY RETURNS TO  
BE HORIZONTAL SIDING

SEE SHEET D3 OF SDH TYPICAL  
DETAILS FOR SOFFIT DETAILS PER  
SOFFIT MATERIAL


# HARRINGTON PLACE

## LOT 0024

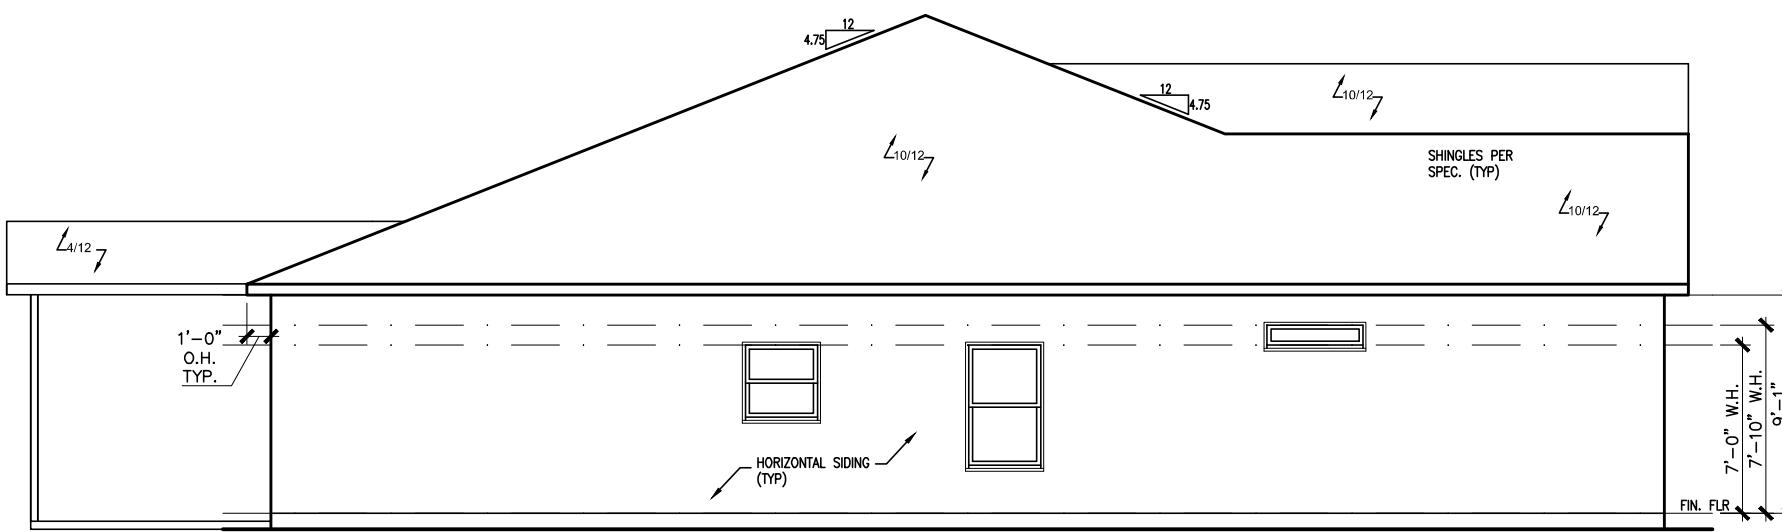


LEFT ELEVATION "C"

SCALE: 1/8" = 1'-0"

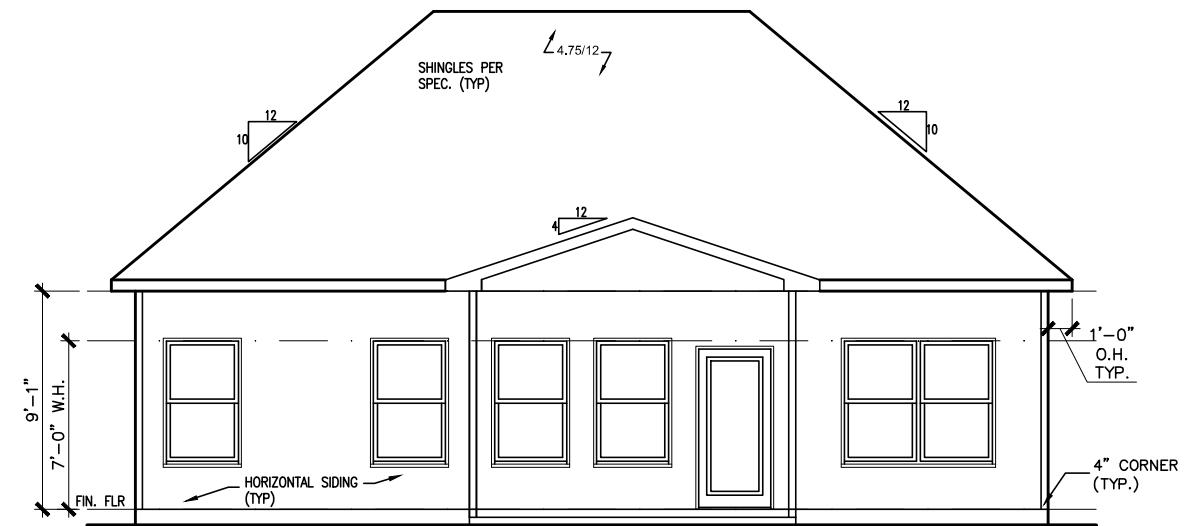

REAR ELEVATION "C"

SCALE: 1/8" = 1'-0"

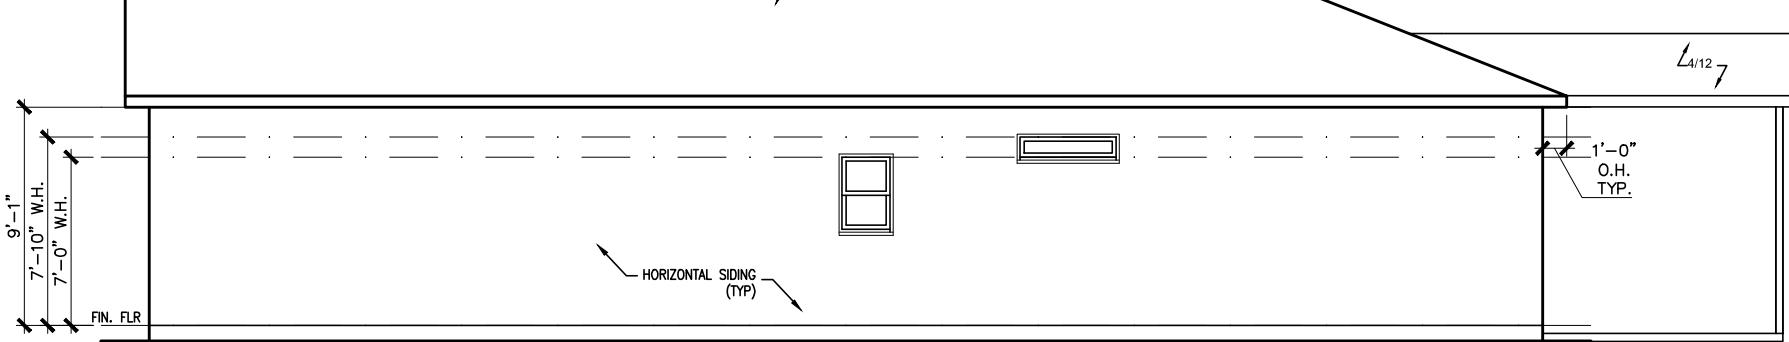

RIGHT ELEVATION "C"

SCALE: 1/8" = 1'-0"

BY:	CH:
DATE:	REVISION
FAÇADE OPT:	# # # # #
PLAN ID:	
FIND:	ELEV:
ALL	C
PAGE NO:	A2.1

SMITH DOUGLAS HOMES
QUALITY   INTEGRITY   VALUE


ELEVATIONS
SIDES AND REAR
BRADLEY


SMITH DOUGLAS HOMES  
110 VILLAGE TRAIL  
SUITE 115  
WOODSTOCK, GA 30188  
[www.smithdouglas.com](http://www.smithdouglas.com)

SMITH DOUGLAS HOMES  
expressly reserves its  
property rights in these  
plans and drawings.  
These plans and related  
drawings are not to be  
reproduced without written  
consent from SMITH  
DOUGLAS HOMES.

BY: TJJ	CH: AW
DATE: 02/12/2024	
FAÇADE OPT: C	
PLAN ID:	
FIND: ALL	ELEV: C
PAGE NO:	A2.1



# HARRINGTON PLACE

## LOT 0024

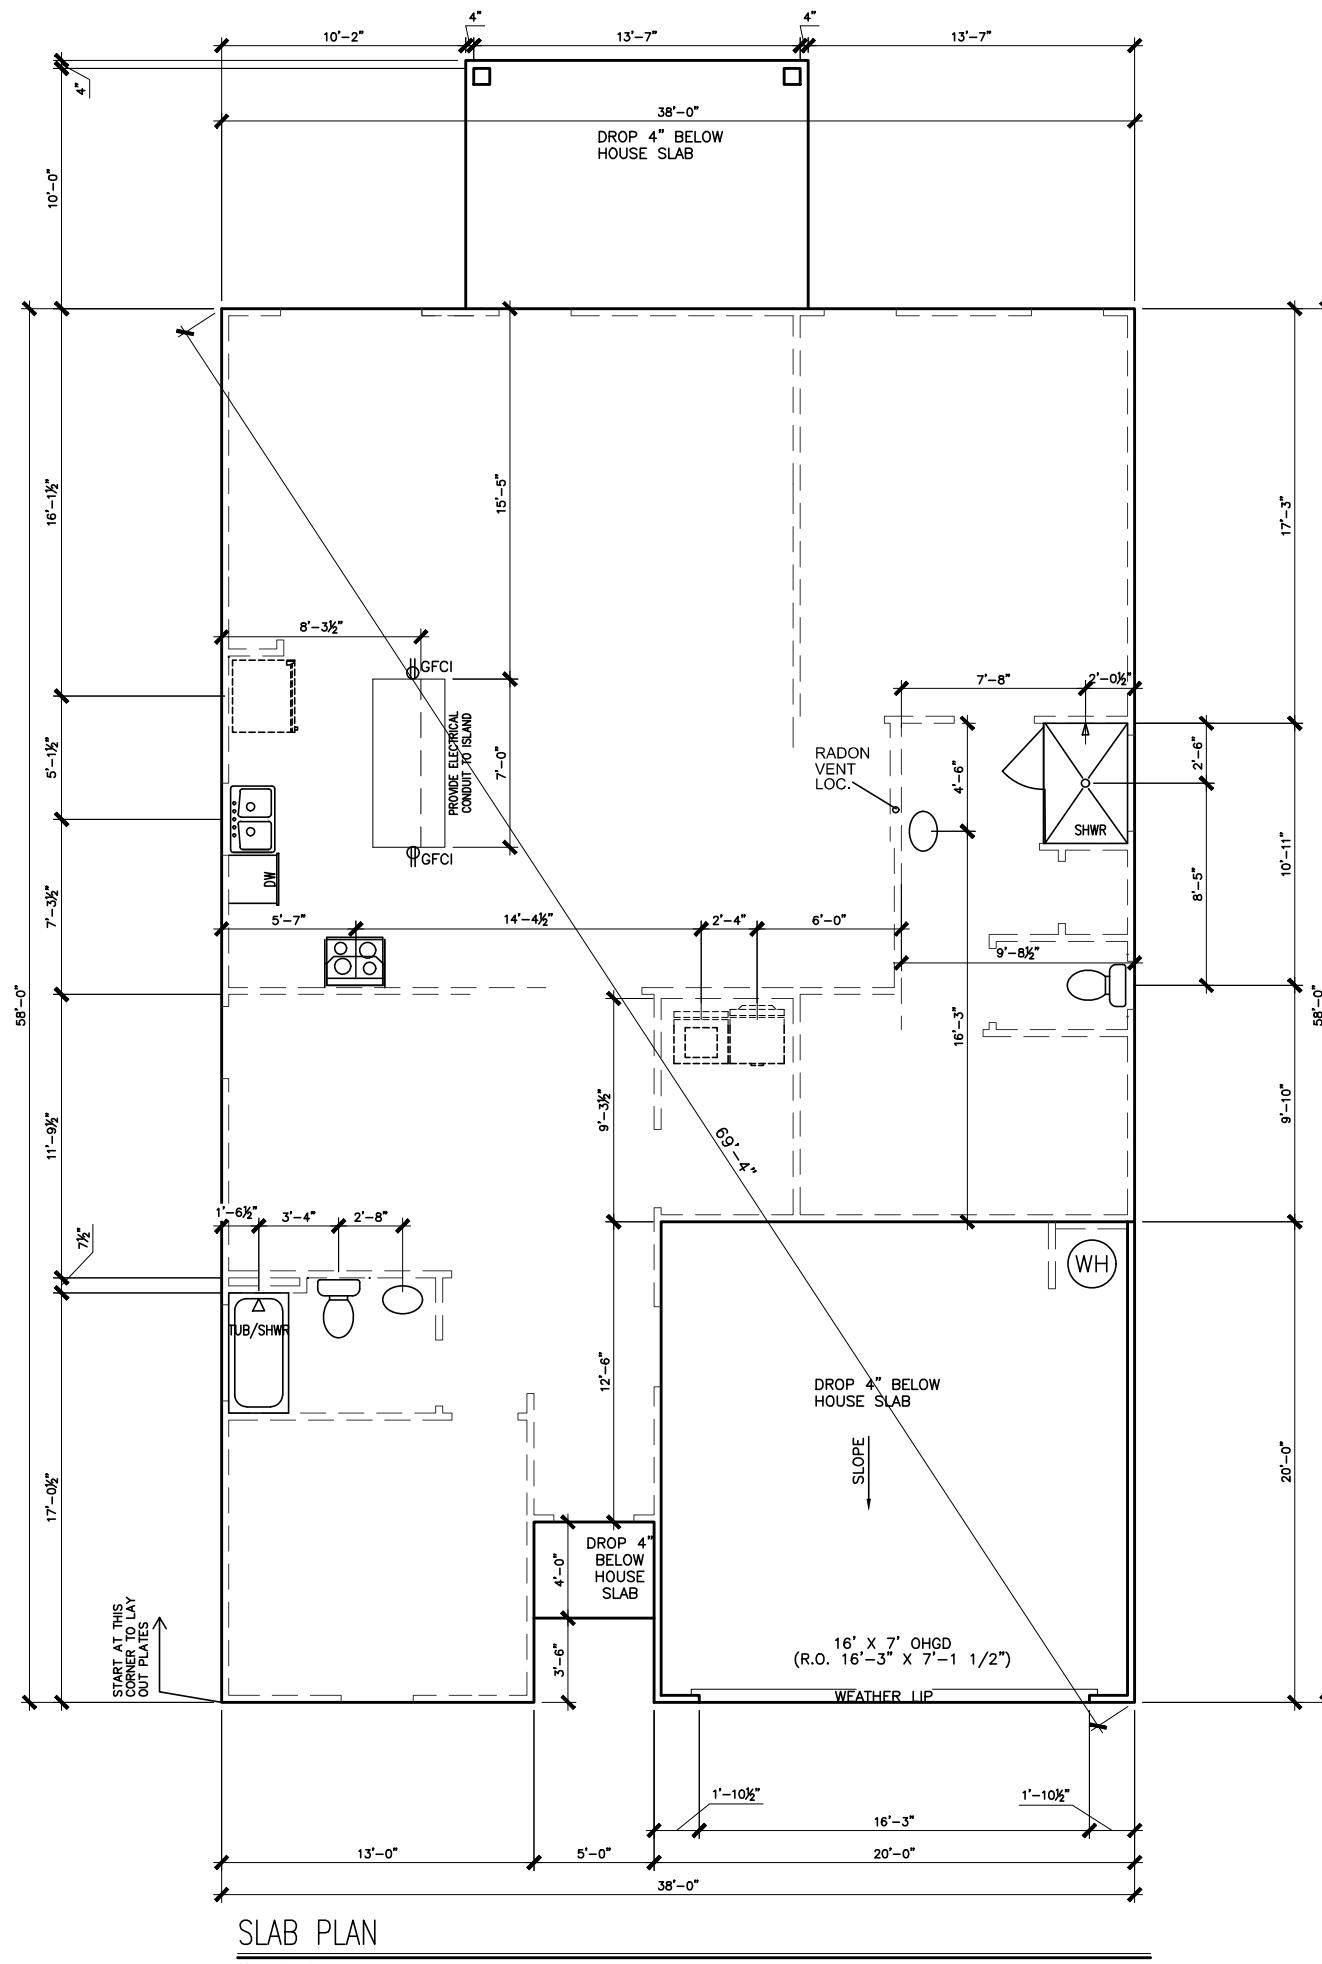


\*RADON VENT  
PROVIDED PER  
LOCAL CODE

REFER TO DETAIL 3/D1 FOR  
BRICK LEDGE DETAIL WHEN  
BRICK VENEER IS CHOSEN

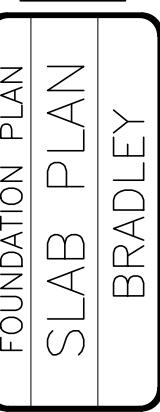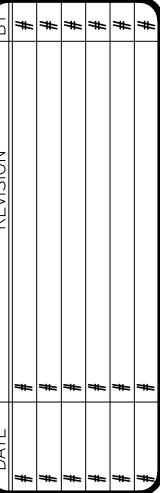


SMITH DOUGLAS HOMES  
110 VILLAGE TRAIL  
SUITE 115  
WOODSTOCK, GA 30188  
[www.smithdouglas.com](http://www.smithdouglas.com)

SMITH DOUGLAS HOMES  
expressly reserves it's  
property rights in these  
plans and drawings.  
These plans and related  
drawings are not to be  
produced without written  
consent from SMITH  
DOUGLAS HOMES.

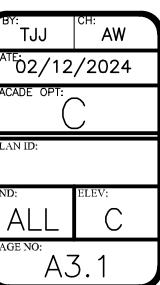


# HARRINGTON PLACE

## LOT 0024

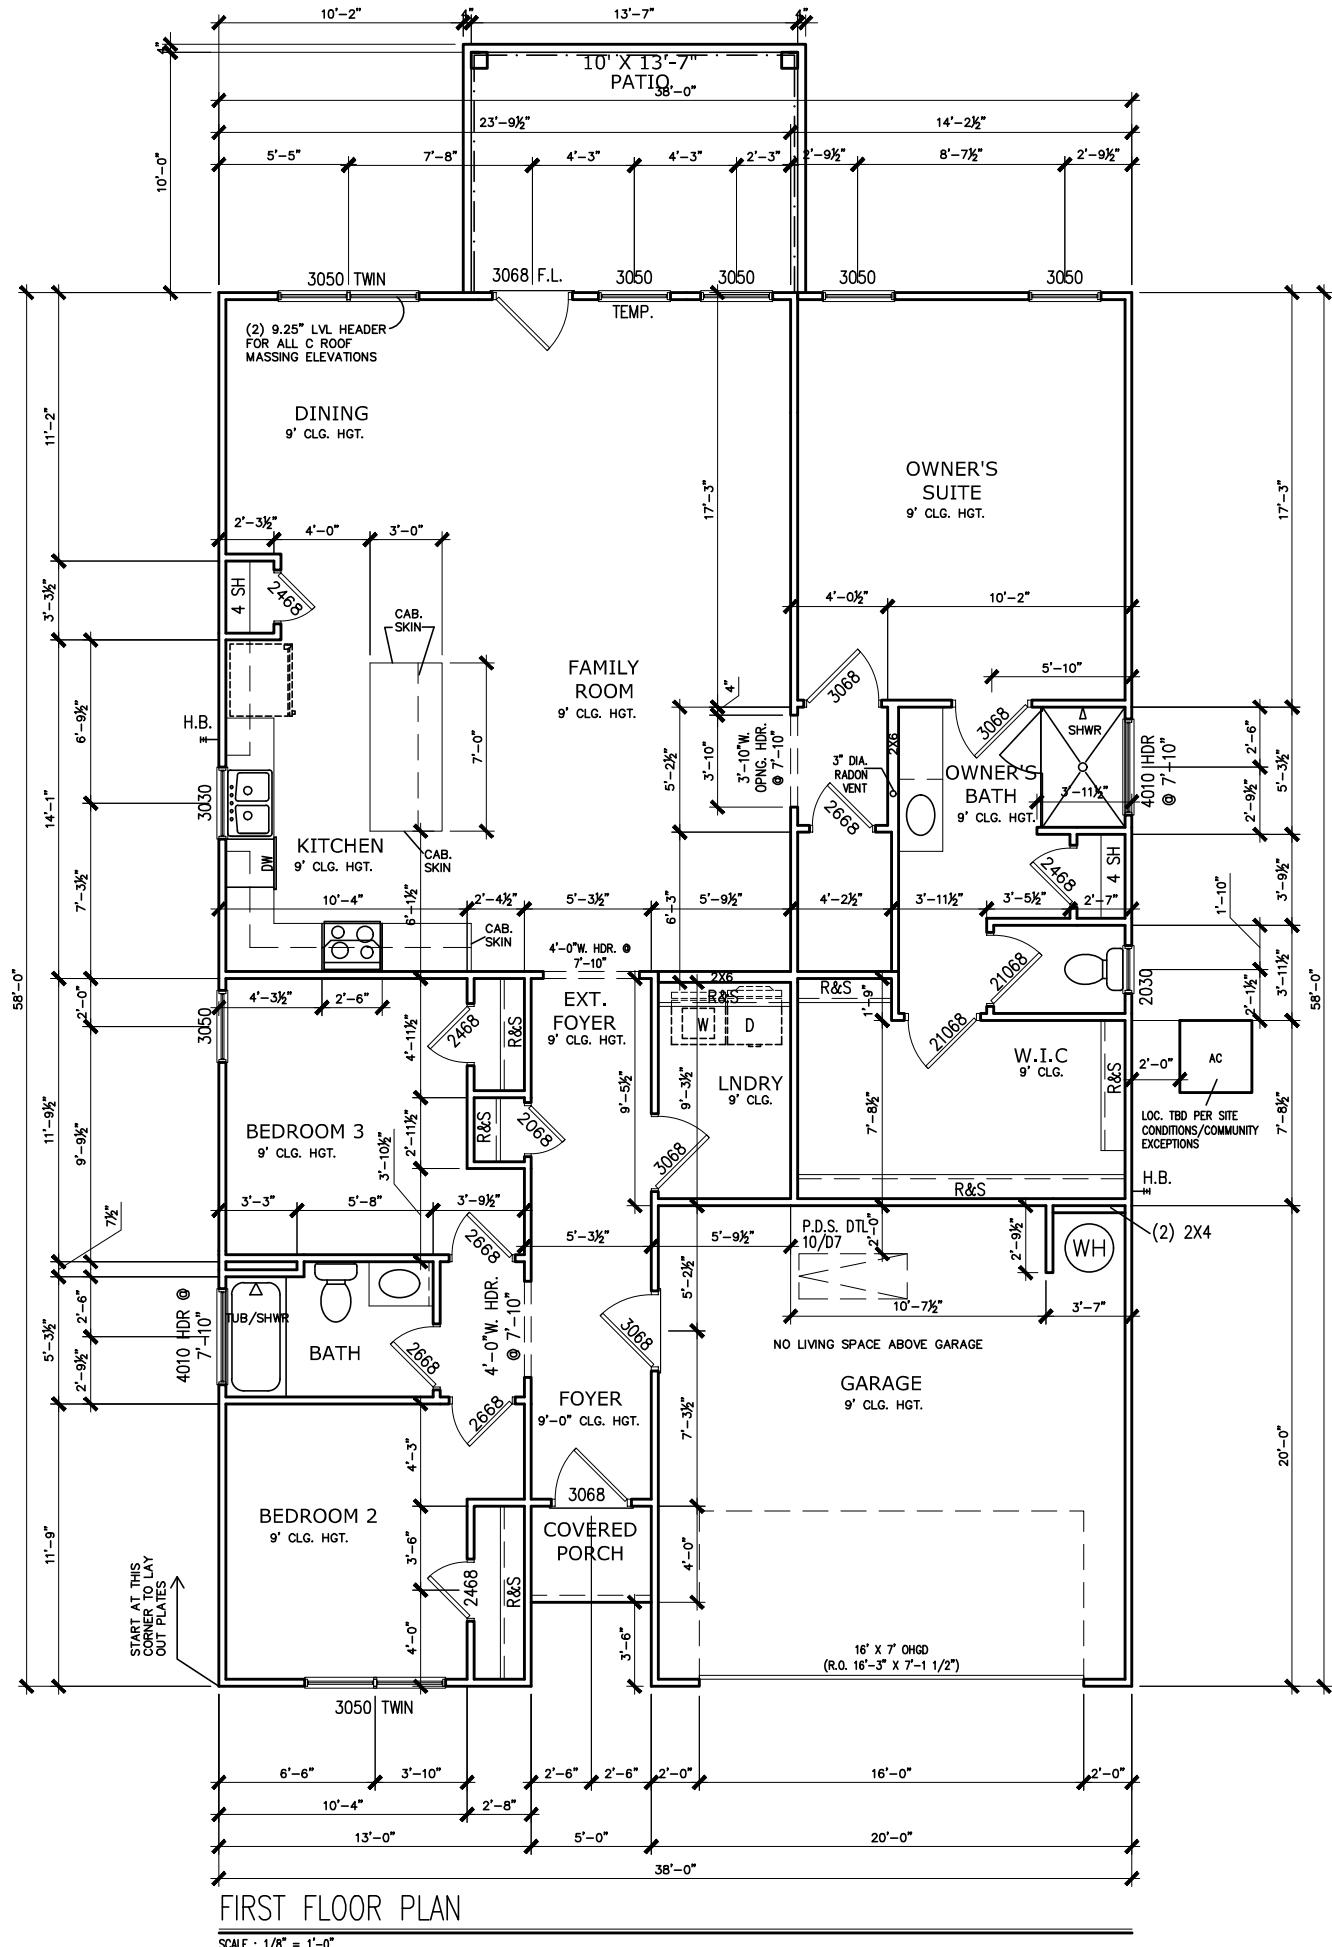

# HARRINGTON PLACE

## LOT 0024

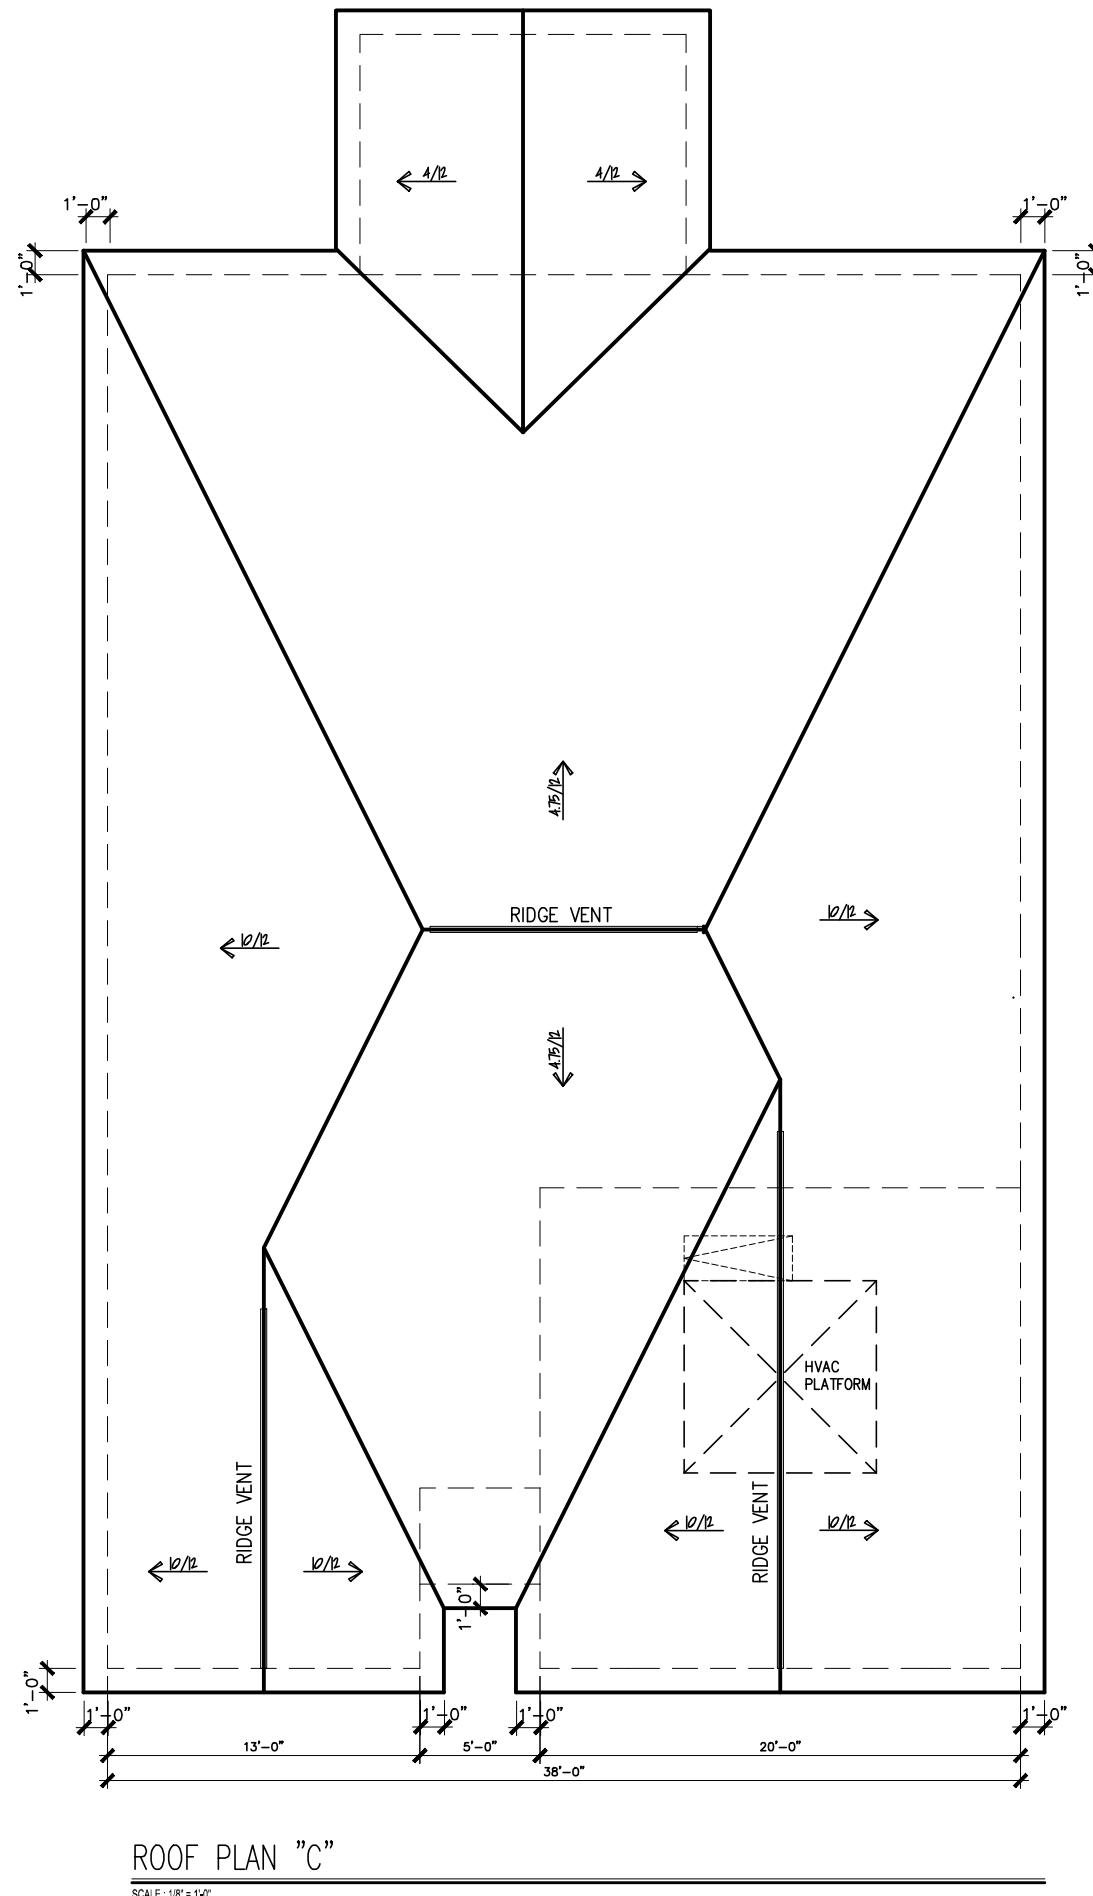

ROOF PLAN "C"

SCALE : 1' 0" = 1' 0"

© SMITH DOUGLAS HOMES 2020

**SMITH DOUGLAS HOMES**  
QUALITY | INTEGRITY | VALUE

**ROOF PLAN**

---

**ROOF PLAN**

**BRADLEY**


SMITH DOUGLAS HOMES  
110 VILLAGE TRAIL  
SUITE 115  
WOODSTOCK, GA 30188  
[www.smithdouglas.com](http://www.smithdouglas.com)

SMITH DOUGLAS HOMES  
expressly reserves it's  
property rights in these  
plans and drawings.  
These plans and related  
drawings are not to be  
produced without written  
consent from SMITH  
DOUGLAS HOMES.

BY: TJJ	CH: AW
ATE: <b>02/12/2024</b>	
ACADE OPT: <b>C</b>	
LAN ID:	
ND: <b>ALL</b>	ELEV: <b>C</b>
AGE NO: <b>A6.1</b>	

# HARRINGTON PLACE

## LOT 0024

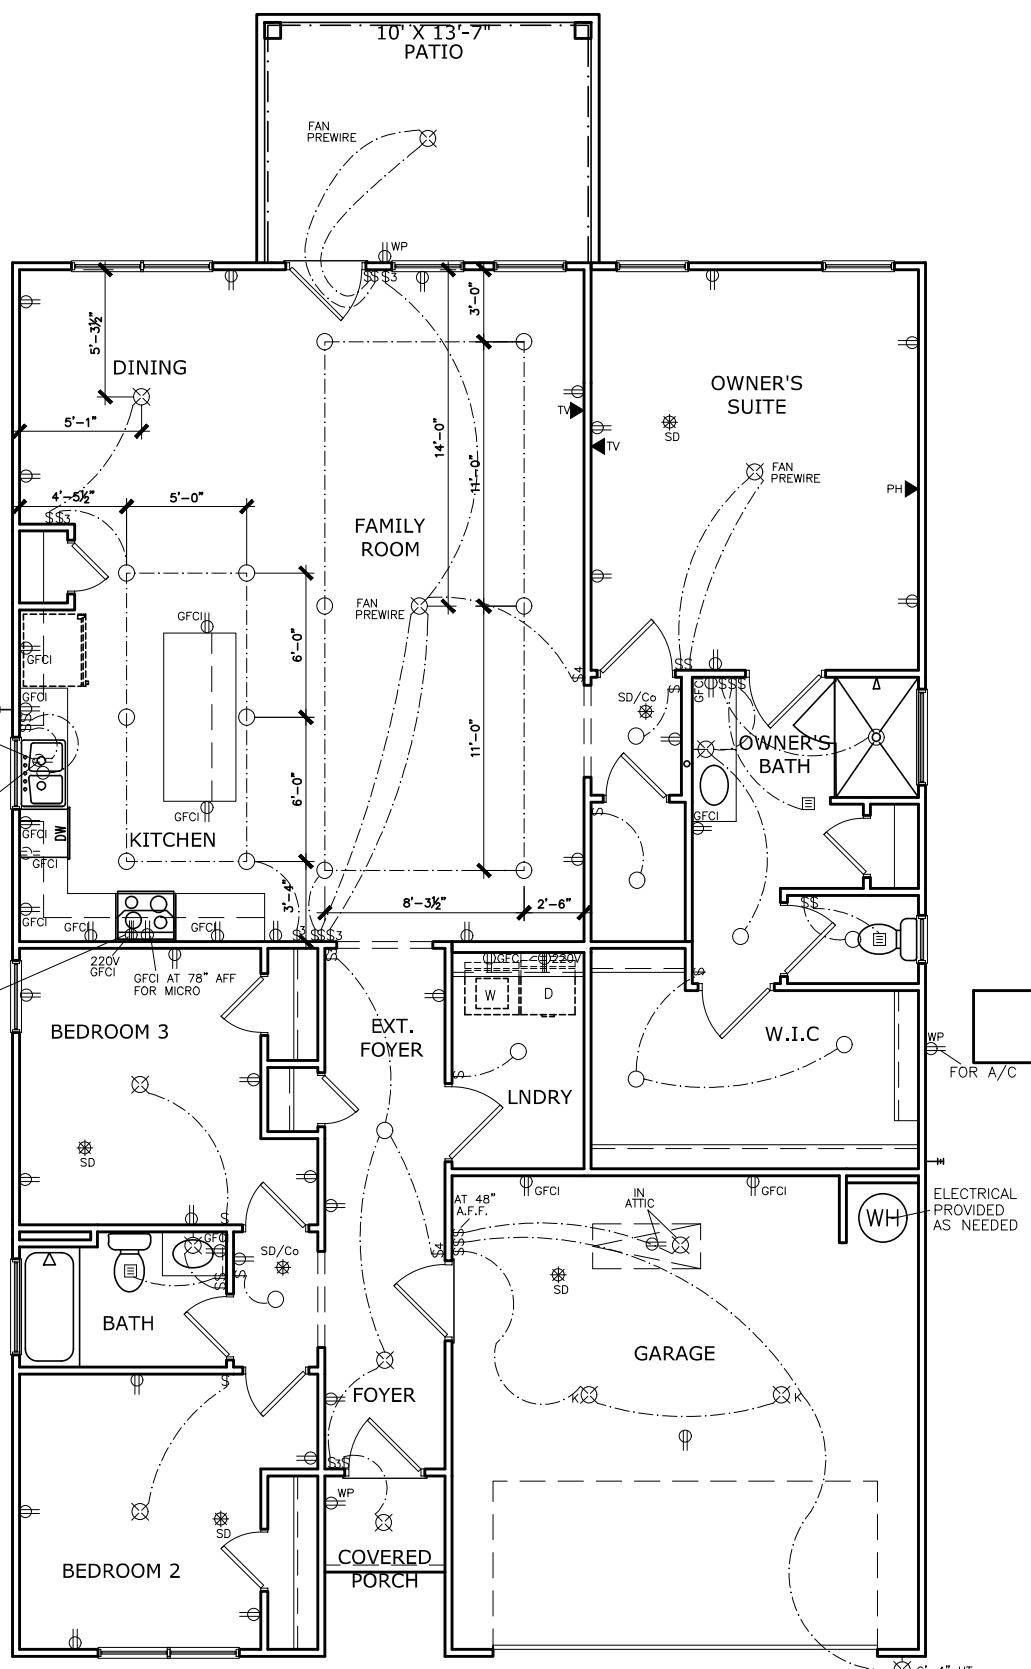

## FIRST FLOOR ELECTRICAL PLAN

SCALE : 1/8" = 1'-0"

ELECTRICAL LEGEND			
\$	SWITCH	TV ▼	TV
\$3	3 WAY SWITCH	○	120V RECEPTACLE
\$4	4 WAY SWITCH	○	120V SWITCHED RECEPTACLE
⊗	CEILING FIXTURE	○	220V RECEPTACLE
-○-K	KEYLESS	○ GFCI	GFCI OUTLET
⊗	WALL MOUNT FIXTURE	○ AFCI	ARCH FAULT CIRCUIT INTERRUPTER
○	CEILING FIXTURE	† GL	GAS LINE
●	FLEX CONDUIT	† WL	WATER LINE
CH	CHIMES	‡	HOSE BIBB
PH ▼	TELEPHONE	○	FLOOD LIGHT
SD/C <sub>o</sub> ⊗	SMOKE DETECTOR & CARBON MONOXIDE	□	1x4 LUMINOUS FIXTURE
SO	SECURITY OUTLET	○	CEILING FAN
□	GARAGE DOOR OPENER	○	ELECTRICAL WIRING
■	EXHAUST FAN	○	CEILING FIXTURE
○	FAN/LIGHT	○	CEILING FIXTURE
ELECTRICAL PLANS TO FOLLOW ALL LOCAL CODES			
APPROX. FIXTURE HTGS (MEASURED FROM BOTTOM OF FIXTURE)			
BREAKFAST/DINING ROOM	63" ABOVE FINISHED FLOOR		
KITCHEN PENDANT LIGHTS	33" ABOVE COUNTER TOP		
TWO STORY FOYER FIXTURE	96" ABOVE FINISHED FLOOR		
CEILING FAN	96" ABOVE FINISHED FLOOR		

NOTE: FINAL PLACEMENT OF  
PHONE/CABLE T.B.D. ON SITE  
BY THE BUILDER


SMITH DOUGLAS HOMES  
110 VILLAGE TRAIL  
SUITE 115  
WOODSTOCK, GA 30188  
[www.smithdouglas.com](http://www.smithdouglas.com)

**SMITH DOUGLAS HOMES**  
expressly reserves it's  
property rights in these  
plans and drawings.  
These plans and related  
drawings are not to be  
reproduced without written  
consent from **SMITH**  
**DOUGLAS HOMES.**

BY: TJJ	CH: AW
DATE: 02/12/2024	
FACADE OPT: <b>C</b>	
PLAN ID:	
FND: <b>ALL</b>	ELEV: <b>C</b>
PAGE NO: <b>A7.2</b>	

# HARRINGTON PLACE

## LOT 0024

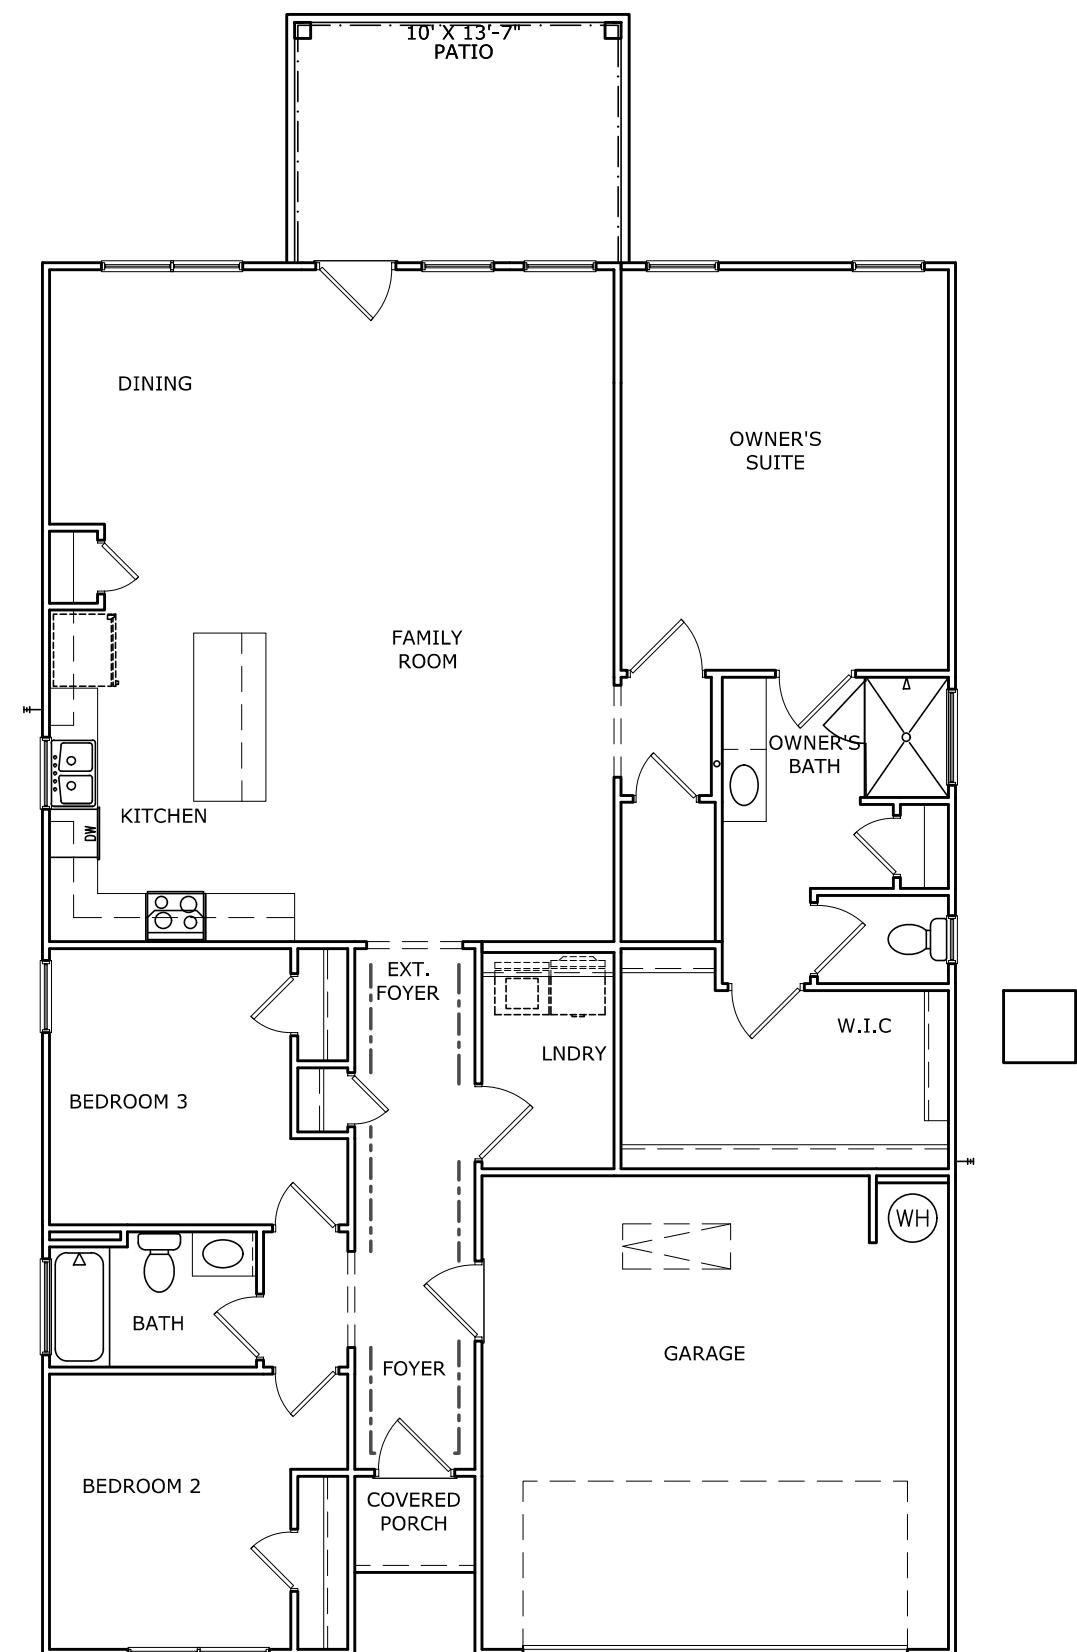

— FOYER TRIM - CHAIR/SHADOW

## TRIM LAYOUT FIRST FLOOR PLAN

---

SCALE : 1/8" = 1'-0"

© SMITH DOUGLAS HOMES 2020

**SMITH DOUGLAS HOMES**

QUALITY | INTEGRITY | VALUE

QUALITY | INTEGRITY | VALUE

# FLOOR PLAN

# TRIM LAYOUT

# BRADLEY

SMITH DOUGLAS HOMES  
110 VILLAGE TRAIL  
SUITE 115  
WOODSTOCK, GA 30188  
[www.smithdouglas.com](http://www.smithdouglas.com)

**SMITH DOUGLAS HOMES**  
expressly reserves its  
property rights in these  
plans and drawings.  
These plans and related  
drawings are not to be  
reproduced without written  
consent from **SMITH**  
**DOUGLAS HOMES**

BY: TJJ	CH: AW
DATE: 02/12/2024	
FACADE OPT: C	
PLAN ID:	
FND: ALL	ELEV: C
PAGE NO: A8.1	





### CONNECTION SPECIFICATIONS (TYP. U.N.O.)

DESCRIPTION OF BLDG. ELEMENT	3"x0.131" NAILS	3"x0.120" NAILS
JOIST TO SOLE PLATE	(3) TOENAILS	(3) TOENAILS*
SOLE PL. TO JOIST/RIM OR BLK'G	NAILS @ 4" O.C.	NAILS @ 4" O.C.
STUD TO PLATE	(4) TOENAILS/ (3) END NAILS	(4) TOENAILS/ (4) END NAILS*
RIM TO TOP PLATE	TOENAILS @ 6" O.C.	TOENAILS @ 4" O.C.*
BLK'G, BTWN. JOISTS TO TOP PL.	(3) TOENAILS EA. END	(3) TOENAILS EA. END*
DOUBLE STUD	NAILS @ 16" O.C.	NAILS @ 16" O.C.
DOUBLE TOP PLATE	NAILS @ 12" O.C.	NAILS @ 8" O.C.
DOUBLE TOP PLATE LAP SPLICE	(12) NAILS IN LAPPED AREA (24" MIN)	(15) NAILS IN LAPPED AREA (24" MIN)
TOP PLATE LAP @ CORNERS & INTERSECTING WALLS	(3) NAILS	(3) NAILS
RAFTER/TRUSS TO TOP PLATE	(4) TOENAILS + (1) SIMPSON H25T	(4) TOENAILS + (1) SIMPSON H25T
GAB. END TRUSS TO DBL. TOP PL.	TOENAILS @ 6" O.C.	TOENAILS @ 6" O.C.
R.T. w/ HEEL HT. 9 1/4" TO 12"	2x10 BLK EVERY 3RD BAY FASTENED TO DBL. TOP PLATE w/ TOENAILS @ 6" O.C.	2x10 BLK EVERY 3RD BAY FASTENED TO DBL. TOP PLATE w/ TOENAILS @ 6" O.C.
R.T. w/ HEEL HT. 12" TO 16"	2x12 BLK EVERY 3RD BAY FASTENED TO DBL. TOP PLATE w/ TOENAILS @ 6" O.C.	2x12 BLK EVERY 3RD BAY FASTENED TO DBL. TOP PLATE w/ TOENAILS @ 4" O.C.
R.T. w/ HEEL HT. UP TO 24"	LAP WALL SHTG. w/ DBL. TOP PL. & INSTALL ON TRUSS VERT. - FASTEN w/ NAILS @ 6" O.C.	LAP WALL SHTG. w/ DBL. TOP PL. & INSTALL ON TRUSS VERT. - FASTEN w/ NAILS @ 6" O.C.
R.T. w/ HEEL HT. 24" TO 48"	LAP WALL SHTG. w/ DBL. TOP PL. & INSTALL ON TRUSS VERT. - FASTEN w/ NAILS @ 6" O.C. PROVIDE 2x BLK @ EA. BAY AT TOP OF HEEL	LAP WALL SHTG. w/ DBL. TOP PL. & INSTALL ON TRUSS VERT. - FASTEN w/ NAILS @ 6" O.C. PROVIDE 2x BLK @ EA. BAY AT TOP OF HEEL*
WALL TO FOUNDATION	WALL SHTG. LAP w/ SILL PL. & FASTENED PER SHEAR WALL FASTENING SPEC.	

\* 2 1/2" x 0.113 IS AN ACCEPTABLE ALTERNATIVE TO A 3" x 0.120", SAME SPACING OR NUMBER OF NAILS.  
(ONLY ACCEPTABLE WHERE \* ARE SHOWN)

### ADDITIONAL NOTES FOR TRUSS & I-JOIST MANUFACTURER

ROOF TRUSS AND ENGINEERED JOISTS SHALL BE DESIGNED TO MEET THE DEFLECTION CRITERIA BELOW UNLESS NOTED OTHERWISE ON PLAN. MULHERN + KULP CANNOT BE HELD RESPONSIBLE FOR ANY STRUCTURAL ISSUES RELATED TO ANY BUILDING COMPONENT IF COMPONENT SHOP DRAWINGS ARE NOT SUBMITTED TO MKF FOR REVIEW PRIOR TO FABRICATION, DELIVERY, OR INSTALLATION.

TRUSSES/JOISTS SHALL BE DESIGNED SO THAT DIFFERENTIAL DEFLECTION BETWEEN ADJACENT PARALLEL TRUSSES/JOISTS OR GIRDERS TRUSSES/FLUSH BEAMS DO NOT EXCEED THE FOLLOWING:  
A. ROOF TRUSSES:  
1/4" DEAD LOAD  
B. ATTIC TRUSSES, & I-JOISTS:  
1/8" DEAD LOAD  
ABSOLUTE DEAD LOAD DEFLECTION OF ATTIC TRUSSES WHEN ADJACENT TO FLOOR FRAMING BY OTHERS SHALL BE LIMITED TO 3/16". (NOT DIFFERENTIAL DEFLECTION)

### VENEER LINTEL SCHEDULE

SPAN (MAX)	HEIGHT OF VENEER ABOVE LINTER	STEEL ANGLE SIZE
3'-0"	20 FT. MAX	L3"x3 1/4"
	3 FT. MAX	L3"x3 1/4"
6'-0"	12 FT. MAX	L4"x3 1/4"
	20 FT. MAX	L5"x3 1/2"x3 1/2"
8'-0"	3 FT. MAX	L4"x4" x 1/4"
	12 FT. MAX	L5"x3 1/2"x3 1/2"
	16 FT. MAX	L6"x3 1/2"x3 1/2"
9'-6"	12 FT. MAX	L6"x3 1/2"x3 1/2"

ALL LINTELS  
- SHALL SUPPORT 2 3/4" - 3 1/2" VENEER w/ 40 psf MAXIMUM HEIGHT.  
- 16" SHALL HAVE 4" MIN BEARING.  
- 16" SHALL HAVE 8" MIN BEARING.  
- 16" SHALL NOT BE FASTENED BACK TO HEADER.  
- 16" SHALL BE FASTENED BACK TO WOOD HEADER IN WALL @ 48" O.C. w/ 1/2" DIA. x 3 1/2" LONG ANCHORS. (DO NOT USE IN BRICK OR CMU WALLS WITH "SLOTTED HOLES").  
- MAX. VENEER HT. APPLIES TO ANY PORTION OF BRICK OVER THE OPENING.  
- ALL LINTELS SHALL BE LONG LEG VERTICAL.  
- WHEN SUPPORTING VENEER, 1/3" WIDE THE EXTERIOR TOE OF THE HORIZONTAL LEG MAY BE CUT OUT. THE LEG IS TO BE MADE OVER THE BEARING LENGTH ONLY. THIS IS TO ALLOW FOR MORTAR JOINT FINISHES.  
- SEE STRUCTURAL PLANS FOR ANY LINTEL CONDITION NOT ENCOMPASSED BY THE ABOVE PARAMETERS.  
\* FOR QUEEN VENEER USE L4x3 1/4".

### GENERAL STRUCTURAL NOTES

#### FOUNDATION

- DESIGN IS BASED ON 2018 NCSBC-RESIDENTIAL CODE

- FOOTING DESIGN - 2,000 PSF NET ALLOWABLE SOIL BEARING PRESSURE IS ASSUMED. BUILDER/CONTRACTOR MUST VERIFY.
- FASTEN 2x4/6 SILL PLATES TO CONC FND WITH A MINIMUM OF 2 ANCHORS PER PLATE, 12" MAX. FROM PLATE ENDS - UTILIZING:  
• 1/2" DIA. ANCHOR BOLTS @ 6"-0" O.C., 1" MIN. EMBEDMENT  
• FA4 ANCHOR STRAPS @ 6"-0" O.C.

- FASTEN 2x10 SILL PLATES TO PRECAST BSMT WALLS WITH A MINIMUM OF 2 ANCHORS PER PLATE, 12" MAX. FROM PLATE ENDS - UTILIZING:  
• 1/2" DIA. BOLTS @ 2'-0" O.C.

- ALL LUMBER EXPOSED TO WEATHER OR IN CONTACT W/ PERIMETER FOUNDATION SHALL BE PRESERVATIVE TREATED SOUTHERN PINE #2.

- BUILDER TO VERIFY CORROSION-RESISTANCE COMPATIBILITY OF HARDWARE & FASTENERS IN CONTACT w/ PRESERVATIVE-TREATED WOOD. CONTACT LUMBER & HARDWARE SUPPLIERS TO COORD.

- FOUNDATION WALLS & FOOTINGS SHALL BE PLAIN CONCRETE, U.N.O.

- CONCRETE DESIGN BASED ON ACI 318. CONCRETE SHALL ATTAIN THE FOLLOWING MIN. COMPRESSIVE STRENGTHS IN 28 DAYS, U.N.O.:  
Fc = 4,000 psi: ..... FOUNDATION WALLS

- 3,000 psi: ..... FOOTINGS & EXTERIOR SLABS ON GRADE  
3,500 psi: ..... GARAGE & EXTERIOR SLABS ON GRADE  
fy = 60,000 psi

- BASEMENT FOUNDATION WALL DESIGN BASED ON:  
• 8' OR 9' HEIGHT (AS NOTED ON PLANS)  
- TALLER WALLS MUST BE ENGINEERED.

- BASEMENT WALL DESIGN IS BASED ON 30 OR 45 PCF BACKFILL SOIL TYPE CLASSIFICATIONS:

- 30 PCF TYPE (GM, GP, SW, SP)  
45 PCF TYPE (GM, GC, SM, SM-SC, ML)
- IMPORTANT - IF 60 PCF SOIL TYPE (SC, ML-CL, OR CL) IS UTILIZED FOR BACKFILL, CONTACT MULHERN + KULP FOR FURTHER EVALUATION OF FOUNDATION DESIGN.

- BASEMENT WALLS SHALL BE BRACED, PRIOR TO BACKFILLING, BY ADEQUATE TEMPORARY BRACING OR INSTALL 1st FLOOR DECK.

- ALL CONCRETE EXPOSED TO THE WEATHER SHALL NOT HAVE LESS THAN 5% OR MORE THAN 1% AIR ENTRAINMENT.

- ALL FOOTINGS SHALL BEAR BELOW FROST LINE (TYP.) OR 12" MIN IN REGIONS WHERE CODE FROST DEPTH IS NOT APPLICABLE. CONSULT SOILS REPORT OR BUILDING DEPT. FOR MINIMUM DEPTH BELOW GRADE.

- FOOTINGS AND SLABS ON GRADE SHALL BEAR ON VIRGIN SOIL OR 95% COMPACTED FILL.

- PROVIDE CONTROL JOINTS AT ALL INSIDE CORNERS OF SLAB EDGES, AND OTHER LOCATIONS WHERE SLAB CRACKS ARE LIKELY TO DEVELOP.

- JOINTS SHALL BE LOCATED @ 10'-0" O.C. (RECOMMENDED) OR 15'-0" O.C. (MAXIMUM)  
JOINT GRID PATTERN SHALL BE AS CLOSE TO SQUARES AS POSSIBLE (1:1 RATIO), WITH A MAXIMUM OF 1:15 RATIO  
CONTROL JOINTS SHALL NOT BE INSTALLED IN STRUCTURAL SLABS

- TYPICAL REINFORCEMENT DETAILS: PROVIDE 3" MIN. CLEAR COVER WHERE CAST AGAINST EARTH, 1 1/2" MIN. CLEAR COVER AGAINST FORMS. LAP ALL REBAR 48 BAR DIAMETERS MIN. (24" FOR #4 BARS) & BEND BARS AND LAP AT CORNERS. PROVIDE 6" HOOK INTO SUPPORTING FOOTINGS WHEN FOOTINGS INTERSECT.

- DIMENSIONS BY OTHERS, BUILDER TO VERIFY.

### LATERAL/WALL BRACING & WALL SHEATHING SPECIFICATIONS

THIS MODEL HAS BEEN DESIGNED TO RESIST LATERAL FORCES RESULTING FROM:  
**120MPH WIND IN 2018 NCSBC:RC**

**& 120MPH WIND IN 2018 IRC**

(120 MPH WIND SPEED IN ASCE 7  
WIND MAP, PER IRC R301.2.1.)  
EXP. B, RISK CAT. 2 & SEISMIC CAT. A/B.

THE DESIGN WAS COMPLETED PER 2015 & 2018 IBC (SECTION 1609) & ASCE 7, AS PERMITTED BY R301.3

OF THE 2018 NCSBC:RC & 2018IRC. IF THE PARAMETERS OF SECTION R602.12 COMPLY, ACCORDINGLY, THIS MODEL, AS DOCUMENTED AND DETAILED HEREINWITH, IS ADEQUATE TO RESIST THE CODE REQUIRED LATERAL FORCES.

DESIGN WIND UPLIFT LOADS HAVE BEEN CALCULATED UTILIZING ASCE 7 (ACCEPTED ENGINEERING PRACTICE) AS ALLOWED FOR 2018 NCSBC:RC & 2018IRC SECTION R802.11.I. THIS MODEL HAS BEEN DETAILED WHERE REQUIRED & ENGINEERED TO RESIST THE WIND UPLIFT LOAD PATH PER SECTIONS R602.3.5 & R802.11.

#### EXT. WALL SHEATHING SPECIFICATION

- 1/16" OSB OR 15/32" PLYWOOD:

FASTEN SHEATHING w/ 2 1/2" x 0.131 NAILS @ 6" O.C. AT EDGES & @ 12" O.C. IN THE PANEL FIELD. (TYP. U.N.O.)

- ALL SHEATHING PANELS SHALL BE ORIENTED VERTICALLY (LONG DIRECTION PARALLEL TO STUDS) AND INSTALLED FULL HEIGHT OF SHEAR WALL - OR - 2x HORIZONTAL BLOCKING SHALL BE PROVIDED TO SUPPORT ALL UNSUPPORTED PANEL EDGES & EDGE FASTENING.

- ALL EXT. WALLS SHALL BE CONTINUOUSLY SHEATHED AND ARE CONSIDERED SHEAR WALLS.

- ALT. STAPLE CONNECTION SPEC: 1 3/4" 16 GA STAPLES (1/8" CROWN) @ 3" O.C. AT EDGES & @ 6" O.C. IN FIELD.

#### 3" O.C. EDGE NAILING

- AT DESIGNATED AREAS - FASTEN PANEL EDGES OF WOOD STRUCTURAL WALL SHEATHING TO FRAMING w/ 2 1/2" x 0.131 NAILS @ 3" O.C. AND 12" O.C. IN THE PANEL FIELD. NO STAPLE ALTERNATIVE AVAILABLE AT THIS SPEC. ALL SHEATHING PANELS SHALL BE ORIENTED VERTICALLY (LONG DIRECTION PARALLEL TO STUD) AND INSTALLED FULL HEIGHT OF SHEAR WALL - OR - 2x HORIZONTAL BLOCKING SHALL BE PROVIDED TO SUPPORT UNSUPPORTED PANEL EDGES AND 3" O.C. EDGE FASTENING.

#### NOTES

- SEE CONNECTION SPECIFICATIONS CHART FOR STANDARD SHEAR TRANSFER DETAILING. IF ADDITIONAL CAPACITY IS REQUIRED BY DESIGN, IT WILL BE SPECIFICALLY NOTED ON PLAN.

- DESIGN ASSUMES 16" O.C. MAX. STUD SPACING, U.N.O.

- ALL STRUCTURAL PANELS ARE TO BE DIRECTLY APPLIED TO STUD FRAMING.

- PRE-MANUFACTURED PANELIZED WALLS:  
FASTEN TOGETHER END STUDS OF WALL PANELS SHEATHED w/ OSB OR PLYWOOD w/ 3" x 0.120" NAILS @ 6" O.C. (THRU ONE SIDE ONLY)

- INDICATES EXTENT OF INT. OSB SHEARWALL, AND/OR 3" O.C. EDGE NAILING

- INDICATES HOLDDOWN

MKF STD. - MAR 2016

### FLOOR FRAMING

- I-JOISTS SHALL BE DESIGNED BY MANUF. TO MEET OR EXCEED L/480 LIVE LOAD DEFLECTION CRITERIA. (EXCLUDES STONE/MARBLE OR MET BED CONSTRUCTED FLOORS - CONTACT MKF FOR EXCLUDED FLOOR DESIGNS)

- PER THE GUIDELINES OF THE TILE COUNCIL OF NORTH AMERICA (TCNA HANDBOOK), IT SHALL BE THE FLOOR FINISH INSTALLER'S RESPONSIBILITY TO VERIFY THAT THE FINISHES TO BE INSTALLED MATCH THE DESIGN CRITERIA NOTED ABOVE (UNDER "DESIGN LOADS").

- FLOOR SYSTEMS & SHEATHING HAVE BEEN DESIGNED TO SUPPORT ADDITIONAL DEAD LOAD FROM CERAMIC TILE (EXCLUDING MARBLE OR STONE). HOWEVER, IT SHALL BE THE FLOOR FINISH INSTALLER'S RESPONSIBILITY TO PROVIDE PROPER UNDERLAYMENT, UNCOUPLING MEMBRANE AND MORTAR/GROUT PER THE ASSEMBLY DESIGNATIONS IN THE TCNA HANDBOOK (TITLE COUNCIL OF NORTH AMERICA).

- AT I-JOIST FLOORS, PROVIDE 1" MIN. OSB RIM BOARD.

- METAL HANGERS SHALL BE SPECIFIED BY MANUFACTURER, U.N.O.

- I-JOIST SHOP DNGS. SHALL BE SUBMITTED TO ARCH. & ENG. FOR REVIEW AND APPROVAL PRIOR TO FABRICATION OR DELIVERY.

- FLOOR SHEATHING SHALL BE 23/32" A.P.A. RATED 'STUD-I-FLOOR' 24" O.C. EXPOSURE I (OR APPROVED EQUAL) WITH TONGUE AND GROOVE EDGES. FASTEN TO FRAMING MEMBERS w/ GLUE AND

- 2 1/2" x 0.131 NAILS @ 6" O.C. & PANEL EDGES @ 12" O.C. FIELD.  
- 2 3/8" x 0.120" NAILS @ 4" O.C. & PANEL EDGES @ 8" O.C. FIELD.  
- 2 3/8" x 0.113" NAILS @ 3" O.C. & PANEL EDGES @ 6" O.C. IN FIELD.


- 2 3/8" x 0.113" NAILS @ 3" O.C. & PANEL EDGES @ 6" O.C. IN FIELD.

- EXT. & INT. BEARING WALLS SHALL BE 2x4 OR 2x6 (AS SHOWN ON PLANS) @ 16" O.C. SPF/SPF "STUD" GRADE LUMBER, OR BETTER, U.N.O.

- WALLS OVER 12' TALL SHALL BE PER PLAN.

- ALL INTERIOR BEARING WALLS ARE ASSUMED TO BE SHEATHED w/ GYP WALL BOARD (ONE SIDE MIN) OR PROVIDE MID HT. BLOCKING.

- ALL

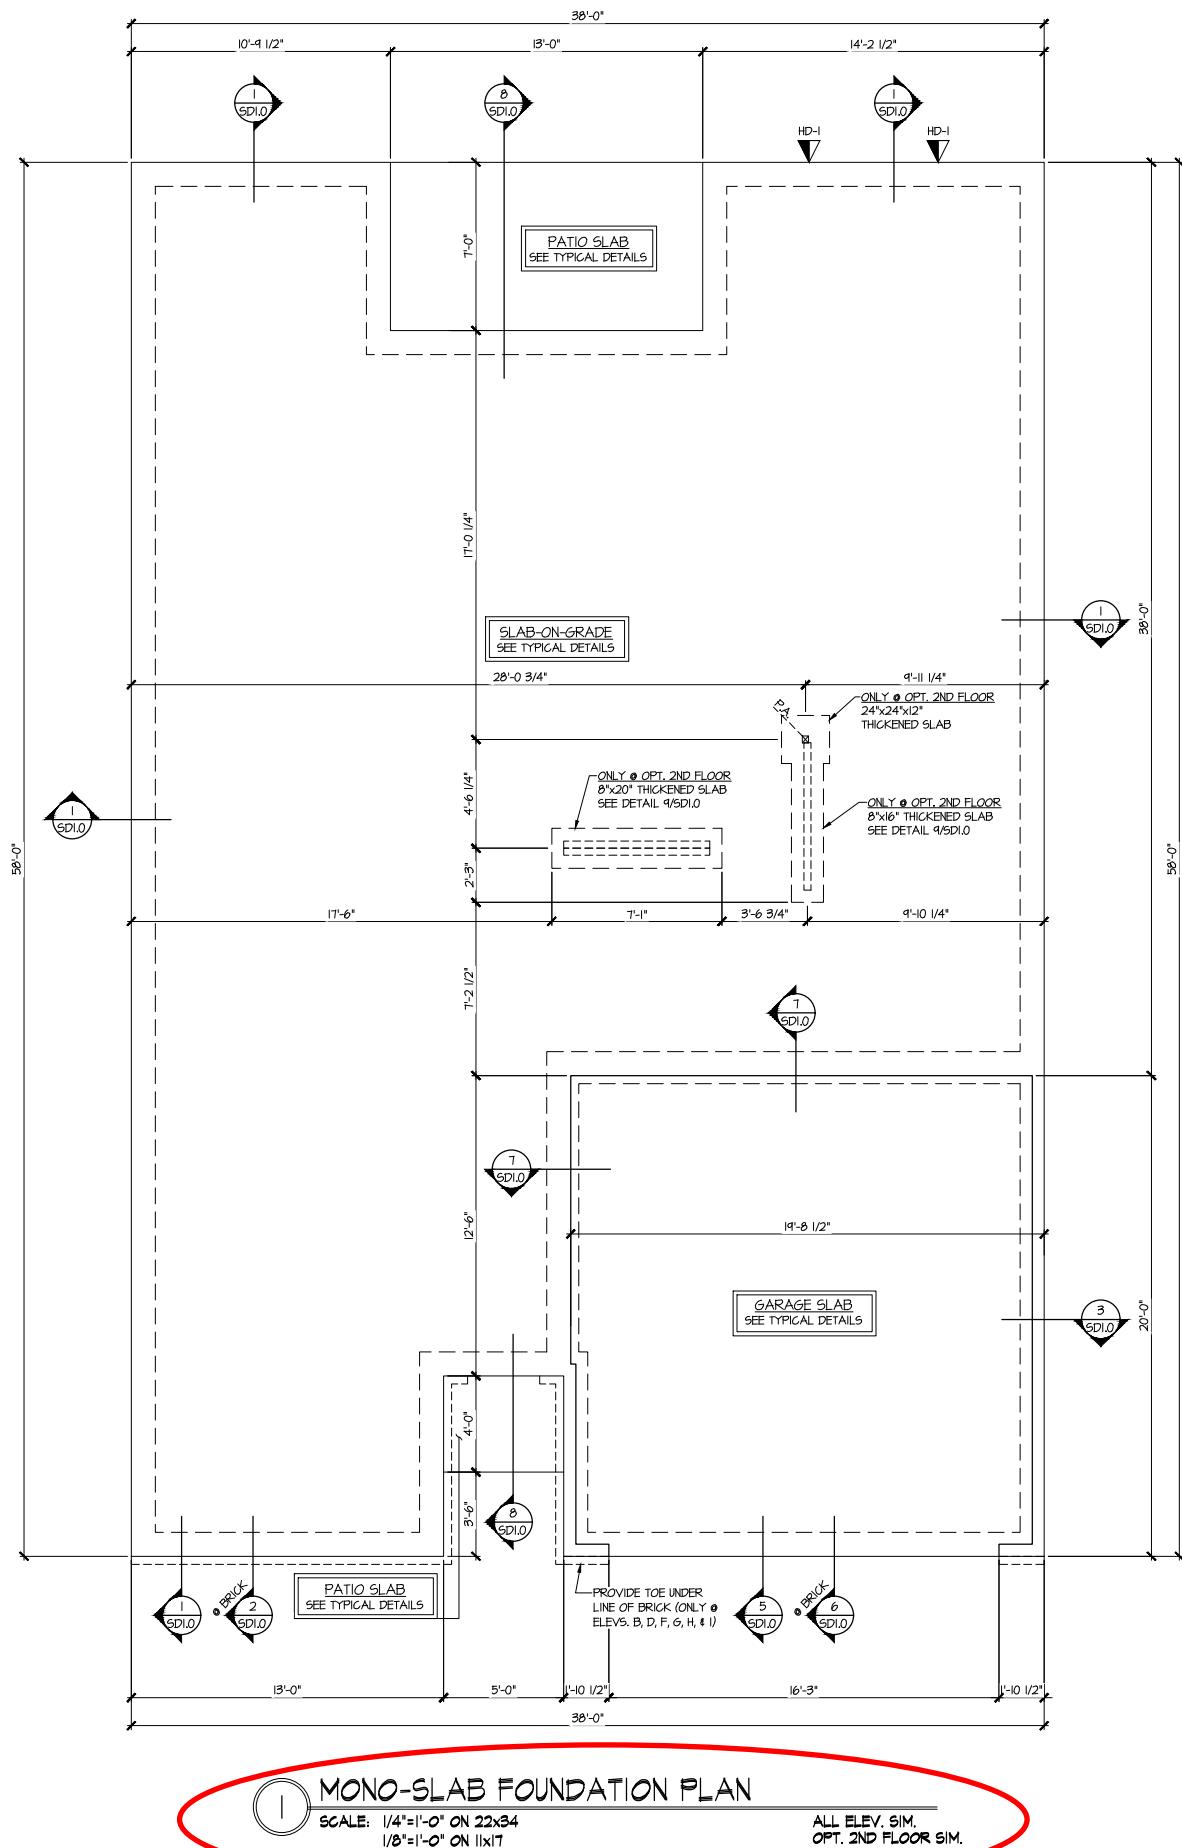

# MONO-SLAB FOUNDATION PLAN

SCALE: 1/4"=1'-0" ON 22x34  
1/8"=1'-0" ON 11x17

ALL ELEV. SIM.  
OPT. 2ND FLOOR SIM.

## HOLD-DOWN SCHEDULE

SYMBOL	SPECIFICATION
▶ HD-1	USP HT45 HOLD-DOWN w/ STB16 ANCHOR BOLT *
▶ HD-2	USP STADI4 HOLD-DOWN STRAP
▶ HD-3	USP MSTC40 HOLD-DOWN STRAP

## ALTERNATIVE TO STB16 ANCHOR BOLT SPECIFICATION:

\* ANCHOR HOLD-DOWN UTILIZING THREADED ROD (REFER TO USP SPECIFICATION FOR ANCHOR DIAMETER). EPOXY-SET INTO CONCRETE FOUNDATION w/ USP CIA-GEL 7000 EPOXY SYSTEM PER MANUF. RECOMMENDATIONS.

CONC. FOUND. - PROVIDE 9" MIN. EMBEDMENT INTO CONCRETE.

**DO NOT LOCATE EPOXY-SET ANCHORS WITHIN 1 3/4" OF FACE OF**

SMALL FOUNDATION TESTS: EPOXY SET ANCHORS ATTACHED TO FACE OF CONCRETE FOUNDATION.

CMU FOUND. - PROVIDE 12" MIN. EMBEDMENT INTO SOLID GROUTED CELLS. DO NOT LOCATE FROXX SET ANCHORS WITHIN 3"

GROUTED CELLS. DO NOT LOCATE EPOXY-SET ANCHORS WITHIN 3" OF EDGE OF CMI FOUNDATION

**Harrington  
Lot 24**

REFER TO 50.0 FOR TYPICAL  
STRUCTURAL NOTES & SCHEDULES

## LEGEND

- ROOF TRUSSES @ 24" O.C. PER ROOF.  
(P.U.N.O.)

TRUSS OVERFRAMING @  
TYP. U.N.O.)

14" DEEP FLOOR I-JOISTS (24" O.C. MAX  
JOIST SERIES AND SPACING SHALL BE  
ONSIBILITY OF THE JOIST MANUFACTURER  
2x8 P.T. DECK JOISTS @ 16" O.C. (MAX)

LOCATIONS OF POTENTIAL TILE FLOOR.  
UFACTURER SHALL DESIGN FLOOR  
OR ADD'L 10 PSF DEAD LOAD AT THESE  
S.

RING WALL

L ABOVE (B.W.A.)

R

A ABOVE (P.A) PROVIDE SOLID  
R POST OR JAMB ABOVE.

MONO-SLAB FOUNDATION

**BRADLEY MC  
NORTHS CAROLINA**

SMITH DOUGLAS  
195

ulhern+Kulp project number:  
**256-21011**

---

project mgr: **SMK**  
rawn by: **MFJ**  
issue date: **02-21-2022**

REVISIONS:  
date: initial:  
3/09/2022 KMV  
~~ERRRORED PLANS ADDED~~  
8/1/2022 SMM  
~~DATE REB. ARCH COMMENTS~~

SMITH DOUGLAS  
HOMES

MONO-SLAB FOUNDATION

meet

S1.0



**MULHERN+KULP**  
RESIDENTIAL STRUCTURAL ENGINEERING  
120 MPH Wind Zone, Sales Tax Address: 84-3802  
170-777-4444 • [www.m-k.com](http://www.m-k.com)

N.C. License # C-3825

Mulhern+Kulp project number:  
256-21011

project mgr: SMK  
drawn by: MJF  
issue date: 02-21-2022

REVISIONS:  
date: initial:  
03/09/2022 KMV  
MIRRORED PLANS ADDED  
08/11/2022 SMM  
UPDATE PER ARCH COMMENTS

SMITH DOUGLAS  
HOMES

BRADLEY MODEL  
120 MPH WIND ZONE  
NORTH CAROLINA


OPTIONS

sheet:

**S4.3**

Harrington  
Lot 24


LEGEND	
• R.T.	INDICATES ROOF TRUSSES @ 24" O.C. PER ROOF. MANUF. (TYP. U.N.O.)
• O.F.	INDICATES TRUSS OVERFRAMING @ 24" O.C. (TYP. U.N.O.)
• F.J.	INDICATES 14" DEEP FLOOR I-JOISTS (24" O.C. MAX SPACING). JOIST SERIES AND SPACING SHALL BE THE RESPONSIBILITY OF THE JOIST MANUFACTURER
• D.J.	INDICATES 2x8 P.T. DECK JOISTS @ 16" O.C. (MAX)
• ━━	INDICATES LOCATIONS OF POTENTIAL TILE FLOOR. JOIST MANUFACTURER SHALL DESIGN FLOOR SYSTEM FOR ADDL 10 PSF DEAD LOAD AT THESE LOCATIONS.
• ━━━━	INTERIOR BEARING WALL
• ━━━━	BEARING WALL ABOVE (B.W.A.)
• - - -	BEAM/HEADER
• JL	METAL HANGER
• *	INDICATES POST ABOVE (P.A.) PROVIDE SOLID BLOCKING UNDER POST OR JAMB ABOVE.

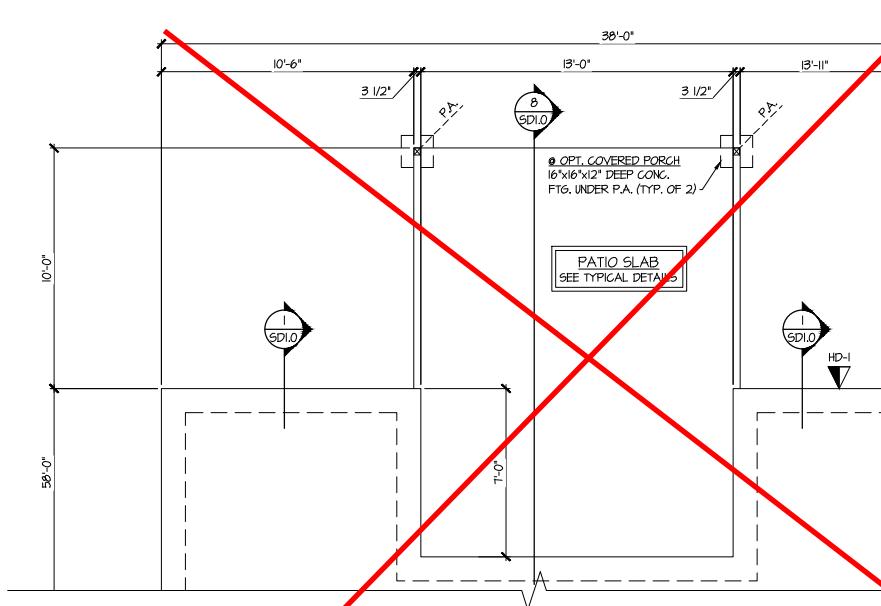

**1 MONO-SLAB FOUNDATION PLAN**

SCALE: 1/4"=1'-0" ON 22x34  
1/8"=1'-0" ON 11x17


OPT. PATIO  
(COVERED PATIO SIM.)  
ALL ELEV. SIM.

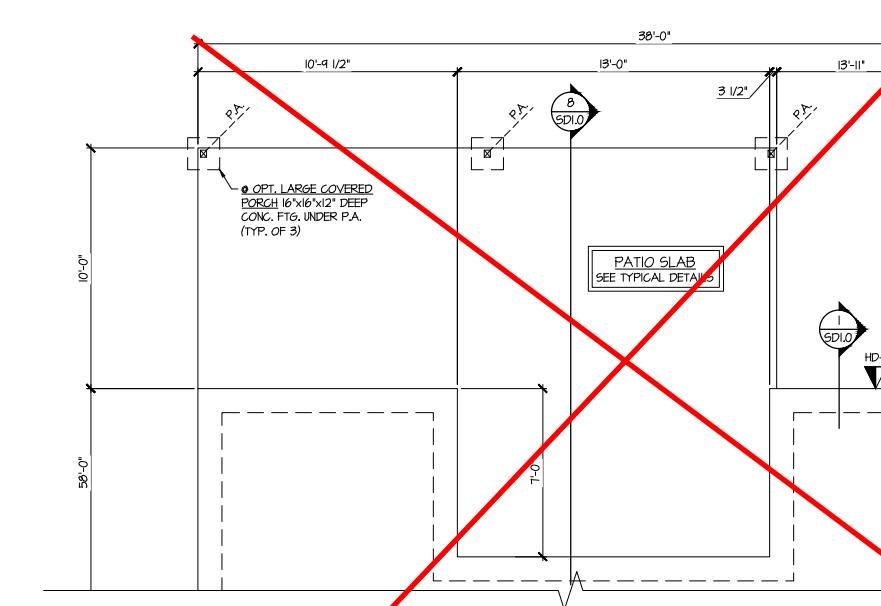

**2 MONO-SLAB FOUNDATION PLAN**

SCALE: 1/4"=1'-0" ON 22x34  
1/8"=1'-0" ON 11x17


OPT. LARGE PATIO  
(EXT. COVERED PATIO)  
ALL ELEV. SIM.

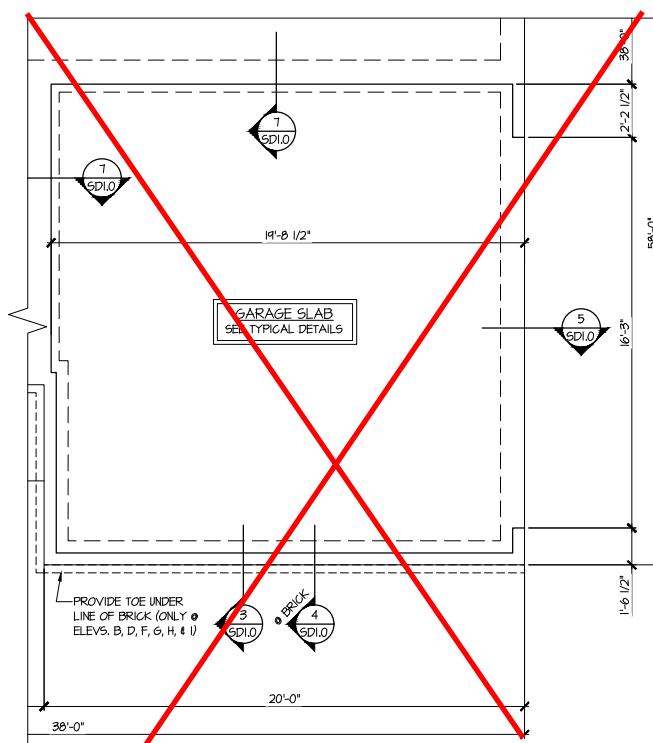

**3 MONO-SLAB FOUNDATION PLAN**

SCALE: 1/4"=1'-0" ON 22x34  
1/8"=1'-0" ON 11x17


OPT. SIDE ENTRY GARAGE  
ALL ELEV. SIM.

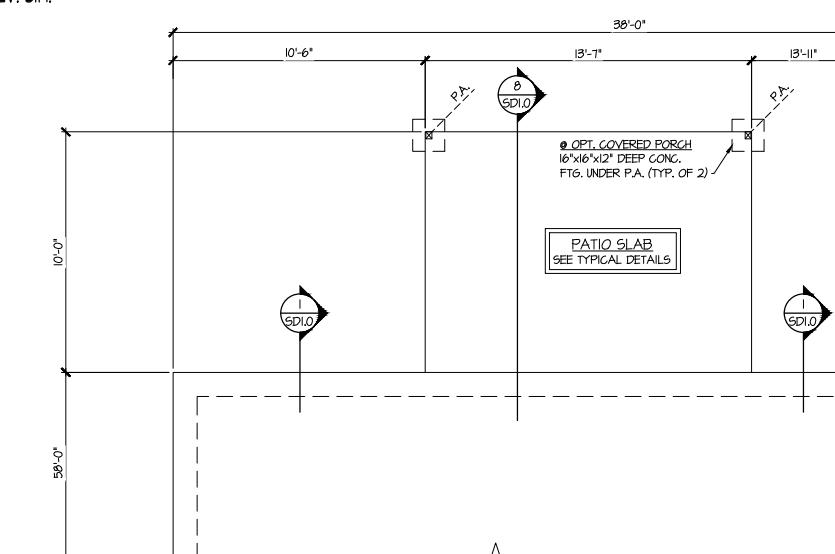

**4 MONO-SLAB FOUNDATION PLAN**

SCALE: 1/4"=1'-0" ON 22x34  
1/8"=1'-0" ON 11x17

OPT. FAMILY ROOM EXT.  
(W/ COVERED PATIO)  
ALL ELEV. SIM.

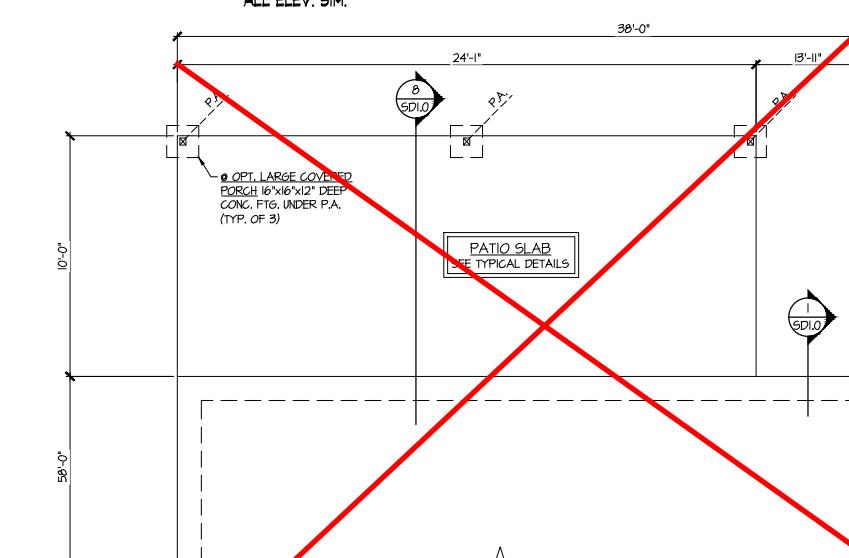


**5 MONO-SLAB FOUNDATION PLAN**

SCALE: 1/4"=1'-0" ON 22x34  
1/8"=1'-0" ON 11x17

OPT. FAMILY ROOM EXT.  
W/ EXT. (COVERED) PATIO  
ALL ELEV. SIM.

REFER TO 50.0 FOR TYPICAL  
STRUCTURAL NOTES & SCHEDULES


sheet:

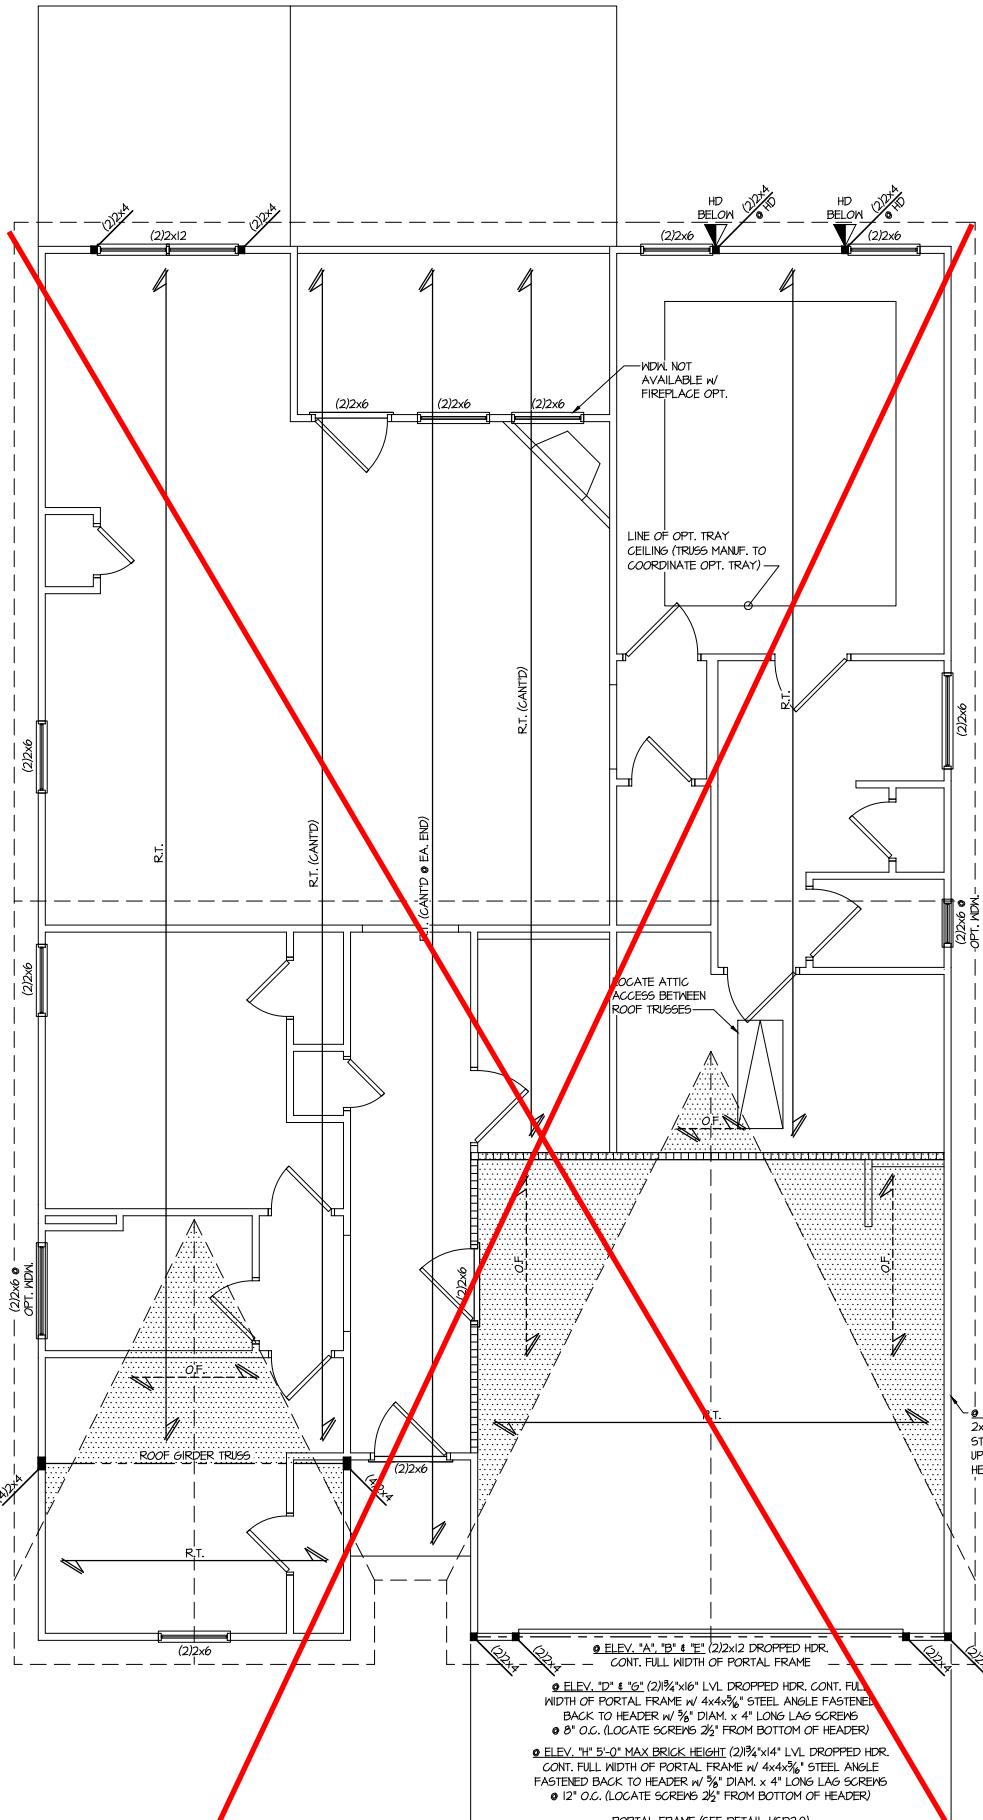

# ROOF FRAMING PLAN

SCALE: 1/4"=1'-0" ON 22x34  
1/8"=1'-0" ON 11x17

ELEV. A, B, D, E, G, & H

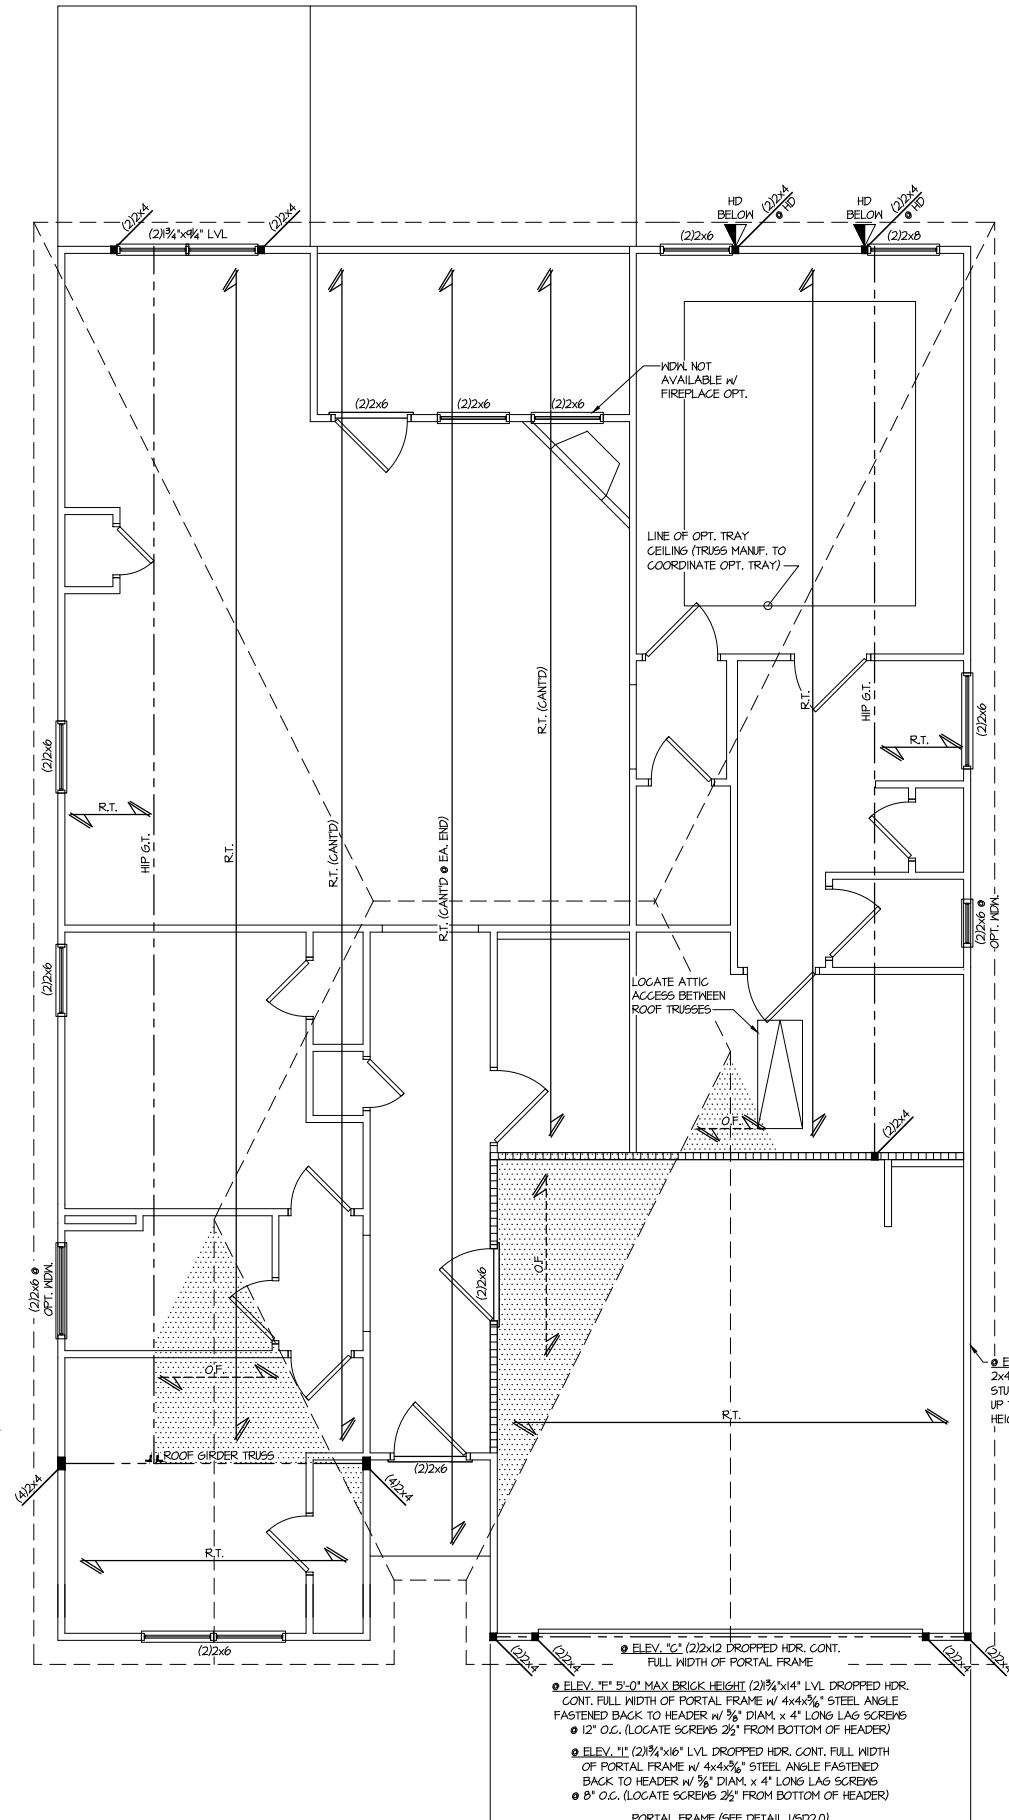

## ~~ROOF FRAMING PLAN~~

SCALE: 1/4"=1'-0" ON 22x36  
1/8"=1'-0" ON 11x17

ELEV. C, F, 4

Harrington  
Lot 24

REFER TO 50.0 FOR TYPICAL  
STRUCTURAL NOTES & SCHEDULES

LEGEND

- OF TRUSSES @ 24" O.C. PER ROOF.  
N.O.)  
SS OVERFRAMING @  
N.O.)  
DEEP FLOOR I-JOISTS (24" O.C. MAX  
T SERIES AND SPACING SHALL BE  
BILITY OF THE JOIST MANUFACTURER  
P.T. DECK JOISTS @ 16" O.C. (MAX)  
ATIONS OF POTENTIAL TILE FLOOR  
CTURER SHALL DESIGN FLOOR  
DD'L 10 PSF DEAD LOAD AT THESE  
WALL  
OVE (B.W.A.)  
OVE (P.A.) PROVIDE SOLID  
ST OR JAMB ABOVE.

**MULHERN+KULP**  
RESIDENTIAL STRUCTURAL ENGINEERING  
 2000 N. BROAD ST., SUITE 1000 • PHILADELPHIA, PA 19105 • 215.923.3000

+Kulp project number:  
256-21011

ngr: SMK  
r: MJF  
e: 02-21-2022

IS:  
initial:  
1/2022 KMV  
PLANS ADDED  
/2022 SMM  
ARCH COMMENTS

SMITH DOUGLAS  
HOMES

ROOF FRAMING PLAN


**1120 MPH WIND ZONE  
NORTH CAROLINA**

1

S3.0




5/1/2015  
ERN & KULP  
Structural Engineering, Inc.

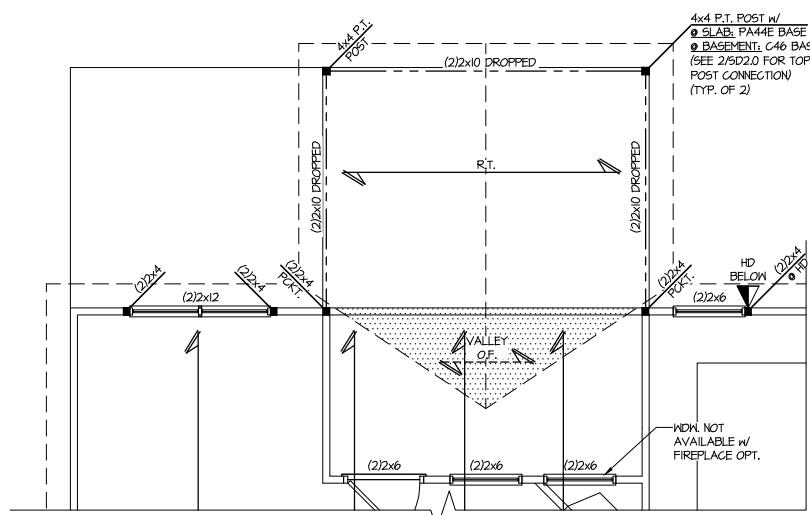


## ROOF FRAMING PLAN


SCALE: 1/4"=1'-0" ON 22x34  
1/8"=1'-0" ON 11x17

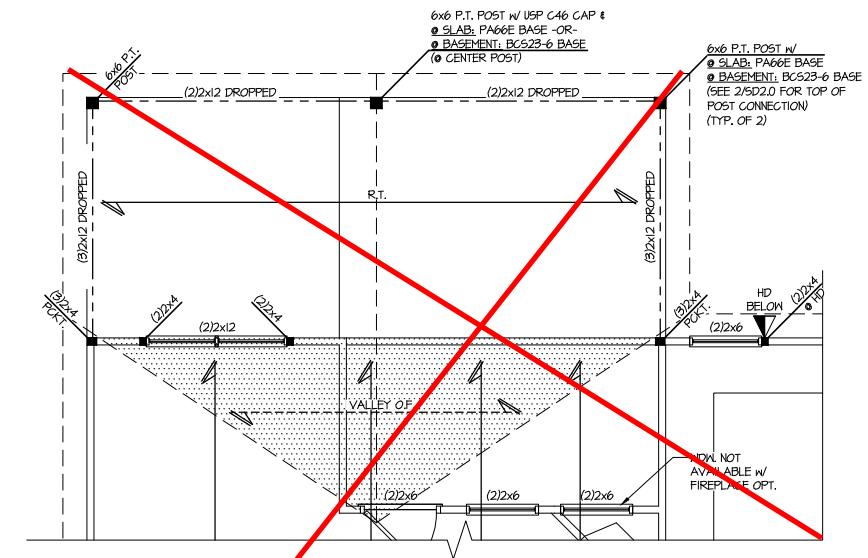

## ~~ROOF FRAMING PLAN~~

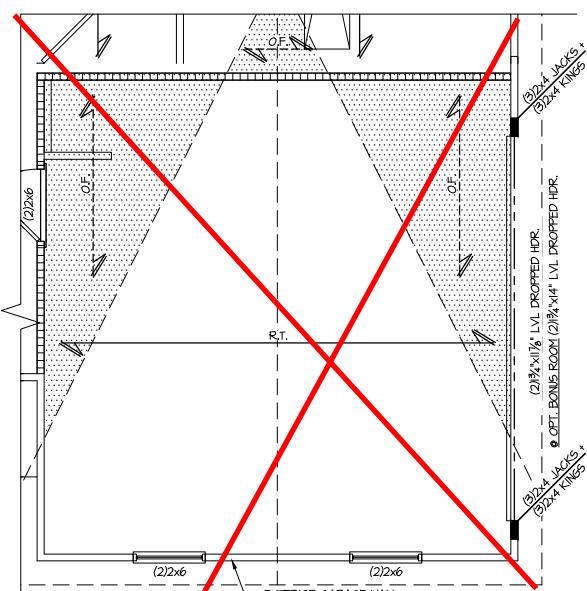

## ~~3~~ ROOF FRAMING PLAN

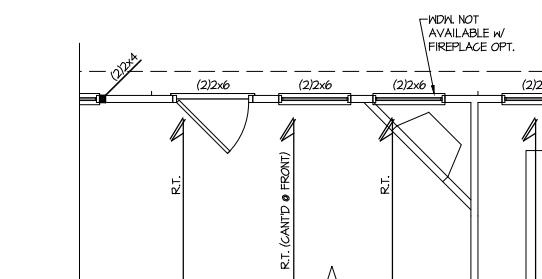

## 4 ROOF FRAMING PLANS

4 SCALE: 1/4"=1'-0" ON 22x34 OPT. FAMILY ROOM E.  
1/8"=1'-0" ON 11x17 ALL ELEV. S.

Harrington  
Lot 24

REFER TO 50.0 FOR TYPICAL  
STRUCTURAL NOTES & SCHEDULES

#### LEGEND

- INDICATES ROOF TRUSSES @ 24" O.C. PER ROOF.  
MANUF. (TYP. UNO.)
  - INDICATES TRUSS OVERFRAMING @  
24" O.C. (TYP. UNO.)
  - INDICATES 14" DEEP FLOOR I-JOISTS (24" O.C. MAX  
SPACING). JOIST SERIES AND SPACING SHALL BE  
THE RESPONSIBILITY OF THE JOIST MANUFACTURER
  - INDICATES 2x8 P.T. DECK JOISTS @ 16" O.C. (MAX)
  - INDICATES LOCATIONS OF POTENTIAL TILE FLOOR.  
JOIST MANUFACTURER SHALL DESIGN FLOOR  
SYSTEM FOR ADD'L 10 PSF DEAD LOAD AT THESE  
LOCATIONS.
  - INTERIOR BEARING WALL
  - BEARING WALL ABOVE (B.W.A.)
  - BEAM/HEADER
  - METAL HANGER
  - INDICATES POST ABOVE (P.A.) PROVIDE SOLID  
BLOCKING UNDER POST OR JAMB ABOVE.

OPTIONS

BRADLEY MODEL  
1900-1910 LITTLE TONIE

120 MPH WIND ZONE  
NORTH CAROLINA

heet

4.2



MULHERN+KULP  
RESIDENTIAL STRUCTURAL ENGINEERING  
17077 Brierwood, Suite 105 • Alpharetta, GA 30025  
NC License # C-3825

ALT TO ANCHOR BOLTS:  
USP FA4 MIDSLV ANCHORS @ 6'-0"  
o.c. PROVIDE (2) PER PLATE, MIN. 12"  
FROM EACH END.

FASTEN SHEATHING TO  
SILL PLATE PER EXT.  
WALL/ SHEARWALL EDGE  
NAILING REQUIREMENTS  
(SEE PLANS)

TYPICAL SLAB ON GRADE  
PERIMETER FOOTING



TYP. SILL PLATE:  
2x4 P.T. PLATE w/  $\frac{1}{2}$ " O.B. @  
6'-0" o.c. PROVIDE (2) PER PLATE,  
MIN. 12" FROM EACH END.

TYP. CONC. SLAB:  
4" CONC. SLAB w/ FIBERMESH ON 6"  
MIL. VAPOR BARRIER ON 4" CRUSHED  
STONE ON 95% COMPACTED FILL

GROUT SOLID TO  
KEEP HOLES @ 24" o.c.

1' AIR GAP

BRICK VENEER PER SPEC  
w/ 1" W x 22GA CORRUGATED  
GALV. METAL WALL TIES

@ 16" o.c. HORIZ. & VERT. (TYP.)

GROUT SOLID TO  
KEEP HOLES @ 24" o.c.

1' AIR GAP

FASTEN SHEATHING TO SILL PLATE  
PER EXT. WALL/ SHEARWALL EDGE  
NAILING REQUIREMENTS  
(SEE PLANS)

TYP. SILL PLATE:  
-SEE 1/SD1.0

TYP. CONC. SLAB:  
-SEE 1/SD1.0

GROUT SOLID TO  
KEEP HOLES @ 24" o.c.

1' AIR GAP

4" BRICK VENEER  
w/ 1" W x 22GA CORRUGATED  
GALV. METAL WALL TIES @ 16"  
o.c. HORIZ. & VERT. (TYP.)

GROUT SOLID TO  
KEEP HOLES @ 24" o.c.

1' AIR GAP

4" CONC. SLAB w/ FIBERMESH ON 4"  
CRUSHED STONE ON 95% COMPACTED  
FILL

-SEE 3/SD1.0

## USE ALTERNATE GARAGE CURB DETAIL

TYPICAL SLAB ON GRADE  
PERIMETER FOOTING



1' AIR GAP

TYP. SILL PLATE:  
-SEE 1/SD1.0

TYP. GARAGE SLAB:  
-SEE 3/SD1.0

GROUT SOLID TO  
KEEP HOLES @ 24" o.c.

1' AIR GAP

4" CONC. SLAB w/ FIBERMESH ON 4"  
CRUSHED STONE ON 95% COMPACTED  
FILL

-SEE 3/SD1.0

TYP. GARAGE SLAB:  
-SEE 3/SD1.0

GROUT SOLID TO  
KEEP HOLES @ 24" o.c.


1' AIR GAP

4" CONC. SLAB w/ FIBERMESH ON 4"  
CRUSHED STONE ON 95% COMPACTED  
FILL


-SEE 3/SD1.0

TYP. GARAGE SLAB:  
-SEE 3/SD1.0

GROUT SOLID TO  
KEEP HOLES @ 24" o.c.

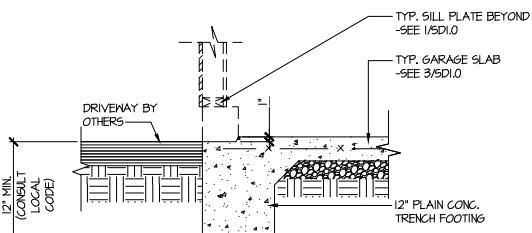


TYPICAL SLAB ON GRADE GARAGE  
ENTRY @ PERIMETER FOOTING

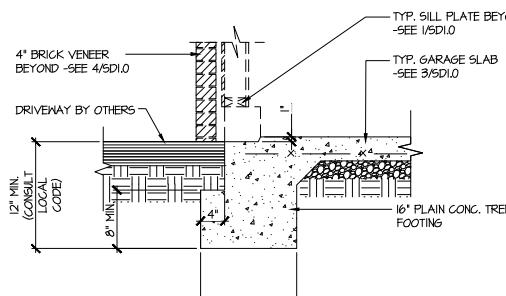


TYPICAL SLAB ON GRADE GARAGE  
ENTRY @ PERIMETER FOOTING



TYPICAL MONOLITHIC INTERIOR  
GARAGE FOOTING

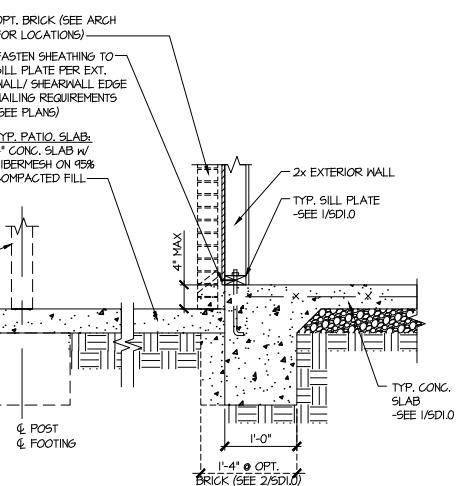

TYPICAL SLAB ON GRADE PERIMETER  
FOOTING @ PORCH/PATIO

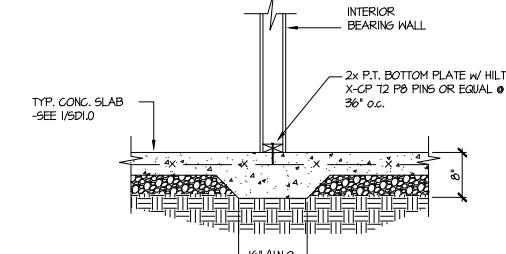

TYPICAL THICKENED SLAB @  
INTERIOR BEARING WALL



FOUNDATION DETAILS

BRADLEY MODEL

120 MPH WIND ZONE  
NORTH CAROLINA

Harrington  
Lot 24

sheet:

SD1.0

Mulhern+Kulp project number:  
256-21011

project mgr: SMK

drawn by: MJF

issue date: 02-21-2022

REVISIONS:

date: 03/09/2022 initial: KMV

MIRRORED PLANS ADDED SMM

08/11/2022 UPDATE PER ARCH COMMENTS

SMITH DOUGLAS  
HOMES



**MULHERN+KULP**  
RESIDENTIAL STRUCTURAL ENGINEERING

3625 Brookside Parkway, Suite 165, Alpharetta, GA 30022 ▶ p 770-777-0074 ▶ mulhernkulp.com

August 18, 2023

Jody Hunt  
Director of Product Development  
**SMITH DOUGLAS HOMES**  
110 Village Trail, Suite 215  
Woodstock, GA 30188

## ALTERNATE GARAGE CURB DETAIL


### Smith Douglas Homes

#### Reference

*Current Structural Plans prepared by Mulhern & Kulp*

Jody:

Pursuant to your request, we have prepared this letter to address the "Alternate Garage Curb Details", prepared by Mulhern & Kulp for Smith Douglas Homes shown below. The foundation details shown below call for a 4" wide curb with a maximum of 8" stem wall height; these are an acceptable alternative to the 6" wide curb at the garage per M&K foundation details 3 & 4 on sheet SD-1.0 at 2x4 garage wall locations.

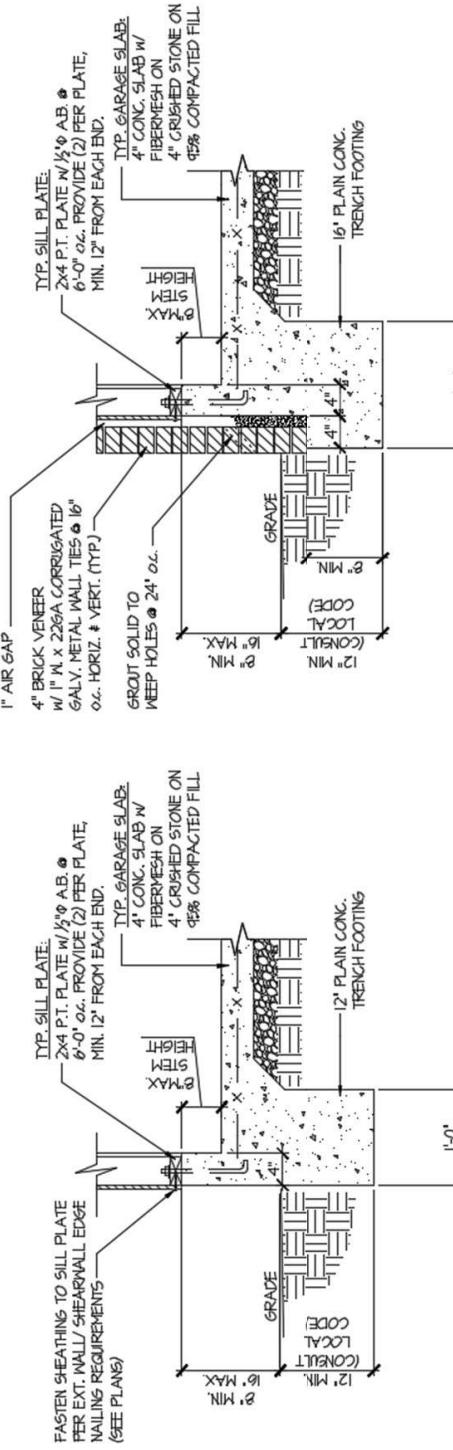

TYPICAL SLAB ON GRADE GARAGE  
A PERIMETER FOOTING

TYPICAL SLAB ON GRADE GARAGE  
B PERIMETER FOOTING

Please feel free to call if you have any questions.

Respectfully,








**MULHERN & KULP STRUCTURAL ENGINEERING, INC.**

NC License # C-3825

Shaun M. Kreidell, P.E. Project Manager + Atlanta Office Director

Signature + Seal 08/18/2023



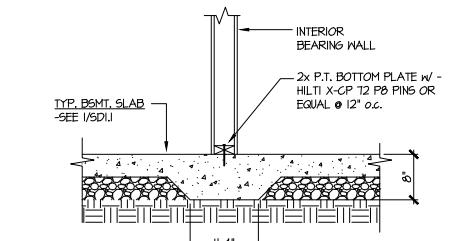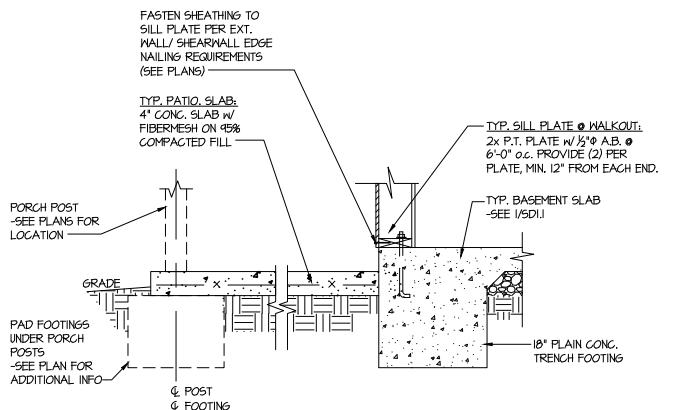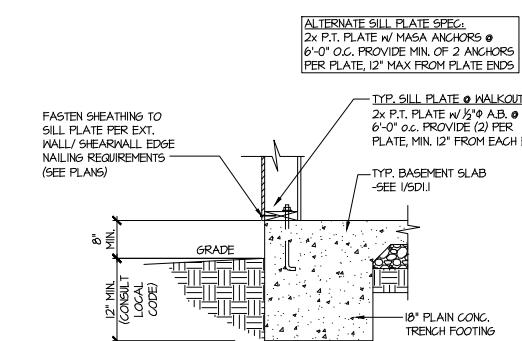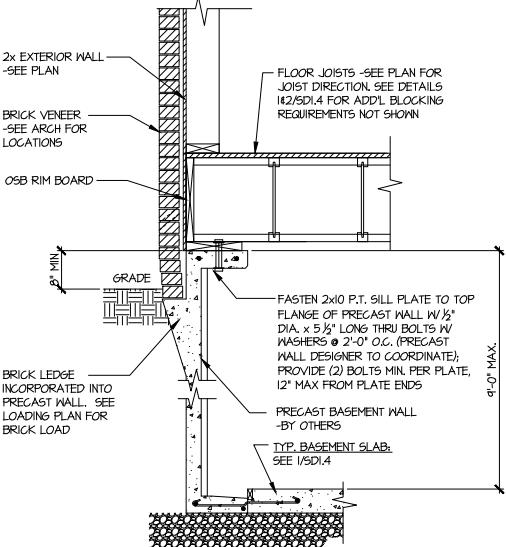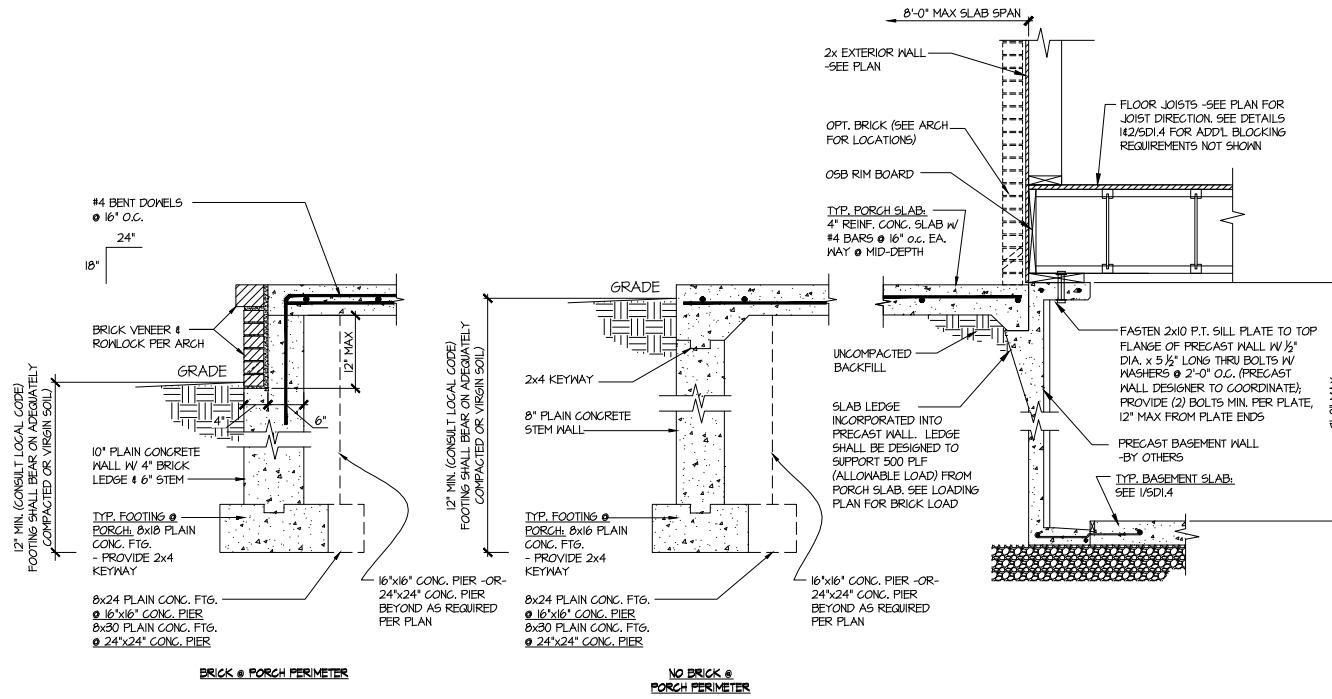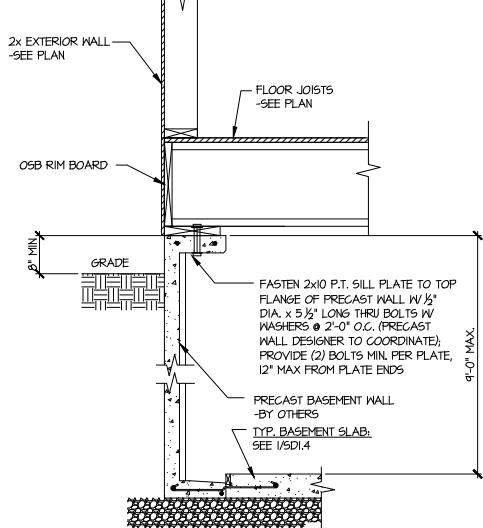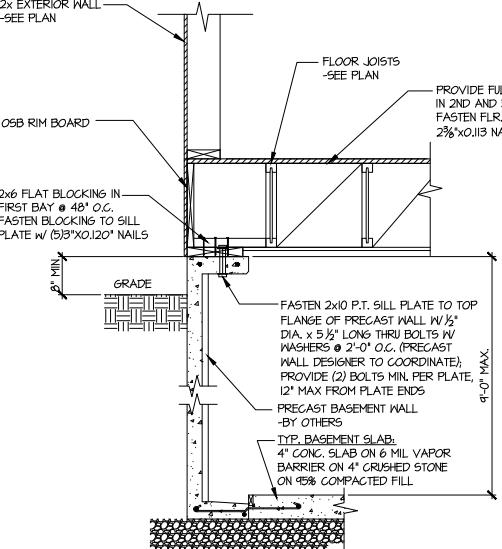

FOUNDATION DETAILS

BRADLEY MODEL

120 MPH WIND ZONE

NORTH CAROLINA

project mgr: SMK  
drawn by: MJF  
issue date: 02-21-2022  
  
REVISIONS:  
date: 03/09/2022 initial: KMV  
08/11/2022 MMF  
08/11/2022 SMM  
UPDATE PER ARCH COMMENTS

**MULHERN+KULP**  
RESIDENTIAL STRUCTURAL ENGINEERING  
1700 University Street, Suite 105, Anchorage, AK 99501  
NC License # C-3825

sheet:

**SD1.4**

Harrington  
Lot 24



**MULHERN+KULP**  
RESIDENTIAL STRUCTURAL ENGINEERING  
1700 University Street, Suite 105 • Atlanta, GA 30325  
www.mkh.com

N.C. License # C-3825

Mulhern+Kulp project number:  
256-21011

project mgr: SMK  
drawn by: MJF  
issue date: 02-21-2022

REVISIONS:  
date: initial:  
03/09/2022 KMV  
MIRRORED PLANS ADDED  
08/11/2022 SMM  
UPDATE PER ARCH COMMENTS



SMITH DOUGLAS  
HOMES

BRADLEY MODEL  
120 MPH WIND ZONE  
NORTH CAROLINA




FOUNDATION DETAILS

Harrington  
Lot 24

**SD1.5**

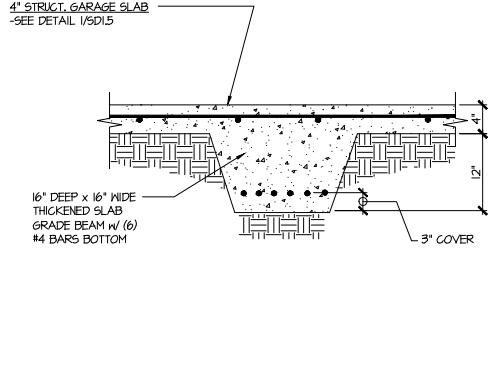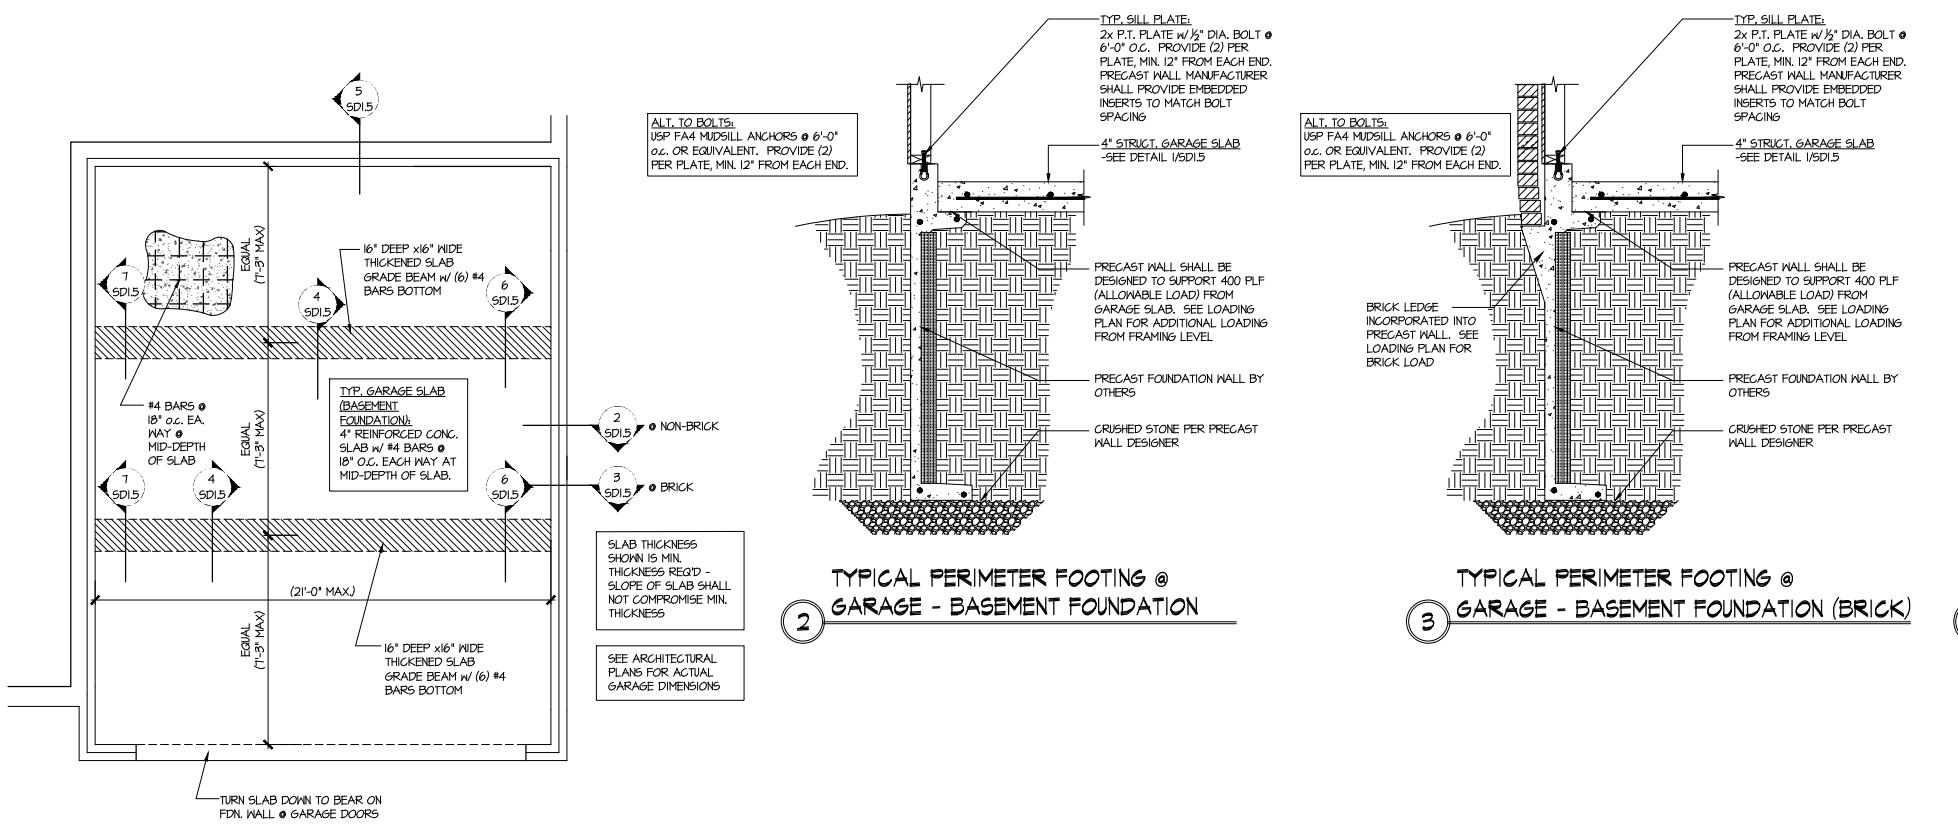

4 TYPICAL CONCRETE GRADE BEAM @ GARAGE FDN.  
SCALE: 9/4"=1'-0"

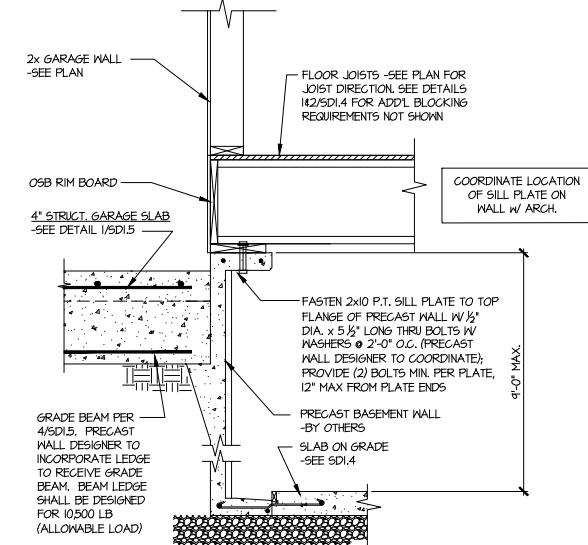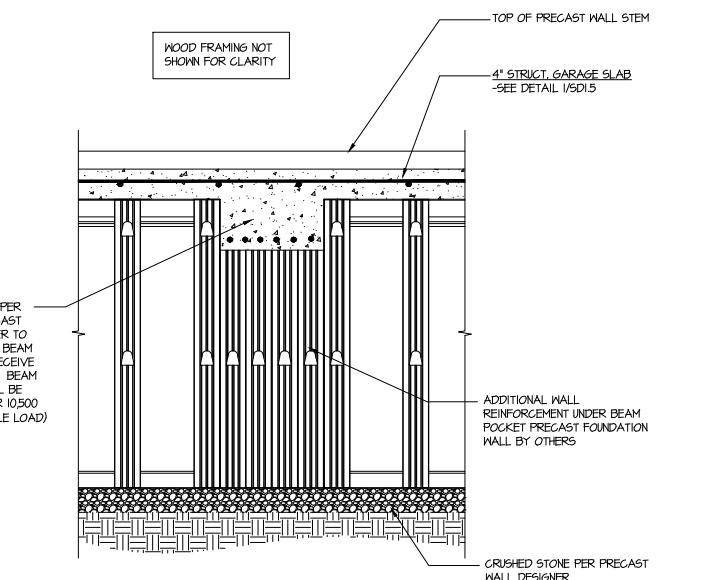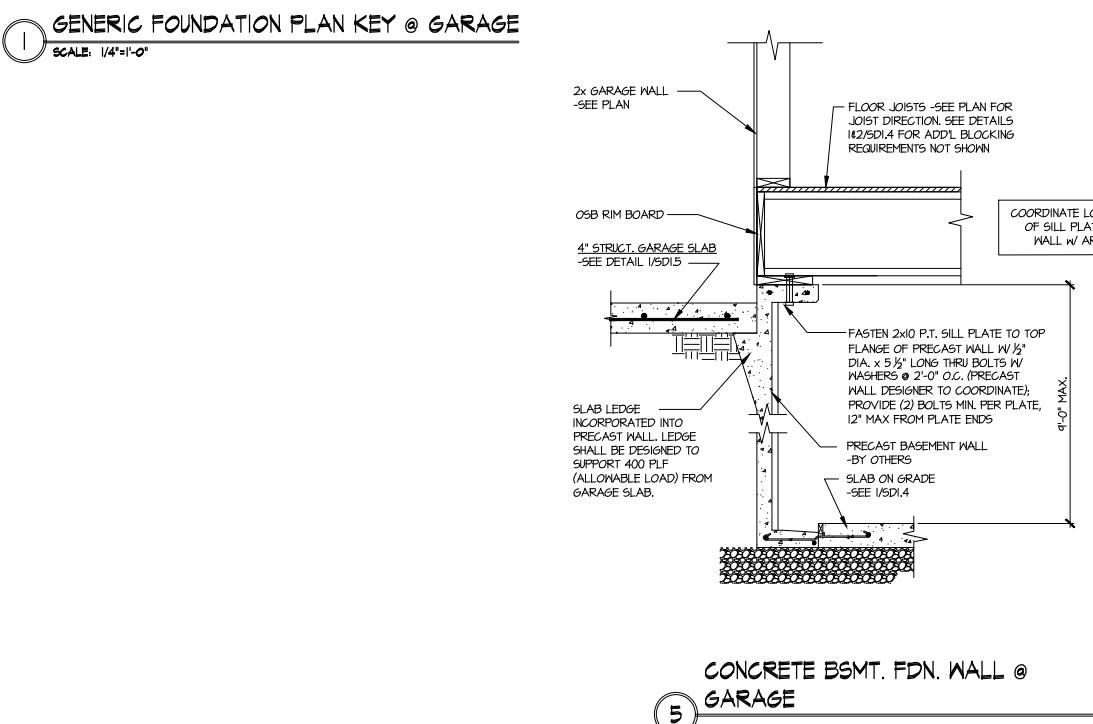



**MULHERN+KULP**  
RESIDENTIAL STRUCTURAL ENGINEERING  
1700 University Street, Suite 105, Albuquerque, NM 87104  
NM License # C-3825

Mulhern+Kulp project number:  
256-21011  
project mgr: SMK  
drawn by: MJF  
issue date: 02-21-2022

REVISIONS:  
date: initial:  
03/09/2022 KMV  
MIRRORED PLANS ADDED  
08/11/2022 SMM  
UPDATE PER ARCH COMMENTS


SMITH DOUGLAS HOMES

BRADLEY MODEL  
120 MPH WIND ZONE  
NORTH CAROLINA



FRAMING DETAILS

Harrington  
Lot 24

SD2.0

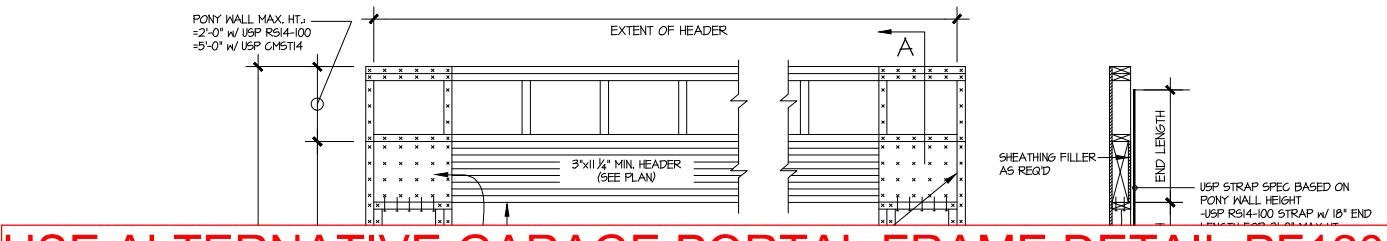


## USE ALTERNATIVE GARAGE PORTAL FRAME DETAIL PF120

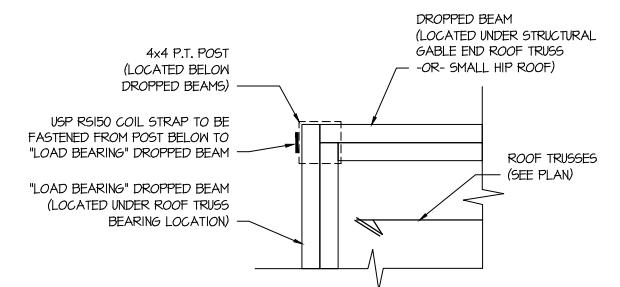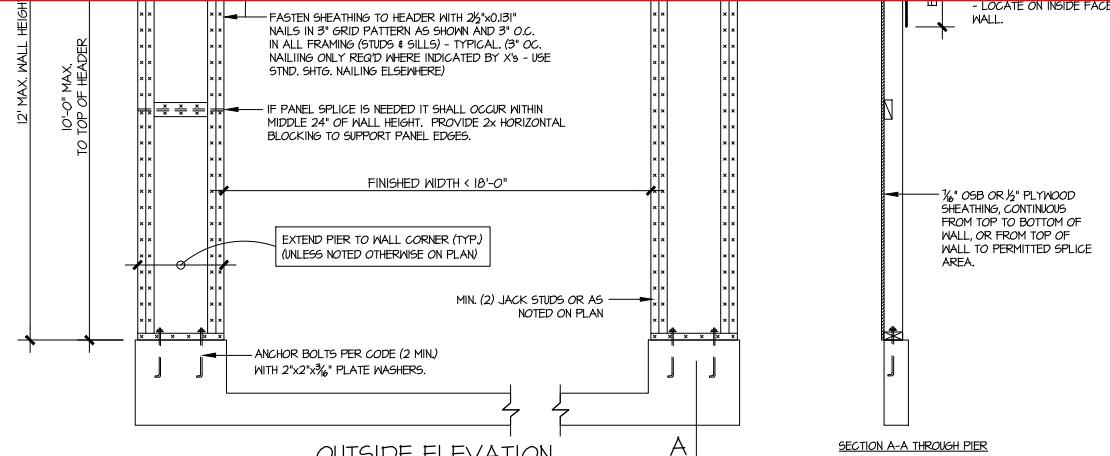


COVERED PORCH  
CONNECTION DETAIL

2

SCALE: 1 1/2"-1'-0"

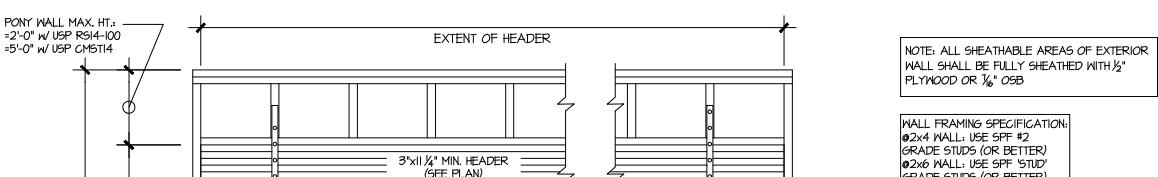

## USE ALTERNATIVE GARAGE PORTAL FRAME DETAIL PF120

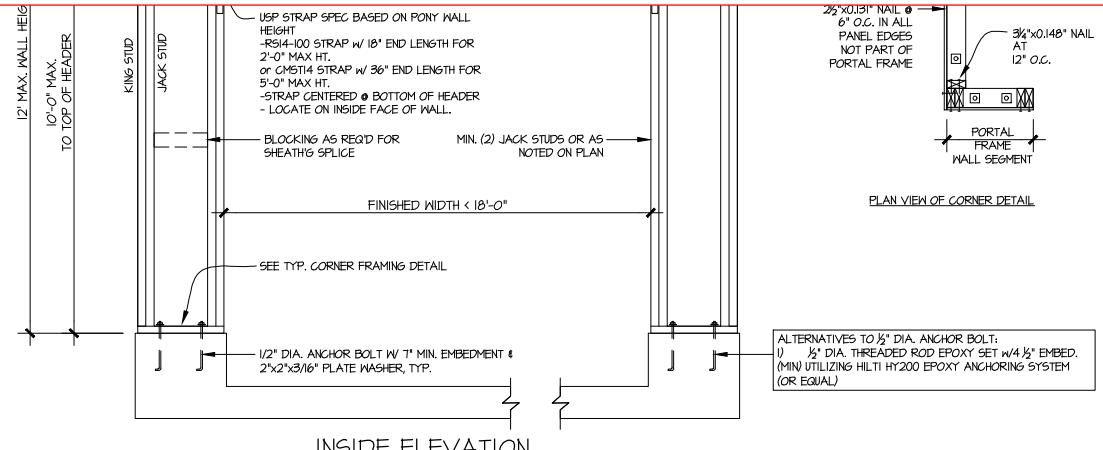

GARAGE PORTAL FRAME BRACING ELEVATION

SCALE: N.T.S.

BOTH SIDES OF GARAGE DOOR  
115 MPH WIND SPEED (ULT)

sheet:



**MULHERN+KULP**  
RESIDENTIAL STRUCTURAL ENGINEERING  
1700 University Street, Suite 105, Albuquerque, NM 87104  
NM License # C-3825


Mulhern+Kulp project number:  
**256-21011**

project mgr: **SMK**  
drawn by: **MJF**  
issue date: **02-21-2022**

REVISIONS:  
date: initial:  
**03/09/2022** **KMV**  
**08/11/2022** **SMM**  
MIRRORED PLANS ADDED  
UPDATE PER ARCH COMMENTS

SMITH DOUGLAS  
HOMES


FRAMING DETAILS  
**BRADLEY MODEL**  
120 MPH WIND ZONE  
NORTH CAROLINA

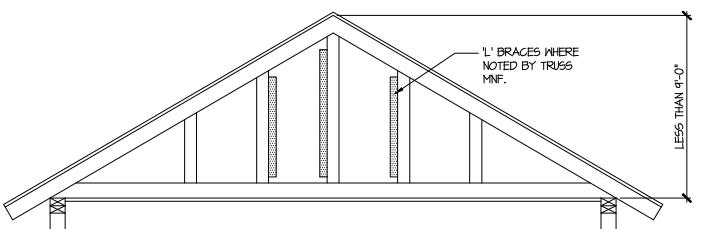

**A TYPICAL GABLE END BRACING DETAIL**

SCALE: NONE  
REQ'D @ GABLE END TRUSS  
HEIGHT UP TO 9'-0"

BRACE GABLE END TRUSSES PER ABOVE DETAIL WHEN GABLE  
HEIGHT IS LESS THAN 9'-0". L' BRACES REQUIRED WHERE NOTED BY  
TRUSS MANUFACTURER.

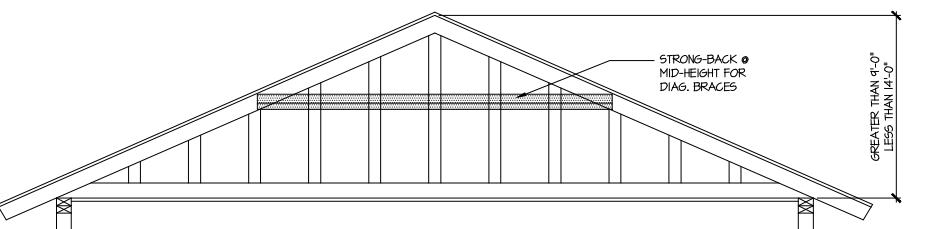

**B TYPICAL GABLE END BRACING DETAIL**

SCALE: NONE  
REQ'D @ GABLE END TRUSS  
HEIGHT BETWN 9'-0" TO 14'-0"

BRACE GABLE END TRUSSES PER ABOVE DETAIL WHEN GABLE  
HEIGHT EXCEEDS 9'-0". L' BRACES NOT REQUIRED.

LETTERED DETAILS ARE TYPICAL FOR  
THIS HOME & SHALL BE IMPLEMENTED IN  
ALL APPLICABLE AREAS. THESE  
DETAILS ARE NOT "CUT" ON THE PLANS.

NUMBERED DETAILS ARE PLAN  
SPECIFIC AND ARE ONLY REQUIRED  
WHERE SPECIFICALLY INDICATED  
("CUT") ON THE PLANS.

Harrington  
Lot 24

**SD2.1**



**MULHERN + KULP**  
RESIDENTIAL STRUCTURAL ENGINEERING

3625 Brookside Parkway, Suite 165, Alpharetta, GA 30022 ▶ p 770-777-0074 ▶ mulhemkulp.com

July 28, 2023

Jody Hunt  
Director of Product Development  
**SMITH DOUGLAS HOMES**  
110 Village Trail, Suite 215  
Woodstock, GA 30188

**ALTERNATE GARAGE PORTAL FRAME DETAIL**  
Smith Douglas Homes

**Reference**

"Alternate Garage Portal Frame Detail" on sheet PF-120 & PF-130, prepared by Mulhern & Kulp dated 07/28/2023 - attached

Jody:

Pursuant to your request, we have prepared this letter to address the "Alternate Garage Portal Frame Detail", prepared by Mulhern & Kulp for Smith Douglas Homes.

The "Alternate Garage Portal Frame Detail" on sheet "PF-120" is an acceptable alternative portal frame design for anywhere in North Carolina with a wind speed less than or equal to 120mph ultimate wind speed per ASCE 7-16. The "Alternate Garage Portal Frame Detail" on sheet "PF-130" is an acceptable alternative portal frame design for anywhere in North Carolina with a wind speed less than or equal to 130mph ultimate wind speed per ASCE 7-16. These details only apply to structural plans that have been designed by Mulhern & Kulp. It is the responsibility of "SDH" to provide the correct "SDH" to provide the correct "Alternate Garage Portal Frame Detail", to the building department that matches the jurisdiction's wind speed requirements.

Please feel free to call if you have any questions.

Respectfully,

**MULHERN & KULP STRUCTURAL ENGINEERING, INC.**

NC License # C-3825

Shaun M. Kreidell, P.E. Project Manager + Atlanta Office Director



Signature + Seal 07/28/2023



Residential Ave, Building 4 - Auditorium 2023  
225 S 600 W • Salt Lake City, UT 84111

Mulheren+Kulp project number:  
**256-23000**

project mgr: **SMK**  
drawn by:  
issue date: **07.28.2023**

REVISIONS:  
date: initial:


SMITH DOUGLAS  
HOMES

ALTERNATE PORTAL FRAME  
PORTAL FRAME

sheet:

**Harrington  
Lot 24**

**PF-120**

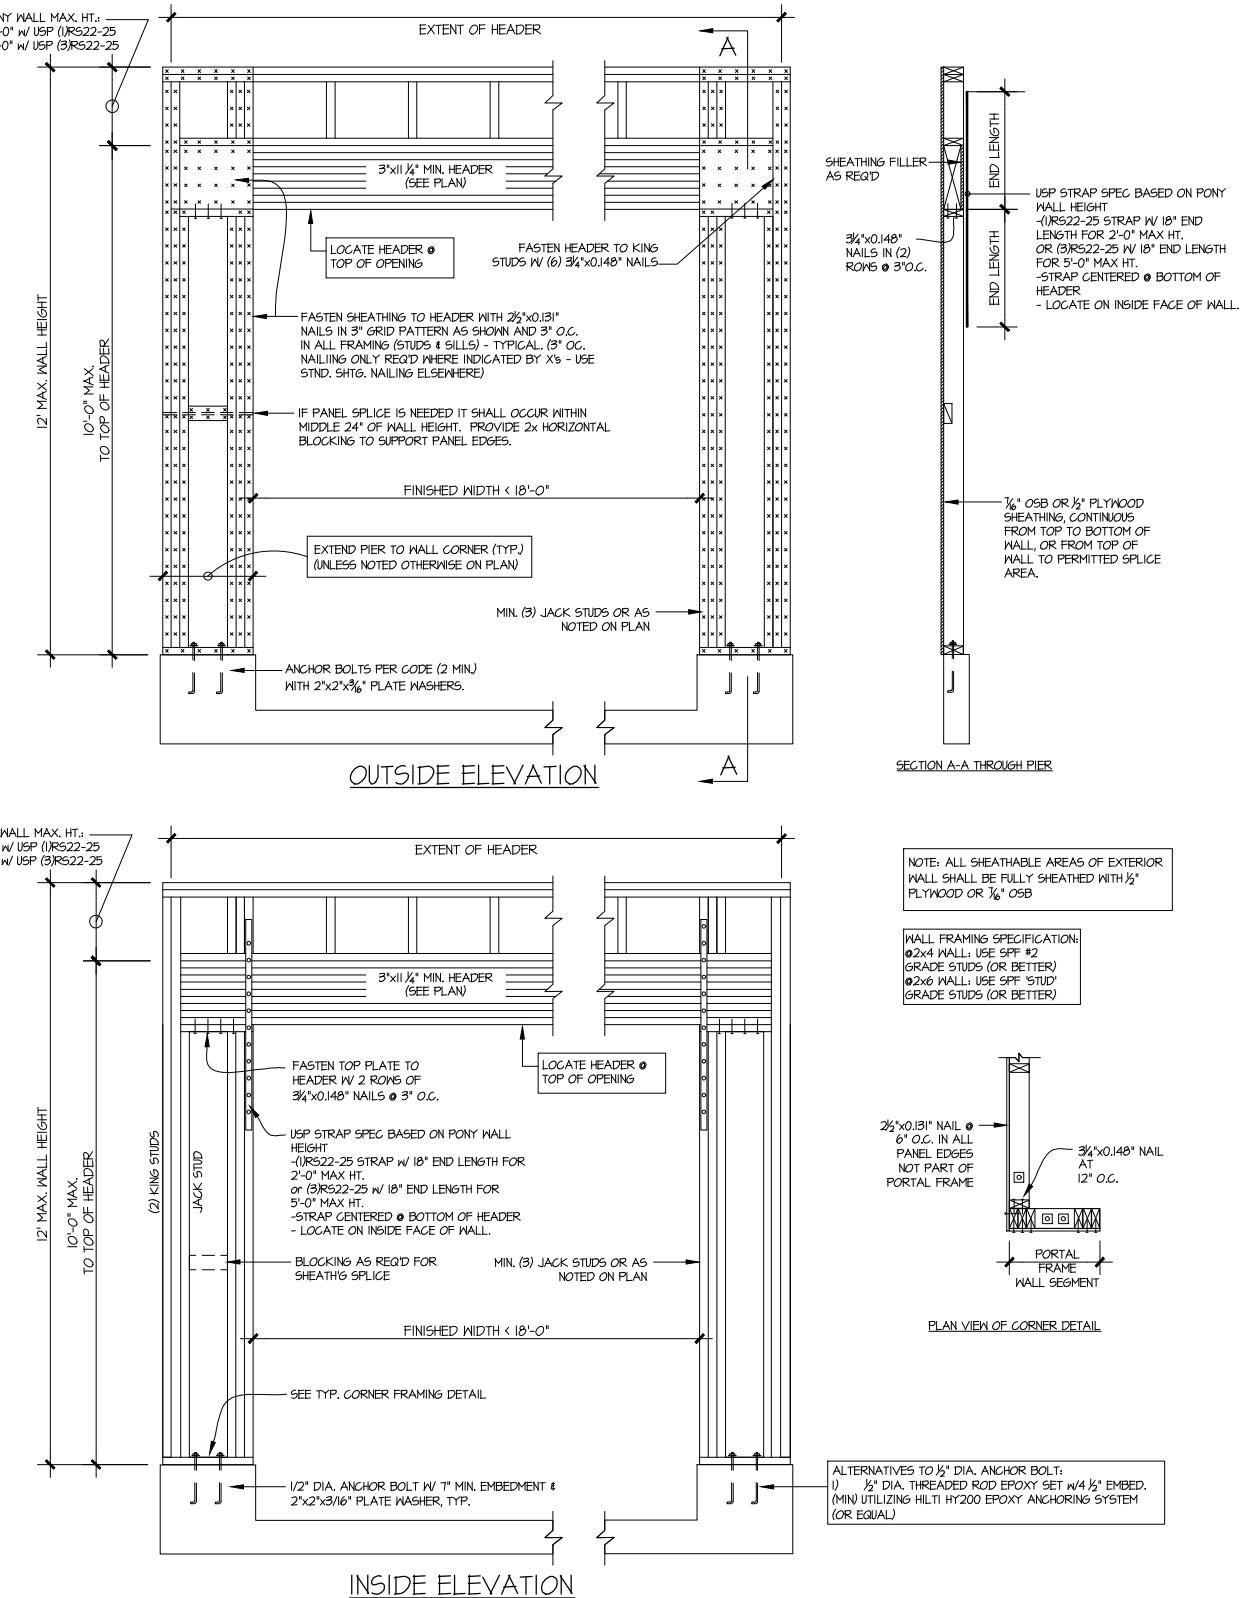

**A** ALTERNATE GARAGE PORTAL FRAME BRACING ELEVATION


SCALE: N.T.S.

BOTH SIDES OF GARAGE DOOR  
120 MPH WIND SPEED (ULT)

# 72403358 24 HARRINGTON PLACE

THIS IS A TRUSS PLACEMENT DIAGRAM (TPD) ONLY; NOT AN ENGINEERED DOCUMENT. Trusses are designed as individual building components to be incorporated into the building design at the specification of the building designer. See individual truss design drawings (TDDs) for each truss design identified on the TPD. The Contractor is responsible for the temporary bracing of the roof and floor system, and requirements for the permanent restraint/bracing of truss systems may be met by following the methods outlined in ANSI/SPRI 1-2014 - 2.3.3. The design of the support structure, including but not limited to headers, beams, walls, and columns is also the responsibility of the building designer. For general guidance regarding installation and bracing, consult "Building Component Safety Information" (BCSI) available from the SBC Association ([www.sbccomponents.com](http://www.sbccomponents.com)). It is the responsibility of the General Contractor to verify that the provided component layout matches the final intended construction plans, bearing conditions, and use. If they do not, it is the responsibility of the General Contractor to notify UFP and provide plans containing the latest specifications and designs. UFP will not be responsible for plan changes by others after final approval of shop drawings, or for errors or modifications made on-site during construction. DO NOT CUT, NOTCH, DRILL, OR OTHERWISE REPAIR MANUFACTURED TRUSSES IN ANY WAY WITHOUT PRIOR WRITTEN AUTHORIZATION BY A LICENSED PROFESSIONAL DESIGNATED BY UFP. The Framer is responsible to verify all dimensions, including adjusting member spacing within tolerances to allow for the drop and rise of plumbing/HVAC, unless noted otherwise. Truss-to-wall connections, if shown, are for uplift only and do not consider lateral loads. All connectors on this project are to be installed per the connector manufacturer's specifications. All connectors shown that are not truss-to-truss are suggestions only and are to be verified by the Building Designer or Engineer of Record for suitability to this particular project. UFP accepts no responsibility for the specific application or suitability of any connector that is not truss-to-truss as they apply to this specific structure.

## PLACEMENT PLAN

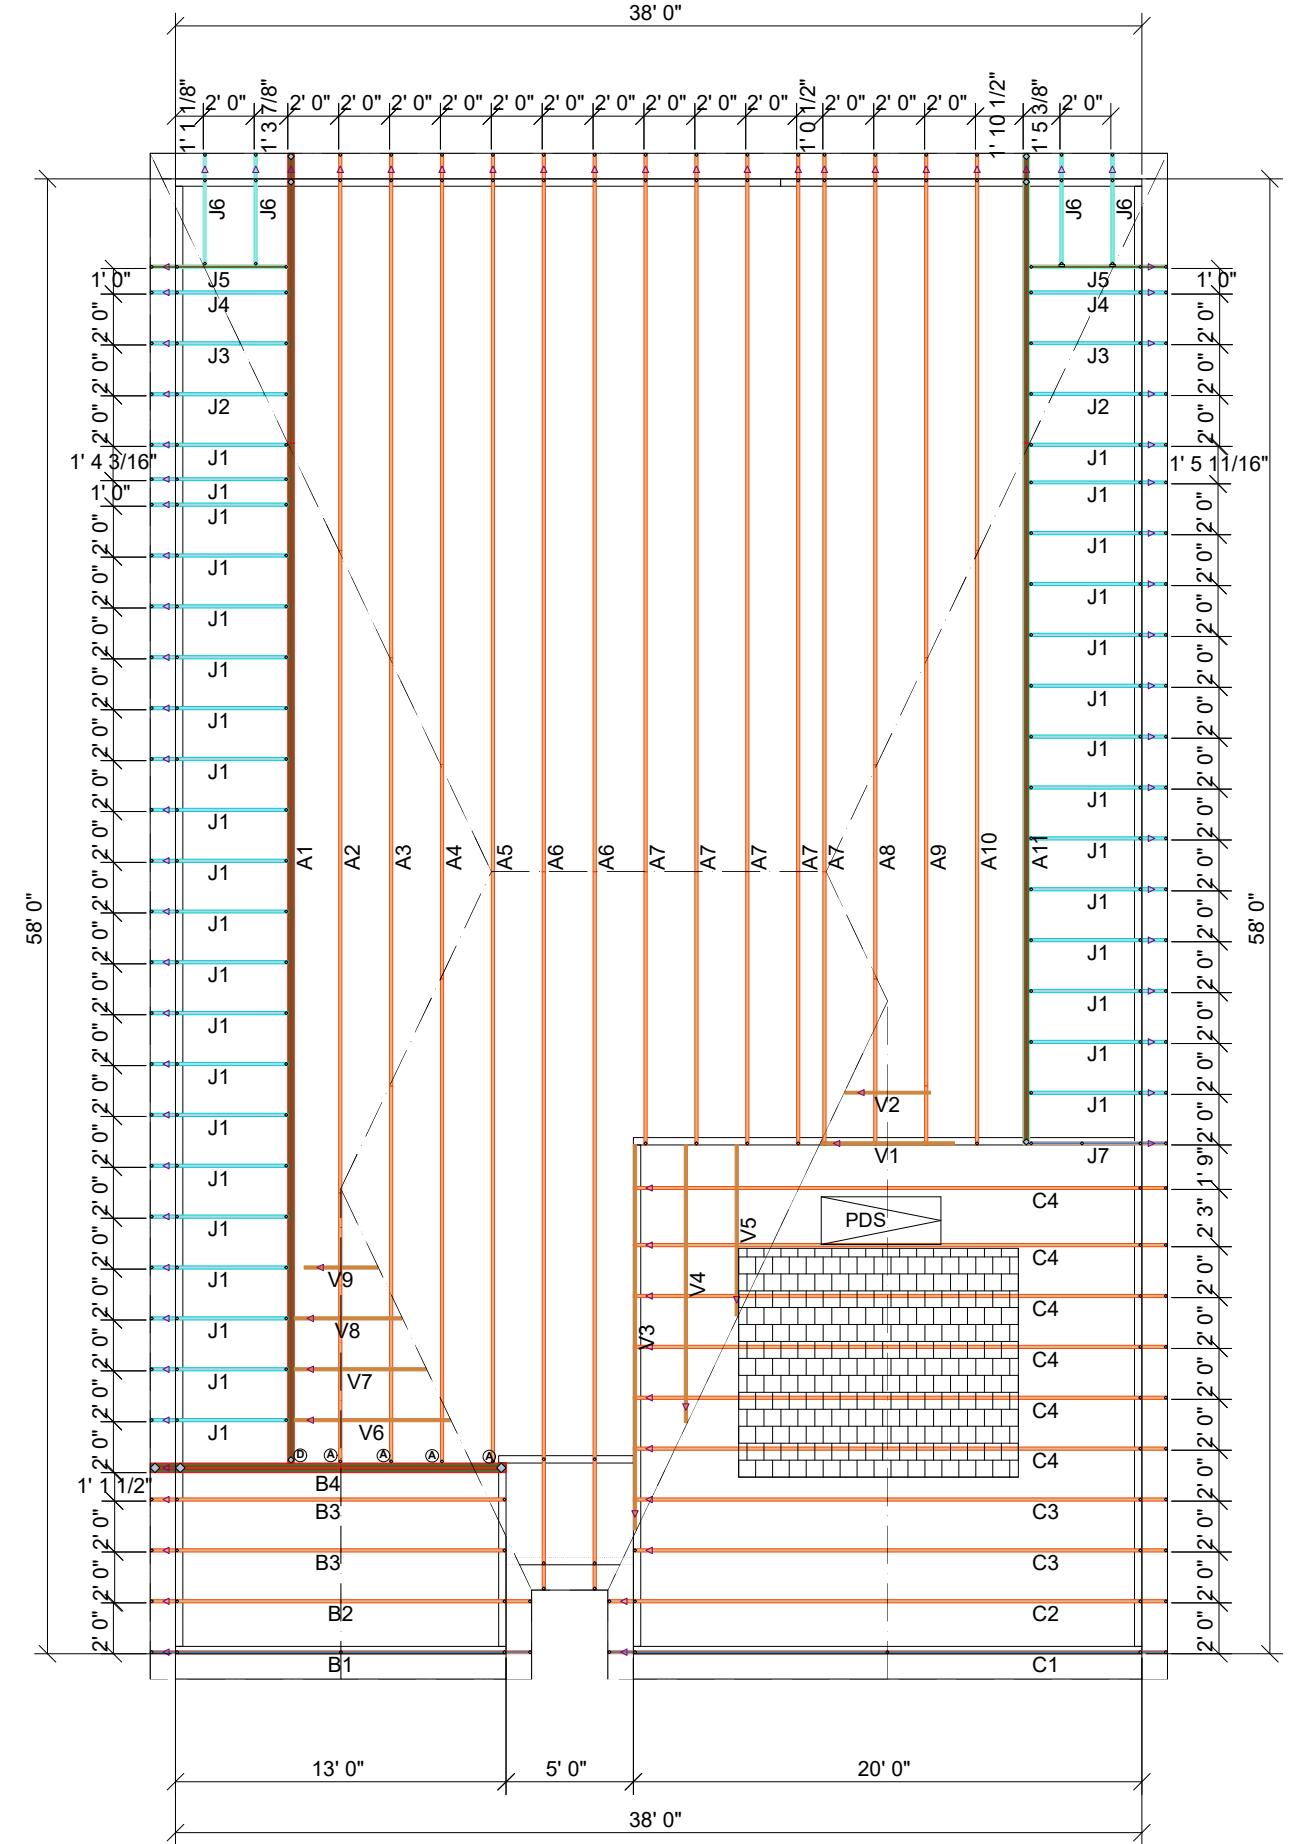

△ INDICATES LEFT END OF TRUSS      SCALE: N.T.S.

ROOF AREA:	2855.11 ft <sup>2</sup> sqft	RIDGE LINE:	59.11 ft	VALLEY LINES:	45.79 ft	HIP LINES:	87.06 ft	THESE VALUES ARE APPROXIMATE ONLY
REVISIONS		BRADLEY CFI EXT FAM NO	SD					
DATE	DESCRIPTION	DSN						
-	-	-	-	-	-	-	-	
DESIGNER	JNN	BRADLEY CFI EXT FAM NO	TRAY					
AYOUT DATE	1/22/24							
ARCH DATE	-							
STRUC DATE	-							
JOB #:	MASTER							

**UFP SITE BUILT**  
A UFP INDUSTRIES COMPANY  
**TRUSTRAX**  
UNCONVENTIONAL  
Burlington, NC Locust, NC Chesapeake, VA Liberty, NC Clinton, NC Ooltewah, TN Pearsburg, VA Stanfield, NC Jefferson, GA Customer Service (800) 476-9356



TruStraxUFP.com


## BRADLEY CFI EXT FAMILY RM NO TRAY



HVAC

72403357 24 HARRINGTON PLACE

**THIS IS A TRUSS PLACEMENT DIAGRAM (TPD) ONLY; NOT AN ENGINEERED DOCUMENT.** Trusses are designed as individual building components to be incorporated into the building design at the specification of the building designer. See individual truss design drawings (TDDs) for each truss design identified on the TPD. The Contractor is responsible for the temporary bracing of the roof and floor system, and the building designer is responsible for the permanent bracing of the roof and floor system and the overall structure. The design of the support structure including but not limited to headers, beams, walls, and columns is also the responsibility of the building designer. For general guidance regarding installation and bracing consult "Building Component Safety Information" (BCSI) or the SBC Association ([www.sbccomponents.com](http://www.sbccomponents.com)). It is the responsibility of the General Contractor to verify that the provided component layout matches the final intended construction plans, loading conditions, and use. If they do not, it is the responsibility of the General Contractor to notify UFP and provide plans containing the latest specifications and designs. UFP will not be responsible for plan changes by others after final approval of shop drawings or for errors or modifications made on-site during construction. **DO NOT CUT, NOTCH, DRILL, OR OTHERWISE "REPAIR" MANUFACTURED TRUSSES IN ANY WAY WITHOUT PRIOR WRITTEN AUTHORIZATION BY A LICENSED PROFESSIONAL DESIGNATED BY UFP.** The Framer is responsible to verify all dimensions, including adjusting member spacing within tolerances to allow for the stop and rise of plumbing/HVAC, unless noted otherwise. Truss-to-wall connections, if shown, are for uplift only and do not consider lateral loads. All connectors on this project are to be installed per the connector manufacturer's specifications. All connectors shown that are not truss-to-truss are suggestions only and are to be verified by the Building Designer or Engineer of Record for suitability to this particular project. UFP accepts no responsibility for the specific application or suitability of any connector used on this project.

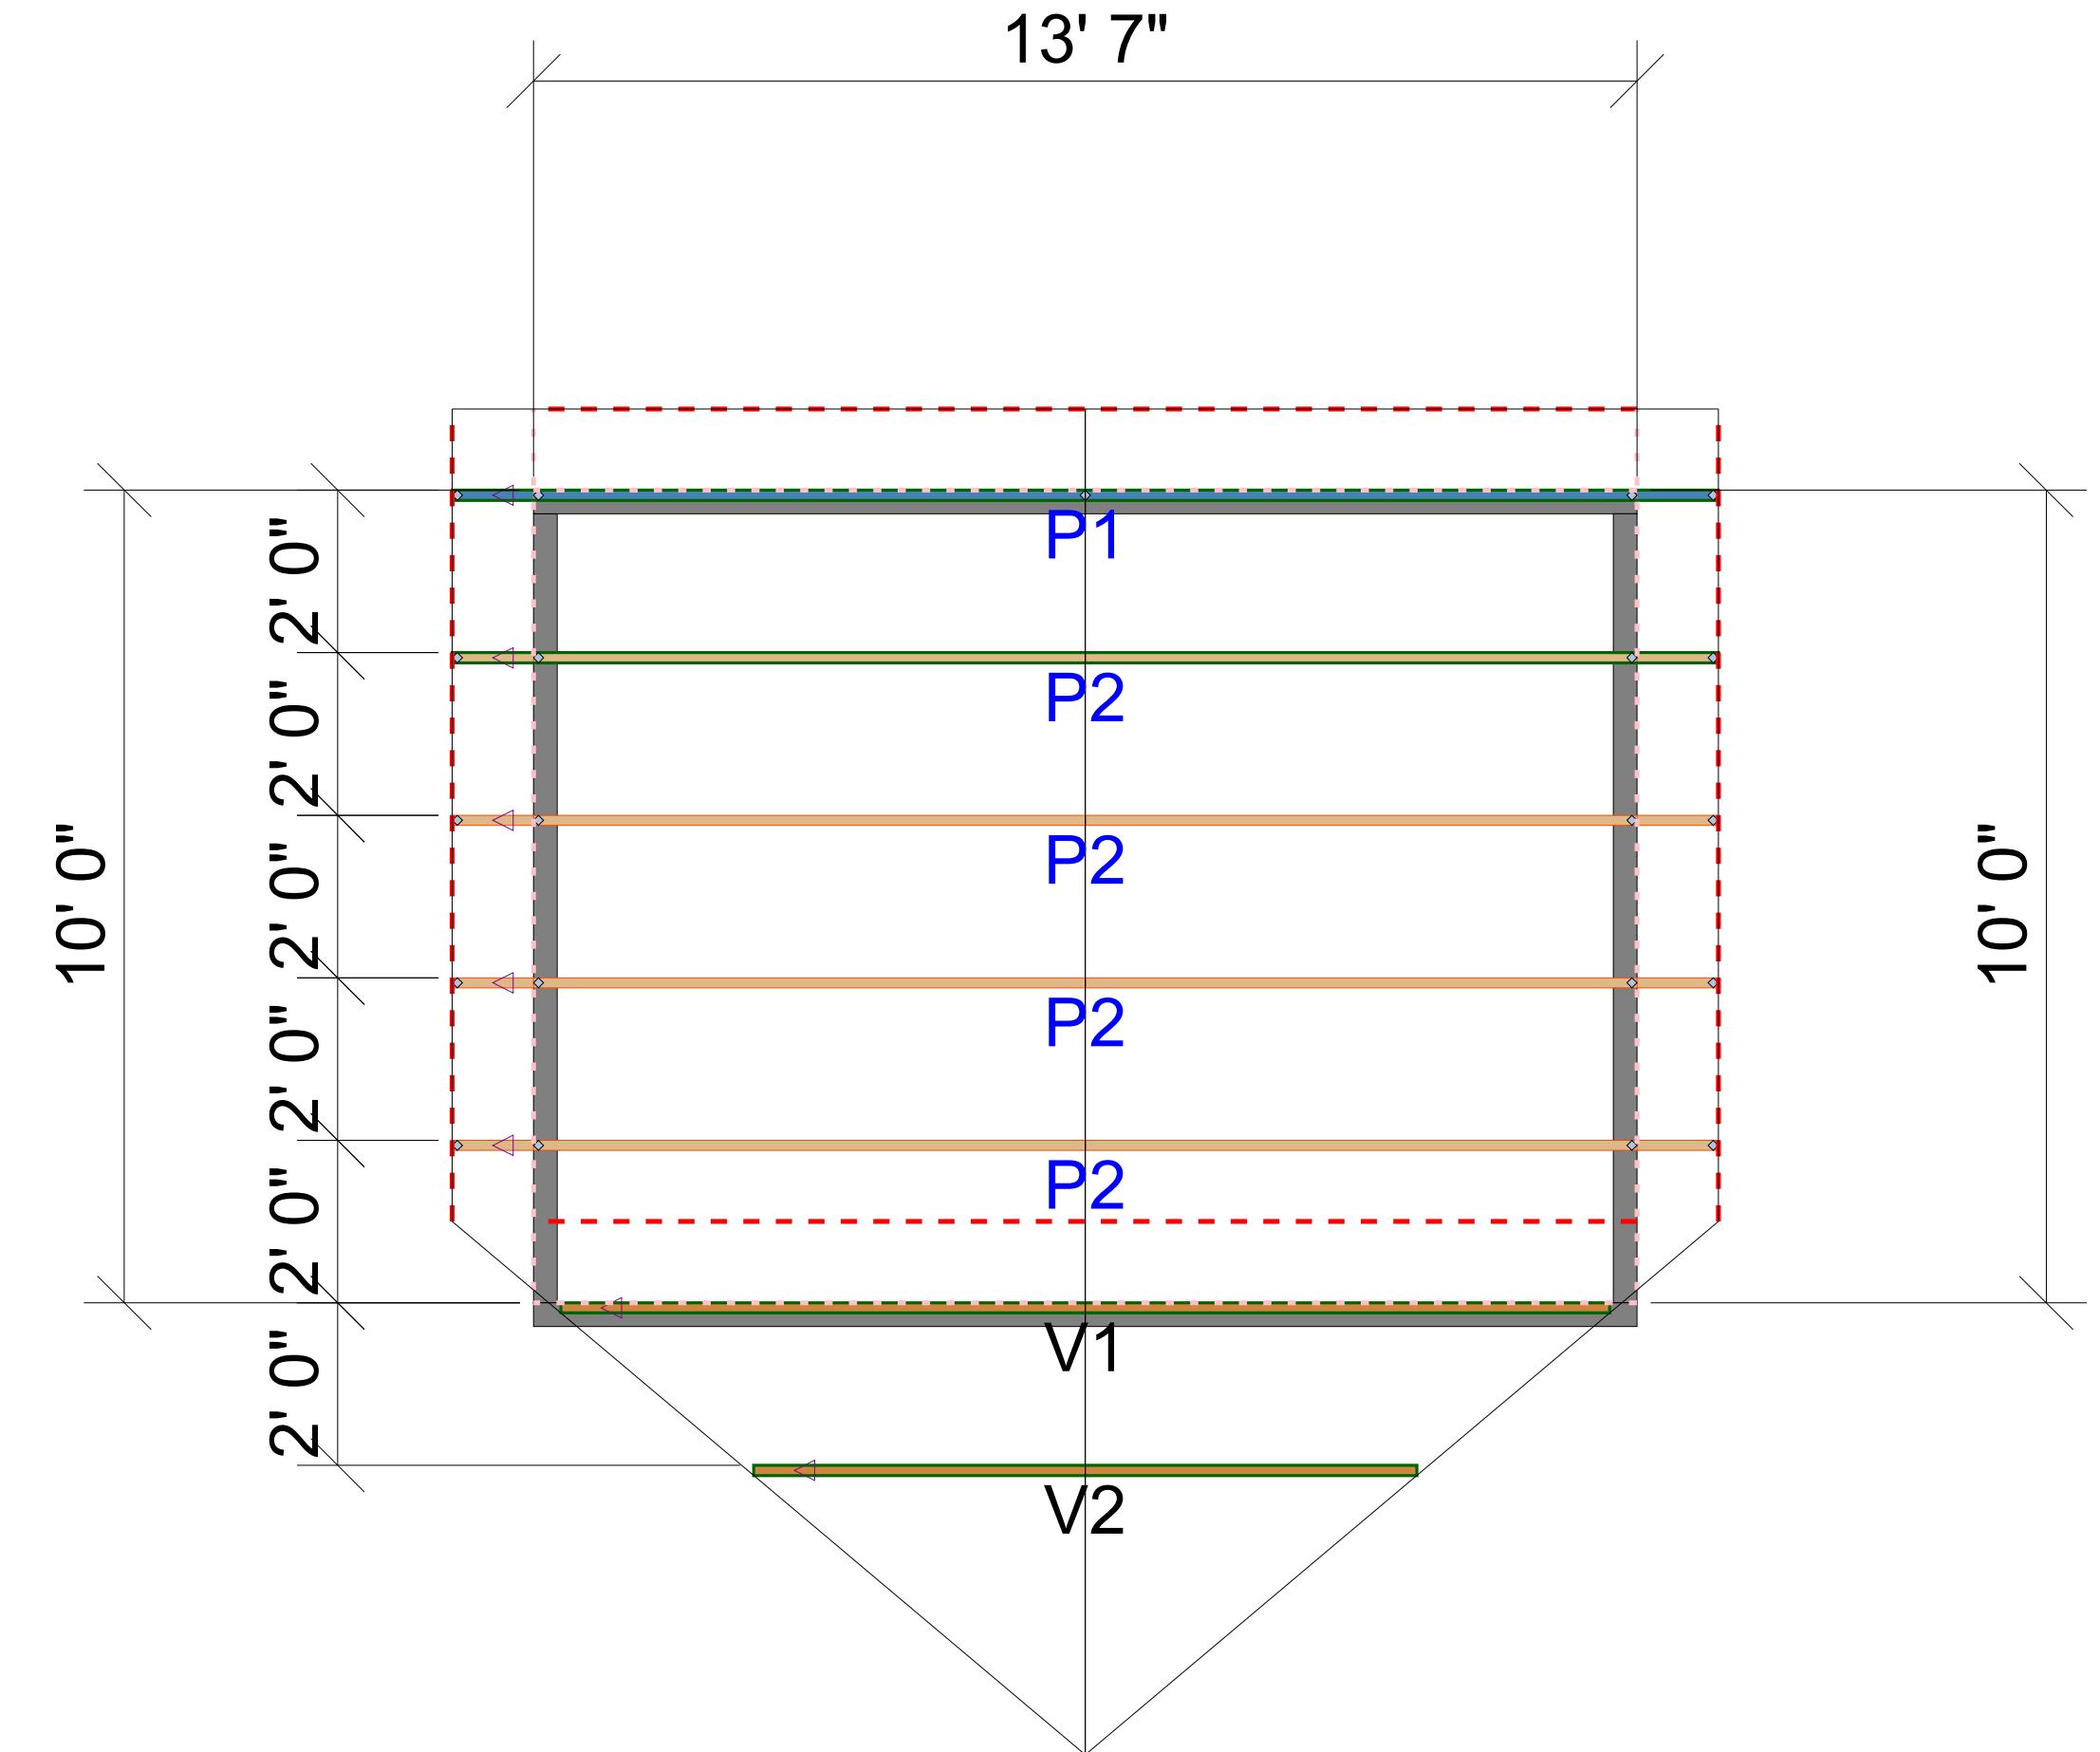

PLACEMENT PLAN

INDICATES LEFT END OF TRUSS

**DESIGNER** JNN  
**AYOUT DATE** 10/6/22  
**ARCH DATE** -  
**STRUC DATE** -

---

**JOB #:** **MASTER**

---



Customer Service (800) 476-9356  
Clinton, NC Ooltewah, TN  
Conway, SC Pearisburg, VA  
Jefferson, GA Stanfield, NC