# WILMINGTON -A, B, C

# PLAN ID: 2800 - LEFT HAND - NORTH CAROLINA

DATE:	REVISION:
09/18/2017	INITIAL RELEASE OF PLANS
10/20/2017	CLIENT REVISIONS
11/01/2017	REMOVED PORCH RAILING FROM ELEVATION 'C' FLATTENED BAR TOP AT KITCHEN REVISED SIZE OF WINDOW AT BASE OF STAIRS REVISED MASTER BEDROOM TO OWNER'S BEDROOM
02/07/2018	ELECTRICAL REVISIONS
06/11/2018	CLIENT REVISIONS
11/14/2018	CLIENT REVISIONS
01/09/2019	REVISED CODE REFERENCES
07/23/2019	CLIENT REVISIONS
12/13/2019	CLIENT REVISIONS
02/28/2020	CLIENT REVISIONS

cs	ARCHITECTURALS - COVERSHEET
0	ARCHITECTURALS - QUICK VIEW
1A	ARCHITECTURALS - ELEVATIONS A
1B	ARCHITECTURALS - ELEVATIONS B
1C	ARCHITECTURALS - ELEVATIONS C
3A	ARCHITECTURALS - FLOOR PLANS A
3B	ARCHITECTURALS - FLOOR PLANS B
3C	ARCHITECTURALS - FLOOR PLANS C
4	ELECTRICAL - FLOOR PLANS

	REVIEWERS STAMP LOCATION
ET INDEX:	
ARCHITECTURALS - COVERSHEET	
ARCHITECTURALS - QUICK VIEW	
ARCHITECTURALS - ELEVATIONS A	
ARCHITECTURALS - ELEVATIONS B	
ARCHITECTURALS - ELEVATIONS C	
ARCHITECTURALS - FLOOR PLANS A	
ARCHITECTURALS - FLOOR PLANS B	
ARCHITECTURALS - FLOOR PLANS C	
ELECTRICAL - FLOOR PLANS	

MODEL WILMI	RUARE FOOTAGES	
AREA	ELEV 'A'	
Ist FLOOR	1225 SF	
2nd FLOOR	1595 SF	
TOTAL LIVING	2824 SF	
GARAGE	411 SF	
PORCH	72 SF	

McKay Place Lot 24 89 Finsbury Court Lillington, NC 27546



COVERSHEET

PLAN REV DATE



Single LAP ILO Triple LAP



SCALE: |/4"=|'-0" AT 22"X34" LAYOUT |/8"=|'-0" AT ||"XI7" LAYOUT

Front Elevation 'C'

'WILMINGTON'

QUICK VIEW


**D-R-HORTON** 


America's Builder

HOMES

PLAN REV DATE 02.28.20

SHEET NUMBER

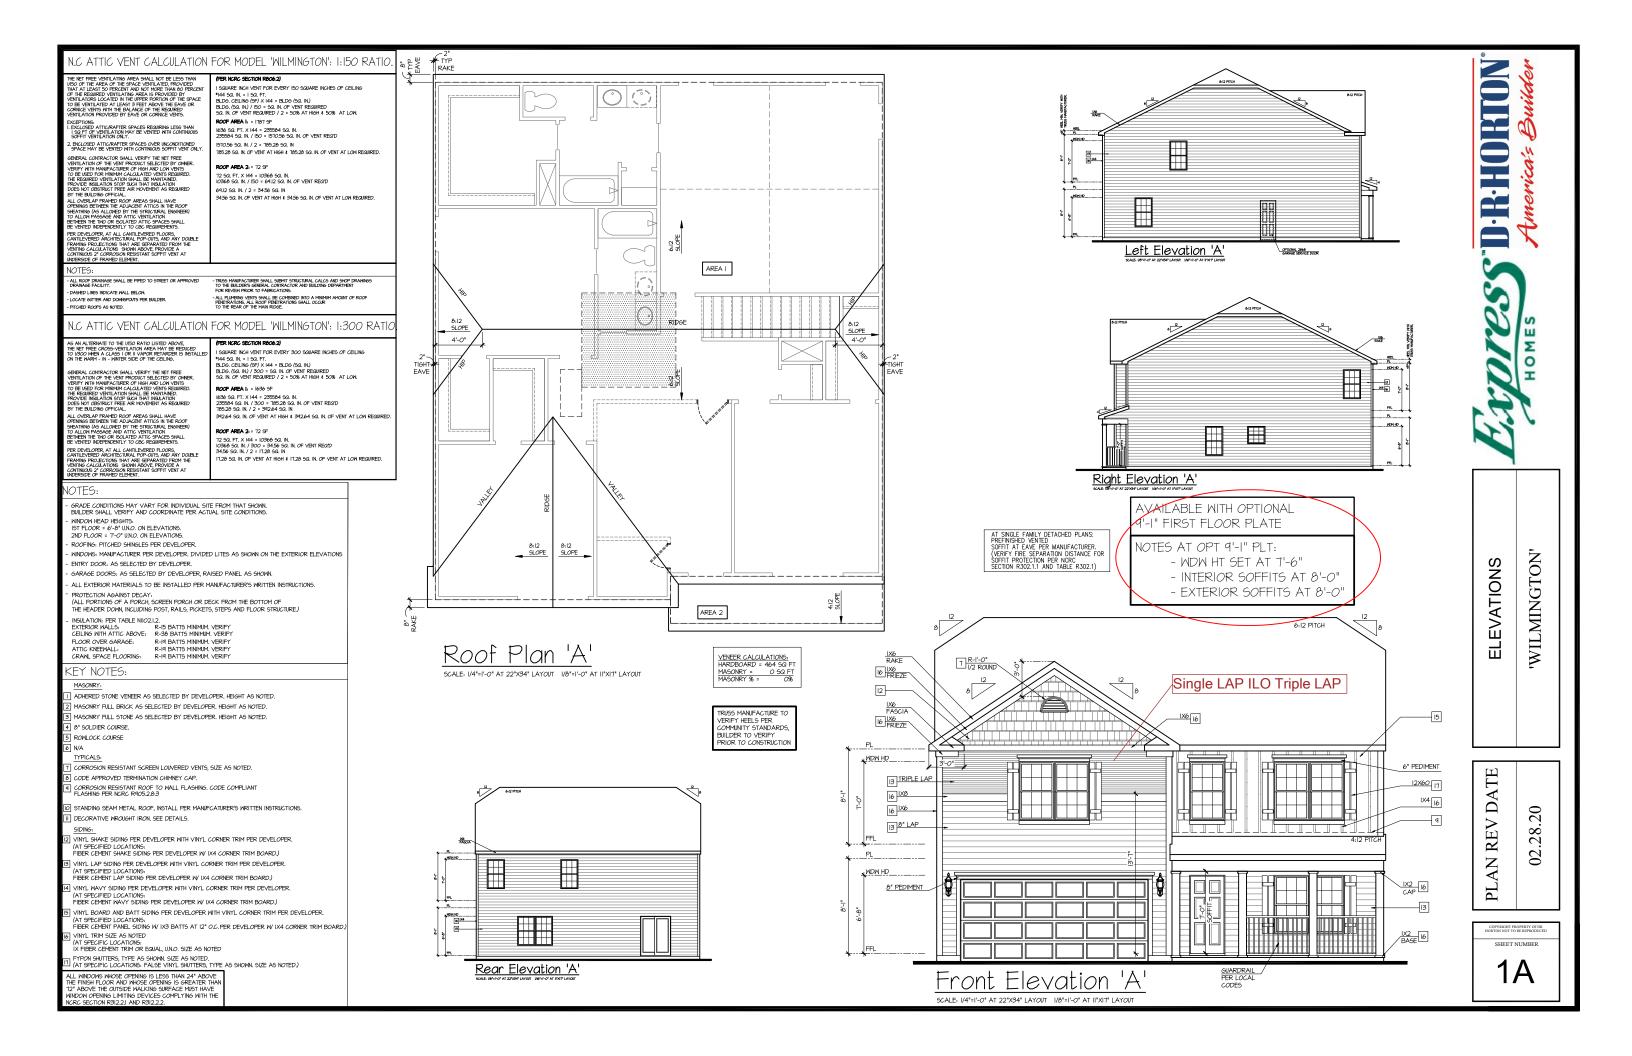

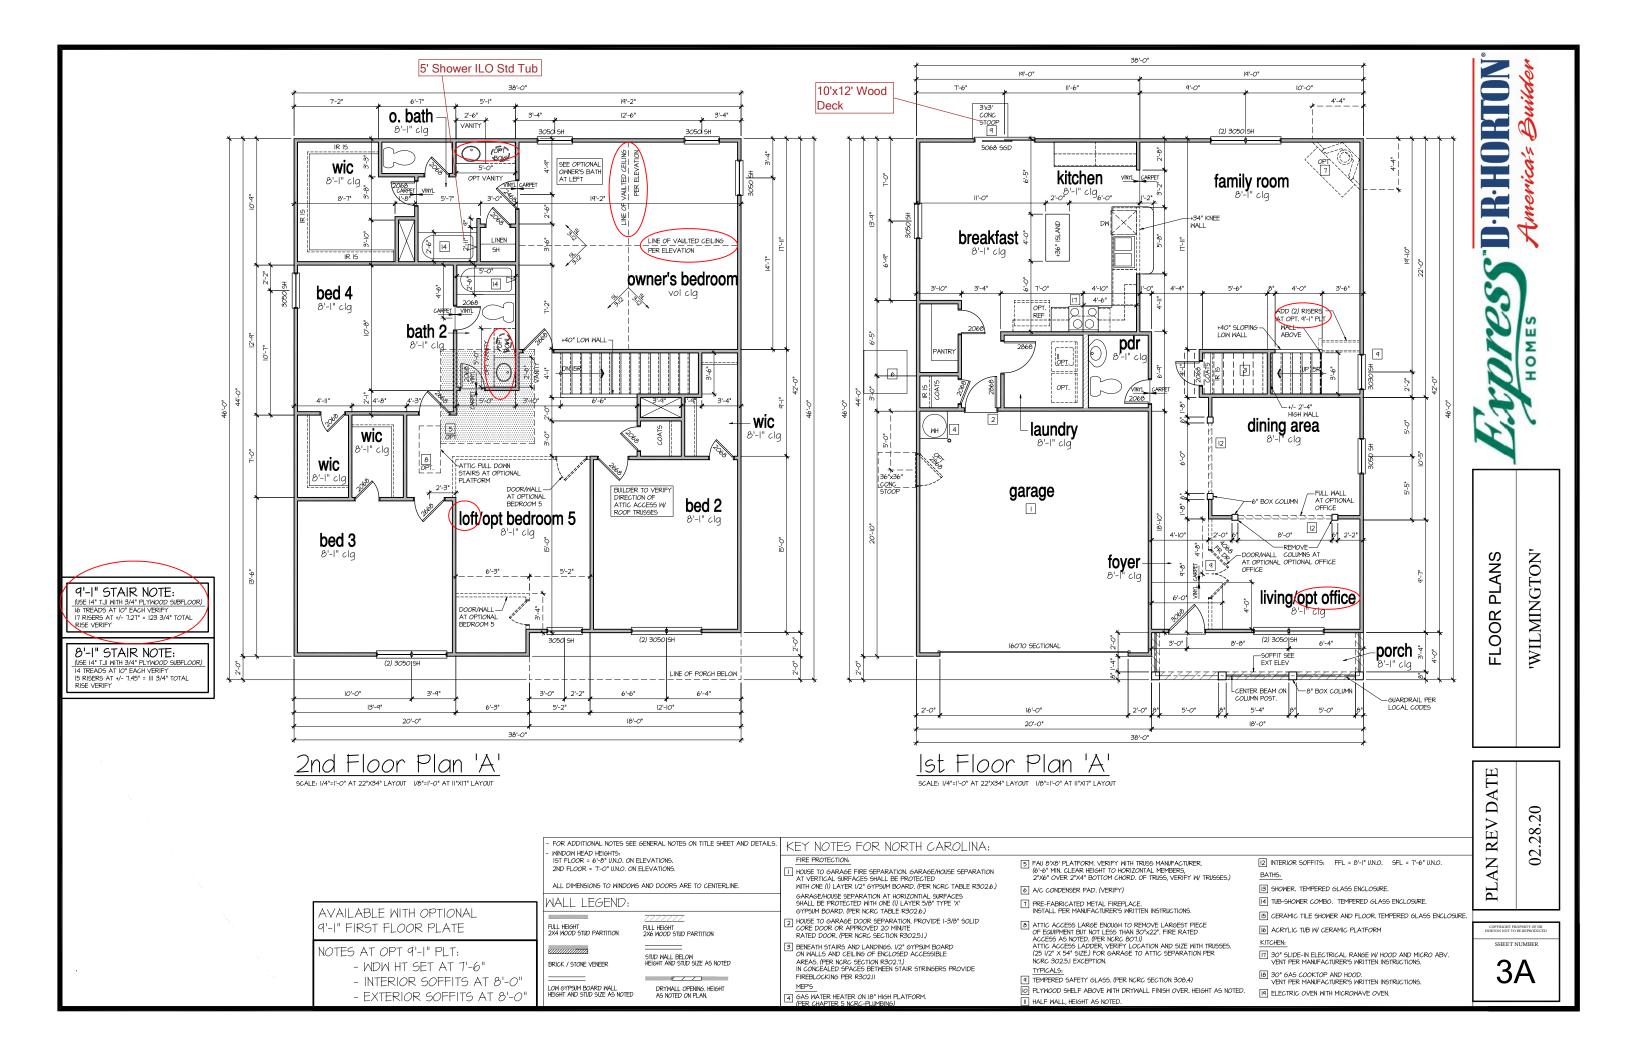

# - PROVIDE 2ND GFI/LIGHT AT OPT BOWL o. bath 6FI⊅ PH wic kitchen 8'-1" clg family room 8'-1" clg GFID PROVIDE ADEQUATE SUPPORT FOR FUTURE CLNG FAN breakfast w.p PROVIDE ADEQUATE SUPPORT FOR FUTURE CLNG FAN owner's bedroom ABOVE FOR HOOD/ MICRO bed 4 bath 2-PROVIDE ADEQUATE SUPPORT FOR FUTURE CLNG FAN 220∨ 👄 A/C DISCONNECT, 30" MIN. CLEAR PROVIDE WP/GFI PER LOCAL CODE WP/GFI wic dining area laundry wic ₩iC 8'-|" clo <del>\</del> garage bed 2 \. <mark>\$ ф</mark> 8'-1" clg loft/opt bedroom 5 ₩<sub>KEYLESS</sub> KEYLESS bed 3 PROVIDE ADEQUATE SUPPORT FOR FUTURE CLING FAN PROVIDE ADEQUATE SUPPORT FOR FUTURE CLNG FAN ∯*GDO* PREWIRE *O*NLY foyer-PROVIDE ADEQUATE SUPPORT FOR FUTURE CLNG FAN living/opt office NOTE: SIZE SERVICE PANEL PER BUILDERS SPECIFICATIONS AND LOCAL CODES TO SWITCH -porch 8'-I" clg COACH LIGHT, CENTERLINE 6'-0" COACH LIGHT, CENTERLINE 6'-O" A.F.F.



- PROVIDE GROUNDING ELECTRICAL ROD PER LOCAL CODES.
- PROVIDE AND INSTALL ARC FAULT CIRCUIT-INTERRUPTERS (AFCI) AS REQUIRED BY NATIONAL ELECTRICAL CODE (NEC) AND MEETING THE REQUIREMENTS OF ALL GOVERNING CODES.
   ALL EXHAUST FANS SHALL HAVE BACKDRAFT DAMPERS.
- FAN/LIGHTS IN WET/DAMP LOCATIONS SHALL BE LABLED "SUITABLE FOR WET OR DAMP LOCATIONS.
- ELECTRICAL SYSTEMS ARE SHOWN FOR INTENT ONLY. THESE SYSTEMS SHALL BE ENGINEERED BY OTHERS. THE CONTRACTOR SHALL BE RESPONSIBLE FOR PROPER INSTALLATION AND PLACEMENT.
- PROVIDE AND INSTALL LOCALLY CERTIFIED SMOKE DETECTORS AND CO2 DETECTORS AS REQUIRED BY
  NATIONAL FIRE PROTECTION ASSOCIATION (NPPA) AND MEETING THE REQUIREMENTS OF ALL GOVERNING CODES.
   PROVIDE AND INSTALL GROUND FAULT CIRCUIT-INITERRUPTERS (GFI) AS REQUIRED BY NATIONAL ELECTRICAL
  CODE (NEC) AND MEETING THE REQUIREMENTS OF ALL GOVERNING CODES.
- ELECTRICAL CONTRACTOR TO PROVIDE REQUIRED DIRECT HOOK-UPS/CUTOFFS.
- HVAC CONTRACTOR TO VERIFY THERMOSTAT LOCATIONS.
- ALL ELECTRICAL AND MECHANICAL EQUIPMENT (FURNACES, A/C UNITS, ELECTRICAL PANELS, SANITARY SUMP PITS, DRAIN TILE SUMP, AND WATER HEATERS) ARE SUBJECT TO RELOCATION DUE TO FIELD CONDITIONS.
- PROVIDE POWER, LIGHT AND SWITCH AS REQUIRED FOR ATTIC FURNACE PER CODE AND MANUFACTURER'S WRITTEN INSTRUCTIONS.

# LEGEND:

	_110.		
ф	DUPLEX OUTLET	<b>\( \rightarrow \)</b>	CEILING MOUNTED INCANDESCENT LIGHT FIXTURE
ФиР/6FI	WEATHERPROOF GFI DUPLEX OUTLET	ф	WALL MOUNTED INCANDESCENT
ф <i>ө</i> ғі	GROUND-FAULT CIRCUIT-INTERRUPTER DUPLEX OUTLET	<del>- : -</del>	LIGHT FIXTURE  RECESSED INCANDESCENT LIGHT FIXTURE
ф	HALF-SWITCHED DUPLEX OUTLET	ф.	(VP) = VAPOR PROOF
<b>\$</b> 220∨	220 VOLT OUTLET	•	CEILING MOUNTED LED LIGHT FIXTURE (VP) = VAPOR PROOF
0	REINFORCED JUNCTION BOX	•	EXHAUST FAN (VENT TO EXTERIOR)
\$	WALL SWITCH	-💝-	EXHAUST FAN/LIGHT COMBINATION (VENT TO EXTERIOR)
\$3	THREE-WAY SWITCH		FLUORESCENT LIGHT FIXTURE
\$4	FOUR-WAY SWITCH		FLUORESCENI LIGHTI FIATURE
CH	CHIMES		TECH HUB SYSTEM
Ŧ	PUSHBUTTON SWITCH	X	CEILING FAN (PROVIDE ADEQUATE SUPPORT)
99	IIOV SMOKE ALARM W BATTERY BACKUP	V \	CEILING FAN WITH INCANDESCENT
€9	IIOV SMOKE ALARM CO2 DETECTOR COMBO		LIGHT FIXTURE (PROVIDE ADEQUATE SUPPORT)
T	THERMOSTAT	∞	GAS SUPPLY WITH VALVE
PH	TELEPHONE		
TV	TELEVISION	→	HOSE BIBB
	ELECTRIC METER	-+ <sub>cm</sub>	I/4" WATER STUB OUT
	ELECTRIC PANEL	Ж	
<u> </u>	DISCONNECT SWITCH	I K	WALL SCONCE

2nd Floor Plan 'A'
scale: 1/4\*=1\*-0\* AT 22\*/94\* LAYOUT 1/8\*=1\*-0\* AT 11\*31\* LAYOUT

Ist Floor Plan 'A'
scale: 1/4\*=1'-0" AT 22"×34" LAYOUT 1/8\*=1'-0" AT 11"X17" LAYOUT

ALL ELEVATIONS ARE SIMILAR

TO FLOOD ABOVE FLOOR PLANS
'WILMINGTON'

D-R-HORTON

£merica's

OME

PLAN REV DATE 02.28.20

COPYRIGHT PROPERTY OF DR
HORTON NOT TO BE REPRODUCED

SHEET NUMBER

# DESIGN SPECIFICATIONS:

Construction Type: Commerical ☐ Residential ☒

Applicable Building Codes:

• 2018 North Carolina Residential Building Code with All Local Amendments

• ASCE 1-10: Minimum Design Loads for Buildings and Other Structures

ign L	oads:		
~ I.		Live Loads	
	1.1.	Conventional 2x	20 P
	1.2.	Truss	
		12.1. Attic Truss	60 F
2.	Roof	Dead Loads	
		Conventional 2x	
	22.	Truse	20 PS
3.	Snow		15 PS
		Importance Factor	
4.	Floor	Live Loads	
	4.1.	Typ. Dwelling	40 P
	4.2.	Sleeping Areas	30 P
	4.3.	Decks	40 P
	11	Passenger Garage	50 D

4.4. Passenger Garage .5. Floor Dead Loads 5.1. Conventional 2x . 5.2. I-Joist ..... IO PSE 5.3. Floor Truss .... Ultimate Design Wind Speed (3 sec. gust)
 Exposure
 Importance Factor

# 631. Vx = 632. Vy = 7. Component and Cladding (in PSF)

63. Wind Base Shear

MEAN ROOF HT.	UP TO 30°	30"1"-35"	35'1"-40'	40'1"-45'
ZONE I	16.7,-18.0	17.5,-18.9	18.2,-19.6	18.7,-202
ZONE 2	16.7,-21.0	17.5,-22.1	18.2,-22.9	<b>8</b> .7,-23.5
ZONE 3	16.7,-21.0	17.5,-22.1	18.2,-22.9	<b>18</b> .7,-23.5
ZONE 4	182,-19.0	19.2,-20 <b>.0</b>	19.9,-20.7	20.4,-21.3
ZONE 5	18 <b>2</b> ,-24.0	19.2,-25.2	19.9,-26.1	20.4,-26.9

3.	Seismi	c	
	8.1.	Site Class	₽
	8.2.	Design Category	Ç
	8.3.	Importance Factor	Ø
	8.4.	Seismic Use Group	1
	8.5.	Spectral Response Acceleration	
		8.5.1. Sms = %g	
		<b>8</b> .52.6ml = %q	

8.6. Seismic Base Shear

8.6.2.Vy = 8.7. Basic Structural System (check one)

□ Bearing Wall
 □ Building Frame
 □ Moment Frame

□ Dual w/ Special Moment Frame
□ Dual w/ Intermediate R/C or Special Stee ☐ Inverted Pendulum

8.8. Arch/Mech Components Anchored
8.9. Lateral Design Control: Seismic 
Assumed Soil Bearing Capacity



# STRUCTURAL PLANS PREPARED FOR:

# WILMINGTON - LH

8001 Arrowridae Blvd. Charlotte, NC 28273

PROJECT ADDRESS: OWNER: DR Horton, Inc.

DESIGNER: GMD Design Group 102 Fountain Brook Circle Cary, NC 27511

These drawings are to be coordinated with the architectural, mechanical, plumbing, electrical, and civil drawings. This coordination is not the responsibility of the structural engineering of record (SER). Should any discrepancies become apparent, the contractor shall notify SUPMIT Engineering, Laboratory 4 Testing, P.C. before construction begins.

# PLAN ABBREVIATIONS:

AB ANCHOR BOLT PT PRESSURE TREATED  AFF ABOVE FINISHED FLOOR RS ROOF SUPPORT  CJ CEILING JOIST 9C STUD COLUMN  CLR CLEAR 9J SINGLE JOIST  DJ DOUBLE JOIST 9FF SPRUCE PINE FIR  DSP DOUBLE STUD POCKET 9SF SPRUCE PINE FIR  EE EACH END 9YP SOUTHERN YELLOW PINE  EW EACH WAY TJ TRIPLE JOIST  NTS NOT TO SCALE TSP TRIPLE STUD POCKET  OC ON CENTER TYP TYPICAL  PSF POUNDS PER SQUARE FOOT UND UNLESS NOTED OTHERWISE  PSF POUNDS PER SQUARE INCH WUF WELDED WIRE FABRIC				
CJ   CEILING JOIST   SC   STUD COLUMN	AB	ANCHOR BOLT	Þ	PRESSURE TREATED
CLE   CLEAR   S.   SNGLE   JOIST	AFF	ABOVE FINISHED FLOOR	RS	ROOF SUPPORT
DJ   DOUBLE JOIST   SPF   SPRUCE PINE FIR	CJ	CEILING JOIST	5C	STUD COLUMN
DOBP   DOUBLE STUD POCKET   S61 SIMPSON STRONG-TIE	CLR	CLEAR	ಖ	SINGLE JOIST
EE	DJ	DOUBLE JOIST	SPF	SPRUCE PINE FIR
EW	D9P	DOUBLE STUD POCKET	551	SIMPSON STRONG-TIE
NT6         NOT 10 SCALE         TSP TRIPLE STUD POCKET           OC         ON CENTER         TYP TYPICAL           PSF POUNDS PER SQUARE FOOT         UND UNLESS NOTED OTHERWISE	EE	EACH END	SYP	SOUTHERN YELLOW PINE
OC ON CENTER TYP TYPICAL PSF POUNDS PER SQUARE FOOT UND UNLESS NOTED OTHERWISE	EW	EACH WAY	TJ	TRIPLE JOIST
PSF POUNDS PER SQUARE FOOT UNO UNLESS NOTED OTHERWISE	NTS	NOT TO SCALE	TSP	TRIPLE STUD POCKET
	oc	ON CENTER	TYP	TYPICAL
PSI POUNDS PER SQUARE INCH WUF WELDED WIRE FABRIC	PSF	POUNDS PER SQUARE FOOT	UNO	UNLESS NOTED OTHERWISE
	P9I	POUNDS PER SQUARE INCH	WWF	WELDED WIRE FABRIC

Roof truss and floor joist layouts, and their corresponding loading details, were not provided to SUMMIT Engineering, Laboratory 4 Testing, P.C. (SUMMIT) prior to the Initial design. Therefore, truss and joist directions were assumed based on the information provided by <u>DR Horton</u>, Subsequent plan revisions based on roof truss and floor joist layouts shall be noted in the revision list, indicating the date the layouts were provided. Should any discrepancies become apparent, the contractor shall notify SUMMIT Immediately.

# SHEET LIST:

Sheet No.	Des <b>c</b> ription
CSI	Cover Sheet, Specifications, Revisions
SI.Øm	Monolithic Slab Foundation
51.Øs	Stem Wall Foundation
51.Øc	Crawl Space Foundation
51.00b	Basement Foundation
52.Ø	Basement Plan
53.Ø	First Floor Plan
54.0	Second Floor Plan
95.Ø	Roof Framing Plan

# DR HORTON PROJECT SIGN-OFF:

Mana <b>g</b> er	Signatur <b>e</b>
Operations	
Operations System	
Operations Product	
Develo <b>p</b> ment	

summit

# REVISION LIST:

Revision No.	Date	Project No.	Descri <b>p</b> tion
1	5.16.17	1261IR	Revised garage slab note. Revised roof overframing. Verified roof truss layouts provided by 84 Lumber on 32.81, Verified floor, joist layout provided by 84 Lumber on 82.15
2	6.14.17	12611R2	Added stem wall foundation plan
3	4.23.18	17862	Added crawl space foundation plan
4	7.10.18	17862R	Revis <b>e</b> d per new architectural files dated 6.12.18
5	8.30.18	17862R2	Added dimensions at tapered porch columns
6	10.5.18	17862R3	Included stick framing option at extended parch
1	11.30.18	17862R4	Revised NC version only for 2018 NCRC
8	3.1.21	TØØ9I	Added OX-16 Structural Insulated Sheating Optic
_			
_			
	l		l .

Revision No.	Date	Project No.	Descri <b>p</b> tion
1	5.16.17	1261IR	Revised garage slab note. Revised roof overframing. Verified roof truss layouts provided by 84 Lumber on 3281. Verified floor, joilst layouts provided by 84 Lumber on 82.15
2	6.14.17	12611R2	Added stem wall foundation plan
3	4.23.18	17862	Added crawl space foundation plan
4	7.10.18	17862R	Revised per new architectural files dated 6.12.18
5	8.30.18	17862R2	Added dimensions at tapered porch columns
6	10.5.18	17862R3	included stick framing option at extended parch
7	11.30.18	17862R4	Revised NC version only for 2018 NCRC
8	3.1.21	TØØ9I	Added OX-16 Structural Insulated Sheating Option

# GENERAL STRUCTURAL NOTES:

- The design professional whose seal appears on these drawings is the structural engineer of record (SER) for this project. The SER bears the responsibility of the primary structural elements and the performance of this structure. No other party may revise alter, or delete any structural aspects of these construction documents without written permission of SUMMIT Engineering, Laboratory & Testing, P.C. (SUMMIT) or the SER. For the purposes of these construction documents the SER and SUMMIT
- shall be considered the same entity.

  The structure is only stable in its completed form. The contractor shall provide all required temporary bracing during construction
- to stabilize the structure.

  The SER is not responsible for construction sequences, methods, or techniques in connection with the construction of this structure. The SER will not be held responsible for the contractor's failure to conform to the contract documents, should any non-conformities occur.

  Any structural elements or details not fully developed on the
- construction drawings shall be completed under the direction of a licensed professional engineer. These shop drawings shall be submitted to SUMMIT for review before any construction begins. The shop drawings will be reviewed for overall compliance as it relates to the structural design of this project. Verification of
- the shop drawings for dimensions, or for actual field conditions, is not the responsibility of the SER or SUMMIT. Verification of assumed field conditions is not the responsibility of the SER. The contractor shall verify the field conditions for accuracy and report any discrepancies to SUMMIT before
- construction begins.

  The SER is not responsible for any secondary structural elements or non-structural elements, except for the elements specifically
- noted on the structural drawings.

  This structure and all construction shall conform to all
- applicable sections of the international residential code. This structure and all construction shall conform to all applicable sections of local building codes. All structural assemblies are to meet or exceed to requirements of the current local building code

# FOUNDATIONS:

The structural engineer has not performed a subsurface investigation. Verification of this assumed value is the responsibility of the owner or the contractor. Should any adverse soil condition be encountered the SER must be

- The bottom of all footings shall extend below the frost line for the region in which the structure is to be constructed. However, the bottom of all footings shall be a minimum of 12" below grade. Any fill shall be placed under the direction or recommendation
- maximum day density.

  Excavations of factings shall be lined temporarily with a 6 mil polysthylere membrane if placement of concrete does not occu within 24 hours of excavation.
- No concrete shall be placed against any subgrade containing water, ice, frost, or loose material.

- STRUCTURAL STEEL:

  L. Structural steel shall be fabricated and erected in accordance with the American Institute of Steel Construction "Code of Standard Practice for Steel Buildings and Bridges" and the manual of Steel Construction "Load Resistance Factor Design" latest editions.
- Structural steel shall receive one coat of shop applied
- rust-inhibitive paint.
  All steel shall have a minimum yield stress (F,) of 36 ksi unless
- Welding shall conform to the latest edition of the American Welding Society's Structural Welding Code AWS D.L. Electrodes for shop and field welding shall be class ETOXX. All welding shall be performed by a certified welder per the above

- NONELE:
  Concrete shall have a normal weight aggregate and a minimum compressive strength (%) at 28 days of 3000 psi, unless otherwise noted on the plan.
  Concrete shall be proportioned, mixed, and placed in
- accordance with the latest editions of ACI 318: "Building Cod Requirements for Reinforced Concrete" and ACI 301: "Specifications for Structural Concrete for Buildings".
- Air entrained concrete must be used for all structural elements exposed to freeze/thaw cycles and deicing chemicals. Air entrainment amounts (in percent) shall be within -1% to +2% of target values as follows:

# 3.1. Footings: 5% 3.2. Exterior **S**labs: 5%

No admixtures shall be added to any structural concrete without written permission of the SER.

- Concrete slabs-on-grade shall be constructed in accordance with ACI 302.1R-96: "Guide for Concrete Slab and Slab Construction".
- The concrete slab-on-grade has been designed using a subgrade modulus of k=250 pci and a design loading of 200 psf. The SER is not responsible for differential settlement, slab of a licensed professional engineer.
  The resulting soil shall be compacted to a minimum of 95% cracking or other future defects resulting from unreported
  - cracking or other future defects resulting from unreported conditions not in accordance with the above assumptions. Control or saw cut joints shall be spaced in interior slabs-on-grade at a maximum of 15°-0° O.C. and in exterior slabs-on-grade at a maximum of 10°-0° unless otherwise noted. Control or saw cut joints shall be produced using conventional process within 4 to 12 hours after the slab has been finished.

  - process within 4 to 12 hours after the stab has been timened. Reinforcing steel may not extend through a control joint. Reinforcing steel may extend through a saw cut joint.

    All welded wire fabric (WWF.) for concrete slabs-on-grade shall be placed at mid-depth of slab. The WWF, shall be securely supported during the concrete pour.

- CONCRETE RENFORCEMENT.

  I. Fibrous concrete reinforcement, or fibermesh, specified in concrete slabs-on-grade may be used for control of cracking due to shrinkage and thermal expansion/contraction, lowered water migration, an increase in impact capacity, increased
- abrasion resistance, and residual strength.
  Fibernesh reinforcing to be 100% virgin polypropylene fibers containing no reprocessed olefin materials and specifically manufactured for use as concrete secondairy reinforcement.
- Application of fibermesh per cubic yard of concrete shall equa a minimum of 0,1% by volume (15 pounds per cubic yard) Fibermesh shall comply with ABTM CIII6, any local building code requirements, and shall meet or exceed the current industry
- Steel reinforcing bars shall be new billet steel conforming to
- ofteer reinforcing pars shall be new onliet steer conforming to ASTM AGS, grade 60.

  Detailing, fabrication, and placement of reinforcing steel shall be in accordance with the latest edition of ACI 315: "Manual of Standard Practice for Detailing Concrete Structures" Horizontal footing and wall reinforcement shall be continuous and shall have 30° bends, or comer bars with the sense laze/epacing as the horizontal reinforcement with a class Better to reiter.
- Lap reinforcement as required, a minimum of 40 bar diameters for tension or compression unless otherwise noted. Splices in masonry shall be a minimum of 48 bar diameters.

- 9. Where reinforcing dowels are required, they shall be equivalent in size and spacing to the vertical reinforcement. The dowel shall extend 48 bar diameters vertically and 20 bar diameters
- into the footing.

  Where reinforcing steel is required vertically, dowels shall be provided unless otherwise noted
- WOOD FRAMING: DITEMINE:
  Solid sawn wood framing members shall conform to the specifications listed in the latest edition of the "National Design Specification for Wood Construction" (NDS). Unless otherwise noted, all wood framing members are designed to be Southern-Yellow-Pine (SYP) 12 or Southm-Spruce Pine (SYF) 12. LVL or PSL engineered wood shall have the following minimum
- design values: 2.1. E = 1,300,000 psi
  - 22. Fb = 2600 ps
  - 23 Ev = 285 ps
- Wood in contact with concrete, masonry, or earth shall be pressure treated in accordance with AWPA standard C-15. All other moisture exposed wood shall be treated in accordance with AWPA standard C-2.
- with AWPA standard C-2
  Mails shall be common wire nails unless otherwise noted.
  Lag screus shall conform to ANSI/ASME standard BI82.1-1381.
  Lead holes for lag screws shall be in accordance with NDS specifications
- All beams shall have full bearing on supporting framing members unless otherwise noted.

  Exterior and load bearing stud walls are to be 2x4 SYP 12 @ 16"
- OC unless atherwise noted. Studs shall be continuous from the sole plate to the double top plate. Studs shall only be discontinuous at headers for window/door openings. A minimum of one king stud shall be placed at each end of the header.
- King stude shall be continuous. Individual stude forming a column shall be attached with one 10d nail \* 6" O.C. staggered. The stud column shall be continuous to the foundation or beam. The column shall be properly blocked at all floor levels to ensure proper load transfer. Multi-ply beams shall have each ply attached with (3) 10d nails
- Four and five ply beams shall be boilted together with (2) rows of 1/2" diameter through boilts staggered @ 16" O.C. unless

# WOOD TRUSSES:

- The wood trues manufacturer/fabricator is responsible for the design of the wood trusses. Submit sealed shop drawings and supporting calculations to the SER for review prior to fabrication. The SER shall have a minimum of five (5) days for review. The review the review for overall compliance with the design documents. The SER shall assume no responsibility for the correctness for the structural design for the support trusses. the wood trusses.
- The wood trusses shall be designed for all required loadings The wood trusses shall be designed for all required loadings as specified in the local building code, the ASCE Standard "Minimum Design Loads for Buildings and Other Structures." (ASCE 7-10), and the loading requirements shown on these specifications. The truss drawings shall be coordinated with all other construction documents and provisions provided for loads shown on these drawings including but not limited to HVAC equipment, piping, and architectural fixtures attached to
- the trusses. The trusses shall be designed, fabricated, and erected in accordance with the latest edition of the "National Design Specification for Wood Construction." (NDS) and "Design Specification for Metal Plate Connected Wood Trusses."
- Specification for least like confected work of the first manufacturer shall provide adequate bracing information in accordance with "Commentary and Recommendations for Handling, Installing, and Bracing Metal Plate Connected Wood Trusses" (HIB-91). This bracing, both temporary and permanent, shall be shown on the shop drawings.

  Also, the shop drawings shall show the required attachments fo the trusses
- Any chords or truss webs shown on these drawings have been shown as a reference only. The final design of the trusses shall be per the manufacturer.

# EXTERIOR WOOD FRAMED DECKS:

Decks are to be framed in accordance with local building codes and as referenced on the structural plans, either through code references or construction details.

- UOOD STRUCTURAL PANELS.

  L. Fabrication and placement of structural wood sheathing shall be in accordance with the APA Design/Construction Guide "Residential and Commercial," and all other applicable APA
- All structurally required wood sheathing shall bear the mark of

- Wood wall sheathing shall comply with the requirements of local building codes for the appropriate state as indicated on these drawings. Refer to wall bracing notes in plan set for more information, Sheathing shall be applied with the long direction perpendicular to framing, unless noted otherwise.

  Roof sheathing shall be APA rated sheathing exposure 1 or 2.
- Roof sheathing shall be continuous over two supports and attached to its supporting roof framing with (1)-8d CC nall at 6"o/c at panel edges and at 12"o/c in panel field unless otherwise noted on the plans. Sheathing shall be applied with the long direction perpendicular to framing. Sheathing shall have a span rating consistent with the framing spacing. Use
- have a span rating consistent with the framing spacing, use suitable edge support by use of plywood clips or limber blocking unless otherwise noted. Panel end joints shall occur over framing. Apply building paper over the sheathing as required by the state Building Code.


  Wood Floor sheathing shall be APA rated sheathing exposure I or 2. Attach sheathing to its supporting framing with (I)-8d CC ingahark nail at 6 "Or a to panel edges and at 12" of in panel field unless otherwise noted on the plans. Sheathing shall be applied perpendicular to framing, Sheathing shall have a span rating consistent with the framing sheaton. Use suitable edges rating consistent with the framing spacing. Use suitable edge support by use of T4G plywood or lumber blocking unless otherwise noted. Panel and joints shall occur over framing. Apply building paper over the sheathing as required by the
- state Building Code.

  Sheathing shall have a I/8" gap at panel ends and edges as recommended in accordance with the APA.

# TRUCTURAL FIBERBOARD PANELS:

- Fabrication and placement of structural fiberboard sheathing shall be in accordance with the applicable AFA standards.
  All structurally required fiberboard sheathing shall bear the mark of the AFA.
- mark of the AFA.

  Fiberboard wall sheathing shall comply with the requirements of local building codes for the appropriate state as indicated on these drawings. Refer to wall bracing notes in plan set for more
- Sheathing shall have a 1/8" gap at panel ends and edges are recommended in accordance with the AFA.

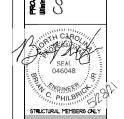

3

CALL SSS MATER COMMITTE AND A LOSS CHECKED BY: BCP

PEPER TO COVER SHEET FOR A COPPLETE LIST OF TREVISIONS

# FOUNDATION NOTES:

- FOUNDATIONS TO BE CONSTRUCTED IN ACCORDANCE WITH CHAPTER 4 OF THE 2018 NORTH CAROLINA RESIDENTIAL BUILDING CODE WITH ALL LOCAL
- AMENDMENTS.

  STRUCTURAL CONCRETE TO BE F. = 3000 PSI, PREPARED AND PLACED IN ACCORDANCE WITH ACI STANDARD 318.

  FOOTINGS TO BE PLACED ON UNDISTURBED EARTH, BEARING A MINIMUM OF 12" BELOW ADJACENT FINISHED GRADE, OR AS OTHERWISE DIRECTED BY THE CODE EMPORCEMENT OFFICIAL.

  FOOTING SIZES BASED ON A PRESUMPTIVE SOIL BEARING CAPACITY OF
- 2000 PSF. CONTRACTOR IS SOLELY RESPONSIBLE FOR VERIFYING THE SUITABILITY OF THE SITE SOIL CONDITIONS AT THE TIME OF CONSTRUCTION.
- 5. FOOTINGS AND PIERS SHALL BE CENTERED UNDER THEIR RESPECTIVE ELEMENTS. PROVIDE 2" MINIMUM FOOTING PROJECTION FROM THE FACE OF
- 6. MAXIMUM DEPTH OF UNBALANCED FILL AGAINST MASONRY WALLS TO BE AS SPECIFIED IN SECTION R404.1 OF THE 2018 NORTH CAROLINA RESIDENTIAL
- BUILDING CODE.
  PILASTERS TO BE BONDED TO PERIMETER FOUNDATION WALL.
- PROVIDE FOUNDATION WATERPROVING, AND DRAIN WITH POSITIVE SLOPE TO OUTLET AS REQUIRED BY SITE CONDITIONS.

  PROVIDED PERIMETER INSULATION FOR ALL FOUNDATIONS PER 2018 NORTH
- CAROLINA RESIDENTIAL BUILDING CODE.

  10. CORBEL FOUNDATION WALL AS REQUIRED TO ACCOMMODATE BRICK VENEERS.
- CRAIL SPACE TO BE GRADED LEVEL AND CLEARED OF ALL DEBRIS
- CRAILL STALE TO BE GRADED LEVEL, AND CLEARED OF ALL DEBRIS.

  FOUNDATION ANCHORAGE SHALL BE CONSTRUCTED PER THE 2018 NORTH

  CAROLINA RESIDENTIAL CODE SECTION RAD316, MINIMUM 12" DIA BOLTS

  SPACED AT 6"-0" ON CENTER WITH A "I" MINIMUM EMBEDMENT INTO MASONRY. OR CONCRETE. ANCHOR BOLTS SHALL BE 10" FROM THE BND OF EACH PLATE SECTION MINIMUM (2) ANCHOR BOLTS FER PLATE SECTION. ANCHOR BOLTS SHALL BE LOCATED IN THE CENTER THIRD OF THE PLATE.

DJ = DOUBLE JOIST S.J = SINGLE JOIST GT = GIRDER TRUSS SC = STUD COLUMN FT = FLOOR TRUSS

DR = DOUBLE RAFTER EE = EACH END TR = TRIPLE RAFTER OC = ON CENTER PL = POINT LOAD TJ = TRIPLE JOIST

- ALL PIERS TO BE 16"x16" MASONRY AND ALL PILASTERS TO BE 8"x16" MASONRY, TYPICAL. (UNO)
   WALL FOOTINGS TO BE CONTINUOUS CONCRETE, SIZES PER STRUCTURAL PLAN.
- 12. A FOUNDATION EXCAVATION OBSERVATION SHOULD BE CONDUCTED BY A
  PROFESSIONAL GEOTECHNICAL ENGINEER OR HIS QUALIFIED
  REPRESENTATIVE. IF ISOLATED AREAS OF YIELDING MATERIALS AND/OR POTENTIALLY EXPANSIVE SOILS ARE OBSERVED IN THE FOOTING EXCAVATIONS AT THE TIME OF CONSTRUCTION, SUMMIT ENGINEERING, LABORATORY 4 TESTING, P.C. MUST BE PROVIDED THE OPPORTUNITY TO REVIEW THE FOOTING DESIGN PRIOR TO CONCRETE PLACEMENT

ALL FOOTINGS & SLABS ARE TO BEAR ON UNDISTURBED SOIL OR \$5% COMPACTED FILL, VERIFIED BY ENGINEER OR CODE OFFICIAL.

REFER TO BRACED WALL PLAN FOR PANEL LOCATIONS AND ANY REQUIRED HOLDOWNS, ADDITIONAL INFORMATION PER SECTION R602.108 AND FIGURES R602.1065, R602.10.1, R602.10.8(1) AND R602.10.8(2) OF THE 2015 IRC

NOTE: ALL EXTERIOR FOUNDATION DIMENSIONS ARE TO FRAMING AND NOT BRICK VENEER UNO

NOTE: A 4" CRUSHED STONE BASE COURSE IS NOT REQUIRED WHEN SLAB IS INSTALLED ON WELL-DRAINED OR SAND-GRAVEL MIXTURE SOILS CLASSIFIED AS GROUP | PER TABLE R4051

REINFORCE GARAGE PORTAL WALLS PER FIGURE R602.10.9 OF THE 2015 IRC.

BEAM POCKETS MAY BE SUBSTITUTED FOR MASONRY PILASTERS AT GIRDER ENDS. BEAM POCKETS SHALL HAVE A MINIMUM 4" SOLID MASONRY BEARING.

NOTE: REDUCE JOIST SPACING UNDER TILE FLOORS, GRANITE COUNTERTOPS AND/OR ISLANDS.

THESE PLANS ARE DESIGNED IN ACCORDANCE WITH ARCHITECTURAL PLANS PROVIDED BY <u>DR.HORTON</u>

COMPLETED/REVISED ON <u>02/28/02/0</u>, IT IS THE RESPONSIBILITY OF
THE CLIENT TO NOTIFY SUMMIT ENGINEERING, LABORATORY 4 TESTING, P.C. IF ANY CHANGES ARE MADE TO THE ARCHITECTURAL PLANS PRIOR TO CONSTRUCTION. SUMMIT ENGINEERING, LABORATORY & TESTING, P.C. CANNOT GUARANTEE THE ADEQUACY OF THESE STRUCTURAL PLANS WHEN USED WITH ARCHITECTURAL PLANS DATED DIFFERENTLY THAN THE DATE LISTED ABOVE.

# STRUCTURAL MEMBERS ONLY

ENGINEERING SEAL APPLIES ONLY TO STRUCTURAL COMPONENTS ON THIS DOCUMENT, SEAL DOES NOT INCLUDE CONSTRUCTION MEANS, METHODS, TECHNIQUES, SEQUENCES, PROCEDURES OR SAFETY PRECAUTIONS ANY DEVIATIONS OR DISCREPANCIES ON PLANS ARE TO BE BROUGHT TO THE IMMEDIATE ATTENTION OF SUMMIT ENGINEERING, LABORATORY & TESTING, P.C. FAILURE TO DO SO WILL VOID SUMMIT LIABILITY


STRUCTURAL ANALYSIS BASED ON 2018 NCRC.

CRAWL SPACE FOUNDATION PLAN

SCALE: 1/4"=1'-0" ON 22"x34" OR 1/8"=1'-0" ON 11"x17"

18"x24" MIN. CRAWL SPACE ACCESS DOOR TO BE LOCATED IN FIELD PER BUILDER PROVIDE MIN. (2) 2x10 HEADER OVER DOOR W/ MIN. 4" BEARING EACH END. AVOID SHOWN POINT LOADS.


DECK FLOOR JOISTS SHALL BE SPACED AT MAX. 12" ON CENTER WHEN DECKING INSTALLED DIAGONALLY

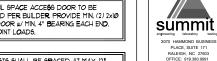






Foundation ace ₹ S PROJECT: Willington -Crawi

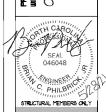

CALL 2564 WH-F-ST CHECKED BY: BCP

REFER TO COVER SHEET FOR A CONFLETE LIST OF PEYHOLOG

S1.0c

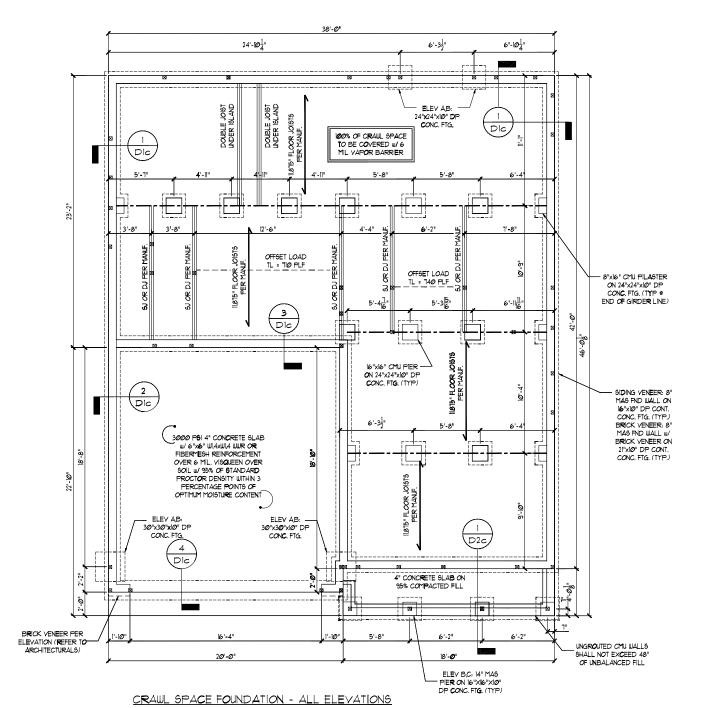

	REQUIRED	BRACED W	ALL PANEL CONNE	CTI <b>O</b> NS
			REQUIRED CONNECTION	
METHOD	MATERIAL	MIN. THICKNESS	PANEL EDGES	# INTERMEDIATE SUPPORTS
C <b>\$</b> -WSP	WOOD STRUCTURAL PANEL	3/8"	6d COMMON NAILS # 6" O.C.	6d COMMON NAIL <b>S</b> # 12" O.C.
GB	GYP9UM BOARD	1/2"	5d COOLER NAILS** 9 T O.C.	5d COOLER NAILS** # 7" O.C.
WSP	WOOD STRUCTURAL PANEL	3/8"	6d COMMON NAILS # 6" O.C.	6d COMMON NAILS # 12" O.C.
PF	WOOD STRUCTURAL PANEL	7/16"	PER FIGURE R602.10.6.4	PER FIGURE R602.10.6.4
		"OR EQUIVALEN	T PER TABLE RT@2.3.5	•

FIRST FI	FIRST FLOOR BRACING (FT)		
CONTI	CONTINUOUS SHEATHING METHOD		
	REQUIRED	PROVIDE <b>D</b>	
BWL I-I	4.8	26.5	
BWL 1-2	4.8	13.5	
BWL 1-3	4.3	13.1	
BWL 1-A	11.5	41.0	
BWL 1-B	11.5	36 <i>.</i> 0	

# GENERAL STRUCTURAL NOTES:

- CONSTRUCTION SHALL CONFORM TO 2018 NORTH CAROLINA RESIDENTIAL BUILDING
- CODE WITH ALL LOCAL AMENDMENTS.

  CONTRACTOR SHALL VERRY ALL DIMENSIONS. CONTRACTOR SHALL COMPLY WITH THE CONTRITO OF THE DRAWING FOR THIS SPECIFIC PROJECT. ENGINEER IS NOT RESPONSIBLE FOR ANY DEVIATIONS FROM THIS PLAN.
- CONTRACTOR (B RESPONSIBLE FOR PROVIDING TEMPORARY BRACING REQUIRED TO RESIST ALL FORCES ENCOUNTERED DURING ERECTION PROPERTIES USED IN THE DESIGN ARE AS FOLLOUS:

- PROPERTIES USED IN THE DESIGN ARE AS FOLLOWS:

  MICROLLAM (1/L), F<sub>B</sub> = 2600 PS), F<sub>V</sub> = 285 PS), E = 1.9×100° PSI

  PARALLAM (PSL): F<sub>B</sub> = 2900 PSI, F<sub>V</sub> = 290 PSI, E = 1.25×100° PSI

  ALL WOOD MEMBERS SHALL BE "2 SYP", SFF (NLESS NOTED ON PLAN, ALL STUD

  COLUMNS AND JOISTS SHALL BE "2 SYP", SFF (NL)

  ALL BEAMS SHALL BE SUPPORTED WITH A (2) 2×4 "2 SYP/", SFF (NL)
- EACH BUT UNLESS NOTED OTHERWISE.

  ALL REINFORCING STEEL SHALL BE GRADE 60 BARS CONFORMING TO ASTM A615
  AND SHALL HAVE A MINIMUM COVER OF 3".
- AND SHALL HAVE A MINIMUM COVER OF 3".

  FOUNDATION ANCHORAGE SHALL BE CONSTRUCTED PER THE 2016 NORTH
  CAROLINA RESIDENTIAL CODE SECTION RAD316 MINIMUM 10" DIA BOLTS SPACED
  AT 6'-0" ON CENTER WITH A 1" MINIMUM EMBEDMENT INTO MASONRY OR
  CONCRETE. ANCHOR BOLTS SHALL BE 12" FROM THE END OF EACH PLATE
- SECTION, MINIMUM (2) ANCHOR BOLTS FER PLATE SECTION, ANCHOR BOLTS SHALL BE LOCATED IN THE CENTER THIRD OF THE PLATE. CONTRACTOR TO PROVIDED LOOKOUTS WHEN CEILING JOISTS SPAN FERPENDICULAR TO RAFTERS.
- 10. FLITCH BEAYS, 4-PLY LVLS AND 3-PLY SIDE LOADED LVLS SHALL BE BOLTED TOGETHER WITH 1/2" DIA THRU BOLTS SPACED AT 24" O.C. (MAX.) STAGGERED OR EQUIVALENT CONNECTIONS PER DETAIL 1/D37. MIN. EDGE DISTANCE SHALL BE 2" AND (2) BOLTS SHALL BE LOCATED MINIMUM 6" FROM EACH END OF THE BEAM
- ALL NON-LOAD BEARING HEADERS SHALL BE (1) FLAT 2'x4 STP "12'SPP" 12, DROPPED, FOR NON-LOAD BEARING HEADERS EXCEEDING 8'-0" IN WIDTH AND/OR WITH MORE THAN 2'-0" OF CRIPPLE WALL ABOVE, 6HALL BE (2) FLAT 2'x4 SYP 12/SPF 12, DROPPED. (UNLESS NOTED OTHERWISE)

DJ = DOUBLE JOIST	SJ = SINGLE JOIST
ST = GIRDER TRUSS	FT = FLOOR TRUSS
C = STUD COLUMN	DR = DOUBLE RAFTER
E = EACH END	TR = TRIPLE RAFTER
TJ = TRIPLE JOIST	OC = ON CENTER
CL = CENTER LINE	PL = <b>POINT</b> LOAD

DESIGNATES JOIST SUPPORTED LOAD BEARING WALL ABOVE, PROVIDE BLOCKING UNDER JOIST SUPPORTED LOAD BEARING WALL

JOIST & BEAM SIZES SHOWN ARE MINIMUMS, BUILDER MAY

INSTALL ANY REQUIRED HOLDOWNS PER SECTION R602.108 AND FIGURES R602.1065, R602.10.1, R602.108(1) AND R602.108(2) OF THE 2015 IRC

THESE PLANS ARE DESIGNED IN ACCORDANCE WITH ARCHITECTURAL PLANS PROVIDED BY <u>DR. HORTON</u>
COMPLETED/REVISED ON <u>02/18/2020</u>, IT IS THE RESPONSIBILITY OF
THE CLIENT TO NOTIFY SUMMIT ENGINEERING, LABORATORY 4 TESTING, P.C. IF ANY CHANGES ARE MADE TO THE ARCHITECTURAL PLANS PRIOR TO CONSTRUCTION. SUMMIT ENGINEERING, LABORATORY & TESTING, P.C. CANNOT GUARANTEE THE ADEQUACY OF THESE STRUCTURAL PLANS WHEN USED WITH ARCHITECTURAL PLANS DATED DIFFERENTLY THAN THE DATE LISTED ABOVE.

NOTE: MEMBER NOTED AS PRESSURE TREATED MAY BE PRAMED WITH NON-PRESSURE TREATED LUMBER PROVIDED THE ENTIRETY OF THE MEMBER IS WRAPPED TO PREVENT MOISTURE INTRUSION


NOTE: REDUCE JOIST SPACING UNDER TILE FLOORS.

# STRUCTURAL MEMBERS ONLY

ENGINEERING SEAL APPLIES ONLY TO STRUCTURAL COMPONENTS ON THIS DOCUMENT, SEAL DOES NOT INCLUDE CONSTRUCTION MEANS, METHODS, TECHNIQUES, SEQUENCES, PROCEDURES OR SAFETY PRECAUTIONS. ANY DEVIATIONS OR DISCREPANCIES ON PLANS ARE TO BE BROUGHT TO THE IMMEDIATE ATTENTION OF SUMMIT ENGINEERING, LABORATORY & TESTING, P.C. FAILURE TO DO SO WILL VOID SUMMIT LIABILITY.

STRUCTURAL ANALYSIS BASED ON 2018 NCRC.

# FIRST FLOOR FRAMING PLAN

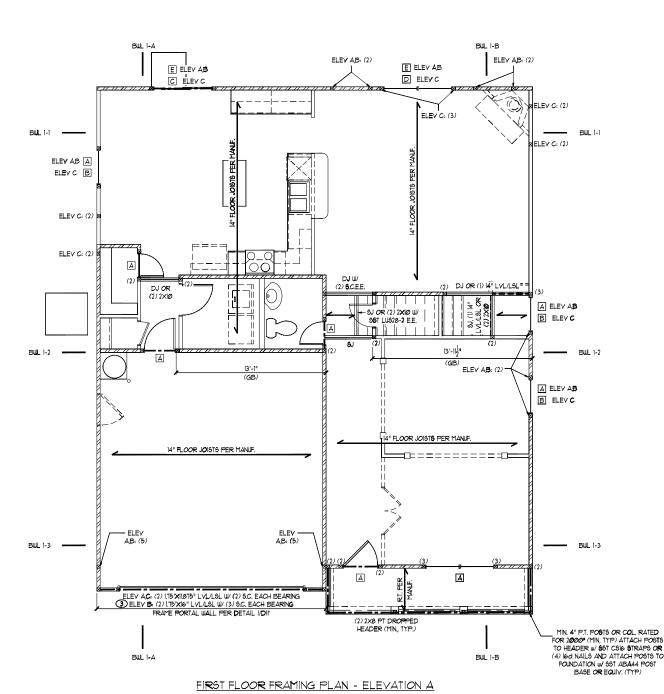

HEADER SCHEDULE TAG SIZE JACKS (EACH END) (2) 246 (2) 2x8 (2) 9-1/4" LSL/LVL (3) 2x6 (3) 2xiØ (3) 2x12

HEADER SIZES SHOWN ON PLANS ARE MINIMUMS. GREATER HEADER SIZES MAY BE USED FOR EASE OF CONSTRUCTION. ALL HEADERS TO BE DROPPED UNLESS NOTED OTHERWISE

LINTEL SCHEDULE		
TAG	SIZE	OPENING SIZE
0	L3x3xl/4"	LESS THAN 6'-0"
2	L5x3x1/4"	6'- <b>0</b> " TO 10'-0"
3	L5x3-1/2"x5/16"	GREATER THAN 10'-0"
4	L5x3-1/2"x5/16" ROLLED OR EQUIY.	ALL ARCHED OPENINGS

SECURE LINTEL TO HEADER w/ (2) 1/2" DIAMETER LAG SCREWS STAGGERED . 16" O.C. (TYP FOR 3)

ALL HEADERS WHERE BRICK IS USED, TO BE: ()(UNO)

# WALL STUD SCHEDULE

16T € 2ND FLOOR LOAD BEARING STUDS: 2x4 STUDS € 16" O.C. OR 2x6 STUDS € 24" O.C. 1ST FLOOR LOAD BEARING STUDS W/ WALK-UP ATTIC: 2x4 STUDS @ 12" O.C. OR 2x6 STUDS @ 16" O.C. BASEMENT LOAD BEARING STUDS: 2x4 STUDS 9 12" OC OR 2x6 STUDS 4 16" OC NON-LOAD BEARING STUDS (ALL FLOORS): 2x4 STUDS @ 24" O.C. TWO STORY WALLS: 2x4 STUDS ● 12" O.C. OR 2x6 STUDS ● 16" O.C. BALLOON FRAMED W/ CROSS BRACING @ 6 -0" O.C. VERTICALLY

OPENING WIDTH	KINGS (EACH END.
LESS THAN 3'-0"	(1)
3'-Ø TO 4'-Ø"	(2)
4'-0" TO 8'-0"	(3)
8'-0" TO 12'-0"	(5)
12'-0" TO 16'-0"	(6)

# BRACED WALL NOTES:

- WALLS SHALL BE DESIGNED IN ACCORDANCE WITH SECTION R602.10 FROM THE 2015 INTERNATIONAL RESIDENTIAL CODE AS ALLOWED PER SECTION R602.10 OF THE 2018 NC RESIDENTIAL CODE.
- WALLS ARE DESIGNED FOR SEISMIC ZONES A-C AND ULTIMATE WIND SPEEDS UP TO 130 MPH.
  REFER TO ARCHITECTURAL PLAN FOR DOORAUNDOW OPENING.

- SIZES.

  BRACING MATERIALS, METHODS AND FASTENERS SHALL BE IN ACCORDANCE WITH IRC TABLE R6/02/10/4.

  ALL BRACED WALL PANELS SHALL BE FULL WALL HEIGHT AND SHALL NOT EXCEED WETET FOR ISOLATED PANEL METHOD AND IZ FEET FOR CONTINUOUS SHEATHING METHOD WITHOUT ADDITIONAL ENGINEERING CALCULATIONS.

  MINIMUM PANEL LENGTH SHALL BE PER TABLE R6/02/10/55.

  THE NATERIOR SECTION ENTRED OF METHOD AND AS AND AS AND ASSOCIATIONS.
- THE INTERIOR SIDE OF EXTERIOR WALLS AND BOTH SIDES OF INTERIOR WALLS SHALL BE SHEATHED CONTINUOUSLY WITH MINIMM IN GYPSUM BOARD (UNO).
  FOR CONTINUOUS SHEATHING METHOD, EXTERIOR WALLS SHALL BE
- PAREATHED ON ALL SHEATHABLE SUFFACES INCLUDING INFILL AREAS BETWEEN BRACED WALL PANELS, ABOVE AND BELOW WALL OPENINGS, AND ON GABLE END WALLS.
- OF BRIGGS, AND ON GABLE BY MALLS.

  FLOORS SHALL NOT BE CANTILEVERED MORE THAN 24" BEYOND
  THE FOUNDATION OR BEARING WALL BELOW WITHOUT ADDITIONAL
  ENGINEERING CALCULATIONS.
  A BRACED WALL PANEL SHALL BE LOCATED WITHIN 10 FEET OF
- EACH END OF A BRACED WALL LINE.
- ID. THE MAXIMUM EDGE DISTANCE BETWEEN BRACED WALL PANELS SHALL NOT EXCEED 20 FEET.

  II. MASONRY OR CONCRETE STEM WALLS WITH A LENGTH OF 48" OR
- LESS SUPPORTING A BRACED WALL PANEL SHALL BE DESIGNED IN ACCORDANCE WITH FIGURE RE20109 OF THE 2015 IRC.
  BRACED WALL PANEL CONNECTIONS TO FLOOR/CELLING SHALL BE CONSTRUCTED IN ACCORDANCE WITH SECTION RE21208
- BRACED WALL PANEL CONNECTIONS TO ROOF SHALL BE CONSTRUCTED IN ACCORDANCE WITH SECTION R602.10.32 AND
- FIGURES R602.10.8(1)4(2)4(3). CRIPPLE WALLS AND WALK OUT BASEMENT WALLS SHALL BE
- DEBICALED IN ACCORDANCE WITH SECTION REGOLIDII
  PORTAL WALLS SHALL BE DESIGNED IN ACCORDANCE WITH FIGURE
  REGOLIDEA (UNO)
- 16 ON SCHEMATIC SHADED WALLS INDICATE BRACED WALL PANELS


GB = GYPSUM BOARD WSP = WOOD STRUCTURAL PANEL 







 $\overline{\Omega}$ aming 宀 3 π̈ PROJECTS Wilnington First

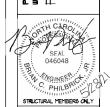

CALL 2564 WH-F-ST CHECKED BY: BCP

PERFECTO COVER SHEET FOR A CONFLETE LIST OF FRANCIS

S3.0

	REQUIRED	BRACED W	ALL PANEL CONNE	CTI <b>O</b> NS
			REQUI <b>R</b> ED	CONNECTION
METHOD	MATERIAL	MIN. THICKNESS	9 PANEL EDGES	# INTERMEDIATE SUPPORTS
C <b>5</b> -W6P	WOOD STRUCTURAL PANEL	3/8"	6d COMMON NAILS @ 6" O.C.	6d COMMON NAILS @ 12" O.C.
GB	GYP9UM BOARD	1/2"	5d COOLER NAILS** # 7" O.C.	5d COOLER NAIL <b>S::</b> @ 7" O.C.
WSP	WOOD STRUCTURAL PANEL	3/8"	6d COMM <b>O</b> N NAILS # 6" <b>O</b> .C.	6d COMMON NAILS # 12" O.C.
PF	WOOD STRUCTURAL PANEL	7/16"	PER FIGURE R602.10.6.4	PER FIGURE R602.10.6.4
		"OR EQUIVALEN	T PER TABLE R1023.5	

## GENERAL STRUCTURAL NOTES:

- CONSTRUCTION SHALL CONFORM TO 2018 NORTH CAROLINA RESIDENTIAL BUILDING CODE WITH ALL LOCAL AMENDMENTS.
- CODE WITH ALL LOCAL AMENDMENTS.
  CONTRACTOR SHALL COMPLY WITH
  THE CONTENTS OF THE DRAWING FOR THIS SPECIFIC PROJECT, ENGINEER IS NOT
  RESPONSIBLE FOR ANY DEVIATIONS FROM THIS PLAN.
  CONTRACTOR IS RESPONSIBLE FOR PROVIDING TEMPORARY BRACING REQUIRED

- CONTRACTOR IS REPORTED TO REPOYIDING TENTPORARY BRACING REQUIRED TO RESIST ALL FORCES ENCOUNTERED DURING ERECTION.

  PROPERTIES USED IN THE DESIGN ARE AS FOLLOWS.

  MICROLLAM (1.74), F. 5, 2600 PSI, F. 285 PSI, E. 1.9510° PSI

  PARALLAM (PSI), F. 5, 2900 PSI, F. 290 PSI, E. 1.9510° PSI

  ALL WOOD MEMBERS SHALL BE 12, SYP/2 SPF UNLESS NOTED ON PLAN, ALL STUD

  COLUMNS AND JOISTS SHALL BE 12, SYP/2 SPF UNLESS NOTED ON PLAN, ALL STUD

  COLUMNS AND JOISTS SHALL BE 12, SYP/2 SPF (UND).
- ALL BEAMS SHALL BE SUPPORTED WITH A (2) 2x4 2 SYP/2 SPF STUD COLUMN AT FACH END UNI ESS NOTED OTHERWISE
- 2. ALL REINFORCING STEEL SHALL BE GRADE 60 BARS CONFORMING TO ASTM A615 AND SHALL HAVE A MINIMUM COVER OF 31.

  8. FOUNDATION ANCHORAGE SHALL BE CONSTRUCTED PER THE 2018 NORTH
- CAROLINA RESIDENTIAL CODE SECTION RADSILE MINIMIM I/2" DIA BOL 15 SPACED AT 6-0" ON CENTER WITH A 1" MINIMIM EMBEDMENT INTO MASONRY OR CONCRETE. ANCHOR BOL 15 SHALL BE I/2" FROM THE END OF EACH PLATE SECTION, MINIMUM (2) ANCHOR BOLTS PER PLATE SECTION, ANCHOR BOLTS SHALL
- BE LOCATED IN THE CENTER THIRD OF THE PLATE.

  9. CONTRACTOR TO PROVIDED LOCKOUTS WHEN CEILING JOISTS SPAN
  PERPENDICULAR TO RAFTERS.
- ID. FLITCH BEAMS, 4-PLY LVLS AND 3-PLY SIDE LOADED LVLS SHALL BE BOLTED TOGETHER WITH IV." DIA THRU BOLTS SPACED AT 24" OC. (MAX) STAGGERED OR EQUIVALENT CONNECTIONS PER DETAIL ID3", MIN EDGE DISTANCE SHALL BE 2" AND (2) BOLTS SHALL BE LOCATED MINIMAM 6" FROM EACH END OF THE BEAM.
- ALL NON-LOAD BEARING HEADERS SHALL BE (I) FLAT 2x4 SYP 9/SPF 92 DROPPED, FOR NON-LOAD BEARING, HEADERS EXCEEDING 8'-0" IN WIDTH AND/OR WITH MORE THAN 2'-0" OF CRIPPLE WALL ABOVE, SHALL BE (2) FLAT 2x4 SYP 12/SPF 12. DROPPED, (UNLESS NOTED OTHERWISE)

PL = POINT LOAD

12. ABBREVIATIONS:

DJ = DOUBLE JOIST SJ = SINGLE JOIST GT = GIRDER TRUSS FT = FLOOR TRUSS SC = STUD COLUMN EE = EACH END DR = DOUBLE RAFTER TR = TRIPLE RAFTER TJ = TRIPLE JOIST OC = ON CENTER

NOTE:

CL = CENTER LINE

DESIGNATES JOIST SUPPORTED LOAD BEARING WALL ABOVE. PROVIDE BLOCKING UNDER JOIST SUPPORTED LOAD BEARING WALL.

JOIST 4 BEAM SIZES SHOWN ARE MINIMUMS, BUILDER MAY INCREASE DEPTH FOR EASE OF CONSTRUCTION.

INSTALL ANY REQUIRED HOLDOWNS PER SECTION R602.10.8 AND FIGURES R602.10.6.5, R602.10.1, R602.10.8(1) AND R602.10.8(2) OF THE 2015 IRC

NOTE: MEMBER NOTED AS PRESSURE TREATED MAY BE FRAMED WITH NON-PRESSURE TREATED LUMBER PROVIDED THE ENTIRETY OF THE MEMBER IS WRAPPED TO PREVENT MOISTURE INTRUSION

THESE PLANS ARE DESIGNED IN ACCORDANCE WITH ARCHITECTURAL PLANS PROVIDED BY <u>DR. HORTON</u> COMPLETED/REVISED ON <u>02/18/2020</u>, IT IS THE RESPONSIBILITY OF THE CLIENT TO NOTIFY SUMMIT ENGINEERING LABORATORY & TESTING, P.C. IF ANY CHANGES ARE MADE TO THE ARCHITECTURAL PLANS PRIOR TO CONSTRUCTION. SUMMIT ENGINEERING, LABORATORY 4 TESTING, P.C. CANNOT GUARANTEE THE ADEQUACY OF THESE STRUCTURAL PLANS WHEN USED WITH ARCHITECTURAL PLANS DATED DIFFERENTLY THAN THE DATE LISTED ABOVE.

# STRUCTURAL MEMBERS ONLY

ENGINEERING SEAL APPLIES ONLY TO STRUCTURAL COMPONENTS ON THIS DOCUMENT, SEAL DOES NOT INCLUDE CONSTRUCTION MEANS, METHODS, TECHNIQUES, SEQUENCES, PROCEDURES OR SAFETY PRECAUTIONS SEQUENCES, PROCEDURES OR SAFELY FRECAUTIONS.
ANY DEVIATIONS OR DISCREPANCIES ON PLANS ARE TO BE BROUGHT TO THE IMMEDIATE ATTENTION OF SUMMIT ENGINEERING, LABORATORY & TESTING, P.C. FAILURE TO DO SO WILL VOID SUMMIT LIABILITY.

SECOND FLOOR BRACING (FT)

REQUIRED PROVIDED

3Ø.I

41.0

CONTINUOUS SHEATHING METHOD

68

68


BWL 2-2

BWL 2-A

STRUCTURAL ANALYSIS BASED ON 2018 NCRC.

FIRST FLOOR FRAMING PLAN

SCALE: 1/4"=1"-0" ON 22"x34" OR 1/8"=1"-0" ON 11"x17"

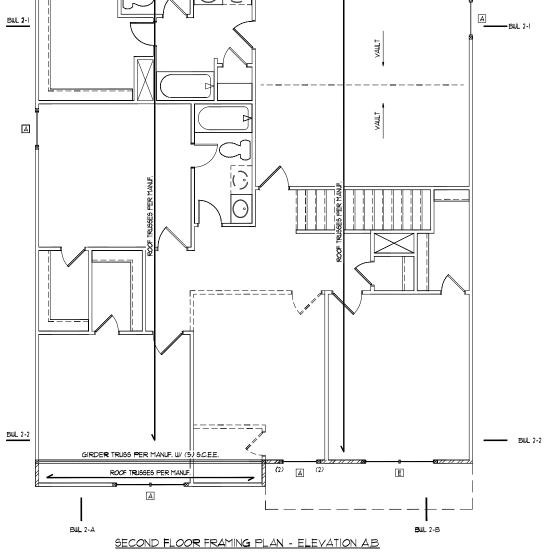

	BWL 2-A	<b>B</b> WL 2-B
<u>BWL 2-1</u>		(2) (2) (2) (2) [A]
A		VAMLT
	ROP TRISSES FER MANIE	BOOF TRANSFER TANKE
BWL 2-2		
	GIRDER TRUSS PER MANUF, W/ (5) S.C.E.E.	N
	ROOF TRUSSES PER MANUF.	(2) A (2)

H	HEADER SCHEDULE		
TAG	SIZE	JACKS (EACH END)	
А	(2) 2x6	(1)	
В	(2) 2x8	(2)	
С	(2) 2xlØ	(2)	
D	(2) 2x12	(2)	
E	(2) 9-1/4" L6L/LVL	(3)	
F	(3) 2x6	(I)	
G	(3) 2x8	(2)	
Н	(3) 2xlØ	(2)	
	(3) 2xl2	(2)	

HEADER SIZES SHOUN ON PLANS ARE MINIMUMS GREATER HEADER SIZES MAY BE USED FOR EASE OF CONSTRUCTION.
ALL HEADERS TO BE DROPPED UNLESS NOTED OTHERWISE. SC NOTED ON PLAN OVERRIDE SC LISTED ABOVE.

LIN	LINTEL SCHEDULE		
TAG	SIZE	OPENING SIZE	
0	L3x3x1/4"	LESS THAN 6'-0"	
2	L5x3x1/4"	6'-0" TO 10'-0"	
3	L5 <b>x</b> 3-1/2"x5/1 <b>6</b> "	GREATER THAN 10'-0"	
4	L5x3-1/2"x5/16" ROLLED OR EQUIV.	ALL ARCHED OPENINGS	

SECURE LINTEL TO HEADER W/ (2) 1/2" DIAMETER LAG SCREWS STAGGERED @ 16" O.C. (TYP FOR 3)

ALL HEADERS WHERE BRICK IS USED, TO BE: (UNO)

# WALL STUD SCHEDULE

<u>161 € 2ND FLOOR LOAD BEARING STUDS:</u> 2x4 STUDS @ 16" O.C. OR **2**x6 STUD**S** @ 24" O.C. IST FLOOR LOAD BEARING STUDS BY WALK-UP ATTIC: 2x4 STUDS @ 12" O.C. OR 2x6 STUDS @ 16" O.C. BASEMENT LOAD BEARING STUDS: 2x4 STUDS @ 12" O.C. OR 2x6 STUDS @ 16" O.C. NON-LOAD BEARING STUDS (ALL FLOORS): 2x4 STUDS @ 24" O.C. TWO STORY WALLS:

2x4 STUDS @ 12" O.C. OR 2x6 STUDS @ 16" O.C. BALLOON FRAMED W/ CROSS BRACING . 6'-0" O.C. VERTICALLY

OPENING WIDTH	KINGS (EACH END)
LESS THAN 3'-0"	(1)
3'- <b>0</b> TO 4'- <b>0</b> "	(2)
4'-0" TO 8'-0"	(3)
8'-0" TO 12'-0"	(5)
12'- <b>0</b> " TO 16'- <b>0</b> "	(6)

# BRACED WALL NOTES:

- D WALLS SHALL BE DESIGNED IN ACCORDANCE WITH SECTION R602.00 FROM THE 2015 INTERNATIONAL RESIDENTIAL CODE AS ALLOWED
- PER SECTION REGOLD OF THE 2018 NO RESIDENTIAL CODE.

  1. WALLS ARE DESIGNED FOR SEISMIC ZONES A-C AND ULTIMATE WIND SPEEDS UP TO 320 MP.I.

  2. REFER TO ARCHITECTURAL PLAN FOR DOORWINDOW OPENING.

- SIZES,

  BRACING MATERIALS, METHODS AND FASTENERS SHALL BE IN
  ACCORDANCE WITH IRC TABLE R602:10.4.

  4. ALL BRACED WALL PANELS SHALL BE RULL WALL HEIGHT AND
  SHALL NOT EXCEED UP FEET FOR ISOLATED PANEL METHOD AND 12
  FEET FOR CONTINUOUS SHEATHING METHOD WITHOUT ADDITIONAL
  DELINERSPOND CALLOUIS TOWN. ENGINEERING CALCULATIONS.
- MINIMUM PAPEL LENGTH SHALL BE PER TABLE R602,105.
  THE INTERIOR SIDE OF EXTERIOR WALLS AND BOTH SIDES OF INTERIOR WALLS SHALL BE SHEATHED CONTINUOUSLY WITH MINIMUM CONTINUOUS AND ASSESSED OF THE SIDES OF THE SIDES
- 1/2" GYPSUM BOARD (UNO). FOR CONTINUOUS SHEATHING METHOD, EXTERIOR WALLS SHALL BE SHEATHED ON ALL SHEATHABLE SURFACES INCLUDING INFILL AREAS BETWEEN BRACED WALL PANELS, ABOVE AND BELOW WALL OPENINGS AND ON GABLE END WALLS
- FLOORS SHALL NOT BE CANTILEVERED MORE THAN 24" BEYOND THE FOUNDATION OR BEARING WALL BELOW WITHOUT ADDITIONAL ENGINEERING CALCULATIONS.
- 9. A BRACED WALL PANEL SHALL BE LOCATED WITHIN 10 FEET OF EACH END OF A BRACED WALL LINE.
  10. THE MAXIMUM EDGE DISTANCE BETWEEN BRACED WALL PANELS
- SHALL NOT EXCEED 20 FEET.
- MASONRY OR CONCRETE STEM WALLS WITH A LENGTH OF 48" OR LESS SUPPORTING A BRACED WALL PANEL SHALL BE DESIGNED IN ACCORDANCE WITH FIGURE R602109 OF THE 2015 IRC. 12. BRACED WALL PANEL CONNECTIONS TO FLOOR/CEILING SHALL BE
- 2. BRACED WALL PANEL CONNECTIONS OF PLOORCELING SHALL CONSTRUCTED IN ACCORDANCE WITH SECTION R602.103

  3. BRACED WALL PANEL CONNECTIONS TO ROOF SHALL BE CONSTRUCTED IN ACCORDANCE WITH SECTION R602.1032 AND
- FIGURES R602 108(1)4(2)4(3) CRIPPLE WALLS AND WALK OUT BASEMENT WALLS SHALL BE DESIGNED IN ACCORDANCE WITH SECTION R602.10/11
- 15. PORTAL WALLS SHALL BE DESIGNED IN ACCORDANCE WITH FIGURE R602,106.4 (UNO)
- 16. ON SCHEMATIC, SHADED WALLS INDICATE BRACED WALL PANELS.
  11. ABBREVIATIONS:

GB = GYPSUM BOARD | USP = WOOD STRUCTURAL PANEL C6-XXX = CONT. SHEATHED | ENG = ENGINEERED SOLUTION FF = PORTAL FRAME PF-ENG = ENG, PORTAL PRAME





aming 宀 ö 3 π̈ PROJECTS Wilnington First



CALL 2564 WH-F-ST COLUMN SYLLOW CHECKED BY: BCP MANUL RECORDATION

FROMET DATE

DATE

ONLY

PERFECTO COVER SHEET FOR A CONFLETE LIST OF FRANCIS

S4.0

THESE PLANS ARE DESIGNED IN ACCORDANCE WITH ARCHITECTURAL, PLANS PROVIDED BY <u>PR HORTON</u> COMPLETED/REVISED ON <u>20.28/2010</u>, IT IS THE RESPONSIBILITY OF THE CLIENT TO NOTIFY SUMMIT ENSINEERING, LABORATORY (\* TESTING, PC. IF ANY CHANSES ARE HADE TO THE ARCHITECTURAL PLANS PRIOR TO CONSTRUCTION. SUMMIT ENGINEERING, LABORATORY (\* TESTING, PC. CANNOT GLIARANTEE THE ADEQUACY OF THESE STRUCTURAL PLANS WHEN USED WITH ARCHITECTURAL PLANS DATED DIFFERENTLY THAN THE DATE LISTED ABOVE.

NOTE: 15T PLY OF ALL SHOWN GIRDER TRUSSES TO ALIGN WITH INSIDE FACE OF WALL (TYP, UNO)

NOTE: ROOF TRUSSES SHALL BE SPACE TO SUPPORT FALSE FRAMED DORMER WALLS (TYP, UNO)


STRUCTURAL MEMBERS ONLY

ENGINEERING SEAL APPLIES ONLY TO STRUCTURAL COMPONENTS ON THIS DOCUMENT, SEAL DOES NOT INCLUDE CONSTRUCTION MEANS, METHODS, TECHNIQUES, SEQUENCES, PROCEDURES OR SAFETY PRECAUTIONS. ANY DEVIATIONS OR DISCREPANCIES ON PLANS ARE TO BE BROUGHT TO THE IMMEDIATE ATTENTION OF SUMMIT ENGINEERING, LABORATORY & TESTING, P.C. FAILURE TO DO SO WILL VOID SUMMIT LIABILITY.

STRUCTURAL ANALYSIS BASED ON 2018 NCRC.

ROOF FRAMING PLAN

SCALE: 1/4"=1'-0" ON 22"x34" OR 1/8"=1'-0" ON 11"x1

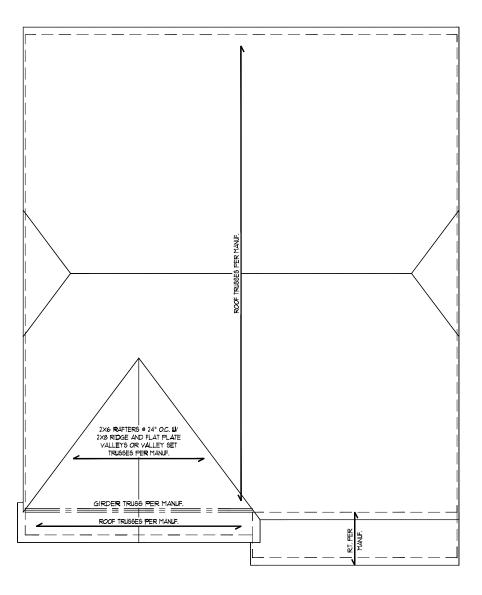


ROOF FRAMING PLAN - ELEVATION A





DR Horton, Inc. 8001 Arrowridge Blvd. Charlotte, NC 28713

Frankin Wengton - 14 First Floor Framing Plan

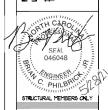

STRUCTURAL MEMBERS OF

BCALE 2844 MP-1-87
BIT MP-1-87
PROJECT \$ 185-649; TRAINE STAIN SYL-CEP
CHECKED BY: BCP
RESMAL RECEPTATION

DATE OF COMP AND THE

PETER TO COMPRISED FOR A COTPLETE LIST OF REVISIONS

S5.Ø