COLLEX481BUYERMARKEDPLAN

SOUTHPORT

SOUTHPORT REVISION LIST - STRUCTURAL:

- . COMBINED WILMINGTON AND WILMINGTON II PLANS. (2-18)
- ADDED BRICK OPTION ON SECOND FLOOR. (2-18)
- CALLED OUT SERIES/SPACING OF IJOISTS ON BASEMENT. (2-18)
- . 2018 NCRC UPDATE (6-19)
- 5. 2018 SC IRC (2-15-20)
- 6. ADDED ELEVATION A.2 (BRICK WATERTABLE W/ SIDING ABOVE) & ELEVATION A.3 (STONE WATERTABLE W/ SIDING ABOVE). (2-15-20)

SOUTHPORT REVISION LIST - ARCHITECTURAL:


AUGUST 01, 2021

- 1. CREATED ELEVATIONS TO BE IN STANDARDS WITH OTHER PLANS (SEE SHEETS A:1 THROUGH A:3.5)
- . CHANGED COLUMNS ON ELEVATIONS TO STANDARD COLUMNS
- 3. CHANGED GARAGE DOORS TO REPRESENT STANDARD GARAGE DOOR FOR EACH ELEVATION
- 4 FIXED COVERED PORCH TO KEEP COLLIMNS FROM OVERLAPPING EDGE OF CONCRETE
- 5. REMOVED GRIDS FROM TRANSOMS ABOVE FRONT DOOR
- 5. ADDED NOTE FOR GARAGE DOOR "GARAGE DOOR PER SPECIFICATIONS AND GLASS INSERT (TOP PANEL ONLY)"
- MOVED ROOF PLANS TO SHEETS A-8 & A-8.1
- CREATED SLAB INTERFACE PLAN (SEE SHEET A-4 THROUGH A-4.2)
- 9. MOVED ALL OPTIONS OFF BASE PLAN AND PLACED ON SEPARATE SHEET
- 10. ADDED NOTE FOR FLUSH COUNTERTOP ON ISLAND
- CHANGED PATIO SIZE TO STANDARD 12'X10'
- ADDED OPTIONAL GAS LINE
- CHANGED KITCHEN LAYOUT
- ADDED 2ND HOSE BIB
- 5. CALLED OUT '45' WALL WITH CAP' AS STANDARD
- 16. CHANGED ALL EXTERIOR WALLS FROM 2X6 TO 2X4 EXCEPT WHERE SHADED
- ADDED NOTE "OPT. REF."
- REMOVED NUMBERS ON STAIRS
- ADDED NOTE 'OPT. W/D'
- 20. ADDED NOTE "WASHER ALWAYS TO BE LOCATED TO THE LEFT OF DRYER
- VERIFIED VENTILATION AND LIGHT REQUIREMENTS AT OWNER'S BEDROOM MEETS CODE (11-01-20)
- 22. SQUARE FOOTAGES ARE UPDATED AND CHANGED DUE TO MOVEMENT OF WALLS FROM 2X6 TO 2X, TO KEEP JOOS IN ROOMS, EXTERIOR WALL MOVED MEANING ROOF LINES HAVE CHANGED
- 3. SQUARE FOOTAGE OF COVERED PORCH CHANGED DUE TO KEEPING COLUMNS FROM OVERLAPPING CONCRETE EDGE
- 24. CREATED PARTIAL PLANS FOR B & C ELEVATIONS (FLOOR, SLAB, & ELECTRICAL)
- REMOVED ALL WALL OUTLETS
- REMOVED ALL PHONE OUTLETS
- 27. REMOVED ALL TV OUTLETS
- 28. PLACED STANDARD 3 BULB LIGHT IN KITCHEN
- VERIFIED COACH LIGHT LOCATIONS (SEE ELEVS. FOR DIMS.)
- 0. PLACED DASHED FANS WHERE APPLICABLE WITH NOTE *STD. LIGHT, OPT. FAN/LT PREWIRE*
- 31. UPDATED ELECTRICAL KEY
- 32. VERIFIED CO2 DETECTOR LOCATIONS
- 33. SHOWED PENDANT LIGHTS AS OPTIONAL
- 4. SHOWED CAN LIGHTS IN KITCHEN AND FAMILY ROOM AS 'OPTIONAL CAN LIGHTS'
- 35. PLACED OPTIONAL FLOOD LIGHTS
- 6. PLACED OPTIONAL FLOOR OUTLET IN FAMILY ROOM
- 37. PLACED CALCULATIONS FOR SOFFIT AND RIDGE VENT REQUIREMENTS
- 8. UPDATED STAIR LAYOUT TO KEEP MAIN WALL AT KITCHEN FROM MOVING WHEN OPTIONAL BASEMENT SELECTED.

NGINEERED BY:





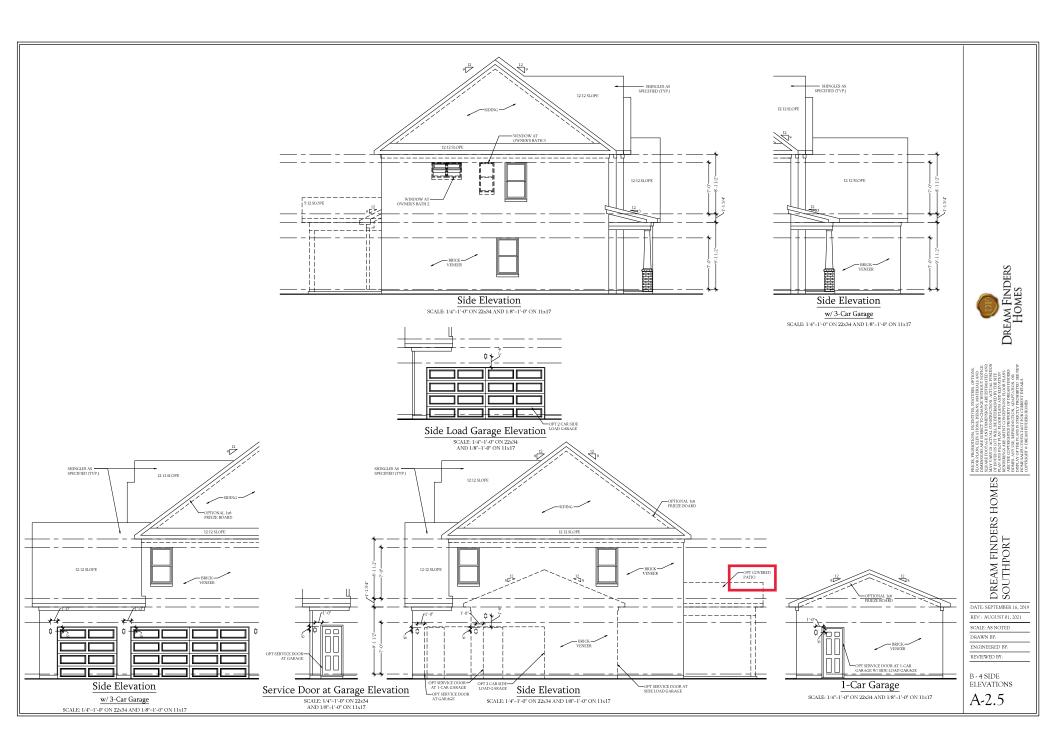




DREAM FINDERS HOMES SOUTHPORT


DATE: SEPTEMBER 16, 2019 REV:: AUGUST 01, 2021


SCALE: 1/4"-1'0" DRAWN BY:

ENGINEERED BY:

SLAB INTERFACE PLAN

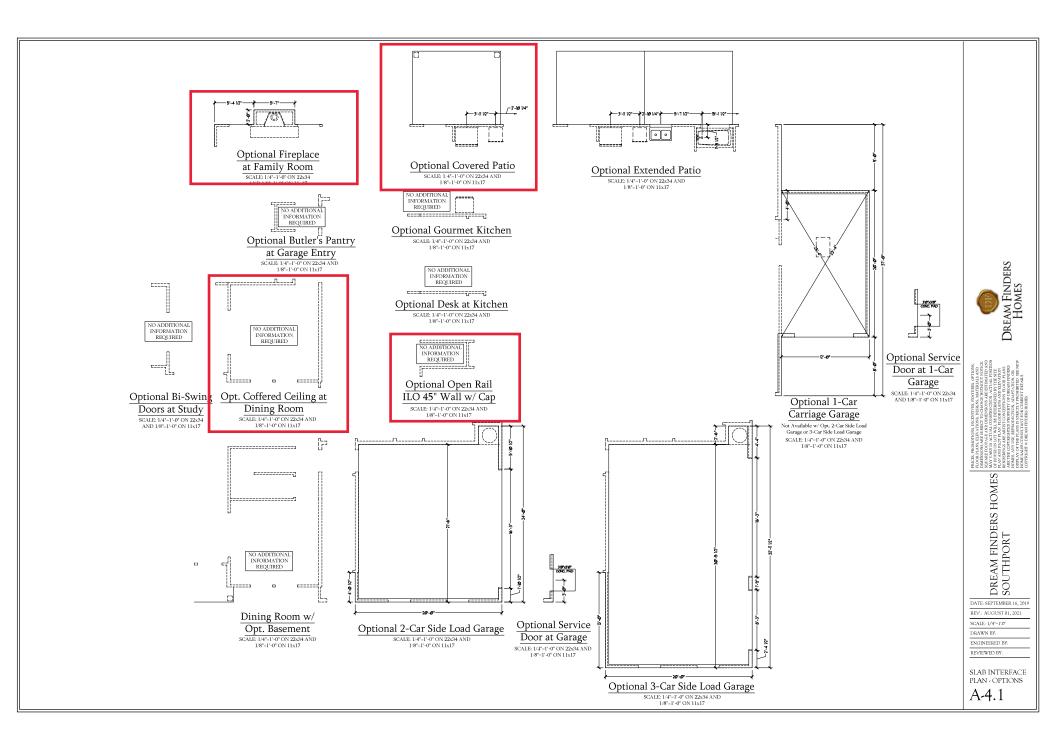

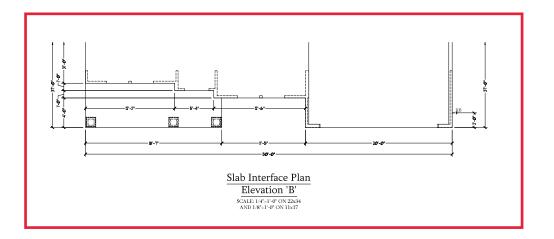

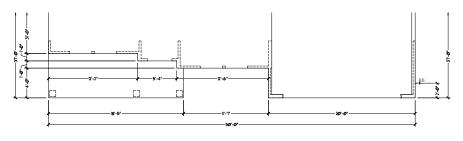

Slab Interface Plan
Elevation 'C'
SCALE: 1/4"-1"-0" ON 22x34
AND 1/8"-1"-0" ON 11x17



DREAM FINDERS HOMES SOUTHPORT


DATE: SEPTEMBER 16, 2019 REV.: AUGUST 01, 2021

SCALE: 1/4"-1'0"

DRAWN BY: ENGINEERED BY: REVIEWED BY:

SLAB INTERFACE PARTIAL PLANS

A-4.2

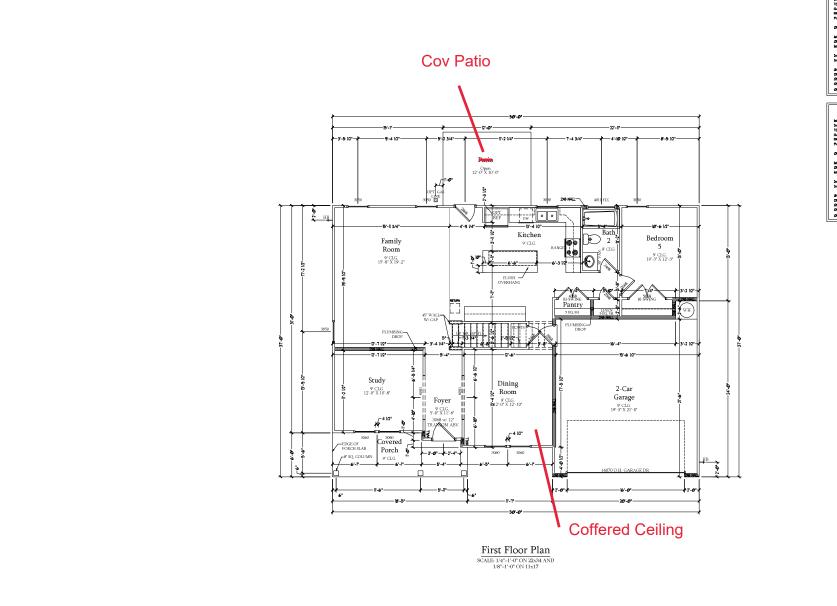

SQUARE ROOTAGE

In ROOM

IN RO

Int. FLOOR:	1321 8Q. F
and FLOOR	1626 5Q.F
TOTAL	1947 5Q.F
GARAGE	430 SQ.F
FRONT PORCH	104 5Q.F
PATIO	100 SQ. F
OPT, BASEMENT	1311 5Q. F
In FLOOR OPTIONS	
OPTIONAL FIREPLACE:	B 50, F
IN FLOOR IN OPT, BASEMENT:	29 8Q.F
2nd FLOOR OPTIONS	
and Floor W OPT, BASEMENT:	25 6Q.F
UNHEATED OPTIONS	
OPT, 1-CAR GARAGE:	258 6Q.F
OPT, 3-CAR GARAGE:	636 5Q.F
OPT. COVERED PATIO:	100 SQ. F
OPT EXTENDED PATES	120 SQ. F



I PRICES PRIMATIONS (DESIGNS AMPRIANCES PATRONES OFTOW PROME PACKS ELIVINOSIS (DESIGNS AMPRIANCES OF PROME PACKS P

DREAM FINDERS HOMES


DATE: SEPTEMBER 16, 2019 REV.: AUGUST 01, 2021

REV.: AUGUST 01, 202 SCALE: 1/4"-1'-0"

DRAWN BY: ENGINEERED BY:

REVIEWED BY:

FIRST FLOOR PLAN

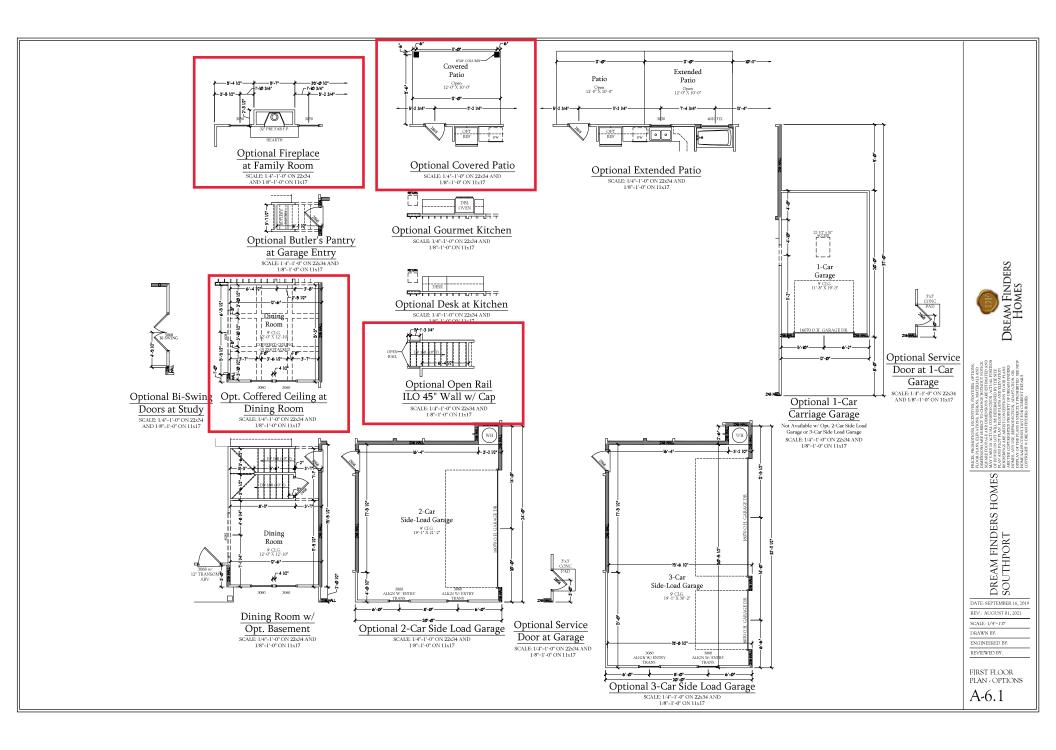



PINCE PROMINON RECIPION FOUNDERS FOUNDERS CONON TO CONCENTRATION OF THE PROPERTY OF THE PROPER

DREAM FINDERS HOMES SOUTHPORT

DATE: SEPTEMBER 16, 2019 REV.: AUGUST 01, 2021


REV.: AUGUST 01, 202 SCALE: 1/4"-1'0"

DRAWN BY: ENGINEERED BY:

REVIEWED BY:

B ELEVATION FIRST FLOOR PARTIAL PLANS

A-6.3

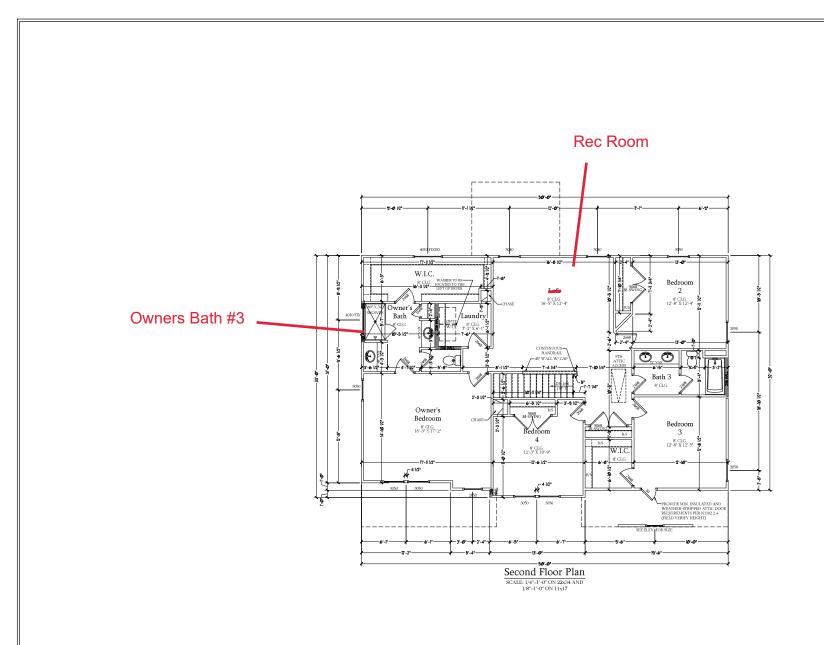



DREAM FINDERS HOMES
SOUTHPORT


DATE: SEPTEMBER 16, 2019 REV.: AUGUST 01, 2021


REV.: AUGUST 01, 202 SCALE: 1/4"-1'-0"


DRAWN BY: ENGINEERED BY:

REVIEWED BY:

SECOND FLOOR PLAN

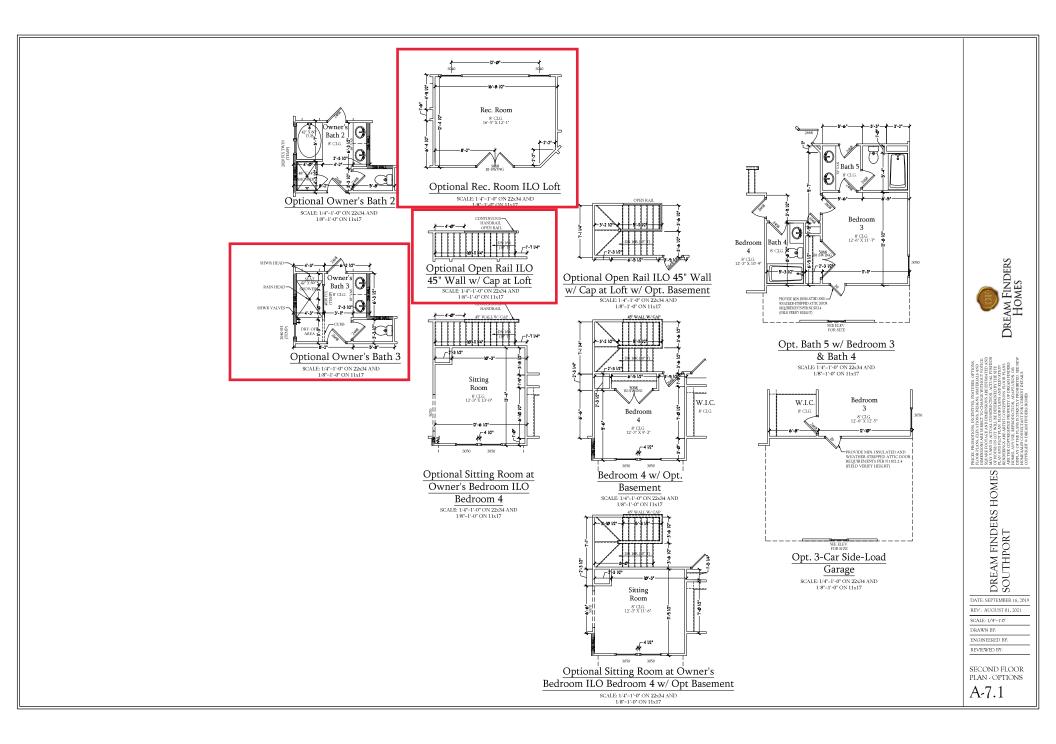

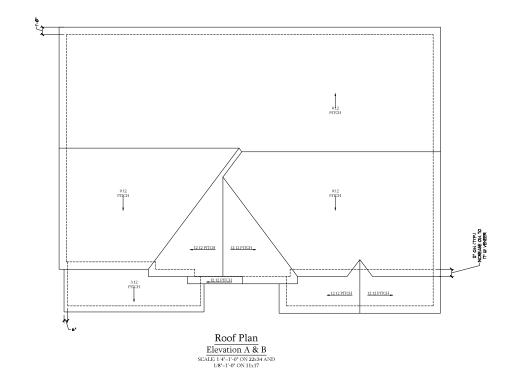

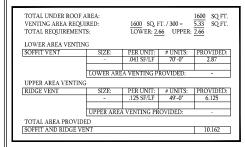

DREAM FINDERS HOMES

ES de preca production de constitución de cons

DREAM FINDERS HOMES RANGE REVENS SOUTHPORT

DATE: SEPTEMBER 16, 2019

REV.: AUGUST 01, 2021


SCALE: 1/4"-1'-0"


DRAWN BY:

ENGINEERED BY:

REVIEWED BY:

ELEVATIONS A & B ROOF PLAN

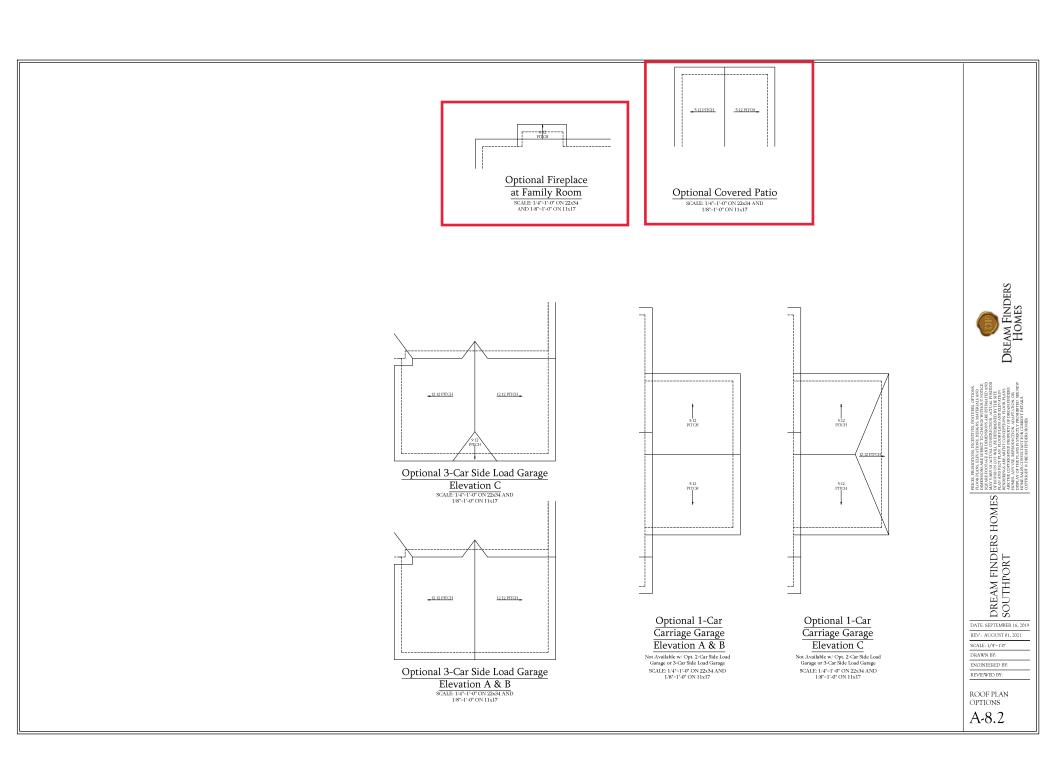

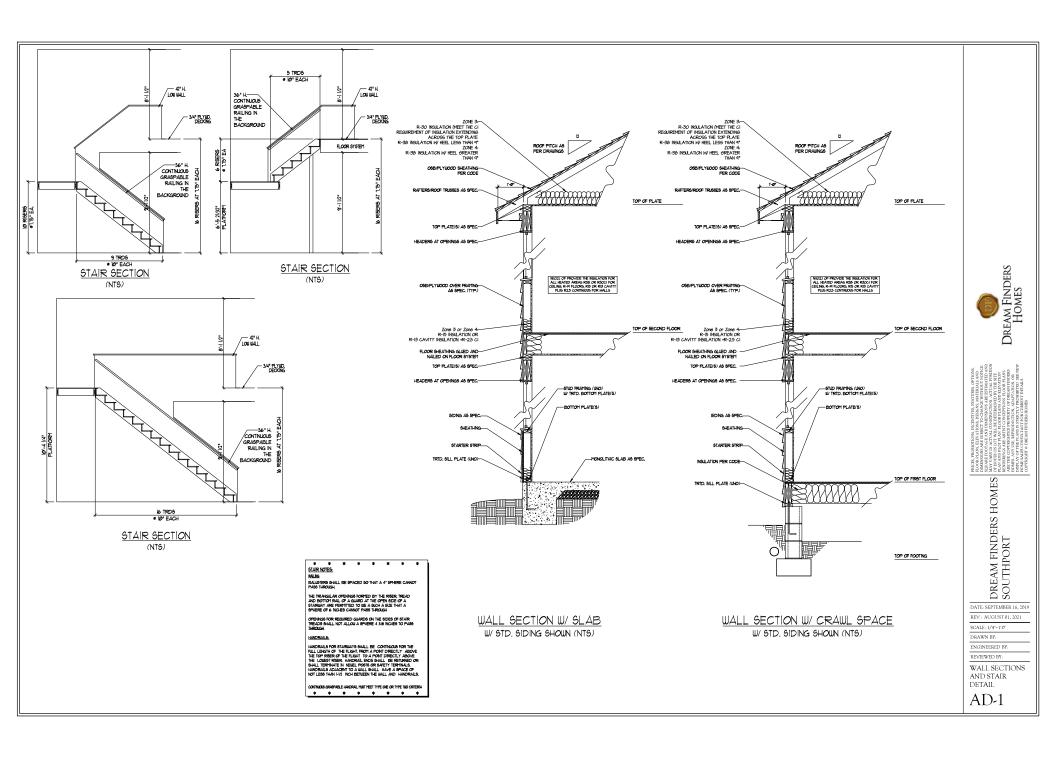

WALL MOUNT LIGHT

CEILING MOUNT LIGHT

PENDANT LIGHT

RECESSED CAN LIGHT

MINI CAN LIGHT

EYEBALL LIGHT

EVERALL LIGHT
FLUORESCENT LIGHT
UNDERCABINET LIGHT
FLOOD LIGHT
SWITCH

3-WAY SWITCH 4-WAY SWITCH DIMMER SWITCH

TV CONNECTION

TV CONDUIT FOR COMPO

SPE SPEAKER

COMBO SMOKE/
CARBON MONOXIDE DETECTOR

110 V SMOKE DETECTOR

EXHAUST FAN

LOW VOLTAGE PA

`\



LCEILING FAN W

ELECTRICAL NOTES:

 PROVIDE AND INSTALL GROUND FAULT CIRCUIT-INTERRUPTERS (C.F.I.) AS INDICATED ON PLANS OR AS ITEM NO. 4 AND 5 BELOW INDICATES.

TELEPTRANE. 17 (SOCIAL CONTESTED AND TELEVISION . 14*

3. ALL SAIOE DETECTORS STALL BE HARDWIRED INTO AN ELECTRICAL POWER SOURCE AND SHALL BE DEJUPPED WITH A MONTRED BATTEST BACKUP. PROVIDE AND INSTALL LOCALLY CERTIFIED MAKED ETELTORS.


 ALL 15A AND 20A RECEPTACLES IN SLEEPING ROOMS, FAMILY ROOMS, DINING ROOMS, LIVING ROOMS, PAGENES, LIBRARIES, DENS, SUNROOMS, RECEPATION ROOMS, CLOSETS, HALLWAYS, AND SIMILAR AREAS WILL REQUIRE A GOMBINATION TYPE A.F.C.I. DEVICE AND TAMPER PROOF RECEPTACLES.

5. ALL 15A AND 20A 120V RECEPTACLES LOCATED IN THE GARAGE AND UTILITY ROOMS SHALL BE G.F.C.I. PROTECTED (G.F.I).

6. IT IS THE RESPONSIBILITY OF THE LICENSED ELECTRICIAN TO ENSURE THAT ALL ELECTRICAL WORK IS IN FULL COMPLIANCE WITH ALL APPLICABLE LOGAL STANDARDS, CODES, AND ORDINANCES.

7. EVERY BUILDING HAVING A POSSIL-PUEL-BURNING HEATER OR APPLIANCE. FIREPLACE, OR AN ATTACHED CARACES HALL HAVE AN OPERATIONAL CARBON MONOXIDE DETECTOR INSTALLED WITHIN 10 FEET OF EACH ROOM USED FOR SLEEPING PUPLOSES.

B. ALARMS SIAL RECEIVE THEIR PRIMARY KOWER
FROM THE BUILDING WIRNO WHEN SIGH
FROM THE BUILDING WIRNO WHEN SIGH
REMAY RESERVED FROM HE LOCAL OWNER
WITHITY SIGH ALARMS SHALL HAVE BATTERY
BACKUP COMMINATION SKOKECHEN
MONOXIDE ALARMS SHALL BE LISTED OR LABELED
BY A NATIONALLY RECOCNIZED TESTING
LABORATORY.

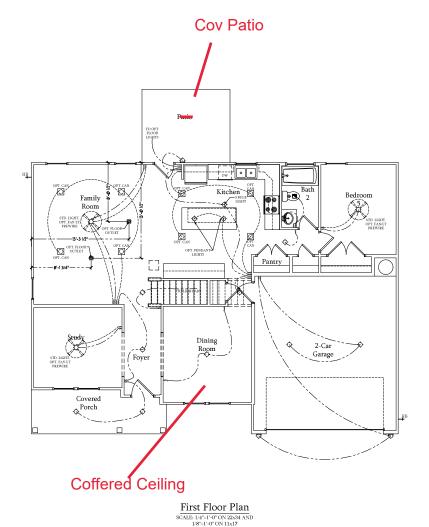



THE THE MEMORING MESTORY RETURNS CHOOSE THE OFFICE OFFICE

DREAM FINDERS HOMES

DATE: SEPTEMBER 16, 2019 REV.: AUGUST 01, 2021


SCALE: 1/4"-1'-0"

DRAWN BY: ENGINEERED BY:

REVIEWED BY: FIRST FLOOR

ELECTRICAL PLAN

E-1

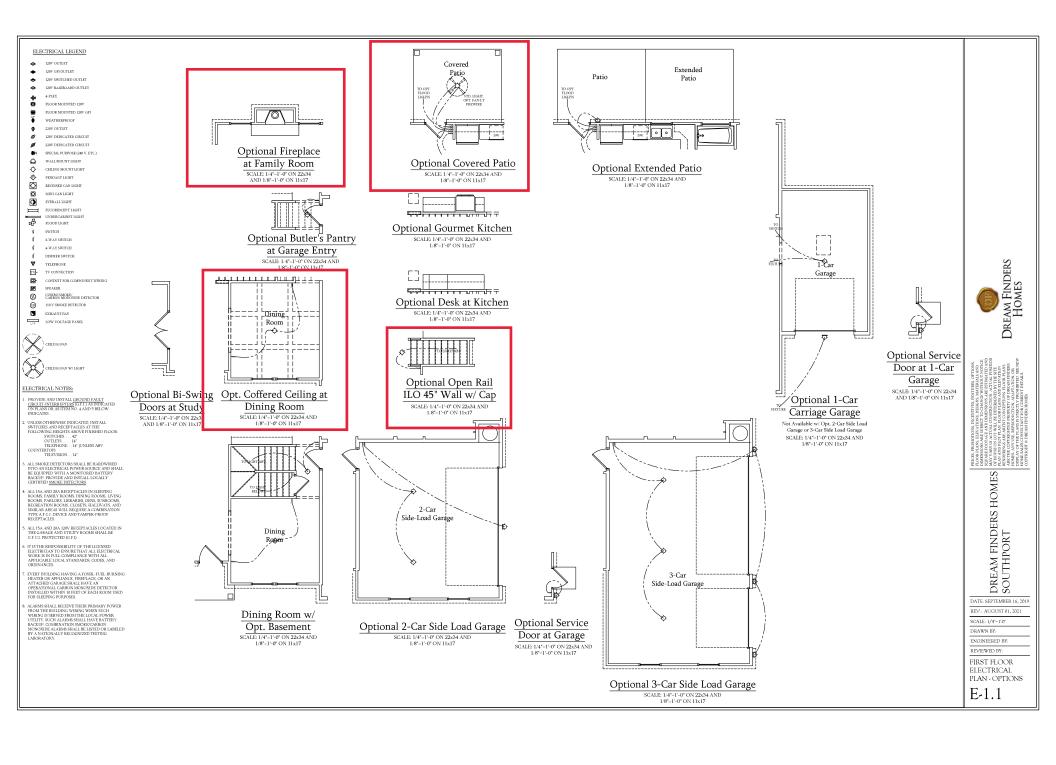

120V GFI OUTLET

120V SWITCHED OUTLET

120V BASEBOARD OUTLET

4-PLEX

FLOOR MOUNTED 120V

FLOOR MOUNTED 120V GFI

120V DEDICATED CIRCUIT

220V DEDICATED CIRCUIT

SPECIAL PURPOSE (240 V, ETC.)

WALL MOUNT LIGHT

CEILING MOUNT LIGHT

PENDANT LIGHT

RECESSED CAN LIGHT

Ø **⊙** MINI CAN LIGHT

EVERALL LIGHT

FLUORESCENT LIGHT \equiv

UNDERCABINET LIGHT
FLOOD LIGHT

SWITCH

3-WAY SWITCH

4-WAY SWITCH

DIMMER SWITCH

TELEPHONE

TV CONNECTION

-CONDUIT FOR COMPONENT WIRING

SPEAKER

Ø

COMBO SMOKE: CARBON MONOXIDE DETECTOR

110 V SMOKE DETECTOR



ELECTRICAL NOTES:

PROVIDE AND INSTALL GROUND FAULT CIRCUIT-INTERRUPTERS [G.F.L] AS INDICATED ON PLANS OR AS ITEM NO. 4 AND 5 BELOW INDICATES.

UNLESS OTHERWISE INDICATED, INSTALL
SWITCHES AND RECEPTACLES AT THE
FOLLOWING HEIGHTS ABOVE FINISHED FLOORSWITCHES ... 42*
OUTLETS ... 14*
COUNTY LIEEPHONE ... 14* (UNLESS ABV

COUNTERTOP)
TELEVISION . . . 14"

ALL SMOKE DETECTORS SHALL BE HARDWIRED INTO AN ELECTRICAL POWER SOURCE AND SHALL BE EQUIPPED WITH A MONITORED BATTERY BACKUP PROVIDE AND INSTALL LOCALLY CERTIFIED SMOKE DETECTORS.


ALL 15A AND 20A RECEPTACLES IN SLEEPING ROOMS, FAMILY ROOMS, DINING ROOMS, FAMILY ROOMS, DINING ROOMS, LIVENGE ROOMS, PAGES, LIBRARIES, DENS, SUNROOMS, RECREATION ROOMS, CLOSETS, HALLWAYS, AND SIMILAR RAESA WILL REQUIRE A COMBINATION TYPE AF CL. DEVICE AND TAMPER-PROOF RECEPTACLES.


ALL 15A AND 20A 120V RECEPTACLES LOCATED IN THE GARAGE AND UTILITY ROOMS SHALL BE G.F.C.I. PROTECTED (G.F.I).

IT IS THE RESPONSIBILITY OF THE LICENSED ELECTRICIAN TO ENSURE THAT ALL ELECTRICAL WORK IS IN FULL COMPLIANCE WITH ALL APPLICABLE LOCAL STANDARDS, CODES, AND ORDINANCES.

EVERY BUILDING HAVING A FOSSIL-FUEL-BURNING HEATER OR APPLIANCE. FIREPLACE, OR AN ATTACHED GARAGE SHALL HAVE AN OPERATIONAL CARBON MONOXIDE DETECTOR INSTALLED WITHIN 10 FEET OF EACH ROOM USED FOR SLEEPING PURPOSES.

ALARMS SIALL RECEIVE THEIR PRIMARY POWER FROM THE BILLIDING WIRING WHEN SICH WIRING IS SEND THE BILLIDING WIRING WHEN SICH WIRING IS SENDED FROM THE LOCAL POWER UTILITY. SUCH ALARMS SHALL HAVE BATTERY BACKLEP COMBINATION SMOKECK, CARBON MONOXIDE ALARMS SHALL BE LISTED OR LABELED BY A NATIONALLY RECOGNIZED TESTING LABORATORY.

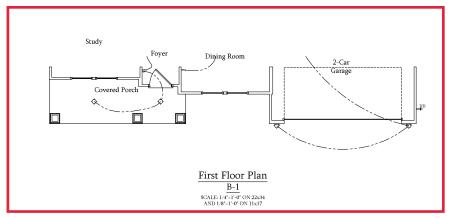

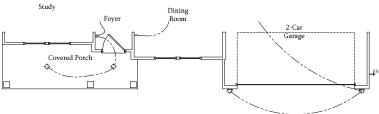

First Floor Plan C-1

SCALE: 1/4"-1'-0" ON 22x34 AND 1/8"-1'-0" ON 11x17



I PREZ PRIMOTORA LENGTHS RETURNE COTORA
TODOS PLACE, ELA VINDEL INSIGNS MATERIALA AND
HARMADORA AGRIBANTO PROCESA
TODOS PLACES PROCESA
TODOS PLACES PROCESA
TODOS PLACESA
TODOS
TO

DREAM FINDERS HOMES SOUTHPORT


DATE: SEPTEMBER 16, 2019 REV.: AUGUST 01, 2021

SCALE: 1/4"-1'-0"

DRAWN BY: ENGINEERED BY-REVIEWED BY:

FIRST FLOOR ELECTRICAL PARTIAL PLANS

E-1.2

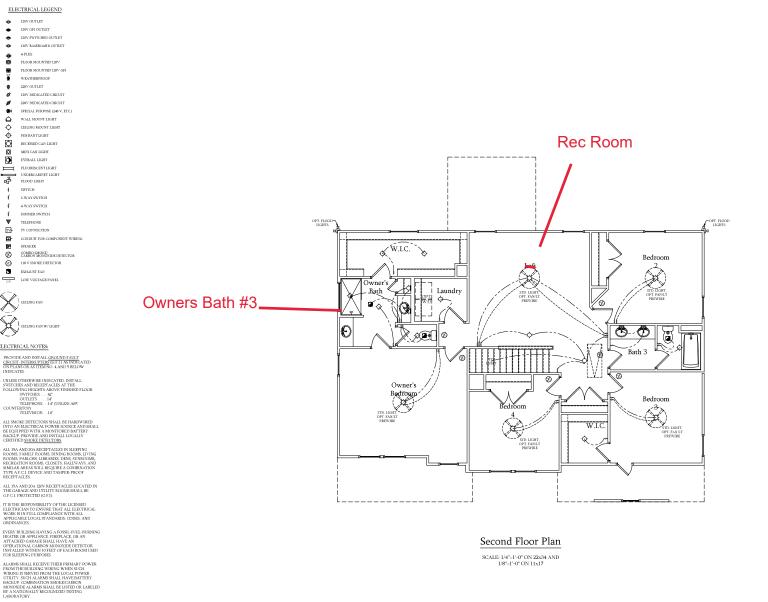

ELECTRICAL LEGEND

WALL MOUNT LIGHT CEILING MOUNT LIGHT

MINI CAN LIGHT EVERALL LIGHT FLUORESCENT LIGHT

TV CONNECTION CONDUIT FOR COMPONENT WIRING

SPEAKER COMBO SMOKE/ CARBON MONOXIDE DETECTOR

ELECTRICAL NOTES:

COUNTERTOP) TELEVISION...14"

PROVIDE AND INSTALL GROUND FAULT CIRCUIT-INTERRUPTERS (G.F.L.) AS INDICATED ON PLANS OR AS ITEM NO. 4 AND 5 BELOW INDICATES.

UNLESS OTHERWISE INDICATED, INSTALL
SWITCHES AND RECEPTACLES AT THE
FOLLOWING HEIGHTS ABOVE FINISHED FLOOR:
SWITCHES ... 42*
OUTLETS ... 14*
COUNTY LIEEPHONE ... 14* (UNLESS ABV

110 V SMOKE DETECTOR

 \equiv UNDERCABINET LIGHT
FLOOD LIGHT SWITCH 3-WAY SWITCH 4-WAY SWITCH DIMMER SWITCH

4-PLEX FLOOR MOUNTED 120* FLOOR MOUNTED 120V GFI

Dream Finders Homes

PRICES PROMOTIONS
THOOR PLANS, ENEWAY
DAMESSIONS ARE SUBMING
SQUARE FOOT AGE AND
MAY VARY IN ACTUAL
OF HOUSE ON LOT WILL
FAN AND PLOY PLAN
RENDERINGS ARE ACTUAL
ROPER AND FOR THE PLANS
HONG SALES CONSULT.

DREAM FINDERS HOMES SOUTHPORT

DATE: SEPTEMBER 16, 2019


REV.: AUGUST 01, 2021 SCALE: 1/4"-1'-0"


DRAWN BY:


ENGINEERED BY-REVIEWED BY:

SECOND FLOOR ELECTRICAL PLAN

E-2

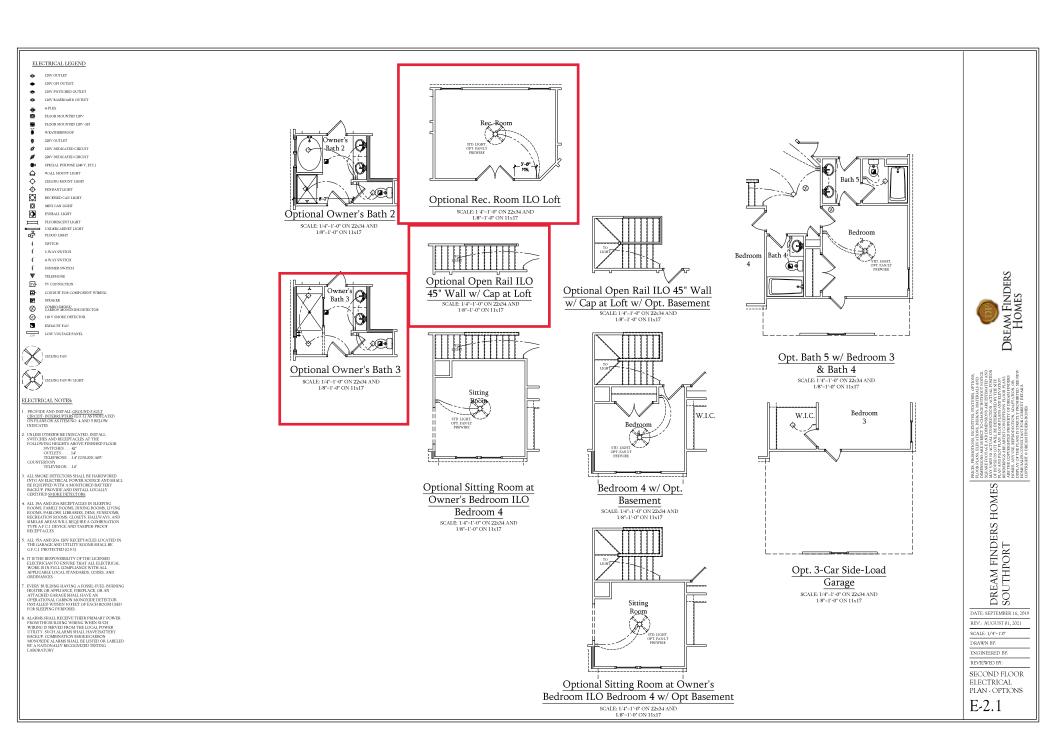

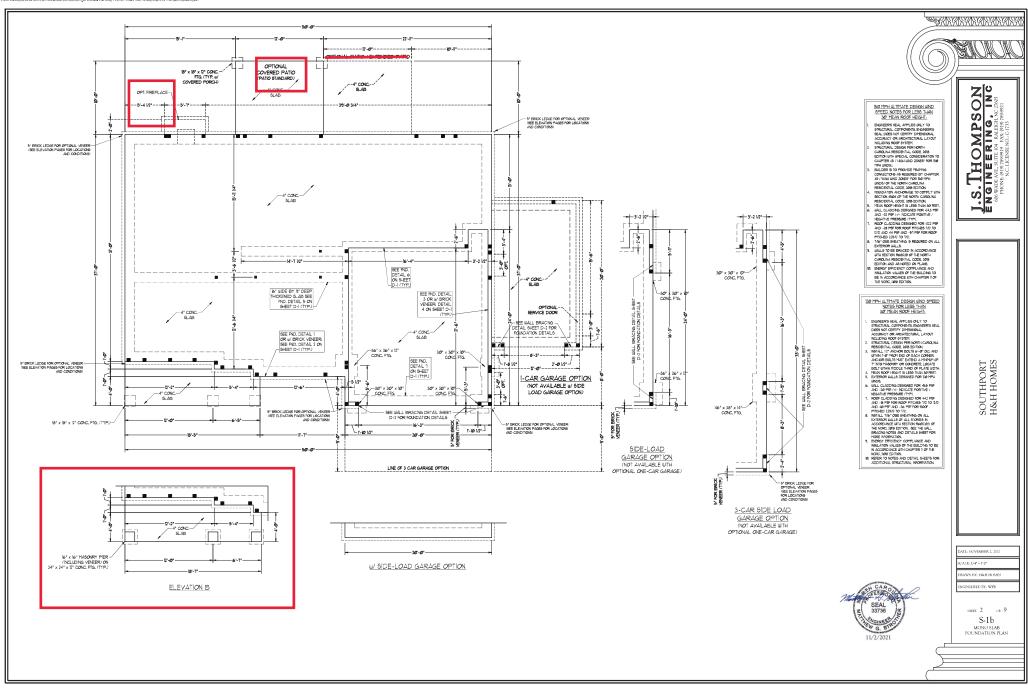

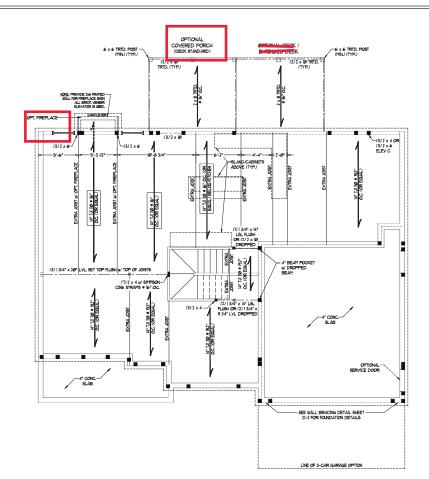

	CHEDULE FOR AL STONE SUPPORT
LENGTH (FT.)	SIZE OF LINTEL
UP TO 4 FT.	L 3 1/2 x 3 1/2 x 1/4
4-8	L 5 x 3 1/2 x 5/16 LLV
8 AND GREATER	L 6 x 4 x 5/16 LLV

BRICK SUPPORT NOTES:

LINTEL SCHEDULE APPLIES TO ALL
OPENINGS IN BRICK VENEER (INO), SEE
ARCH DUGS, FOR SIZE AND LOCATION OF

ARCH DIBER TON SEE ME COPENICAL

(LLV) = LONG LEE VERTICAL

ENGTH = CLEAR OPENICA

EYERD ALL ARCLE ROAD MA ** EACH

SOLE NO MERCER O PROVIDE EX-RING.

SOLE NO MERCER O PROVIDE EX-RING.

N. ENGLE OF MERCER OF MERCER

N. LEIGHT, ATTACH STEEL ANCLE TO

READER WIT VIA & SCREIGS = 17 O.C.

STAGGERED.

STAGGERE

HEADER WITH LAS DOCUMEN & TO FOR.

PARKET WITH THE STATE OF THE STATE

NOTE:

BCI 45006-LB JOISTS MAY BE USED IN LIEU OF TJI IIØ JOISTS AT THE DEPTH AND SPACING NOTED ON THE PLAN.

BRACED WALL DESIGN NOTES:

- RACED MALL DEBON SOTES

 BRACED WALL DEBON FRE SECTION REGULD OF THE NCRC
 308 EDITION.

 108 EDITION.

 109 EDITION.

 109 EDITION.

 100 EDITION.

NOTE:

- 1 FER RECTION REGULAND OF THE 10/9 NORC, THE AYOUNT OF BRACKS REQUIRED ON THE BUILK OUT BASEFISH' BUILLS BUCKEDS THE AYOUNT OF BRACKS ON THE BUILL ADOVE THE THE AYOUNT OF THE AYOUNT OF THE AYOUNT OF THE SHEATH ALL DETRICKS WILLIAS BUILT IN'S 'OSB SHEATHING ATTACKED BUTH BUT NAILS AT 8' OLD ALONG PANEL BOXES AND 0" OLD. IN THE FIELD.

STRUCTURAL NOTES:

- STUDS (UNO)
- ALL LOAD BEARING HEADERS TO BE (3) 2 x 10 (UNO.)

- STUDS (NO.)

 STUDS (NO.)

 STEP SLAFFON FRANCH FRADERS TO BE (3) 2 × 10 (NO.)

 STEP SLAFFON FRADERS TO BE (3) 2 × 10 (NO.)

 STEP SLAFFON FRADERS TO EXECUTE SLAFFON FRADERS TO BE 2 × 4 ± 0"

 CO. COS 2 × 6 ± 10" CO. (NO.)

 ALL LOAD BEARNS INTERCOR BULLS TO BE 2 × 4 ± 0"

 CO. COS 2 × 6 ± 10" CO. (NO.)

 SOR HIGH HID FORDERS, ALL EXTERCOR BULLS TO BE SEATHER SITH OF THE SEATHER SHAFFON FRADERS TO SHAFFON SHAFFON FRADERS TO BE A SHAFFON BULLS TO SHAFFON FRADERS TO SHAFFON SHAFFON FRADERS TO SHAFFON SHAFF

TABLE R662.75
MINMUM NUMBER OF RULL HEIGHT STUDS
AT EACH END OF HEADERS IN EXTERIOR WALLS

HEADER SPAN (FEET)	MAXIMUM STUD SPACING (INCHES) (PER TABLE R6023/5)		
115517	16	24	
UP 10 3'	1	1	
4	2	1	
8'	3	2	
12'	5	3	
16"	6	4	




SON LINCZIGOS I.S. THOMPS ENGINEERING,


SOUTHPORT H&H HOMES

DATE: NOVEMBER 2, 2021

NGINEERED BY: WFB

S-2 FIRST FLOOR FRAMING PLAN

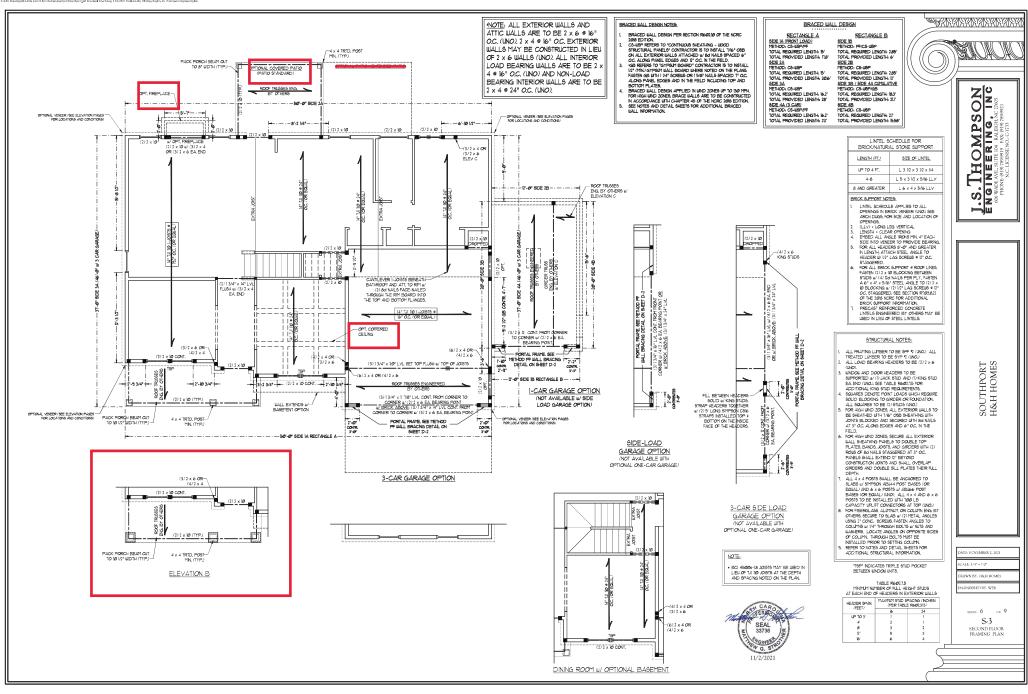

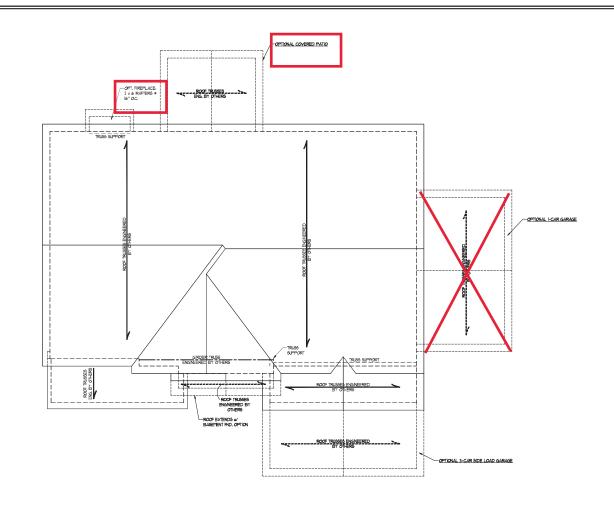

ELEVATIONS A & B



BRICK SUPPORT NOTE:

STRUCTURAL NOTES:

- STEACHEAL NOTES

 STEACHEAL NOTES

 STEACH AND LIMITED TO BE 7

 STEACH AND THE TO BE 67A-CE

 FOR EACH AND CO (TIP) J.

 STEAC TRAVE O CRE-TRAVED ON STEACH

 FOR EACH AND LIMITED TO BE 67A-CE

 F

SOUTHPORT H&H HOMES


DATE: NOVEMBER 2, 2021

RAWN BY: H&H HOMES


NUINEERED BY: WFB

яныт. 8 он 9 S-5a ROOF FRAMING PLAN




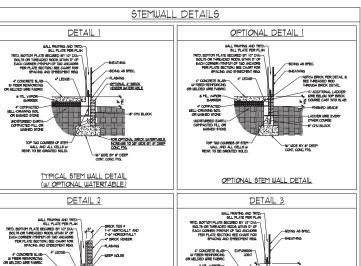



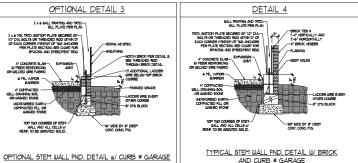

 715 0110 071002	
DETAIL 8	
NSIDE EDGE OF 12* ANCHOR ROD MAGONEY STEMBALL	
LADDER WIRE PER DETAIL	
BRICK MASONRY SOIS CO.	
STICK FRAMED WALL ABOVE	
NOTCH BRICK @ THREADED / ROD AND GROUT SOLID /	
THREADED ROD THROUGH BRICK MASONRY	

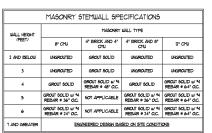

STRUCTURAL NOTES:

ANCHOR SPACING AND EMBEDMENT		
WIND ZONE	12Ø MPH	13/0 MPH
SPACING	6'-Ø" O.C.	4'-Ø" O.C.
EMBEDMENT	יי	5" INTO MASONRY 1" INTO CONCRETE

WIND SPEED MPH ULTIMATE DESIGN FOUNDATION DETAILS

NON CONTRACTOR

S OMPS ERING.

工口

S. TE

DATE: NOVEMBER 14, 2018

1301

20

D-1 FOUNDATION DETAILS



ATE: NOVEMBER 14, 2018


GINEERED BY: 18


D-2 BRACED WALL NOTES AND DETAILS AND PF DETAIL




- WILL BRACING DESIGNED IN ACCORDANCE WITH CHAPTER 6 OF THE 1008 NC RESIDENTIAL BUILDING CODE (NCRC.)
 TABLES AND FRANCES REFERNICED AND RINGTH CHAPTER 6 OF THE 1008 NCRC. FOR ADDITIONAL INFORMATION AS NEEDED.
 SEE HIS SEET FOR CREATED WILL LOCATIONS DITEISMONS, ROLD DOWN THE AND LOCATIONS REVIEW WITH THE REST WITH WALL LINE AND ANY SECOND WILL LOCATION BRACED WALL NOTES.
- ALL EXTERIOR WALLS ARE TO BE SHEATHED WITH CS-WSP IN ACCORDANCE WITH SECTION REGIZIOZ UNLESS NOTED

- A LESTEROR BULLS ARE TO BE SHARHED WITH G-MERN IN ACCORDINGE BITH SECTION RISKINDS NAMES NOTIFE TO SEE PLANTING BY A LESTEROR BOY THE NAME OF THE THE SHARP BY A LESTEROR BY A DIVISION SHARP BY A CORPORATION OF THE SHARP BY A LESTEROR BY A SHARP BY A SHARP BY A LESTEROR BY A LESTE

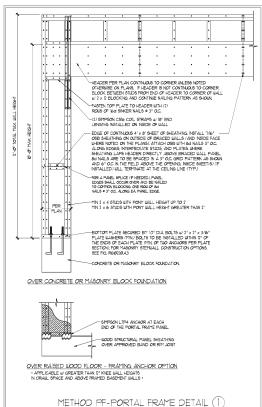


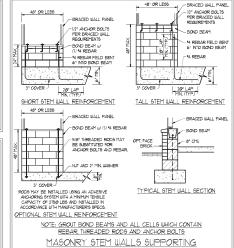

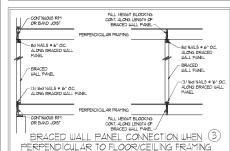


BRACED WALL PANELS (2)


PER FIGURE R602.10.4.3

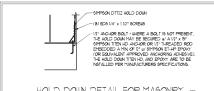



PER FIGURE R602.10.4.4(1)


HOLD DOWN DETAIL FOR MASONRY FOUNDATION OR MONOLITHIC SLAB · APPLICABLE ONLY WHERE SPECIFIED ON PLAN:

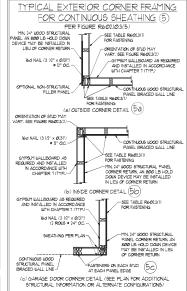

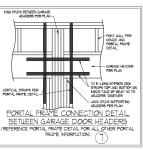

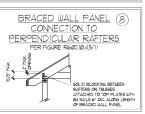

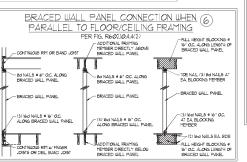

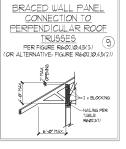

This sealed page is to be used in conjunction with a full plan set engineered by J.S. Thompson Engineering, Inc. only. Use of this individual sealed page within architectural pages or shop drawings by others is a punishable offense under N.C. Statute § 89C-23





GENERAL NOTES

- 1 ENGINEER'S SEAL APPLIES ONLY TO STRUCTURAL COMPONENTS INCLUDING ROOF RAFFERS HIPS VALLEYS RIGGES FLOORS HALLS BEAMS HEADERS, COLLINS, CANTILEVERS, OFFSET LOAD BEARNS WILLS, PERS, CHOPER SYSTEM AND FOOTNS. INSIGERS'S EAL DOES NOT CERTIFY DIMENSIONAL ACCURACY OF ARCHITECTURAL LAYOUT INCLUDING ROOF. ENGINEER'S EAL DOES NOT APPLY TO 1-JOIST OR FLOOR/ROOF TRUSS
- ALL CONSTRUCTION SHALL CONFORM TO THE LATEST REQUIREMENTS OF THE NORTH CAROLINA RESIDENTIAL CODE INDEX.) 20% EDITION, PLUS ALL LOCAL CODES AND REGULATIONS. THE STRUCTURAL ENGINEERS IN OUT REPONSIBLE FOR AND INLL NOT HAVE CONTROL OF, CONSTRUCTION PEANS, HETFOOS, ELCANOLISE SCIENCES OR PROCEDURES, OR SAFETY PRECAUTION AND PROCRAFTS OR CONSECTION WITH THE CONSTRUCTION. WORK, NOR WILL THE ENGINEER BE RESPONSIBLE FOR THE CONTRACTORS FAILURE TO CARRY OUT THE CONSTRUCTION WORK IN ACCORDANCE WITH THE CONTRACT DOCUMENTS
- 3. STRUCTURAL DESIGN BASED ON THE PROVISIONS OF THE NORC, 2018 EDITION (RGØ1.4 RGØ1.1)

DESIGN CRITERIA:	LIVE LOAD (PSF)	DEAD LOAD (PSF)	DEFLECTION (IN)
ATTIC WITH LIMITED STORAGE	20	lø	L/240 (L/360 w/ BRITTLE FINISHES)
ATTIC WITHOUT STORAGE	lø	lØ	L/36Ø
DECKS	40	iø	L/36Ø
EXTERIOR BALCONIES	40	IØ	L/36Ø
FIRE ESCAPES	40	10	L/36Ø
HANDRAILS/GUARDRAILS	200 LB OR 50 (PLF)	IØ	L/36Ø
PASSENGER VEHICLE GARAGE	50	iø	L/36Ø
ROOMS OTHER THAN SLEEPING ROOM	40	10	L/36Ø
SLEEPING ROOMS	30	iø	L/36Ø
STAIRS	40	10	L/36Ø
UND LOAD	(BASED ON TABLE R3012)	4) JUND ZONE AND EXPOSURE	
GROUND SNOW LOAD: Pg	2Ø (PSF)		

- I-JOIST SYSTEMS DESIGNED WITH 12 PSF DEAD LOAD AND DEFLECTION (IN) OF L/480
- 4. FOR 115 AND 130 MPH WIND ZONES, FOUNDATION ANCHORAGE 15 TO COMPLY WITH SECTION RADAGE OF THE NORG, 20'9 EDITION. FOR 150 MPH, IAO MPH, AND 150 MPH WIND ZONES, FOUNDATION ANCHORAGE 15 TO COMPLY WITH SECTION 4504 OF THE NORG, 20'9 EDITION.
- 5. ENERGY EFFICIENCY COMPLIANCE AND INSULATION VALUES OF THE BUILDING TO BE IN ACCORDANCE WITH CHAPTER II OF THE NORC. 2018 EDITION.

FOOTING AND FOUNDATION NOTES

- 1. FOUNDATION DEBIGN BASED ON A MINIMUM ALLOWABLE BEARING CAPACITY OF 2000 P6F. CONTACT GEOTECHNICAL ENGINEER IF BEARING CAPACITY IS NOT ACHEVED.
- PROPERLY DEMATER EXCAVATION PRIOR TO POURNIG CONCRETE WHEN BOTTOM OF CONCRETE SLAB IS AT OR BELOW WATER TABLE.
 APPELICABLE, 34 1 PEBER CONTROL JOINTS AND TO BE SAMED WITHIN 4 TO IT HOURS OF CONCRETE PRISHING AND WALL LOCATIONS -EERN THANGOL, DAUGH SHAFE RECESSION?
- 4. CONCRETE SHALL COPPORT TO SECTION RADGE OF THE NORC, 1908 EDITION. CONCRETE REINFORCING STELL TO BE ASTH ASS GRADE 60. BELDED LIREF PARRIED TO BE ASTH ASS. MARKINAL A MINIMAL CONCRETE CONFER ASOLID REINFORCING STELL OF 3° IN PROTINGS ASD 10° IN SUB-ASS. FOR PROTED CONCRETE BLUE, SOURCESTE CONFER REINFORCING STELL PARKED FORT THE MOSTE PARKED OF THE BLUEL SHALL NOT BE LESS THAN 314°. CONCRETE COPPER FOR REINFORCING STELL PLASMED FROM THE CUTSIDE FACE OF THE BLUEL. SHALL NOT BE LESS THAN 114° FOR SHAD SHOOT LARKER.
- MASONRY UNITS TO CONFORM TO ACE 530/ASCE 5/TMS 402. MORTAR SHALL CONFORM TO ASTM CITIE.
- 6. THE UNSUPPORTED HEIGHT OF MASONRY PIERS SHALL NOT EXCEED FOUR TIMES THEIR LEAST DIMENSION FOR CAPILLED HOLLOW CONCRETE MASONRY UNITS AND TEN TIMES THEIR LEAST DIMENSION FOR SOLD OR SOLID FILLED FIRED. FERSE MAY BE FILLED SOLID WITH CONCRETE OR TYPE IN OR S YOUTH, PIERS AND WALLS SHALL BE CAPPED WITH 8" OF S OLID MASONRY.
- THE CENTER OF EACH OF THE PIERS SHALL BEAR IN THE MIDDLE THIRD OF ITS RESPECTIVE FOOTING, EACH GIRDER SHALL BEAR IN THE MIDDLE THIRD OF THE PIERS.
- ALL COPERTE AID MASSIFF FORDATION ALLS LIFE OF BE CONTINCED IN ACCORDANCE WITH THE PROPRIOS OF SECTION AND IT HE LIVER, THE SECTION OF IN ACCORDANCE WITH ALT 38, ACL 333, NOTA 1984-A OR ACE BOUAGE INTO A OR 1, MASSIFF ROMATION UNLIL DATE TO BE REPORTED THE TILE OF BOUAGE INTO A OR ACCORDANCE THE TILE OF BOUAGE INTO A OR ACCORDANCE THE TILE OR ACCORDANCE THE TILE OF THE MASSIFF AND ALTON AND A OR ACCORDANCE AND A OR ACCORDANCE TO A OR ACCORDANCE AND ACCORDANCE AND A OR ACCORDANCE AND ACCORDANCE AND A OR ACCORDANCE AND A O

This sealed page is to be used in conjunction with a full plan set engineered by J.S. Thompson Engineering, Inc. only. Use of this individual sealed page within architectural pages or shop drawings by others is a punishable offense under N.C. Statute § 89C-23

FRAMING NOTES

- L. ALL FRAMING LIMPER 9-IALL BE 12 9FF MINIMUM (Fig. 875 PS) Fy : 375 PS) E : 16/00/2/2 PS) UNLESS NOTED OTHERUSE (UNC). ALL TREATED LUMBER SHALL BE 12 SYP MINMUM (Fb = 915 PS), Fv = 115 PS), E = 16000000 PS) UNLESS NOTED OTHERWISE (UNO
- 2. LATINATED VENEER LIMBER (LIV.) SHALL HAVE THE FOLLOUNG MINITUM PROFERITIES. Fo. 12600 PSI, Fo. 1265 PSI, E. 1. PROGOOD PSI, LATINATED STRAND LIMBER (SLJ.) SHALL HAVE THE FOLLOUNG MINITUM PROFERITIES fo. 1250 PSI, Fo. 1950000 PSI, PARALLEL STRAND LIMBER (PSIL) TO TO PSITH SHALL HAVE THE FOLLOUNG MINITUM PROFERITIES fo. 1250 PSI E. 1260000 PSI, PARALLEL STRAND LIMBER (PSIL) MORE THAN 17 DEPTH SHALL HAVE THE FOLLOUNG MINITUM PROFERITIES fo. 1200 PSI E. 120000000 PSI, INSTALL ALL CONNECTIONS PER MANUFACTURER'S SPECIFICATIONS.
- 3. STRUCTURAL STEEL SHALL CONFORM TO THE FOLLOWING ASTM SPECIFICATIONS

, A4.	W AND WI SHAFES!	MOTITI ADDA
В.	CHANNELS AND ANGLES:	ASTM A36
C.	PLATES AND BARS:	ASTM A36
D.	HOLLOW STRUCTURAL SECTIONS:	ASTM A500 GRADE B
E.	STEEL PIPE:	ASTM A53, GRADE B. TYPE E OR S

4. STEEL BEAMS SHALL BE SUPPORTED AT EACH END WITH A MINIMUM BEARING LENGTH OF 3 I/2" AND FULL FLANGE WIDTH (UNO), PROVIDE SOLID BEARNS FROM BEAM SUPPORT TO FOUNDATION, BEAMS SHALL BE ATTACHED AT THE BOTTOM FLANGE TO EACH SUPPORT AS FOLLOUS (UNO)

A, WOOD FRAMING (2) 12° DIA, x 4° LONG LAG SCREUS (2) 12° DIA, x 4° WEDGE ANCHORS (2) 12° DIA, x 4° LONG SIMPSON TITEN HD ANCHORS

LATERAL SUPPORT IS CONSIDERED ADEQUATE PROVIDING THE JOISTS ARE TOE NALED TO THE 5X NAILER ON TOP OF THE STEEL BEAM, AND THE 2x NATURE IS SECURED TO THE TOP OF THE STEEL BEAM w/ (2) ROUS OF SELF TAPPING SCREUS @ Vo" O.C. OR (2) ROUS OF I/2" DIAMETER BOLTS * I6* O.C. F 12* BOLTS ARE USED TO FASTEN THE NAILER. THE STEEL BEAM SHALL BE FABRICATED w/ (2) ROUS OF 9/16* DIAMETER HOLES & IS' OC.

- SQUARES DENOTE POINT LOADS WHICH REQUIRE SOULD BLOCKING TO GIRDER OR FOUNDATION, SHADED SQUARES DENOTE POINT LOADS FROM ABOVE WHICH REQUIRE SOULD BLOCKING TO SUPPORTING MEMBER BELOW.
- 6. ALL LOAD BEARING HEADERS TO CONFORM TO TABLE R602.1(1) AND R602.1(2) OF THE NORC, 2018 EDITION OR BE (2) 2 x 6 WITH (1) JACK AND (I) KING STUD EACH END (UNO), WHICHEVER IS GREATER ALL HEADERS TO BE SECURED TO EACH JACK STUD WITH (4) 8d NAILS, ALL BEAMS TO BE SUPPORTED WITH (2) STUDS AT EACH BEARING FOINT (UNO). INSTALL KING STUDS PER SECTION R6(02):15 OF THE NORTH CAROLINA RESIDENTIAL CODE 2018 EDITION
- 1. ALL BEAMS, HEADERS, OR GRODER TRUSSES PARALLEL TO WALL ARE TO BEAR RULLY ON (1) JACK OR (2) STUDS THINMTH OR THE NUMBER OF JACKS OR STUDS NOTES. ALL BEAMS OR GRODER TRUSSES FREEDOLGLAR TO WALL AND SUPPORTED BY (1) STUDS OR LESS ARE TO MAKE (1)? MAND MEANING MEANING AND, ALL BEAMS OR GRODER TRUSSES FREEDOCULAR TO WALL AND SUPPORTED BY TO WEET HAN (3) STUDS OR OTHER MOTED COUNTS, ARE TO BEAR RULLY ON SUPPORT DO YOUR TRUSS FREEDOM FOR BUTTER WALL DEPTH (NO.). BEAM BUDG THAT BUTT INTO ONE ANOTHER ARE TO EACH BEAR EQUAL LENGTHS (UNO).
- 8. FLITCH BEAMS SHALL BE BOLTED TOGETHER USING 101 DIAMETER BOLTS (ASTM A3@1) WITH WASHERS PLACED AT THREADED END OF BOLT. BOLTS SHALL BE SPACED AT 24" CENTERS (MAXIMUM), AND STAGGERED AT TOP AND BOTTOM OF BEAM (2" EDGE DISTANCE), WITH (2) BOLTS LOCATED AT 6" PROM EACH END (UNO
- ALL I-JOIST OR TRUSS LAYOUTS ARE TO BE IN COMPLIANCE WITH THE OVERALL DESIGN SPECFED ON THE PLANS. ALL DEVIATIONS ARE TO BE BROUGHT TO THE ATTENTION OF THE ENGINEER OF RECORD PRIOR TO INSTALLATION.
- 10. BRACED WALL PANELS SHALL BE CONSTRUCTED ACCORDING TO THE NORTH CAROLINA RESIDENTIAL CODE 2018 EDITION WALL BRACING CRITERIA THE AMOUNT, LENGTH, AND LOCATION OF BRACING SHALL COMPLY WITH ALL APPLICABLE TABLES IN SECTION R6/02/10.
- PROVIDE DOUBLE JOST UNDER ALL WALLS PARALLEL TO FLOOR JOSTS. PROVIDE SUPPORT UNDER ALL WALLS PARALLEL TO FLOOR 5 PER MANUFACTURER'S SPECIFICATIONS. INSTALL BLOCKING BETWEEN JOISTS OR TRUSSES FOR POINT LOAD SUPPORT FOR ALL POINT LOADS ALONG OFFSET LOAD LINES.
- FOR ALL HEADERS SUPPORTING BRICK VENEER THAT ARE LESS THAN 8"-0" IN LENGTH, REST A 6" x 4" x 5/6" STEEL ANGLE WITH 6" MINIMUM EMBEDMENT AT SIDES FOR BRICK SUPPORT (UNO). FOR ALL HEADERS 8'-8" AND GREATER IN LENGTH, BOLT A 6" x 4" x 5'/6" STEEL ANGLE TO HEADER WITH IVE LAG SCREUS AT 12' O.C. STAGGERED FOR BRICK SUPPORT. FOR ALL BRICK SUPPORT AT ROOF LINES, BOLT A 6" x 4" x 5/16" STEEL ANGLE TO (2) 2 x 10 BLOCKING INSTALLED W (4) 12d NAILS EA, PLY BETWEEN WALL STUDG WITH (2) PROUS OF 1/2" LAG SCREWS AT 12" O.C. STAGGERED AND IN ACCORDANCE WITH SECTION RTØ3.8.2.) OF THE NORC, 2018 EDITION
- 13. FOR STICK FRAMED ROOFS; CIRCLES DENOTE (3) 2 x 4 POSTS FOR ROOF MEMBER SUPPORT, HIP SPLICES ARE TO BE SPACED A MINIMUM OF SHOULD NOT SEE THAT THE ROUS OF 124 X × TUDITS FOR ROOF PETIERR SUPPORT, HIP SPLICES ARE TO BE SPACED A MINIMUM SHOP. FASTEN MEMBERS WITH THREE ROUS OF 12d NALES AT 16* O.C. FRAME DORMER WALLS ON TOM OF DOUBLE OR TRIMLE RAFFERS AS SHOULD KNOW.
- 14. FOR TRUSSED ROOFS: FRAME DORMER WALLS ON TOP OF 2 x 4 LADDER FRAMING AT 24" OC. BETWEEN ADJACENT ROOF TRUSSES. STICK FRAME OVER-FRAMED BOOF SECTIONS WITH 2 x 8 RIDGES, 2 x 6 RAFTERS AT 16" O.C., AND FLAT 2 x 10 VALLEYS (LNO.);
- 15. ALL 4 x 4 AND 6 x 6 POSTS TO BE INSTALLED WITH TWO LIB CAPACITY UPLIFT CONNECTORS TOP AND BOTTOM (UNO.) POSTS MAY BE SECURED USING ONE SIMPSON HE OR LITIST UPLET CONNECTOR FASTENED TO THE BAND AT THE BOTTOM AND THE BEAM AT THE TOP OF EACH POST. ONE IN SECTION OF SIMPSON CASE COLL STRANGING WITH (8) SEL HOS NALE AT EACH END MAY BE USED IN LIBU OF EACH MUST STRUP P DESIDED. FOR MASONIX OR CONCRETE PONDATION USE STRYON POST BASE.

WIND SPEED · 130 MPH ULTIMATE DESIGN WIN STANDARD STRUCTURAL NOTES MPH.

DATE: NOVEMBER 14, 2018

GINEERED BY: 157

S-0 STRUCTURAL NOTES

NO S S HOMPS S.Tr

20