### COLLEX458InventoryMarkedPlan

# SOUTHPORT

### SOUTHPORT REVISION LIST - STRUCTURAL:

- . COMBINED WILMINGTON AND WILMINGTON II PLANS. (2-18)
- ADDED BRICK OPTION ON SECOND FLOOR. (2-18)
- CALLED OUT SERIES/SPACING OF IJOISTS ON BASEMENT. (2-18)
- . 2018 NCRC UPDATE (6-19)
- 5 2019 SC ID C (2 15 20)
- 6. ADDED ELEVATION A.2 (BRICK WATERTABLE W/ SIDING ABOVE) & ELEVATION A.3 (STONE WATERTABLE W/ SIDING ABOVE). (2-15-20)


### SOUTHPORT REVISION LIST - ARCHITECTURAL:

### ALIGUST 01, 2021

- 1. CREATED ELEVATIONS TO BE IN STANDARDS WITH OTHER PLANS (SEE SHEETS A:1 THROUGH A:3.5)
- CHANGED COLUMNS ON ELEVATIONS TO STANDARD COLUMNS
- 3. CHANGED GARAGE DOORS TO REPRESENT STANDARD GARAGE DOOR FOR EACH ELEVATION
- 4 FIXED COVERED PORCH TO KEEP COLUMNS FROM OVERLAPPING EDGE OF CONCRETE
- 5. REMOVED GRIDS FROM TRANSOMS ABOVE FRONT DOOR
- 6. ADDED NOTE FOR GARAGE DOOR "GARAGE DOOR PER SPECIFICATIONS AND GLASS INSERT (TOP PANEL ONLY)"
- . MOVED ROOF PLANS TO SHEETS A-8 & A-8.1
- CREATED SLAB INTERFACE PLAN (SEE SHEET A-4 THROUGH A-4.2)
- 9. MOVED ALL OPTIONS OFF BASE PLAN AND PLACED ON SEPARATE SHEET
- 10. ADDED NOTE FOR FLUSH COUNTERTOP ON ISLAND
- 11. CHANGED PATIO SIZE TO STANDARD 12'X10'
- 12. ADDED OPTIONAL GAS LINE
- CHANGED KITCHEN LAYOUT
- ADDED 2ND HOSE BIB
- 15. CALLED OUT '45' WALL WITH CAP" AS STANDARD
- 16. CHANGED ALL EXTERIOR WALLS FROM 2X6 TO 2X4 EXCEPT WHERE SHADED
- ADDED NOTE 'OPT. REF.'
- REMOVED NUMBERS ON STAIRS
- ADDED NOTE "OPT. W/D"
- 20. ADDED NOTE "WASHER ALWAYS TO BE LOCATED TO THE LEFT OF DRYER
- VERIFIED VENTILATION AND LIGHT REQUIREMENTS AT OWNER'S BEDROOM MEETS CODE (11-01-20)
- SQUARE FOOTAGES ARE UPDATED AND CHANGED DUE TO MOVEMENT OF WALLS FROM 2X6 TO 2X, TO KEEP JOOS IN ROOMS, EXTERIOR WALL MOVED MEANING ROOF LINES HAVE CHANGED
- 23. SQUARE FOOTAGE OF COVERED PORCH CHANGED DUE TO KEEPING COLUMNS FROM OVERLAPPING CONCRETE EDGE
- 24. CREATED PARTIAL PLANS FOR B & C ELEVATIONS (FLOOR, SLAB, & ELECTRICAL)
- 25. REMOVED ALL WALL OUTLETS
- 26. REMOVED ALL PHONE OUTLETS
- 27. REMOVED ALL TV OUTLETS
- 28. PLACED STANDARD 3 BULB LIGHT IN KITCHEN
- VERIFIED COACH LIGHT LOCATIONS (SEE ELEVS. FOR DIMS.)
- 0. PLACED DASHED FANS WHERE APPLICABLE WITH NOTE "STD. LIGHT, OPT. FAN/LT PREWIRE"
- 31. UPDATED ELECTRICAL KEY
- 32. VERIFIED CO2 DETECTOR LOCATIONS
- SHOWED PENDANT LIGHTS AS OPTIONAL
- 34. SHOWED CAN LIGHTS IN KITCHEN AND FAMILY ROOM AS 'OPTIONAL CAN LIGHTS'
- 35. PLACED OPTIONAL FLOOD LIGHTS
- 36. PLACED OPTIONAL FLOOR OUTLET IN FAMILY ROOM
- 37. PLACED CALCULATIONS FOR SOFFIT AND RIDGE VENT REQUIREMENTS
- 8. UPDATED STAIR LAYOUT TO KEEP MAIN WALL AT KITCHEN FROM MOVING WHEN OPTIONAL BASEMENT SELECTED.





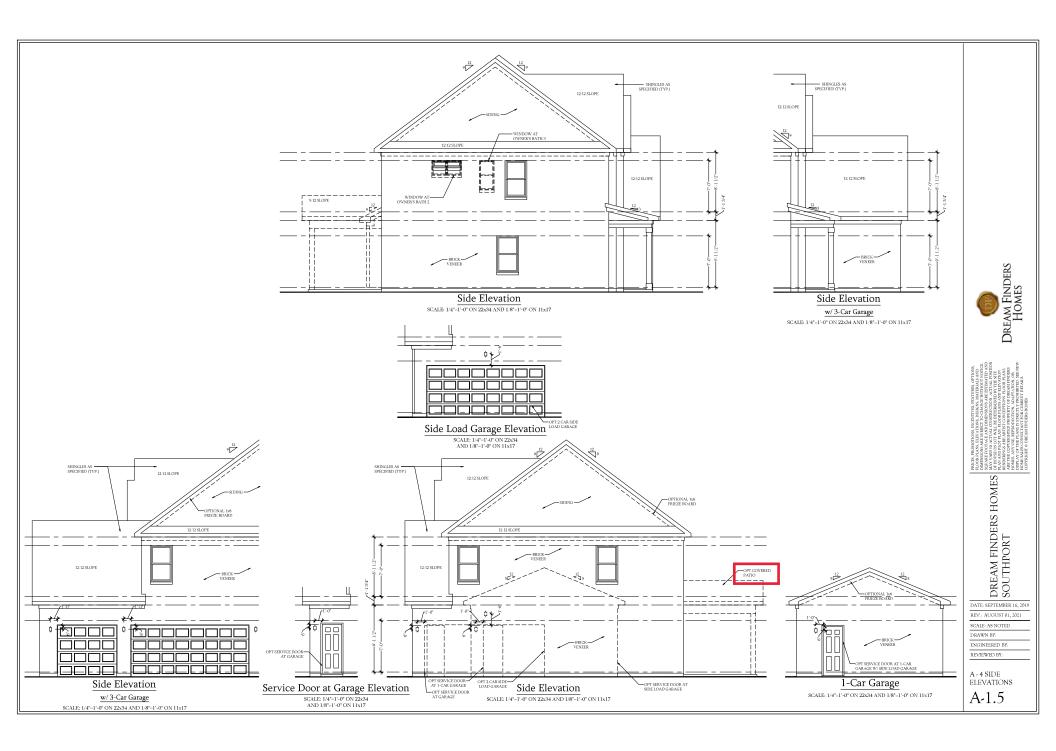



DREAM FINDERS HOMES SOUTHPORT


DATE: SEPTEMBER 16, 2019 REV:: AUGUST 01, 2021


SCALE: 1/4"-1'0" DRAWN BY:


ENGINEERED BY:


SLAB INTERFACE PLAN

A-4

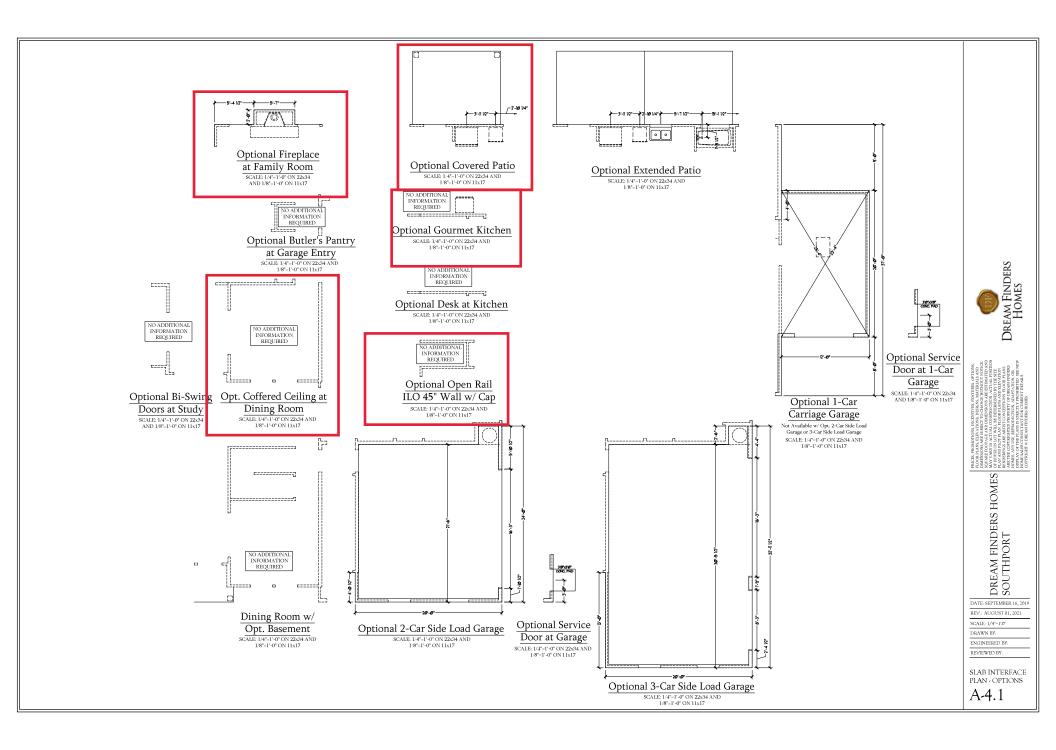

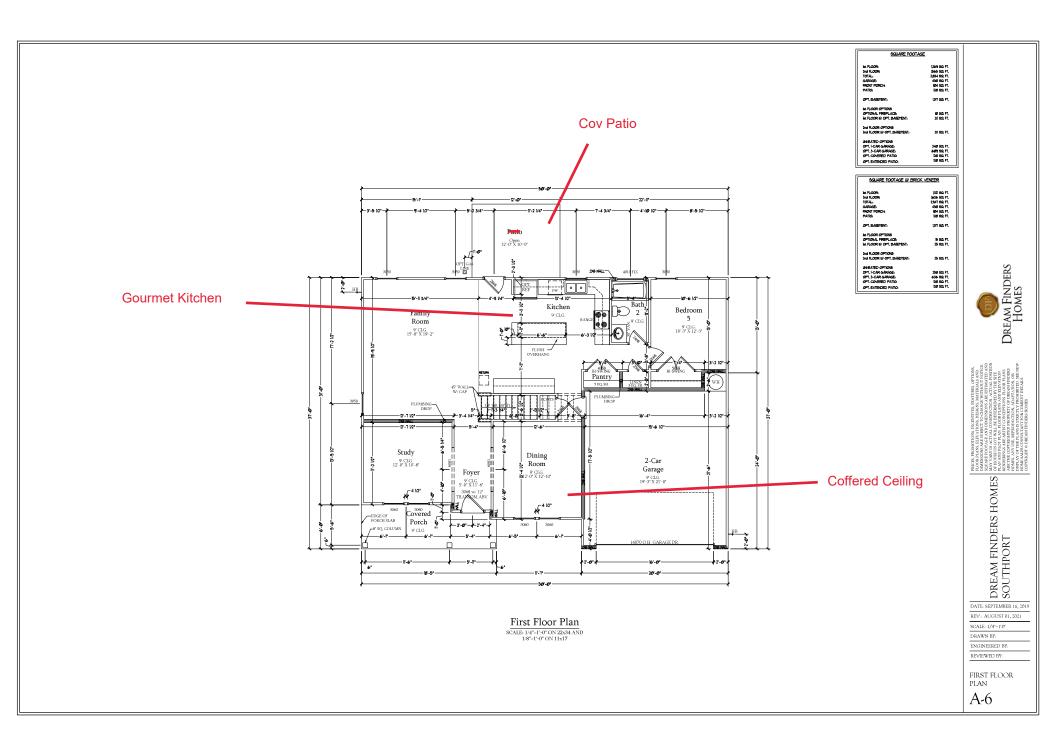

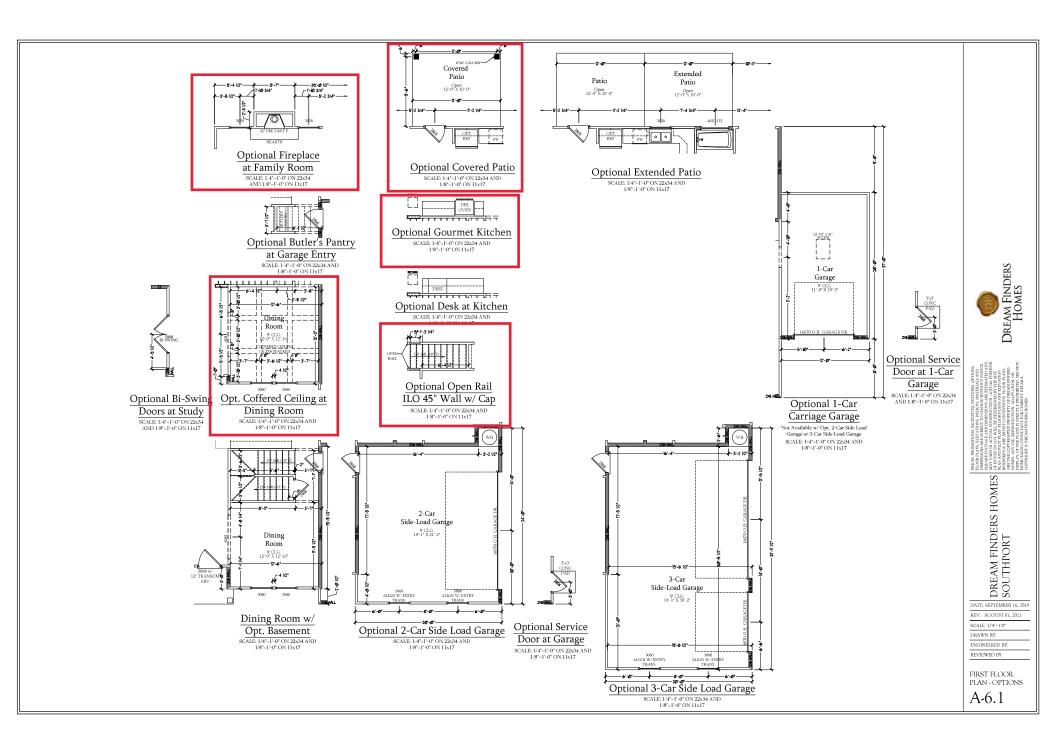

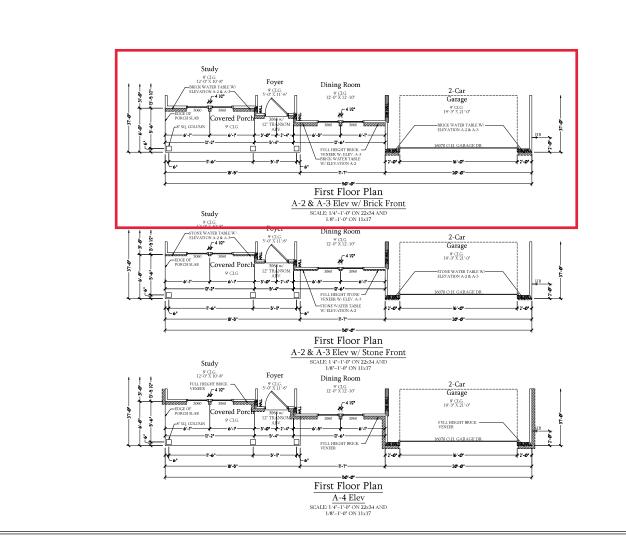



HIGHST, MORNON, MENTANE TRAFFILES, OFFORK HOUSE INCOME, MANIES, OFFORK HAVINGS, IRRINAS, AND MANIES, A

DREAM FINDERS HOMES
SOUTHPORT

DATE: SEPTEMBER 16, 2019 REV.: AUGUST 01, 2021

SCALE: 1/4"-1'0"


DRAWN BY:

ENGINEERED BY:

REVIEWED BY:

A ELEVATION FIRST FLOOR PARTIAL PLANS

A-6.2

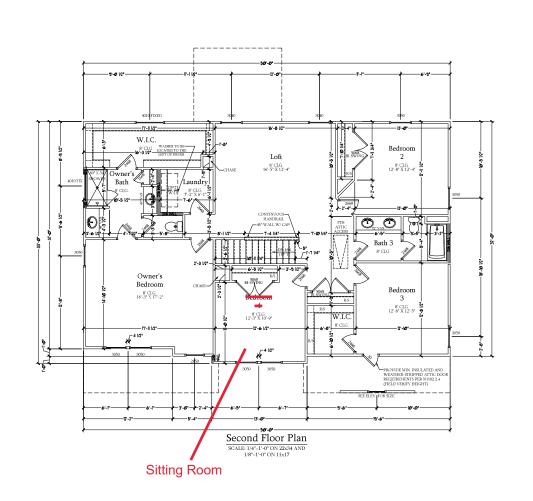



INCOR MACKS IRACATORS NATIONALS OF THOSE ACTORS HANDS ACTORS ACTO

DREAM FINDERS HOMES SOUTHPORT

DATE: SEPTEMBER 16, 2019 REV:: AUGUST 01, 2021


REV.: AUGUST 01, 20 SCALE: 1/4"-1'0"

DRAWN BY: ENGINEERED BY:

REVIEWED BY:

SECOND FLOOR PLAN

A-7

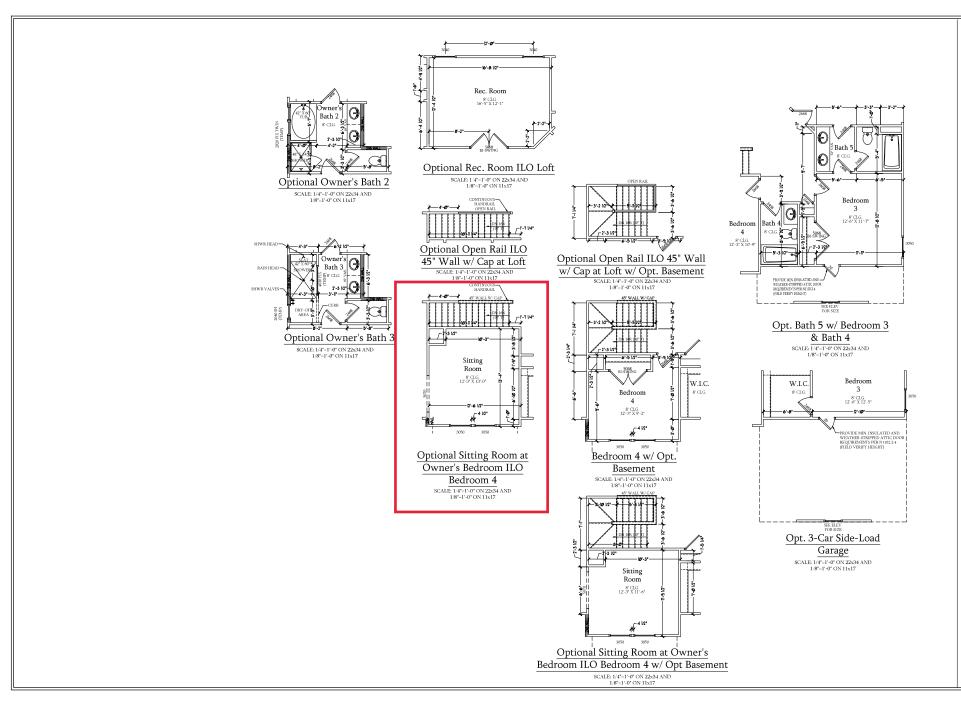



NIS ARE MINISTORY CONTROL WITHOUT FOUND OF THE STATE OF T

DREAM FINDERS HOMES
SOUTHPORT
REAL RETURN REAL RETURN REAL RETURN RETURN

DATE: SEPTEMBER 16, 2019 REV.: AUGUST 01, 2021


REV.: AUGUST 01, 202 SCALE: 1/4"-1'0"

DRAWN BY:

ENGINEERED BY: REVIEWED BY:

SECOND FLOOR PLAN - OPTIONS

A-7.1

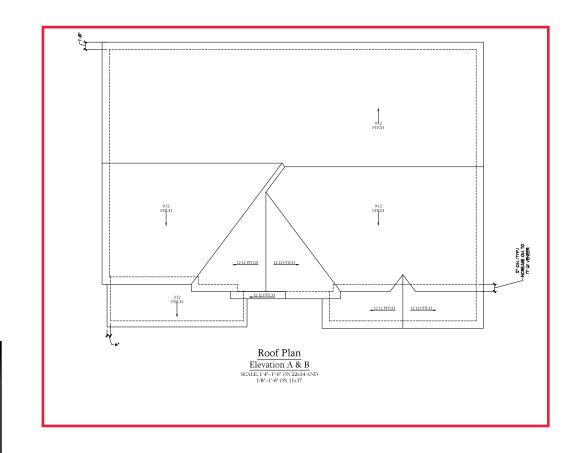



ES DI PRESENDA MONTRONE DE RESPONSA MENTROS ANON MONTROS ANON MONTROS

DREAM FINDERS HOMES RANDS SOUTHPORT

DATE: SEPTEMBER 16, 2019

REV.: AUGUST 01, 2021


SCALE: 1/4"-1'0"


DRAWN BY:

ENGINEERED BY: REVIEWED BY:

ELEVATIONS A & B ROOF PLAN

A-8

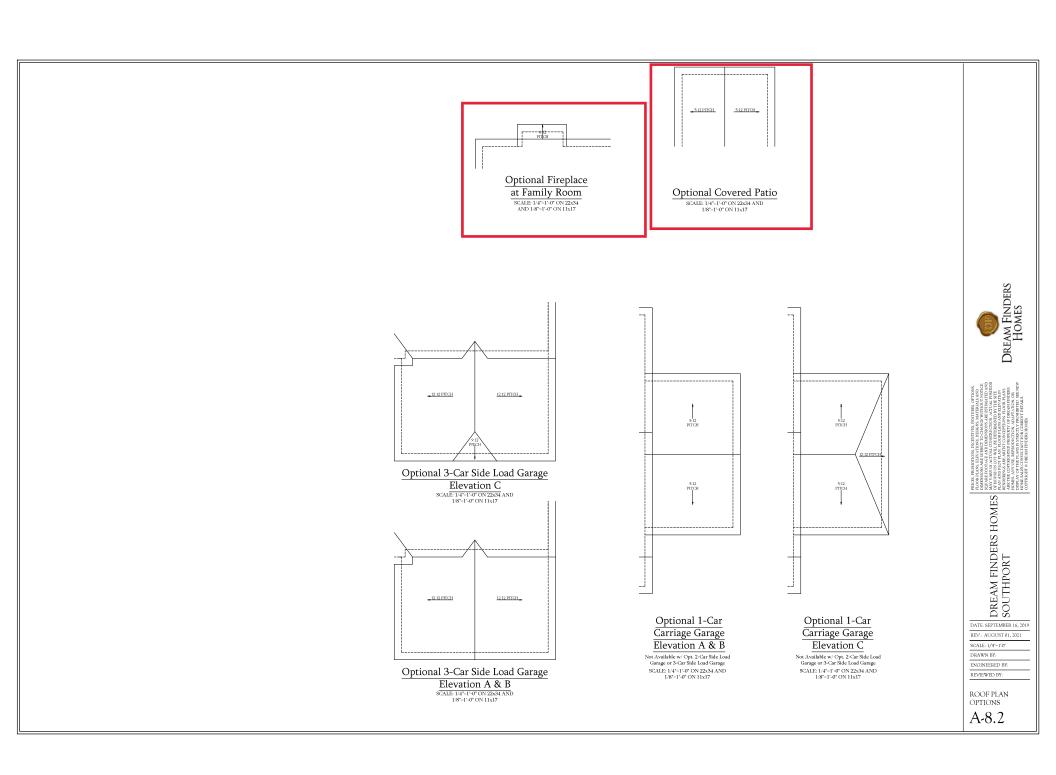

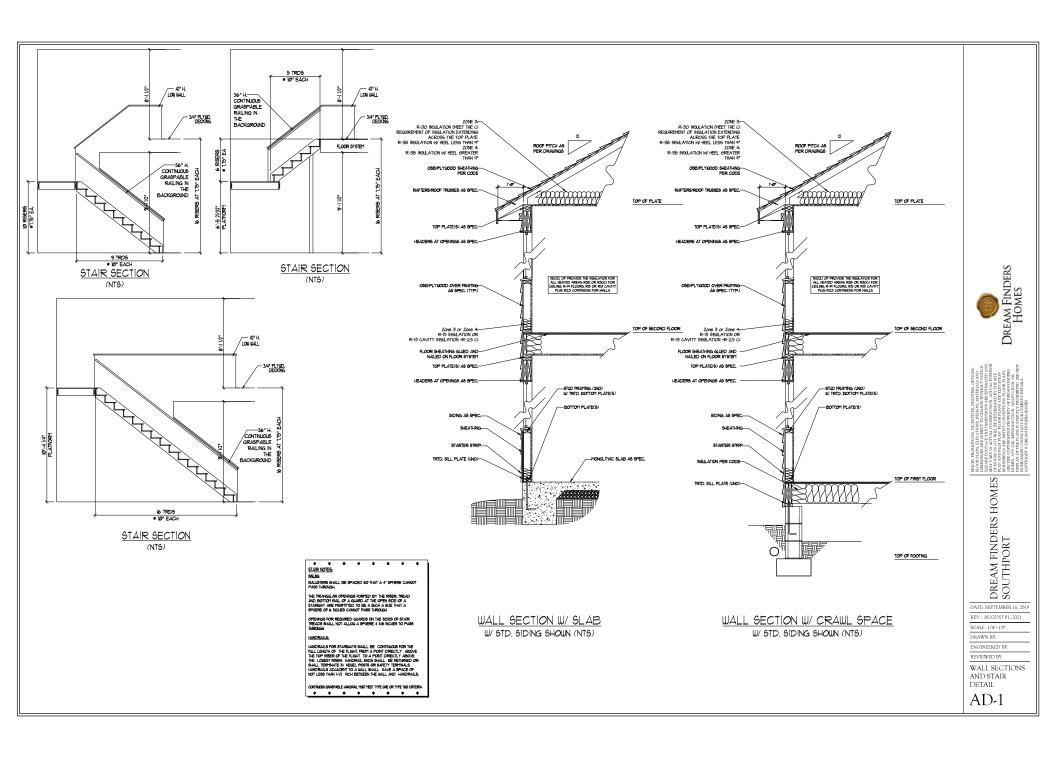

120V BASEBOARD OUTLET 4-PLEX

FLOOR MOUNTED 120V

FLOOR MOUNTED 120V GFI

220V OUTLET

220V DEDICATED CIRCUIT

SPECIAL PURPOSE (240 V, ETC.)

WALL MOUNT LIGHT

CEILING MOUNT LIGHT

PENDANT LIGHT

Ø EVERALL LIGHT

FLUORESCENT LIGHT

UNDERCABINET LIGHT
FLOOD LIGHT

SWITCH

3-WAY SWITCH

4-WAY SWITCH

DIMMER SWITCH

TV CONNECTION

SPEAKER

COMBO SMOKE/ CARBON MONOXIDE DETECTOR

110 V SMOKE DETECTOR



### ELECTRICAL NOTES:

PROVIDE AND INSTALL GROUND FAULT CIRCUIT-INTERRUPTERS (G.F.L.) AS INDICATED ON PLANS OR AS ITEM NO. 4 AND 5 BELOW INDICATES.

UNLESS OTHERWISE INDICATED, INSTALL
SWITCHES AND RECEPTACLES AT THE
FOLLOWING HEIGHTS ABOVE FINISHED FLOORSWITCHES ... 42\*
OUTLETS ... 14\*
COUNTY LEEPHONE ... 14\* (UNLESS ABV

COUNTERTOP)
TELEVISION...14°

ALL SMOKE DETECTORS SHALL BE HARDWIRED INTO AN ELECTRICAL POWER SOURCE AND SHALL BE EQUIPPED WITH A MONITORED BATTERY BACKUP PROVIDE AND INSTALL LOCALLY CERTIFIED SMOKE DETECTORS.


ALL 15A AND 20A RECEPTACLES IN SLEEPING ROOMS, FAMILY ROOMS, DINING ROOMS, LIVING ROOMS, DINING ROOMS, LIVING ROOMS, LIVING SECOMS, PARICES, LIBRARIES, DENS, SUNROOMS, RECREATION ROOMS, CLOSETS, HALLWAYS, AND SIMILAR AREAS WILL REQUIRE A GOMBINATION TYPE AF CL. DEVICE AND TAMPER-PROOF RECEPTACLES.

ALL 15A AND 20A 120V RECEPTACLES LOCATED IN THE GARAGE AND UTILITY ROOMS SHALL BE G.F.C.I. PROTECTED (G.F.I).

IT IS THE RESPONSIBILITY OF THE LICENSED ELECTRICIAN TO ENSURE THAT ALL ELECTRICAL WORK IS IN FULL COMPILANCE WITH ALL APPLICABLE LOCAL STANDARDS, CODES, AND ORDINANCES.

EVERY BUILDING HAVING A FOSSIL-FUEL-BURNING HEATER OR APPLIANCE, FIREPLACE, OR AN ATTACHED EARAGE SHALL HAVE AN OPERATIONAL CARBON MONOXIDE DETECTOR INSTALLED WITHIN 16 FEET OF EACH ROOM USED FOR SLEEPING TURPOSES.

ALARAS SHALL RECEIVE THER PRIMARY POWER FROM THE BULLDING WIRING WHEN SUCH FROM THE BULLDING WIRING WHEN SUCH SHALL BULLDING WIRING WHEN SUCH SHALL BULLDING WIRING WHEN SUCH SHALL BULLDING WIRING WI

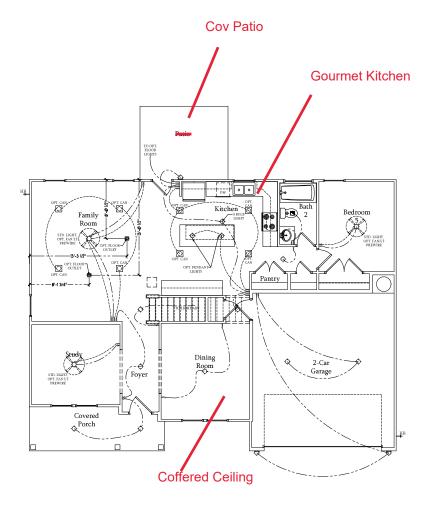

First Floor Plan SCALE: 1/4"=1'-0" ON 22x34 AND 1/8"=1'-0" ON 11x17



HORST MOMENTON, MEDICAN ENTINGS, OTTON THOOR LACK ILLY ALTON INSING IN MUTRIALS AND NUMBERS OF SERVICE TO ACCOMPANIENT STORY NUMBERS OF SERVICE TO ACCOMPANIENT STORY OF GROON OF THE REPORT ACCOMPANIENT STORY OF GROON OF THE REPORT STORY ACCOMPANIENT STORY OF THE SERVICE OF THE STORY ACCOMPANIENT STORY ACCOMPANIENT STORY ACCOMPANIENT STORY ACCOMPANIENT STORY ACCOMPANIENT STORY ACCORDING TO THE ACCOMPANIENT STORY ACCOMPANIENT STORY ACCOUNTS AND ACCOMPANIENT STORY ACCOUNTS AND ACCOUNT ACCOUNTS AND ACCOUNTS AND

DREAM FINDERS HOMES SOUTHPORT


DATE: SEPTEMBER 16, 2019 REV.: AUGUST 01, 2021

SCALE: 1/4"-1'-0"

DRAWN BY: ENGINEERED BY-REVIEWED BY:

FIRST FLOOR ELECTRICAL

PLAN E-1

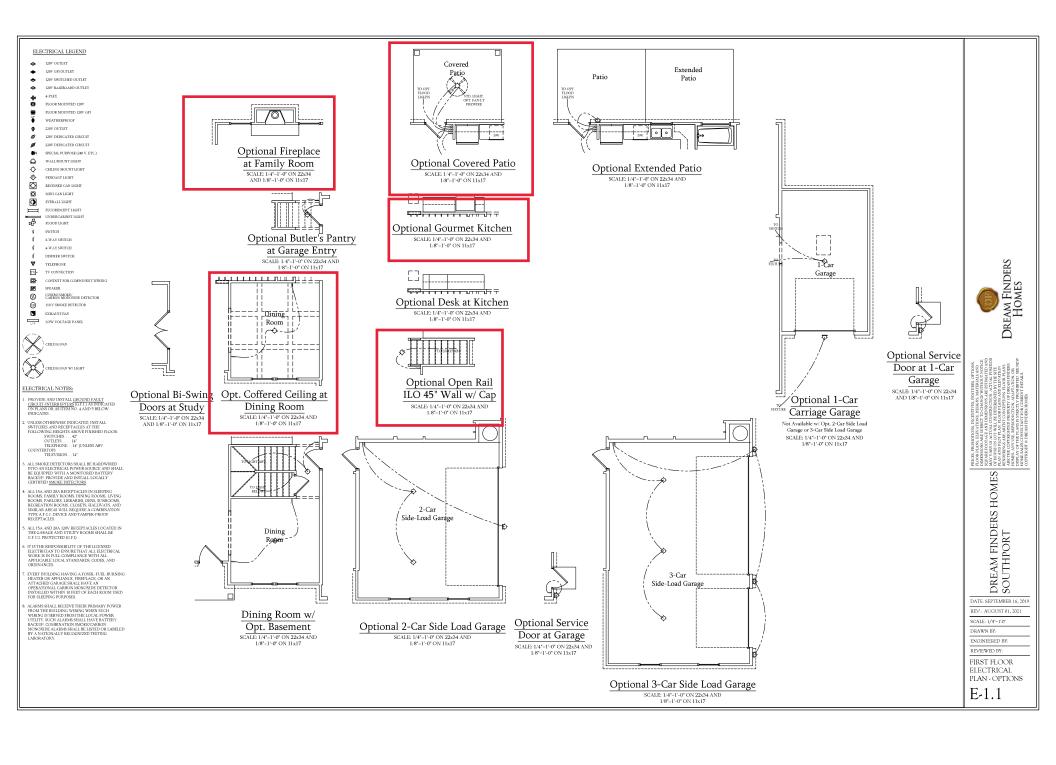

ALL SMOKE DETECTORS SHALL BE HARDWIRED INTO AN ELECTRICAL POWER SOURCE AND SHALL BE EQUIPPED WITH A MONITORED BATTERY BACKUP PROVIDE AND INSTALL LOCALLY CERTIFIED SMOKE DETECTORS.


ALL 15A AND 20A RECEPTACLES IN SLEEPING ROOMS, PAMILY ROOMS, DINING ROOMS, LIVING ROOMS, DINING ROOMS, LIVING ROOMS, LIVING ROOMS, CLOSETS, HALLWAYS, AND SIMILAR AREAS WILL REQUIRE A COMBINATION TYPE AF GL DEVICE AND TAMPER-PROOF RECEPTACLES.

ALL 15A AND 20A 120V RECEPTACLES LOCATED IN THE GARAGE AND UTILITY ROOMS SHALL BE G.F.C.I. PROTECTED (G.F.I).

IT IS THE RESPONSIBILITY OF THE LICENSED ELECTRICIAN TO ENSURE THAT ALL ELECTRICAL WORK IS IN FULL COMPILANCE WITH ALL APPLICABLE LOCAL STANDARDS, CODES, AND ORDINANCES.

EVERY BUILDING HAVING A FOSSIL-FUEL-BURNING HEATER OR APPLIANCE, FIREPLACE OR AN ATTACHED CARAGE SHALL HAVE AN OPERATIONAL CARBON MONOXIDE DETECTOR INSTALLED WITHIN 10 FEET OF EACH ROOM USED FOR SLEEPING PURPOSES.

ALARMS SHALL RECEIVE THEIR PRIMARY POWER FROM THE BUILDING WIRING WHEN SUCH WIRING SERVICE FROM THE LOCAL POWER WIRING SERVICE FROM THE LOCAL POWER OF THE LOCAL POWER SERVICE FROM THE LOCAL PROPERTY OF THE THE LOCAL POWER SERVICE FROM THE LOCAL PO

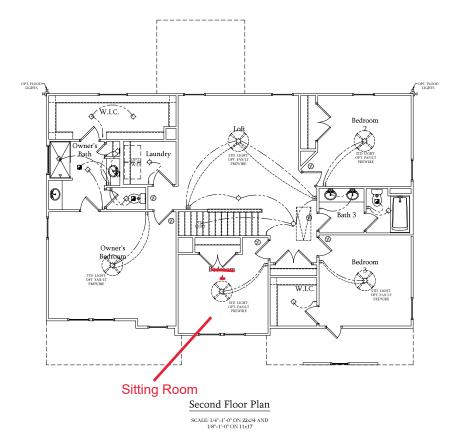

Dream Finders Homes

IN PRESENT MEMORY SENDENCES REFUTERS, COTONS
TO CORE LANGE IN A VIEW RESENTANCE OF THE SENDENCES AND T

DREAM FINDERS HOMES SOUTHPORT

DATE: SEPTEMBER 16, 2019

REV.: AUGUST 01, 2021

SCALE: 1/4"-1'-0" DRAWN BY:

ENGINEERED BY-REVIEWED BY:

SECOND FLOOR ELECTRICAL PLAN

E-2

4-PLEX

FLOOR MOUNTED 1207

FLOOR MOUNTED 128V GFI

220V OUTLET

SPECIAL PURPOSE (240 V, ETC.)

WALL MOUNT LIGHT

CEILING MOUNT LIGHT

PENDANT LIGHT

Ø **⊙** 

EVERALL LIGHT

FLUORESCENT LIGHT  $\equiv$ 

亞 UNDERCABINET LIGHT FLOOD LIGHT

SWITCH

3-WAY SWITCH 4-WAY SWITCH

DIMMER SWITCH

CONDUIT FOR COMP

₽-SPEAKER

Ø COMBO SMOKE/ CARBON MONOXIDE DETECTOR

110 V SMOKE DETECTOR

EXHAUST FAN



### ELECTRICAL NOTES:

PROVIDE AND INSTALL GROUND FAULT GROUNT-INTERRUPTERS (G.F.1) AS INDICATED ON PLANS OR AS ITEM NO. 4 AND 5 BELOW INDICATES.

UNLESS OTHERWISE INDICATED, INSTALL
SWITCHES AND RECEPT ACLES AT THE
FOLLOWING HEIGHTS ABOVE FINISHED FLOORSVITCHES ... 42
OUTLETS ... 14
TELEPHONE ... 14 (UNLESS ABV

COUNTERTOP) TELEVISION...14"

ALL SMOKE DETECTORS SHALL BE HARDWIRED INTO AN ELECTRICAL POWER SOURCE AND SHALL BE DQUIPPED WITH A MONITORED BATTERY BACKUP PROVIDE AND INSTALL LOCALLY CERTIFIED SMOKE DETECTORS.

ALL 15A AND 20A RECEPTACLES IN SLEEPING ROOMS, FAMILY ROOMS, DINING ROOMS, LIVING ROOMS, DINING ROOMS, LIVING ROOMS, DENS, SUNROOMS, RECREATION ROOMS, CLOSETS, HALLWAYS, AND SIMILAR RAEAS WILL REQUIRE A GOMBINATION TYPE A F.C.I. DEVICE AND TAMPER-PROOF RECEPTACLES.

G.F.C.I. PROTECTED (G.F.I).

IT IS THE RESPONSIBILITY OF THE LICENSED ELECTRICIAN TO ENSURE THAT ALL ELECTRICAL WORK IS IN FULL COMPLIANCE WITH ALL APPLICABLE LOCAL STANDARDS, CODES, AND ORDINANCES.

EVERY BUILDING HAVING A FOSSIL-FUEL-BURNING HEATER OR APPLIANCE, FIREPLACE, OR AN ATTACHED CARAGE SHALL HAVE AN OPERATIONAL CARBON MONOXIDE DETECTOR INSTALLED WITHIN 16 FEET OF EACH ROOM USED FOR SLEEPING TURPOSES.


ALARMS SHALL RECIVE THEIR PRIMARY POWER FROM THE BUILDING WIENNG WHEN SUCH WIRING IS SEVED PROMTHE LOCAL POWER UTILITY. SUCH ALARMS SHALL HAVE BATTERY BACKUP, DOMINATION SMOKEABEON MOXIMIE ALARMS SHALL BE LISTED OR LABELED BY A NATIONALLY RECOUNTED TESTING LABORATORY



1/8"=1'-0" ON 11x17

Optional Owner's Bath 3

SCALE: 1/4"=1'-0" ON 22x34 AND 1/8"=1'-0" ON 11x17

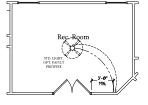

Optional Rec. Room ILO Loft

SCALE: 1/4"=1'-0" ON 22x34 AND 1/8"=1'-0" ON 11x17








Optional Sitting Room at Owner's Bedroom ILO

> Bedroom 4 SCALE: 1/4"=1"-0" ON 22x34 AND 1/8"-1"-0" ON 11x17




w/ Cap at Loft w/ Opt. Basement

SCALE: 1/4"=1'-0" ON 22x34 AND 1/8"=1'-0" ON 11x17

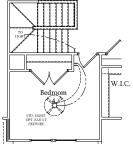


Bedroom 4 w/ Opt. Basement

SCALE: 1/4"=1"-0" ON 22x34 AND 1/8"=1'-0" ON 11x17

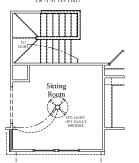


Optional Sitting Room at Owner's Bedroom ILO Bedroom 4 w/ Opt Basement

SCALE: 1/4"=1'-0" ON 22x34 AND 1/8"=1'-0" ON 11x17

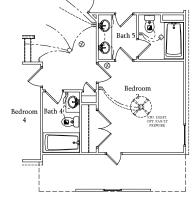

Opt. Bath 5 w/ Bedroom 3 & Bath 4

SCALE: 1/4"=1'-0" ON 22x34 AND 1/8"=1'-0" ON 11x17

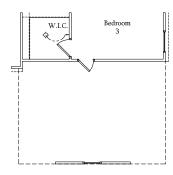

Opt. 3-Car Side-Load Garage SCALE: 1/4"=1'-0" ON 22x34 AND 1/8"=1'-0" ON 11x17

SECOND FLOOR ELECTRICAL

Dream Finders Homes

PRICES, PLOOR F DIMENS SQUARE MAY VA OF HOU PLAN AN RENDER ARE THI HOMES, DISPLAY HOMES, DREAM FINDERS HOMES SOUTHPORT


DATE: SEPTEMBER 16, 2019


REV.: AUGUST 01, 2021 SCALE: 1/4"-1'-0"

DRAWN BY: ENGINEERED BY: REVIEWED BY:

PLAN - OPTIONS

E-2.1

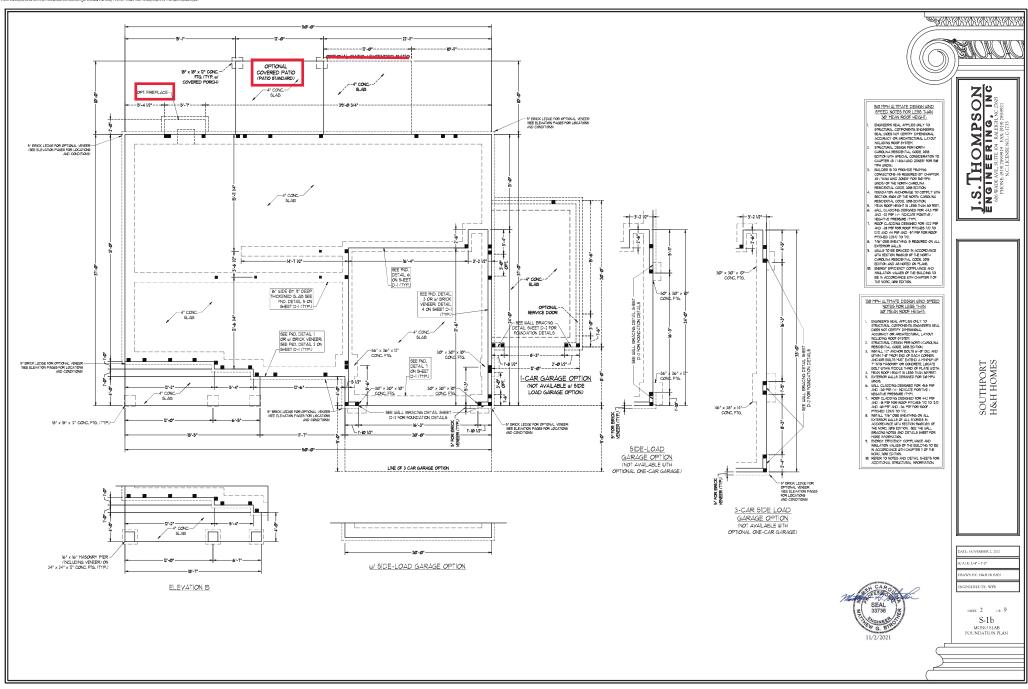

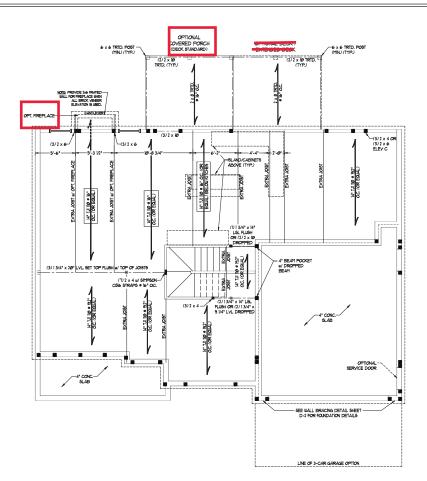

LINTEL SCHEDULE FOR BRICKNATURAL STONE SUPPORT	
LENGTH (FT.)	SIZE OF LINTEL
UP TO 4 FT.	L 3 1/2 x 3 1/2 x 1/4
4-8	L 5 x 3 1/2 x 5/16 LLV
8 AND GREATER	L 6 x 4 x 5/16 LLV

### BRICK SUPPORT NOTES:

LINTEL SCHEDULE APPLIES TO ALL
OPENINGS IN BRICK VENEER (INO), SEE
ARCH DUGS, FOR SIZE AND LOCATION OF

- ARCH DIBER TON SEE ME COPENICAL

  (LLV) = LONG LEE VERTICAL

  ENGTH = CLEAR OPENICA

  EYERD ALL ARCLE ROAD MA \*\* EACH

  SOLE NO MERCER O PROVIDE EX-RING.

  SOLE NO MERCER O PROVIDE EX-RING.

  N. ENGLE OF MERCER OF MERCER

  N. LEIGHT, ATTACH STEEL ANCLE TO

  READER WIT VIA & SCREIGS = 17 O.C.

  STAGGERED.

  STAGGERE
- HEADER WITH LAS DOCUMEN & TO FOR.

  PARKET WITH THE STATE OF THE STATE

### NOTE:

BCI 45006-LB JOISTS MAY BE USED IN LIEU OF TJI IIØ JOISTS AT THE DEPTH AND SPACING NOTED ON THE PLAN.

- RACED MALL DEBON SOTES

  BRACED WALL DEBON FRE SECTION REGULD OF THE NCRC
  308 EDITION.

  108 EDITION.

  109 EDITION.

  109 EDITION.

  109 EDITION.

  109 EDITION.

  100 EDITION.

### NOTE:

- 1 FER RECTION REGULAND OF THE 10/9 NORC, THE AYOUNT OF BRACKS REQUIRED ON THE BUILK OUT BASEFISH' BUILLS BUCKEDS TO AYOUNT OF BRACKS ON THE BUILL ADOVE THE THE AYOUNT OF THE STATE OF THE THE AYOUNT OF THE SHEATH ALL DETRICKS WILLIAS BUILT IN'S 'OSB SHEATHING ATTACHED BUTH BO NAILS AT 6' OC. 4LONG PANEL BOXES AND 0' OC. IN THE FELD.
- - ALL RRAYNS LIPBER TO BE 9 SPF (MO). ALL
    TREATISE LIPBER TO BE 9 SPF (MO). ALL
    TREATISE LIPBER TO BE 9 SPF (MO).
    THE ALL METHER MOTED ON THE PLANS.
    LINDOU AND DOOR HADDERS TO BE UPPORTED W/ 10
    JACK SIDD AND (MO) SIDD EA BY (MO). SEE
    TAKES BROOM FOR ADDITIONAL HAS SIDD
    TAKES BROOM SIDE OF ADDITIONAL HAD SIDD
    SOURCES DEBOTE POINT LADS SHALD REQUIRE SOLD
    BLOCKNET TO BROOK OR FORWERD SHEPO (MO)
    UNSPECTED FIT, LOADS ALONG FRATED WALLS W/ (2)
    SIDDS (MO).
  - STUDS (UNO)

- STUDS (NO.)

  STUDS (NO.)

  STEP SLAFFON FRANCH FRADERS TO BE (3) 2 × 10 (NO.)

  STEP SLAFFON FRADERS TO BE (3) 2 × 10 (NO.)

  STEP SLAFFON FRADERS TO EXPENDING TO 2 × 6 × 10 ° CC. CULL

  ALL LOAD BEARNIN INTERCRE MULLS TO BE 2 × 4 × 0 ° CC. (NO.)

  SON RIGH WIND FORDERS, ALL EXTERNOR MULLS TO BE SEATHING BEARNING TO BE SEATHING BEARNING TO STEP SEATHING BEARNING FRADERS AND OF CO. IN THE FIRST TO STEP SEATHING PRINTS TO FORDER SLAFFON FRADERS SEATHING PRINTS TO STEP SEATHING PRINTS TO DOUBLE TO PLATE BANGE, JOSTS, AND GROTERS WITH (1) ROUGH FOR HAIR BANGE, JOSTS, AND GROTERS WITH (1) ROUGH FOR HAIR BANGE, JOSTS, AND GROTERS WITH (1) ROUGH FOR HAIR BANGE, JOSTS, AND GROTERS WITH (1) ROUGH FOR HAIR BANGE, JOSTS, AND GROTERS WITH (2) ROUGH FOR HAIR BANGE, JOSTS, AND GROTERS WITH (2) ROUGH FOR HAIR BANGE, JOSTS, AND GROTERS WITH (2) ROUGH FOR HAIR BANGE, JOSTS, AND GROTERS WITH FARTH FROM THE PRINTS WITH GROTE SAME FOR THE PRINTS WITH FRADERS WITH THE PRINTS WITH THE P

TABLE R602.15
MINIMUM NUMBER OF RULL HEIGHT STUDS
AT EACH END OF HEADERS IN EXTERIOR WALLS

HEADER SPAN	MAXIMUM STUD SPACING (INCHES) (PER TABLE R6023/5)		
112217	16	24	
UP 10 3'	- 1	1	
4'	2	1	
8'	3	2	
12'	5	3	
161	6	4	





### STRUCTURAL NOTES:

- ALL LOAD BEARING HEADERS TO BE (3) 2 x 10 (UNO.)

SON LINCZIGOS I.S. THOMPS ENGINEERING,


SOUTHPORT H&H HOMES


DATE: NOVEMBER 2, 2021

NGINEERED BY: WFB


S-2 FIRST FLOOR FRAMING PLAN



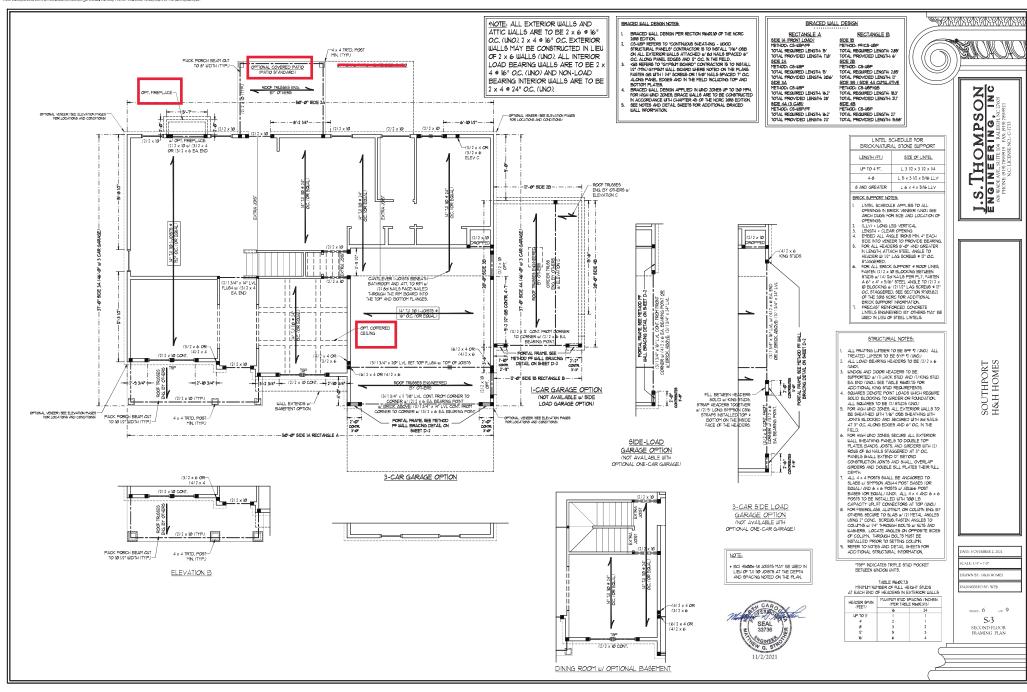

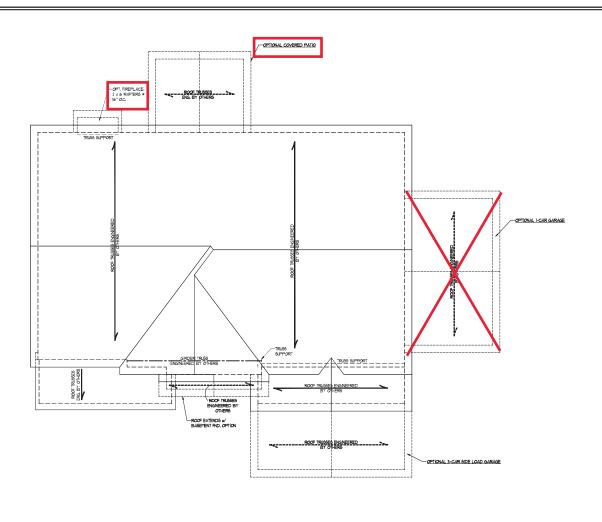

ELEVATIONS A & B

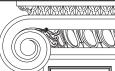

### BRICK SUPPORT NOTE:

### STRUCTURAL NOTES:

- STEACHEAL NOTES

  STEACHEAL NOTES

  STEACH AND LIMITED TO BE 7

  STEACH AND THE TO BE 67A-CE

  FOR EACH AND LIMITED TO BE

  FOR EACH AND LIMITED

  FOR EACH AND LIMI

DATE: NOVEMBER 2, 2021

RAWN BY: H&H HOMES


NUINEERED BY: WFB

яныт. 8 он 9 S-5a ROOF FRAMING PLAN




I.S. THOMPSON ENGINEERING, INC GEWARDARD ENTER HARBOR AND THOSE GEWARD FOR THE PROPERTY OF THE


SOUTHPORT H&H HOMES

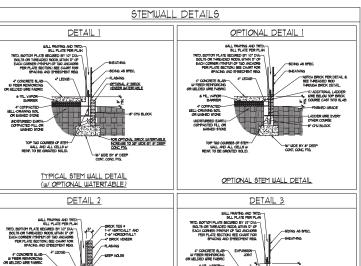



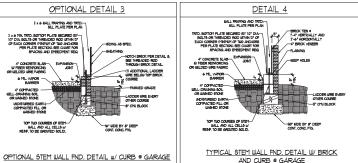

 715 0110 071002	
DETAIL 8	
NSIDE EDGE OF 12* ANCHOR ROD MAGONEY STEMBALL	
LADDER WIRE PER DETAIL	
BRICK MASONRY SOIS CO.	
STICK FRAMED WALL ABOVE	
NOTCH BRICK @ THREADED / ROD AND GROUT SOLID /	
THREADED ROD THROUGH BRICK MASONRY	

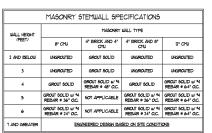

### STRUCTURAL NOTES:

ANCHOR SPACING AND EMBEDMENT		
WIND ZONE	12Ø MPH	13/0 MPH
SPACING	6'-Ø" O.C.	4'-Ø" O.C.
EMBEDMENT	יי	5" INTO MASONRY 1" INTO CONCRETE

WIND SPEED MPH ULTIMATE DESIGN FOUNDATION DETAILS

NON CONTRACTOR

S OMPS ERING.

工口

S. TE

DATE: NOVEMBER 14, 2018

1301

20

D-1 FOUNDATION DETAILS



ATE: NOVEMBER 14, 2018


GINEERED BY: 18


D-2 BRACED WALL NOTES AND DETAILS AND PF DETAIL




- WILL BRACING DESIGNED IN ACCORDANCE WITH CHAPTER 6 OF THE 1008 NC RESIDENTIAL BUILDING CODE (NCRC.)
  TABLES AND FRANCES REFERNICED AND RINGTH CHAPTER 6 OF THE 1008 NCRC. FOR ADDITIONAL INFORMATION AS NEEDED.
  SEE HIS SEET FOR CREATED WILL LOCATIONS DITEISMONS, ROLD DOWN THE AND LOCATIONS REVIEW WITH THE RESIDENCE WILL LOCATION BRACED WILL INFORM THE RESIDENCE TO THE RESIDENCE TO THE FOR THE THE LIBERS ADVINCES OF REGIMENT PROPERTY OF THAT FOR THE AUXIL LINE AD ON THE STEED AND THE SECOND WITH THE RESIDENCE THAT THE RESIDEN
- ALL EXTERIOR WALLS ARE TO BE SHEATHED WITH CS-WSP IN ACCORDANCE WITH SECTION REGIZIOZ UNLESS NOTED

- A LESTEROR BULLS ARE TO BE SHARHED WITH G-MERN IN ACCORDINGE BITH SECTION RISKINDS NAMES NOTIFE TO SEE PLANTING BY A LESTEROR BOY BY A LESTEROR BY A DIVISION RELIAND. SECTION RISKINDS AND RESPONDED TO SEE PLANTING DESCRIPTION RELIAND. A RESPONDED THE RES

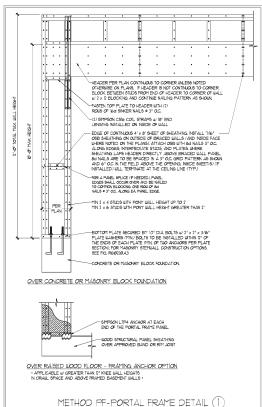


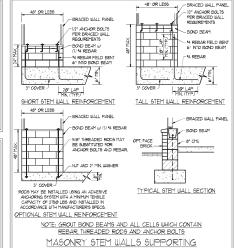

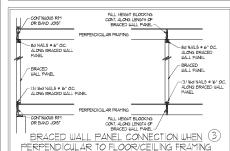


BRACED WALL PANELS (2)


PER FIGURE R602.10.4.3

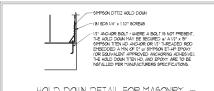



PER FIGURE R602.10.4.4(1)


HOLD DOWN DETAIL FOR MASONRY FOUNDATION OR MONOLITHIC SLAB · APPLICABLE ONLY WHERE SPECIFIED ON PLAN:

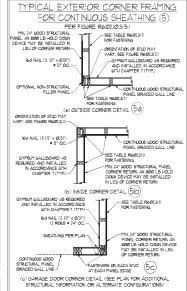

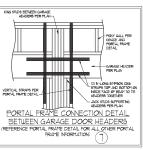

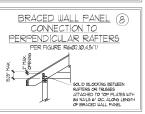

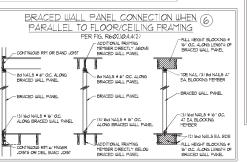

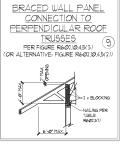

This sealed page is to be used in conjunction with a full plan set engineered by J.S. Thompson Engineering, Inc. only. Use of this individual sealed page within architectural pages or shop drawings by others is a punishable offense under N.C. Statute § 89C-23





## NO S

### GENERAL NOTES

- 1 ENGINEER'S SEAL APPLIES ONLY TO STRUCTURAL COMPONENTS INCLUDING ROOF RAFFERS HIPS VALLEYS RIGGES FLOORS HALLS BEAMS HEADERS, COLLINS, CANTILEVERS, OFFSET LOAD BEARNS WILLS, PERS, CHOPER SYSTEM AND FOOTNS. INSIGERS'S EAL DOES NOT CERTIFY DIMENSIONAL ACCURACY OF ARCHITECTURAL LAYOUT INCLUDING ROOF. ENGINEER'S EAL DOES NOT APPLY TO 1-JOIST OR FLOOR/ROOF TRUSS
- ALL CONSTRUCTION SHALL CONFORM TO THE LATEST REQUIREMENTS OF THE NORTH CAROLINA RESIDENTIAL CODE INDEX.) 20% EDITION, PLUS ALL LOCAL CODES AND REGULATIONS. THE STRUCTURAL ENGINEERS IN OTHER PROVISIONED FOR ANY DILL NOT HAVE CONTROL OF, CONSTRUCTION PEANS, HETCHOS, ELCANOLISE SEQUENCES OR RECOGNIZED AS SAFETY PRECULTIONS AND PROSCARS TO CONSECTION WITH THE CONSTRUCTION. WORK, NOR WILL THE ENGINEER BE RESPONSIBLE FOR THE CONTRACTORS FAILURE TO CARRY OUT THE CONSTRUCTION WORK IN ACCORDANCE WITH THE CONTRACT DOCUMENTS
- 3. STRUCTURAL DESIGN BASED ON THE PROVISIONS OF THE NORC, 2018 EDITION (RGØ1.4 RGØ1.1)

DESIGN CRITERIA:	LIVE LOAD (PSF)	DEAD LOAD (PSF)	DEFLECTION (IN)
ATTIC WITH LIMITED STORAGE	20	lØ	L/240 (L/360 w/ BRITTLE FNISHES)
ATTIC MITHOUT STORAGE	lø	lø	L/36Ø
DECK5	40	IØ	L/36Ø
EXTERIOR BALCONIES	40	lØ	L/36Ø
FIRE ESCAPES	40	IØ	L/36Ø
HANDRAILS/GUARDRAILS	200 LB OR 50 (PLF)	lø	L/36Ø
PASSENGER VEHICLE GARAGE	50	iø	L/36Ø
ROOMS OTHER THAN SLEEPING ROOM	40	lØ	L/36Ø
SLEEPING ROOMS	30	1Ø	L/36Ø
STAIRS	40	lØ	L/36Ø
WND LOAD	(BASED ON TABLE R30(3(4) WIND ZONE AND EXPOSURE)		
GROUND SNOW LOAD: Pa	2Ø (PSF)		

- I-JOIST SYSTEMS DESIGNED WITH 12 PSF DEAD LOAD AND DEFLECTION (IN) OF L/480
- 4. FOR 115 AND 130 MPH WIND ZONES, FOUNDATION ANCHORAGE 15 TO COMPLY WITH SECTION RADAGE OF THE NORG, 20'9 EDITION. FOR 150 MPH, IAO MPH, IAO 150 MPH WIND ZONES, FOUNDATION ANCHORAGE 15 TO COMPLY WITH SECTION 4504 OF THE NORG, 20'9 EDITION.
- 5. ENERGY EFFICIENCY COMPLIANCE AND INSULATION VALUES OF THE BUILDING TO BE IN ACCORDANCE WITH CHAPTER II OF THE NORC. 2018 EDITION.

### FOOTING AND FOUNDATION NOTES

- 1. FOUNDATION DEBIGN BASED ON A MINIMUM ALLOWABLE BEARING CAPACITY OF 2000 P6F. CONTACT GEOTECHNICAL ENGINEER IF BEARING CAPACITY IS NOT ACHEVED.
- PROFERLY DEMATER EXCAVATION PRIOR TO POURNIS CONCRETE WHEN BOTTOM OF CONCRETE SLAB IS AT OR BELOW WATER TABLE.
  APPLICABLE, 34" In DEEP CONTROL JONES AND TO BE SAMED WITHIN 4 TO BE HOURS OF CONCRETE FINISHING AND WALL LOCATIONS BEEN MARKEY, AUDIST WHEN NECESSARY.
- 4. CONCRETE SHALL COPPORT TO SECTION RADGE OF THE NORC, 1908 EDITION. CONCRETE REINFORCING STELL TO BE ASTH ASS GRADE 60. BELDED LIREF PARRIED TO BE ASTH ASS. MARKINAL A MINIMAL CONCRETE CONFER ASOLID REINFORCING STELL OF 3° IN PROTINGS ASD 10° IN SUB-ASS. FOR PROTED CONCRETE BLUE, SOURCESTE CONFER REINFORCING STELL PARKED FORT THE MOSTE PARKED OF THE BLUEL SHALL NOT BE LESS THAN 314°. CONCRETE COPPER FOR REINFORCING STELL PLASMED FROM THE CUTSIDE FACE OF THE BLUEL. SHALL NOT BE LESS THAN 114° FOR SHAD SHOOT LARKER.
- MASONRY UNITS TO CONFORM TO ACE 530/ASCE 5/TMS 402. MORTAR SHALL CONFORM TO ASTM CITIE.
- 6. THE UNSUPPORTED HEIGHT OF MASONRY PIERS SHALL NOT EXCEED FOUR TIMES THEIR LEAST DIYENSIGN FOR INFILLED HOLLOW CONCRETE YASONRY WITTS AND TEN TIMES THER LEAST DIYENSIGN FOR SO, DO FOR SO, LID FILLED PIERS, PERS YAY DE FILLED BUILD UITH CONCRETE OR TYPE HOR S MORTAR PIERS AND WILLES SHALL BE CAPPED WITH 8" OF SO, LID WITH ASONRY THE SHALL BE CAPPED WITH 8" OF SO, LID WITH CONCRETE WITH SHALL BY CAPPED WITH 8" OF SO, LID WISONRY BUILD SHALL BY CAPPED WITH 8" OF SO, LID WISONRY BUILD SHALL BY CAPPED WITH 8" OF SO, LID WISONRY BUILD SHALL BY CAPPED WITH 8" OF SO, LID WITH SHALL BY CAPPED WITH 8" OF SO, LID WITH SHALL BY CAPPED WITH
- THE CENTER OF EACH OF THE PIERS SHALL BEAR IN THE MIDDLE THIRD OF ITS RESPECTIVE FOOTING, EACH GIRDER SHALL BEAR IN THE MIDDLE THIRD OF THE PIERS.
- ALL COPERTE AID MASSIFF FORDATION ALLS LIFE OF BE CONTINCED IN ACCORDANCE WITH THE PROPRIOS OF SECTION AND IT HE LIVER, THE SECTION OF IN ACCORDANCE WITH ALT 38, ACL 333, NOTA 1984-A OR ACE BOUAGE INTO A OR 1, MASSIFF ROADATION MALLS HE TO BE REPORTED THE THE LIFE OR SECTION OF THE MASSIFF AND ACTION OF THE REPORT OF THE MASSIFF AND ACTION OF THE MASSIFF AND ACTION OF THE MASSIFF AND ACTION ACTION AND ACTION OF THE MASSIFF AND ACTION ACTION MALLS 107.1 6 FRAMED MALLS AT 19 COLUMNET CANNER (AND ACTION ACTION MALLS 107.3 6 FRAMED MALLS AT 19 COLUMNET CANNER (AND ACTION ACTION MASSIFF AND ACTION ACT

This sealed page is to be used in conjunction with a full plan set engineered by J.S. Thompson Engineering, Inc. only. Use of this individual sealed page within architectural pages or shop drawings by others is a punishable offense under N.C. Statute § 89C-23

### FRAMING NOTES

- L. ALL FRAMING LIMPER 9-IALL BE 12 9FF MINIMUM (Fig. 875 PS) Fy : 375 PS) E : 16/00/2/2 PS) UNLESS NOTED OTHERUSE (UNC). ALL TREATED LUMBER SHALL BE 12 SYP MINMUM (FIG. # 915 PS), FV #175 PS), E # 16000000 PS)) UNLESS NOTED OTHERWISE (UND
- 2. LATINATED VENEER LIMBER (LIV.) SHALL HAVE THE FOLLOUNG MINITUM PROFERITIES. Fo. 12600 PSI, Fo. 1265 PSI, E. 1. PROGOOD PSI, LATINATED STRAND LIMBER (SLJ.) SHALL HAVE THE FOLLOUNG MINITUM PROFERITIES fo. 1250 PSI, Fo. 1950000 PSI, PARALLEL STRAND LIMBER (PSIL) TO TO PSITH SHALL HAVE THE FOLLOUNG MINITUM PROFERITIES fo. 1250 PSI E. 1260000 PSI, PARALLEL STRAND LIMBER (PSIL) MORE THAN 17 DEPTH SHALL HAVE THE FOLLOUNG MINITUM PROFERITIES fo. 1200 PSI E. 120000000 PSI, INSTALL ALL CONNECTIONS PER MANUFACTURER'S SPECIFICATIONS.
- 3. STRUCTURAL STEEL SHALL CONFORM TO THE FOLLOWING ASTM SPECIFICATIONS

Α.	W AND WI SHAPES:	ASITI ASSV
В.	CHANNELS AND ANGLES:	ASTM A36
C.	PLATES AND BARS:	ASTM A36
D.	HOLLOW STRUCTURAL SECTIONS:	ASTM A500 GRADE B
E.	STEEL PIPE:	ASTM A53, GRADE B. TYPE E OR S

4. STEEL BEAMS SHALL BE SUPPORTED AT EACH END WITH A MINIMUM BEARING LENGTH OF 3 I/2" AND FULL FLANGE WIDTH (UNO), PROVIDE SOLID BEARNS FROM BEAM SUPPORT TO FOUNDATION, BEAMS SHALL BE ATTACHED AT THE BOTTOM FLANGE TO EACH SUPPORT AS FOLLOUS (UNO)

A, WOOD FRAMING (2)  $12^{\circ}$  DIA, x 4° LONG LAG SCREUS (2)  $12^{\circ}$  DIA, x 4° WEDGE ANCHORS (2)  $12^{\circ}$  DIA, x 4° LONG SIMPSON TITEN HD ANCHORS

LATERAL SUPPORT IS CONSIDERED ADEQUATE PROVIDING THE JOISTS ARE TOE NALED TO THE 5X NAILER ON TOP OF THE STEEL BEAM, AND THE 2x NATURE IS SECURED TO THE TOP OF THE STEEL BEAM w/ (2) ROUS OF SELF TAPPING SCREUS @ Vo" O.C. OR (2) ROUS OF I/2" DIAMETER BOLTS \* I6\* O.C. F 12\* BOLTS ARE USED TO FASTEN THE NAILER. THE STEEL BEAM SHALL BE FABRICATED w/ (2) ROUS OF 9/16\* DIAMETER HOLES # 16" O.C.

- SQUARES DENOTE POINT LOADS WHICH REQUIRE SOULD BLOCKING TO GIRDER OR FOUNDATION, SHADED SQUARES DENOTE POINT LOADS FROM ABOVE WHICH REQUIRE SOULD BLOCKING TO SUPPORTING MEMBER BELOW.
- 6. ALL LOAD BEARING HEADERS TO CONFORM TO TABLE R602.1(1) AND R602.1(2) OF THE NORC, 2018 EDITION OR BE (2) 2 x 6 WITH (1) JACK AND (I) KING STUD EACH END (UNO), WHICHEVER IS GREATER ALL HEADERS TO BE SECURED TO EACH JACK STUD WITH (4) 8d NAILS, ALL BEAMS TO BE SUPPORTED WITH (2) STUDS AT EACH BEARING FOINT (UNO). INSTALL KING STUDS PER SECTION R6(02):15 OF THE NORTH CAROLINA RESIDENTIAL CODE 2018 EDITION
- 1. ALL BEAMS, HEADERS, OR GRODER TRUSSES PARALLEL TO WALL ARE TO BEAR RULLY ON (1) JACK OR (2) STUDS THINMTH OR THE NUMBER OF JACKS OR STUDS NOTES. ALL BEAMS OR GRODER TRUSSES FREEDOLGLAR TO WALL AND SUPPORTED BY (1) STUDS OR LESS ARE TO MAKE (1)? MAND MEANING MEANING AND, ALL BEAMS OR GRODER TRUSSES FREEDOCULAR TO WALL AND SUPPORTED BY TO WEET HAN (3) STUDS OR OTHER MOTED COUNTS, ARE TO BEAR RULLY ON SUPPORT DO YOUR TRUSS FREEDOM FOR BUTTER WALL DEPTH (NO.). BEAM BUDG THAT BUTT INTO ONE ANOTHER ARE TO EACH BEAR EQUAL LENGTHS (UNO).
- 8. FLITCH BEAMS SHALL BE BOLTED TOGETHER USING 101 DIAMETER BOLTS (ASTM A3@1) WITH WASHERS PLACED AT THREADED END OF BOLT. BOLTS SHALL BE SPACED AT 24" CENTERS (MAXIMUM), AND STAGGERED AT TOP AND BOTTOM OF BEAM (2" EDGE DISTANCE), WITH (2) BOLTS LOCATED AT 6" PROM EACH END (UNO).
- ALL I-JOIST OR TRUSS LAYOUTS ARE TO BE IN COMPLIANCE WITH THE OVERALL DESIGN SPECFED ON THE PLANS. ALL DEVIATIONS ARE TO BE BROUGHT TO THE ATTENTION OF THE ENGINEER OF RECORD PRIOR TO INSTALLATION.
- 10. BRACED WALL PANELS SHALL BE CONSTRUCTED ACCORDING TO THE NORTH CAROLINA RESIDENTIAL CODE 2018 EDITION WALL BRACING CRITERIA THE AMOUNT, LENGTH, AND LOCATION OF BRACING SHALL COMPLY WITH ALL APPLICABLE TABLES IN SECTION REGION.
- II PROVIDE DOUBLE JOST UNDER ALL WALLS PARALLEL TO FLOOR JOSTS. PROVIDE SUPPORT UNDER ALL WALLS PARALLEL TO FLOOR 5 PER MANUFACTURER'S SPECIFICATIONS. INSTALL BLOCKING BETWEEN JOISTS OR TRUSSES FOR POINT LOAD SUPPORT FOR ALL POINT LOADS ALONG OFFSET LOAD LINES.
- FOR ALL HEADERS SUPPORTING BRICK VENEER THAT ARE LESS THAN 8"-0" IN LENGTH, REST A 6" x 4" x 5/6" STEEL ANGLE WITH 6" MINIMUM EMBEDMENT AT SIDES FOR BRICK SUPPORT (UNO). FOR ALL HEADERS 8'-8" AND GREATER IN LENGTH, BOLT A 6" x 4" x 5'/6" STEEL ANGLE TO HEADER WITH IVE LAG SCREUS AT 12' O.C. STAGGERED FOR BRICK SUPPORT. FOR ALL BRICK SUPPORT AT ROOF LINES, BOLT A 6" x 4" x 5/16" STEEL ANGLE TO (2) 2 x 10 BLOCKING INSTALLED W (4) 12d NAILS EA, PLY BETWEEN WALL STUDG WITH (2) PROUS OF 1/2" LAG SCREWS AT 12" O.C. STAGGERED AND IN ACCORDANCE WITH SECTION RTØ3.8.2.) OF THE NORC, 2018 EDITION
- 13. FOR STICK FRAMED ROOFS; CIRCLES DENOTE (3) 2 x 4 POSTS FOR ROOF MEMBER SUPPORT, HIP SPLICES ARE TO BE SPACED A MINIMUM OF SHOULD NOT SELF-SECTION LIFELIZED LICENSES 120 / X = TUDITS FOR ROCK PIETEER BLIPPORT, HIP SELECES ARE TO BE SPACED A MINIMA 8-01, FASTEN MEMBERS LITH THREE ROUS OF 12d NALES AT 161 O.C., FRAME DORMER WALLS ON TOP OF DOUBLE OR TRIME RAFTERS AS SHOUN (IAO).
- 14. FOR TRUSSED ROOFS: FRAME DORMER WALLS ON TOP OF 2 x 4 LADDER FRAMING AT 24" OC. BETWEEN ADJACENT ROOF TRUSSES. STICK FRAME OVER-FRAMED BOOF SECTIONS WITH 2 x 8 RIDGES, 2 x 6 RAFTERS AT 16" O.C., AND FLAT 2 x 10 VALLEYS (LNO.);
- 15. ALL 4 x 4 AND 6 x 6 POSTS TO BE INSTALLED WITH TWO LIB CAPACITY UPLIFT CONNECTORS TOP AND BOTTOM (UNO.) POSTS MAY BE SECURED USING ONE SIMPSON HE OR LITIST UPLET CONNECTOR FASTENED TO THE BAND AT THE BOTTOM AND THE BEAM AT THE TOP OF EACH POST. ONE IN SECTION OF SIMPSON CASE COLL STRANGING WITH (8) SEL HOS NALE AT EACH END MAY BE USED IN LIBU OF EACH MUST STRUP P DESIGNED. FOR MASONIX OR CONCRETE PONDATION USE STRYON POST BASE.

· 130 MPH ULTIMATE DESIGN WIND SPEED STANDARD STRUCTURAL NOTES

DATE: NOVEMBER 14, 2018

GINEERED BY: 157

S-0

S HOMPS S.Tr

> MPH 20

STRUCTURAL NOTES