

Harnett County Department of Public Health

PERMIT # SFD2406-0005

Operation Permit

☒ New Installation ☒ Septic Tank ☒ Nitrification Line ☐ Repair ☐ Expansion

PROPERTY LOCATION: 261 Hawksmoor Ln

Name: (owner) D.R. Horton

SUBDIVISION Mekay Place

LOT # 34

System Installer: Jason Matthews

Basement with plumbing: ☐ Garage ☒ Number of Bedrooms 4 (8 people)


Type of Water Supply: ☐ Community ☒ Public ☐ Well Distance from well _____ feet

System Type: TYPE III B Types V and VI Systems expire in 5 years.

(In accordance with Table V a)

Owner must contact Health Department 6 months prior to expiration for permit renewal.

This system has been installed in compliance with applicable North Carolina General Statutes, Rules for Sewage Treatment and Disposal, and all conditions of the Improvement Permit and Construction Authorization.

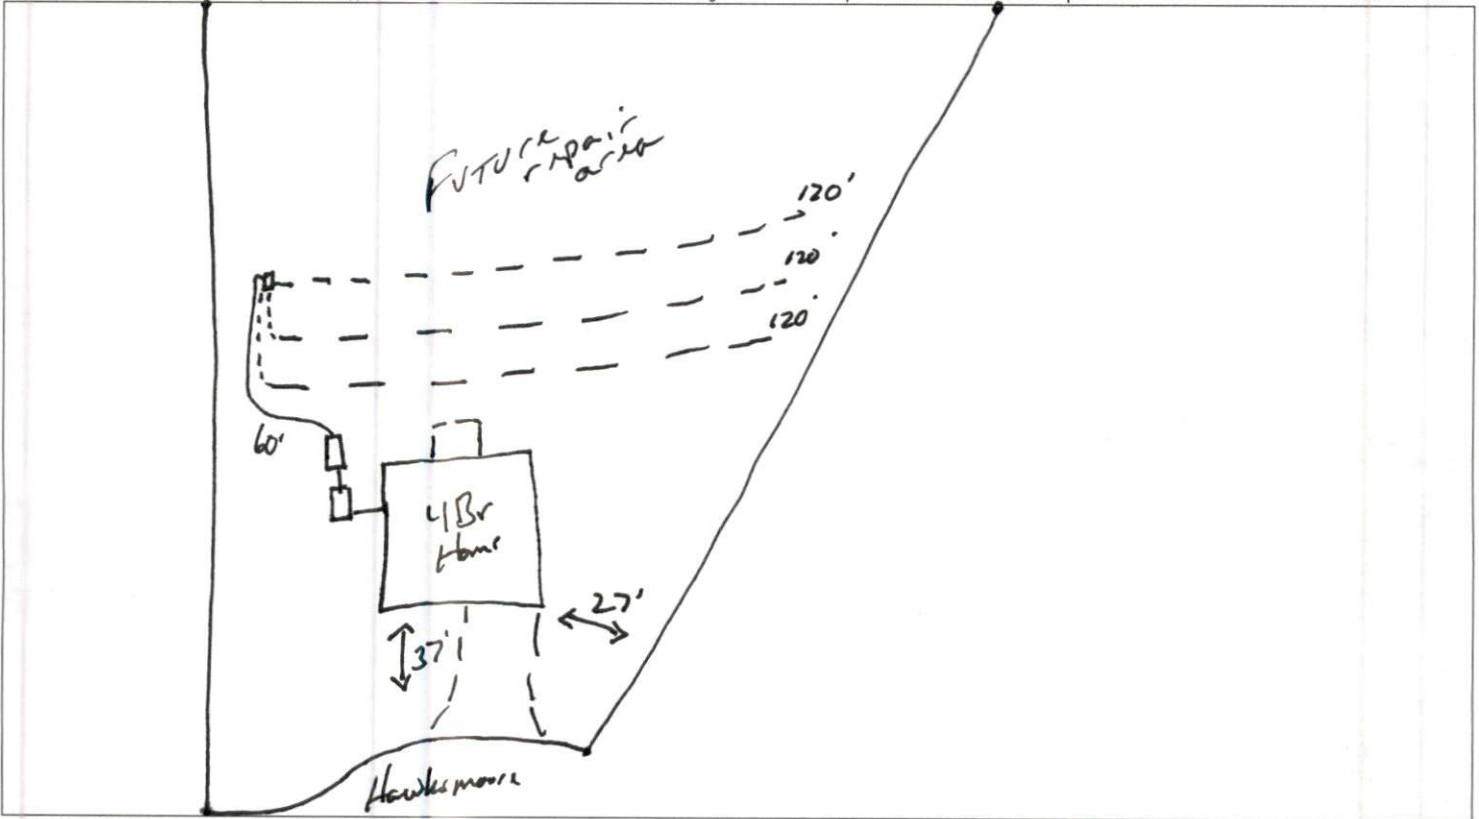

PERMIT CONDITIONS:

I. Performance: System shall perform in accordance with Rule .1961.

II. Monitoring: As required by Rule .1961.

III. Maintenance: As required by Rule .1961. Other: _____

Subsurface system operator required? Yes ☐ No ☒

If yes, see attached sheet for additional operation conditions, maintenance and reporting.

IV. Operation: _____

V. Other: _____

☒ D-Box ☒ Pump ☒ Alarm ☐ H2O Line ☐ PWR Line

Following are the specifications for the sewage disposal system on the above captioned property.

Type of system: ☐ Conventional ☒ Other 25% reduction Effluent Septic Tank: 1000 gallons Pump Tank: 1000 gallons

Subsurface No. of exact length width of depth of
Drainage Field ditches _____ of each ditch _____ feet ditches _____ feet ditches _____ inches

French Drain Required: _____ Linear feet

Authorized State Agent

John A. Davis

Date 4-21-25

*House footprint to be field staked by surveyor and system verified prior to any construction

**Septic area must not be altered by construction activities.

***No cuts of 2' or greater within 15' of septic area


**** Recommend protective barrier around septic field during construction.

Mckay Place
Lot 34
4 Bedroom
Harnett County
"As Built" 2-5-25

*At time of installation distribution method was changed to pump to "D-Box"

*If plumbing is not suffice,
pump tank will be required
septic field.

*1000 Gallon Septic and Pump Tank utilized
*Changes approved by Alex Adams

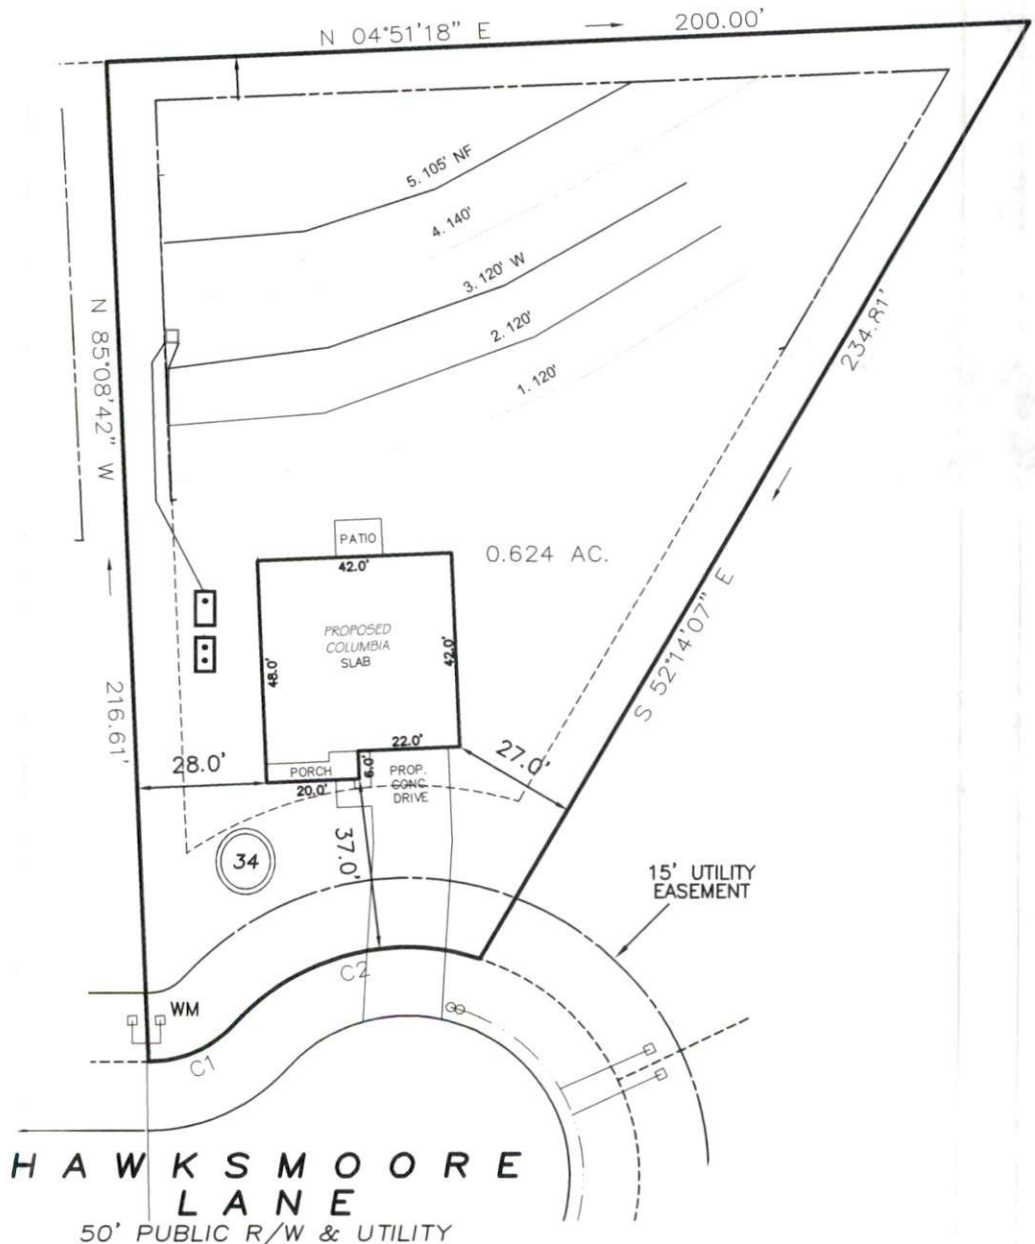

INITIAL:
Lines 1-3 (360')
Accepted Status
Pump to Manatee
REPAIR:
Lines 4-5 (245')
PPBPS
Pressure Manifold

Adams
Soil Consulting
919-414-6761

HAWKSMOORE
LANE
50' PUBLIC R/W & UTILITY