

Harnett County Department of Public Health

Well Abandonment Permit Application

APPLICANT INFORMATION

Custom Contracting Corp

VAN R. GROCK JR (919) 775-1497
Applicant/Owner Phone Number

1504 S. Horner Blvd Sanford, NC 27330
Street Address, City, State, Zip Code

PROPERTY INFORMATION

Street Address 448 Knight Rd Broadway Subdivision/Lot # 1

Parcel # 139680.0082 PIN # 9680-49-1790.000

Directions to the Site

421 N. toward Sanford. L on Lee Co Line Rd.
L on Knight Rd. Lot on L

Brief description of the well location (ex. front yard, behind out building, front yard, etc.)
Too close to new septic system for new house

*Please include a Site Plan of your property showing the location of the well. If the well is underground, it must be uncovered prior to the department's site visit.

Please Complete the Following Information:

Date Well Was Constructed ? Grouted: Yes No
Above Ground or Below Ground Total Depth of Well _____
Well Type: Drilled Bored Hand dug Diameter _____ inches

I have thoroughly read and completed this Application and certify that the information provided herein is true, complete and correct to the best of my knowledge and is give in good faith. Representatives of the Harnett County Health Department and State Officials are granted right of entry to conduct necessary inspections to determine compliance with applicable rules.

I understand that I am solely responsible for the proper identification and labeling of all property lines, underground utility lines, and making the site accessible so that a well can be properly constructed according to the permit.

K R Grock Jr 9/25/24
Property Owner's or Owner's Legal Representative Signature Required Date


AREA OF A COUNTY OR MUNICIPALITY THAT HAS AN ORDINANCE THAT REGULATES PARCELS OF LAND.

Larry K. Allen

LARRY K. ALLEN, R.L.S. NO.-2454

NEIL W. KELLY

NEIL W. KELLY HEIRS

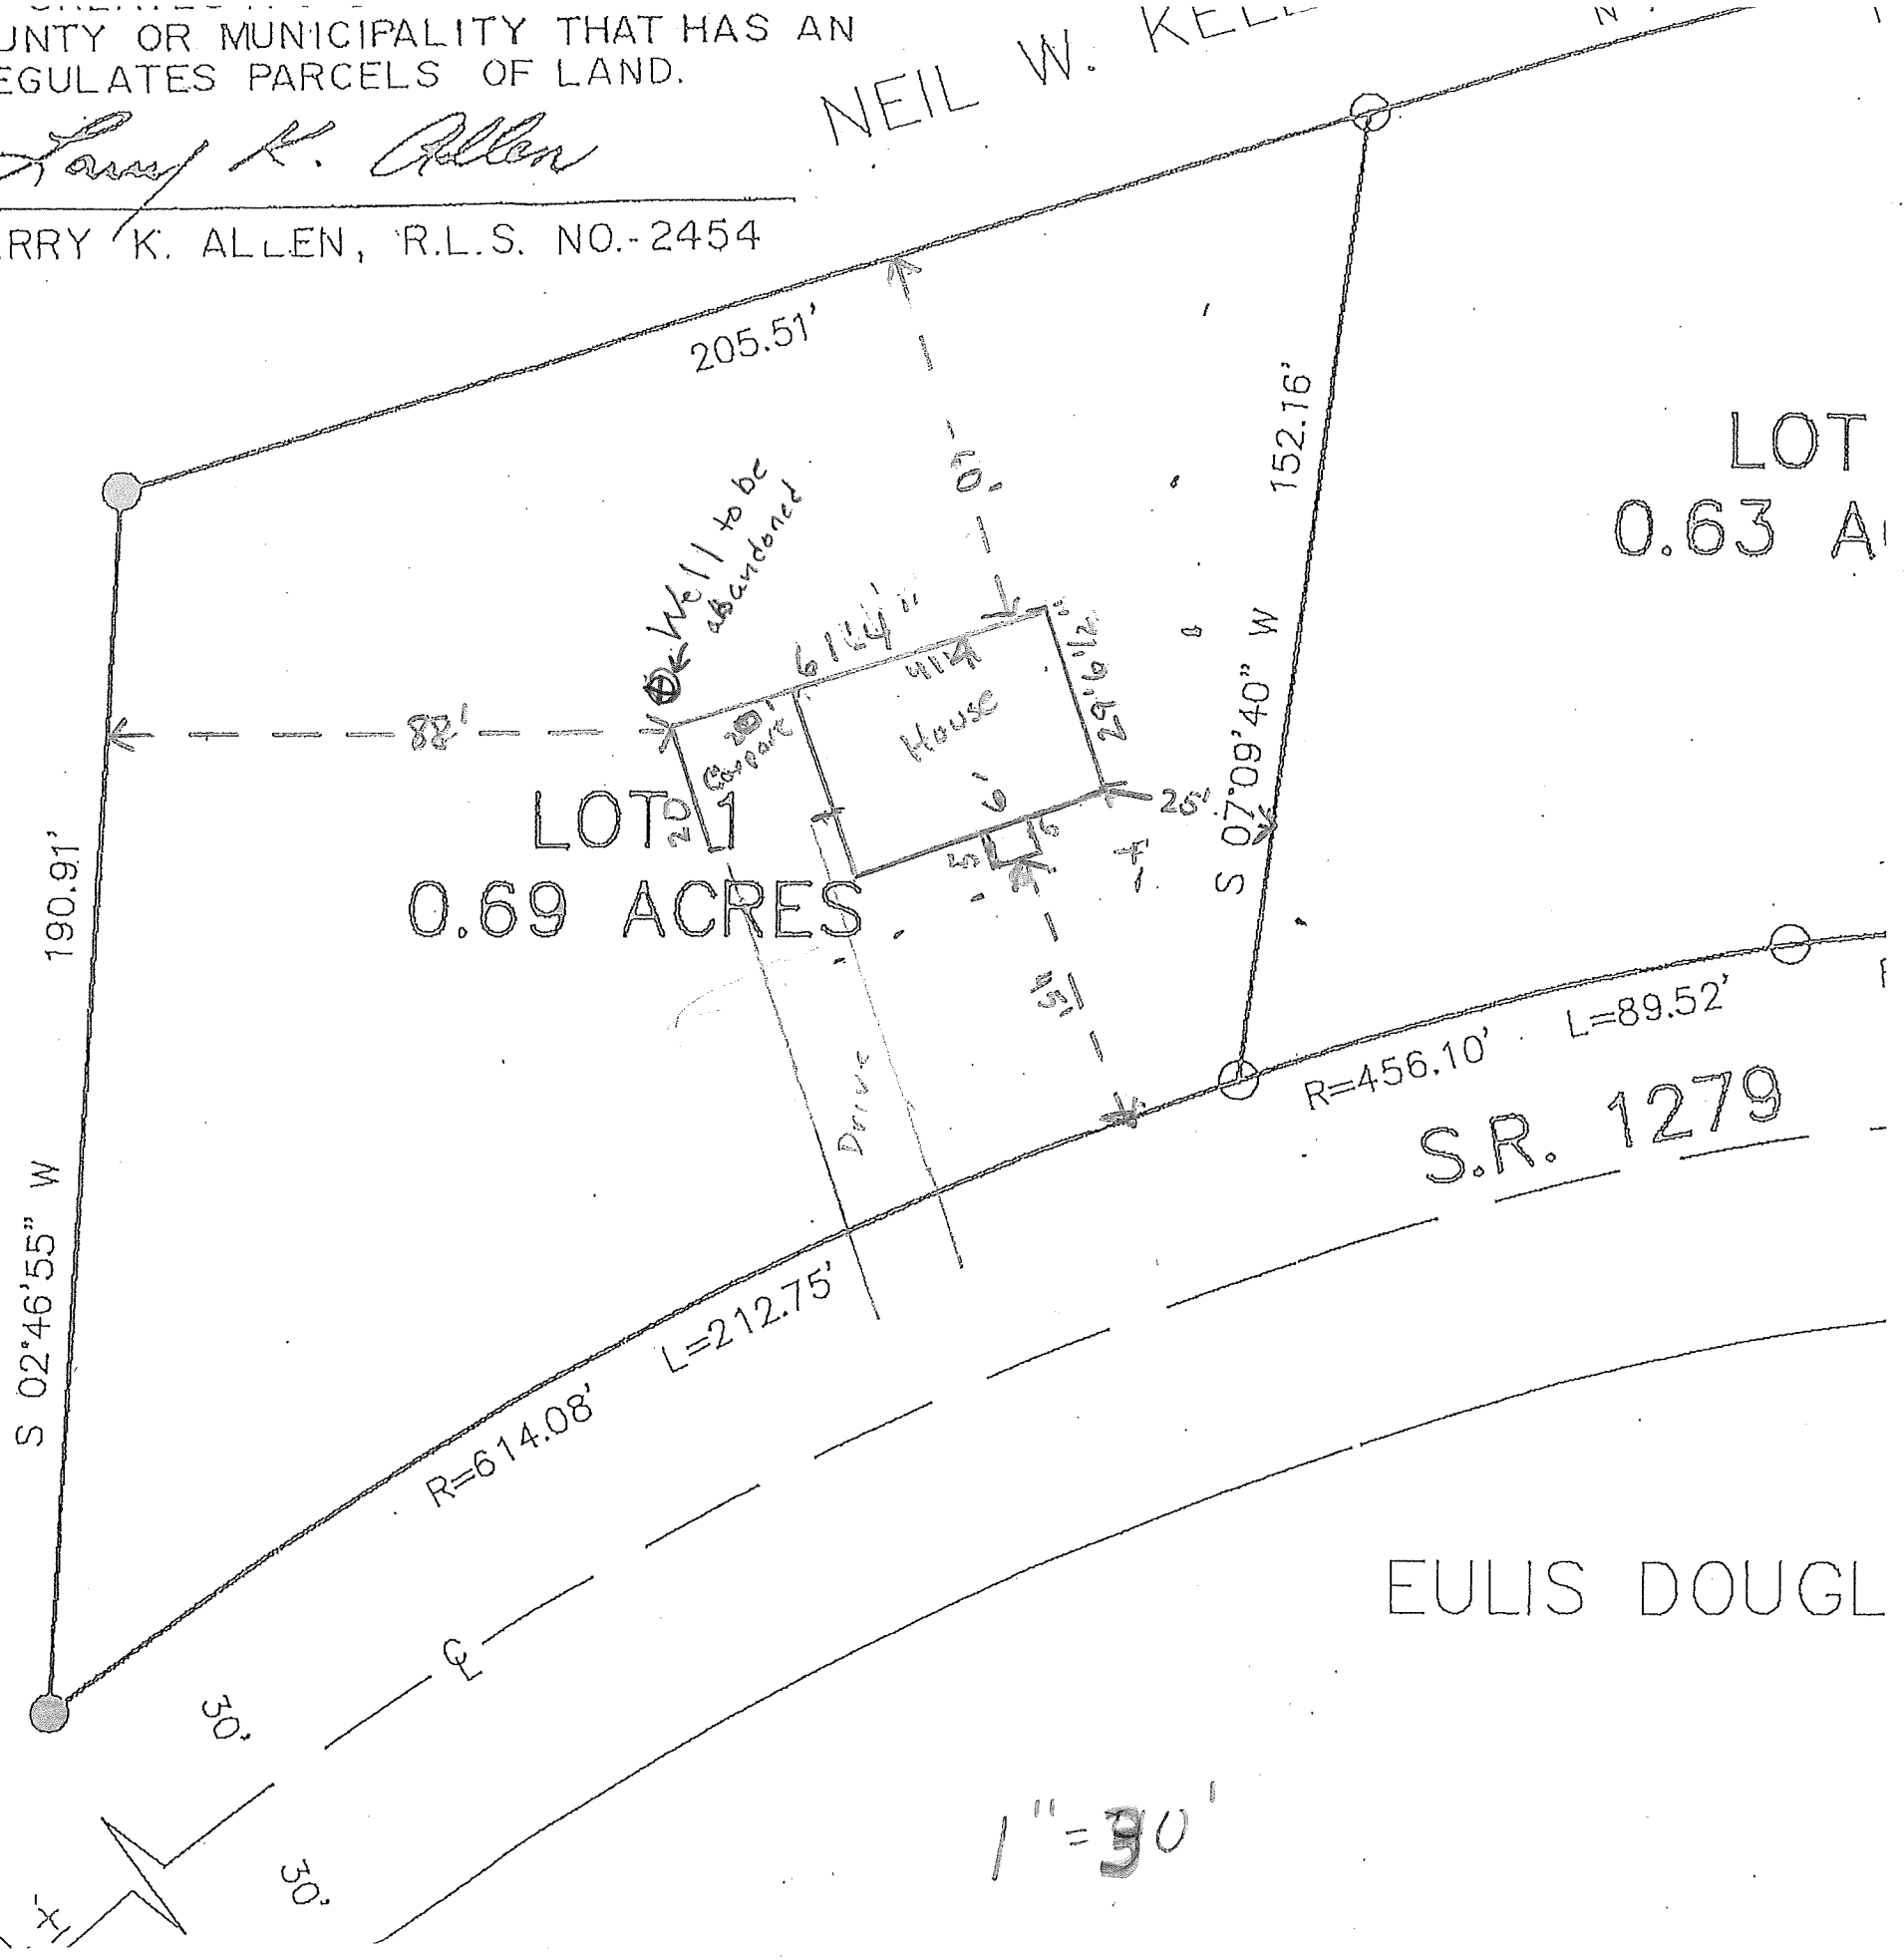

LOT 2
0.63 ACRES

LOT 1
0.69 ACRES

S.R. 1279

EULIS DOUGL