

S17°37'06"W  
80.50


S72°37'19"E  
126.82

S72°37'22"E  
126.49

276

278

277

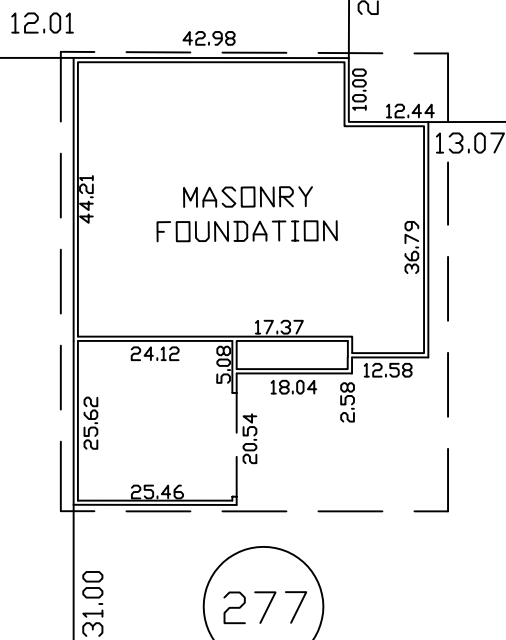

N17°23'01"E  
80.50

FALLING WATER ROAD  
60' PRIVATE R/W



THIS IS AN AS-BUILT SURVEY ONLY. THIS SURVEY IS NOT FOR THE CONVEYANCE OF PROPERTY AND DOES NOT NECESSARILY MEET G.S. 47-30 AS AMMENDED NOR WAS IT INTENDED TO.

*Charlie T. Carpenter* 10/7/24

Charlie T. Carpenter, P.L.S.

Professional Land Surveyor

1940 Juniper Church Road

Four Oaks, NC 27524

(919) 320-5281

plschuck30@yahoo.com

FOUNDATION SURVEY FOR:

RED ROCK BUILDERS, LLC

PIN 0506-60-1643.000

PARCEL ID 010535089 0100 25

LOT 277 ANDERSON CREEK CLUB S/D

PB2004 PG812

10/3/24

1"=30'

10,196 SQ. FT.

0.23 ACRES

484 FALLING WATER ROAD  
SPRING LAKE, NC 28390