

# DETACHED SINGLE FAMILY DWELLING

## MODEL 628 - GARAGE LEFT

### CONTENTS

1	CONTENTS AND PROJECT INFORMATION
2	MONOLITHIC SLAB FOUNDATION PLANS
2.0	MONOLITHIC SLAB FOUNDATION PLANS - OPTIONS
3	FIRST FLOOR PLANS
3.1	FIRST FLOOR PLANS - OPTIONS
3.1.1	FIRST FLOOR PLANS - OPTIONS
3.2	SECOND FLOOR PLAN
4	ELEVATION A AND ROOF PLAN
4.1	ELEVATION B AND ROOF PLAN
4.2	ELEVATION C AND ROOF PLAN
4.3	ELEVATION D AND ROOF PLAN
4.4	ELEVATION E AND ROOF PLAN
4.5	ELEVATION F AND ROOF PLAN
5	TYPICAL BUILDING SECTION
6	FOUNDATION, WALL AND SOFFIT DETAILS
6.1	FOUNDATION AND WALL DETAILS
6.2	FOUNDATION AND WALL DETAILS
6.2A	ELEVATION A DETAILS
6.2B	ELEVATION B/C/D/E/F DETAILS
7	FIRST FLOOR ELECTRICAL PLANS
7.1	SECOND FLOOR ELECTRICAL PLAN
SD1	STANDARD DETAILS AND NOTES - MONOLITHIC

### AREA SCHEDULE

FIRST FLOOR HEATED *	1,308 SF
SECOND FLOOR HEATED **	1,708 SF
TOTAL HEATED AREA	3,016 SF
GARAGE ***	450 SF
COVERED FRONT PORCH (VARIES) ****	165 SF
TOTAL COVERED AREA	3,631 SF
OPT. COVERED REAR PORCH/SUNROOM *****	138 SF

\* + 83 SF @ OPT. BATH #1  
+ 81 SF @ OPT. BATH #2  
+ 25 SF @ ELEV. D

\*\* +25 SF @ ELEV. D

\*\*\* + 252 SF @ OPT. THIRD-CAR GARAGE  
+ 56 SF @ OPT. GARAGE STORAGE

\*\*\*\* 150 SF @ ELEV D  
+ 98 SF @ OPT. WRAP AROUND PORCH

\*\*\*\*\* + 174 SF @ OPT. SUNROOM W/ OPT. COVERED PORCH

NC 132 - 628 Plan - Azalea - garage Left

Door 2468 tp Bedroom #4 to Bathroom  
Optional Full Bath #2 addition w/Walkin Closet  
Primary Deluxe Bath #1  
Pickets and Rails - 1st Floor  
Gas Line in Kitchen  
Double Bowl Sink in Hall Bath  
8' Front Door  
Microwave Vented Out

### GENERAL NOTES

#### 01. GENERAL CONDITIONS

- STAIRS: ALL STAIRS SHALL BE CONSTRUCTED IN ACCORDANCE WITH THE REQUIREMENTS ESTABLISHED BY THE ADOPTED BUILDING CODE. STAIR INFORMATION - MAXIMUM STAIR RISER 8-1/4"; MINIMUM STAIR TREAD 9" WITH A 3/4" - 1-1/4" NOSING ON STAIRS WITH SOLID RISER. MINIMUM STAIR HEADROOM 6'-8" CLEAR MEASURED VERTICALLY FROM THE STAIR NOSING OR FROM THE FLOOR SURFACE OF THE LANDING OR PLATFORM. MINIMUM CLEAR STAIR OPENING WIDTH SHALL NOT BE LESS THAN 36 INCHES. STAIRS WITH OPEN RISERS SHALL BE CONSTRUCTED TO PREVENT THE PASSAGE OF A SPHERE OF 4 INCHES OR MORE IN DIAMETER THROUGH THE RISER OPENINGS. THE GREATEST RISER HEIGHT WITHIN ANY FLIGHT OF STAIRS SHALL NOT EXCEED THE SMALLEST BY MORE THAN 3/8 INCHES. THE GREATEST TREAD RUN WITHIN ANY FLIGHT OF STAIRS SHALL NOT EXCEED THE SMALLEST BY MORE THAN 3/8 INCHES.
- HANDRAILS AND GUARDRAILS: HANDRAILS MUST HAVE A MINIMUM AND MAXIMUM HEIGHT OF 34 INCHES AND 38 INCHES, RESPECTIVELY, MEASURED VERTICALLY FROM THE NOSING OF THE TREADS, AND SHALL BE PROVIDED ONE AT LEAST ON SIDE OF STAIRWAYS OF FOUR OR MORE RISERS. HANDRAILS SHALL BE CONTINUOUS THE FULL LENGTH OF THE STAIRS. ENDS SHALL BE RETURNED OR SHALL TERMINATE IN NEWEL POSTS OR SAFETY TERMINALS. ALL STAIRWAY HANDRAILS SHALL HAVE A CIRCULAR CROSS SECTION WITH AND OUTSIDE DIAMETER OF AT LEAST 1-1/4 INCHES AND NOT GREATER THAN 2 INCHES MAX. OR APPROVED RAILS OF EQUIVALENT GRASPABILITY. HANDRAILS PROJECTING FROM THE WALL SHALL HAVE A SPACE OF NOT LESS THAN 1-1/2 INCHES BETWEEN THE WALL AND THE HANDRAIL. GUARDRAILS NOT LESS THAN 36 INCHES IN HEIGHT AND SHALL BE INSTALLED AT ALL PORCHES, BALCONIES, OR RAISED FLOOR SURFACES LOCATED MORE THAN 30 INCHES ABOVE THE FLOOR OR GRADE BELOW.
- WINDOW SUPPLIER IS TO CERTIFY THAT THE WINDOWS PROVIDED FOR BEDROOMS MEET THE GOVERNING BUILDING CODE EGRESS AND FALL PREVENTION REQUIREMENTS. IF LARGER WINDOWS ARE REQUIRED THAN THOSE SHOWN ON THE PLANS, THE SUPPLIER SHALL NOTIFY THE BUILDER AND THE BUILDER SHALL SUBSTITUTE THE LARGER WINDOWS FOR THOSE SHOWN ON THE PLANS. THE BUILDER SHALL CONFIRM WINDOW SIZES BY COMPLETING THE ROUGH FRAME OPENINGS BEFORE THE WINDOWS ARE ORDERED. GLAZING AT ALL WINDOWS, DOORS, TUBS, FIXED GLASS PANELS, SIDELIGHTS, ETC. MUST MEET THE REQUIREMENTS OF THE GOVERNING CODE WITH SPECIAL ATTENTION PAID TO GLAZING AT HAZARDOUS LOCATIONS PER IRC SECTION R308.
- ALL VENTED CRAWL OR ATTIC SPACES SHALL BE PROVIDED WITH VENTS TO ALLOW A FLOW OF AIR THROUGH THE SPACE. FREE VENT AREA IS TO BE AS FOLLOWS: CRAWL VENTS SHOULD EQUAL 1/150 OF GROUND AREA, ROOF VENTS 1/300 OF CEILING AREA WITH VENTS DISTRIBUTED PER THE GOVERNING BUILDING CODE. PROVIDE ACCESS OPENINGS TO CRAWL (18"x 24" MIN.) AND ATTIC (22" X 30" MIN. WITH 30" HEADROOM) OR SIZED FOR REMOVAL OF MECHANICAL EQUIPMENT IF LOCATED IN ATTIC PER IRC M1305.1.3.
- WHERE DRAWINGS OR INFORMATION IS IN CONFLICT WITH OTHER DRAWINGS OR DETAILS, THE BUILDER SHALL NOTIFY THE ARCHITECT IN WRITING PRIOR TO THE COMMENCEMENT OF CONSTRUCTION IN ORDER THAT A CLARIFICATION NOTICE CAN BE ISSUED.
- ALL COMPONENTS AND CLADDING SHALL BE ATTACHED FOR WIND SPEED REQUIREMENTS NOTED ON THIS COVER SHEET OR PER THE GOVERNING BUILDING OFFICIAL'S REQUIREMENTS.

#### 02. SITE WORK

- PRESUMED SOIL BEARING CAPACITY IS NOTED ON THIS COVER SHEET. THE BUILDER IS RESPONSIBLE FOR VERIFYING THIS BEARING CAPACITY. ALL FOOTINGS SHALL BEAR ON UNDISTURBED SOIL OR ENGINEERED FILL.
- THE BOTTOM OF ALL FOOTINGS SHALL BE BELOW THE FROST LINE AS DEFINED BY THIS COVER SHEET, THE DRAWINGS OR THE GOVERNING BUILDING OFFICIAL'S REQUIREMENTS AND/OR 12" MINIMUM.
- FOR BASEMENT CONDITIONS, THE MAXIMUM VERTICAL DISTANCE MEASURED FROM THE TOP OF A BASEMENT FLOOR SLAB TO THE OUTSIDE FINISHED GRADE SHALL NOT EXCEED DISTANCES FOR THE WALL THICKNESS AS SHOWN IN IRC TABLES R-404.1.1 (1-4) OR R-404.1.2 (1-9) BASED ON WALL TYPE AND SOIL CLASS.
- DO NOT BACKFILL UNTIL WALLS HAVE CURED AND THE ENTIRE BUILDING STRUCTURE ABOVE IS IN PLACE. BACKFILL SHALL BE CLEAN GRANULAR FILL, FREE OF ORGANIC MATERIAL, PLACED EQUALLY ON ALL SIDES, COMPACTED TO 95% MAXIMUM DRY DENSITY PER ASTM D698.
- FINISHED GRADE SHALL SLOPE AWAY FROM THE BUILDING AT A MINIMUM SLOPE OF 6 INCHES PER FOR A MINIMUM DISTANCE OF 10 FEET FROM THE BUILDING PER IRC SECTION R401.3.
- TERMITE TREATMENT - TREAT INTERIOR AND EXTERIOR EARTH AT PERIMETER WITH EPA APPROVED TERMICIDE. SPRAY BORA-CARE OR EQ TERMICIDE & MOLD TREATMENT ON STUDS 3 FEET ABOVE SLABS PER MANUFACTURER'S RECOMMENDATIONS. PROVIDE TERMITE SHIELDS WHERE SHOWN ON PLANS.

#### 03. CAST-IN-PLACE CONCRETE

- CONCRETE SHALL HAVE A MINIMUM 28-DAY COMPRESSIVE STRENGTH OF 3,000 PSI. EXTERIOR SLABS TO BE 3,000 PSI, MIN. 5% & MAX. 7% AIR ENTRAINED CONCRETE.
- CONCRETE PLACEMENT SHALL COMPLY WITH RECOMMENDATIONS OF ACI 332.
- CONCRETE SLABS SHALL HAVE POLYPROPYLENE FIBER ADDITIVE (1.5 LB/CY) OR WVF REINFORCEMENT 6 X 6, W1.4 X W1.4 PER ASTM A 185 LOCATED MIDWAY THROUGH THE SLAB THICKNESS. ALL SLABS ARE TO BEAR ON COMPACTED FILL TESTED FOR 95% MAXIMUM DRY DENSITY PER ASTM D698.
- REINFORCING STEEL WHERE SHOWN ON PLANS SHALL CONFORM TO ASTM A615, GRADE 60 MIN., DEFORMED.
- PROVIDE A 6 MIL POLYETHYLENE MOISTURE VAPOR BARRIER MEMBRANE UNDER INTERIOR AND GARAGE CONCRETE SLABS AND FOOTINGS WHERE INDICATED ON THE DRAWINGS. LAP SHEETS 6" MIN. AT JOINTS.
- COVERED PORCHES SLABS SHALL SLOPE AT A MINIMUM SLOPE OF 1/8" PER FOOT TO DRAIN WATER AWAY FROM EXTERIOR WALLS. UNCOVERED PATIO SLABS SHALL SLOPE AT 1/4" PER FOOT.

#### 04. MASONRY

- CONCRETE MASONRY UNITS (CMU) SHALL CONFORM TO ASTM C90, GRADE N, NORMAL WEIGHT UNITS.
- MORTAR TO BE TYPE "M" WITH A 28 DAY COMPRESSIVE STRENGTH OF 2,000 PSI. PROVIDE CONTINUOUS HORIZONTAL JOINT REINFORCING EVERY OTHER COURSE. MORTAR TO MEET ASTM C270 STANDARDS.
- GROUT SHALL MEET THE REQUIREMENTS OF ASTM C476 WITH A 28 DAY COMPRESSIVE STRENGTH OF 2,500 PSI. GROUT ALL CELLS RECEIVING ANCHORS AND THE TOP COURSE OF ALL BEARING WALLS.
- FACE BRICK SHALL BE STANDARD SIZE AND COMPLY WITH ASTM C216, RUNNING BOND WITH TOOLED JOINT APPLICATION. SECURE BRICK VENEER TO WALL STUDS WITH 22 GA. GALV. METAL TIES ATTACHED TO STUDS WITH 8d WALLS SPACING AS SHOWN ON PLANS.
- APPLY A BITUMINOUS WATERPROOF MEMBRANE TO THE EXTERIOR OF ALL BASEMENT WALLS TO BE BELOW GRADE AFTER BACKFILLING.
- MANUFACTURED STONE WHERE SHOWN ON PLANS, SHALL BE INSTALLED IN STRICT ACCORDANCE WITH MANUFACTURER'S INSTALLATION INSTRUCTIONS AND DETAILS AND THE MASONRY VENEER MANUFACTURERS ASSOCIATION (MVMA) "INSTALLATION GUIDE AND DETAILING OPTIONS FOR COMPLIANCE WITH ASTM C1780.

#### 05. STRUCTURAL STEEL

- STEEL BEAMS AND PLATES SHALL CONFORM WITH ASTM A36. STEEL COLUMNS SHALL CONFORM TO ASTM A53.
- ALL STRUCTURAL STEEL SHALL BE INSTALLED IN ACCORDANCE WITH CURRENT AISC SPECIFICATIONS AND "STEEL CONSTRUCTION MANUAL." ALL PIPE COLUMNS SHALL BE STANDARD WEIGHT STEEL COLUMNS IN ACCORDANCE WITH ASTM A500 AND FINISHED WITH CORROSION RESISTANT COATING PER ASTM B117. STEEL COLUMNS AT BASEMENT LOCATIONS SHALL PENETRATE THE BASEMENT SLAB DOWN TO THE TOP OF THE COLUMN FOOTING BELOW SLAB.
- ALL BRICK STEEL LINTELS SHALL BE SIZED PER STRUCTURAL DRAWINGS ON SHEET SD1.

#### 06. WOOD

- FRAMING LUMBER SHALL BE IDENTIFIED BY A GRADE MARK OR CERTIFICATE OF INSPECTION WHICH PROVIDES THE FOLLOWING MINIMUM DESIGN VALUES:

MEMBER	GRADE	VALUES
FRAMING LUMBER	HEM/SYP/SPF #2 OR BETTER	Fb = 875 PSI
PRESSURE TREATED LUMBER	SYP #2 OR BETTER	Fb = 975 PSI
PLATES	HEM/SYP/SPF #3	Fc = 425 PSI
BLOCKING	STANDARD	Fb = 275 PSI
- CONSTRUCTION SHALL BE IN ACCORDANCE WITH THE AMERICAN WOOD COUNCIL (AWC), "WOOD FRAME CONSTRUCTION MANUAL" (WFCM) AND SHALL COMPLY WITH IRC R301.1 TO SUPPORT AND TRANSFER ALL LOADS SAFELY TO THE FOUNDATION.
- THE DESIGN LOADS FOR PREFABRICATED WOOD TRUSSES ARE PER THESE SPECS., THE GOVERNING BUILDING CODE AND CURRENT EDITIONS OF TPI-1 AND NDS. THE TRUSS MANUF. SHALL PROVIDE SHOP DRAWINGS, SEALED BY A STATE-LICENSED DESIGN PROFESSIONAL, FOR APPROVAL PRIOR TO FABRICATION. INSTALL TRUSSES AND ENGINEERED LUMBER IN STRICT ACCORDANCE WITH THE SHOP DRAWINGS AND WTCA-B1 AND WTCA-B2. ALL POINT LOADS, PARTIAL UNIFORM LOADS OR COMBINATIONS THEREOF SHALL BE DETERMINED BY THE TRUSS MANUFACTURER AND ACCOUNTED FOR IN THE DESIGN OF THE ROOF AND/OR FLOOR SYSTEM.
- PREFABRICATED WOOD JOISTS SHALL BE RATED PER ASTM D5055 AND INSTALLED PER SHOP DRAWINGS AND DETAILS PROVIDED BY THE MANUFACTURER.
- HANGERS, ANCHORS AND FASTENERS, WHEN CALLED FOR IN SHOP DRAWINGS OR THESE DRAWINGS, SHALL BE INSTALLED IN COMPLIANCE WITH THE MANUFACTURER'S INSTRUCTIONS.
- ALL HANGERS, FRAMING ANCHORS AND FASTENERS IN CONTACT WITH PRESSURE TREATED WOOD TO BE STAINLESS STEEL OR GALVANIZED PER G185 RATING "Z-MAX" COATING BY SIMPSON OR "TRIPLE ZINC" BY USP.
- BEAMS AND HEADERS ARE TO BEAR ON JACK STUDS AS NOTED ON THE PLANS, SHOP DRAWINGS, OR PER CODE. PROVIDE SOLID BLOCKING BELOW ALL JACK STUDS FORMING A CONTINUOUS BEARING LINE TO THE FOUNDATION.
- ALL LUMBER IN CONTACT WITH EARTH, CONCRETE OR MASONRY SHALL BE PRESSURE TREATED. FIELD TREAT SAWED, DRILLED OR NOTCHED TREATED LUMBER PER AWP4 M4-11.
- PROVIDE STRUCTURAL SHEATHING WHERE NOTED ON PLANS. ALL WOOD SHEATHING SHALL BE APA RATED FOR INTENDED USE AND SUPPORT SPANS. INSTALL ROOF SHEATHING WITH "H" CLIPS BETWEEN TRUSSES.
- INSTALL FIREBLOCKING PER R302.11 TO CUT OFF DRAFT OPENINGS AT ALL INTERCONNECTIONS BETWEEN CONCEALED VERTICAL AND HORIZONTAL SPACES, BETWEEN STORIES, AND BETWEEN THE TOP STORY AND ROOF.
- STUDS FOR EXTERIOR WALLS SHALL BE SIZED PER THE INTERNATIONAL RESIDENTIAL CODE, TABLE R602.3.1
- ALL NOTCHES AND CUTS IN FRAMING SHALL NOT EXCEED MAX. DIMENSIONS AS DEFINED IN THE IRC R602.6.

#### 07. THERMAL AND MOISTURE PROTECTION

- INSTALL INSULATION MATERIALS TO MEET THE "R" VALUES AS SHOWN ON THE DRAWINGS. FIT INSULATION TIGHT INTO SPACES AND LEAVE NO GAPS OR VOIDS. PROVIDE RIGID INSULATION WHERE SHOWN ON PLANS. AT INTERIOR WALLS SEAL ALL JOINTS, SEAMS AND PENETRATIONS TO PREVENT AIR LEAKAGE PER R1102.4.
- INSTALL FIBERGLASS/ASPHALT ROOF SHINGLES IN ACCORDANCE WITH MANUF. INSTRUCTIONS AND ASPHALT ROOFING MANUFACTURERS ASSOC. "ASPHALT ROOFING RESIDENTIAL MANUAL." SHINGLES ARE TO BE CERTIFIED MIN. CLASS C FIRE RESISTANCE PER ASTM E108 OR UL 790 AND WIND RESISTANCE CLASS PER ASTM D 3161 OR D7158 FOR WIND SPEED. INSTALL UNDERLAYMENT PER ROOF SLOPE AND IRC R905.2.2 AND CONFORMING TO ASTM D226 TYPE I.
- INSTALL FLASHING, SHEET METAL, GUTTERS AND DOWNSPOUTS PER PLANS AND PER "ASPHALT ROOFING RESIDENTIAL MANUAL" AND "ARCHITECTURAL SHEET METAL MANUAL" BY SMOACMA. INSTALL FLASHING AT ALL ROOF TO WALL CONDITIONS, EXTERIOR OPENINGS AND ELSEWHERE WHERE REQUIRED.
- INSTALL A WATER-RESISTIVE BARRIER ON ALL WALLS. HOUSEWRAPS SHOULD MEET ASTM D5034 FOR DURABILITY, D779 FOR WATER RESISTANCE AND E96 FOR PERMEABILITY AND BE INSTALLED PER MANUF. INSTALLATION INSTRUCTIONS. PRE-WEATHERIZED SHEATHING SHALL BE TAPED AND SECURED PER MANUF. INSTALLATION INSTRUCTIONS.
- INSTALL SIDING AND ACCESSORY COMPONENTS IN STRICT ACCORDANCE WITH MANUFACTURER'S INSTRUCTIONS. WIND PRESSURE RESISTANCE TO BE DETERMINED BY ASTM E330.

#### 08. DOORS, WINDOWS AND GLASS

- INSTALL DOORS IN ACCORDANCE WITH MANUFACTURER'S WRITTEN INSTALLATION RECOMMENDATIONS.
- ALL ALUMINUM AND/OR VINYL (PVC) AND/OR WOOD WINDOWS AND DOORS SHALL CONFORM TO CLASS R WITH DP PERFORMANCE GRADE AS NOTED ON THE COVER SHEET, TESTED PER AAMA/WDMA/CSA 101/1.5.2/A440 FOR THE APPLICABLE WINDOW AND DOOR TYPES SHOWN ON THE DRAWINGS. INSTALL TEMPERED GLASS AND WINDOWS WHERE NOTED ON PLANS OR AS REQUIRED BY CODE. ENERGY PERFORMANCE RATINGS FOR U VALUES AND SHGC SHALL BE AS NOTED ON THE COVER SHEET AND TESTED PER NFRC 100 AND NFRC 200 RESPECTIVELY.
- INSTALLATION AND FLASHING OF WINDOWS AND DOORS TO BE IN ACCORDANCE WITH MANUFACTURERS WRITTEN INSTALLATION INSTRUCTIONS AND ASTM E2112.
- INSECT SCREENS TO BE IN ACCORDANCE WITH ANSI/SMA 1004, ANSI/SMA 2006, OR ANSI/SMA 3001.
- PROVIDE AND INSTALL HARDWARE PER OWNER'S SCHEDULE.
- GARAGE DOORS SHALL BE CERTIFIED IN ACCORDANCE WITH ASTM/DASMA 108 FOR THE APPLICABLE WIND PRESSURES AS NOTED ON THE COVER SHEET.

#### 09. FINISHES

- GYPSON WALL BOARD, GYPSON SHEATHING MATERIALS AND ACCESSORIES SHALL BE INSTALLED IN ACCORDANCE WITH IRC R702.3 AND WITH GA-253 "APPLICATION OF GYPSON SHEATHING" PUBLISHED BY THE GYPSON ASSOCIATION.
- INSTALL FLOOR COVERINGS AS SHOWN ON PLANS OR PER OWNER'S SCHEDULE PER MANUF. INSTALLATION INSTRUCTIONS.

#### 10. SPECIALTIES

- PROVIDE KITCHEN AND BATH CABINETS FIXTURES AND APPLIANCES, FIREPLACE, HARDWARE AND MISC. ITEMS PER OWNERS SCHEDULE. INSTALLATIONS TO BE IN ACCORDANCE WITH APPROVED SHOP DRAWINGS AND MANUFACTURER'S INSTALLATION INSTRUCTIONS. PRE-FAB FIREPLACES TO BE UL LISTED AND COMPLY WITH UL 127.

#### 11-14. N/A

#### 15. MECHANICAL

- INSTALL VENTILATORS AND HEATING AND AIR CONDITIONING SYSTEMS AS SHOWN ON PLANS OR PER OWNER'S SCHEDULE. SIZE ALL EQUIPMENT PER ACCA MANUAL S AND J AND INSTALL FOR FUTURE ACCESS SERVICE AND REMOVAL. PROVIDE COMBUSTION AIR WHEN REQUIRED PER M1701. ALL DUCTWORK AND PIPING LOCATED IN UNCONDITIONED SPACES SHALL BE INSULATED AND SEALED PER CODE. INSTALL DRYER DUCT TO OUTSIDE WITH SMOOTH METAL DUCTING WITHOUT SCREWS AND WITH MINIMUM BENDS, MAXIMUM DUCT LENGTH PER IRC M1502.
- VENTING: ALL DRYERS AND BATH EXHAUSTS MUST BE VENTED DIRECT TO THE EXTERIOR OF THE STRUCTURE WITH A BACKDRAFT DAMPER IN ACCORDANCE WITH THE CURRENT CODE.
- PROVIDE A PROGRAMMABLE THERMOSTAT, MANUALS FOR MECHANICAL AND WATER HEATING EQUIPMENT, ENERGY COMPLIANCE CERTIFICATE AND ALL OTHER REQUIREMENTS OF THE CURRENT ENERGY CODE.

#### 16. ELECTRICAL

- TERMINAL HOOK UP IS REQUIRED FOR ALL FIXTURES, APPLIANCES, MOTORS, FANS AND CONTROLS. LOCATION OF OUTLETS AND EQUIPMENT ON PLANS IS APPROXIMATE, EXACT ROUTING OF WIRING AND OUTLETS SHALL BE GOVERNED BY STRUCTURAL CONDITIONS AND OBSTRUCTIONS.
- ALL ELECTRICAL BREAKERS AND CONTROLS SHALL BE PROPERLY LABELED. INSTALL GFCI PROTECTED AND AFCI OUTLETS WHERE SHOWN ON PLANS OR AS REQUIRED BY CODE. MATERIALS AND EQUIPMENT SHALL BEAR A UL LABEL. LIGHT FIXTURES MUST MEET CLEARANCES STATED IN THE NEC. INSTALL LIGHT SWITCHES AT 3' 6" A.F.F. AND OUTLETS 12" A.F.F. TO CENTERLINE U.N.O.
- INSTALL ELECTRIC SMOKE DETECTORS, CARBON MONOXIDE/ALARMS WHERE SHOWN ON PLANS. ALL DETECTORS MUST BE INTER-CONNECTED AND INCORPORATE A BATTERY BACK-UP. INSTALL PER NFPA 72 AND UL 217 REQUIREMENTS. CO ALARMS TO COMPLY WITH NFPA 720 AND UL 2034. COMBINATION SMOKE/CO ALARMS MUST BE LISTED PER UL 2034.
- PROVIDE HIGH EFFICACY LAMPS IN PERMANENT FIXTURES PER CURRENT ENERGY CODE.

#### 17. PLUMBING

- INSTALL PLUMBING FIXTURES, SUPPLY AND WASTE LINES PER GOVERNING CODE. ALL NOTCHES AND CUTS IN FRAMING SHALL NOT EXCEED MAX. DIMENSIONS AS DEFINED IN THE BUILDING CODE. PROTECT PLUMBING LINES AND REINFORCE STUD WALL NOTCHES WITH 16 GA. METAL PLATES.

### BUILDING CODE SUMMARY

Location: Various Locations, NC Market  
Proposed Use: Detached Single Family Dwelling  
Owner: Chesapeake Homes  
Contact Person: Brad Blough Telephone #: (919) 256-3060 E-mail: bblough@cheshomes.com

#### DESIGNER OF RECORD:

Designer	Name	License #	Telephone #	E-mail:
Architect	James W. Wentling	NC-Arch. # 4642	(215) 568-2551	JamesWentling@wentlinghouseplans.com
Structural:	Jonathan A. Troxler	NC-P.E. # 27845	(919) 878-1617	jtroxler@southernengineers.com

#### BUILDING DATA:

Year Edition of Code: 2018 North Carolina State Residential Code (2015 IRC with North Carolina Amendments)

#### DESIGN LOADS:

Roof Live Load:	20 PSF	Attic With Permanent Stair:	40 PSF
Floor Live Load:	40 PSF	Attic Without Permanent Stair:	20 PSF
Floor Live Load Sleeping Rooms:	30 PSF	Attic Without Storage:	10 PSF

#### CLIMATIC & GEOGRAPHIC DESIGN CRITERIA:

Ground Snow Load:	20 PSF	Exposure:	B	Design Pressure:	20
Design Wind Speed:	115-120 MPH	Risk Group:	II	Walls:	35
Seismic Site Class:	C			Roof:	20
Seismic Design Category:	B			Windows + Doors:	20
Weathering:	Moderate to Heavy				
Frost Line:	12"				
Termite Decay:	4A				
Winter Design Temp.:					
Climate Zone:					

#### ENERGY EFFICIENCY:

Minimum Insulation:

Ceiling:	R-38 (R-30 w/ Raised Heel Truss)
Walls:	R-15
Floors:	R-19
Slab:	R-0 (Per Southern Energy)
Glazing U' Value:	0.35 Max.
SHGC:	0.30 Max.

(Note: Minimum insulation values per Southern Energy Reports)

#### SOIL BEARING CAPACITIES:

Presumptive Bearing Capacity: 2,000 PSF

ABBREVIATIONS			
TEXT	DESCRIPTION	TEXT	DESCRIPTION
A.F.F.	: ABOVE FINISHED FLOOR	MANUF.	: MANUFACTURER
ALUM.	: ALUMINUM	MAX.	: MAXIMUM
BRG.	: BEARING	MIN.	: MINIMUM
C	: CARPET	O.C.	: ON CENTER
CLG.	: CEILING	OPT.	: OPTIONAL
C.J.	: CEILING JOISTS	OSB	: ORIENTED STRAND BOARD
CONC.	: CONCRETE	P.T.	: PRESSURE TREATED
COND.	: CONDITION	R.	: RISERS
DBL.JST.	: DOUBLE JOIST	REF.	: REFRIGERATOR
DIA.	: DIAMETER	REQ.	: REQUIRED
DWG.	: DRAWING	R & S	: ROD AND SHELF
E.M.	: ELECTRIC METER	R.R.	: ROOF RAFTERS
ENG.	: ENGINEERED	R.T.	: ROOF TRUSSES
E.P.	: ELECTRICAL PANEL	S.C.	: SOLID CORE
EQ.	: EQUAL	S.S.	: SELECT STRUCTURAL
EXT.	: EXTERIOR	SHOW.	: SHOWER
FOUND.	: FOUNDATION	S.L.	: SIDE LITE
FTG.	: FOOTING	SPEC.	: SPECIFICATIONS
H.P.D.	: HINGED PATIO DOOR	T.	: TREADS
H.	: HIGH	TEMP.	: TEMPERED
HB	: HOSE BIBB	T.O.F.	: TOP OF FOUNDATION
INCL.	: INCLUDED	TYP.	: TYPICAL
INT.	: INTERIOR	U.N.O.	: UNLESS NOTED OTHERWISE
J.M.	: JOIST MANUFACTURER	V	: VINYL
J.S.	: JACK STUDS	W/	: WITH

JAMES WENTLING/  
ARCHITECT

LAND TITLE BUILDING  
100 SOUTH BROAD STREET,  
SUITE 1524  
PHILADELPHIA, PA 19110

(215) 568-2551  
email - information@  
wentlinghouseplans.com

ARCHITECTURE

LAND PLANNING

GRAPHICS

THESE PLANS ARE COPYRIGHTED AND ARE SUBJECT TO COPYRIGHT PROTECTION AS AN "ARCHITECTURAL WORK" UNDER SECTION 107 OF THE COPYRIGHT ACT, 17 U.S.C. AS AMENDED DECEMBER 1, 1990 AND KNOWN AS THE "ARCHITECTURAL WORKS" COPYRIGHT PROTECTION ACT OF 1990. THE PROTECTION INCLUDES BUT IS NOT LIMITED TO, THE OVERALL FORM AS WELL AS THE ARRANGEMENT AND COMPOSITION OF SPACES AND ELEMENTS OF THE DESIGN. UNDER SUCH PROTECTION, UNAUTHORIZED USE OF THESE PLANS, WORKS, OR FORMS REPRESENTED CAN LEGALLY RESULT IN THE CESSATION OF SUCH CONSTRUCTION OR BUILDINGS BEING SEIZED AND/OR RAISED.

© Copyright 2016 James Wentling/ Architect



#### REVISIONS

MARK	DATE	DESCRIPTION
DN	01-10-19	CONVERT OLAHS
DN	02-14-19	STRUCT. DWGS. REV.
CH	12-10-19	ADD KINGST. ELEV. D + E
CH	05-18-20	ELEV. F + SUNRM. W/ COV.
DN	04-04-24	CONVERT I13-69/ADD OPT. BATH #2 LM

#### PROJECT NO.

113-88

#### DATE

01-13-16

#### SCALE

NO SCALE

#### DRAWN BY

JIB

#### CHECKED BY

JW

#### ISSUED FOR

PERMITS/CONSTRUCTION

#### PROJECT TITLE

MODEL 628 -  
GARAGE LEFT

CLIENT  
**CHESAPEAKE  
HOMES OF NC**

3100 Smoketree Court,  
Suite 210  
Raleigh, NC 27604  
(919) 256-3060  
(919) 556-0690 Fax


#### DRAWING TITLE

CONTENTS AND PROJECT  
INFORMATION


#### SHEET

1



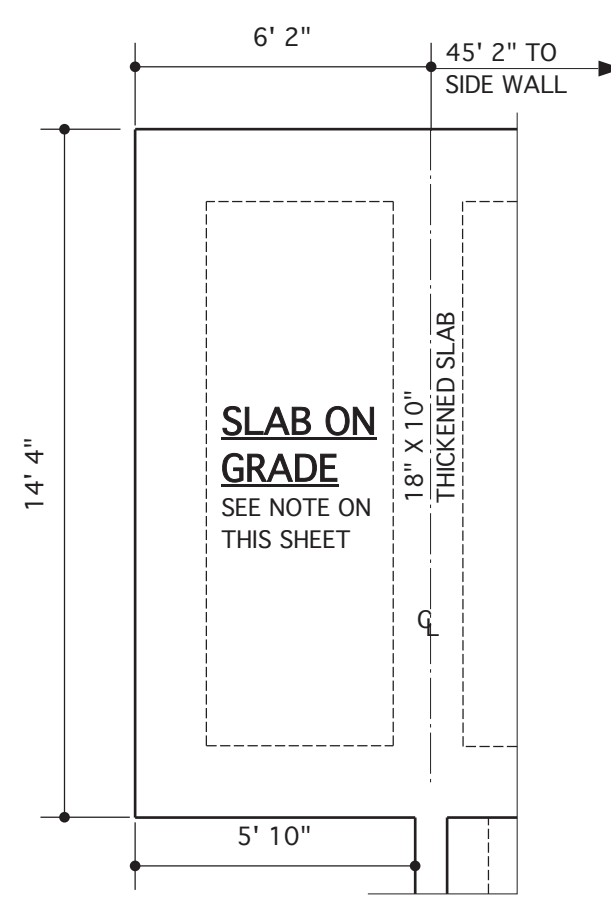


**@ OPT. COVERED PORCH**  
SCALE 1/4" = 1'-0"

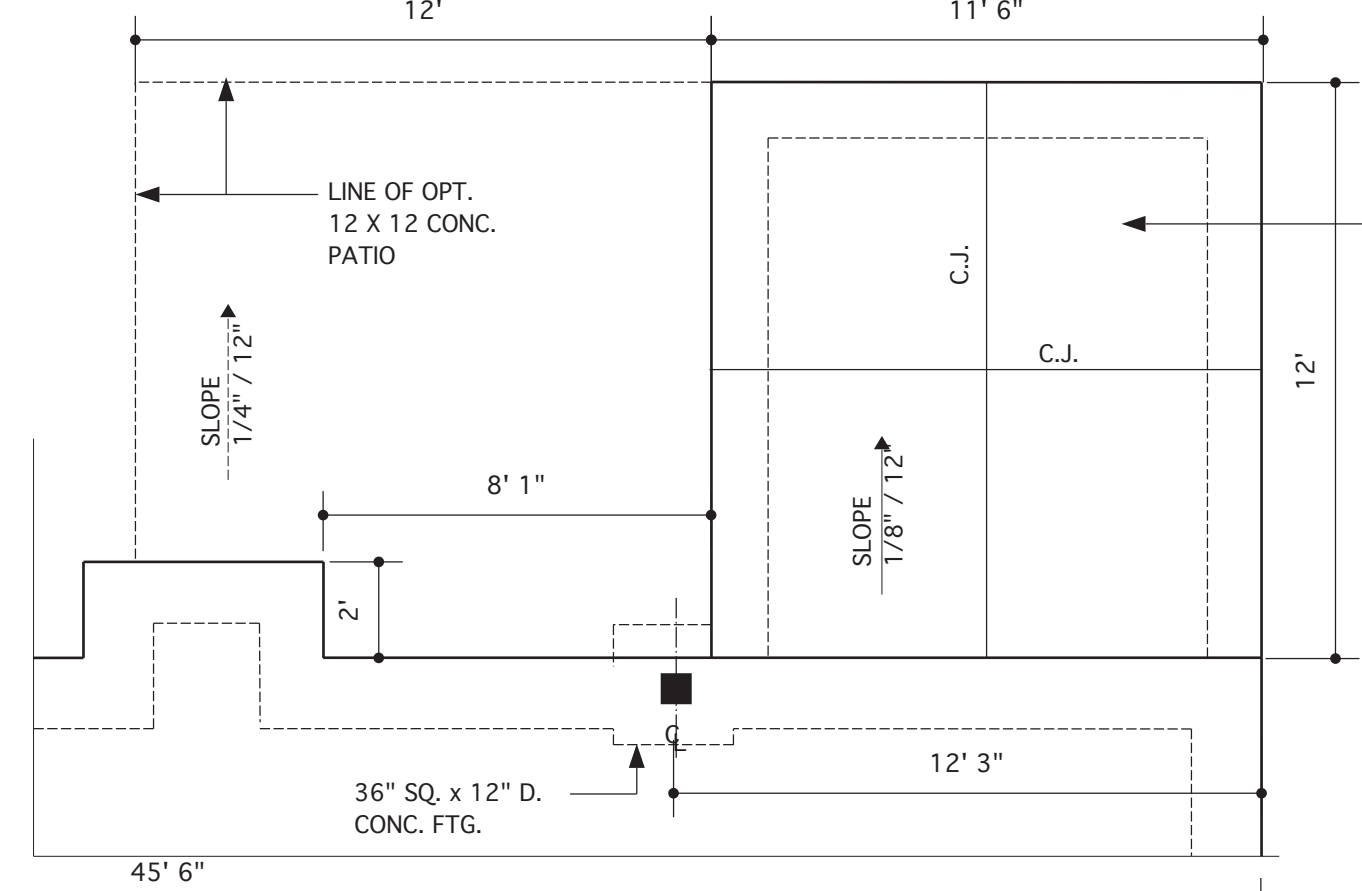


**PORCH**  
4" CONC. PORCH SLAB OVER COMP. POROUS FILL - MIN. 5%, MAX. 7% AIR-ENTRAINED CONC. MIN. 3,000 PSI CONC.

**@ OPT. BATH #1**  
SCALE 1/4" = 1'-0"

NOTE: SEE SHEET 2.0 FOR OPT. BATHROOM W/ OPT. SIDE-LOAD GARAGE

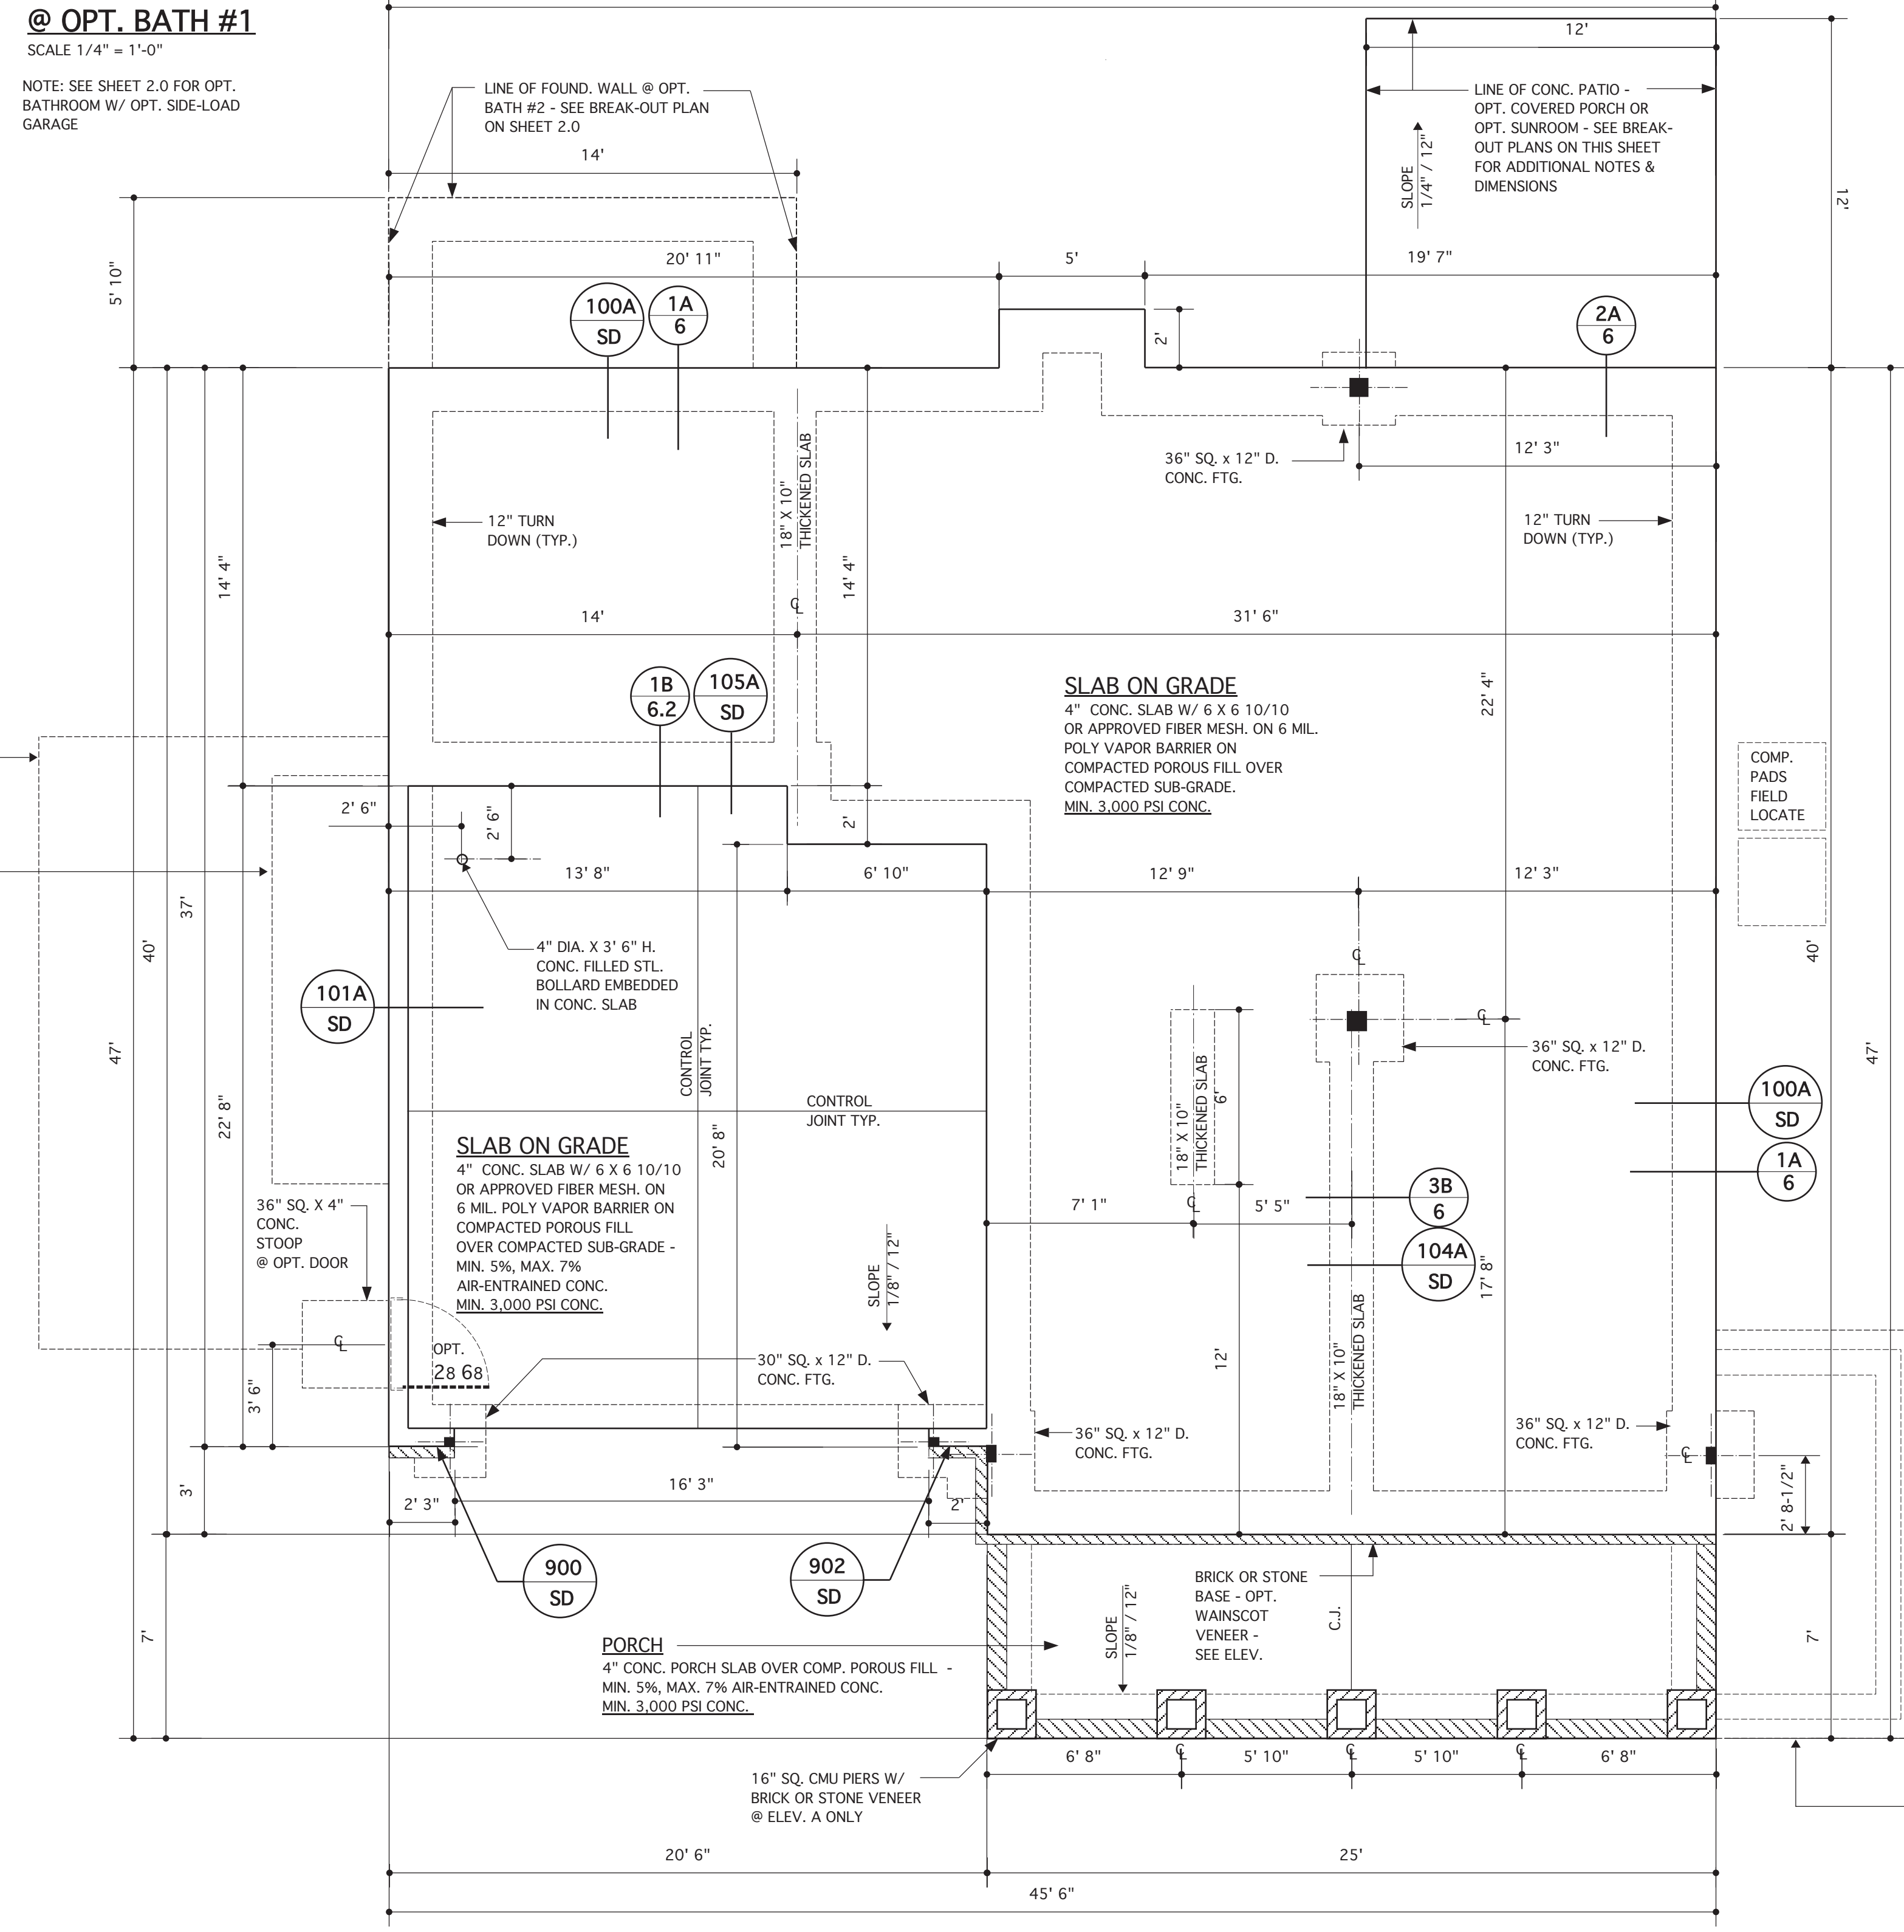


**MONOLITHIC SLAB FOUNDATION PLAN**  
SCALE 1/4" = 1'-0"

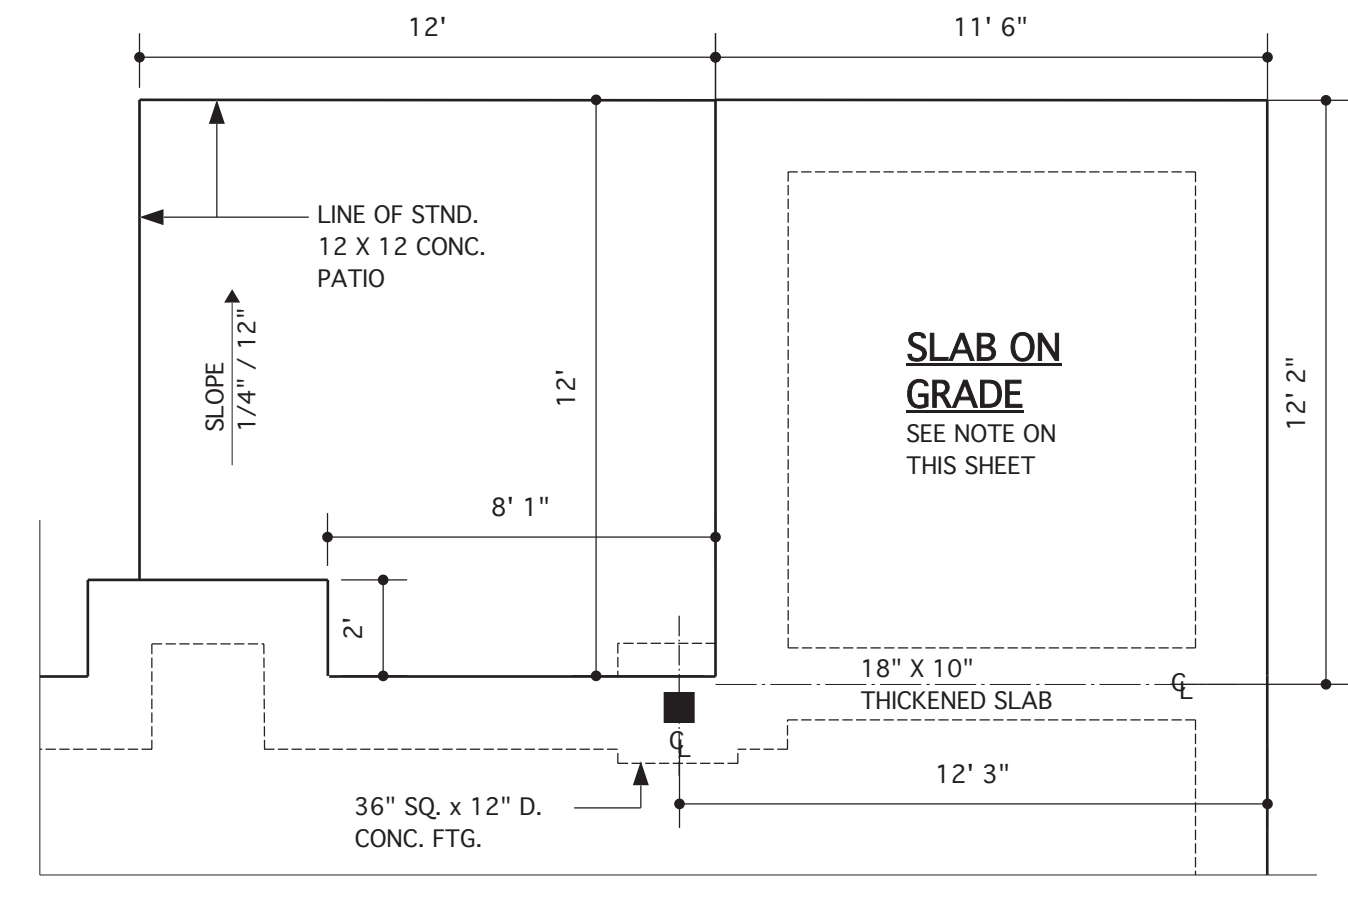


**@ OPT. SUNROOM**  
SCALE 1/4" = 1'-0"

**PORCH**  
4" CONC. PORCH SLAB OVER COMP. POROUS FILL - MIN. 5%, MAX. 7% AIR-ENTRAINED CONC. MIN. 3,000 PSI CONC.

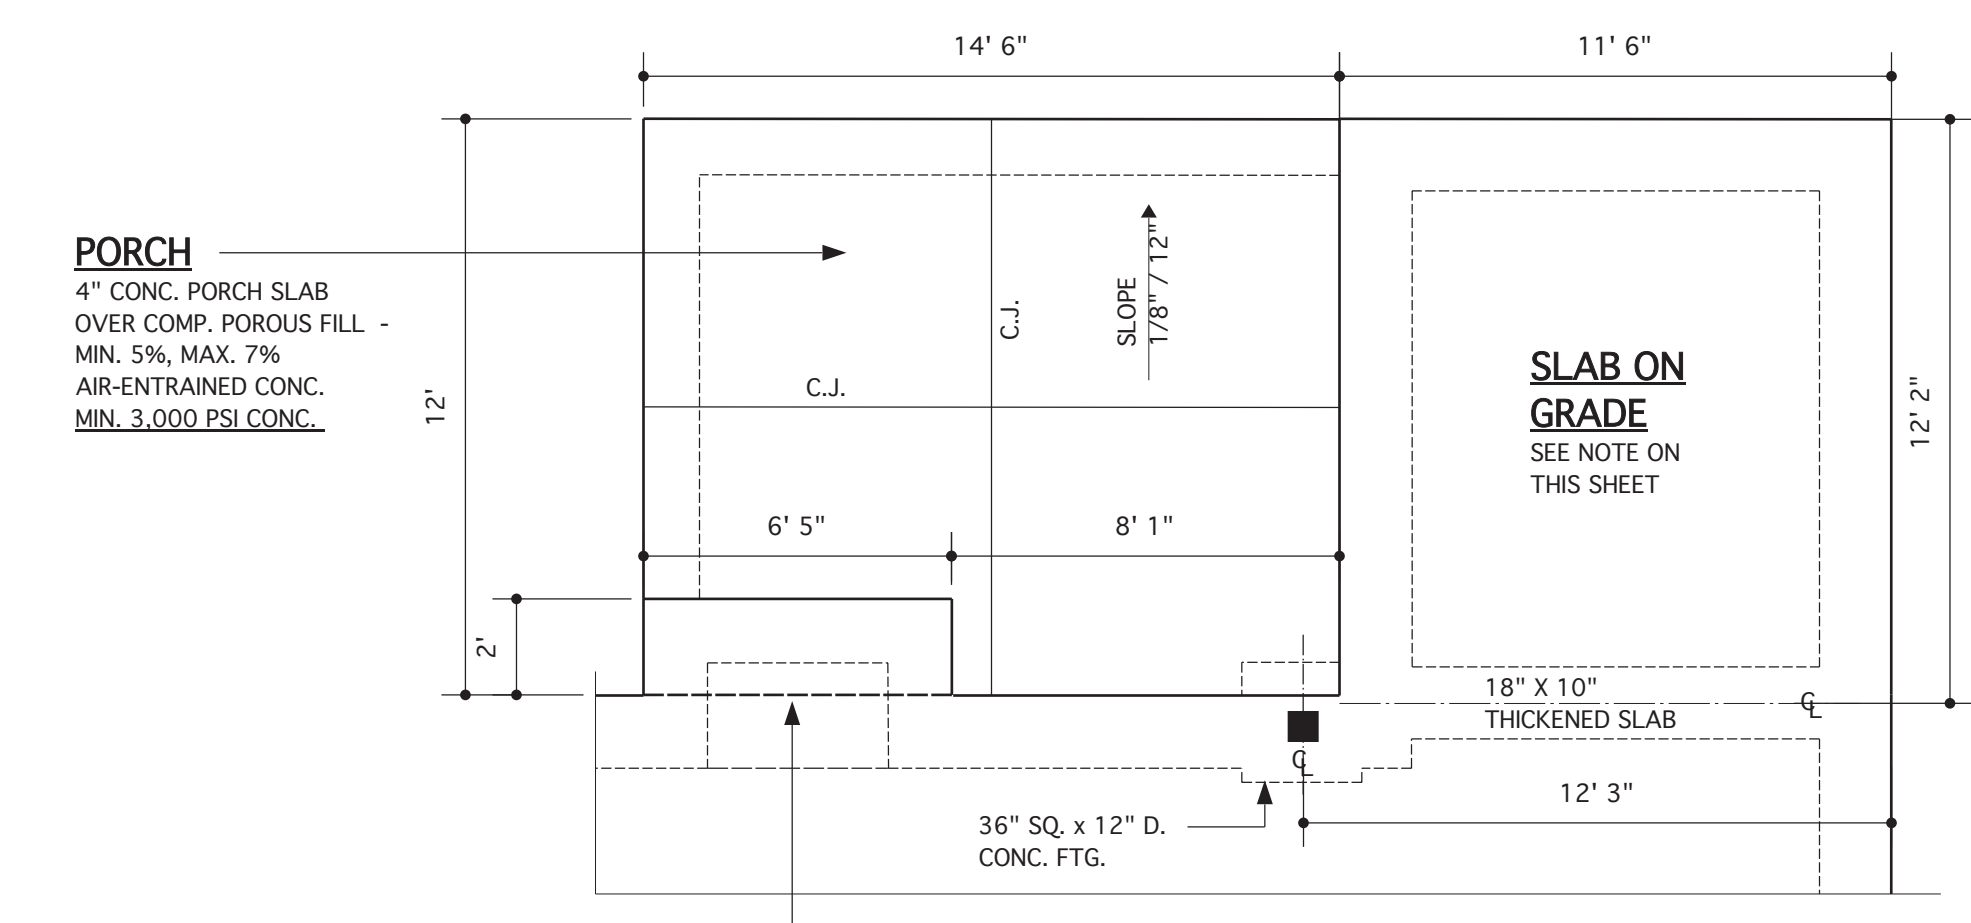

**@ OPT. SUNROOM W/ OPT. COVERED PORCH**  
SCALE 1/4" = 1'-0"

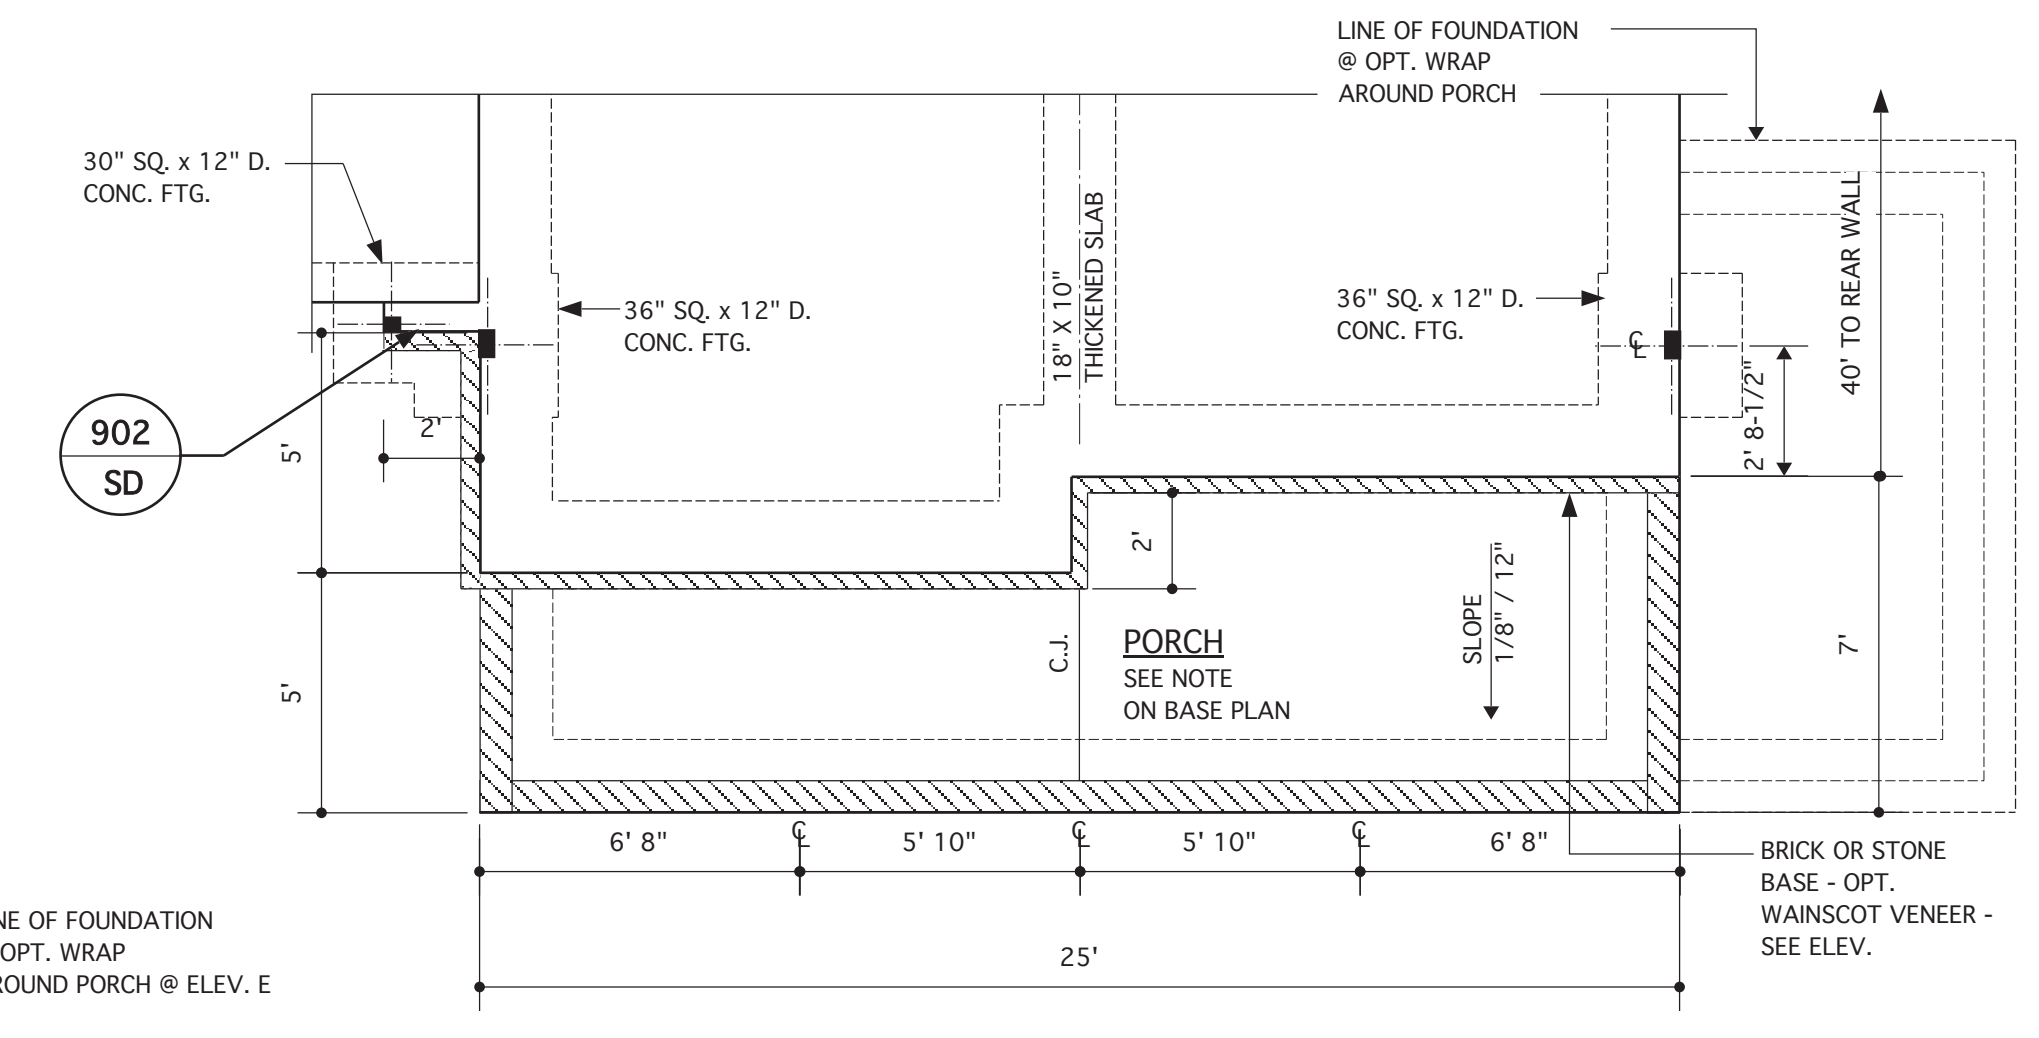

**@ ELEV. D**  
SCALE 1/4" = 1'-0"


STRUCTURAL DESIGN BY:  
SOUTHERN ENGINEERS, P.A.  
3716 BENSON DR., RALEIGH, NC 27609  
LICENSE: C-1287, PHONE: 919-878-1617  
PROJECT # 19-1059

\* Engineers seal applies only to structural components on this document. Seal does not include construction means, methods, techniques, sequences, procedures or safety precautions.

\* Any deviations or discrepancies on plans are to be brought to the immediate attention of Southern Engineers. Failure to do so will void Southern Engineer's liability.

\* Seal is valid for a project permitted within one year from date of seal.

\* Use of these plans constitutes approval of terms & conditions as defined in the customer agreement.

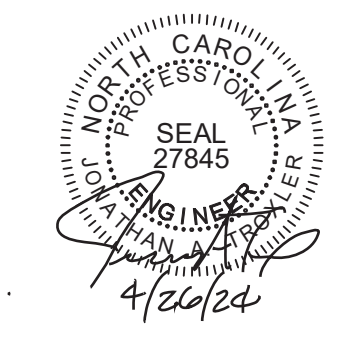

REFER TO "SD" SHEET(S) FOR STANDARD DETAILS, BRACING DETAILS AND STRUCTURAL NOTES.

**JAMES WENTLING/ ARCHITECT**

LAND TITLE BUILDING  
100 SOUTH BROAD STREET,  
SUITE 1524  
PHILADELPHIA, PA 19110

(215) 568-2551  
email - information@wentlinghouseplans.com

ARCHITECTURE  
LAND PLANNING  
GRAPHICS

THESE PLANS ARE COPYRIGHTED AND ARE SUBJECT TO COPYRIGHT PROTECTION AS AN "ARCHITECTURAL WORK" UNDER SECTION 102 OF THE COPYRIGHT ACT, 17 U.S.C., AS AMENDED DECEMBER 1, 1990 AND KNOWN AS THE "ARCHITECTURAL WORKS COPYRIGHT PROTECTION ACT OF 1990". THE PROTECTION INCLUDES BUT IS NOT LIMITED TO, THE OVERALL FORM AS WELL AS THE ARRANGEMENT AND COMPOSITION OF SPACES AND ELEMENTS OF THE DESIGN. UNDER SUCH PROTECTION, UNAUTHORIZED USE OF THESE PLANS, WORKS, OR FORMS REPRESENTED CAN LEGALLY RESULT IN THE CESSION OF SUCH CONSTRUCTION OR BUILDINGS BEING SEIZED AND/OR RAISED.

REVISIONS		
MARK	DATE	DESCRIPTION
DN	01-10-19	CONVERT OLAHS
DN	02-14-19	STRUCT. DWGS. REV.
CH	12-10-19	ADD ELEV. D & E
CH	05-18-20	SUNRM. W/ COV. PORCH
DN	04-04-24	CONVERT 113-69/ADD OPT. BATH #2 LM

PROJECT NO.	113-88
DATE	01-13-16
SCALE	AS NOTED
DRAWN BY	JB
CHECKED BY	JW
ISSUED FOR	PERMITS/CONSTRUCTION

PROJECT TITLE  
**MODEL 628 - GARAGE LEFT**

CLIENT  
**CHESAPEAKE HOMES OF NC**  
3100 Smoketree Court,  
Suite 210  
Raleigh, NC 27604  
(919) 256-3060  
(919) 556-0690 Fax

DRAWING TITLE  
**MONOLITHIC SLAB FOUNDATION PLANS**


SHEET  
**2**

© Copyright 2016 James Wentling/ Architect








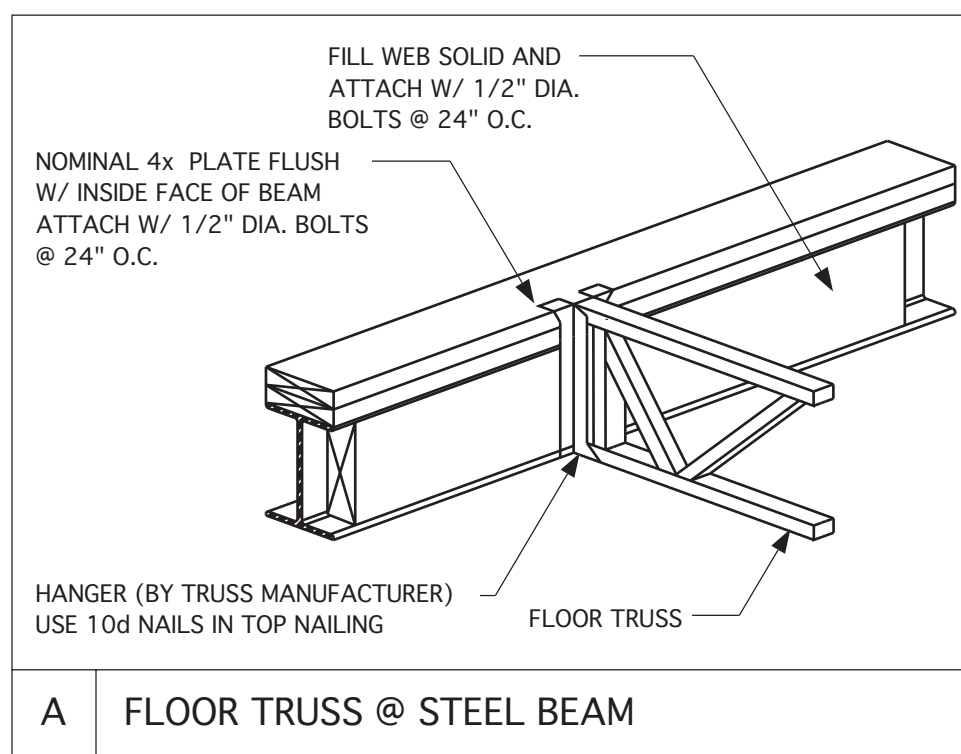


**A FLOOR TRUSS @ STEEL BEAM**

**ALT. FIREPLACE LOCATION**  
SCALE 1/4" = 1'-0" - 9'-0" CLG. U.N.O.

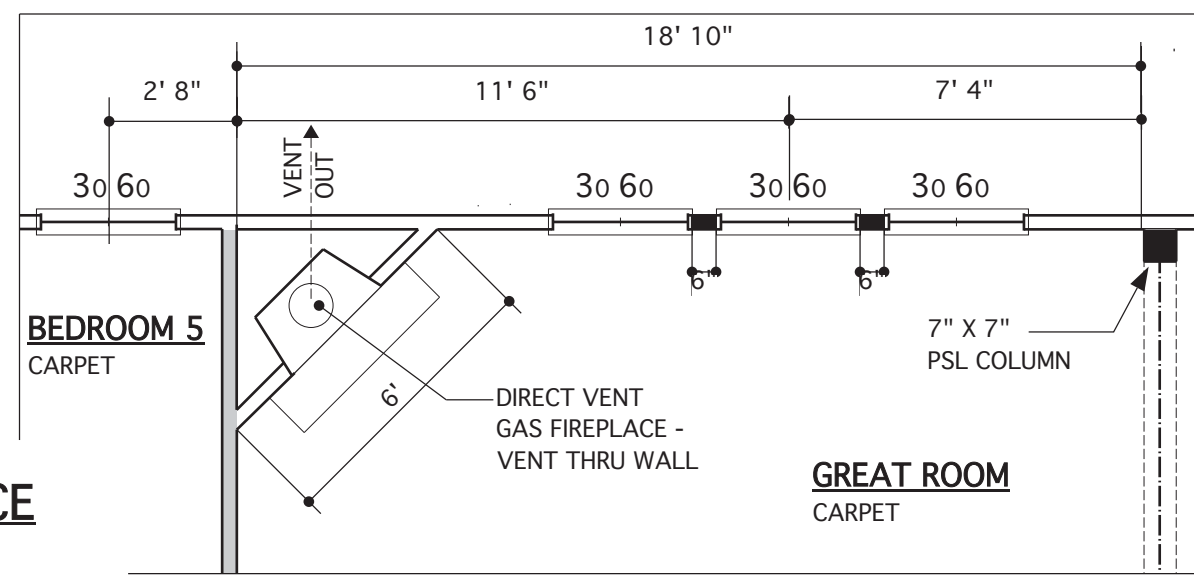

STRUCTURAL DESIGN BY:  
SOUTHERN ENGINEERS, P.A.  
3716 BENSON DR., RALEIGH, NC 27609  
LICENSE: C-1287, PHONE: 919-878-1617  
PROJECT # 19-1059

- \* Engineers seal applies only to structural components on this document. Seal does not include construction means, methods, techniques, sequences, procedures or safety precautions.
- \* Any deviations or discrepancies on plans are to be brought to the immediate attention of Southern Engineers. Failure to do so will void Southern Engineer's liability.
- \* Seal is valid for a project permitted within one year from date of seal.
- \* Use of these plans constitutes approval of terms & conditions as defined in the customer agreement.

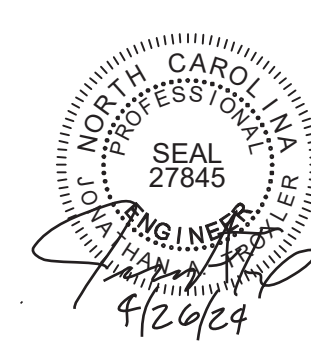

**PORTAL FRAME LEGEND**  
SEE SD SHEETS FOR PORTAL FRAME DETAILS  
APA-PF: APA PORTAL FRAME  
APA-PF-END: END CONDITION FOR APA PORTAL FRAME  
CS-PF: CONTINUOUS PORTAL FRAME CONSTRUCTION  
CS-PF-END: END CONDITION FOR CONTINUOUS PORTAL FRAME

REFER TO "SD" SHEET(S) FOR STANDARD DETAILS, BRACING DETAILS AND STRUCTURAL NOTES.

**JAMES WENTLING/ ARCHITECT**

LAND TITLE BUILDING  
100 SOUTH BROAD STREET,  
SUITE 1524  
PHILADELPHIA, PA 19110


(215) 568-2551  
email - information@wentlinghouseplans.com

ARCHITECTURE  
LAND PLANNING  
GRAPHICS


THESE PLANS ARE COPYRIGHTED AND ARE SUBJECT TO COPYRIGHT PROTECTION AS AN "ARCHITECTURAL WORK" UNDER SECTION 102 OF THE COPYRIGHT ACT, 17 U.S.C. AS AMENDED DECEMBER 1, 1990 AND KNOWN AS THE "ARCHITECTURAL WORKS" COPYRIGHT PROTECTION ACT OF 1990. THE PROTECTION INCLUDES BUT IS NOT LIMITED TO, THE OVERALL FORM AS WELL AS THE ARRANGEMENT AND COMPOSITION OF SPACES AND ELEMENTS OF THE DESIGN. UNDER SUCH PROTECTION, UNAUTHORIZED USE OF THESE PLANS, WORKS, OR FORMS REPRESENTED CAN LEGALLY RESULT IN THE CESSION OF SUCH CONSTRUCTION OR BUILDINGS BEING SEIZED AND/OR RAISED.




© Copyright 2016 James Wentling/ Architect

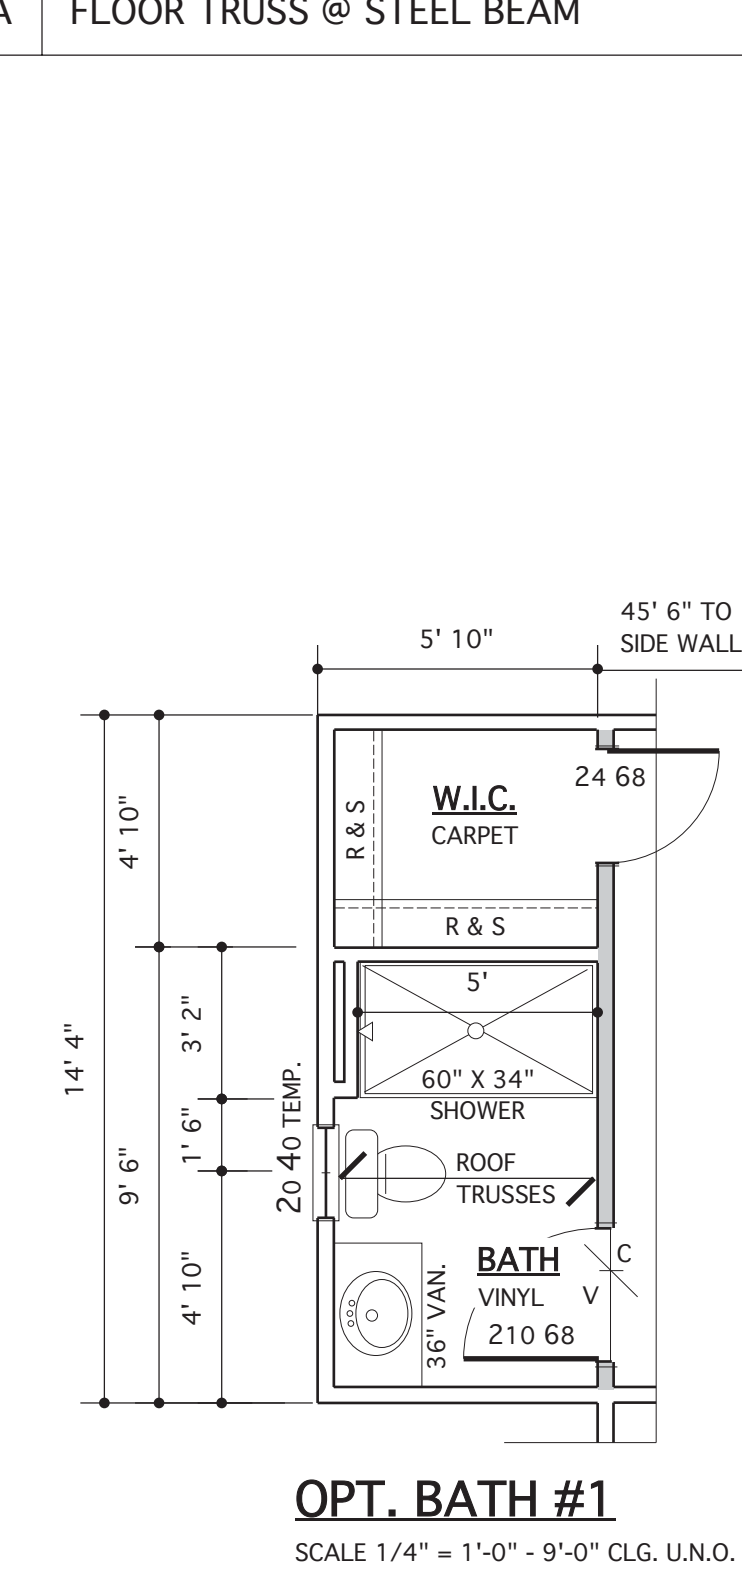


**OPT. BATH #1**  
SCALE 1/4" = 1'-0" - 9'-0" CLG. U.N.O.

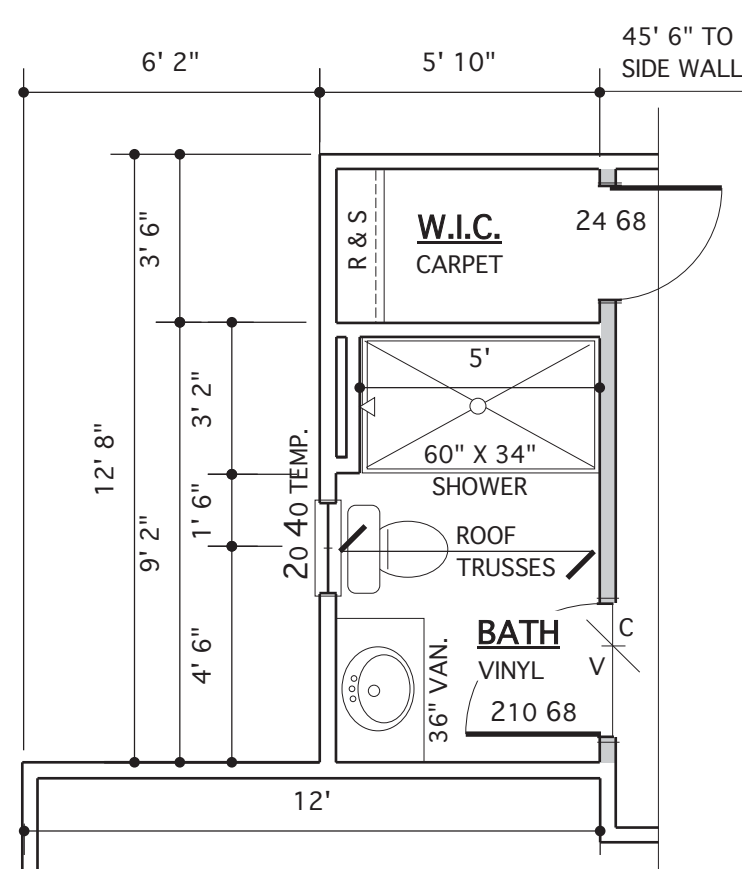

**OPT. BATH #1 @ OPT. THIRD CAR GARAGE**  
SCALE 1/4" = 1'-0" - 9'-0" CLG. U.N.O.

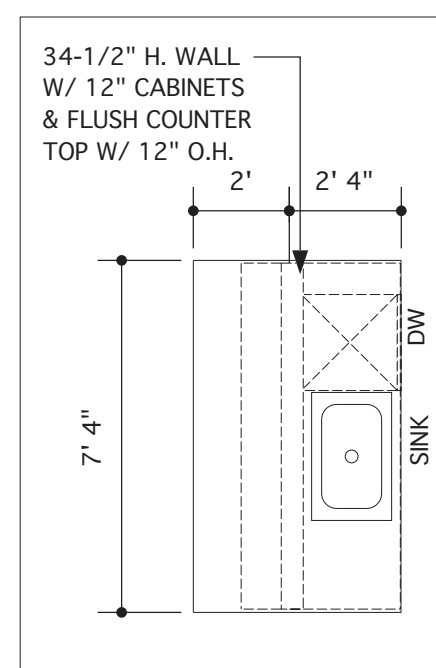

**GOURMET ISLAND**  
SCALE 1/4" = 1'-0"

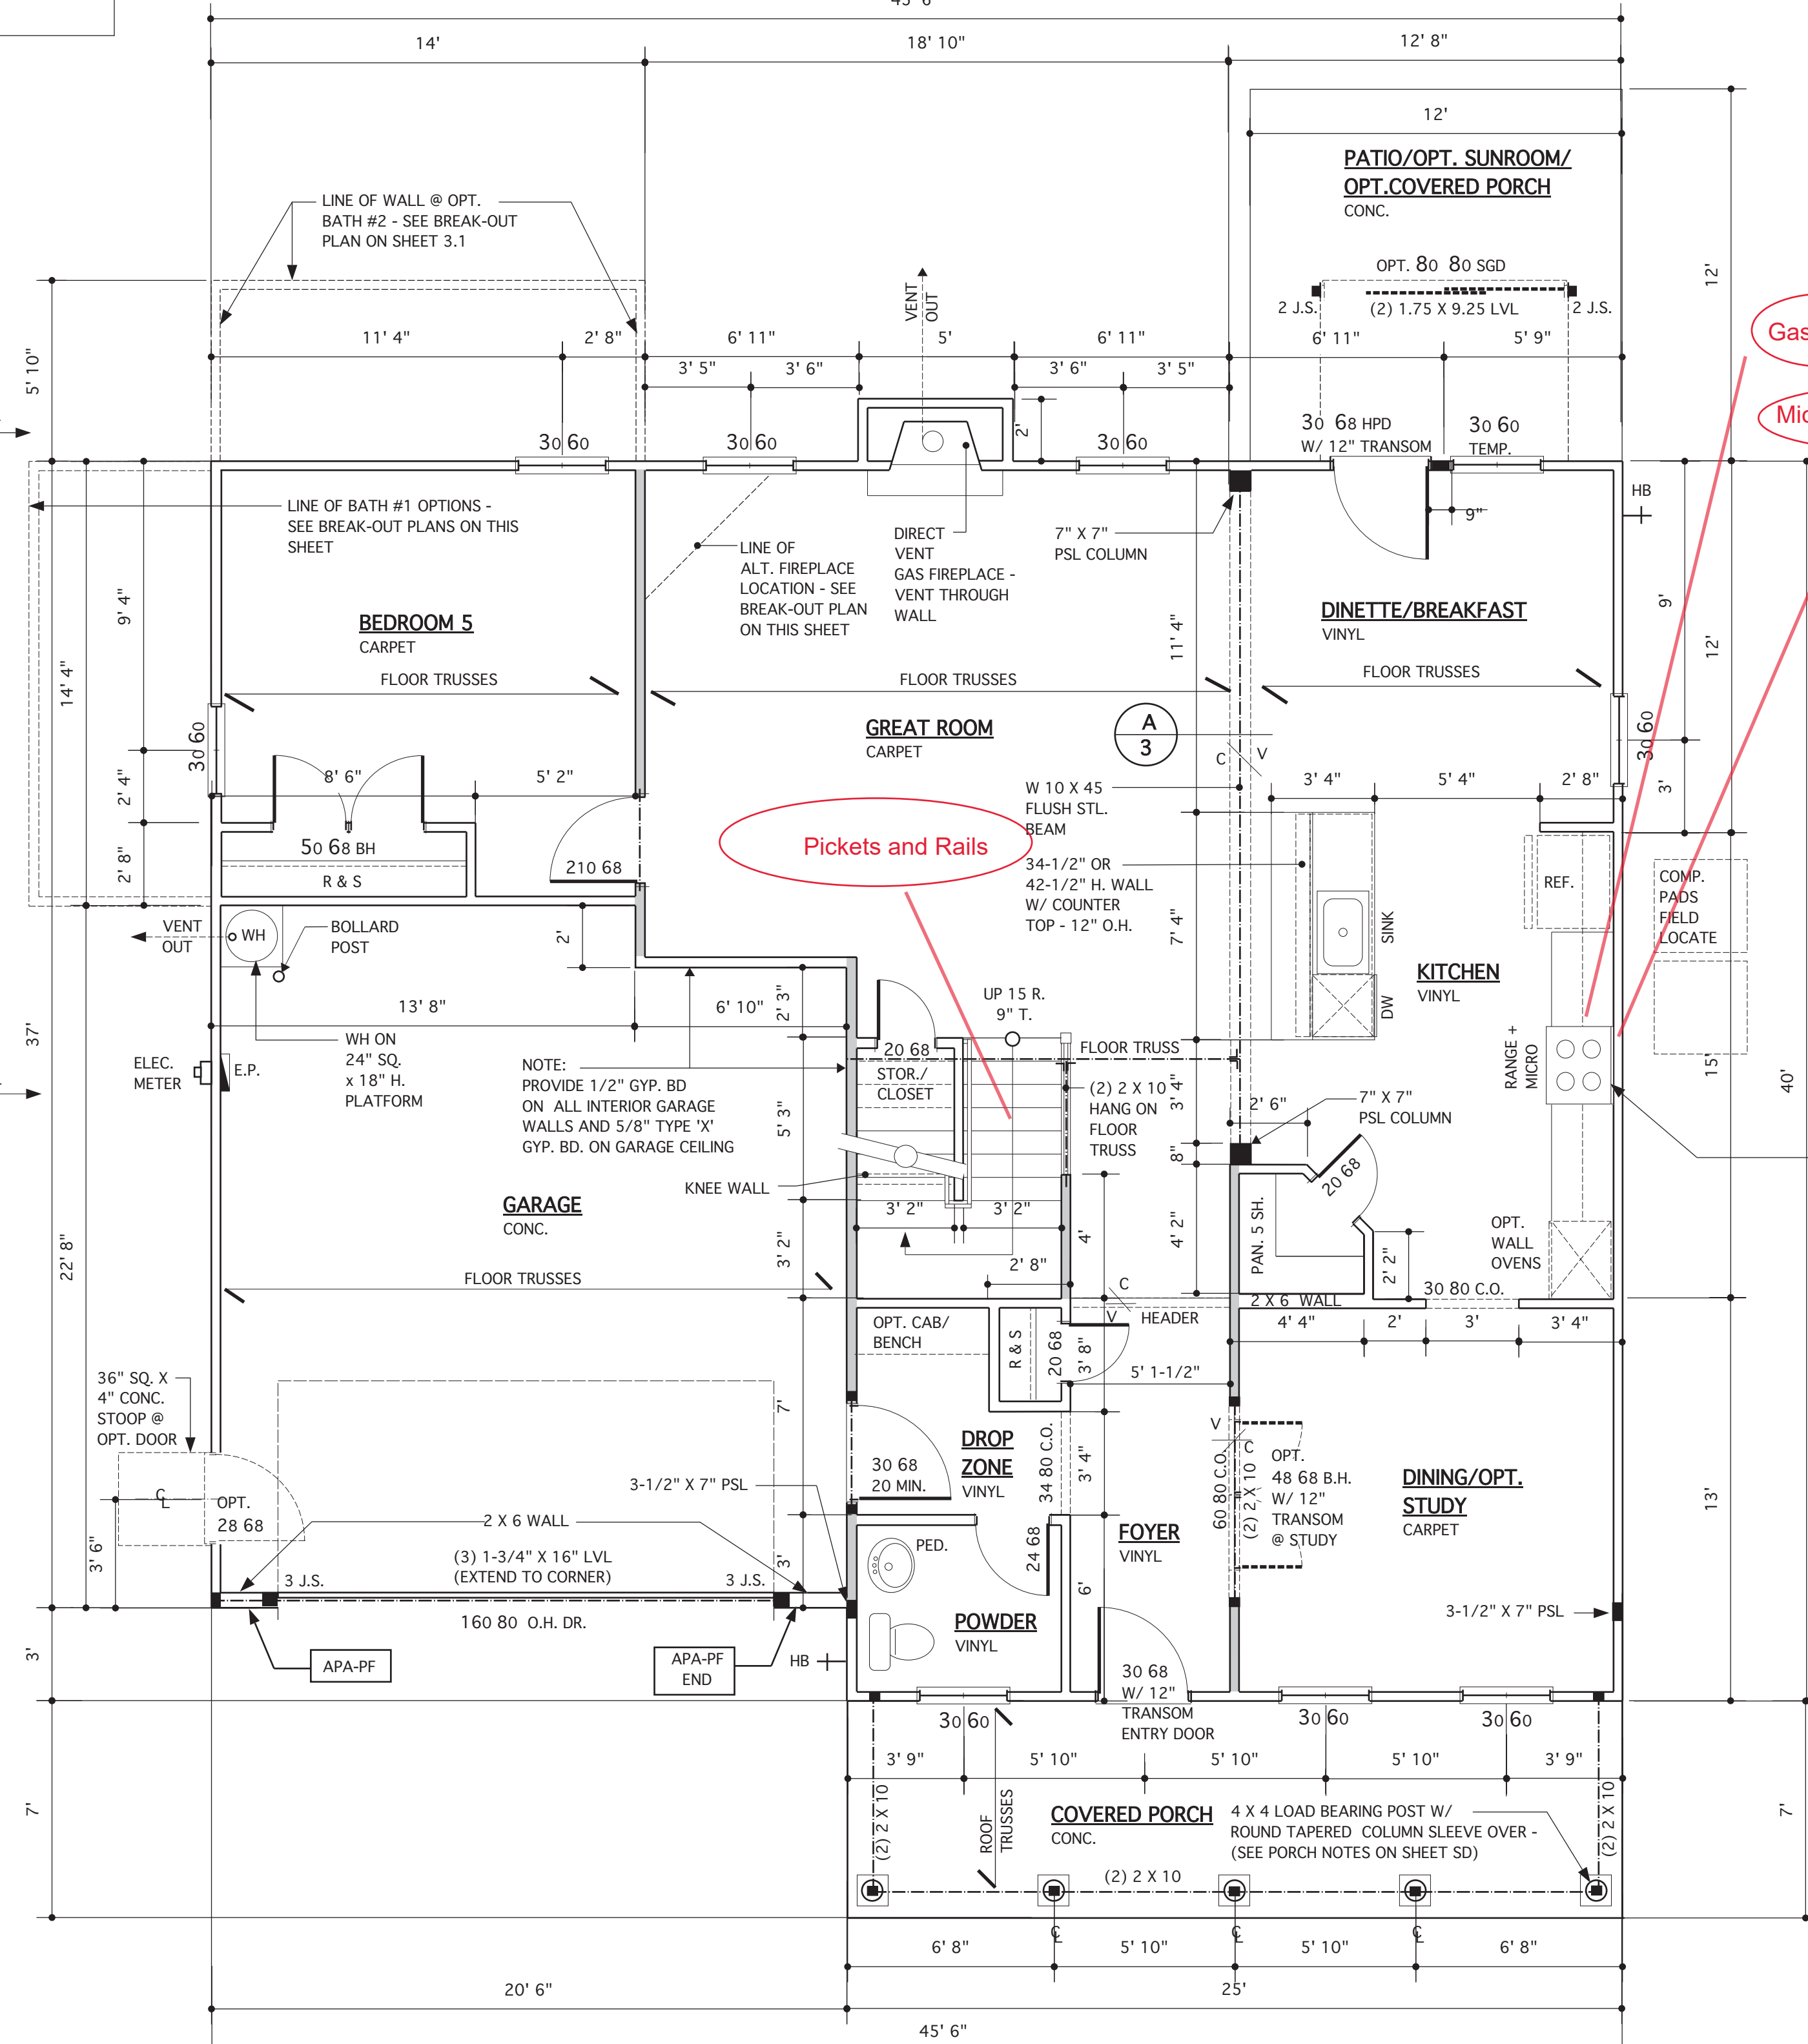


**FIRST FLOOR PLAN @ ELEV. B**


SCALE 1/4" = 1'-0" - 9'-0" CLG. U.N.O.  
WALLS ARE DIMENSIONED TO FACE OF STUD AND ARE 3-1/2" THICK UNLESS NOTED OTHERWISE.  
NOTE: SEE SHEET 3.1 FOR FIRST FLOOR PLAN OPTIONS  
NOTE: SEE ELEVATIONS FOR OPT. BRICK OR STONE WAINSCOT/VENEER TYPES & LOCATIONS

NOTE: SEE ELEVATIONS FOR OPT. BRICK OR STONE WAINSCOT/VENEER TYPES & LOCATIONS (SEE SHEET SD-1 FOR ADDITIONAL NOTES & DETAILS)  
(SEE FLOOR SYSTEM LAYOUT AND SHOP DRAWINGS FOR ADDITIONAL INFORMATION AND TO VERIFY BEAM & TRUSS SIZES AND LOCATIONS.)


**WALL LEGEND**  
INTERIOR LOAD BEARING WALL  
DENOTES 2 JACK STUDS UNLESS NOTED OTHERWISE

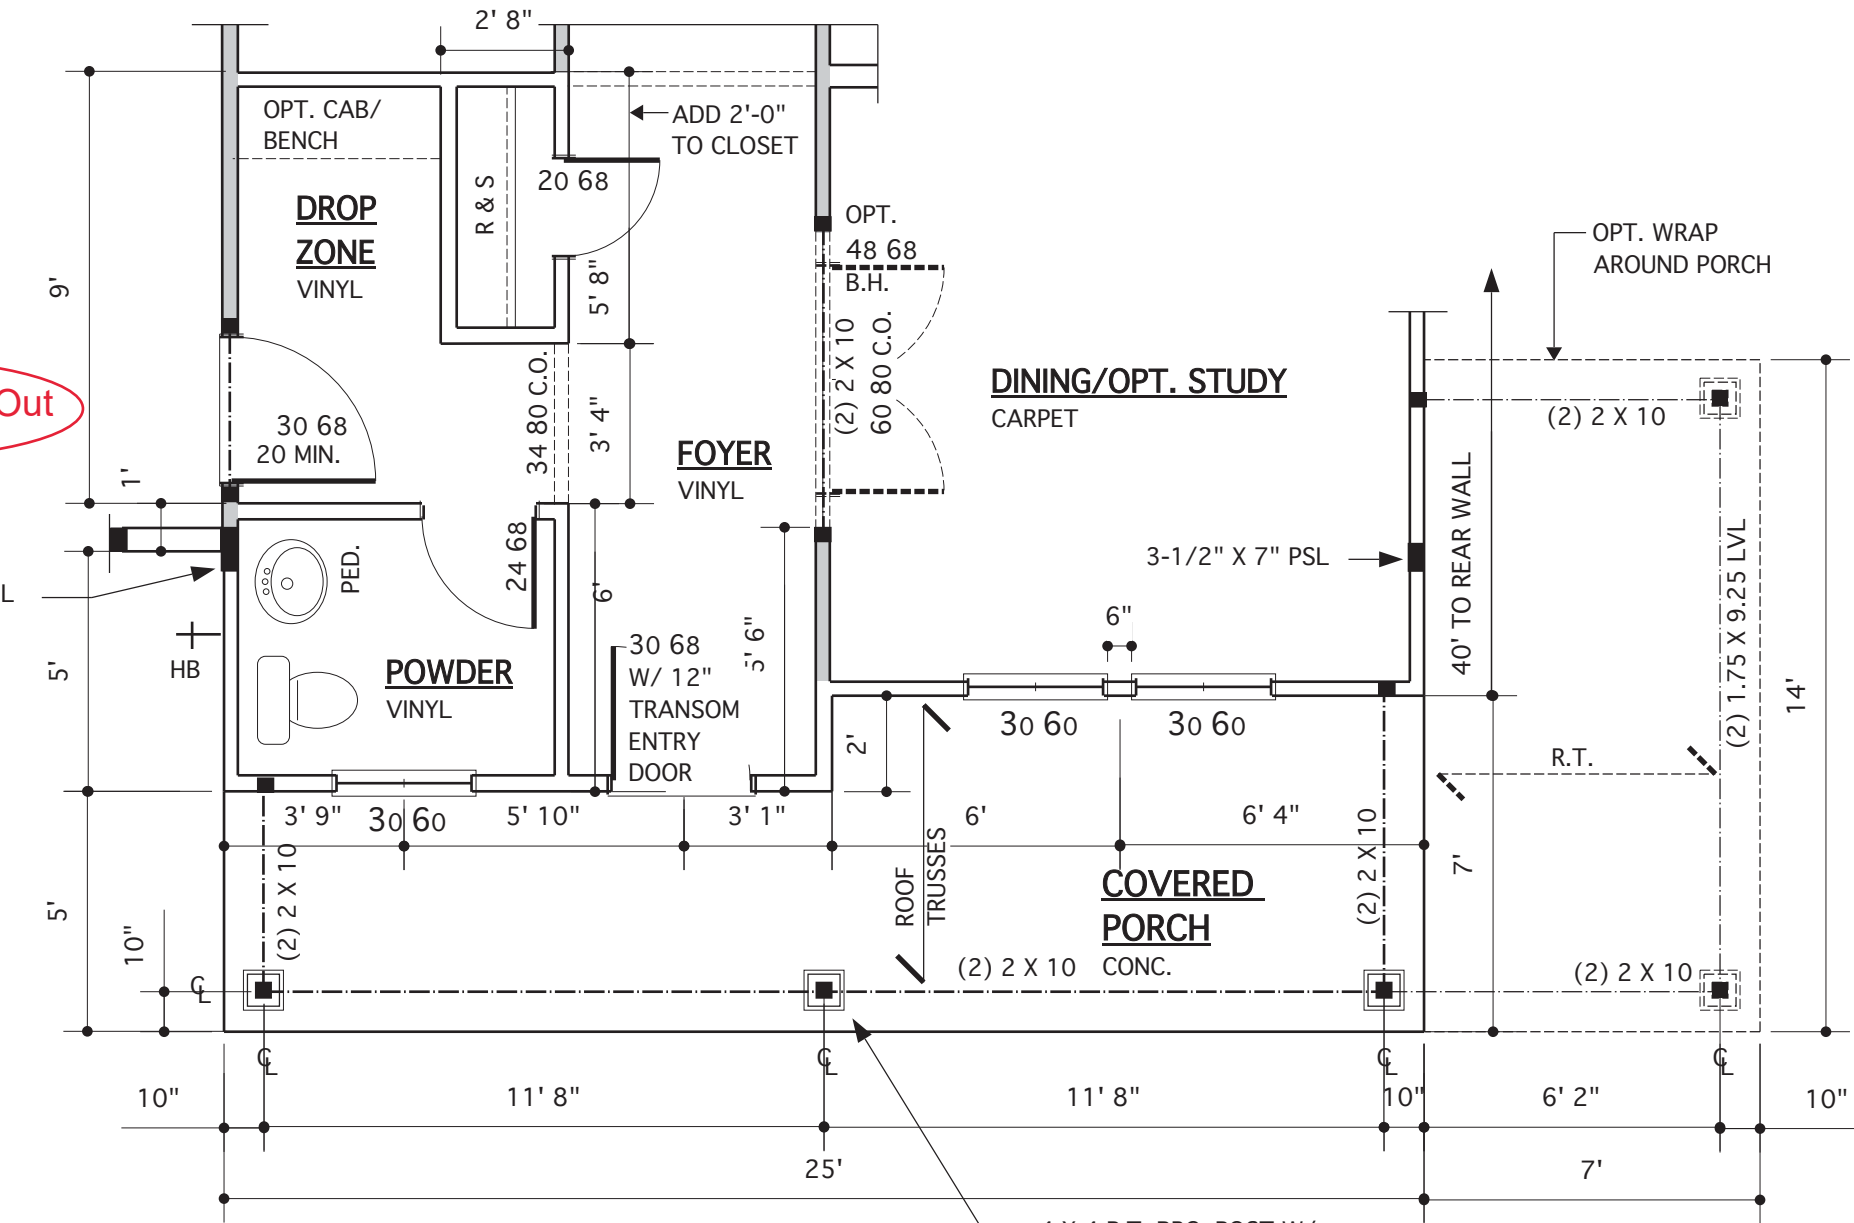

**@ ELEV. D**  
SCALE 1/4" = 1'-0" - 9'-0" CLG. U.N.O.

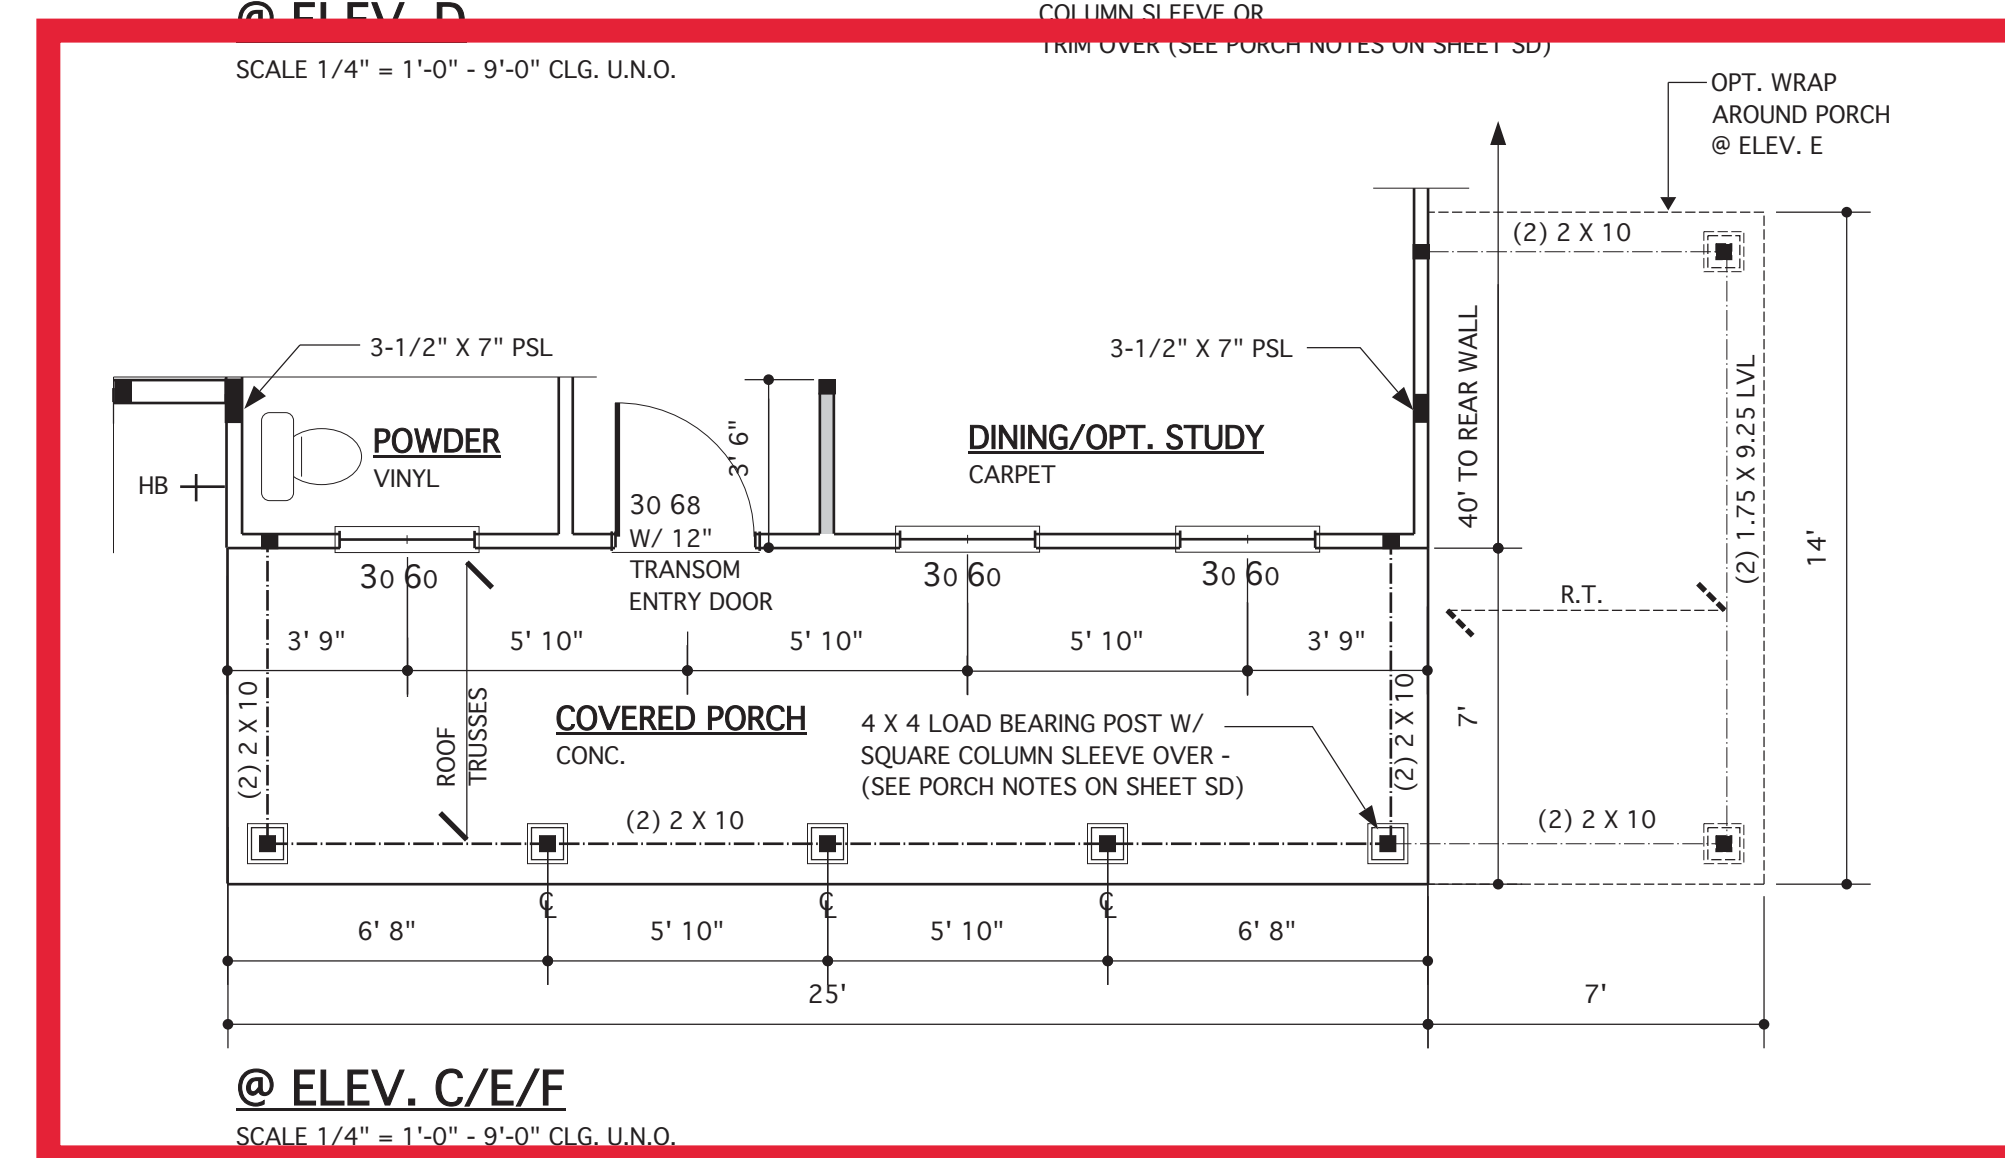

**@ ELEV. C/E/E**  
SCALE 1/4" = 1'-0" - 9'-0" CLG. U.N.O.

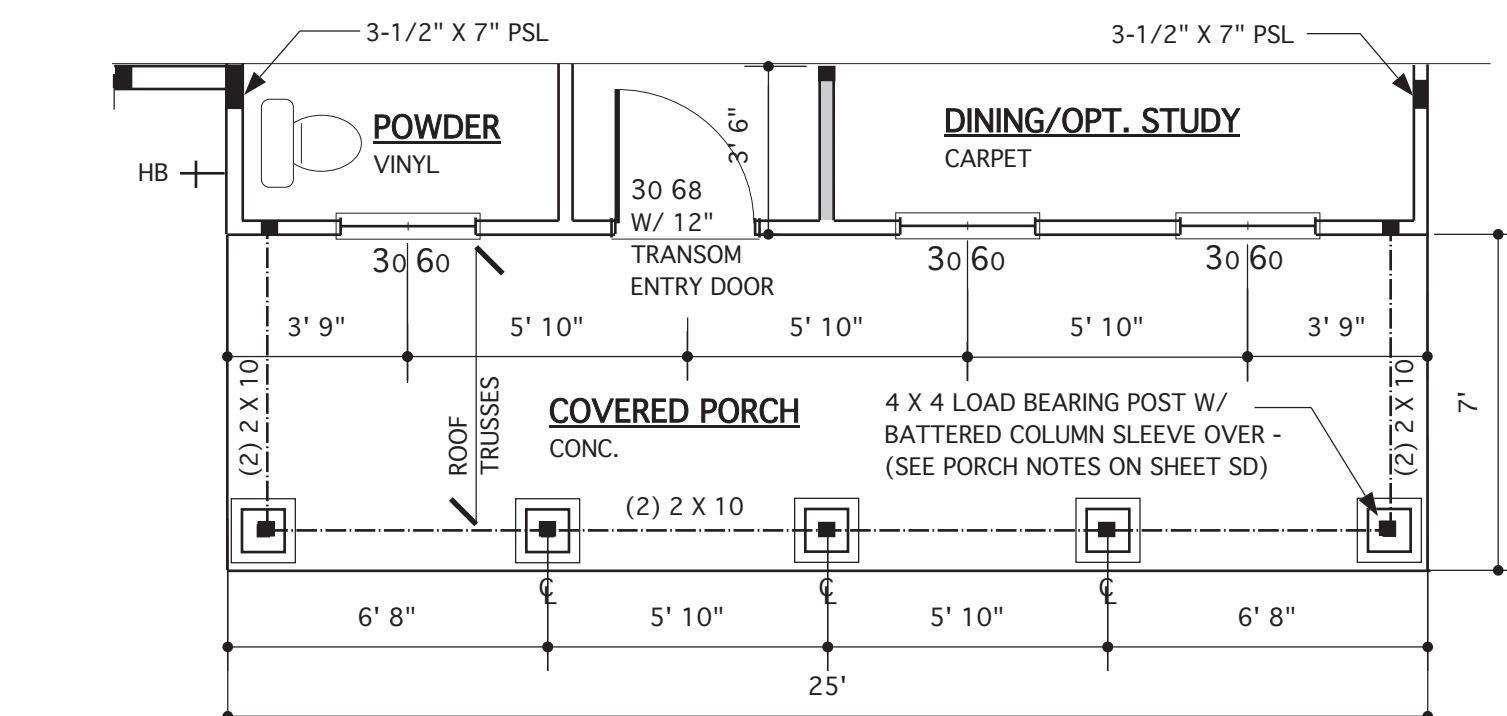

**@ ELEV. A**  
SCALE 1/4" = 1'-0" - 9'-0" CLG. U.N.O.

REVISIONS		
MARK	DATE	DESCRIPTION
DN	01-10-19	CONVERT OLAHS
DN	02-14-19	STRUCT. DWGS. REV.
CH	12-10-19	ADD ELEV. D & E
CH	05-18-20	ADD ELEV. F
DN	04-04-24	CONVERT 113-69/ADD OPT. BATH #2 LM

PROJECT NO.	113-88
DATE	01-13-16
SCALE	AS NOTED
DRAWN BY	JB
CHECKED BY	JW
ISSUED FOR	PERMITS/CONSTRUCTION


PROJECT TITLE  
**MODEL 628 - GARAGE LEFT**

CLIENT  
**CHESAPEAKE HOMES OF NC**  
3100 Smoketree Court,  
Suite 210  
Raleigh, NC 27604  
(919) 256-3060  
(919) 556-0690 Fax

DRAWING TITLE  
**FIRST FLOOR PLANS**

SHEET  
**3**




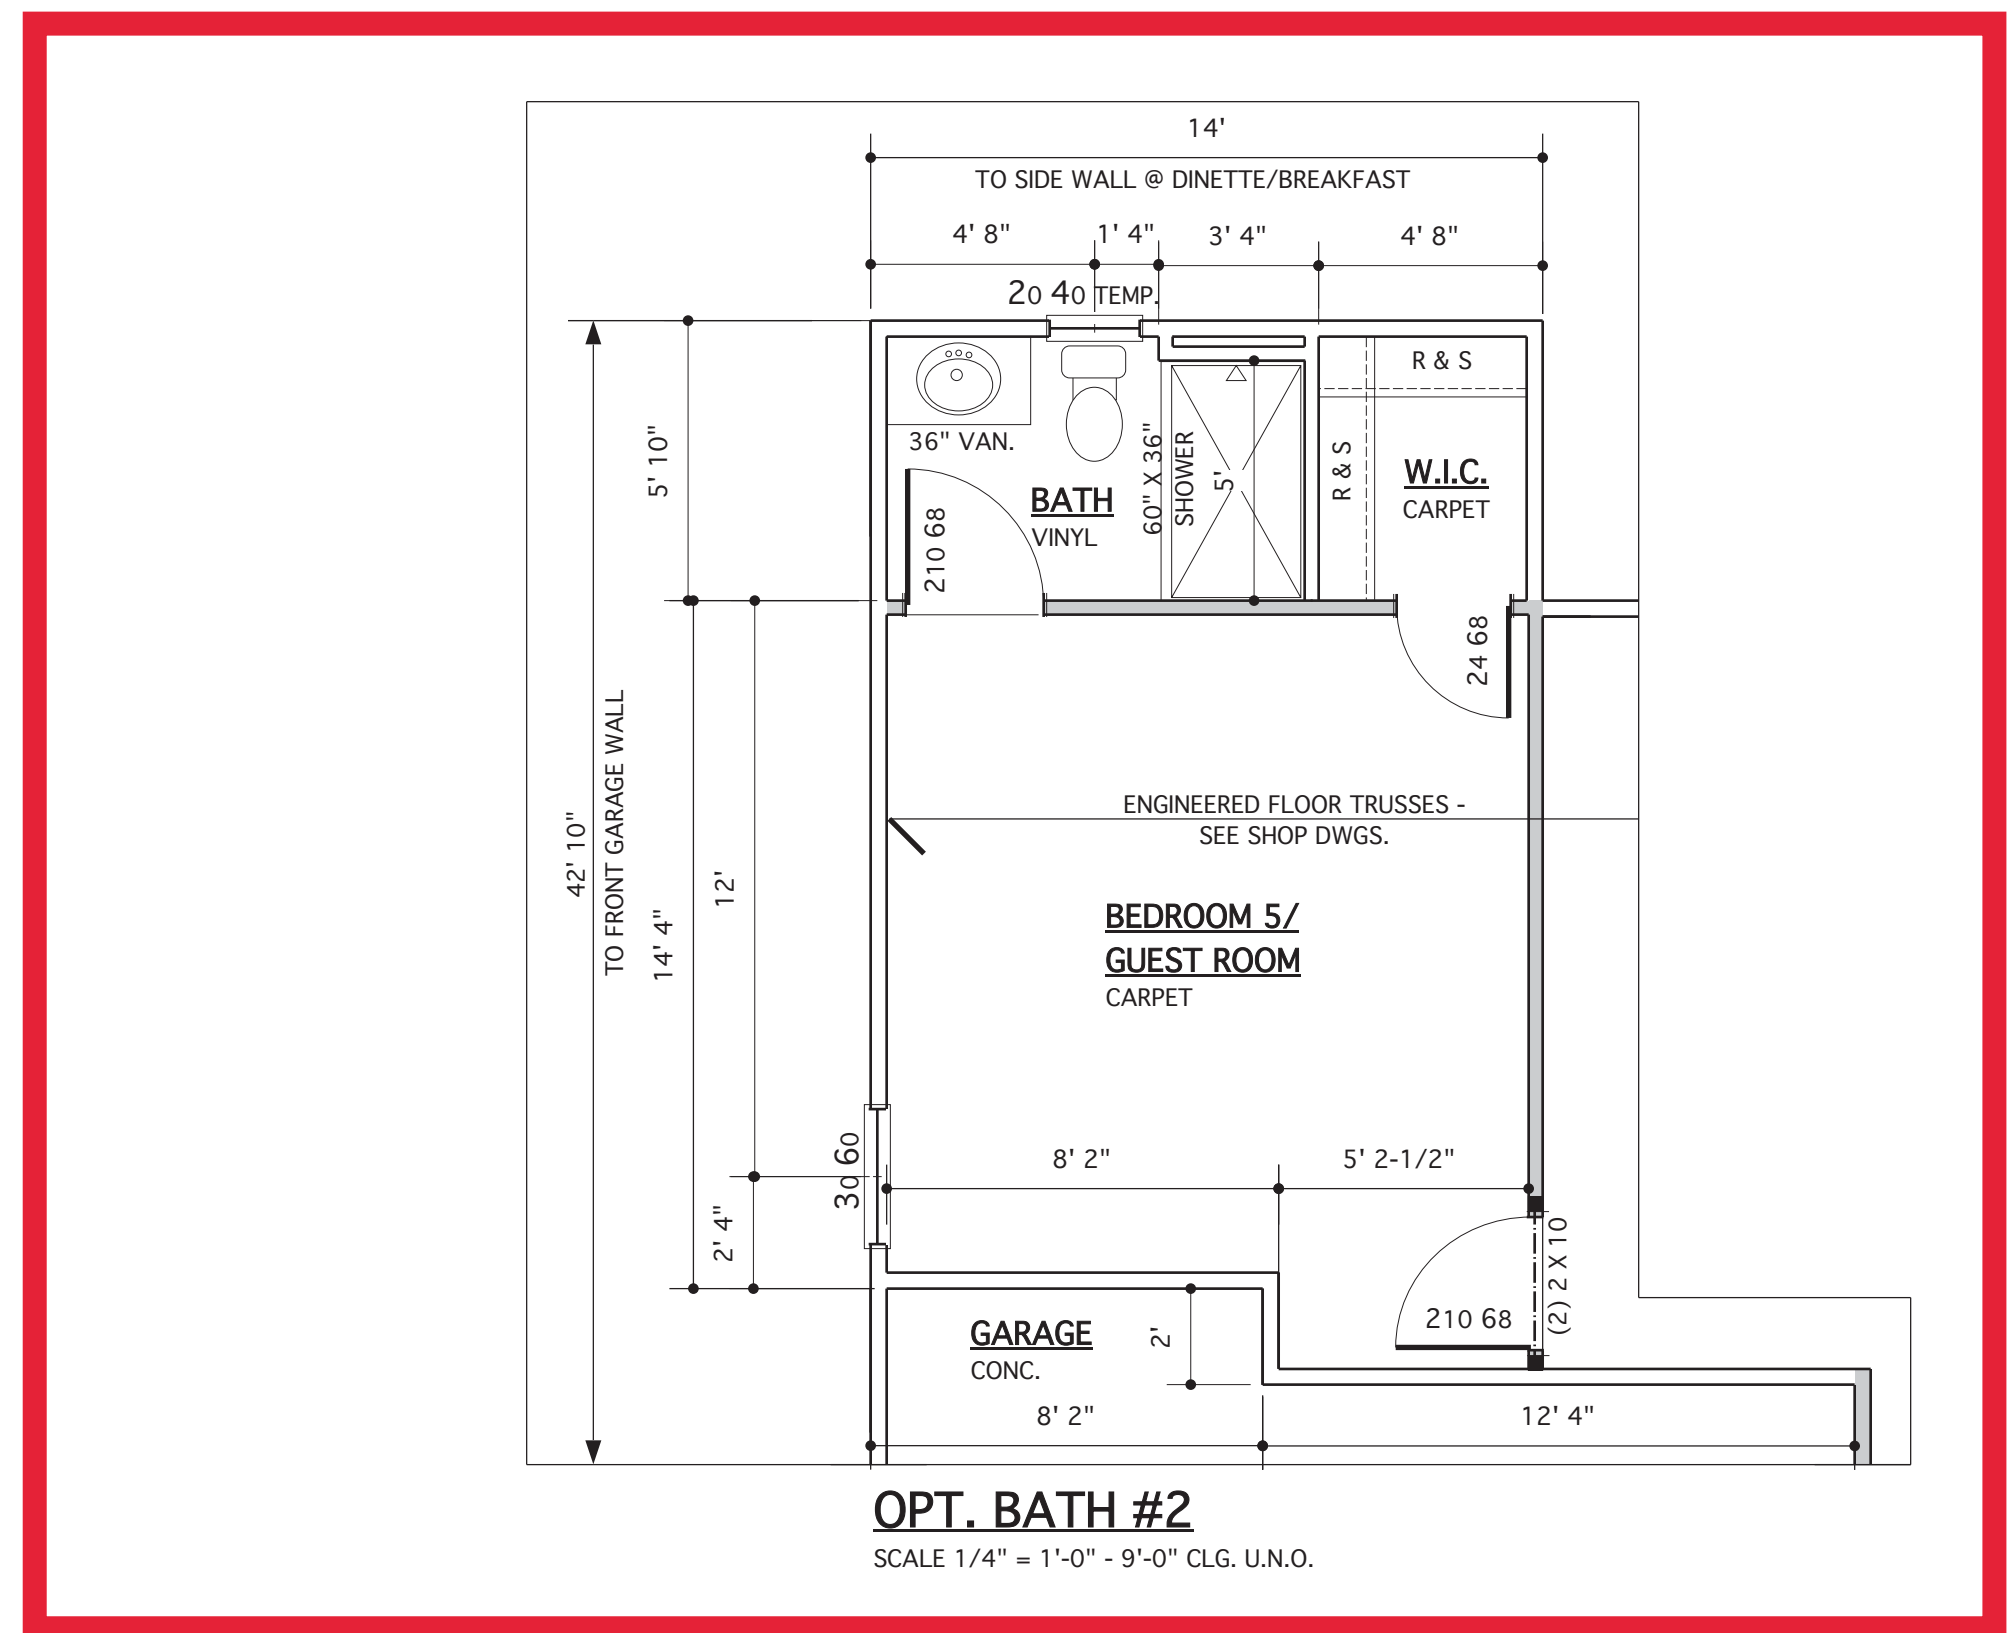

STRUCTURAL DESIGN BY:  
SOUTHERN ENGINEERS, P.A.  
3716 BENSON DR., RALEIGH, NC 27609  
LICENSE: C-1287, PHONE: 919-878-1617  
PROJECT # 19-1059




\* Engineers seal applies only to structural components on this document. Seal does not include construction means, methods, techniques, sequences, procedures or safety precautions.  
\* Any deviations or discrepancies on plans are to be brought to the immediate attention of Southern Engineers. Failure to do so will void Southern Engineer's liability.  
\* Seal is valid for a project permitted within one year from date of seal.  
\* Use of these plans constitutes approval of terms & conditions as defined in the customer agreement.

REFER TO "SD" SHEET(S) FOR STANDARD DETAILS, BRACING DETAILS AND STRUCTURAL NOTES.

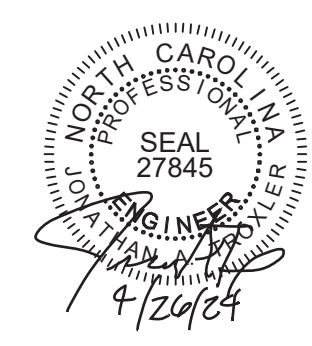

**PORTAL FRAME LEGEND**  
SEE SD SHEETS FOR PORTAL FRAME DETAILS  
APA-PF: APA PORTAL FRAME  
APA-PF-END: END CONDITION FOR APA PORTAL FRAME  
CS-PF: CONTINUOUS PORTAL FRAME CONSTRUCTION  
CS-PF-END: END CONDITION FOR CONTINUOUS PORTAL FRAME

**WALL LEGEND**  
INTERIOR LOAD BEARING WALL  
DENOTES 2 JACK STUDS UNLESS NOTED OTHERWISE

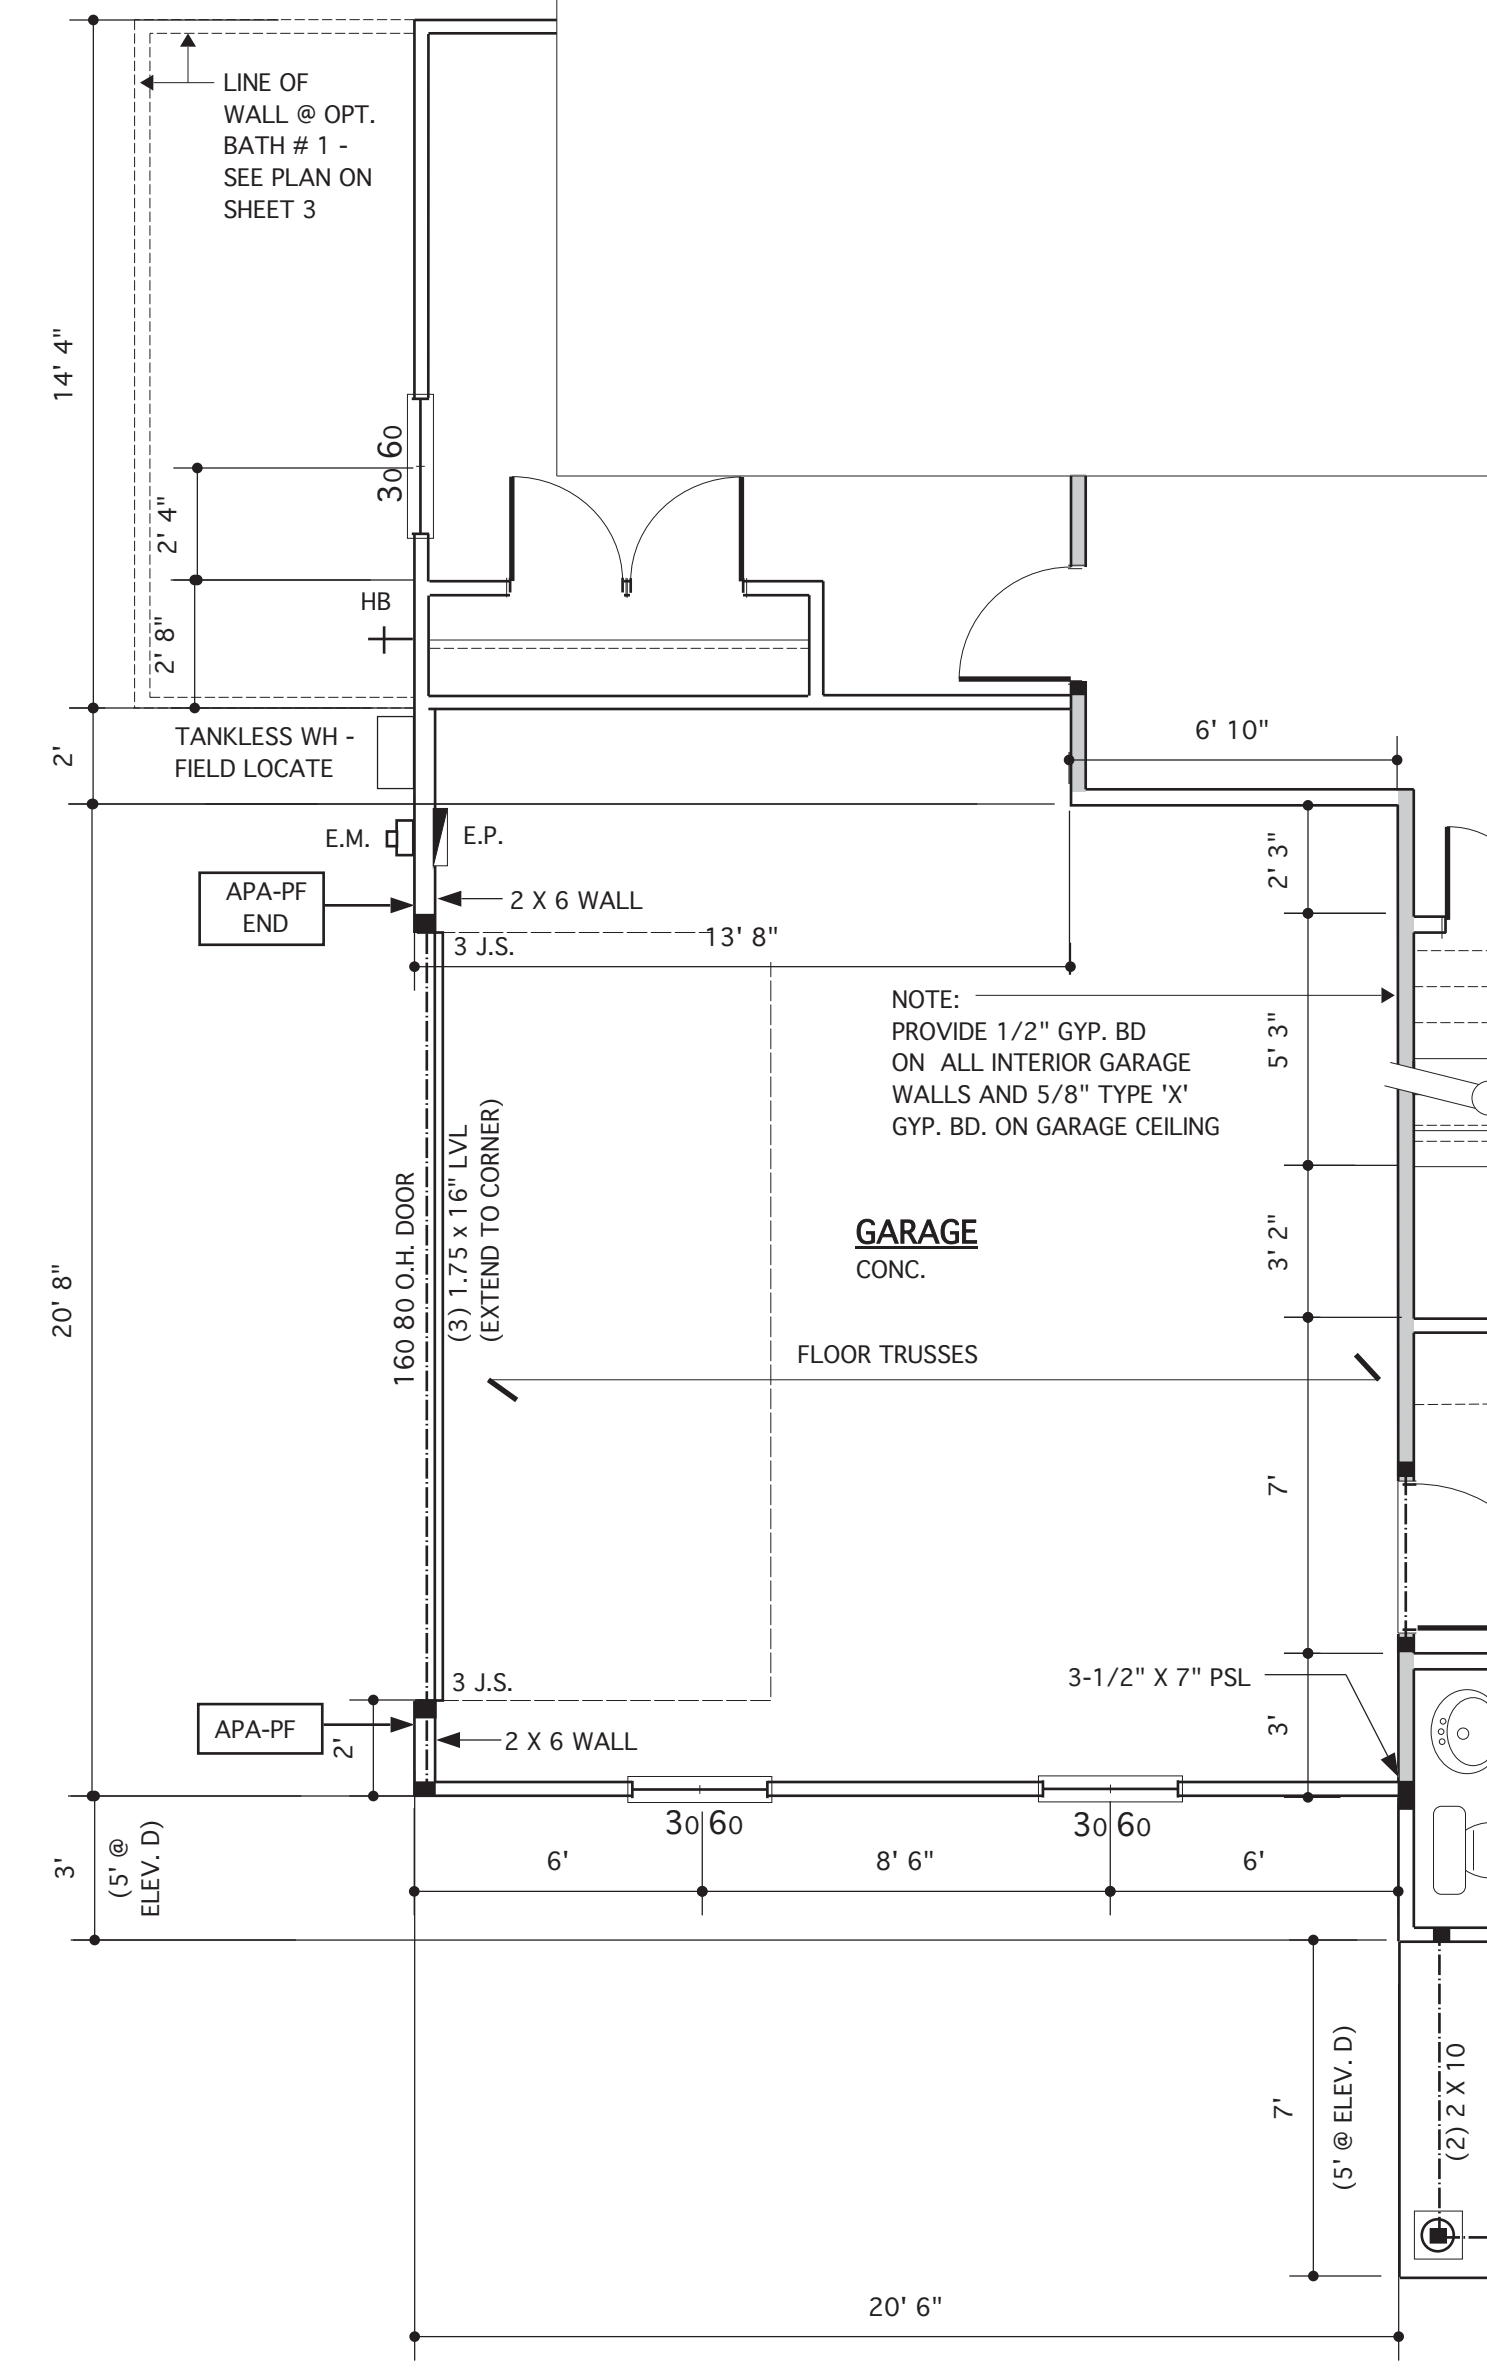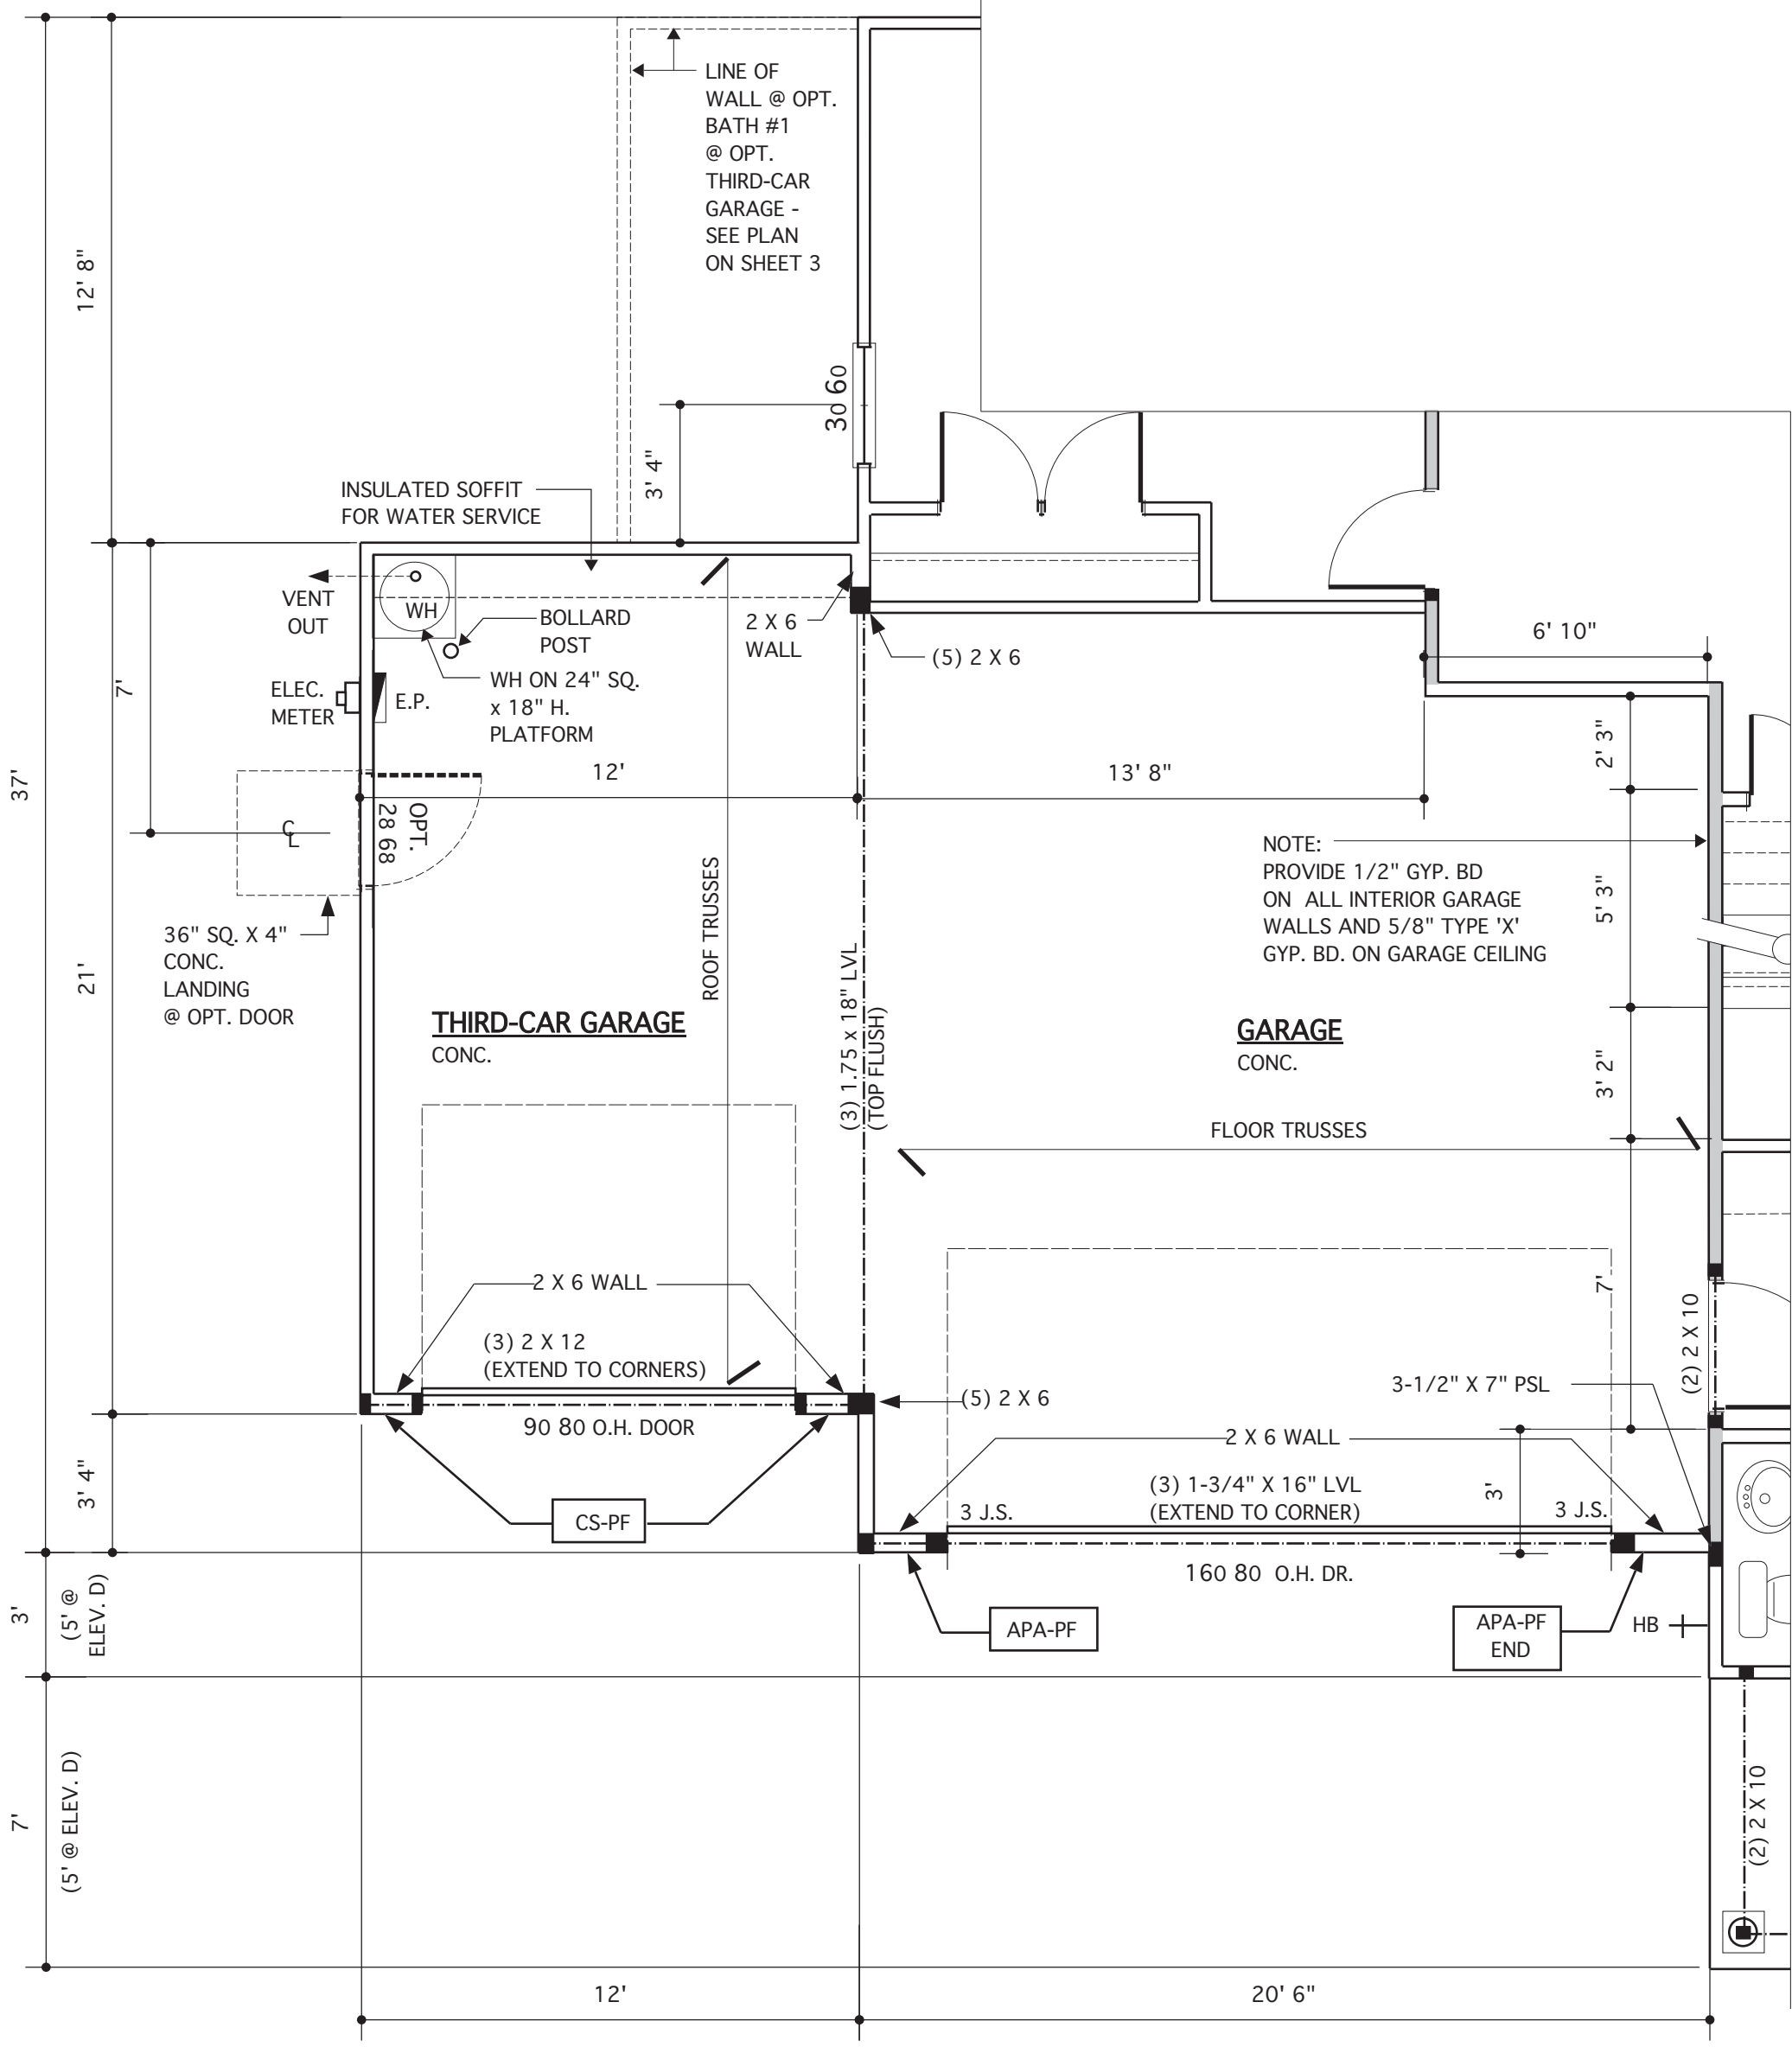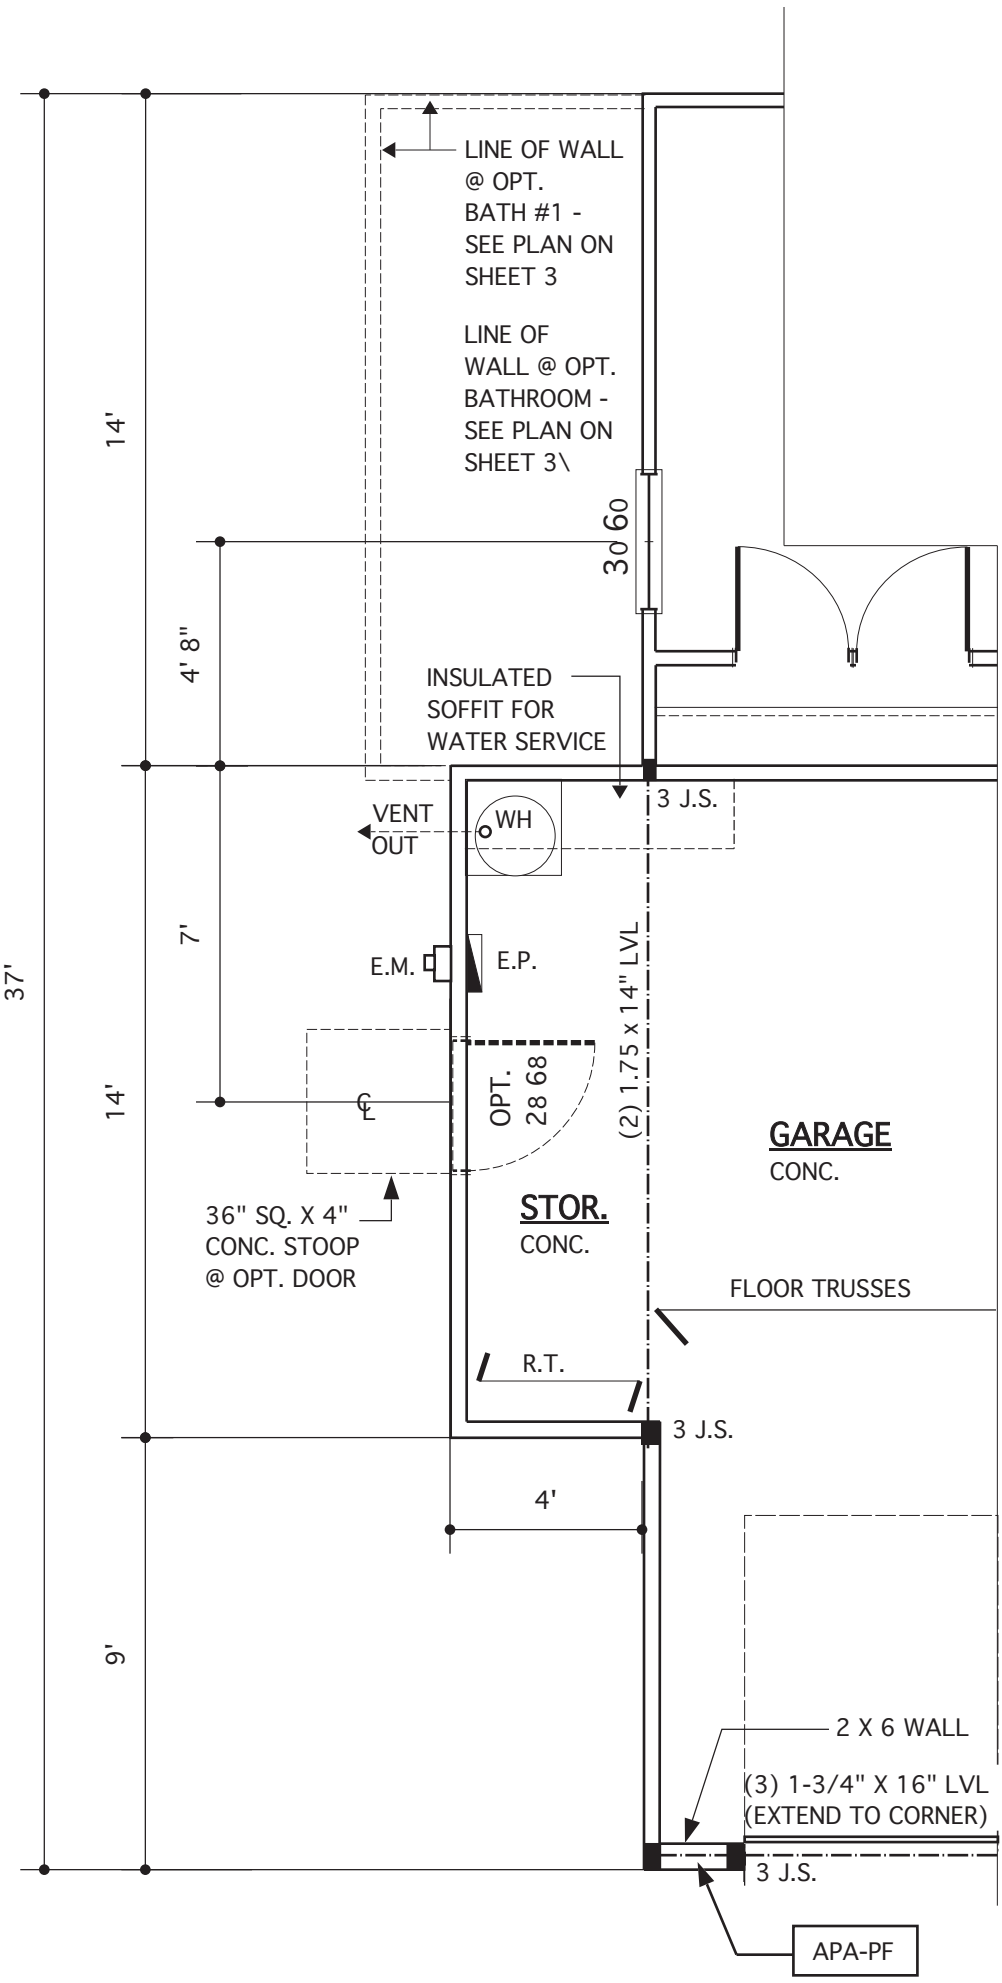

**JAMES WENTLING/ ARCHITECT**  
LAND TITLE BUILDING  
100 SOUTH BROAD STREET,  
SUITE 1524  
PHILADELPHIA, PA 19110

(215) 568-2551  
email - information@  
wentlinghouseplans.com

ARCHITECTURE  
LAND PLANNING  
GRAPHICS

THESE PLANS ARE COPYRIGHTED AND ARE SUBJECT TO COPYRIGHT PROTECTION AS AN "ARCHITECTURAL WORK" UNDER SECTION 102 OF THE COPYRIGHT ACT, 17 U.S.C. AS AMENDED DECEMBER 1, 1990 AND KNOWN AS THE "ARCHITECTURAL WORKS" COPYRIGHT PROTECTION ACT OF 1990. THE PROTECTION INCLUDES BUT IS NOT LIMITED TO, THE OVERALL FORM AS WELL AS THE ARRANGEMENT AND COMPOSITION OF SPACES AND ELEMENTS OF THE DESIGN. UNDER SUCH PROTECTION, UNAUTHORIZED USE OF THESE PLANS, WORKS, OR FORMS REPRESENTED CAN LEGALLY RESULT IN THE CESSATION OF SUCH CONSTRUCTION OR BUILDINGS BEING SEIZED AND/OR RAISED.

© Copyright 2016 James Wentling/ Architect

**JAMES WALTER WENTLING**  
REGISTERED ARCHITECT  
#642  
NORTH CAROLINA  
RALEIGH, N.C.  
4/1/24

REVISIONS		
MARK	DATE	DESCRIPTION
DN	01-10-19	CONVERT OLAHS
DN	02-14-19	STRUCT. DWGS. REV.
CH	12-10-19	ELEV. D + E
CH	05-18-20	ADD SHEET 3.1.1
DN	04-04-24	CONVERT 113-69/ADD OPT. BATH #2 LM


PROJECT NO: 113-88  
DATE: 01-13-16  
SCALE: AS NOTED  
DRAWN BY: JB  
CHECKED BY: JW  
ISSUED FOR: PERMITS/CONSTRUCTION

PROJECT TITLE  
**MODEL 628 - GARAGE LEFT**


CLIENT  
**CHESAPEAKE HOMES OF NC**  
3100 Smoketree Court,  
Suite 210  
Raleigh, NC 27604  
(919) 256-3060  
(919) 556-0690 Fax

DRAWING TITLE  
**FIRST FLOOR PLAN - OPTIONS**


SHEET  
**3.1**

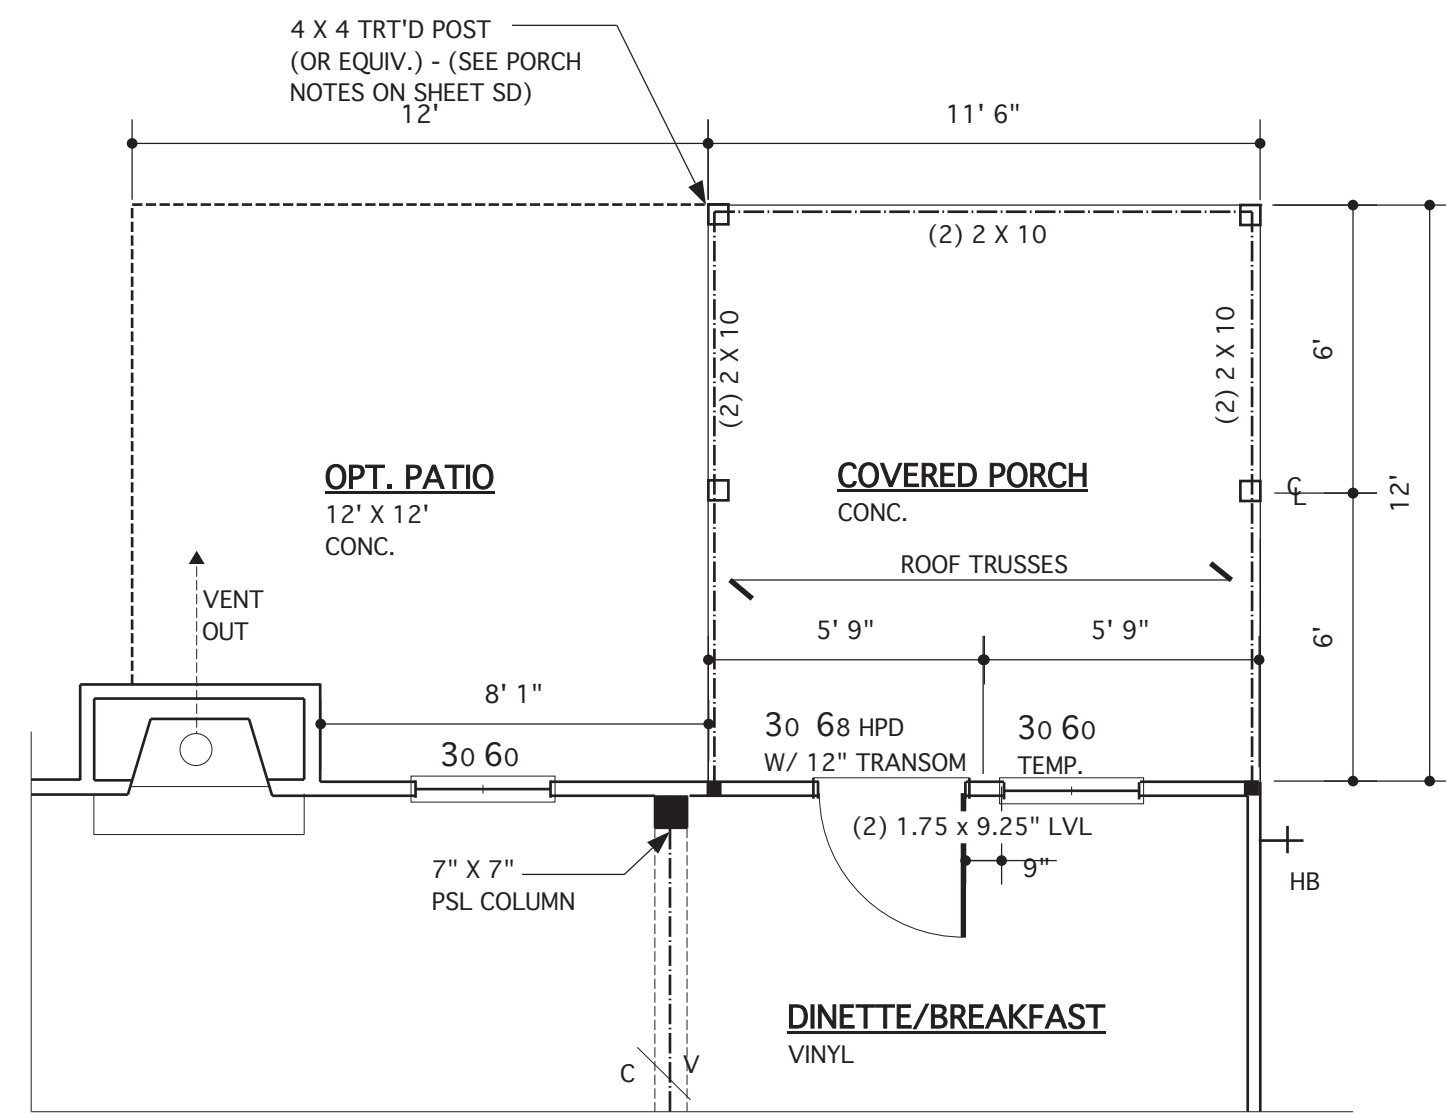


**OPT. COVERED PORCH**  
SCALE 1/4" = 1'-0" - 9'-0" CLG. U.N.O.

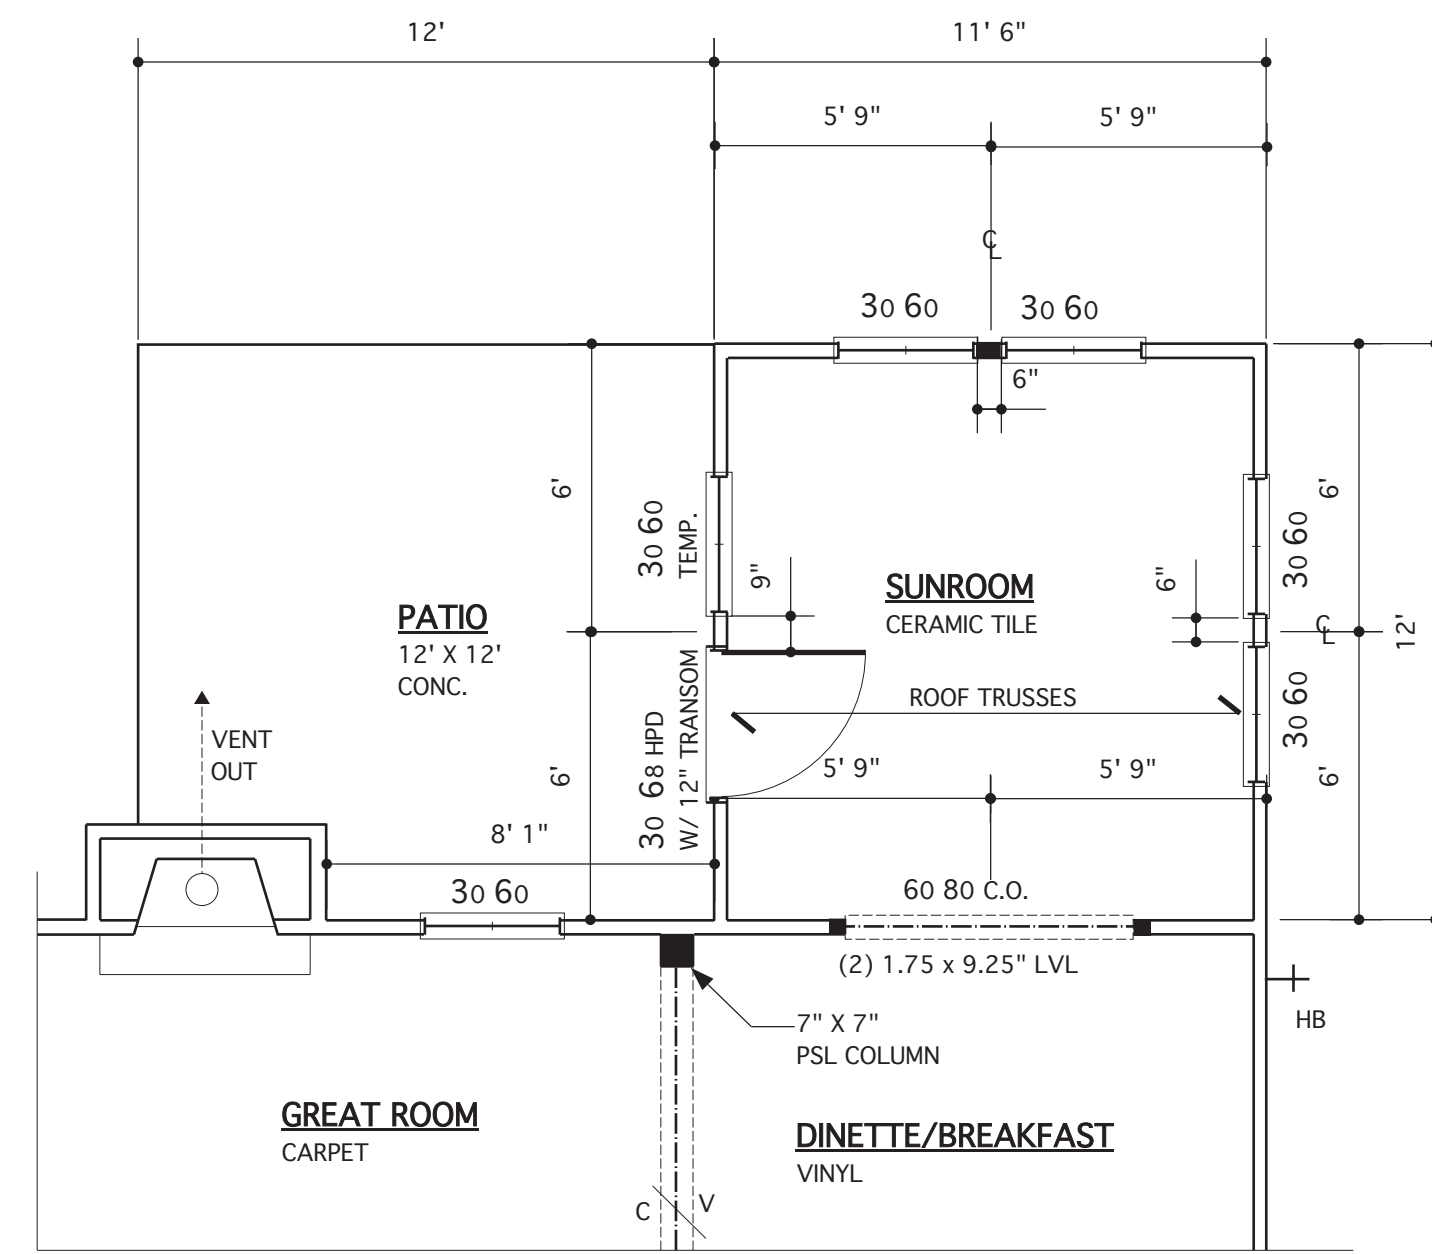

**OPT. SUNROOM**  
SCALE 1/4" = 1'-0" - 9'-0" CLG. U.N.O.

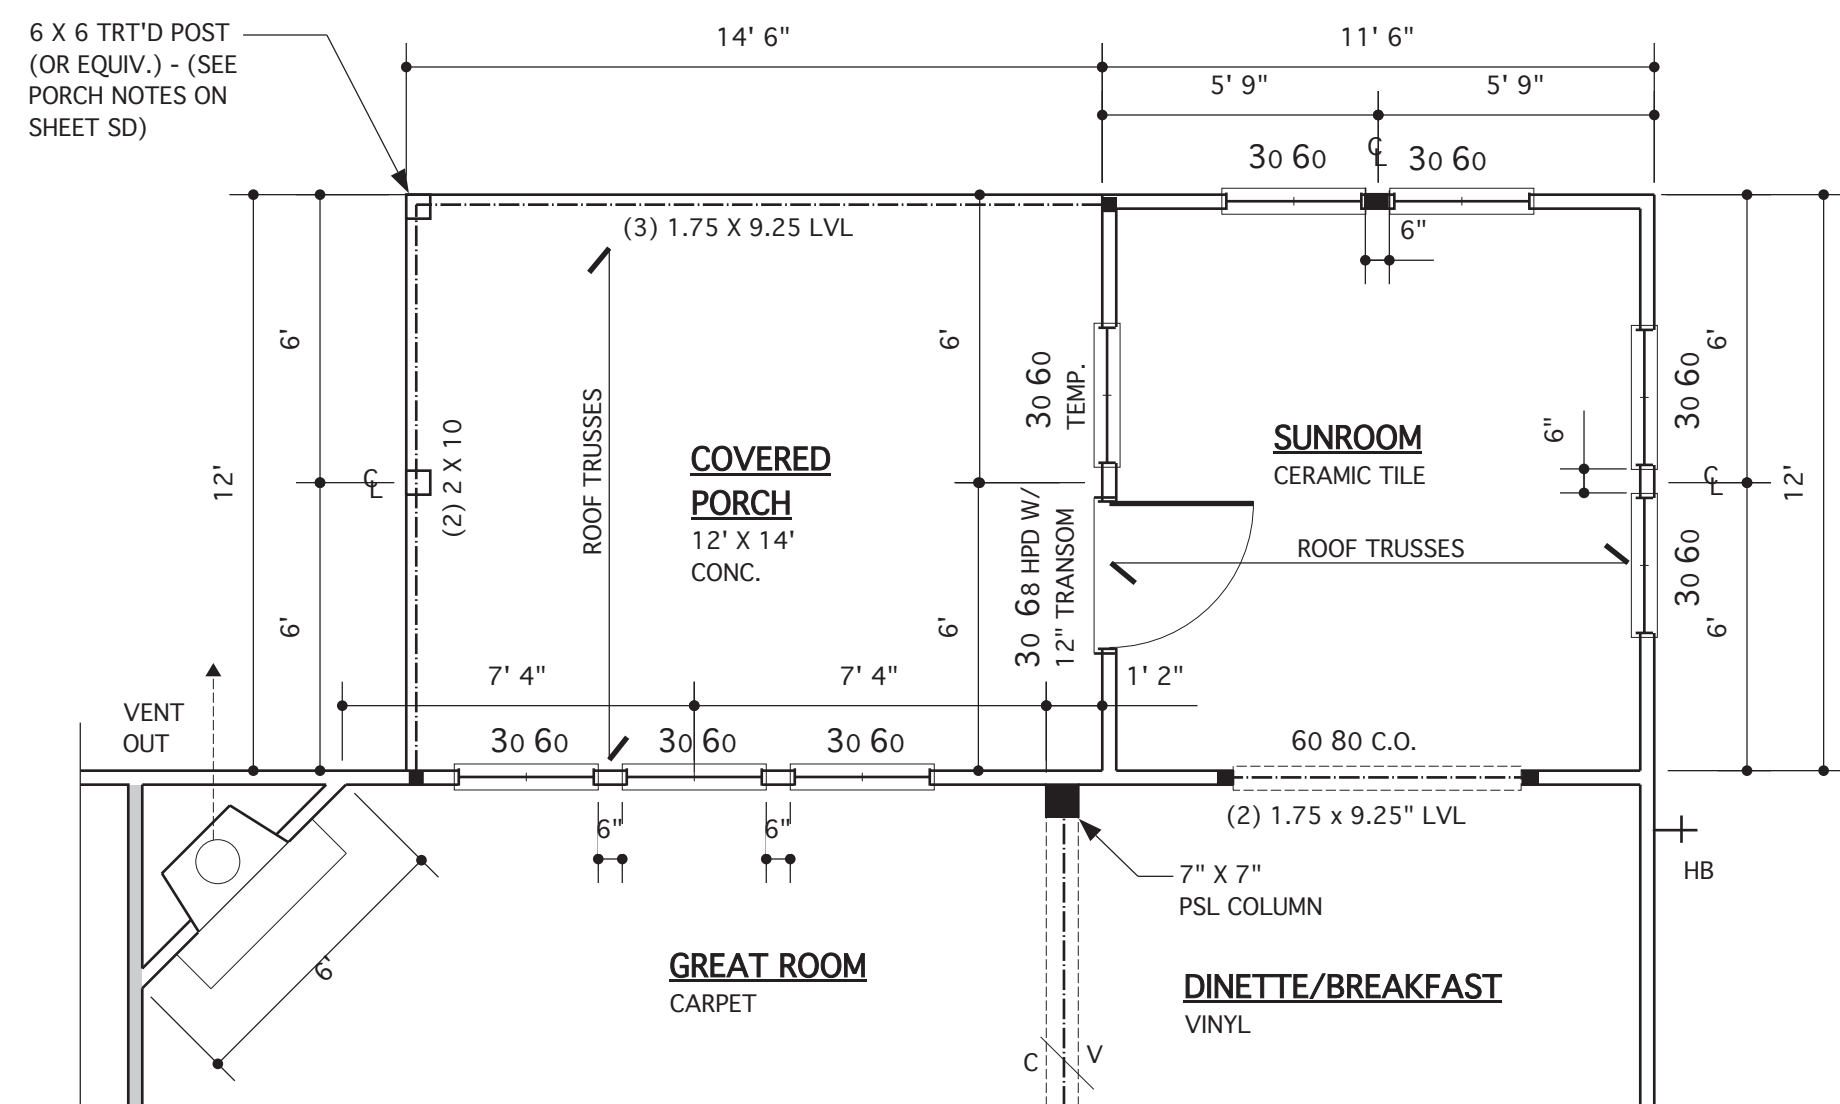

**OPT. SUNROOM W/ OPT. COVERED PORCH  
& ALT. FIREPLACE LOCATION**  
SCALE 1/4" = 1'-0" - 9'-0" CLG. U.N.O.

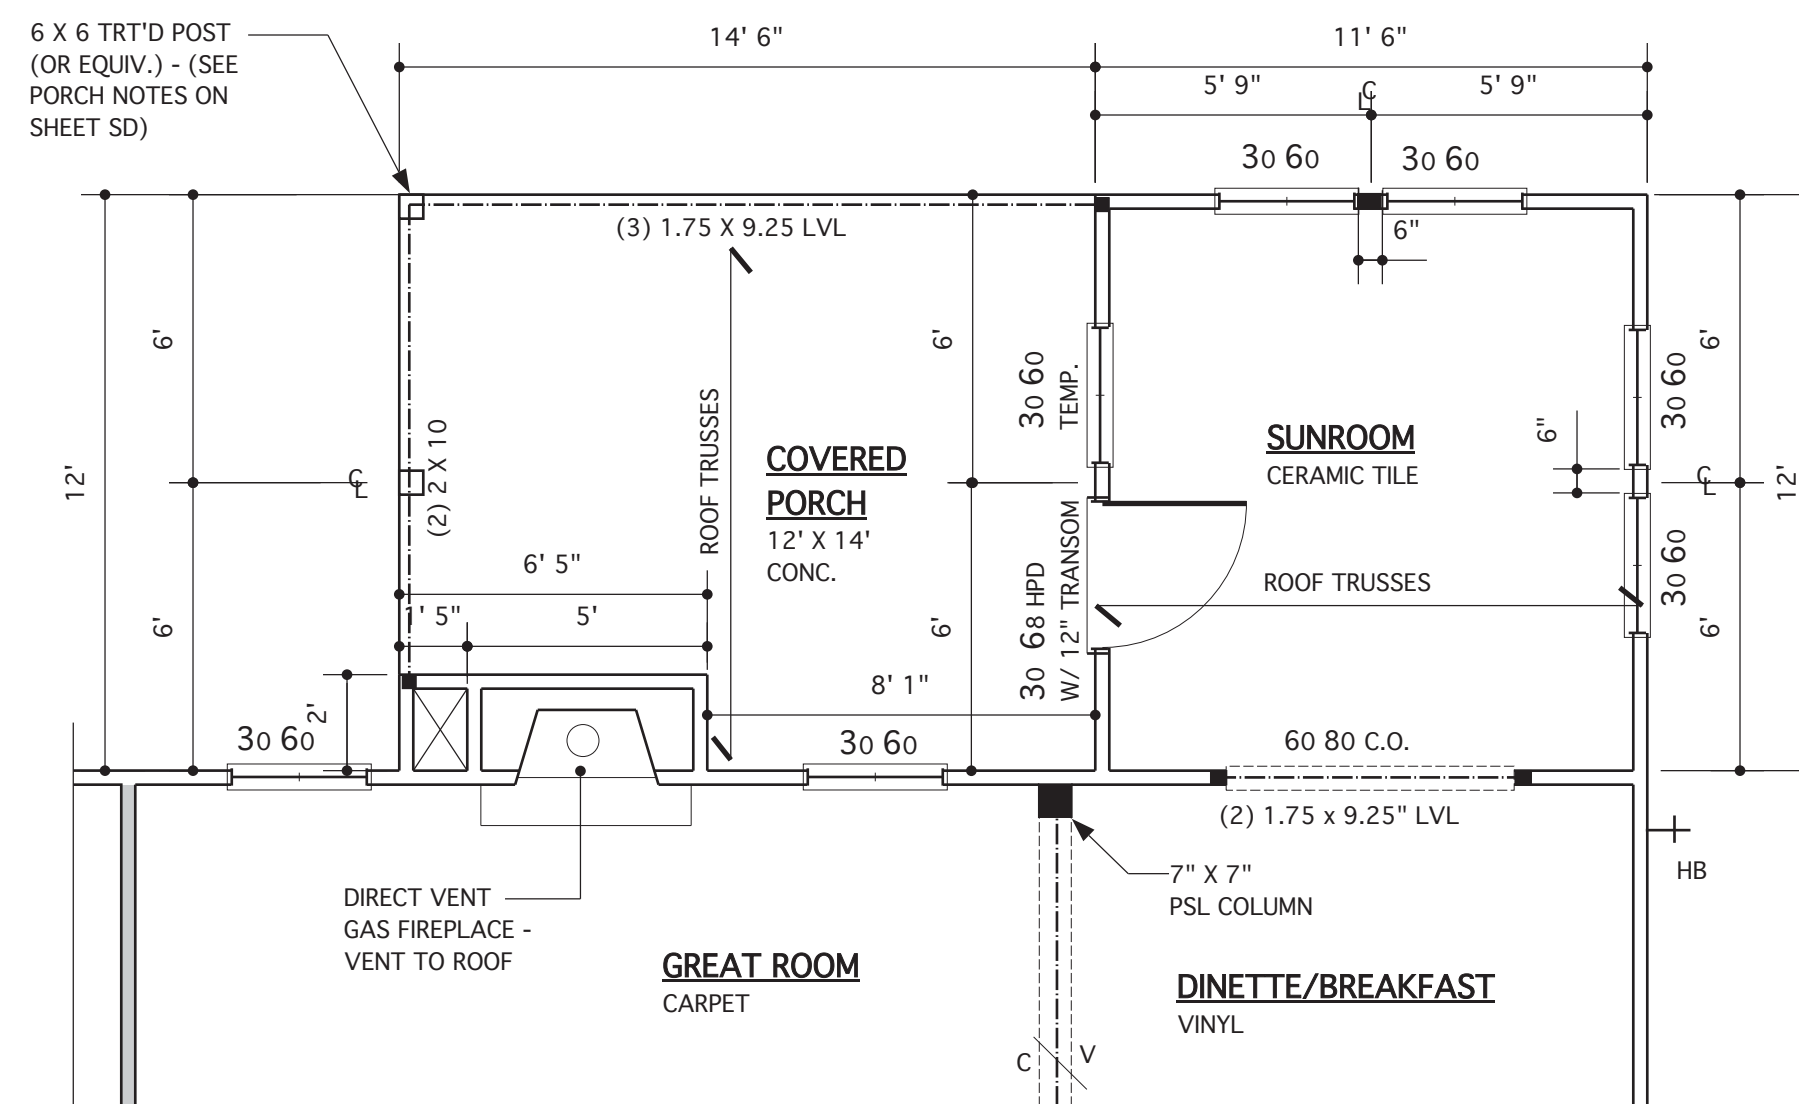

**OPT. SUNROOM W/ OPT. COVERED PORCH**  
SCALE 1/4" = 1'-0" - 9'-0" CLG. U.N.O.

STRUCTURAL DESIGN BY:  
SOUTHERN ENGINEERS, P.A.  
3716 BENSON DR., RALEIGH, NC 27609  
LICENSE: C-1287, PHONE: 919-878-1617  
PROJECT # 19-1059

- \* Engineers seal applies only to structural components on this document. Seal does not include construction means, methods, techniques, sequences, procedures or safety precautions.
- \* Any deviations or discrepancies on plans are to be brought to the immediate attention of Southern Engineers. Failure to do so will void Southern Engineer's liability.
- \* Seal is valid for a project permitted within one year from date of seal.
- \* Use of these plans constitutes approval of terms & conditions as defined in the customer agreement.

REFER TO "SD" SHEET(S) FOR STANDARD DETAILS, BRACING DETAILS AND STRUCTURAL NOTES.

**PORTAL FRAME LEGEND**


SEE SD SHEETS FOR PORTAL FRAME DETAILS

APA-PF: APA PORTAL FRAME

APA-PF-END: END CONDITION FOR APA PORTAL FRAME

CS-PF: CONTINUOUS PORTAL FRAME CONSTRUCTION

CS-PF-END: END CONDITION FOR CONTINUOUS PORTAL FRAME

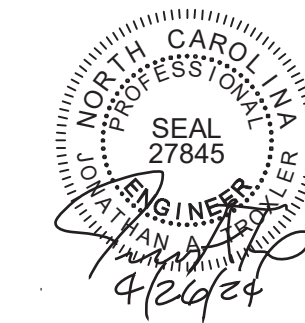

**WALL LEGEND**

- INTERIOR LOAD BEARING WALL
- DENOTES 2 JACK STUDS UNLESS NOTED OTHERWISE

**JAMES WENTLING/  
ARCHITECT**

LAND TITLE BUILDING  
100 SOUTH BROAD STREET,  
SUITE 1524  
PHILADELPHIA, PA 19110

(215) 568-2551  
email - information@  
wentlinghouseplans.com

ARCHITECTURE  
LAND PLANNING  
GRAPHICS

THESE PLANS ARE COPYRIGHTED AND ARE SUBJECT TO COPYRIGHT PROTECTION AS AN "ARCHITECTURAL WORK" UNDER SECTION 102 OF THE COPYRIGHT ACT, 17 U.S.C. AS AMENDED DECEMBER 1, 1990 AND KNOWN AS THE "ARCHITECTURAL WORKS COPYRIGHT PROTECTION ACT OF 1990". THE PROTECTION INCLUDES BUT IS NOT LIMITED TO, THE OVERALL FORM AS WELL AS THE ARRANGEMENT AND COMPOSITION OF SPACES AND ELEMENTS OF THE DESIGN. UNDER SUCH PROTECTION, UNAUTHORIZED USE OF THESE PLANS, WORKS, OR FORMS REPRESENTED CAN LEGALLY RESULT IN THE CESSATION OF SUCH CONSTRUCTION OR BUILDINGS BEING SEIZED AND/OR RAISED.

© Copyright 2016 James Wentling/ Architect



**REVISIONS**

MARK	DATE	DESCRIPTION
DN	04-04-24	CONVERT 113-69/ADD OPT. BATH #2 LM

PROJECT NO.	113-88
DATE	05-18-20
SCALE	AS NOTED
DRAWN BY	CH
CHECKED BY	JW
ISSUED FOR	PERMITS/CONSTRUCTION

PROJECT TITLE  
**MODEL 628 -  
GARAGE LEFT**


CLIENT  
**CHESAPEAKE  
HOMES OF NC**  
3100 Smoketree Court,  
Suite 210  
Raleigh, NC 27604  
(919) 256-3060  
(919) 556-0690 Fax

DRAWING TITLE  
**FIRST FLOOR PLAN -  
OPTIONS**

SHEET  
**3.1.1**



STRUCTURAL DESIGN BY:  
SOUTHERN ENGINEERS, P.A.  
3716 BENSON DR., RALEIGH, NC 27609  
LICENSE: C-1287, PHONE: 919-878-1617  
PROJECT # 19-1059

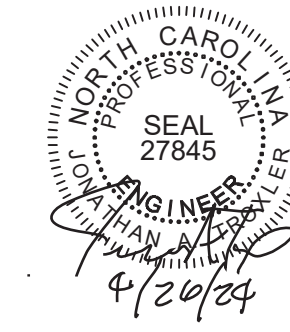


- \* Engineers seal applies only to structural components on this document. Seal does not include construction means, methods, techniques, sequences, procedures or safety precautions.
- \* Any deviations or discrepancies on plans are to be brought to the immediate attention of Southern Engineers. Failure to do so will void Southern Engineer's liability.
- \* Seal is valid for a project permitted within one year from date of seal.
- \* Use of these plans constitutes approval of terms & conditions as defined in the customer agreement.

**PORTAL FRAME LEGEND**

SEE SD SHEETS FOR PORTAL FRAME DETAILS  
**APA-PF:** APA PORTAL FRAME  
**APA-PF-END:** END CONDITION FOR APA PORTAL FRAME  
**CS-PF:** CONTINUOUS PORTAL FRAME CONSTRUCTION  
**CS-PF-END:** END CONDITION FOR CONTINUOUS PORTAL FRAME


REFER TO "SD" SHEET(S) FOR STANDARD DETAILS, BRACING DETAILS AND STRUCTURAL NOTES.

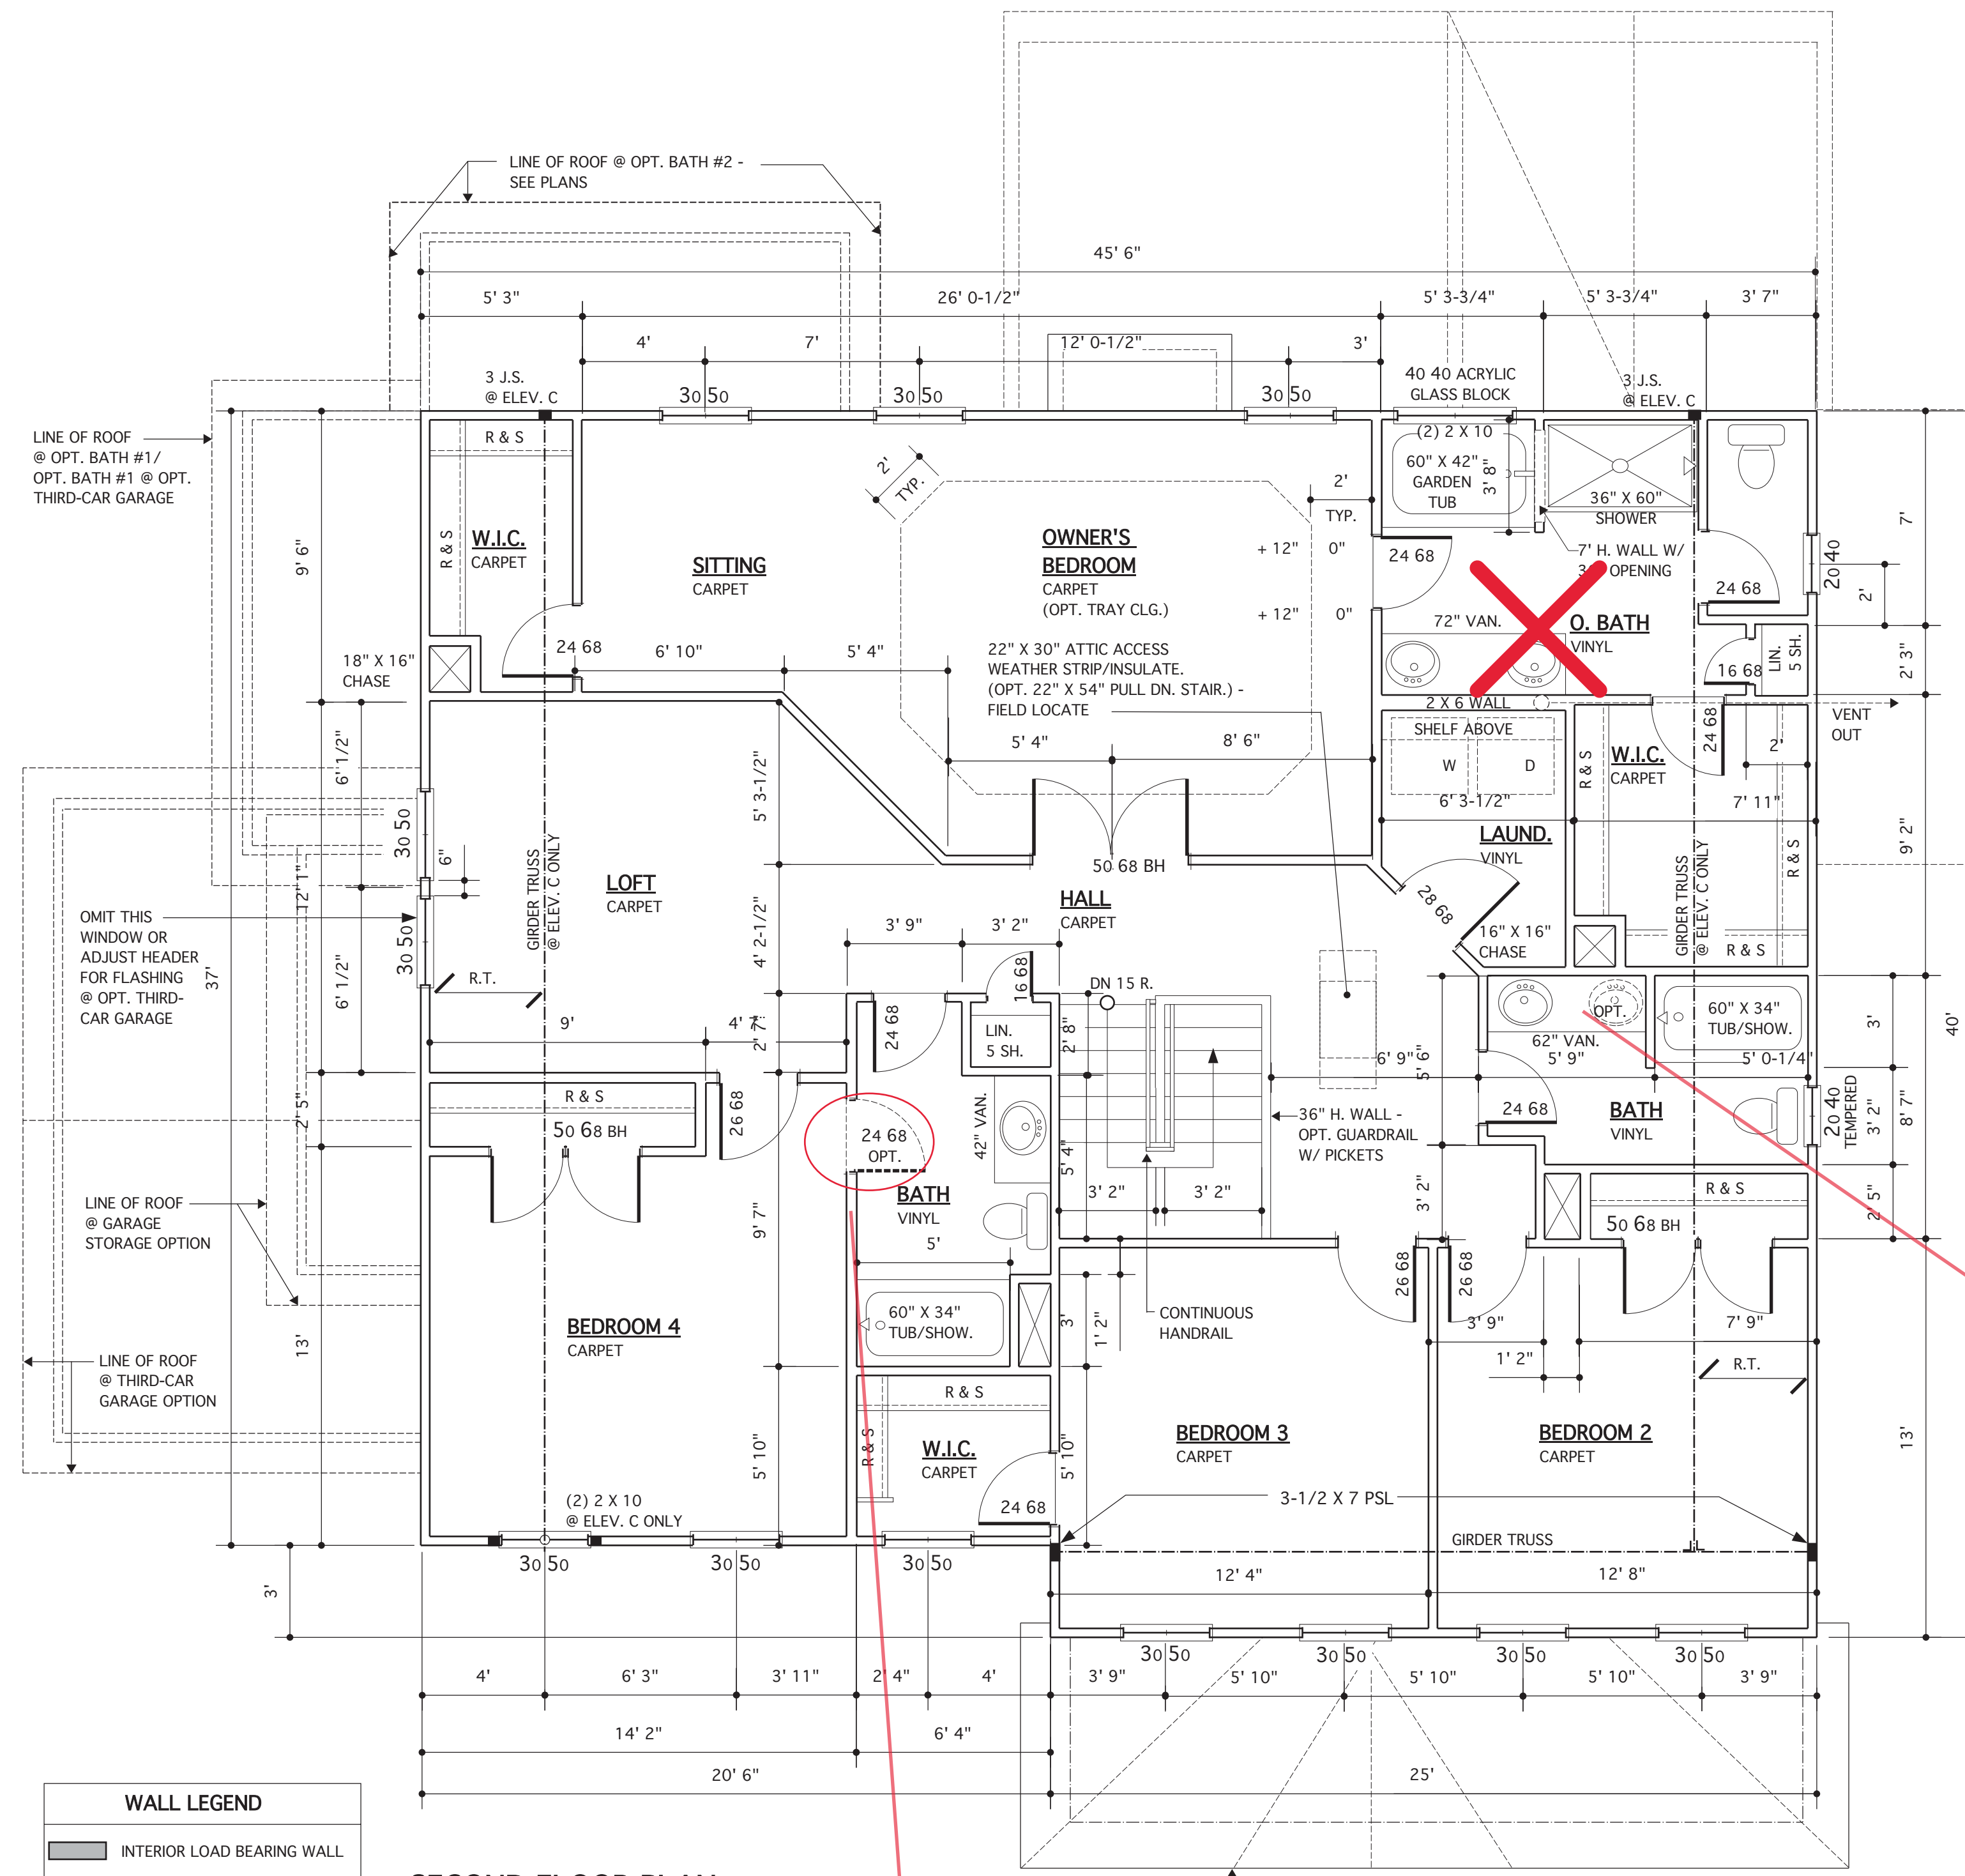

**WALL LEGEND**


	INTERIOR LOAD BEARING WALL
	DENOTES 2 JACK STUDS UNLESS NOTED OTHERWISE

**SECOND FLOOR PLAN**  
SCALE 1/4" = 1'-0" - 8'-0" CLG. U.N.O.  
SEE ELEVATION SHEETS FOR ROOF PLAN

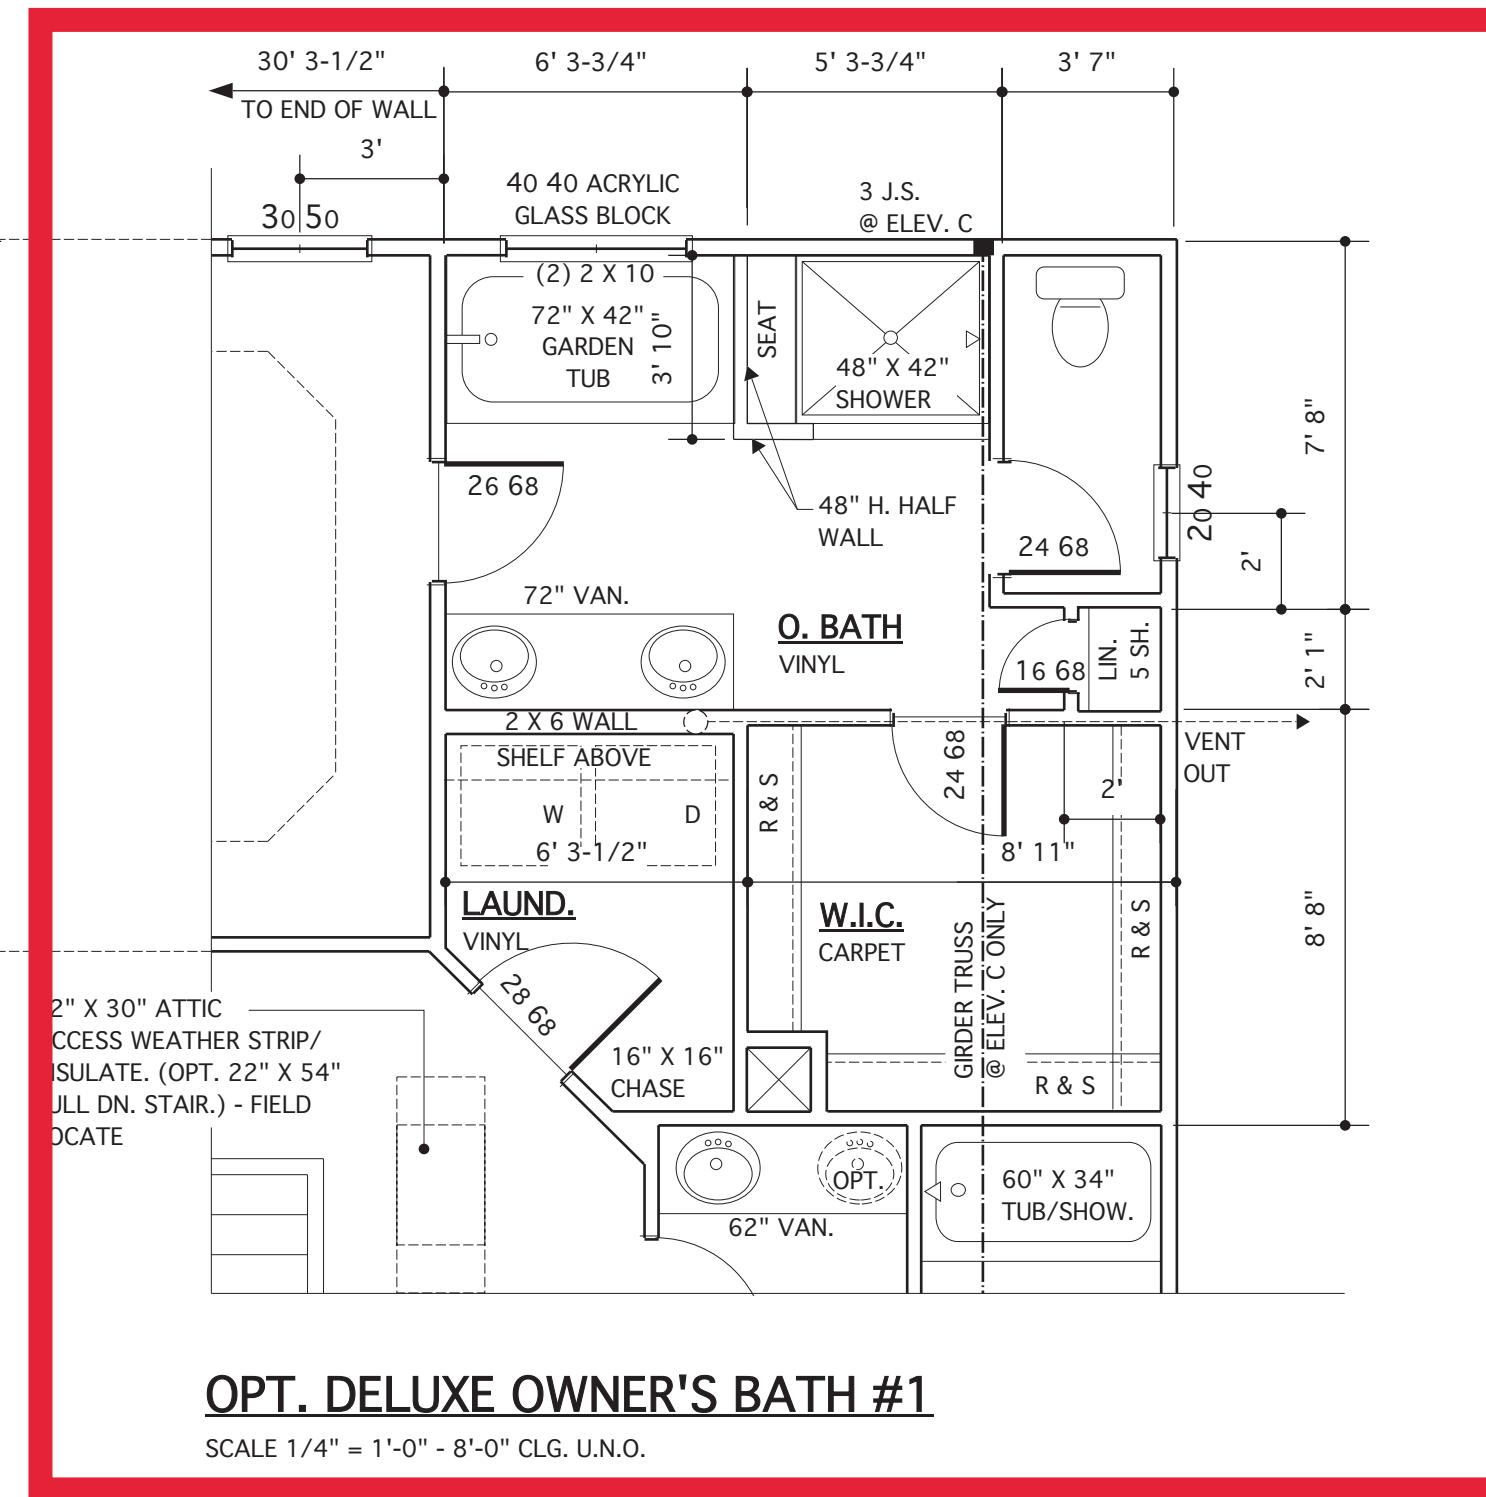

**OPT. DELUXE OWNER'S BATH #1**  
SCALE 1/4" = 1'-0" - 8'-0" CLG. U.N.O.

Double Bowl Sink in Hall Bath

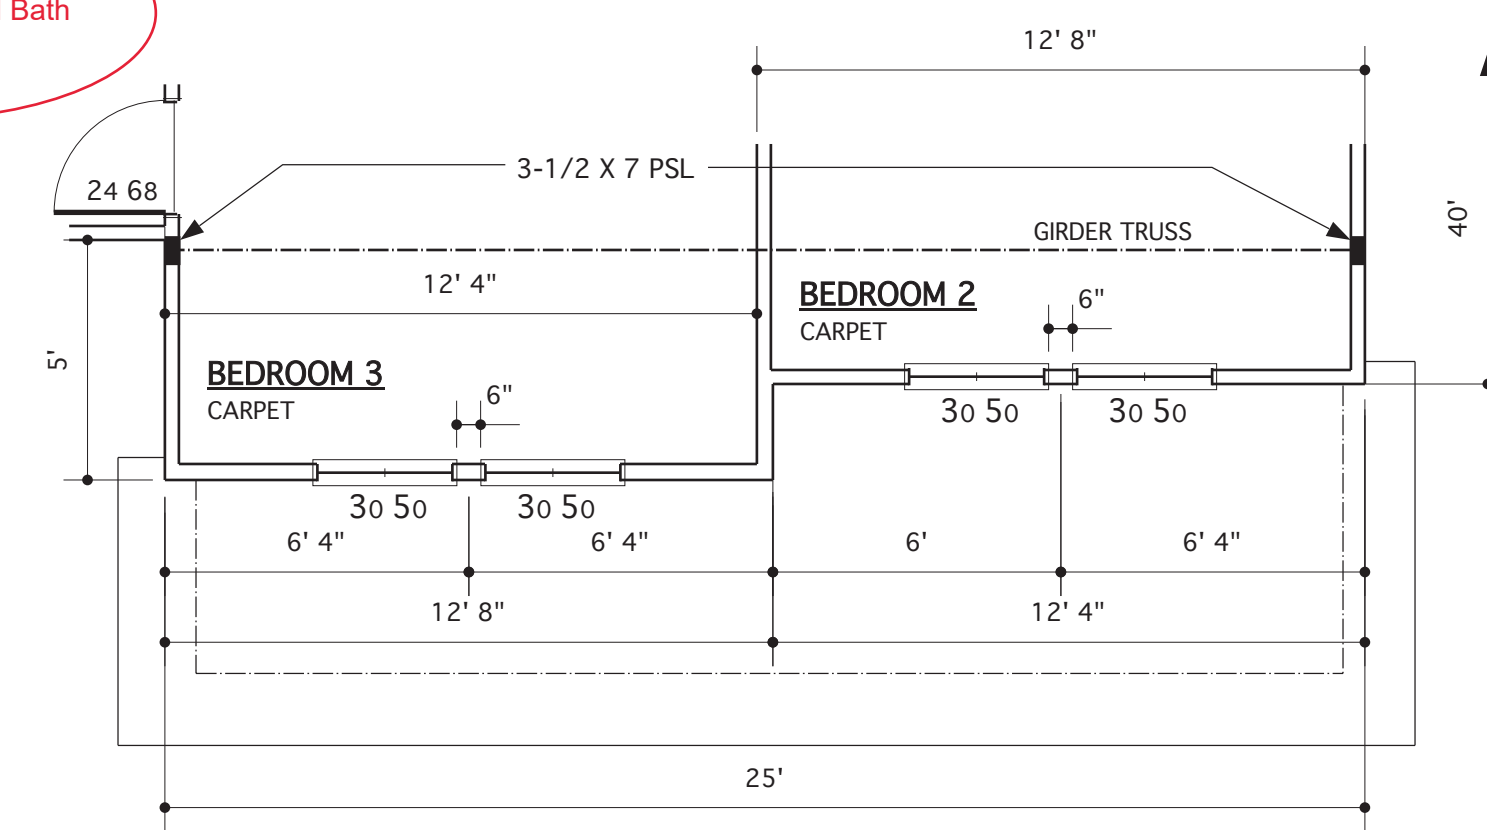

**@ ELEV. D**  
SCALE 1/4" = 1'-0" - 8'-0" CLG. U.N.O.

Door from bath to bed #4


© Copyright 2016 James Wentling/ Architect

**JAMES WENTLING/ ARCHITECT**  
LAND TITLE BUILDING  
100 SOUTH BROAD STREET,  
SUITE 1524  
PHILADELPHIA, PA 19110

(215) 568-2551  
email - information@  
wentlinghouseplans.com

ARCHITECTURE  
LAND PLANNING  
GRAPHICS

THESE PLANS ARE COPYRIGHTED AND ARE SUBJECT TO COPYRIGHT PROTECTION AS AN "ARCHITECTURAL WORK" UNDER SECTION 102 OF THE COPYRIGHT ACT, 17 U.S.C. AS AMENDED DECEMBER 1, 1990 AND KNOWN AS THE "ARCHITECTURAL WORKS COPYRIGHT PROTECTION ACT OF 1990." THE PROTECTION INCLUDES BUT IS NOT LIMITED TO, THE OVERALL FORM AS WELL AS THE ARRANGEMENT AND COMPOSITION OF SPACES AND ELEMENTS OF THE DESIGN. UNDER SUCH PROTECTION, UNAUTHORIZED USE OF THESE PLANS, WORKS, OR FORMS REPRESENTED CAN LEGALLY RESULT IN THE CESSATION OF SUCH CONSTRUCTION OR BUILDINGS BEING SEIZED AND/OR RAISED.

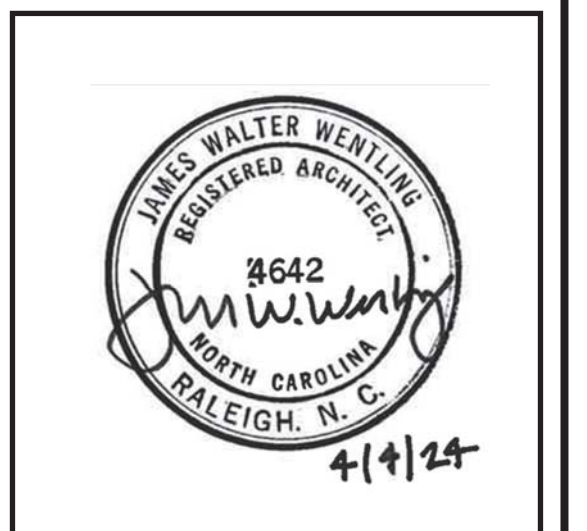

**REVISIONS**

MARK	DATE	DESCRIPTION
DN	01-10-19	CONVERT OLAHS
DN	02-14-19	STRUCT. DWGS. REV.
CH	12-10-19	ADD ELEV. D & E
CH	05-18-20	MINOR UPDATE
DN	04-04-24	CONVERT 113-69/ADD OPT. BATH #2 LM


**PROJECT NO.** 113-88  
**DATE** 01-13-16  
**SCALE** AS NOTED  
**DRAWN BY** JB  
**CHECKED BY** JW  
**ISSUED FOR** PERMITS/CONSTRUCTION

**MODEL 628 - GARAGE LEFT**  
**CLIENT**  
**CHESAPEAKE HOMES OF NC**  
 3100 Smoketree Court,  
 Suite 210  
 Raleigh, NC 27604  
 (919) 256-3060  
 (919) 556-0690 Fax


**DRAWING TITLE**  
**SECOND FLOOR PLAN**

**SHEET**  
**3.2**



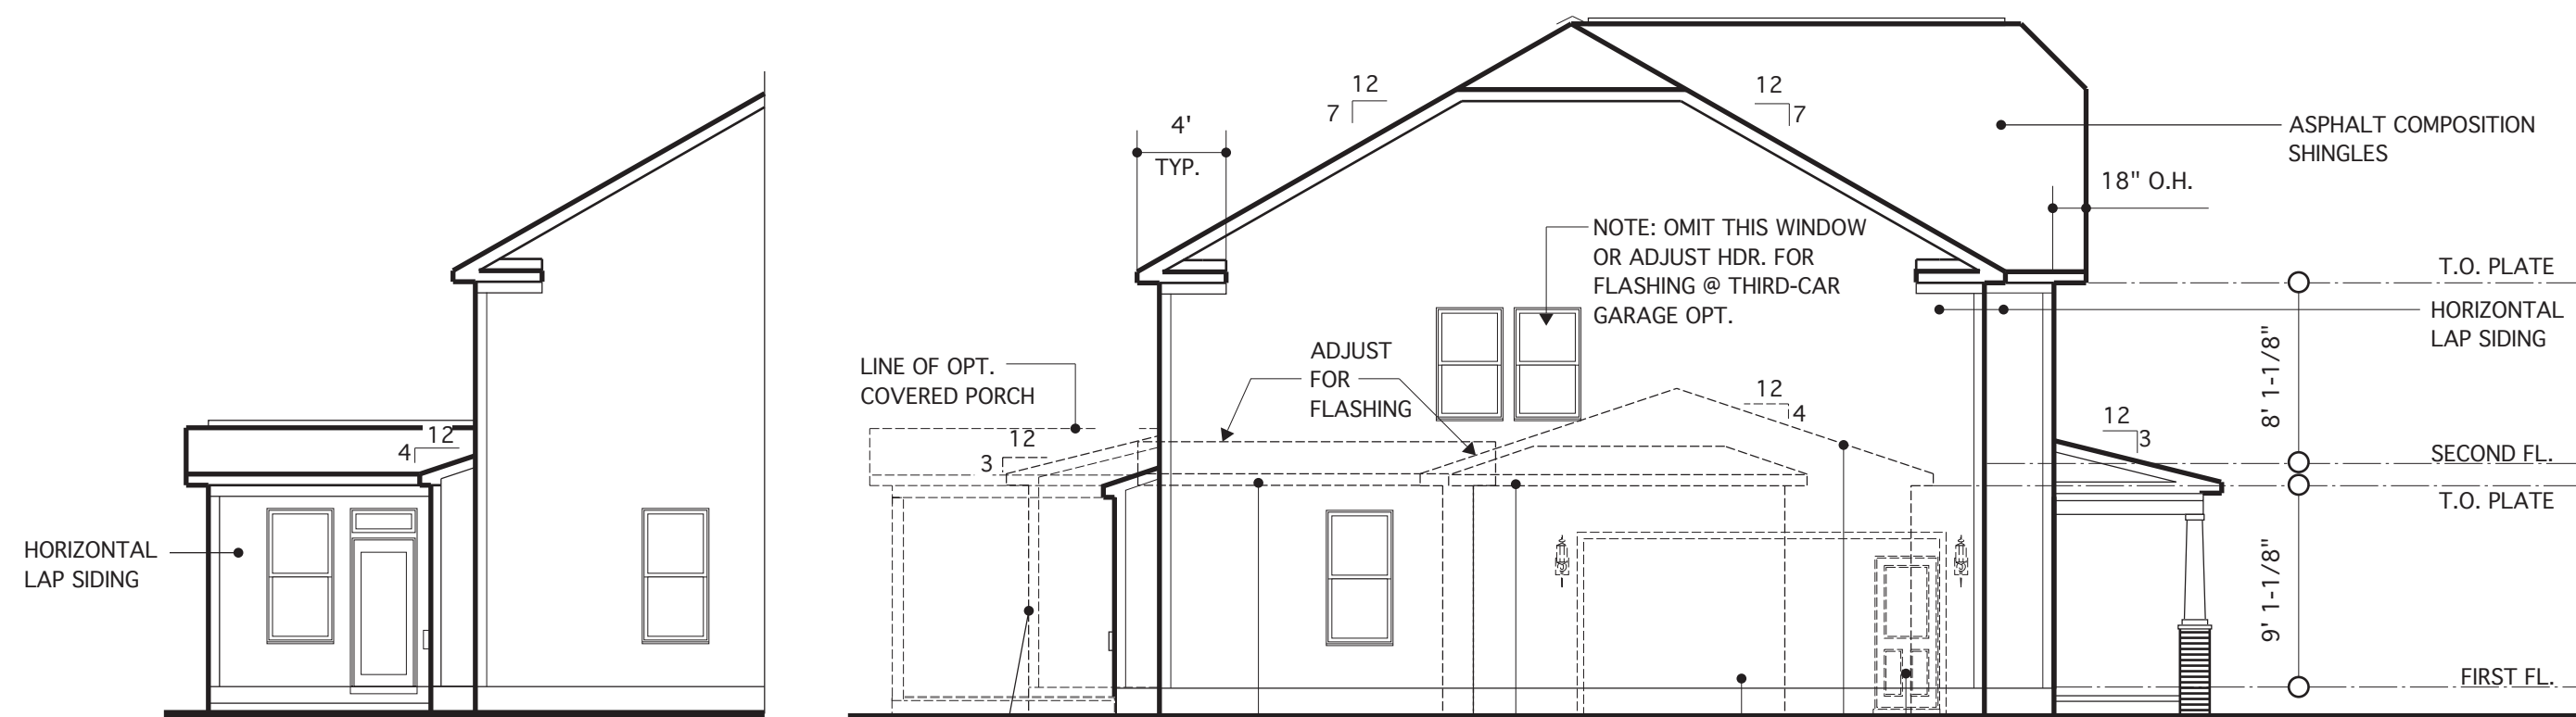


**LEFT ELEVATION W/ OPT. SUNROOM**  
SCALE: 1/8"=1'-0"

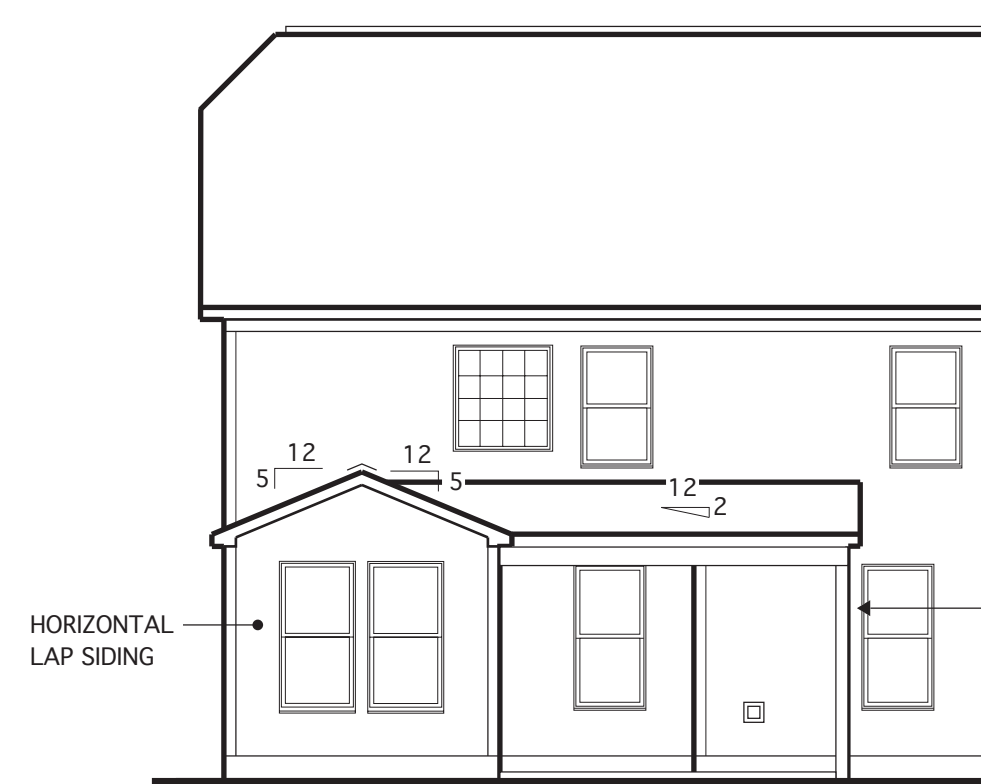


**REAR ELEV. W/ OPT. SUNROOM & OPT. COVERED PORCH**  
SCALE: 1/8"=1'-0"


NOTE: SEE SHEET 4.1 FOR OPT. SUNROOM & OPT. COVERED PORCH W/ ALT. FIREPLACE LOCATION

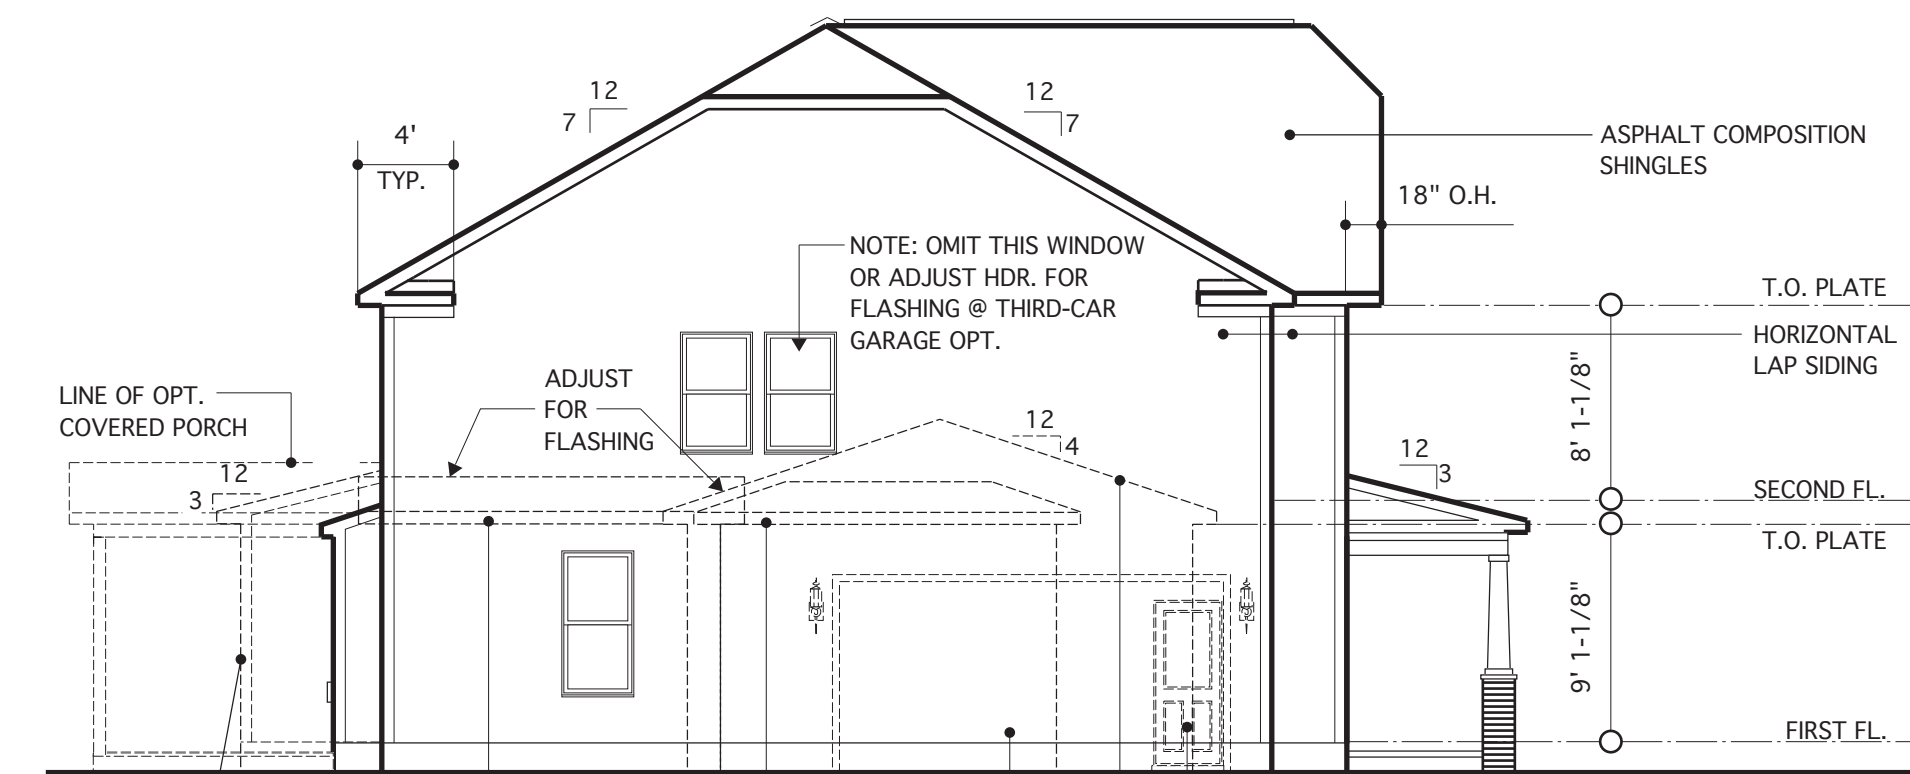


**LEFT ELEVATION**  
SCALE: 1/8"=1'-0"

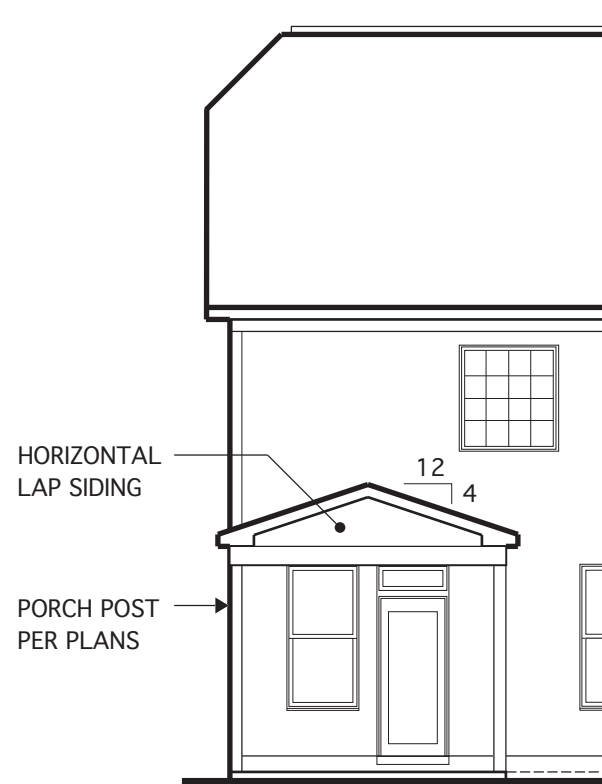


**REAR ELEV. W/ OPT. COVERED PORCH**  
SCALE: 1/8"=1'-0"

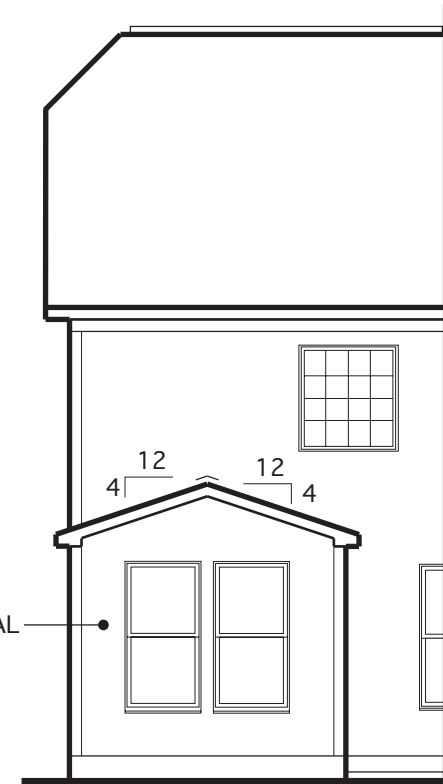


**REAR ELEV. W/ OPT. SUNROOM**  
SCALE: 1/8"=1'-0"

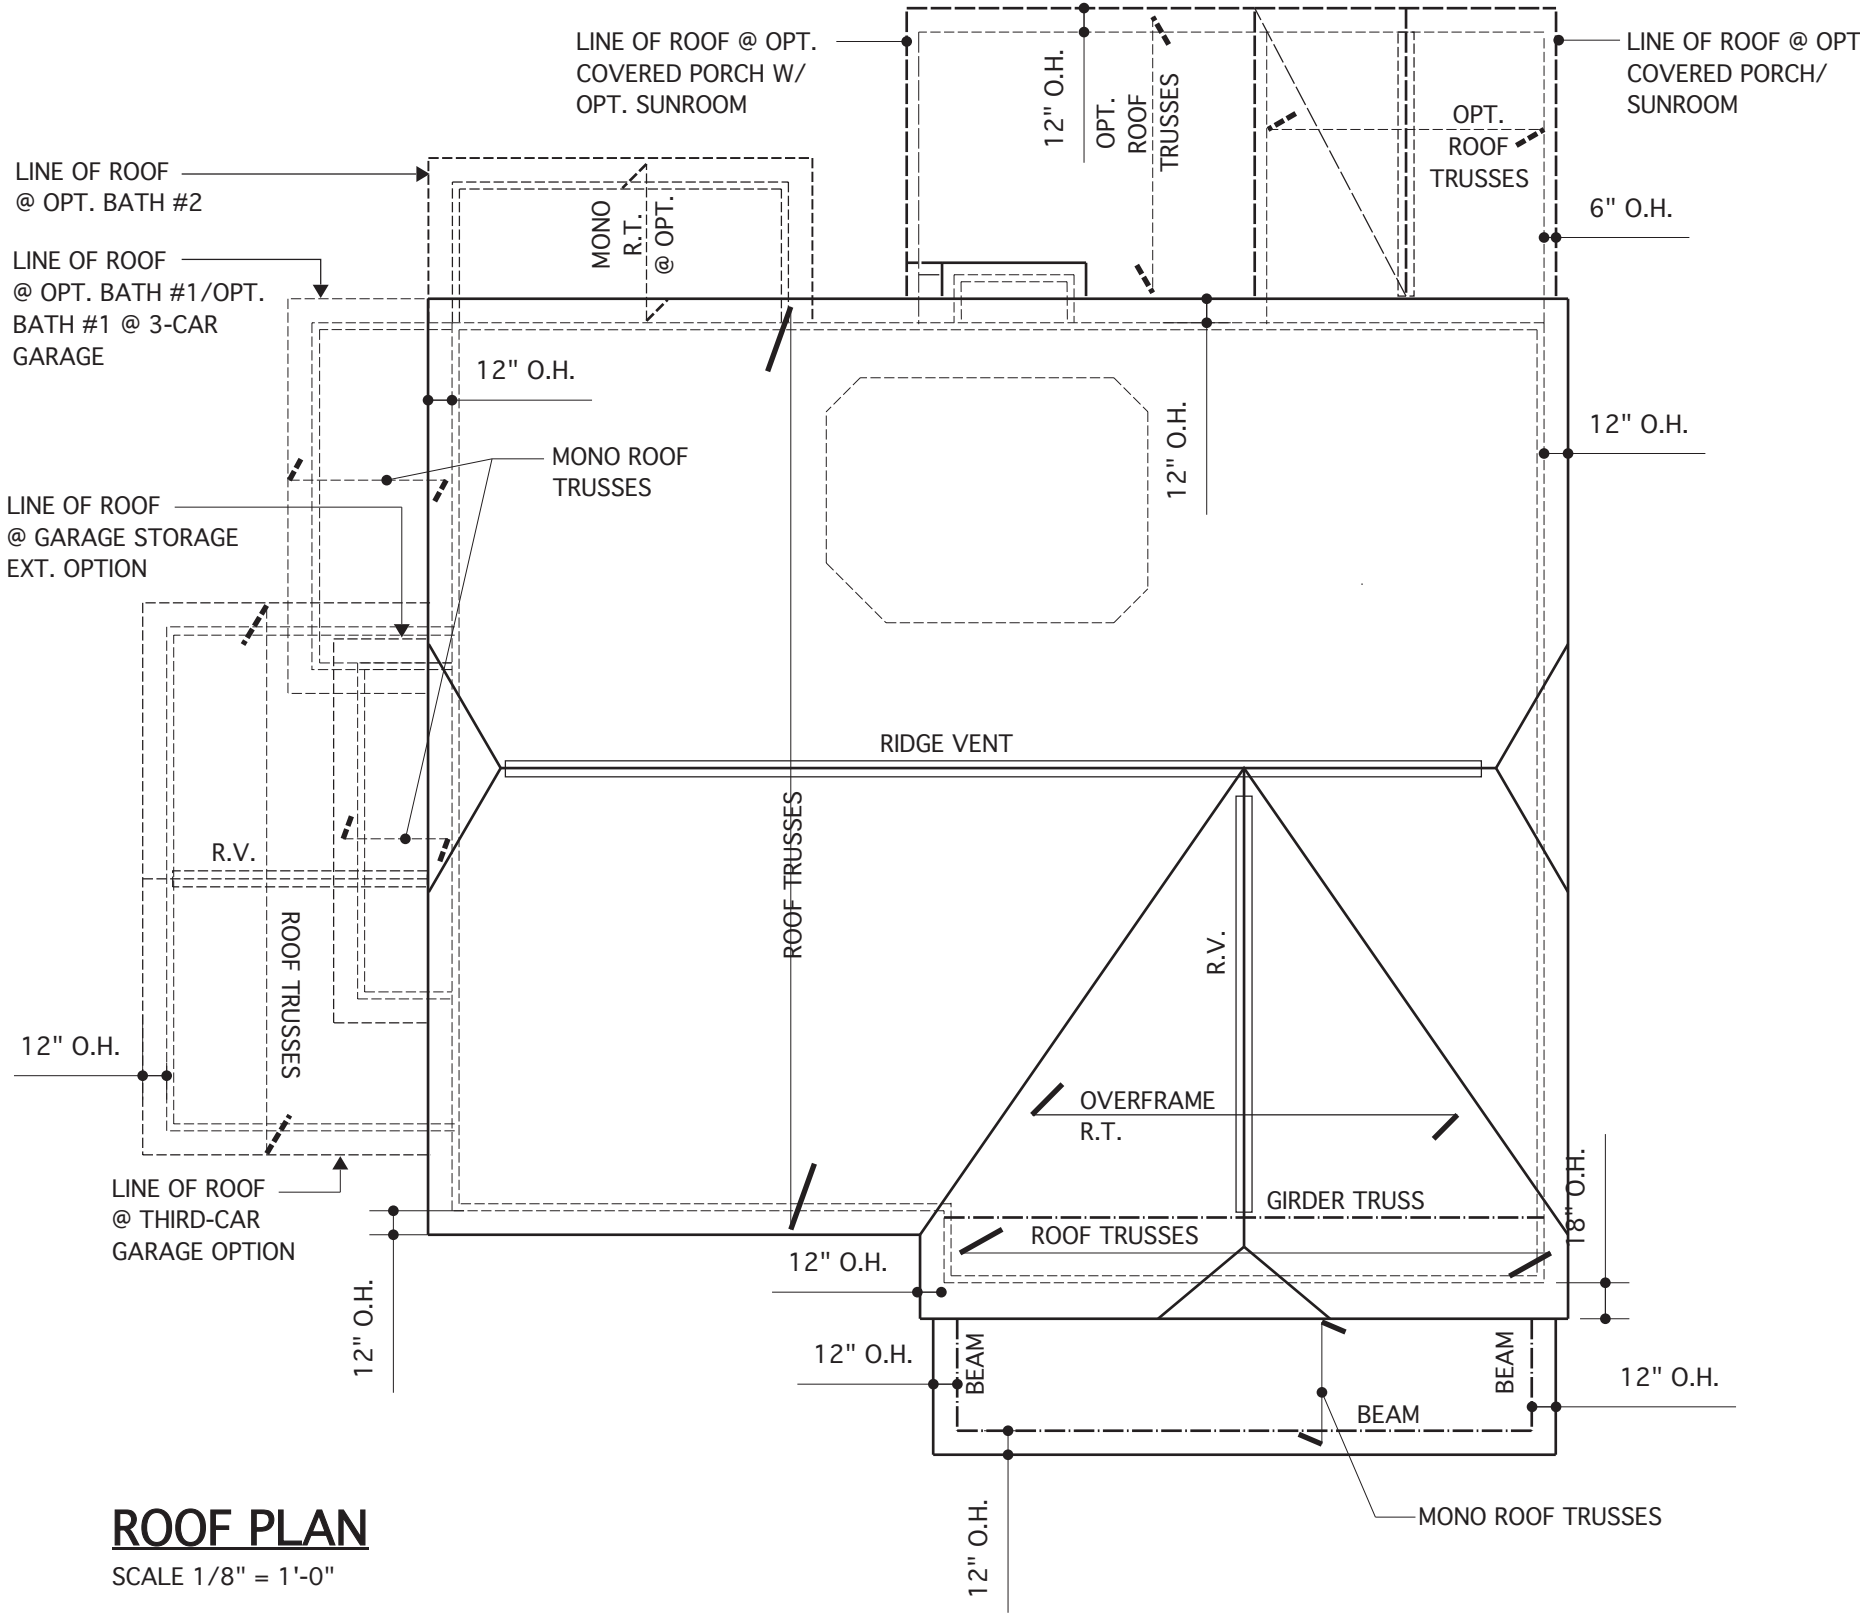


**ROOF PLAN**  
SCALE 1/8" = 1'-0"

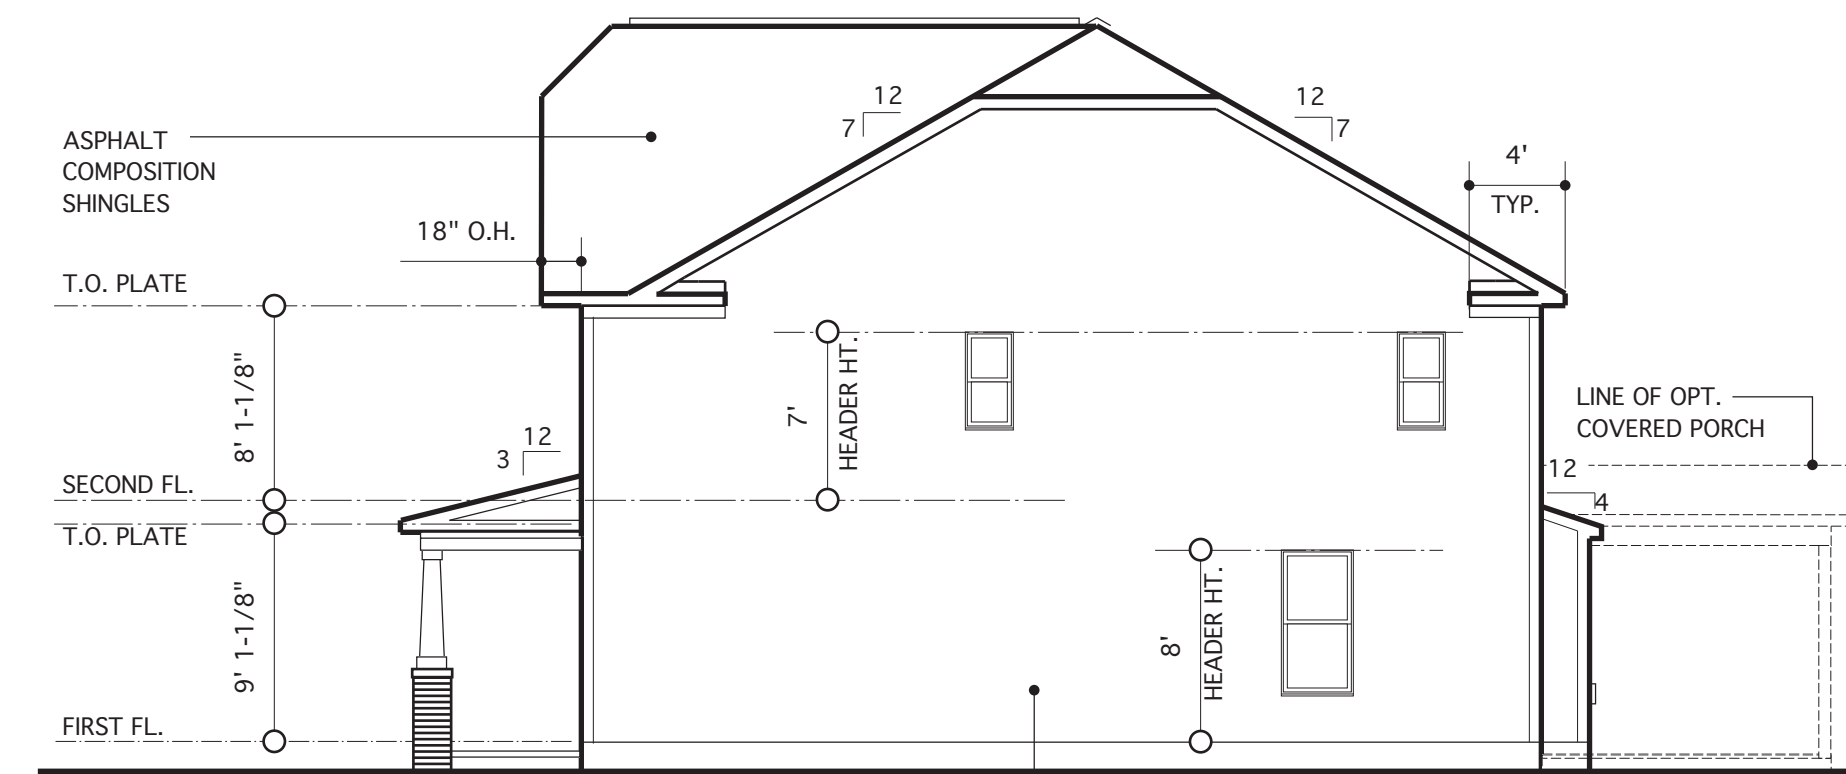


**RIGHT ELEVATION**  
SCALE: 1/8"=1'-0"

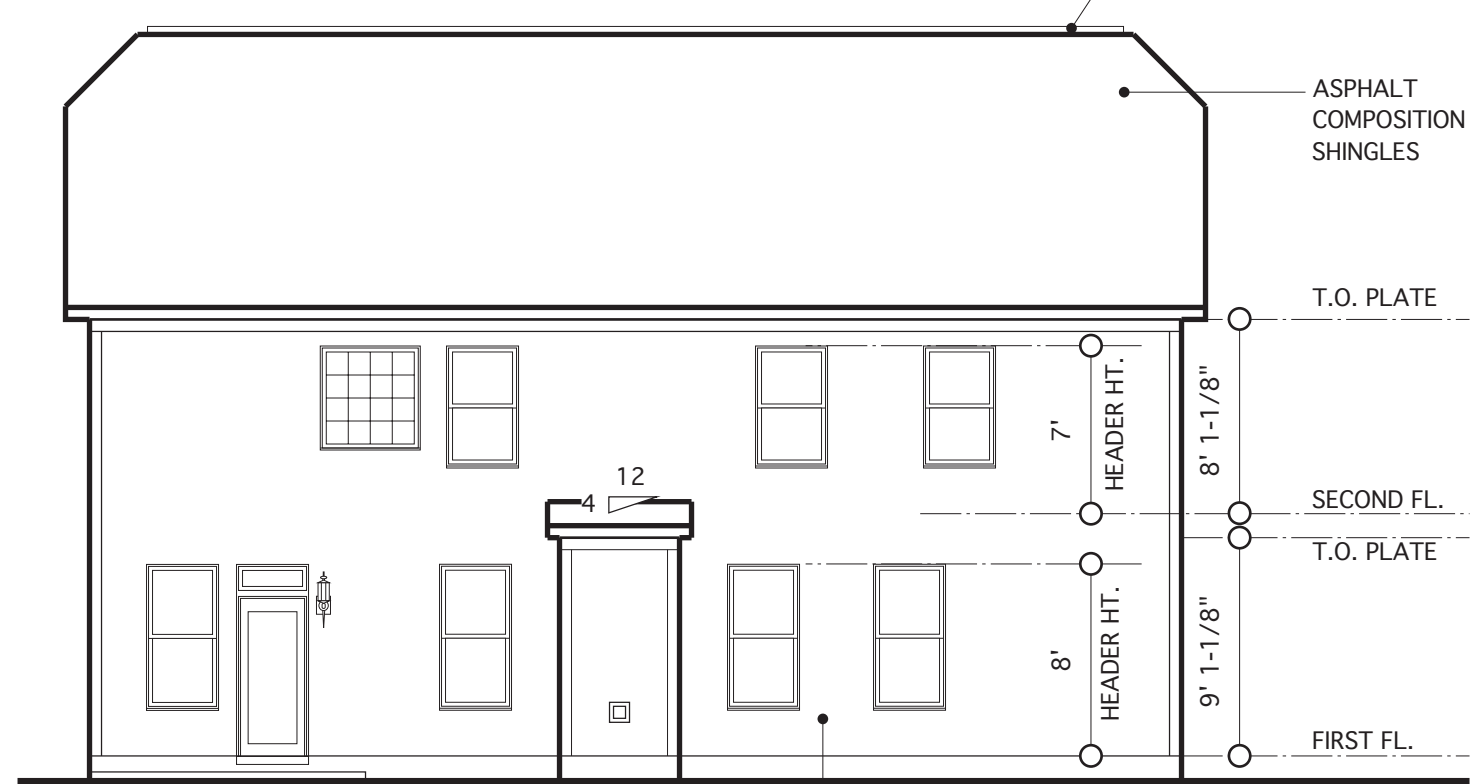

**REAR ELEVATION**  
SCALE: 1/8"=1'-0"

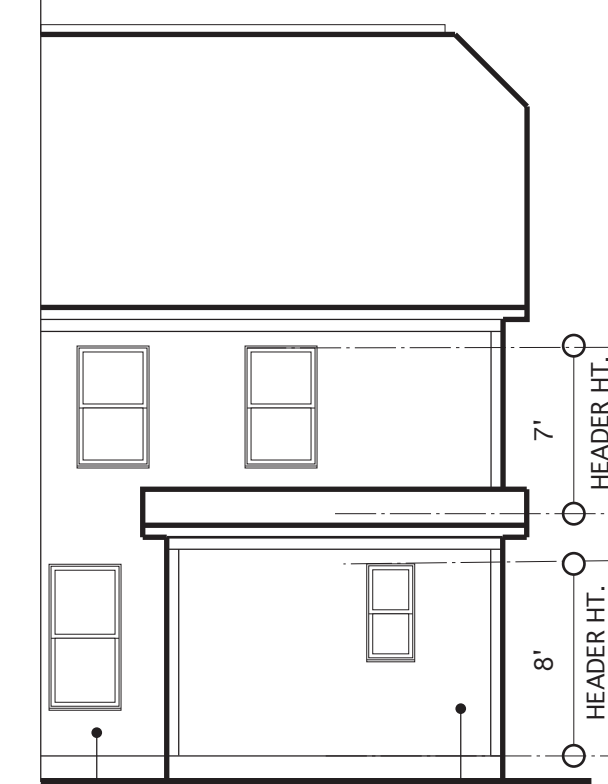

**REAR ELEV. W/ OPT. BATH #2**  
SCALE: 1/8"=1'-0"

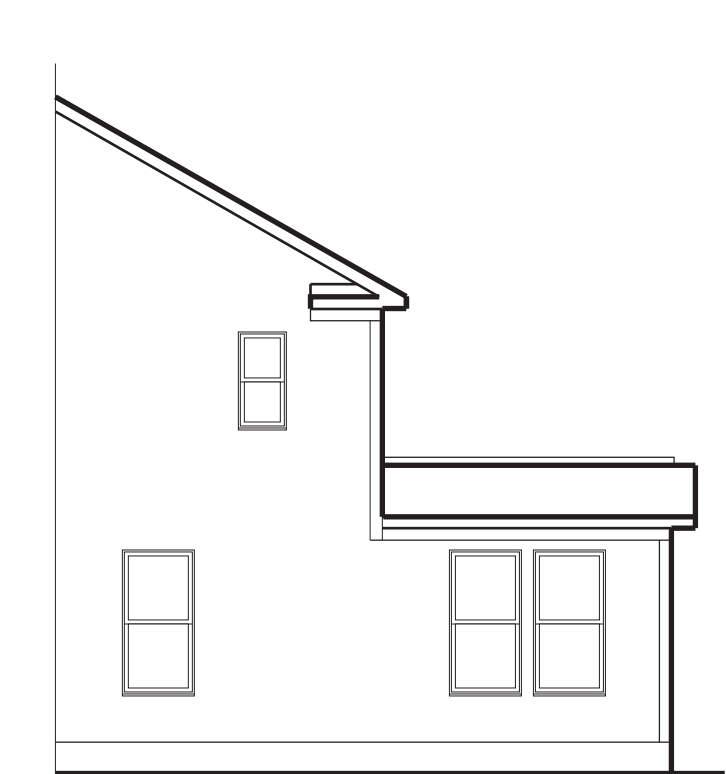

**RIGHT ELEVATION W/ OPT. SUNROOM**  
SCALE: 1/8"=1'-0"

**REQUIRED VENTILATION SCHEDULE - SUNROOM**

138 SQ. FT. OF CEILING AREA / 300	= 0.46 SQ. FT. REQ.
<b>RIDGE VENTS</b> 0.46 X 0.5 = 0.23 SQ. FT. 0.23 SQ. FT. X 144 = 33 SQ. IN. 33 SQ. IN. / 18 SQ. IN. = 1.83 (18 SQ. IN. VENT PER LIN. FT.)	= 1.83 LIN. FT. REQ. (12 LIN. FT. PROVIDED)
<b>SOFFIT VENTS</b> 0.46 X 0.5 = 0.23 SQ. FT. 0.23 SQ. FT. X 144 = 33 SQ. IN. 33 SQ. IN. / 9 SQ. IN. = 3.7 LIN. FT. (9 SQ. IN. VENT PER LIN. FT.)	= 3.7 LIN. FT. REQ. (24 LIN. FT. PROVIDED)

**REQUIRED VENTILATION SCHEDULE - MAIN HOUSE**

1,802 SQ. FT. OF CEILING AREA / 300	= 6.00 SQ. FT. REQ.
<b>RIDGE VENTS</b> 6.0 X 0.5 = 3.00 SQ. FT. 3.00 SQ. FT. X 144 = 432.5 SQ. IN. 432.5 SQ. IN. / 18 SQ. IN. = 24.03 (18 SQ. IN. VENT PER LIN. FT.)	= 25 LIN. FT. REQ. (58 LIN. FT. PROVIDED)
<b>SOFFIT VENTS</b> 6.0 X 0.5 = 3.00 SQ. FT. 3.00 SQ. FT. X 144 = 432.5 SQ. IN. 432.5 SQ. IN. / 12 SQ. IN. = 36.04 LIN. FT. (12 SQ. IN. VENT PER LIN. FT.)	= 37 LIN. FT. REQ. (72 LIN. FT. PROVIDED)

CODE REFERENCE: 2018 NCSRC, SEC. R806.2

**NOTE:**  
BUILDING ELEMENTS ARE TO BE APPLIED TO MEET LOCAL WINDLOAD REQUIREMENTS



**FRONT ELEVATION A**  
SCALE 1/4" = 1'-0"

**JAMES WENTLING/ ARCHITECT**  
LAND TITLE BUILDING  
100 SOUTH BROAD STREET,  
SUITE 1524  
PHILADELPHIA, PA 19110

(215) 568-2551  
email - information@  
wentlinghouseplans.com

ARCHITECTURE  
LAND PLANNING  
GRAPHICS

THESE PLANS ARE COPYRIGHTED AND ARE SUBJECT TO COPYRIGHT PROTECTION AS AN "ARCHITECTURAL WORK" UNDER SECTION 102 OF THE COPYRIGHT ACT, 17 U.S.C. AS AMENDED DECEMBER 1, 1990 AND KNOWN AS THE "ARCHITECTURAL WORKS COPYRIGHT PROTECTION ACT OF 1990." THE PROTECTION INCLUDES BUT IS NOT LIMITED TO, THE OVERALL FORM AS WELL AS THE ARRANGEMENT AND COMPOSITION OF SPACES AND ELEMENTS OF THE DESIGN. UNDER SUCH PROTECTION, UNAUTHORIZED USE OF THESE PLANS, WORKS, OR FORMS REPRESENTED CAN LEGALLY RESULT IN THE CESSATION OF SUCH CONSTRUCTION OR BUILDINGS BEING SEIZED AND/OR RAISED.

© Copyright 2016 James Wentling/ Architect

**JAMES WALTER WENTLING**  
REGISTERED ARCHITECT  
#642  
NORTH CAROLINA  
RALEIGH, N. C.  
4/1/24

**REVISIONS**

MARK	DATE	DESCRIPTION
DN	01-10-19	CONVERT OLAHS
DN	02-14-19	STRUCT. DWGS. REV.
CH	12-10-19	WINDOW UPDATE
CH	05-18-20	MINOR UPDATE
DN	04-04-24	CONVERT 113-69/ADD OPT. BATH #2 L.M.

PROJECT NO. 113-88  
DATE 01-13-16  
SCALE AS NOTED  
DRAWN BY JB  
CHECKED BY JW  
ISSUED FOR PERMITS/CONSTRUCTION

PROJECT TITLE  
**MODEL 628 - GARAGE LEFT**

CLIENT  
**CHESAPEAKE HOMES OF NC**  
3100 Smoketree Court,  
Suite 210  
Raleigh, NC 27604  
(919) 256-3060  
(919) 556-0690 Fax

DRAWING TITLE  
**ELEVATION A AND ROOF PLAN**

SHEET  
**4**



**JAMES WENTLING/  
ARCHITECT**  
LAND TITLE BUILDING  
100 SOUTH BROAD STREET,  
SUITE 1524  
PHILADELPHIA, PA 19110  
  
(215) 568-2551  
email - information@  
wentlinghouseplans.com

ARCHITECTURE  
LAND PLANNING  
GRAPHICS

THESE PLANS ARE COPYRIGHTED AND ARE SUBJECT TO COPYRIGHT PROTECTION AS AN "ARCHITECTURAL WORK" UNDER SECTION 102 OF THE COPYRIGHT ACT, 17 U.S.C. AS AMENDED DECEMBER 1, 1990 AND KNOWN AS THE "ARCHITECTURAL WORKS" COPYRIGHT PROTECTION ACT OF 1990. THE PROTECTION INCLUDES BUT IS NOT LIMITED TO, THE OVERALL FORM AS WELL AS THE ARRANGEMENT AND COMPOSITION OF SPACES AND ELEMENTS OF THE DESIGN. UNDER SUCH PROTECTION, UNAUTHORIZED USE OF THESE PLANS, WORKS, OR FORMS REPRESENTED CAN LEGALLY RESULT IN THE CESSATION OF SUCH CONSTRUCTION OR BUILDINGS BEING SEIZED AND/OR RAISED.



REVISIONS


MARK	DATE	DESCRIPTION
DN	01-10-19	CONVERT OLAHS
DN	02-14-19	STRUCT. DWGS. REV.
CH	12-10-19	WINDOW UPDATE
CH	05-18-20	MINOR UPDATE
DN	04-04-24	CONVERT 113-69/ADD OPT. BATH #2 LM

PROJECT NO. 113-88  
DATE 01-13-16  
SCALE AS NOTED  
DRAWN BY JB  
CHECKED BY JW  
ISSUED FOR PERMITS/CONSTRUCTION

PROJECT TITLE  
**MODEL 628 -  
GARAGE LEFT**  
  
CLIENT  
**CHESAPEAKE  
HOMES OF NC**  
3100 Smoketree Court,  
Suite 210  
Raleigh, NC 27604  
(919) 256-3060  
(919) 556-0690 Fax

DRAWING TITLE  
**ELEVATION B  
AND ROOF PLAN**

SHEET  
**4.1**

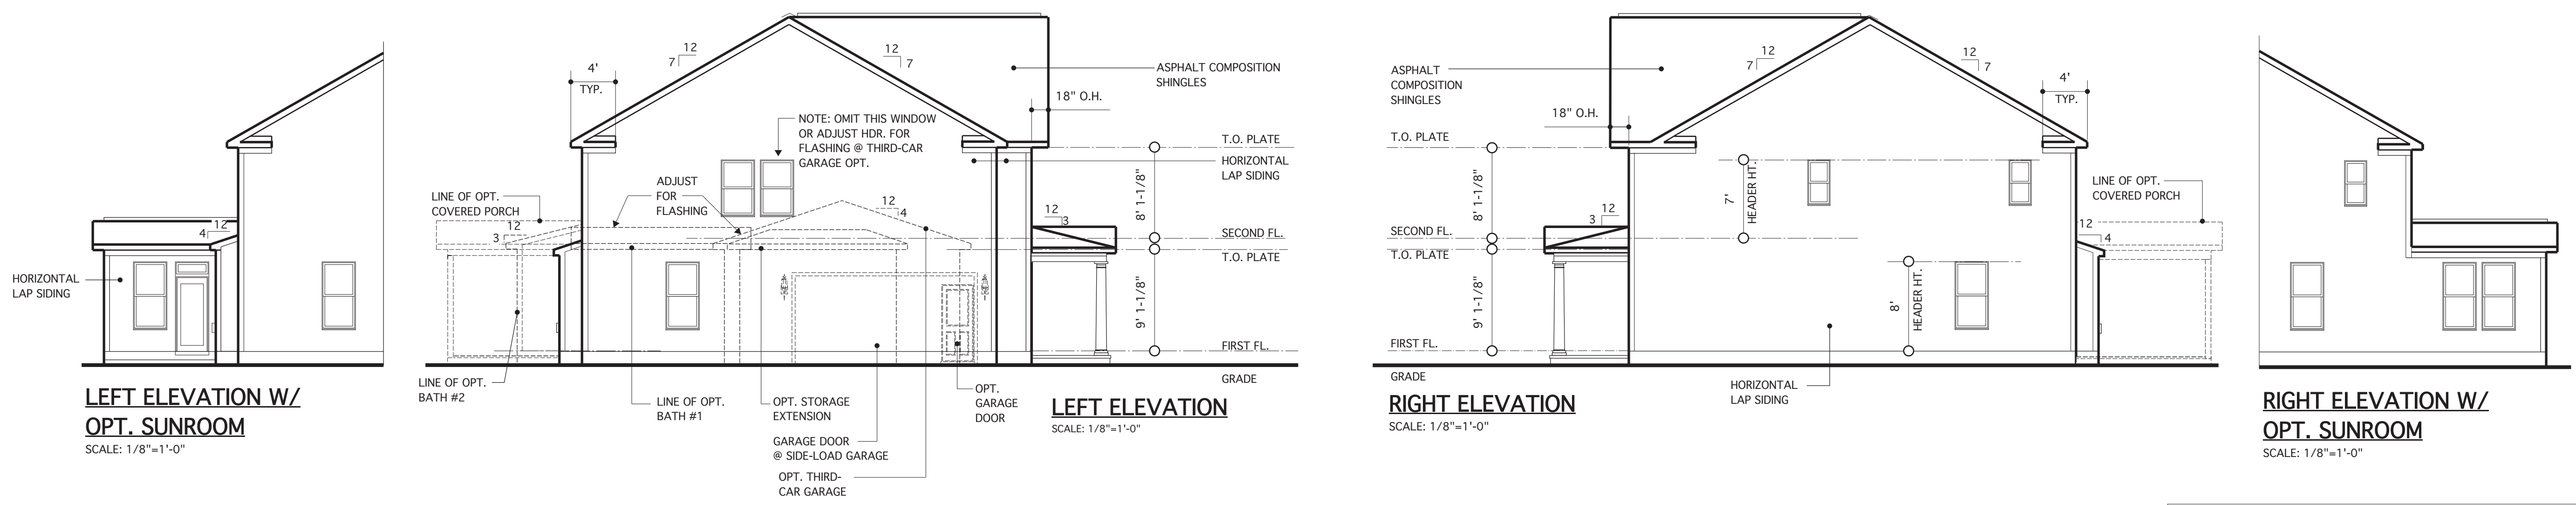


**REQUIRED VENTILATION SCHEDULE - SUNROOM**

138 SQ. FT. OF CEILING AREA / 300	= 0.46 SQ. FT. REQ.
<b>RIDGE VENTS</b> 0.46 X 0.5 = 0.23 SQ. FT. 0.23 SQ. FT. X 144 = 33 SQ. IN. 33 SQ. IN. / 18 SQ. IN. = 1.83 (18 SQ. IN. VENT PER LIN. FT.)	= 1.83 LIN. FT. REQ. (12 LIN. FT. PROVIDED)
<b>SOFFIT VENTS</b> 0.46 X 0.5 = 0.23 SQ. FT. 0.23 SQ. FT. X 144 = 33 SQ. IN. 33 SQ. IN. / 9 SQ. IN. = 3.7 LIN. FT. (9 SQ. IN. VENT PER LIN. FT.)	= 3.7 LIN. FT. REQ. (24 LIN. FT. PROVIDED)

**REQUIRED VENTILATION SCHEDULE - MAIN HOUSE**

1,777 SQ. FT. OF CEILING AREA / 300	= 5.92 SQ. FT. REQ.
<b>RIDGE VENTS</b> 5.92 X 0.5 = 2.96 SQ. FT. 2.96 SQ. FT. X 144 = 426 SQ. IN. 426 SQ. IN. / 18 SQ. IN. = 23.7 (18 SQ. IN. VENT PER LIN. FT.)	= 23.7 LIN. FT. REQ. (66 LIN. FT. PROVIDED)
<b>SOFFIT VENTS</b> 5.92 X 0.5 = 2.96 SQ. FT. 2.96 SQ. FT. X 144 = 426 SQ. IN. 426 SQ. IN. / 12 SQ. IN. = 35.5 LIN. FT. (12 SQ. IN. VENT PER LIN. FT.)	= 35.5 LIN. FT. REQ. (72 LIN. FT. PROVIDED)

CODE REFERENCE: 2018 NCSRC, SEC. R806.2  
**NOTE:**  
BUILDING ELEMENTS ARE TO BE APPLIED TO MEET  
LOCAL WINDLOAD REQUIREMENTS

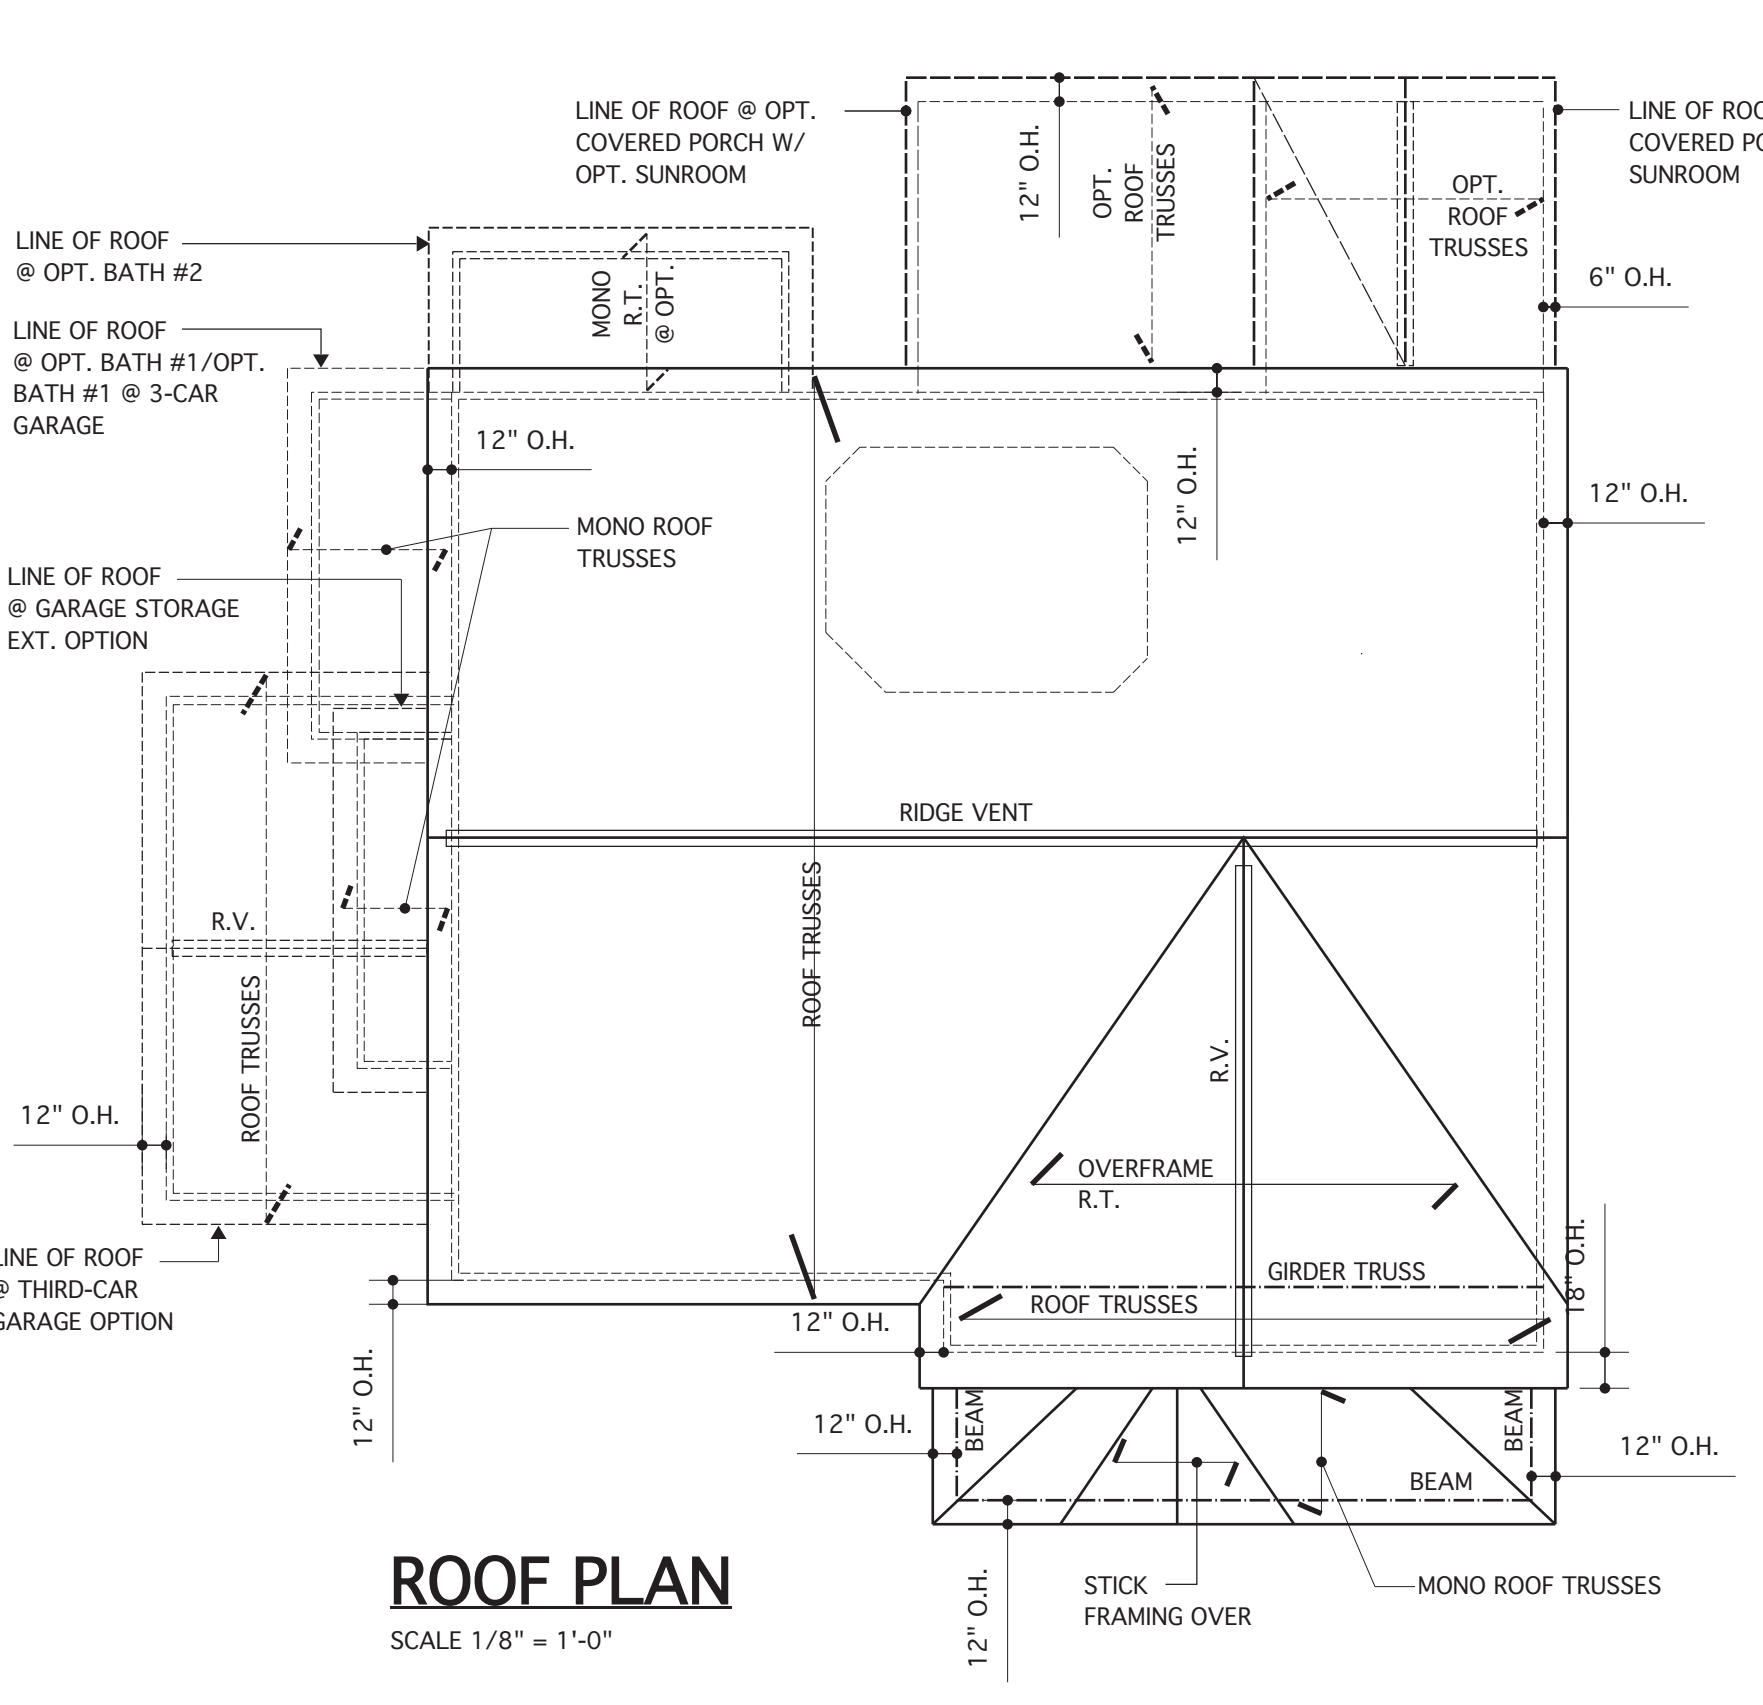


© Copyright 2016 James Wentling/Architect






**LEFT ELEVATION W/  
OPT. SUNROOM**

SCALE: 1/8"=1'-0"

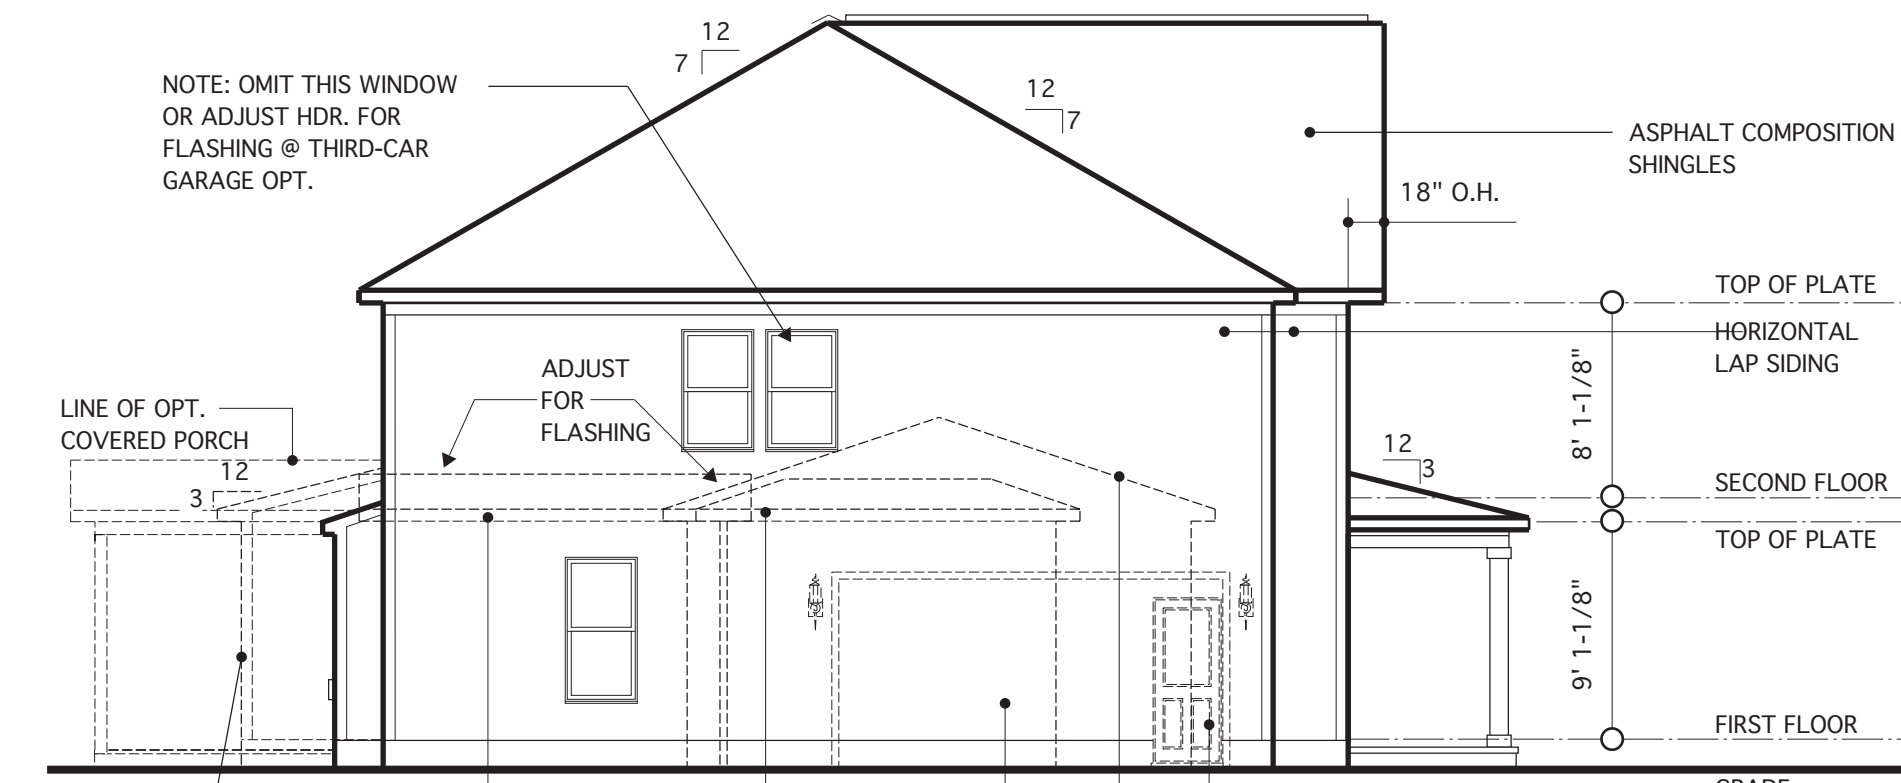


**LEFT ELEVATION**

SCALE: 1/8"=1'-0"

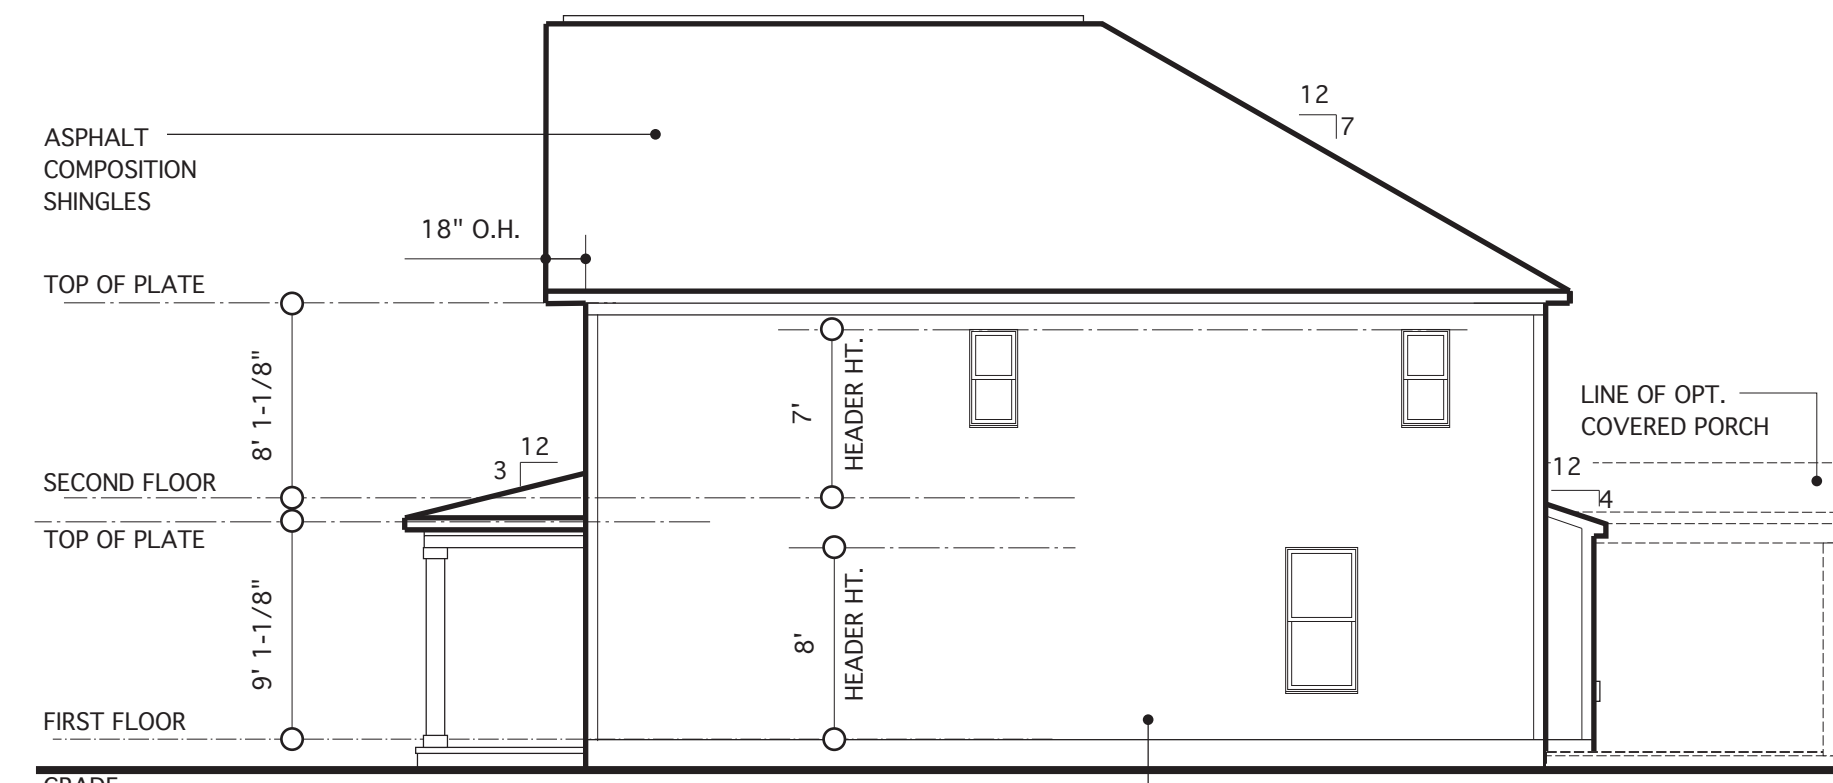


**RIGHT ELEVATION**

SCALE: 1/8"=1'-0"

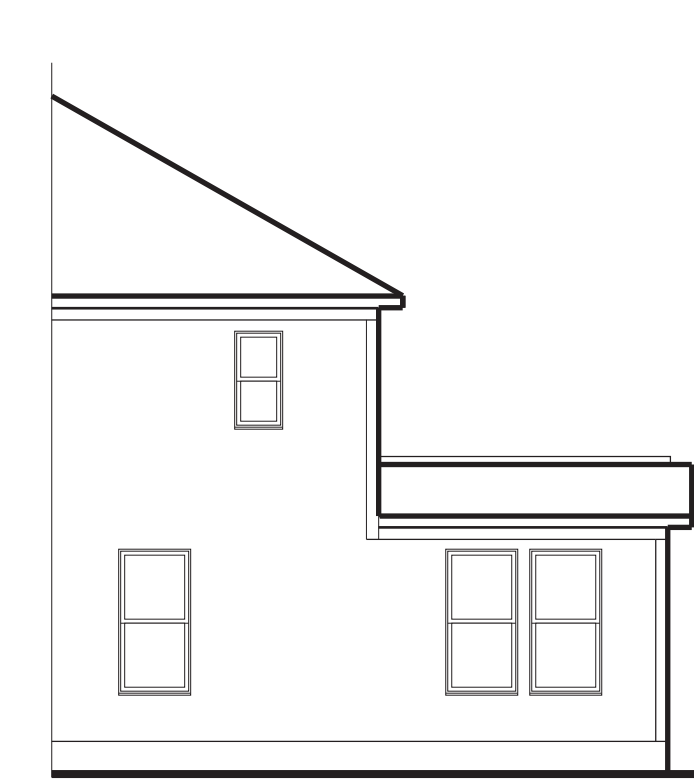


**RIGHT ELEVATION W/  
OPT. SUNROOM**

SCALE: 1/8"=1'-0"

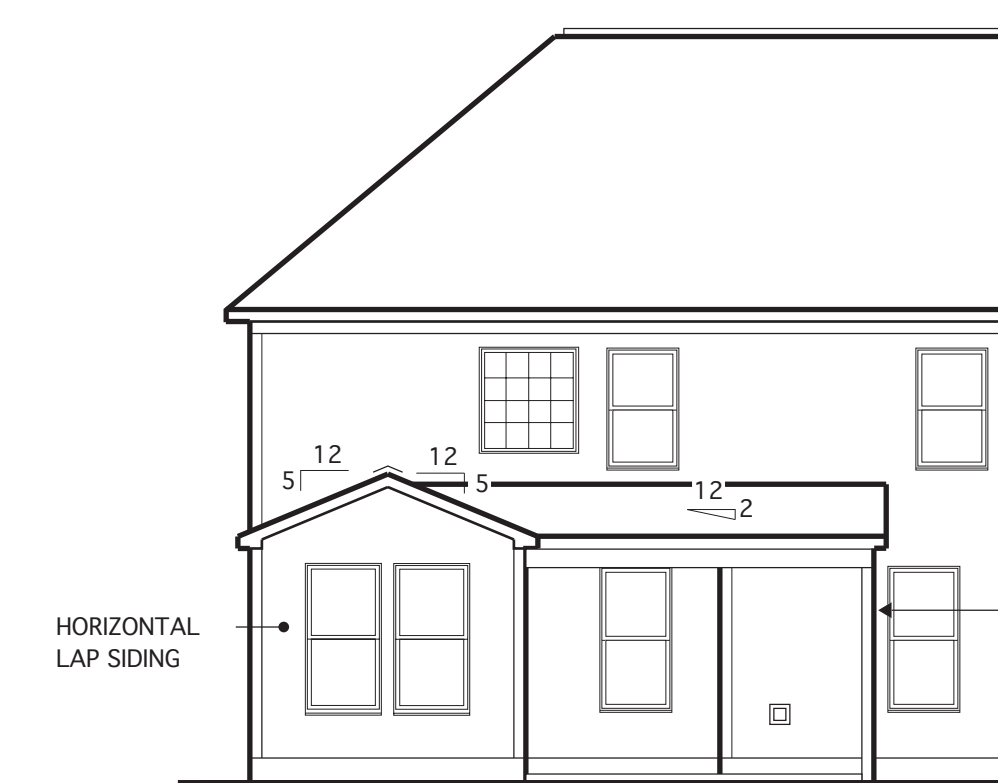


**REAR ELEV. W/ OPT. SUNROOM  
& OPT. COVERED PORCH**

SCALE: 1/8"=1'-0"

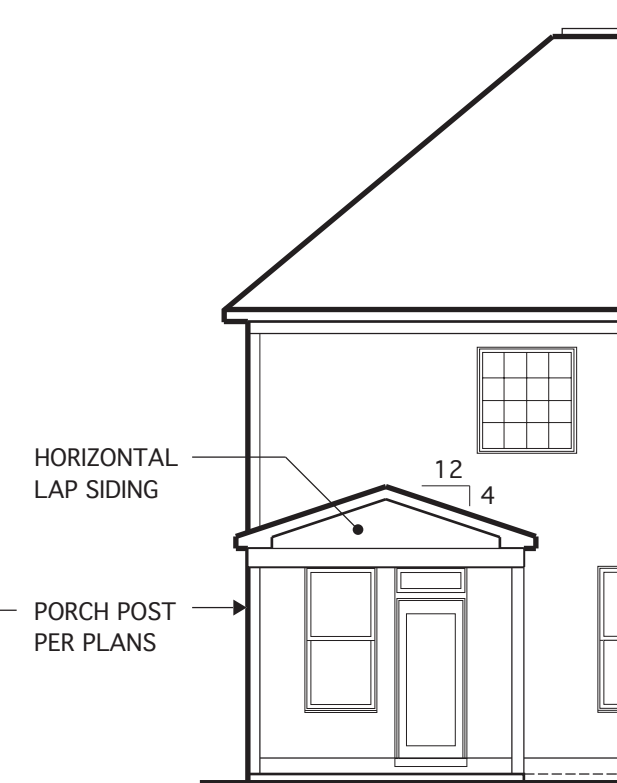


**REAR ELEV. W/  
OPT. COVERED PORCH**

SCALE: 1/8"=1'-0"

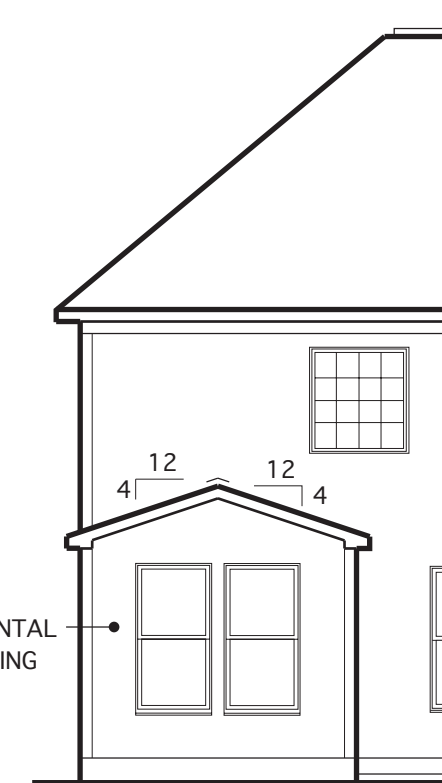


**REAR ELEV. W/  
OPT. SUNROOM**

SCALE: 1/8"=1'-0"

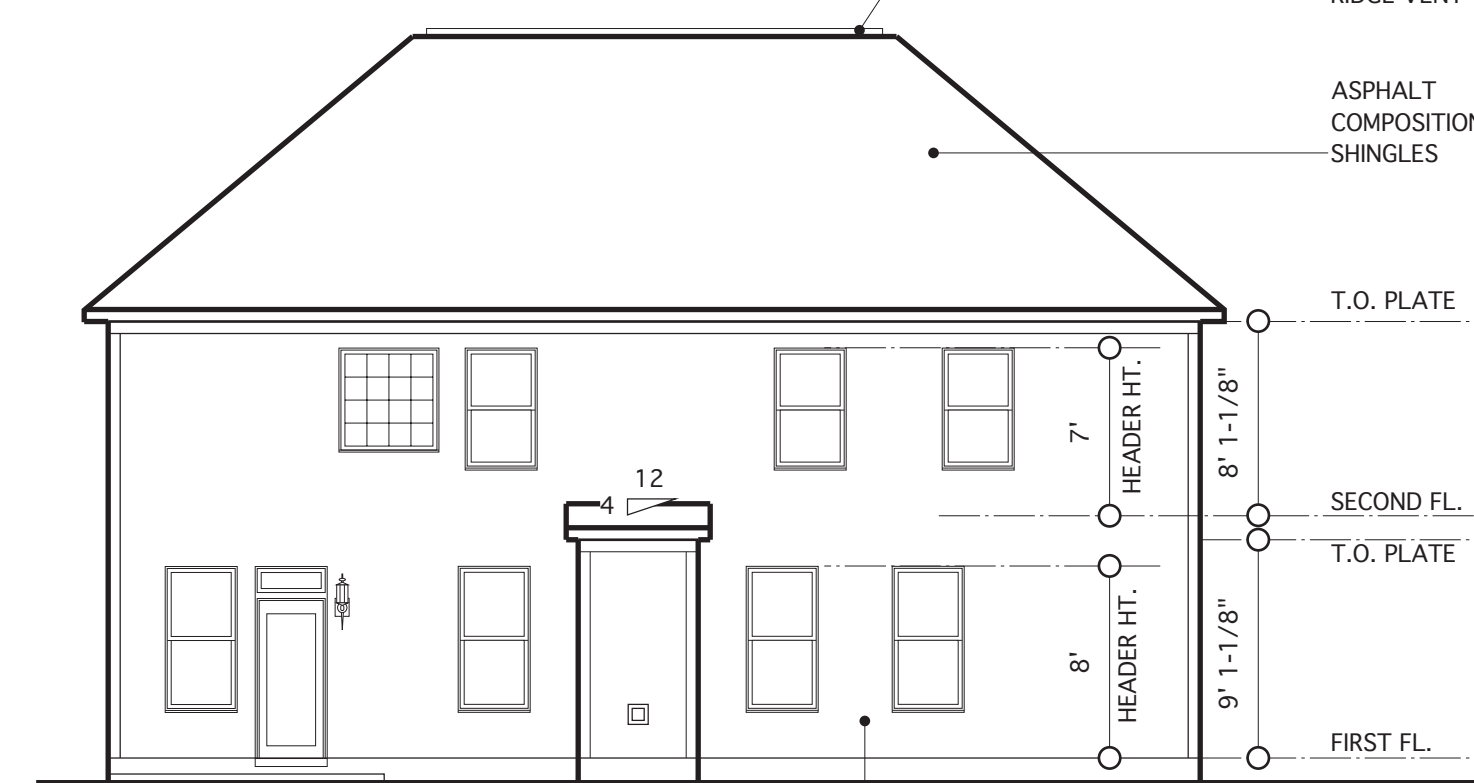

**REAR ELEVATION**

SCALE: 1/8"=1'-0"

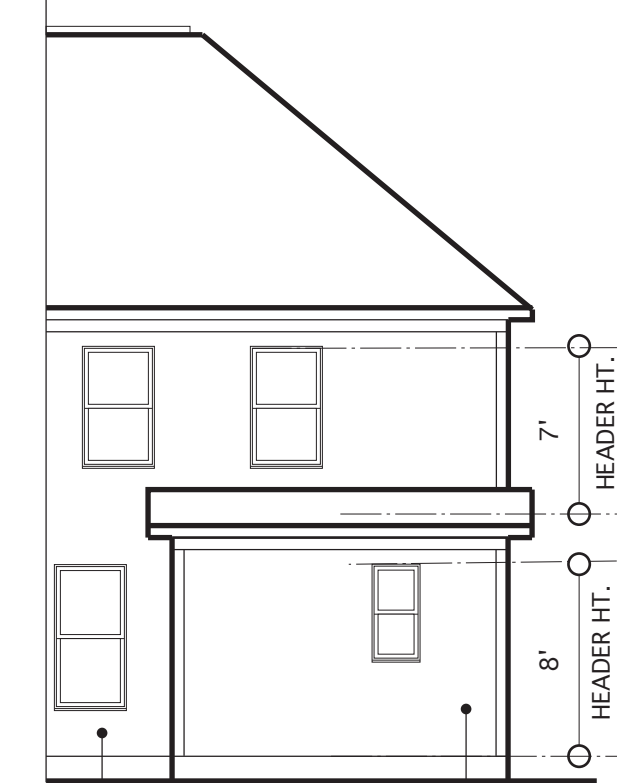

**REAR ELEV. W/  
OPT. BATH #2**


SCALE: 1/8"=1'-0"

REQUIRED VENTILATION SCHEDULE - SUNROOM	
138 SQ. FT. OF CEILING AREA / 300	= 0.46 SQ. FT. REQ.
<b>RIDGE VENTS</b> 0.46 X 0.5 = 0.23 SQ. FT. 0.23 SQ. FT. X 144 = 33 SQ. IN. 33 SQ. IN. / 18 SQ. IN. = 1.83 (18 SQ. IN. VENT PER LIN. FT.)	= 1.83 LIN. FT. REQ. (12 LIN. FT. PROVIDED)
<b>SOFFIT VENTS</b> 0.46 X 0.5 = 0.23 SQ. FT. 0.23 SQ. FT. X 144 = 33 SQ. IN. 33 SQ. IN. / 9 SQ. IN. = 3.7 LIN. FT. (9 SQ. IN. VENT PER LIN. FT.)	= 3.7 LIN. FT. REQ. (24 LIN. FT. PROVIDED)

REQUIRED VENTILATION SCHEDULE - MAIN HOUSE	
1,777 SQ. FT. OF CEILING AREA / 300	= 5.92 SQ. FT. REQ.
<b>RIDGE VENTS</b> 5.92 X 0.5 = 2.96 SQ. FT. 2.96 SQ. FT. X 144 = 426 SQ. IN. 426 SQ. IN. / 18 SQ. IN. = 23.7 (18 SQ. IN. VENT PER LIN. FT.)	= 23.7 LIN. FT. REQ. (44 LIN. FT. PROVIDED)
<b>SOFFIT VENTS</b> 5.92 X 0.5 = 2.96 SQ. FT. 2.96 SQ. FT. X 144 = 426 SQ. IN. 426 SQ. IN. / 12 SQ. IN. = 35.5 LIN. FT. (12 SQ. IN. VENT PER LIN. FT.)	= 35.5 LIN. FT. REQ. (152 LIN. FT. PROVIDED)


CODE REFERENCE: 2018 NCSRC, SEC. R806.2

**NOTE:**  
BUILDING ELEMENTS ARE TO BE APPLIED TO MEET  
LOCAL WINDLOAD REQUIREMENTS

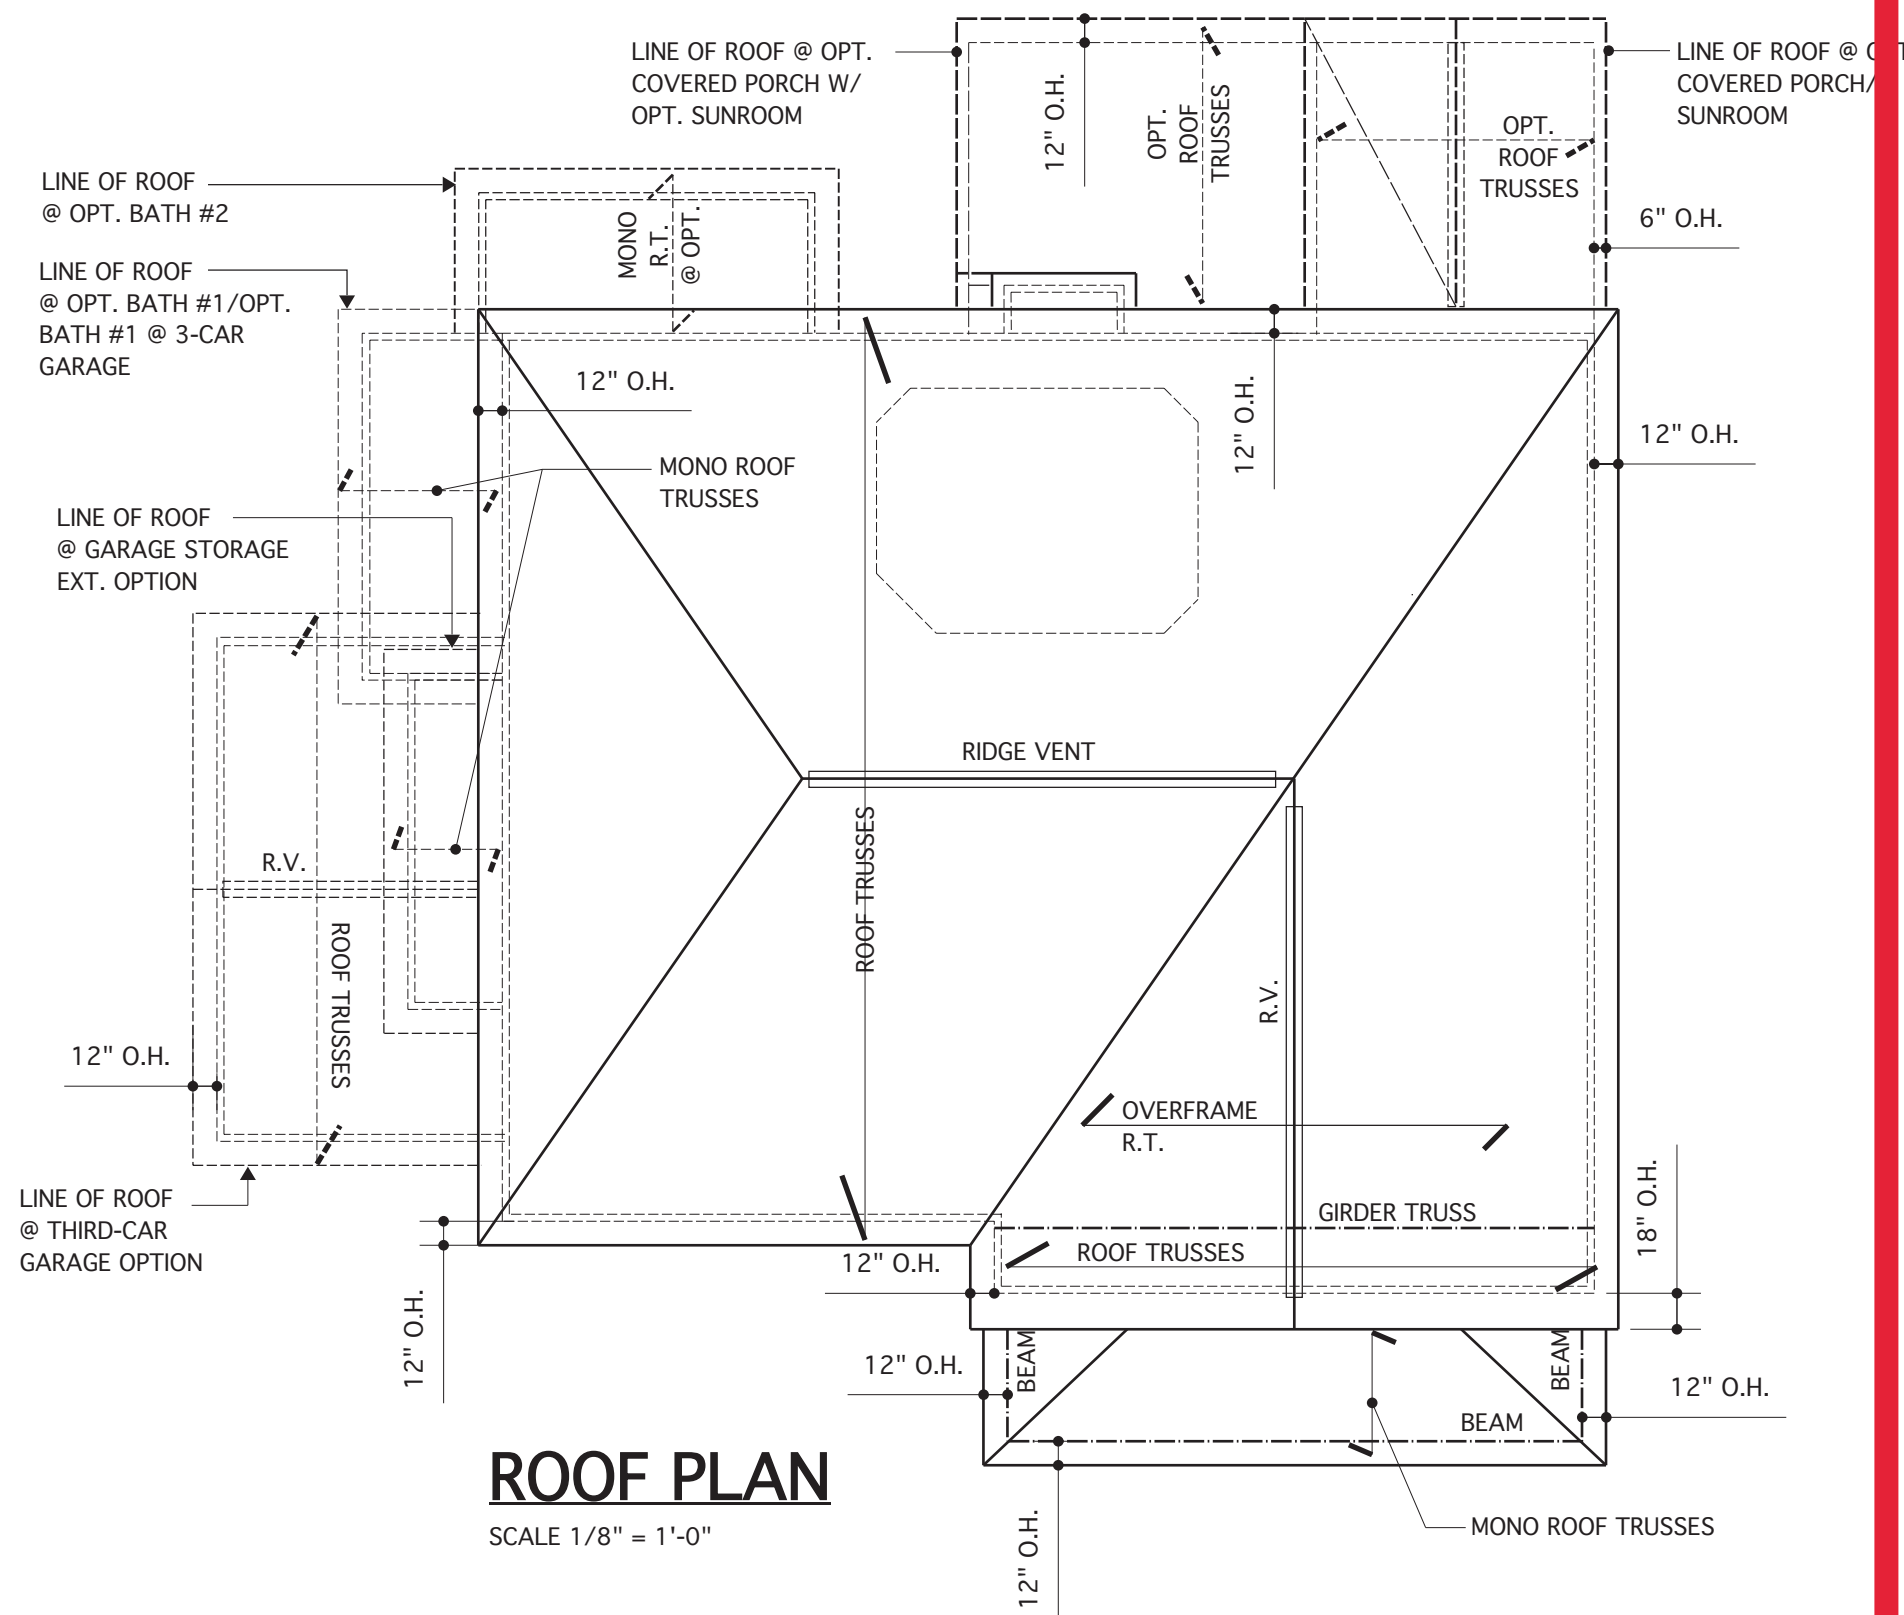

**ROOF PLAN**

SCALE 1/8" = 1'-0"

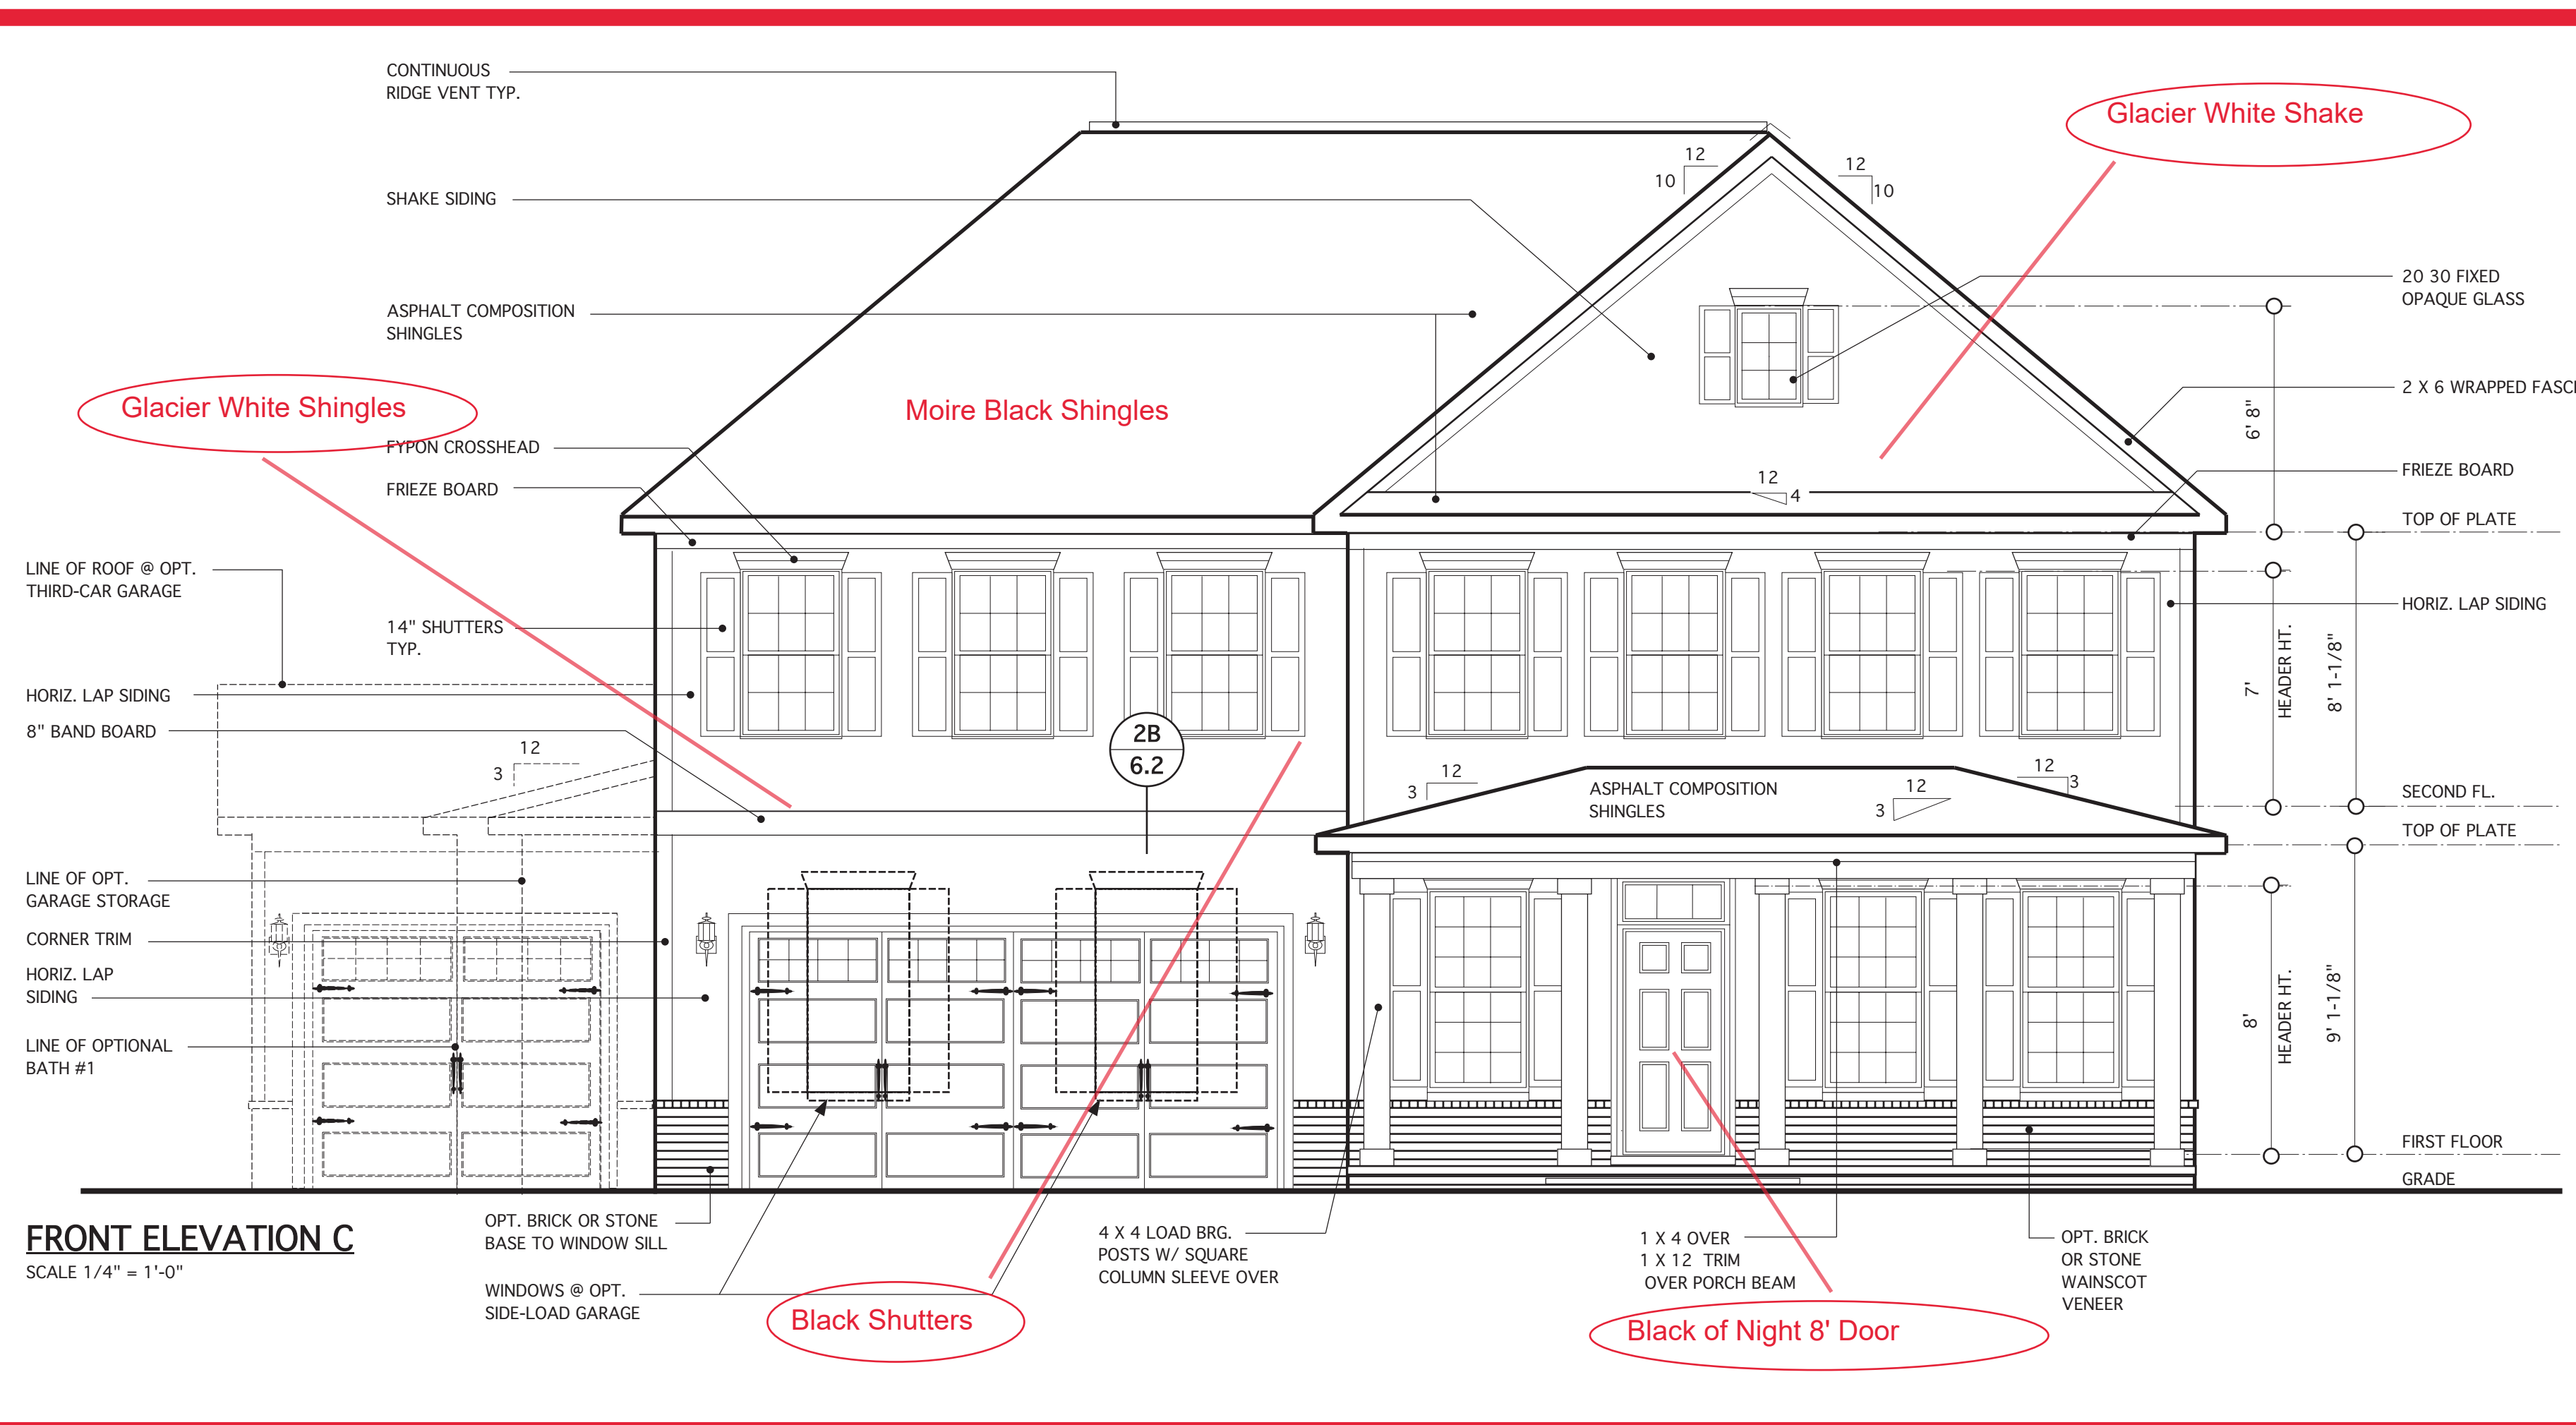

**FRONT ELEVATION C**

SCALE 1/4" = 1'-0"

**JAMES WENTLING/  
ARCHITECT**

LAND TITLE BUILDING  
100 SOUTH BROAD STREET,  
SUITE 1524  
PHILADELPHIA, PA 19110

(215) 568-2551  
email - information@  
wentlinghouseplans.com

ARCHITECTURE  
LAND PLANNING  
GRAPHICS

THESE PLANS ARE COPYRIGHTED AND ARE SUBJECT TO COPYRIGHT PROTECTION AS AN "ARCHITECTURAL WORK" UNDER SECTION 102 OF THE COPYRIGHT ACT OF 1976, AS AMENDED DECEMBER 1, 1990 AND KNOWN AS THE "ARCHITECTURAL WORKS" COPYRIGHT PROTECTION ACT OF 1990. THE PROTECTION INCLUDES BUT IS NOT LIMITED TO, THE OVERALL FORM AS WELL AS THE ARRANGEMENT AND COMPOSITION OF SPACES AND ELEMENTS OF THE DESIGN. UNDER SUCH PROTECTION, UNAUTHORIZED USE OF THESE PLANS, WORKS, OR FORMS REPRESENTED CAN LEGALLY RESULT IN THE CESSATION OF SUCH CONSTRUCTION OR BUILDINGS BEING SEIZED AND/OR RAISED.

© Copyright 2016 James Wentling / Architect

**JAMES WALTER WENTLING**  
REGISTERED ARCHITECT  
#642  
W. W. Wentling  
NORTH CAROLINA  
RALEIGH, N. C.  
4/1/24

REVISIONS		
MARK	DATE	DESCRIPTION
DN	01-10-19	CONVERT OLAHS
DN	02-14-19	STRUCT. DWGS. REV.
CH	12-10-19	UPDATE
CH	05-18-20	MINOR UPDATE
DN	04-04-24	CONVERT 113-69/ADD OPT. BATH #2 LHM

PROJECT NO. 113-88  
DATE 01-13-16  
SCALE AS NOTED  
DRAWN BY JB  
CHECKED BY JW  
ISSUED FOR PERMITS/CONSTRUCTION


PROJECT TITLE  
**MODEL 628 -  
GARAGE LEFT**

CLIENT  
**CHESAPEAKE  
HOMES OF NC**  
3100 Smoketree Court,  
Suite 210  
Raleigh, NC 27604  
(919) 256-3060  
(919) 556-0690 Fax

DRAWING TITLE  
**ELEVATION C  
AND ROOF PLAN**


SHEET  
**4.2**



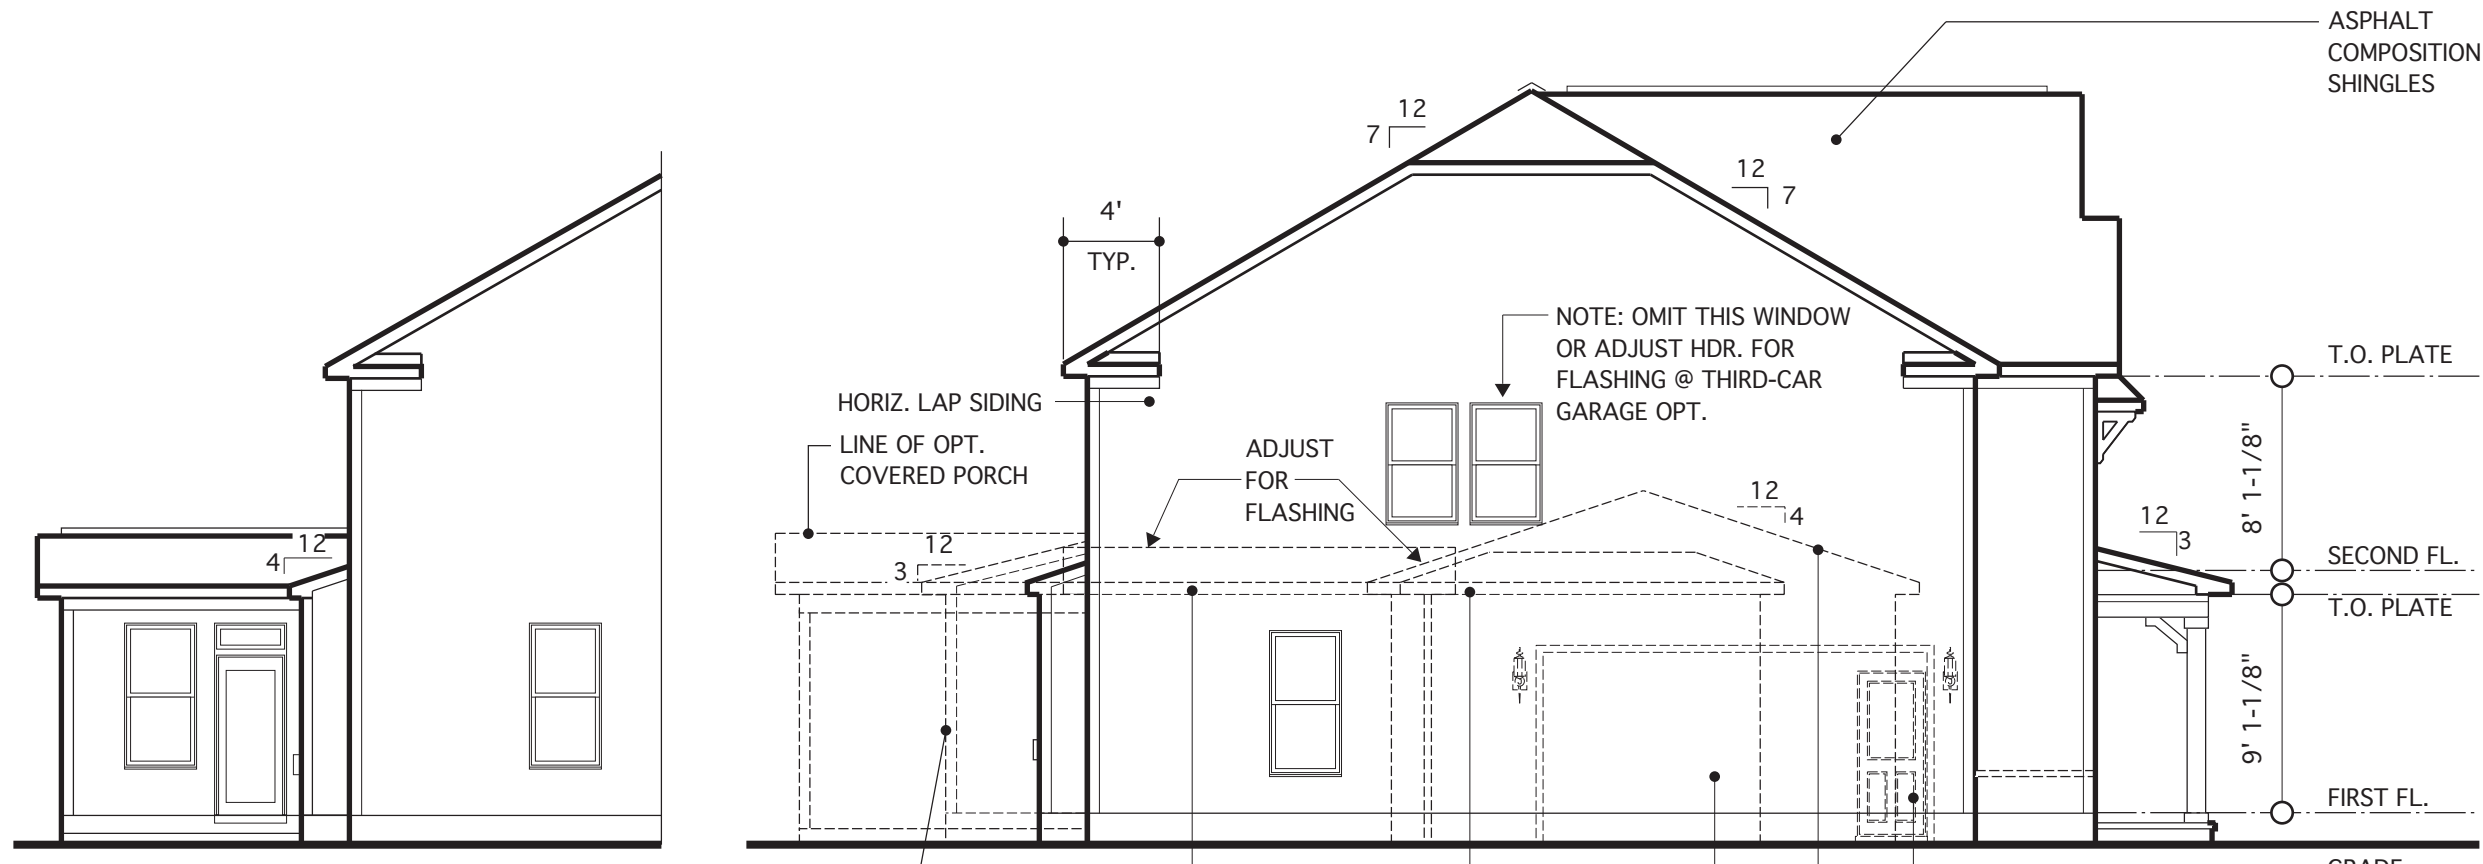


**LEFT ELEVATION W/  
OPT. SUNROOM**  
SCALE: 1/8"=1'-0"


**LEFT ELEVATION**  
SCALE: 1/8"=1'-0"

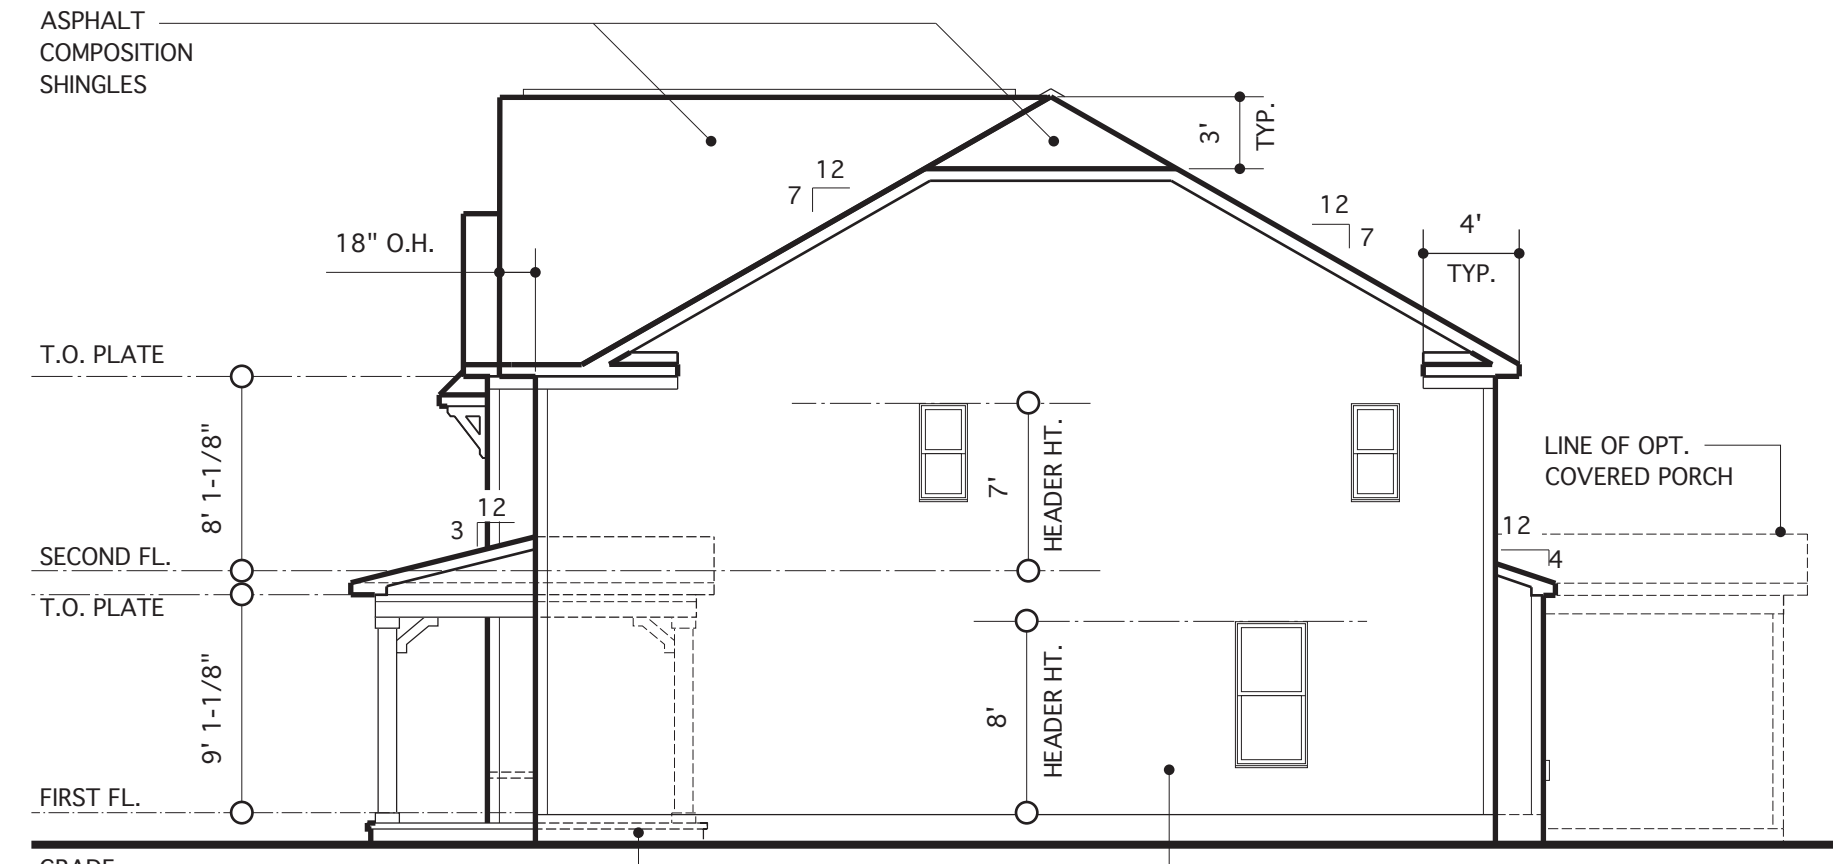


**RIGHT ELEVATION**  
SCALE: 1/8"=1'-0"

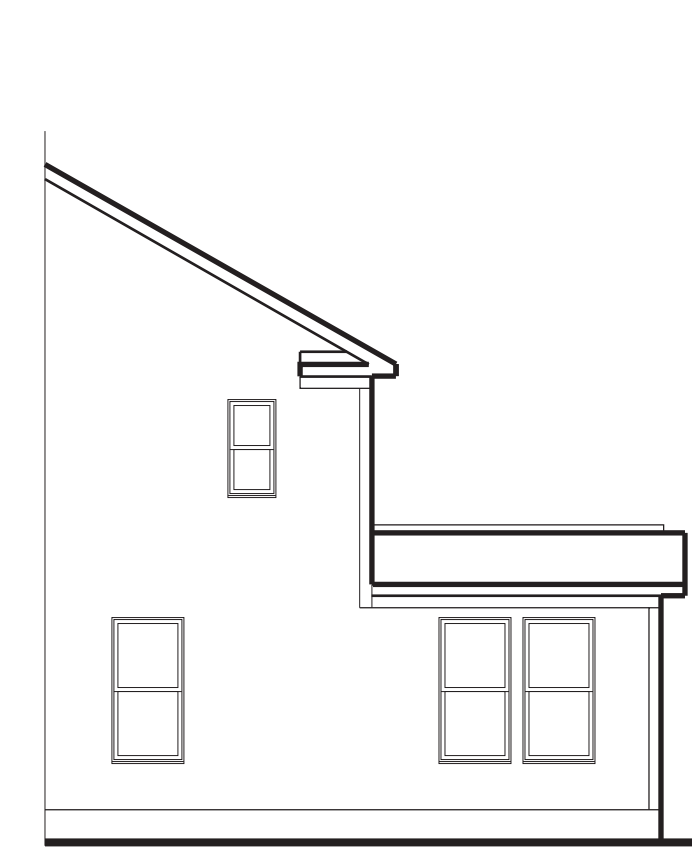


**LEFT ELEVATION W/  
OPT. SUNROOM**  
SCALE: 1/8"=1'-0"

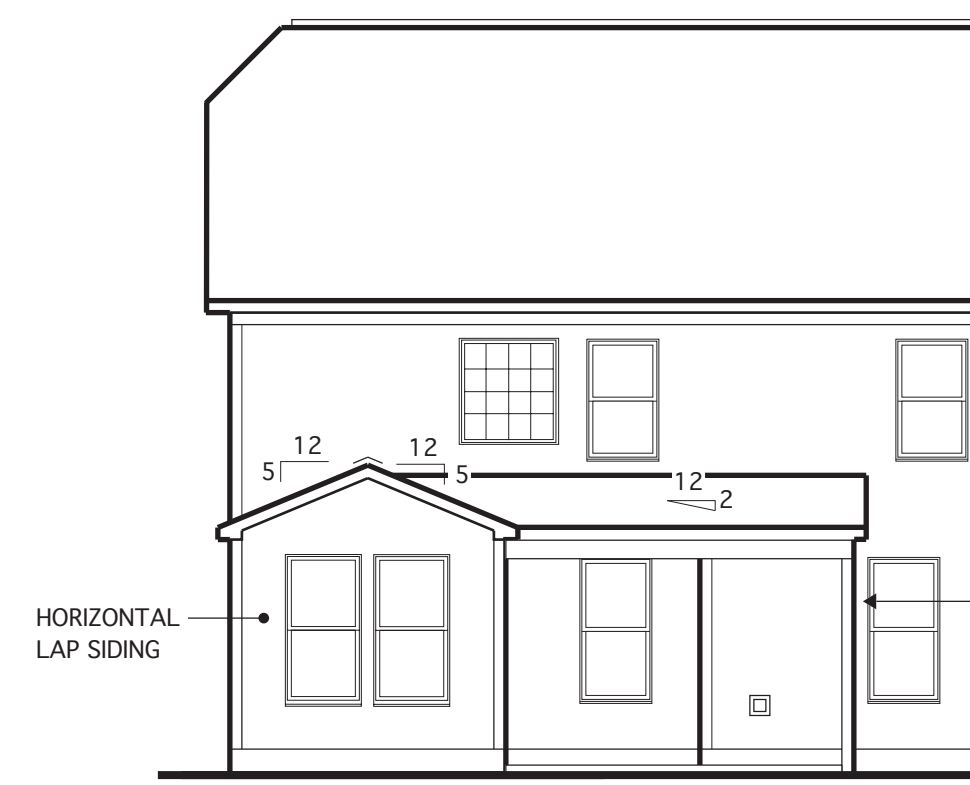


**REAR ELEV. W/ OPT. SUNROOM  
& OPT. COVERED PORCH**  
SCALE: 1/8"=1'-0"

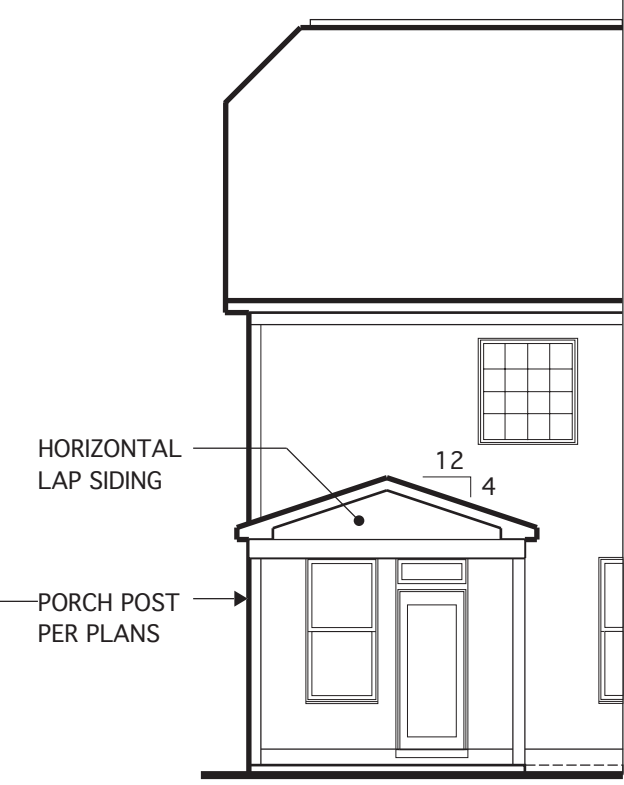


**REAR ELEV. W/  
OPT. COVERED PORCH**  
SCALE: 1/8"=1'-0"

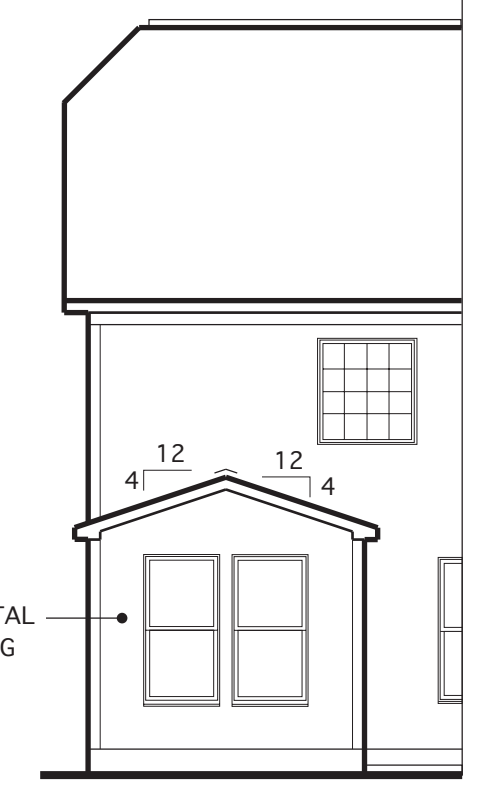

**REAR ELEV. W/  
OPT. SUNROOM**  
SCALE: 1/8"=1'-0"

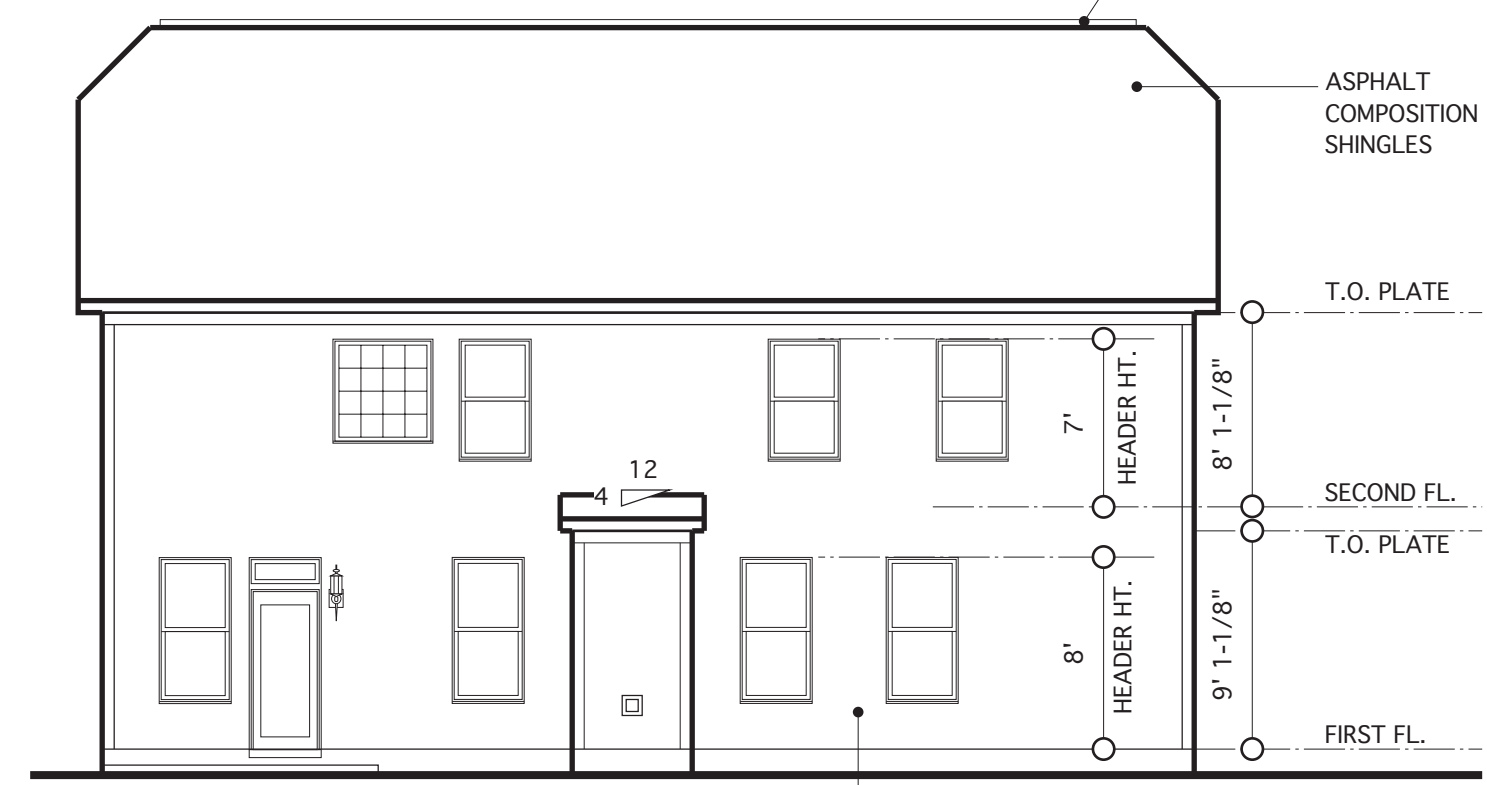

**REAR ELEVATION**  
SCALE: 1/8"=1'-0"

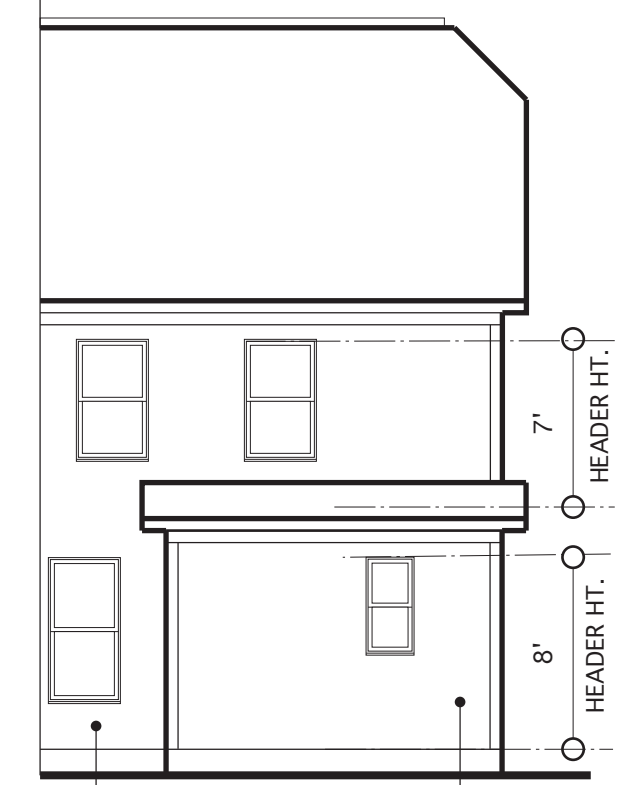

**REAR ELEV. W/  
OPT. BATH #2**  
SCALE: 1/8"=1'-0"

NOTE: SEE SHEET 4.1 FOR OPT. SUNROOM & OPT. COVERED PORCH W/ ALT. FIREPLACE LOCATION

**REQUIRED VENTILATION SCHEDULE - SUNROOM**

138 SQ. FT. OF CEILING AREA / 300	= 0.46 SQ. FT. REQ.
<b>RIDGE VENTS</b> 0.46 X 0.5 = 0.23 SQ. FT. 0.23 SQ. FT. X 144 = 33 SQ. IN. 33 SQ. IN. / 18 SQ. IN. = 1.83 (18 SQ. IN. VENT PER LIN. FT.)	= 1.83 LIN. FT. REQ. (12 LIN. FT. PROVIDED)
<b>SOFFIT VENTS</b> 0.46 X 0.5 = 0.23 SQ. FT. 0.23 SQ. FT. X 144 = 33 SQ. IN. 33 SQ. IN. / 9 SQ. IN. = 3.7 LIN. FT. (9 SQ. IN. VENT PER LIN. FT.)	= 3.7 LIN. FT. REQ. (24 LIN. FT. PROVIDED)

**REQUIRED VENTILATION SCHEDULE - MAIN HOUSE**

1,777 SQ. FT. OF CEILING AREA / 300	= 5.92 SQ. FT. REQ.
<b>RIDGE VENTS</b> 5.92 X 0.5 = 2.96 SQ. FT. 2.96 SQ. FT. X 144 = 426 SQ. IN. 426 SQ. IN. / 18 SQ. IN. = 23.7 (18 SQ. IN. VENT PER LIN. FT.)	= 23.7 LIN. FT. REQ. (58 LIN. FT. PROVIDED)
<b>SOFFIT VENTS</b> 5.92 X 0.5 = 2.96 SQ. FT. 2.96 SQ. FT. X 144 = 426 SQ. IN. 426 SQ. IN. / 12 SQ. IN. = 35.5 LIN. FT. (12 SQ. IN. VENT PER LIN. FT.)	= 35.5 LIN. FT. REQ. (72 LIN. FT. PROVIDED)

CODE REFERENCE: 2018 NCSRC, SEC. R806.2

**NOTE:**  
BUILDING ELEMENTS ARE TO BE APPLIED TO MEET LOCAL WINDLOAD REQUIREMENTS

**JAMES WENTLING/  
ARCHITECT**  
LAND TITLE BUILDING  
100 SOUTH BROAD STREET,  
SUITE 1521  
PHILADELPHIA, PA 19110  
(215) 568-2551  
email - information@  
wentlinghouseplans.com

ARCHITECTURE  
LAND PLANNING  
GRAPHICS

THESE PLANS ARE COPYRIGHTED AND ARE SUBJECT TO COPYRIGHT PROTECTION AS AN "ARCHITECTURAL WORK" UNDER SECTION 102 OF THE COPYRIGHT ACT, 17 U.S.C. AS AMENDED DECEMBER 1, 1990 AND KNOWN AS THE "ARCHITECTURAL WORKS" COPYRIGHT PROTECTION ACT OF 1990. THE PROTECTION INCLUDES BUT IS NOT LIMITED TO, THE OVERALL FORM AS WELL AS THE ARRANGEMENT AND COMPOSITION OF SPACES AND ELEMENTS OF THE DESIGN. UNDER SUCH PROTECTION, UNAUTHORIZED USE OF THESE PLANS, WORKS, OR FORMS REPRESENTED CAN LEGALLY RESULT IN THE CESSATION OF SUCH CONSTRUCTION OR BUILDINGS BEING SEIZED AND/OR RAISED.



**REVISIONS**

MARK	DATE	DESCRIPTION
CH	12-10-19	CONVERT KINGSTON
CH	05-18-20	MINOR UPDATE
DN	04-04-24	CONVERT 113-69ADD OPT. BATH #2 LM

**PROJECT INFO**


PROJECT NO.	113-88
DATE	12-10-19
SCALE	AS NOTED
DRAWN BY	CH
CHECKED BY	JW
ISSUED FOR	PERMITS/CONSTRUCTION

**PROJECT TITLE**  
**MODEL 628 -  
GARAGE LEFT**


**CLIENT**  
**CHESAPEAKE  
HOMES OF NC**  
3100 Smoketree Court,  
Suite 210  
Raleigh, NC 27604  
(919) 256-3060  
(919) 556-0690 Fax

**DRAWING TITLE**  
**ELEVATION D  
AND ROOF PLAN**

**SHEET**  
**4.3**

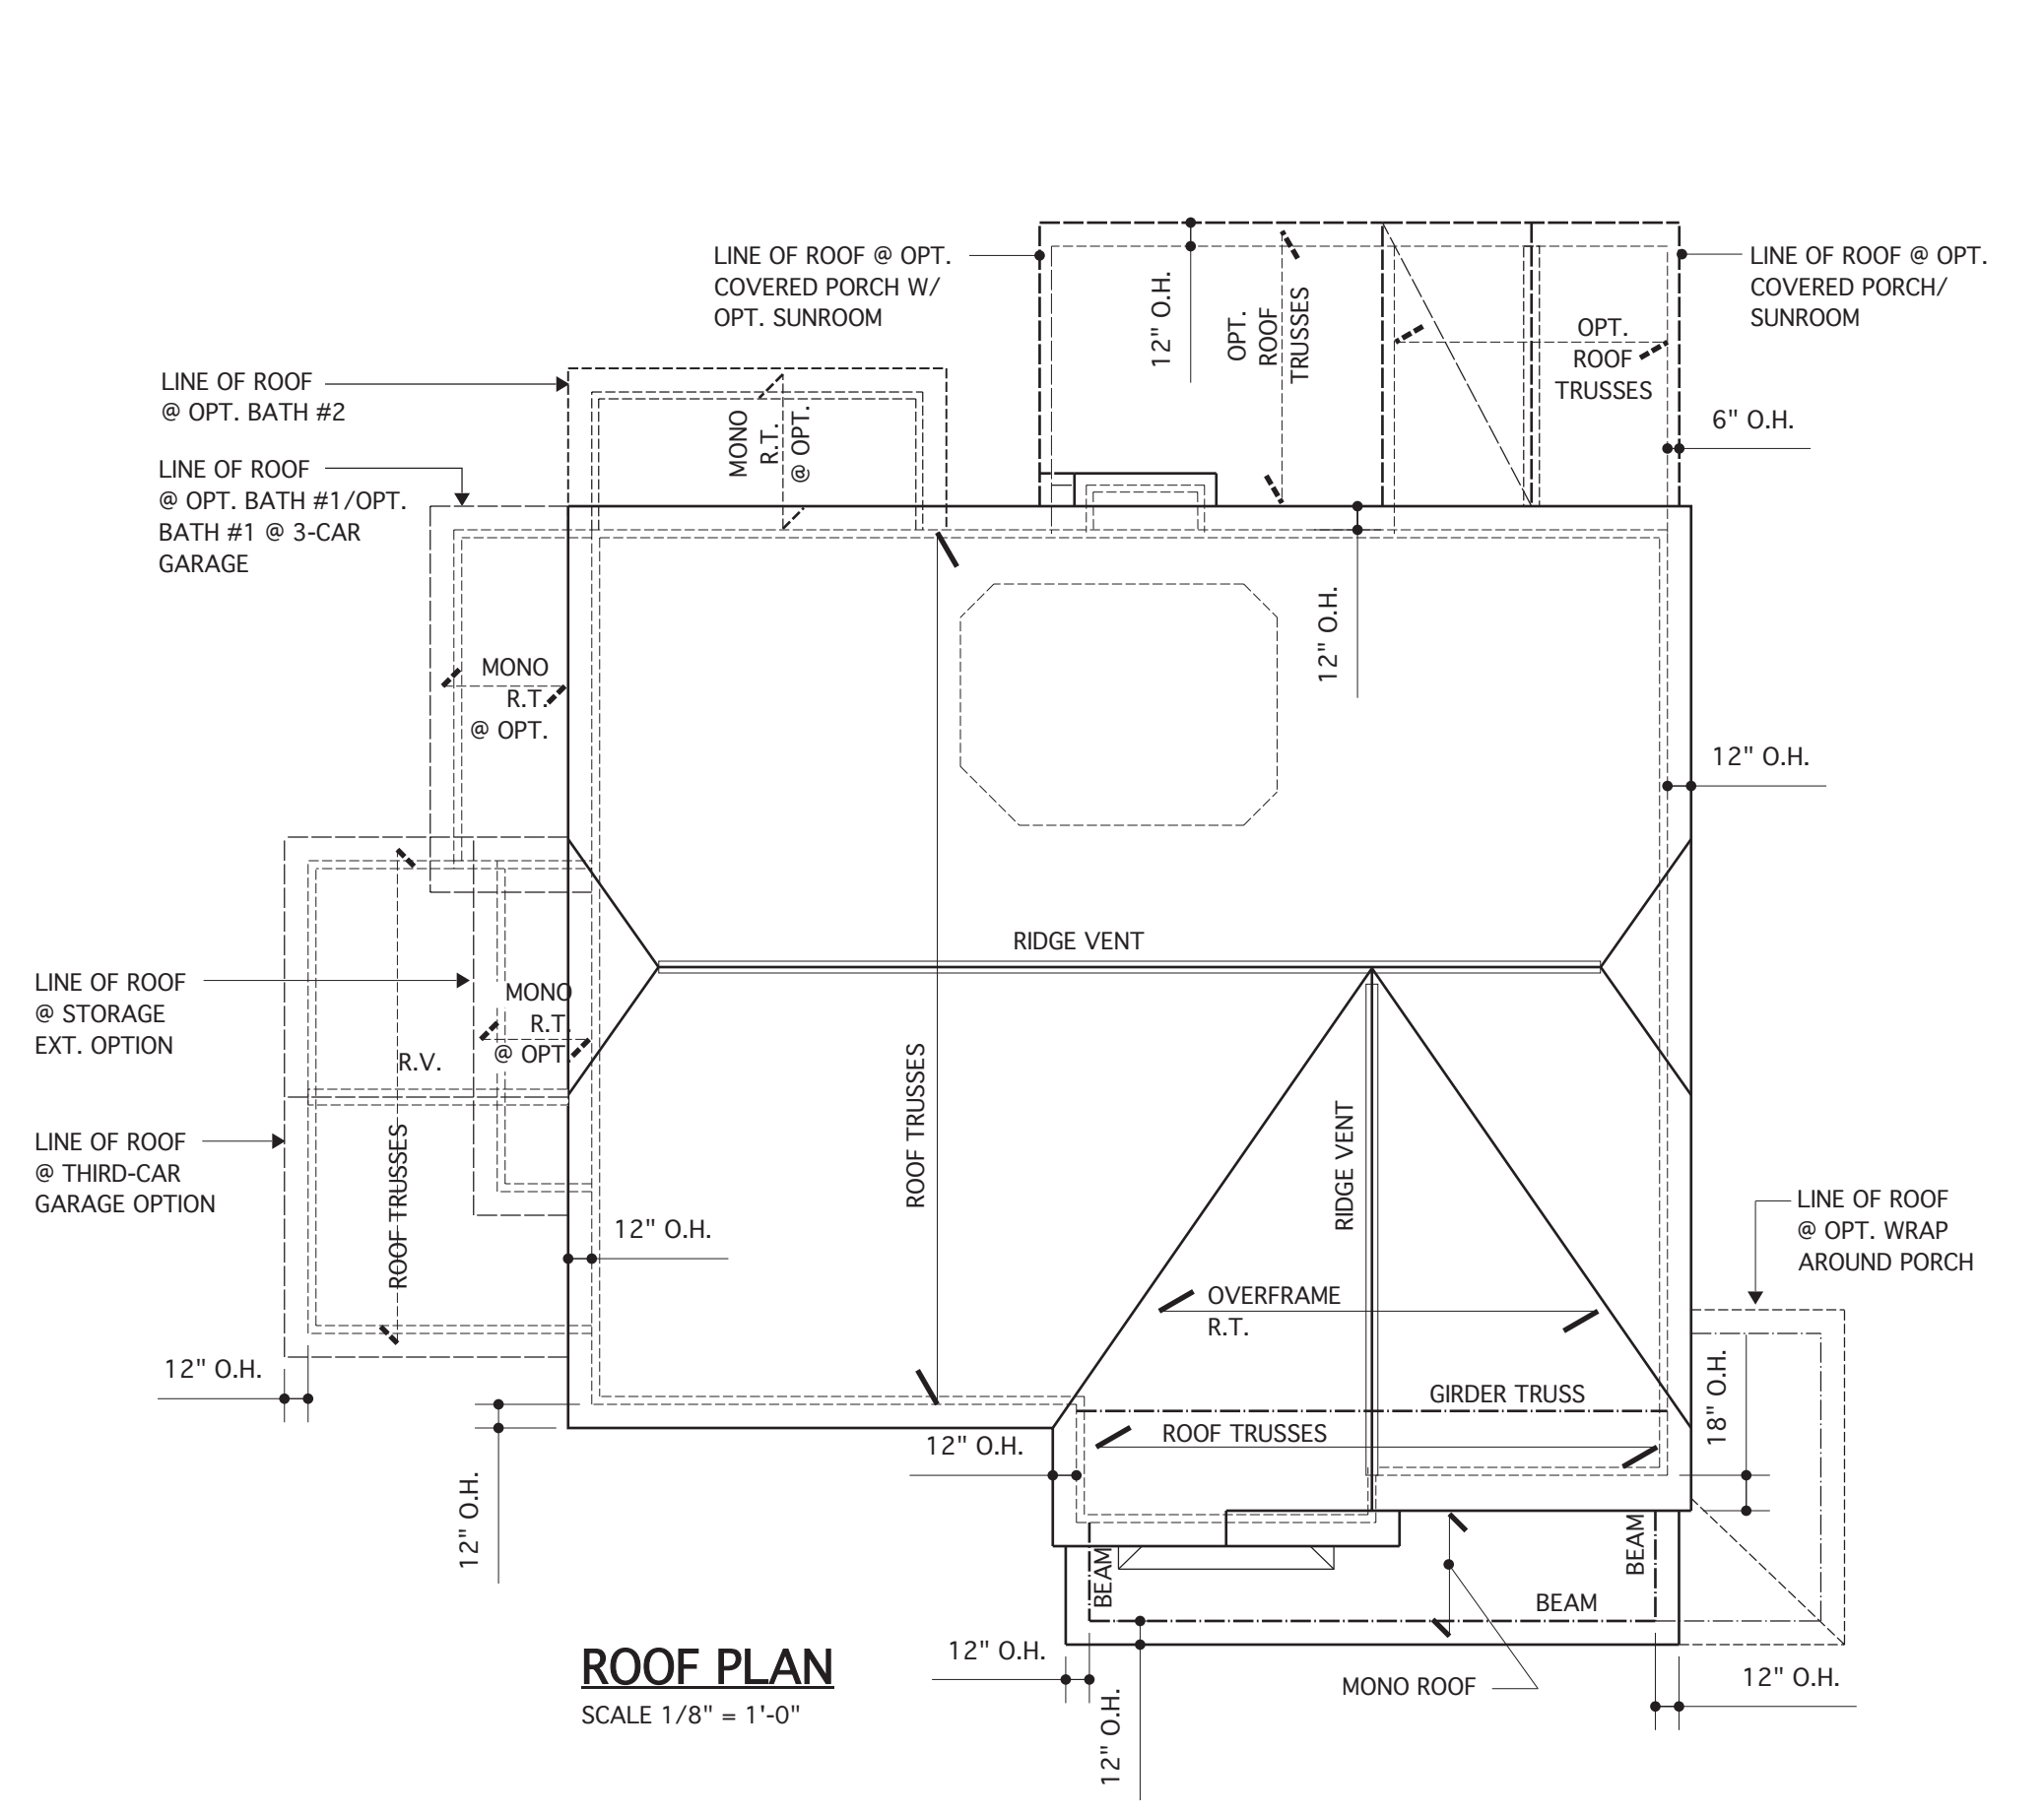


**ROOF PLAN**  
SCALE: 1/8"=1'-0"

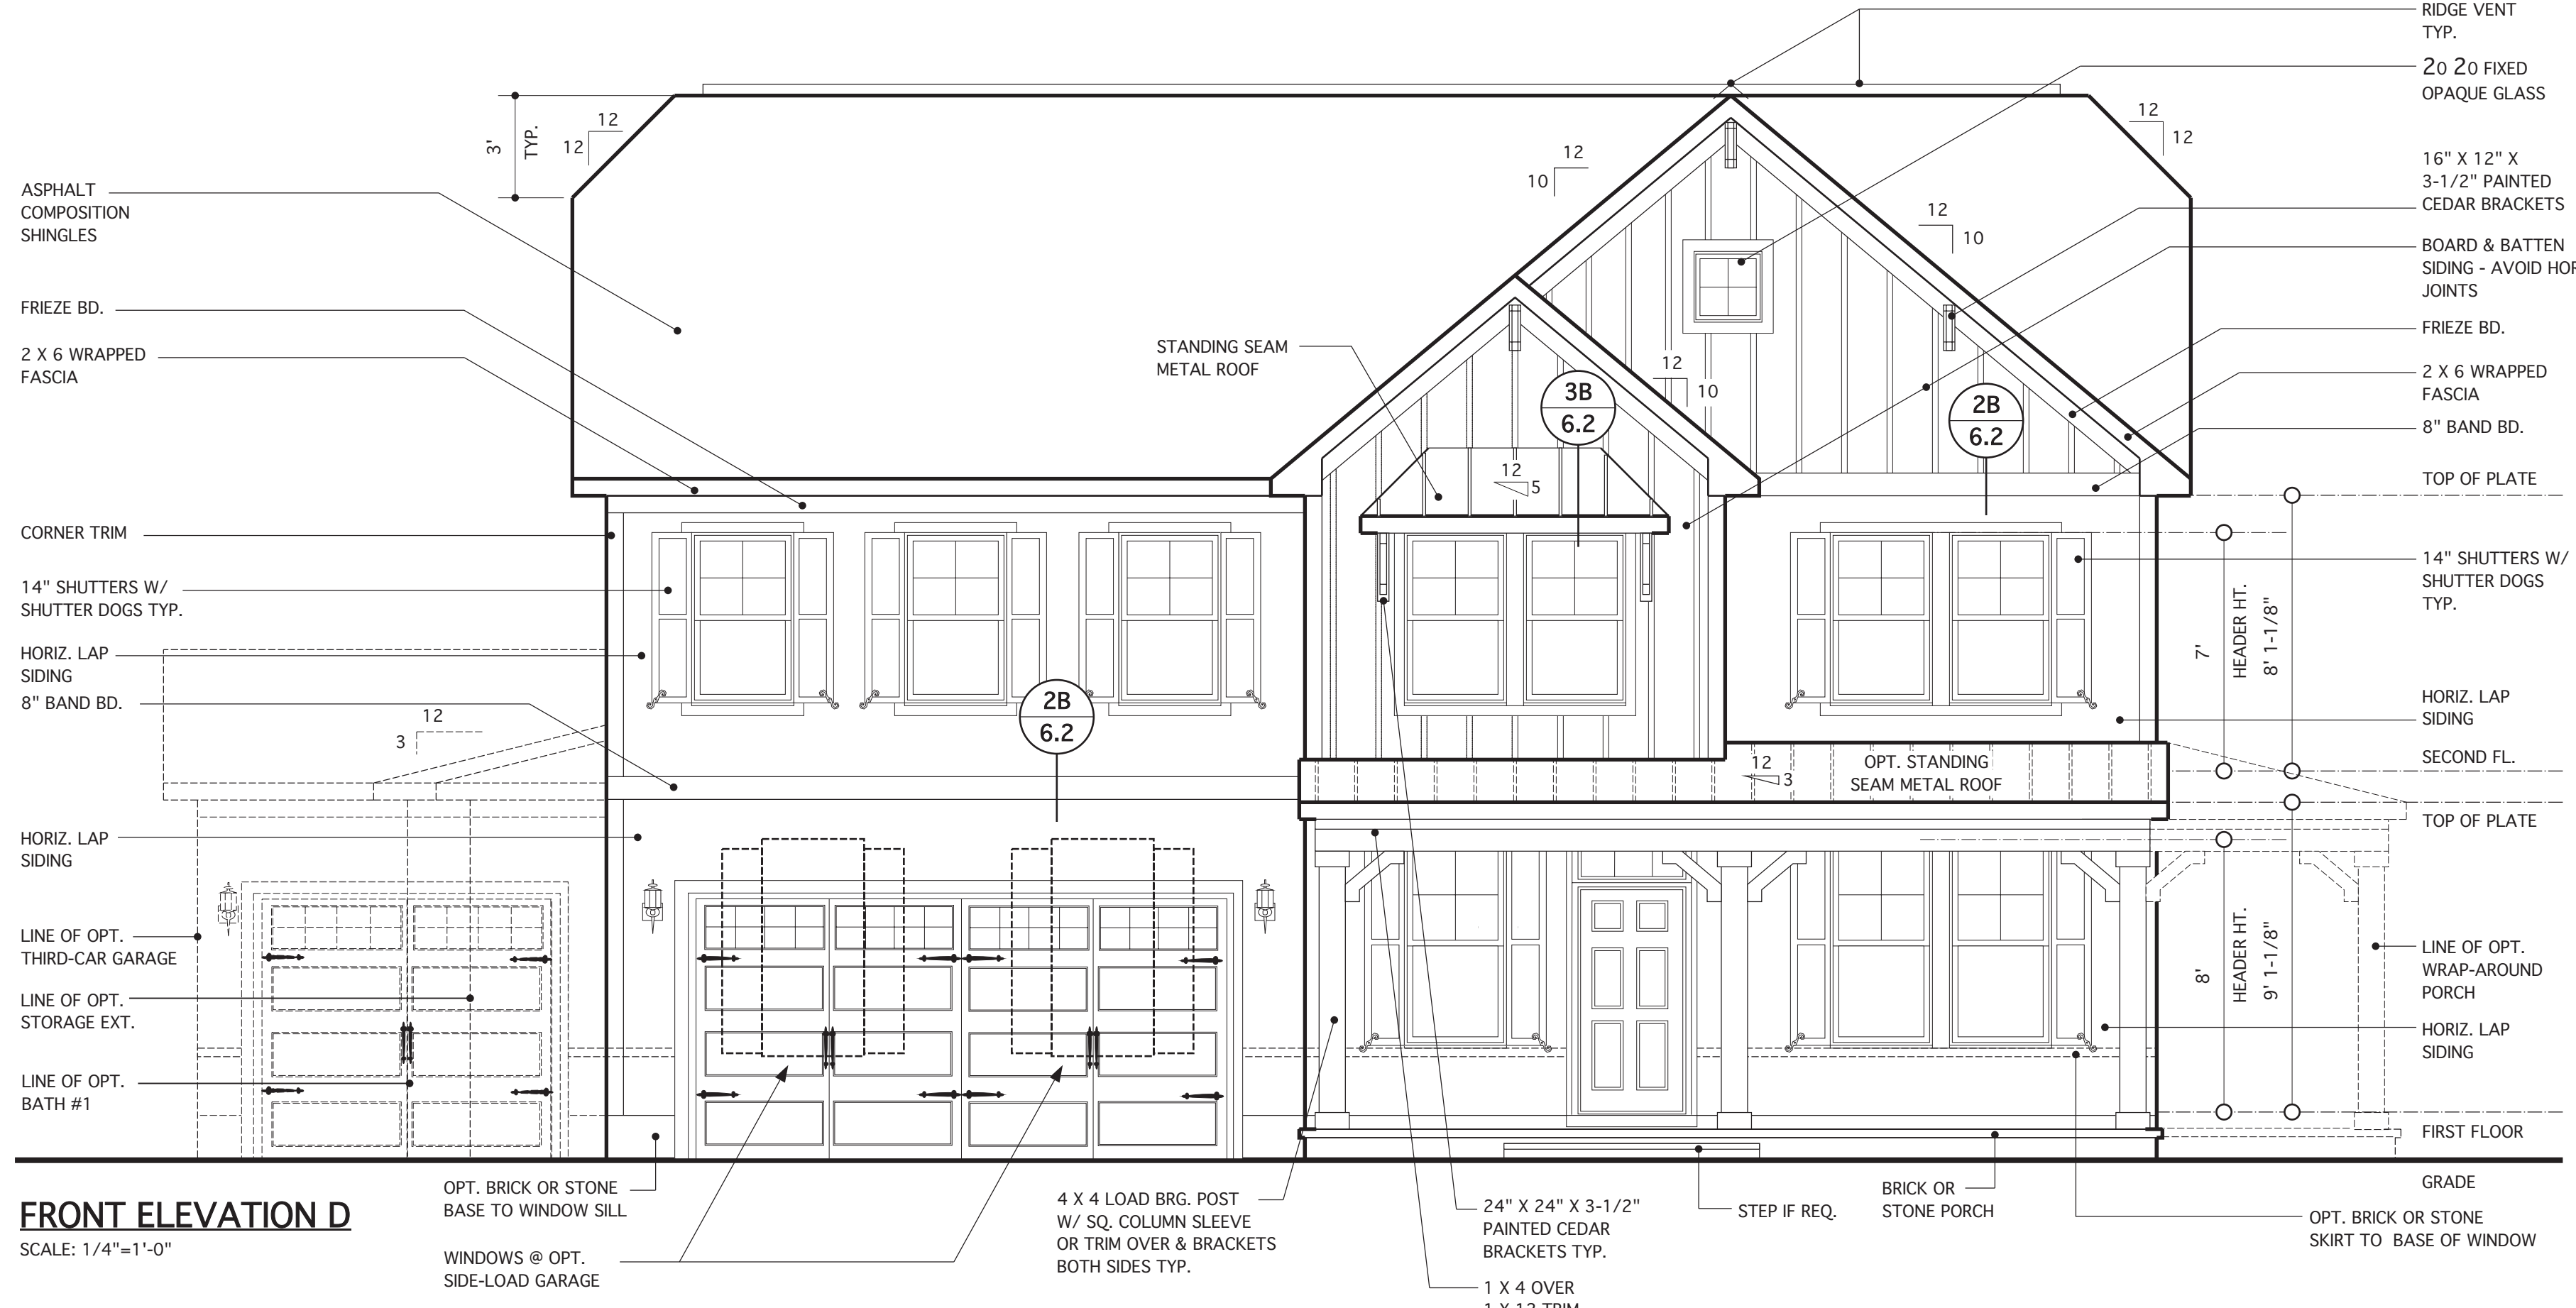


**FRONT ELEVATION D**  
SCALE: 1/4"=1'-0"

© Copyright 2016 James Wentling/Architect




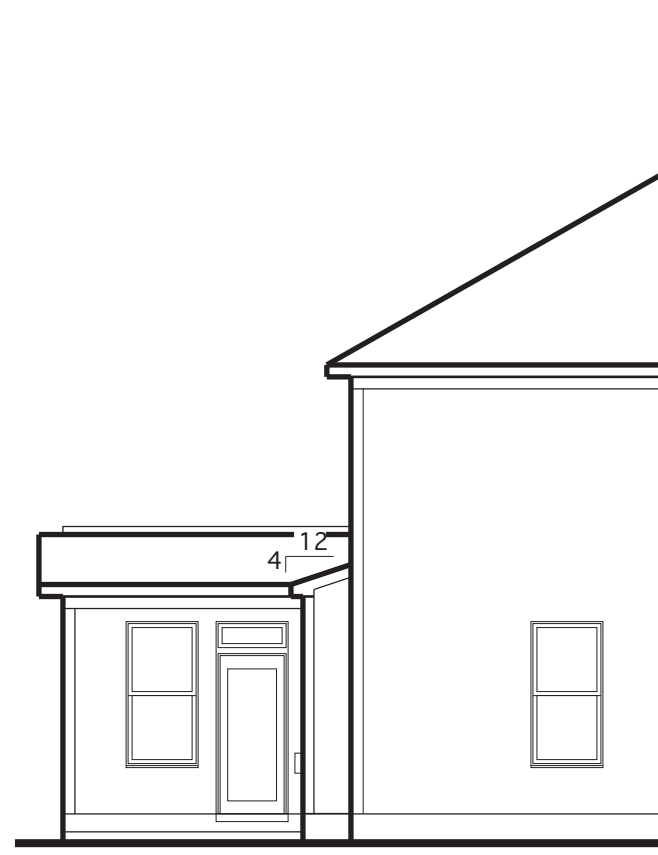

**LEFT ELEV. W/  
OPT. SUNROOM**  
SCALE: 1/8"=1'-0"

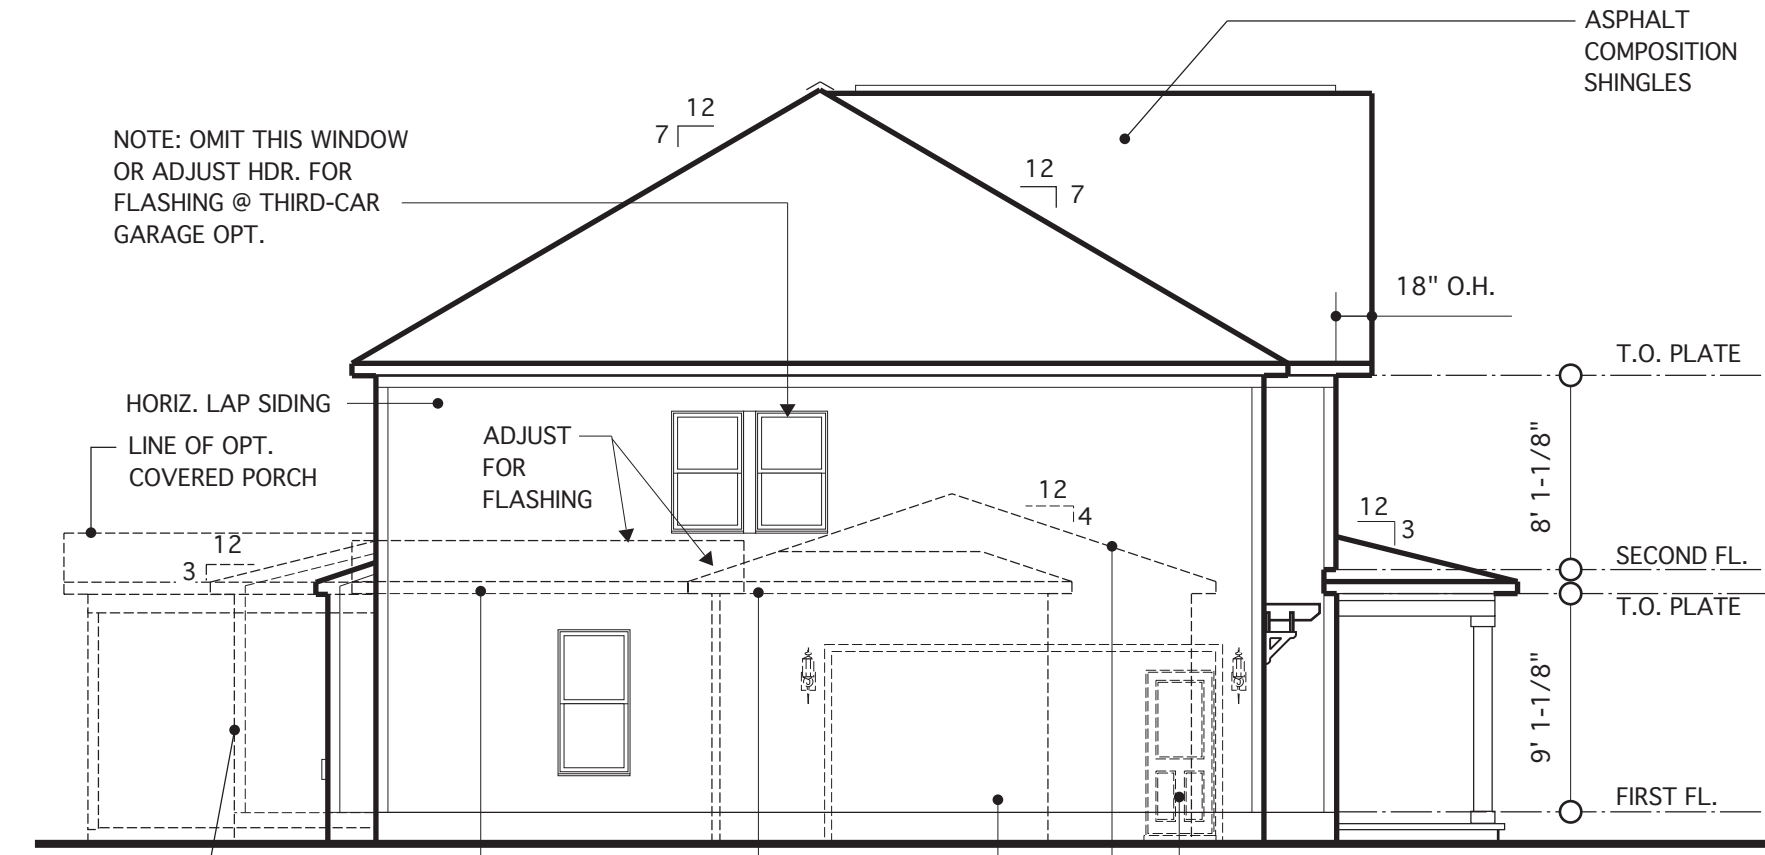


**LEFT ELEVATION**  
SCALE: 1/8"=1'-0"

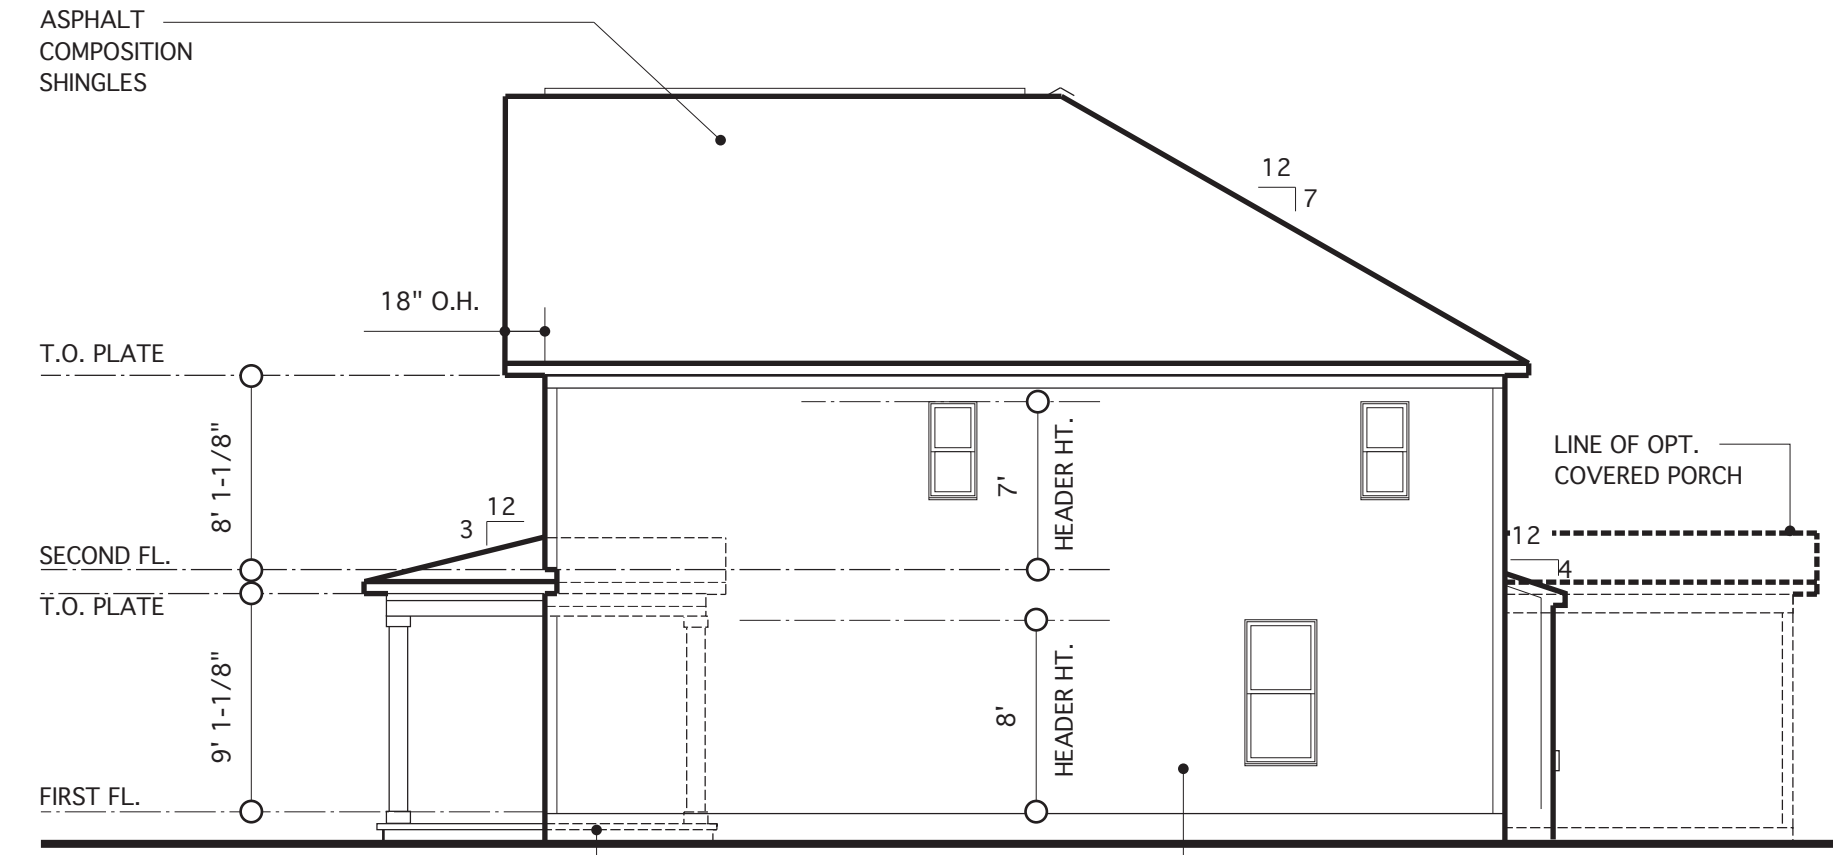

**RIGHT ELEVATION**  
SCALE: 1/8"=1'-0"




**RIGHT ELEVATION W/  
OPT. SUNROOM**  
SCALE: 1/8"=1'-0"

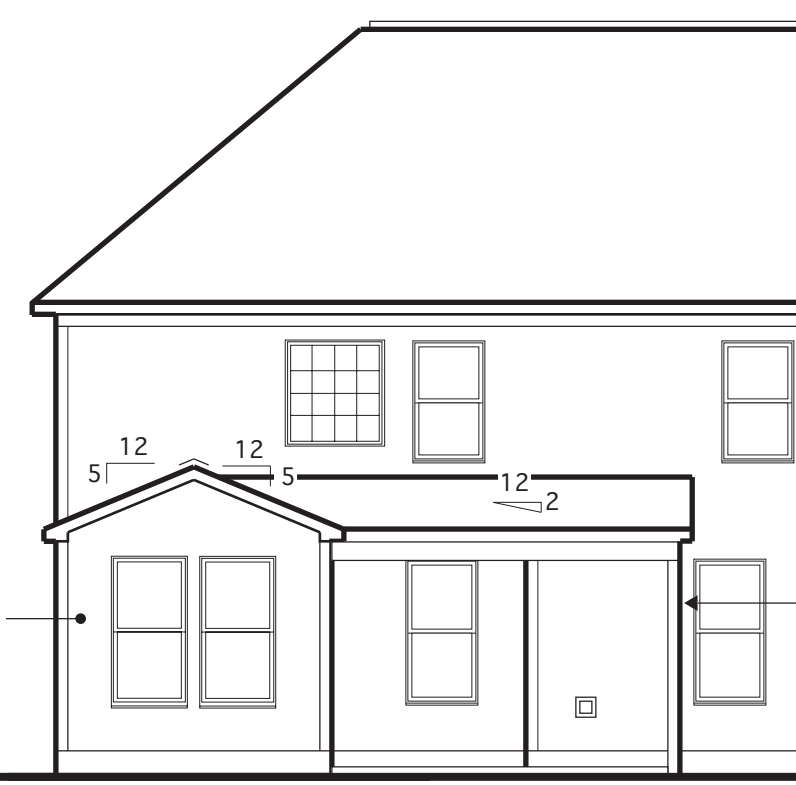


**REAR ELEV. W/  
OPT. SUNROOM  
& OPT. COVERED PORCH**  
SCALE: 1/8"=1'-0"


NOTE: SEE SHEET 4.1 FOR OPT. SUNROOM & OPT. COVERED PORCH W/ ALT. FIREPLACE LOCATION

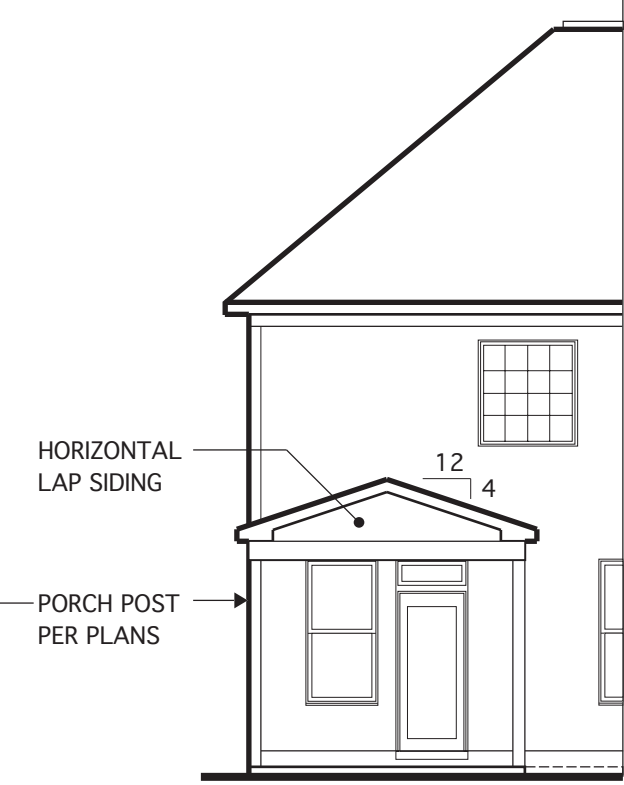


**REAR ELEV. W/  
OPT. COVERED PORCH**  
SCALE: 1/8"=1'-0"

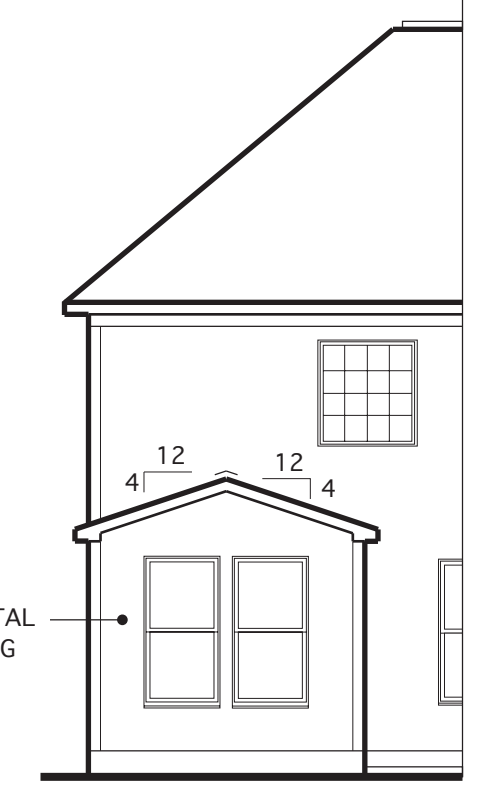

**REAR ELEV. W/  
OPT. SUNROOM**  
SCALE: 1/8"=1'-0"

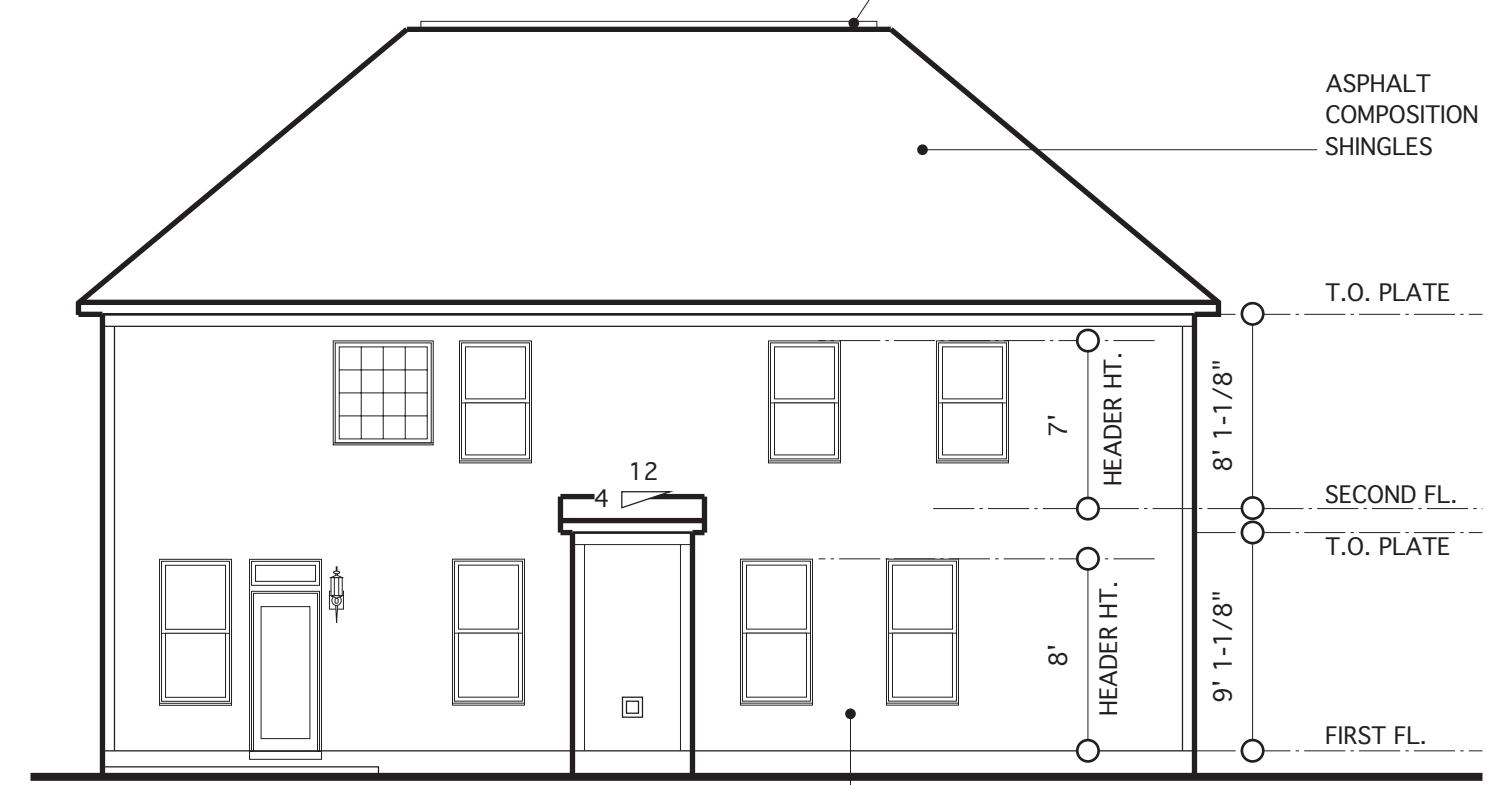

**REAR ELEVATION**  
SCALE: 1/8"=1'-0"

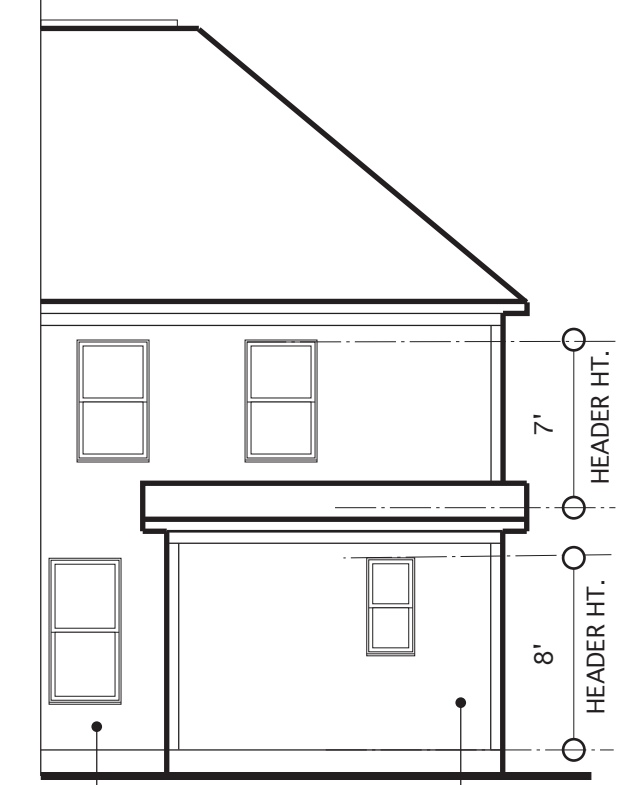


**REAR ELEV. W/  
OPT. BATH #2**  
SCALE: 1/8"=1'-0"

REQUIRED VENTILATION SCHEDULE - SUNROOM		
	138 SQ. FT. OF CEILING AREA / 300	= 0.46 SQ. FT. REQ.
<b>RIDGE VENTS</b>	0.46 X 0.5 = 0.23 SQ. FT. 0.23 SQ. FT. X 144 = 33.1 SQ. IN. 33.1 SQ. IN. / 18 SQ. IN. = 1.8 (18 SQ. IN. VENT PER LIN. FT.)	= 2 LIN. FT. REQ. 12 LIN. FT. PROVIDED
<b>SOFFIT VENTS</b>	0.46 X 0.5 = 0.23 SQ. FT. 0.23 SQ. FT. X 144 = 33.1 SQ. IN. 33.1 SQ. IN. / 9 SQ. IN. = 3.7 (9 SQ. IN. VENT PER LIN. FT.)	= 4 LIN. FT. REQ. 24 LIN. FT. PROVIDED

REQUIRED VENTILATION SCHEDULE - MAIN HOUSE		
	1,758 SQ. FT. OF CEILING AREA / 300	= 5.86 SQ. FT. REQ.
<b>RIDGE VENTS</b>	5.86 X 0.5 = 2.93 SQ. FT. 2.93 SQ. FT. X 144 = 421.9 SQ. IN. 421.9 SQ. IN. / 18 SQ. IN. = 23.4 (18 SQ. IN. VENT PER LIN. FT.)	= 24 LIN. FT. REQ. 44 LIN. FT. PROVIDED
<b>SOFFIT VENTS</b>	5.86 X 0.5 = 2.93 SQ. FT. 2.93 SQ. FT. X 144 = 421.9 SQ. IN. 421.9 SQ. IN. / 9 SQ. IN. = 46.9 (9 SQ. IN. VENT PER LIN. FT.)	= 47 LIN. FT. REQ. 66 LIN. FT. PROVIDED

CODE REFERENCE: 2018 NC RESIDENTIAL CODE, SEC. R806

**NOTE:**  
BUILDING ELEMENTS ARE TO BE APPLIED TO MEET LOCAL WINDLOAD REQUIREMENTS

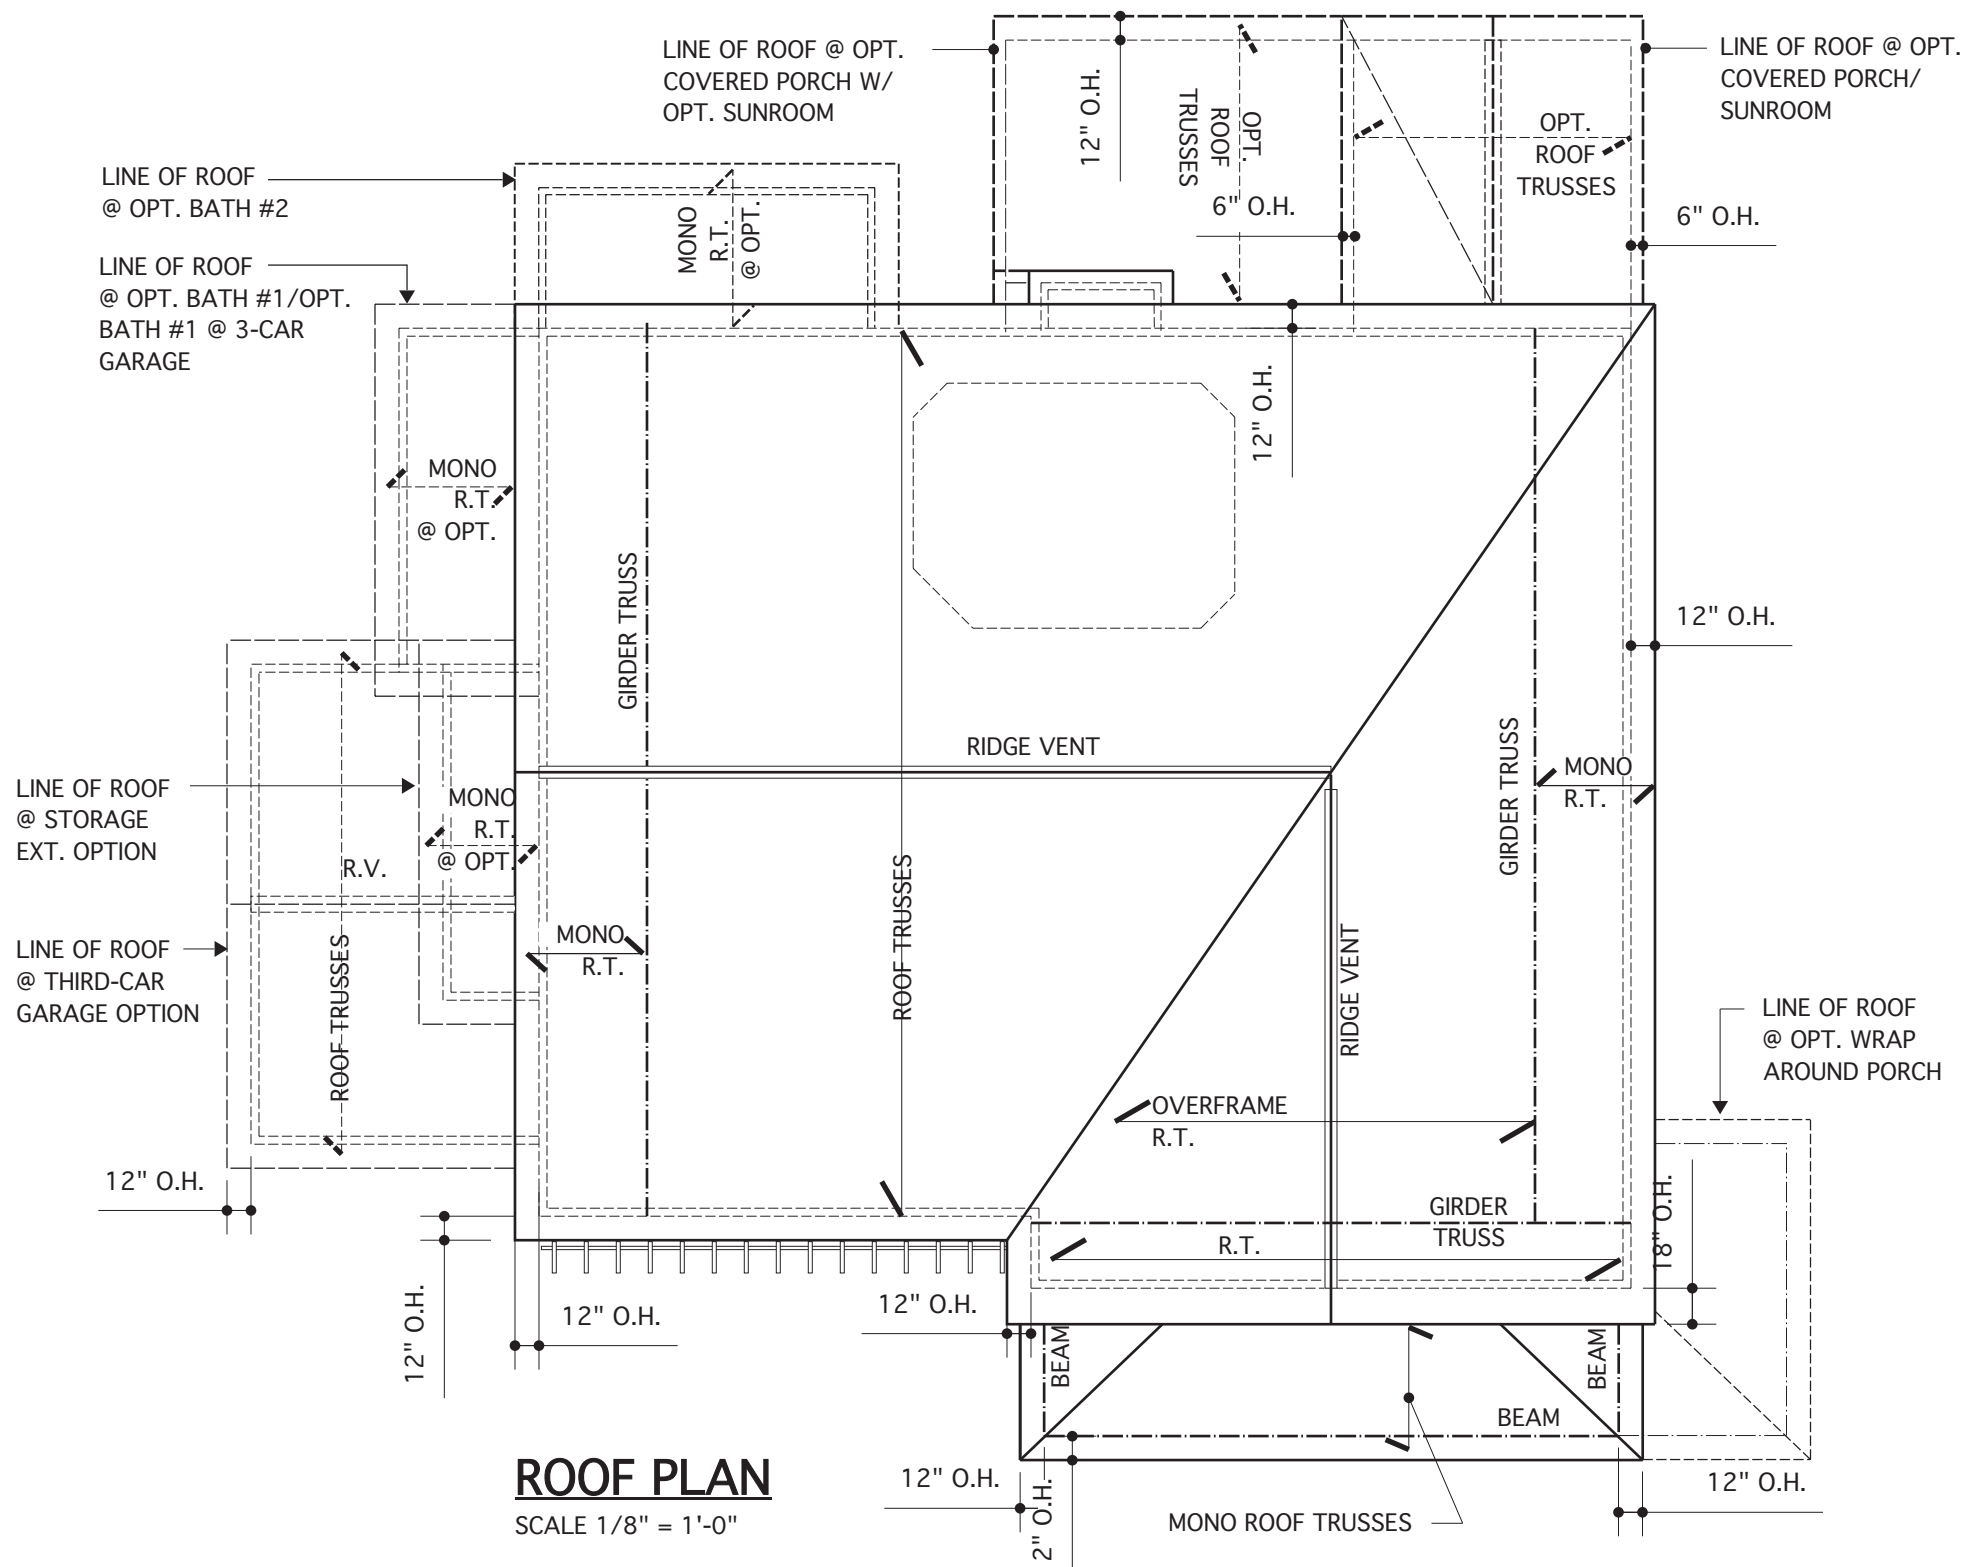

**ROOF PLAN**  
SCALE 1/8"=1'-0"



**FRONT ELEVATION E**  
SCALE: 1/4"=1'-0"

BRICK OR STONE BASE  
BRICK MOLD W/ TRIM  
WINDOWS @ OPT. SIDE-LOAD GARAGE  
10" TRELLIS BEAM & 8" TRELLIS MEMBERS MADE FROM COMPOSITE LUMBER OR USE TRELLIS SYSTEM BY FYPON (OMIT @ SIDE LOAD GARAGE)  
16" X 16" X 3-1/2" PAINTED CEDAR BRACKETS  
BRICK OR STONE PORCH  
STEP IF REQ.  
BRICK MOLD W/ TRIM  
1 X 4 OVER  
1 X 12 TRIM OVER PORCH BEAM  
4 X 4 P.T. BRG. POST W/ SQUARE COLUMN SLEEVE OR TRIM OVER

**JAMES WENTLING/  
ARCHITECT**

LAND TITLE BUILDING  
100 SOUTH BROAD STREET,  
SUITE 1524  
PHILADELPHIA, PA 19110

(215) 568-2551  
email - information@  
wentlinghouseplans.com

ARCHITECTURE  
LAND PLANNING  
GRAPHICS

THESE PLANS ARE COPYRIGHTED AND ARE SUBJECT TO COPYRIGHT PROTECTION AS AN "ARCHITECTURAL WORK" UNDER SECTION 102 OF THE COPYRIGHT ACT, 17 U.S.C. AS AMENDED DECEMBER 1, 1990 AND KNOWN AS THE "ARCHITECTURAL WORKS COPYRIGHT PROTECTION ACT OF 1990." THE PROTECTION INCLUDES BUT IS NOT LIMITED TO THE OVERALL FORM AS WELL AS THE ARRANGEMENT AND COMPOSITION OF SPACES AND ELEMENTS OF THE DESIGN. UNDER SUCH PROTECTION, UNAUTHORIZED USE OF THESE PLANS, WORKS, OR FORMS REPRESENTED CAN LEGALLY RESULT IN THE CESSATION OF SUCH CONSTRUCTION OR BUILDINGS BEING SEIZED AND/OR RAISED.

4/1/24

REVISIONS	
MARK	DESCRIPTION
CH	12-10-19 CONVERT KINGSTON
CH	05-18-20 MINOR UPDATE
DN	04-04-24 CONVERT 113-69/ADD OPT. BATH #2 LM

PROJECT NO.	113-88
DATE	12-10-19
SCALE	AS NOTED
DRAWN BY	CH
CHECKED BY	JW
ISSUED FOR	PERMITS/CONSTRUCTION

PROJECT TITLE  
**MODEL 628 -  
GARAGE LEFT**

CLIENT  
**CHESAPEAKE  
HOMES OF NC**  
3100 Smoketree Court,  
Suite 210  
Raleigh, NC 27604  
(919) 256-3060  
(919) 556-0690 Fax

DRAWING TITLE  
**ELEVATION E  
AND ROOF PLAN**

SHEET  
**4.4**

© Copyright 2016 James Wentling / Architect



**JAMES WENTLING/  
ARCHITECT**  
LAND TITLE BUILDING  
100 SOUTH BROAD STREET,  
SUITE 1524  
PHILADELPHIA, PA 19110  
  
(215) 568-2551  
email - information@  
wentlinghouseplans.com

ARCHITECTURE  
LAND PLANNING  
GRAPHICS

THESE PLANS ARE COPYRIGHTED AND ARE SUBJECT TO COPYRIGHT PROTECTION AS AN "ARCHITECTURAL WORK" UNDER SECTION 102 OF THE COPYRIGHT ACT, 17 U.S.C. AS AMENDED DECEMBER 1, 1990 AND KNOWN AS THE "ARCHITECTURAL WORKS" COPYRIGHT PROTECTION ACT OF 1990. THE PROTECTION INCLUDES BUT IS NOT LIMITED TO, THE OVERALL FORM AS WELL AS THE ARRANGEMENT AND COMPOSITION OF SPACES AND ELEMENTS OF THE DESIGN. UNDER SUCH PROTECTION, UNAUTHORIZED USE OF THESE PLANS, WORKS, OR FORMS REPRESENTED CAN LEGALLY RESULT IN THE CESSATION OF SUCH CONSTRUCTION OR BUILDINGS BEING SEIZED AND/OR RAISED.



REVISIONS




MARK	DATE	DESCRIPTION
DN	04-04-24	CONVERT 113-69/ADD OPT. BATH #2 LM

PROJECT NO. 113-88  
DATE 05-18-20  
SCALE AS NOTED  
DRAWN BY CH  
CHECKED BY JW  
ISSUED FOR PERMITS/CONSTRUCTION

PROJECT TITLE  
**MODEL 628 -  
GARAGE LEFT**  
  
CLIENT  
**CHESAPEAKE  
HOMES OF NC**  
3100 Smoketree Court,  
Suite 210  
Raleigh, NC 27604  
(919) 256-3060  
(919) 556-0690 Fax

DRAWING TITLE  
**ELEVATION F  
AND ROOF PLAN**

SHEET  
**4.5**

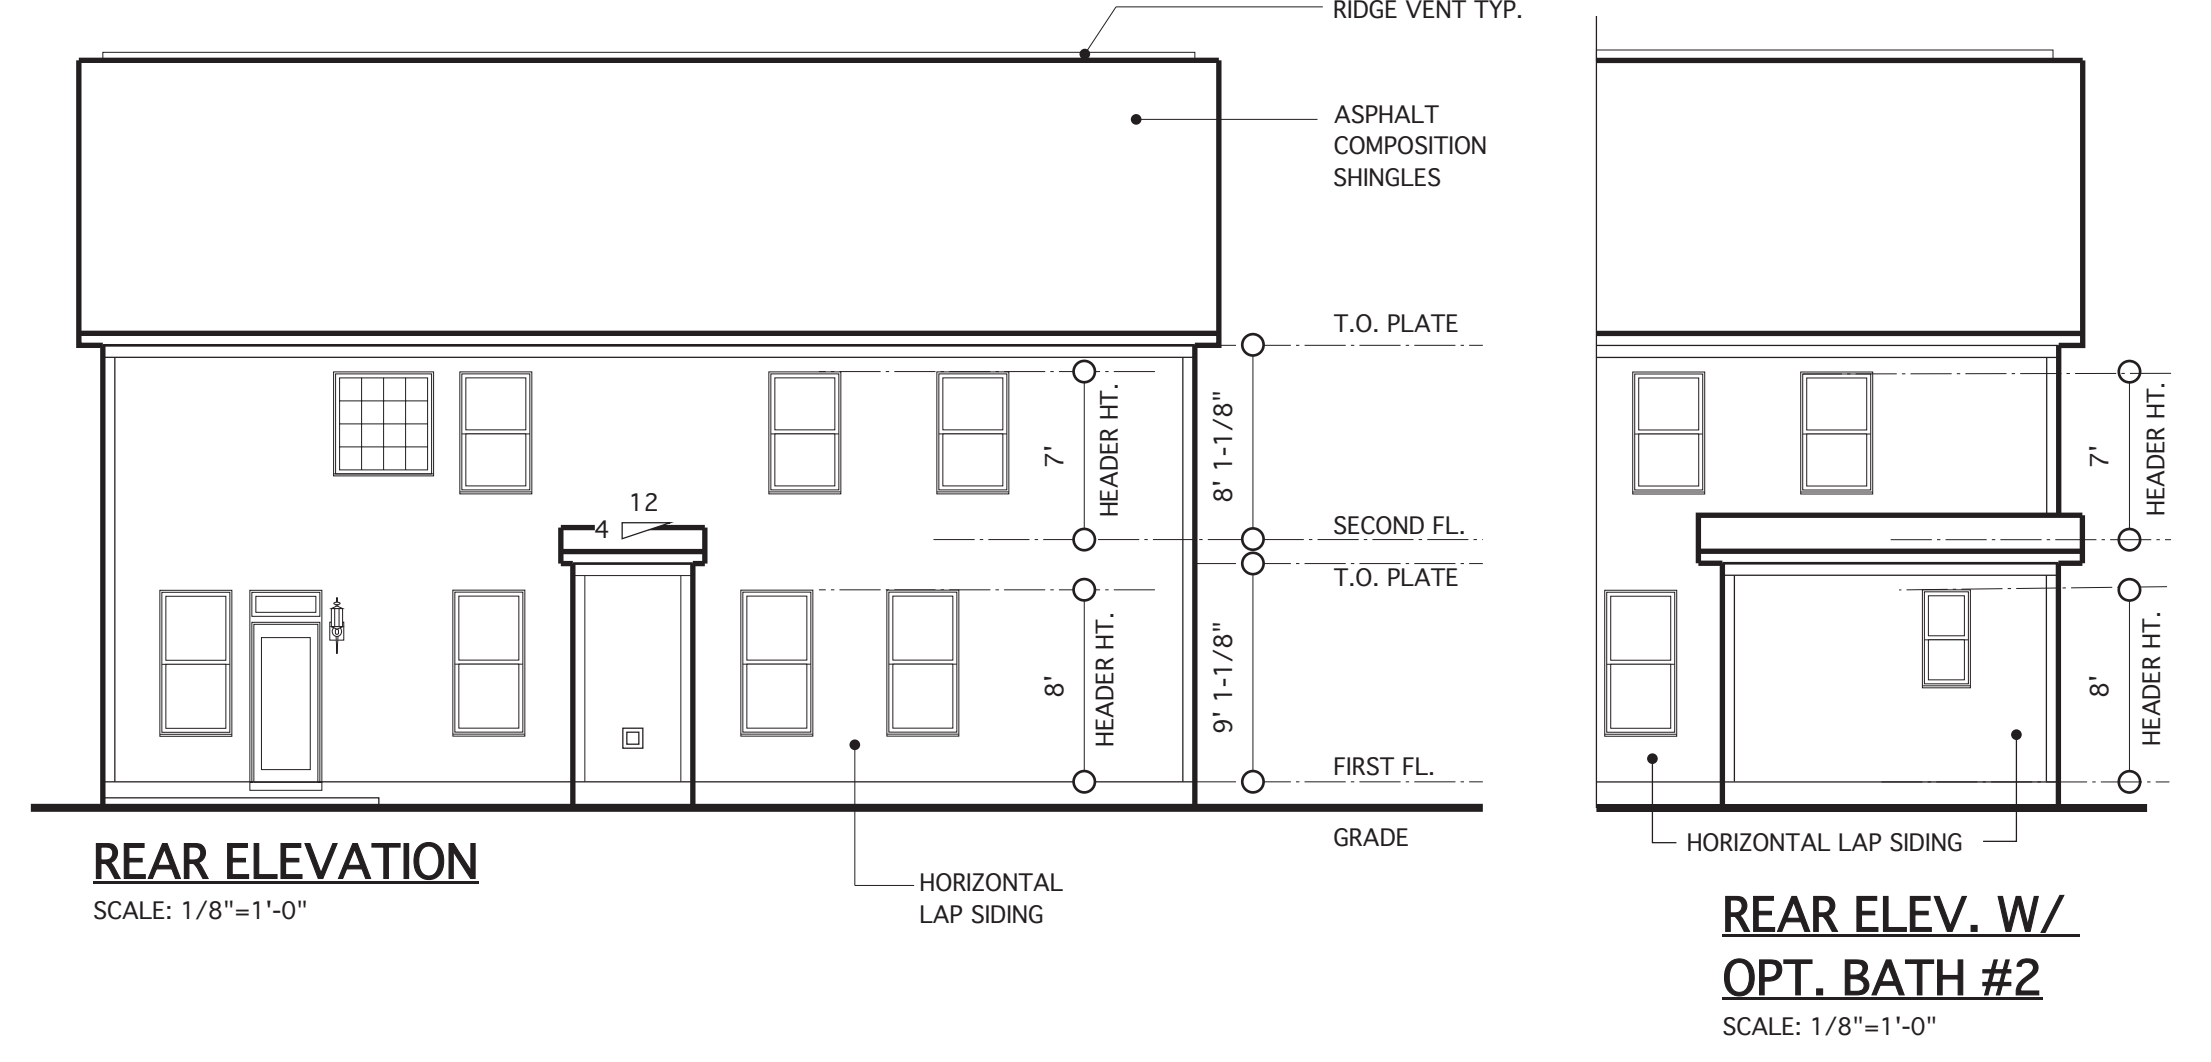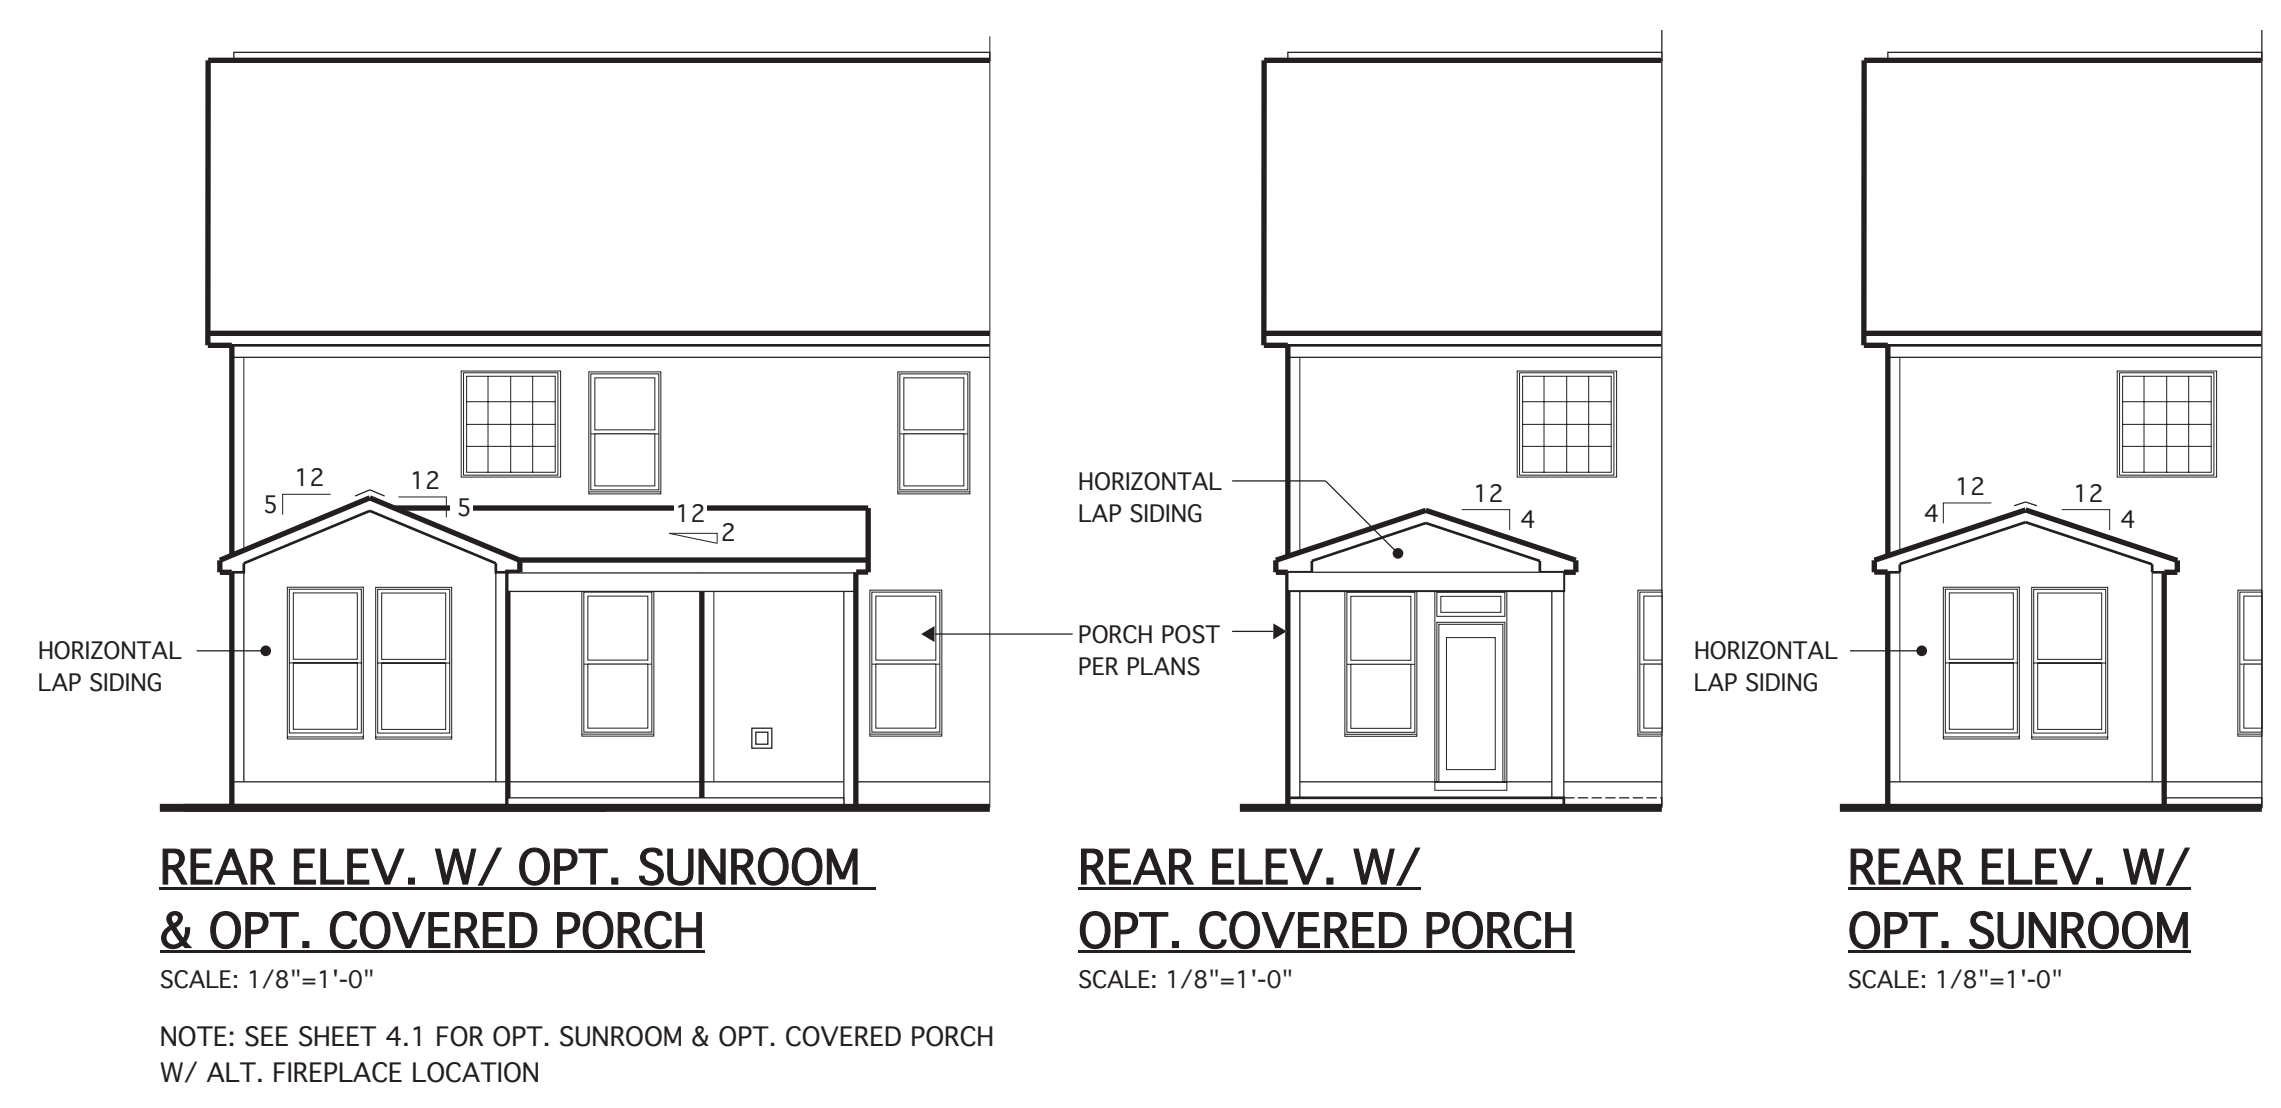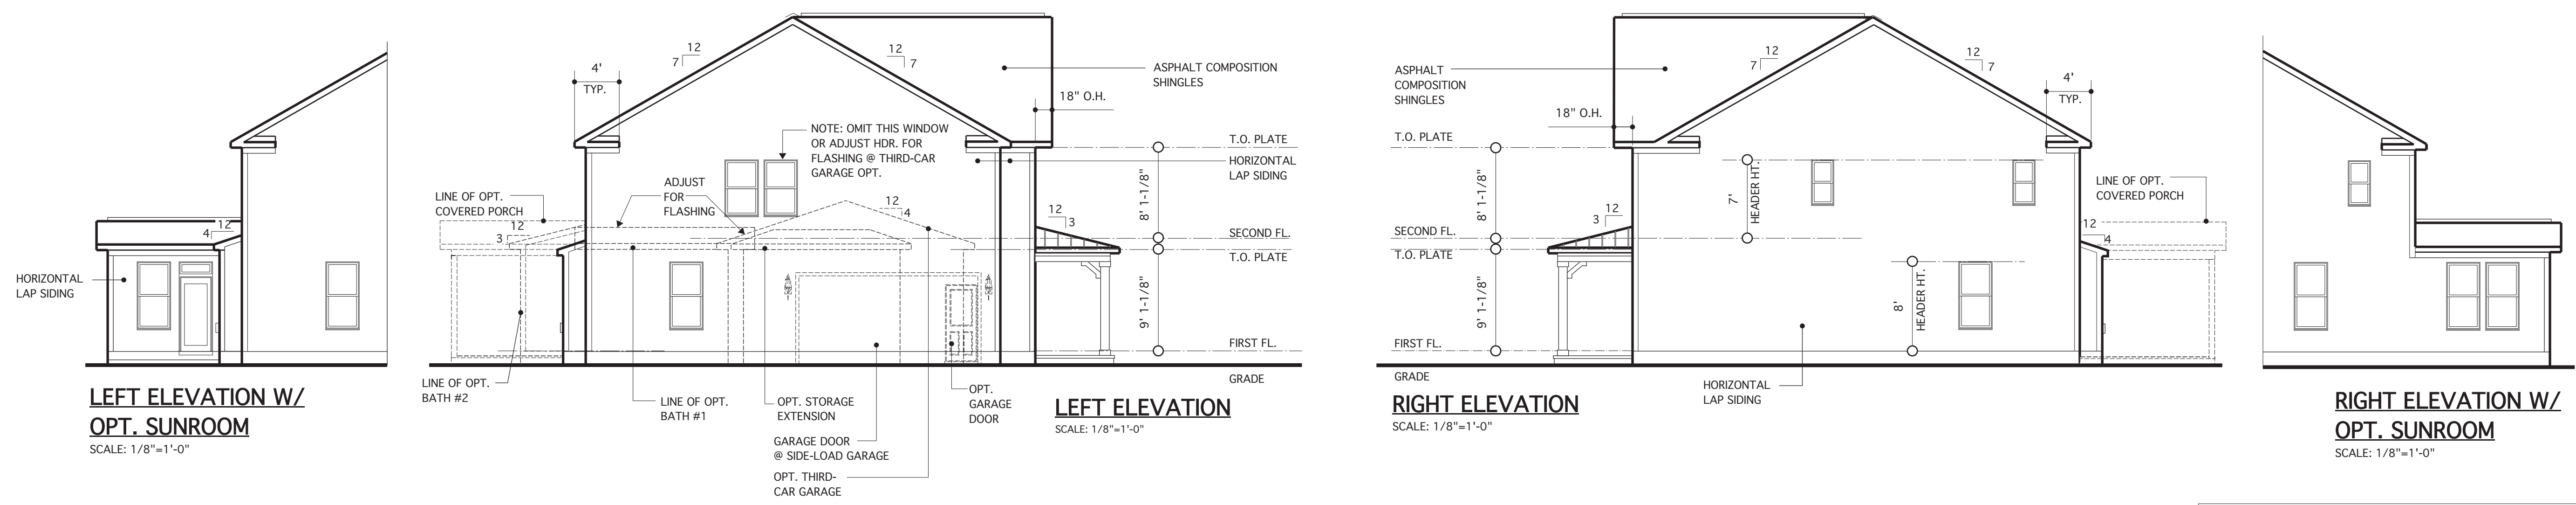


**REQUIRED VENTILATION SCHEDULE - SUNROOM**

138 SQ. FT. OF CEILING AREA / 300	= 0.46 SQ. FT. REQ.
<b>RIDGE VENTS</b> 0.46 X 0.5 = 0.23 SQ. FT. 0.23 SQ. FT. X 144 = 33 SQ. IN. 33 SQ. IN. / 18 SQ. IN. = 1.83 (18 SQ. IN. VENT PER LIN. FT.)	= 1.83 LIN. FT. REQ. (12 LIN. FT. PROVIDED)
<b>SOFFIT VENTS</b> 0.46 X 0.5 = 0.23 SQ. FT. 0.23 SQ. FT. X 144 = 33 SQ. IN. 33 SQ. IN. / 9 SQ. IN. = 3.7 LIN. FT. (9 SQ. IN. VENT PER LIN. FT.)	= 3.7 LIN. FT. REQ. (24 LIN. FT. PROVIDED)

**REQUIRED VENTILATION SCHEDULE - MAIN HOUSE**


1,777 SQ. FT. OF CEILING AREA / 300	= 5.92 SQ. FT. REQ.
<b>RIDGE VENTS</b> 5.92 X 0.5 = 2.96 SQ. FT. 2.96 SQ. FT. X 144 = 426 SQ. IN. 426 SQ. IN. / 18 SQ. IN. = 23.7 (18 SQ. IN. VENT PER LIN. FT.)	= 23.7 LIN. FT. REQ. (66 LIN. FT. PROVIDED)
<b>SOFFIT VENTS</b> 5.92 X 0.5 = 2.96 SQ. FT. 2.96 SQ. FT. X 144 = 426 SQ. IN. 426 SQ. IN. / 12 SQ. IN. = 35.5 LIN. FT. (12 SQ. IN. VENT PER LIN. FT.)	= 35.5 LIN. FT. REQ. (72 LIN. FT. PROVIDED)

CODE REFERENCE: 2018 NCSRC, SEC. R806.2  
  
**NOTE:**  
BUILDING ELEMENTS ARE TO BE APPLIED TO MEET  
LOCAL WINDLOAD REQUIREMENTS

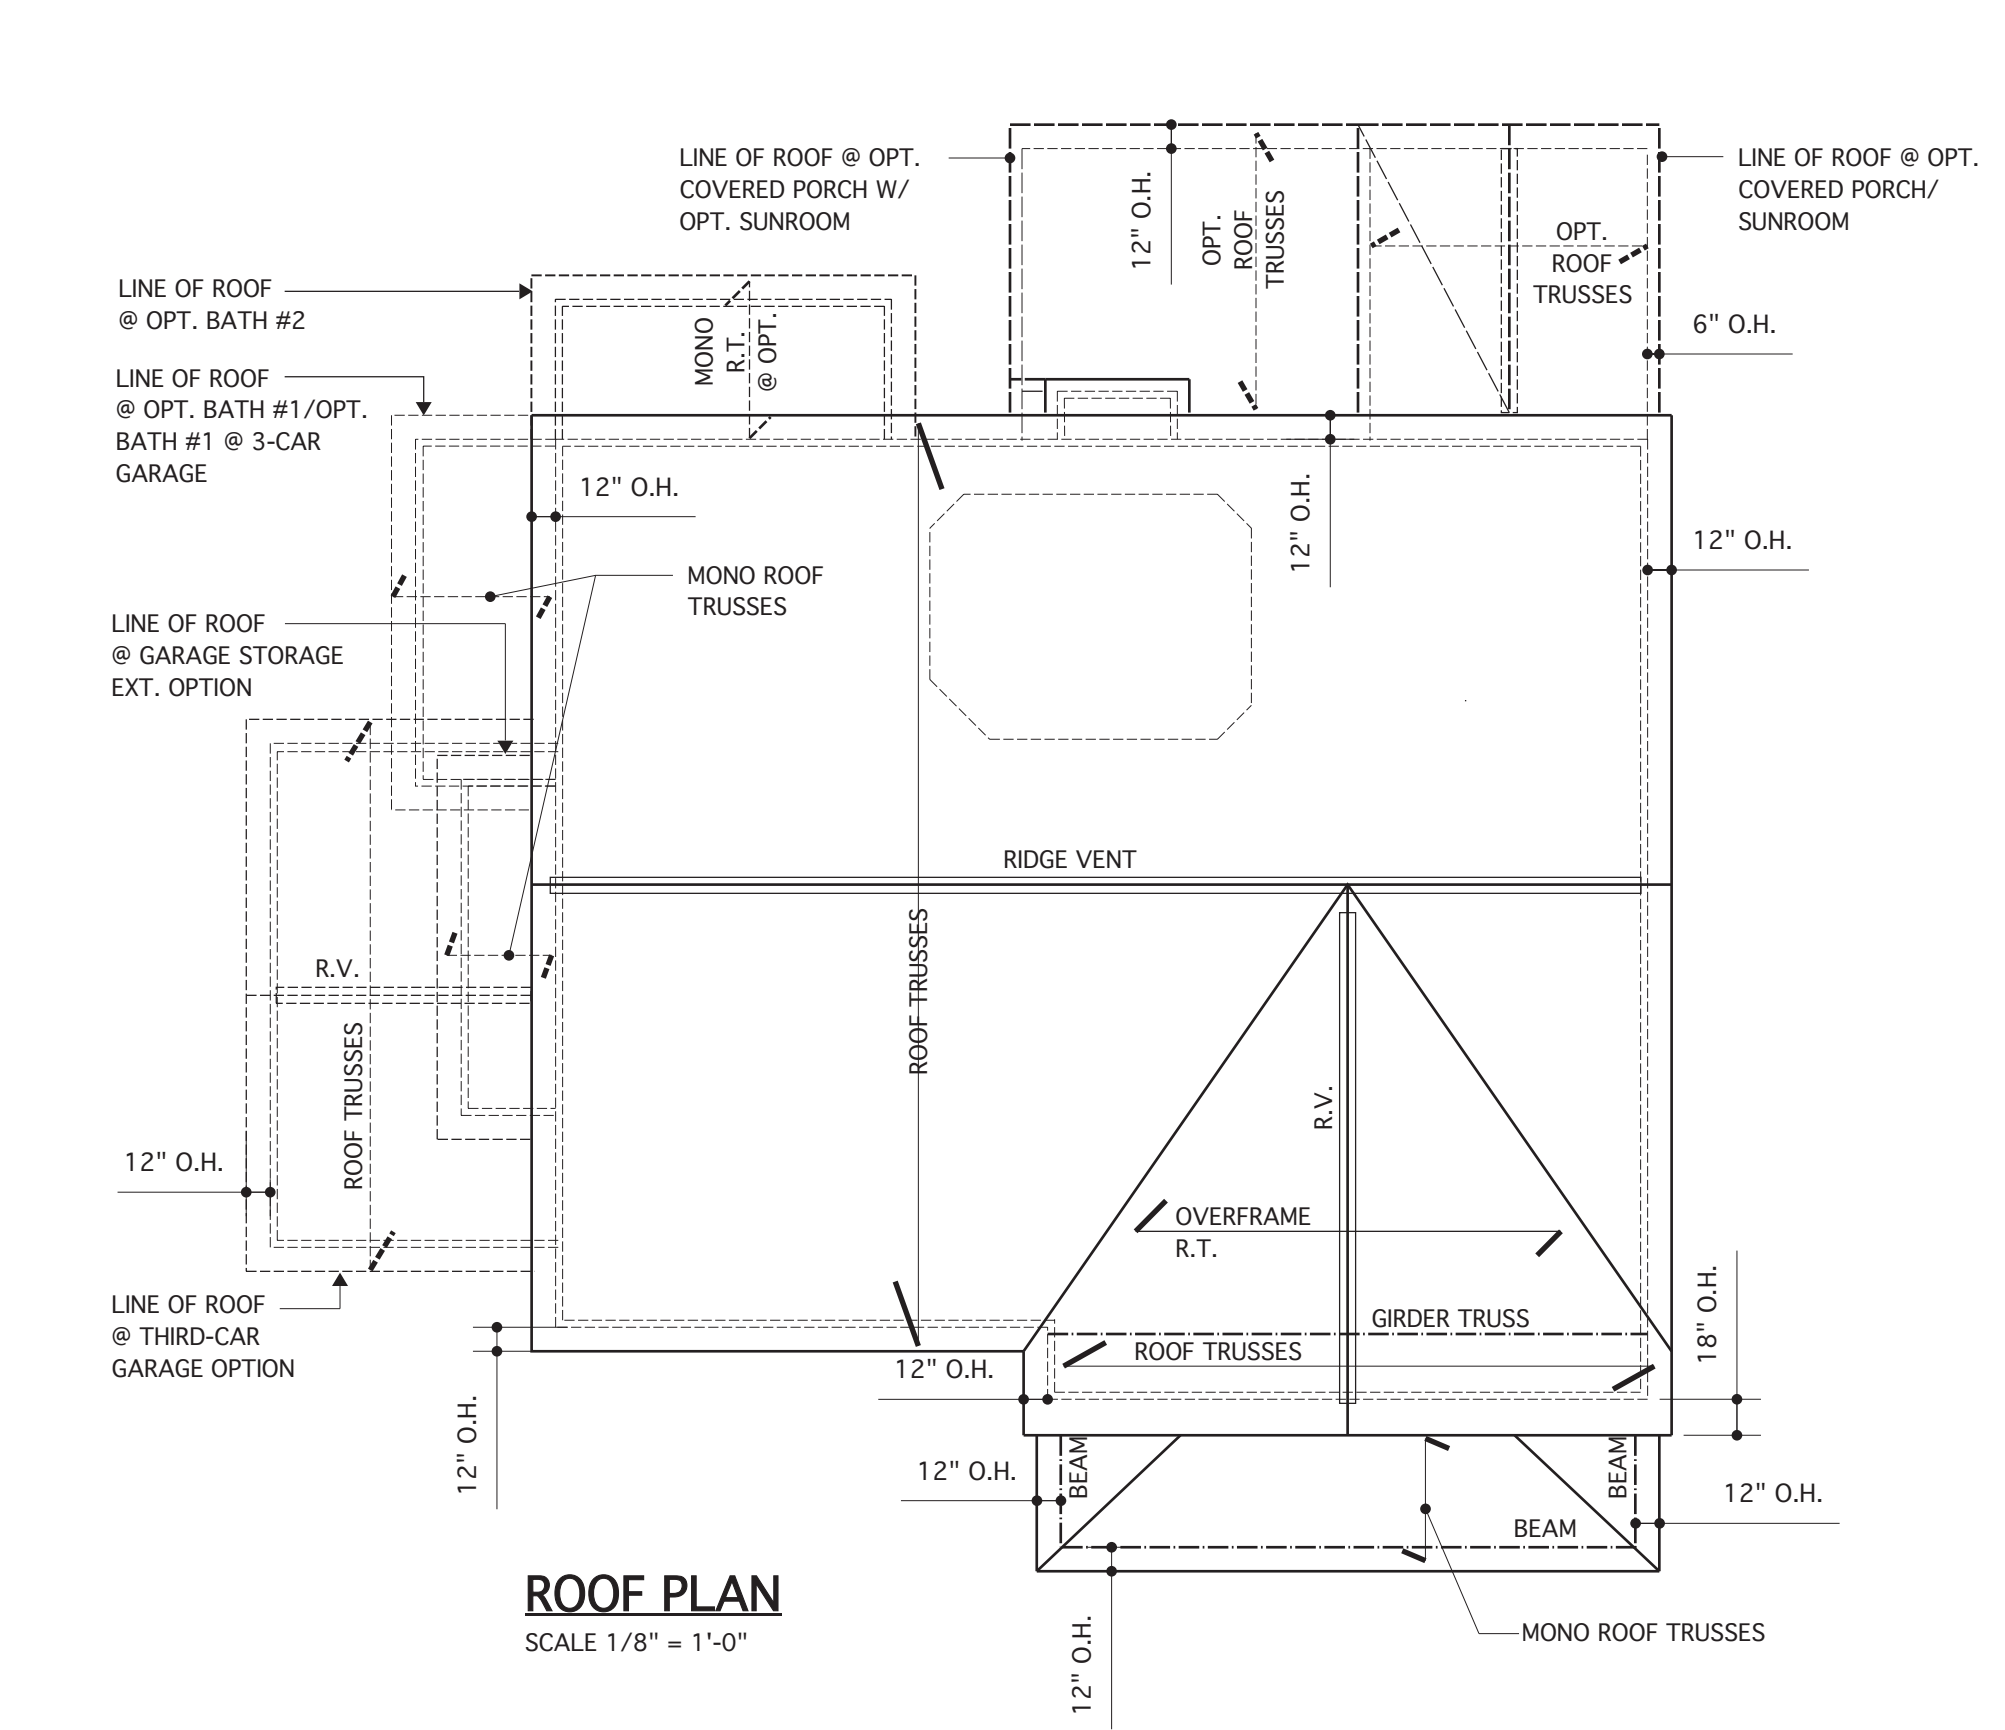


© Copyright 2016 James Wentling / Architect





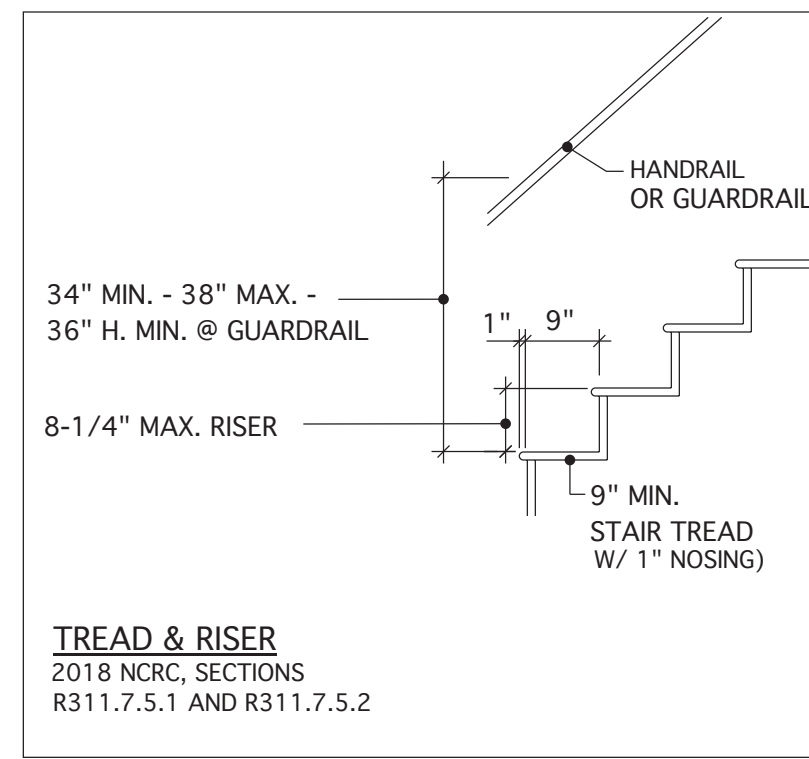

**TYPICAL STAIR/STEP SECTION**  
SCALE: 1/2" = 1'-0"  
ALL STAIR AND GUARD REQUIREMENTS TO COMPLY WITH R311 AND R312 NCRBC 2018  
**NOTE:** STAIRS ARE SHOWN WITH 7-3/4" RISER & 10" TREAD WHICH IS ABOVE CODE MINIMUM.

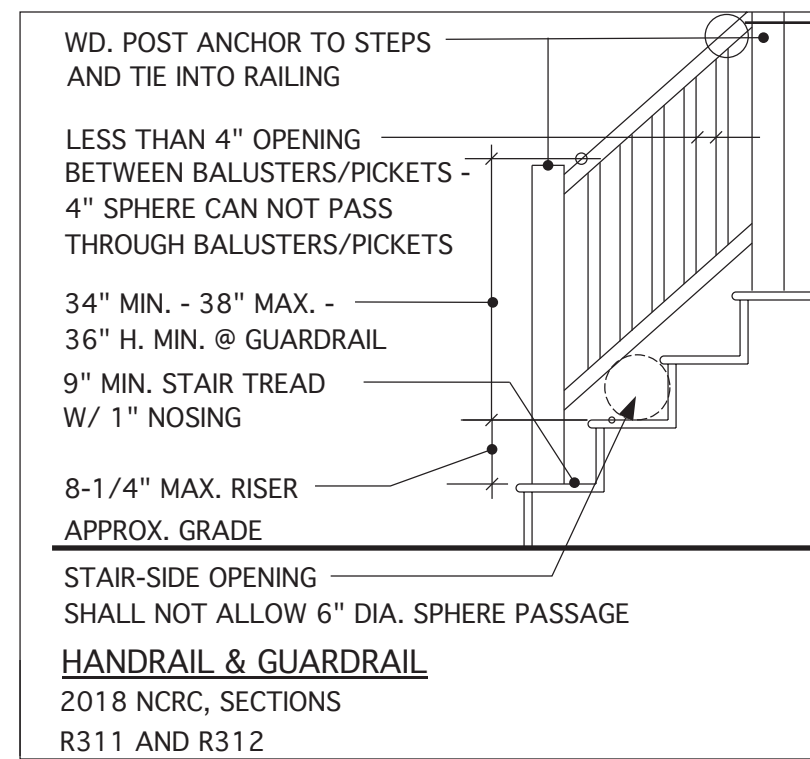

**TYPICAL RAILING @ PORCH/DECK**  
SCALE: 1/2" = 1'-0"  
(PROVIDE GUARDRAIL BOTH SIDES WHEN HEIGHT ABOVE GRADE EXCEEDS 30")  
PROVIDE HANDRAIL ONE SIDE OF STEPS WHERE 4 OR MORE RISERS)

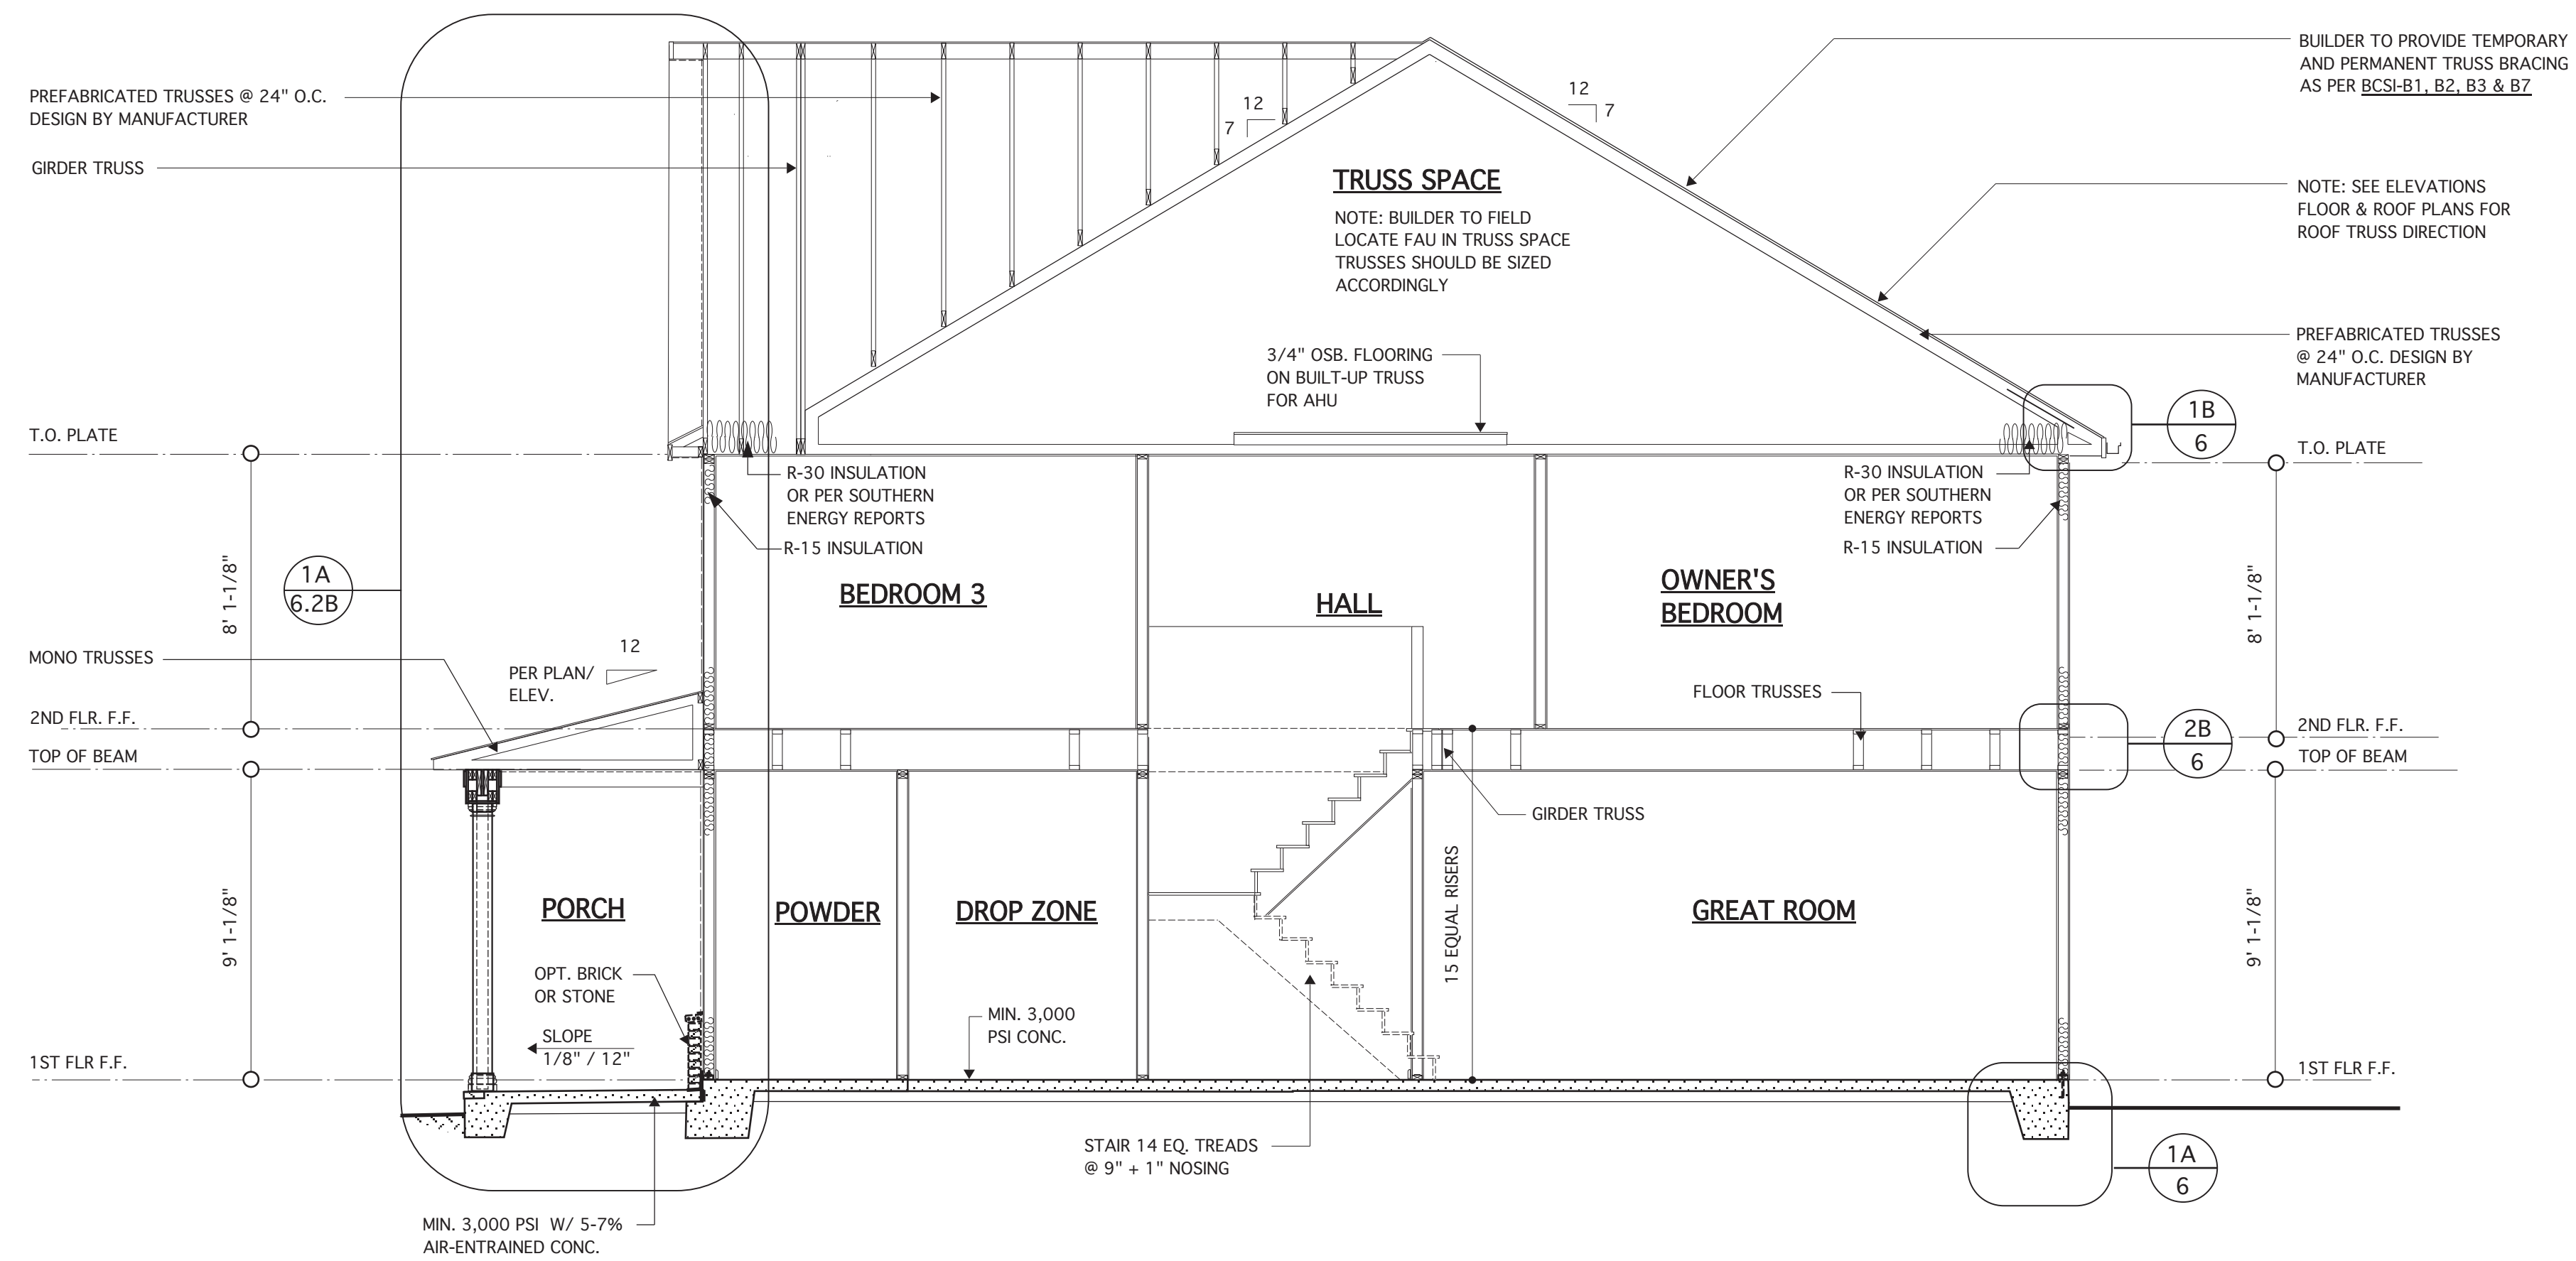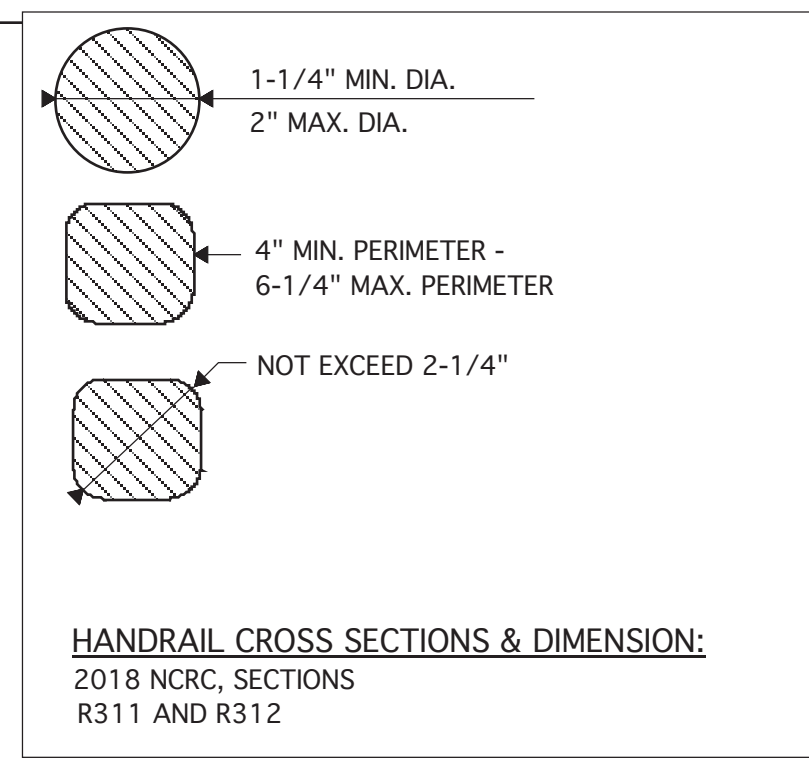

**TYPICAL BUILDING SECTION @ ELEVATION B**  
SCALE: 1/4" = 1'-0"  
Note: Minimum insulation values subject to Southern Energy

**JAMES WENTLING/ ARCHITECT**

LAND TITLE BUILDING  
100 SOUTH BROAD STREET,  
SUITE 1524  
PHILADELPHIA, PA 19110

(215) 568-2551  
email - information@  
wentlinghouseplans.com

ARCHITECTURE  
LAND PLANNING  
GRAPHICS

THESE PLANS ARE COPYRIGHTED AND ARE SUBJECT TO COPYRIGHT PROTECTION AS AN "ARCHITECTURAL WORK" UNDER SECTION 102 OF THE COPYRIGHT ACT, 17 U.S.C. AS AMENDED DECEMBER 1, 1990 AND KNOWN AS THE "ARCHITECTURAL WORKS COPYRIGHT PROTECTION ACT OF 1990." THE PROTECTION INCLUDES BUT IS NOT LIMITED TO, THE OVERALL FORM AS WELL AS THE ARRANGEMENT AND COMPOSITION OF SPACES AND ELEMENTS OF THE DESIGN. UNDER SUCH PROTECTION, UNAUTHORIZED USE OF THESE PLANS, WORKS, OR FORMS REPRESENTED CAN LEGALLY RESULT IN THE CESSATION OF SUCH CONSTRUCTION OR BUILDINGS BEING SEIZED AND/OR RAISED.

© Copyright 2016 James Wentling/Architect



**REVISIONS**

MARK	DATE	DESCRIPTION
DN	01-10-19	CONVERT OLABS
DN	02-14-19	STRUCT. DWGS. REV.
CH	05-18-20	MINOR UPDATE
DN	04-04-24	CONVERT 113-69/ADD OPT. BATH #2 LM

**PROJECT NO.**

113-88

**DATE**

01-13-16

**SCALE**

AS NOTED

**DRAWN BY**

JB

**CHECKED BY**

JW

**ISSUED FOR**

PERMITS/CONSTRUCTION

**PROJECT TITLE**

**MODEL 628 - GARAGE LEFT**

**CLIENT**

**CHESAPEAKE HOMES OF NC**  
3100 Smoketree Court,  
Suite 210  
Raleigh, NC 27604  
(919) 256-3060  
(919) 556-0690 Fax


**DRAWING TITLE**

**BUILDING SECTIONS**


**SHEET**

**5**




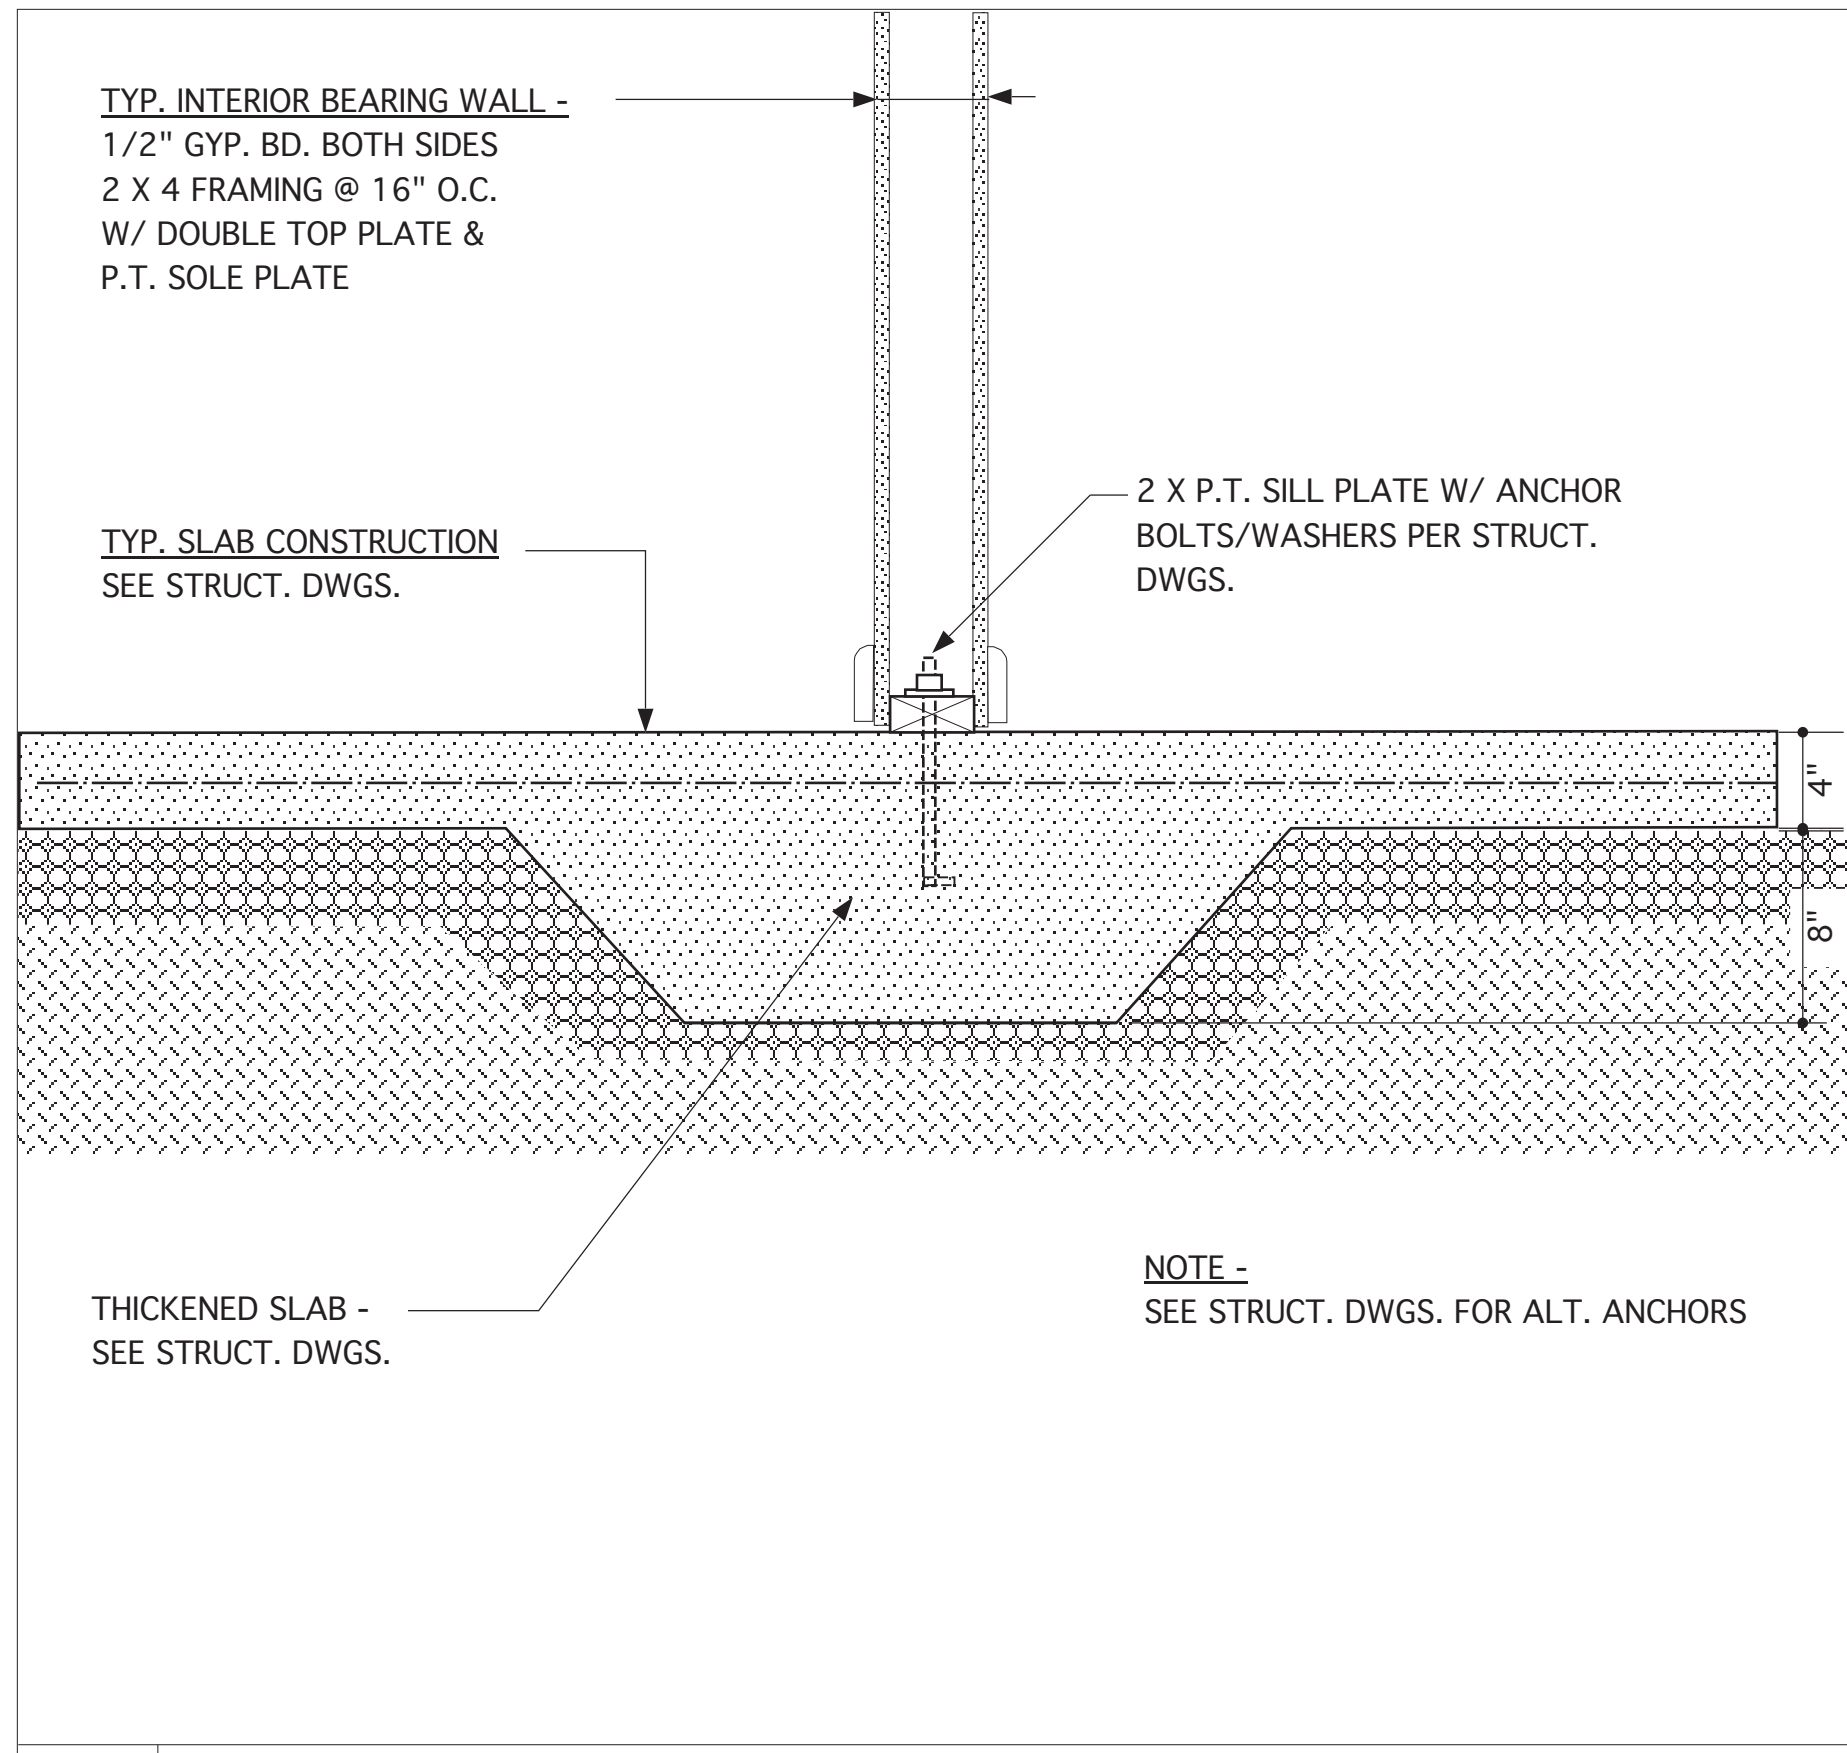


3B FOUNDATION DETAIL @ INTERIOR THICKENED SLAB

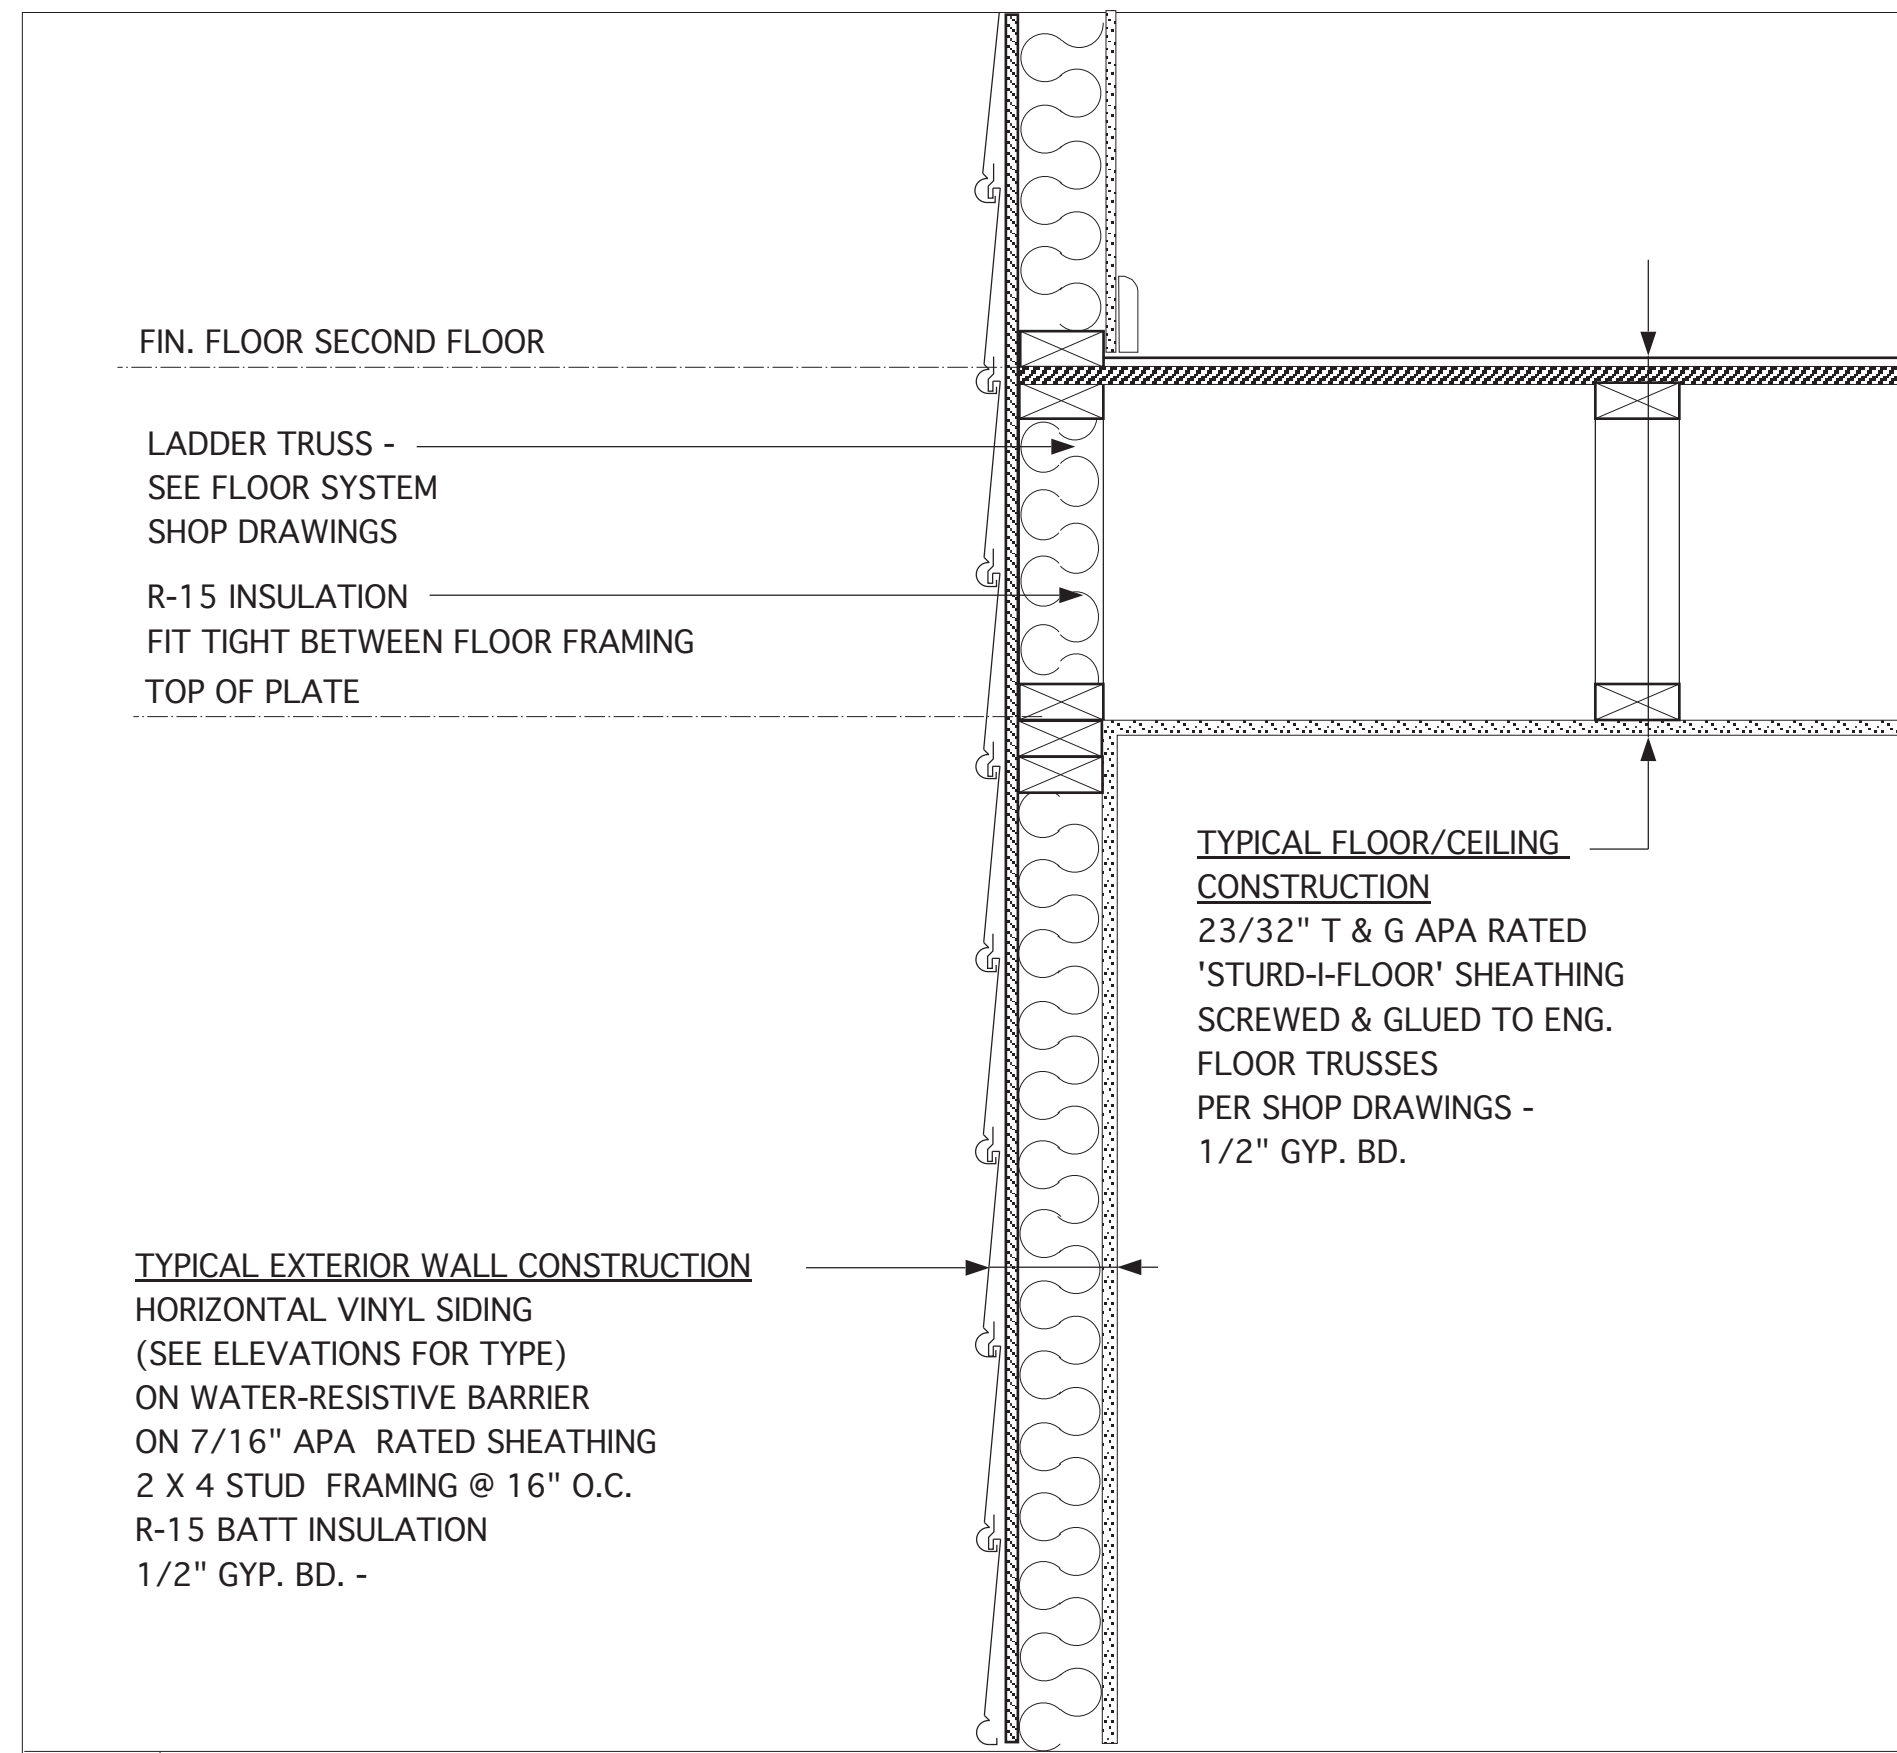


2B TYPICAL FLOOR / WALL DETAIL

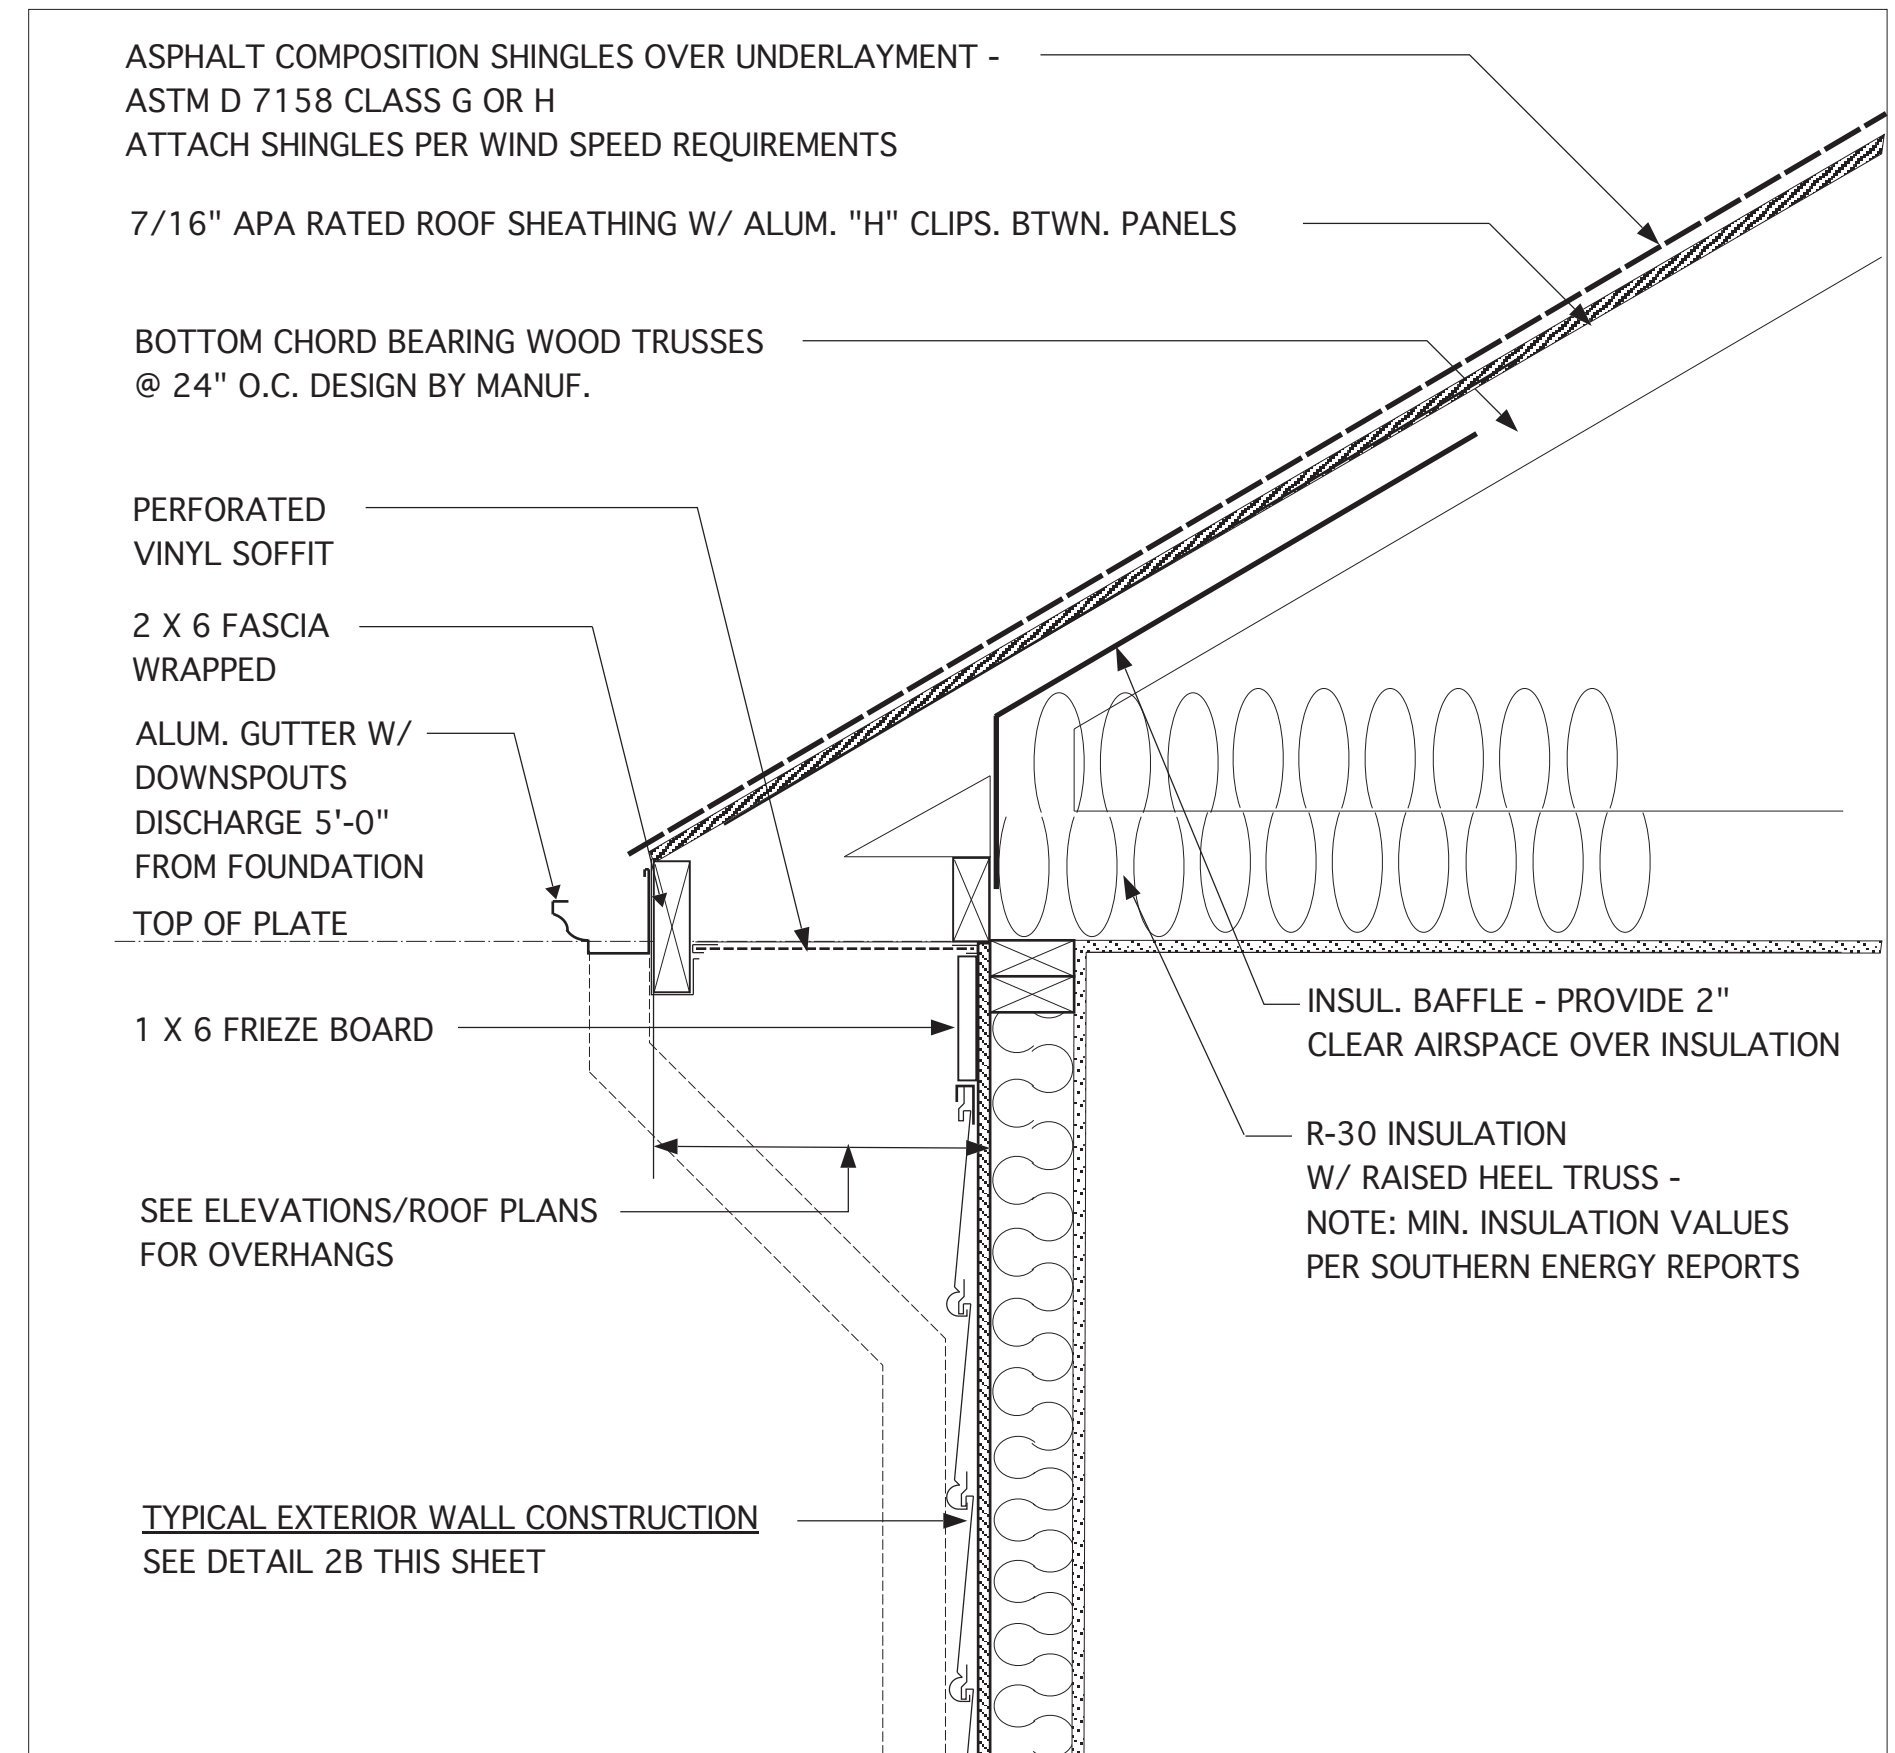


1B TYPICAL SOFFIT DETAIL

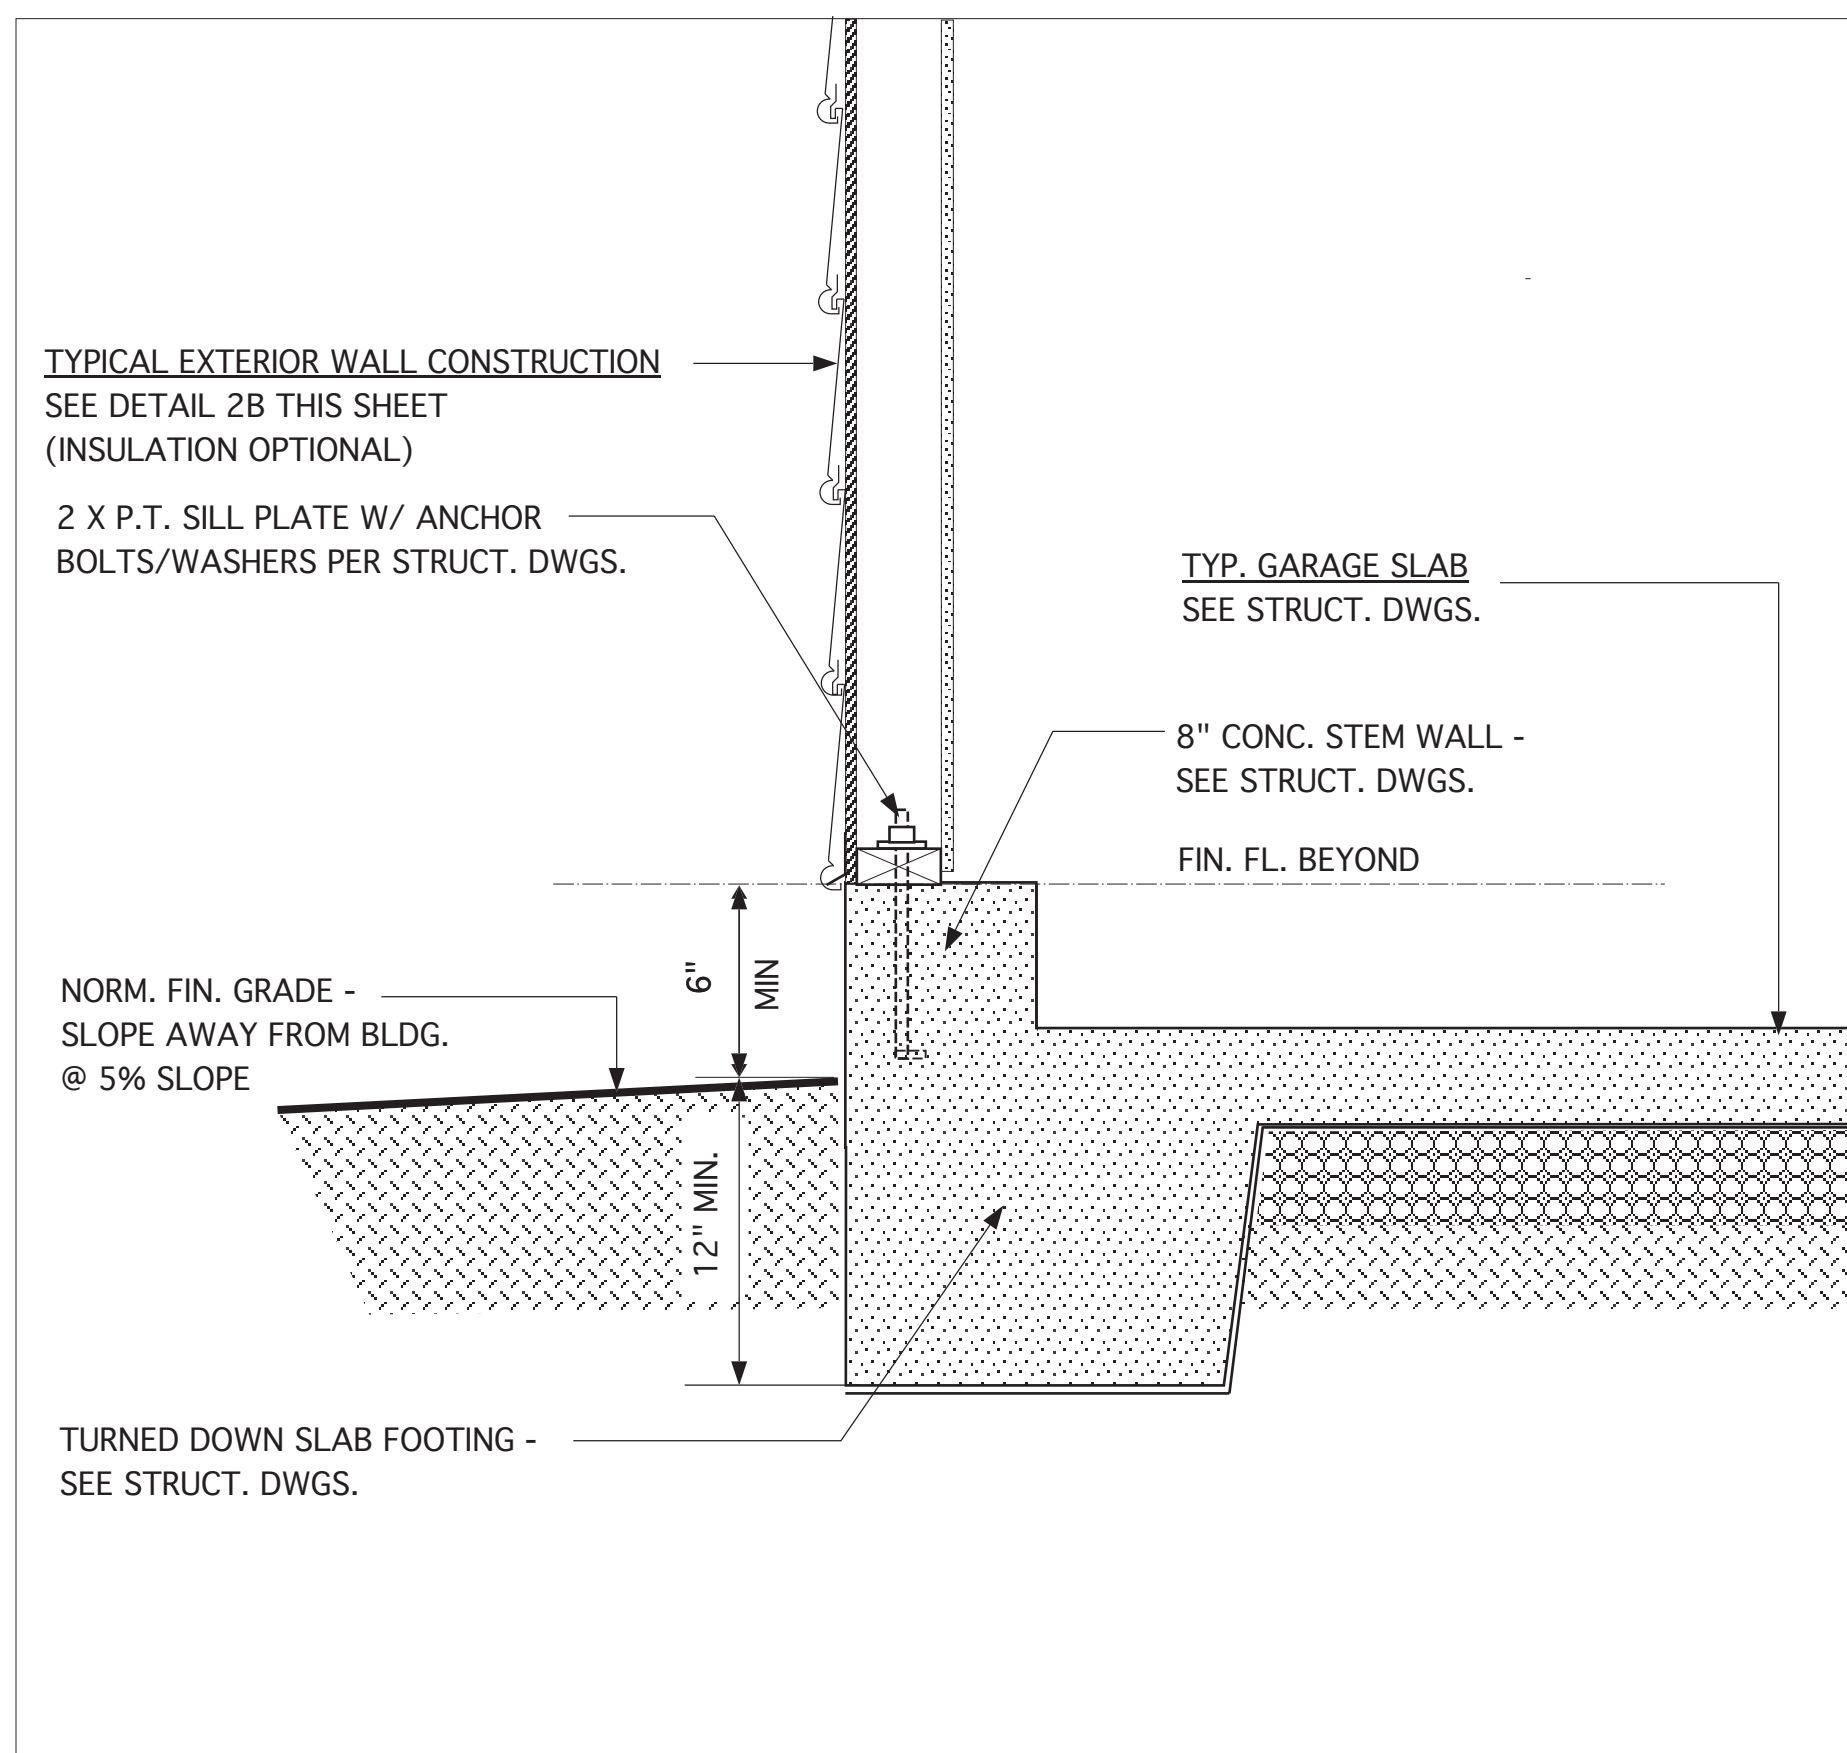

3A FOUND. DETAIL @ GARAGE EXTERIOR SIDE WALL

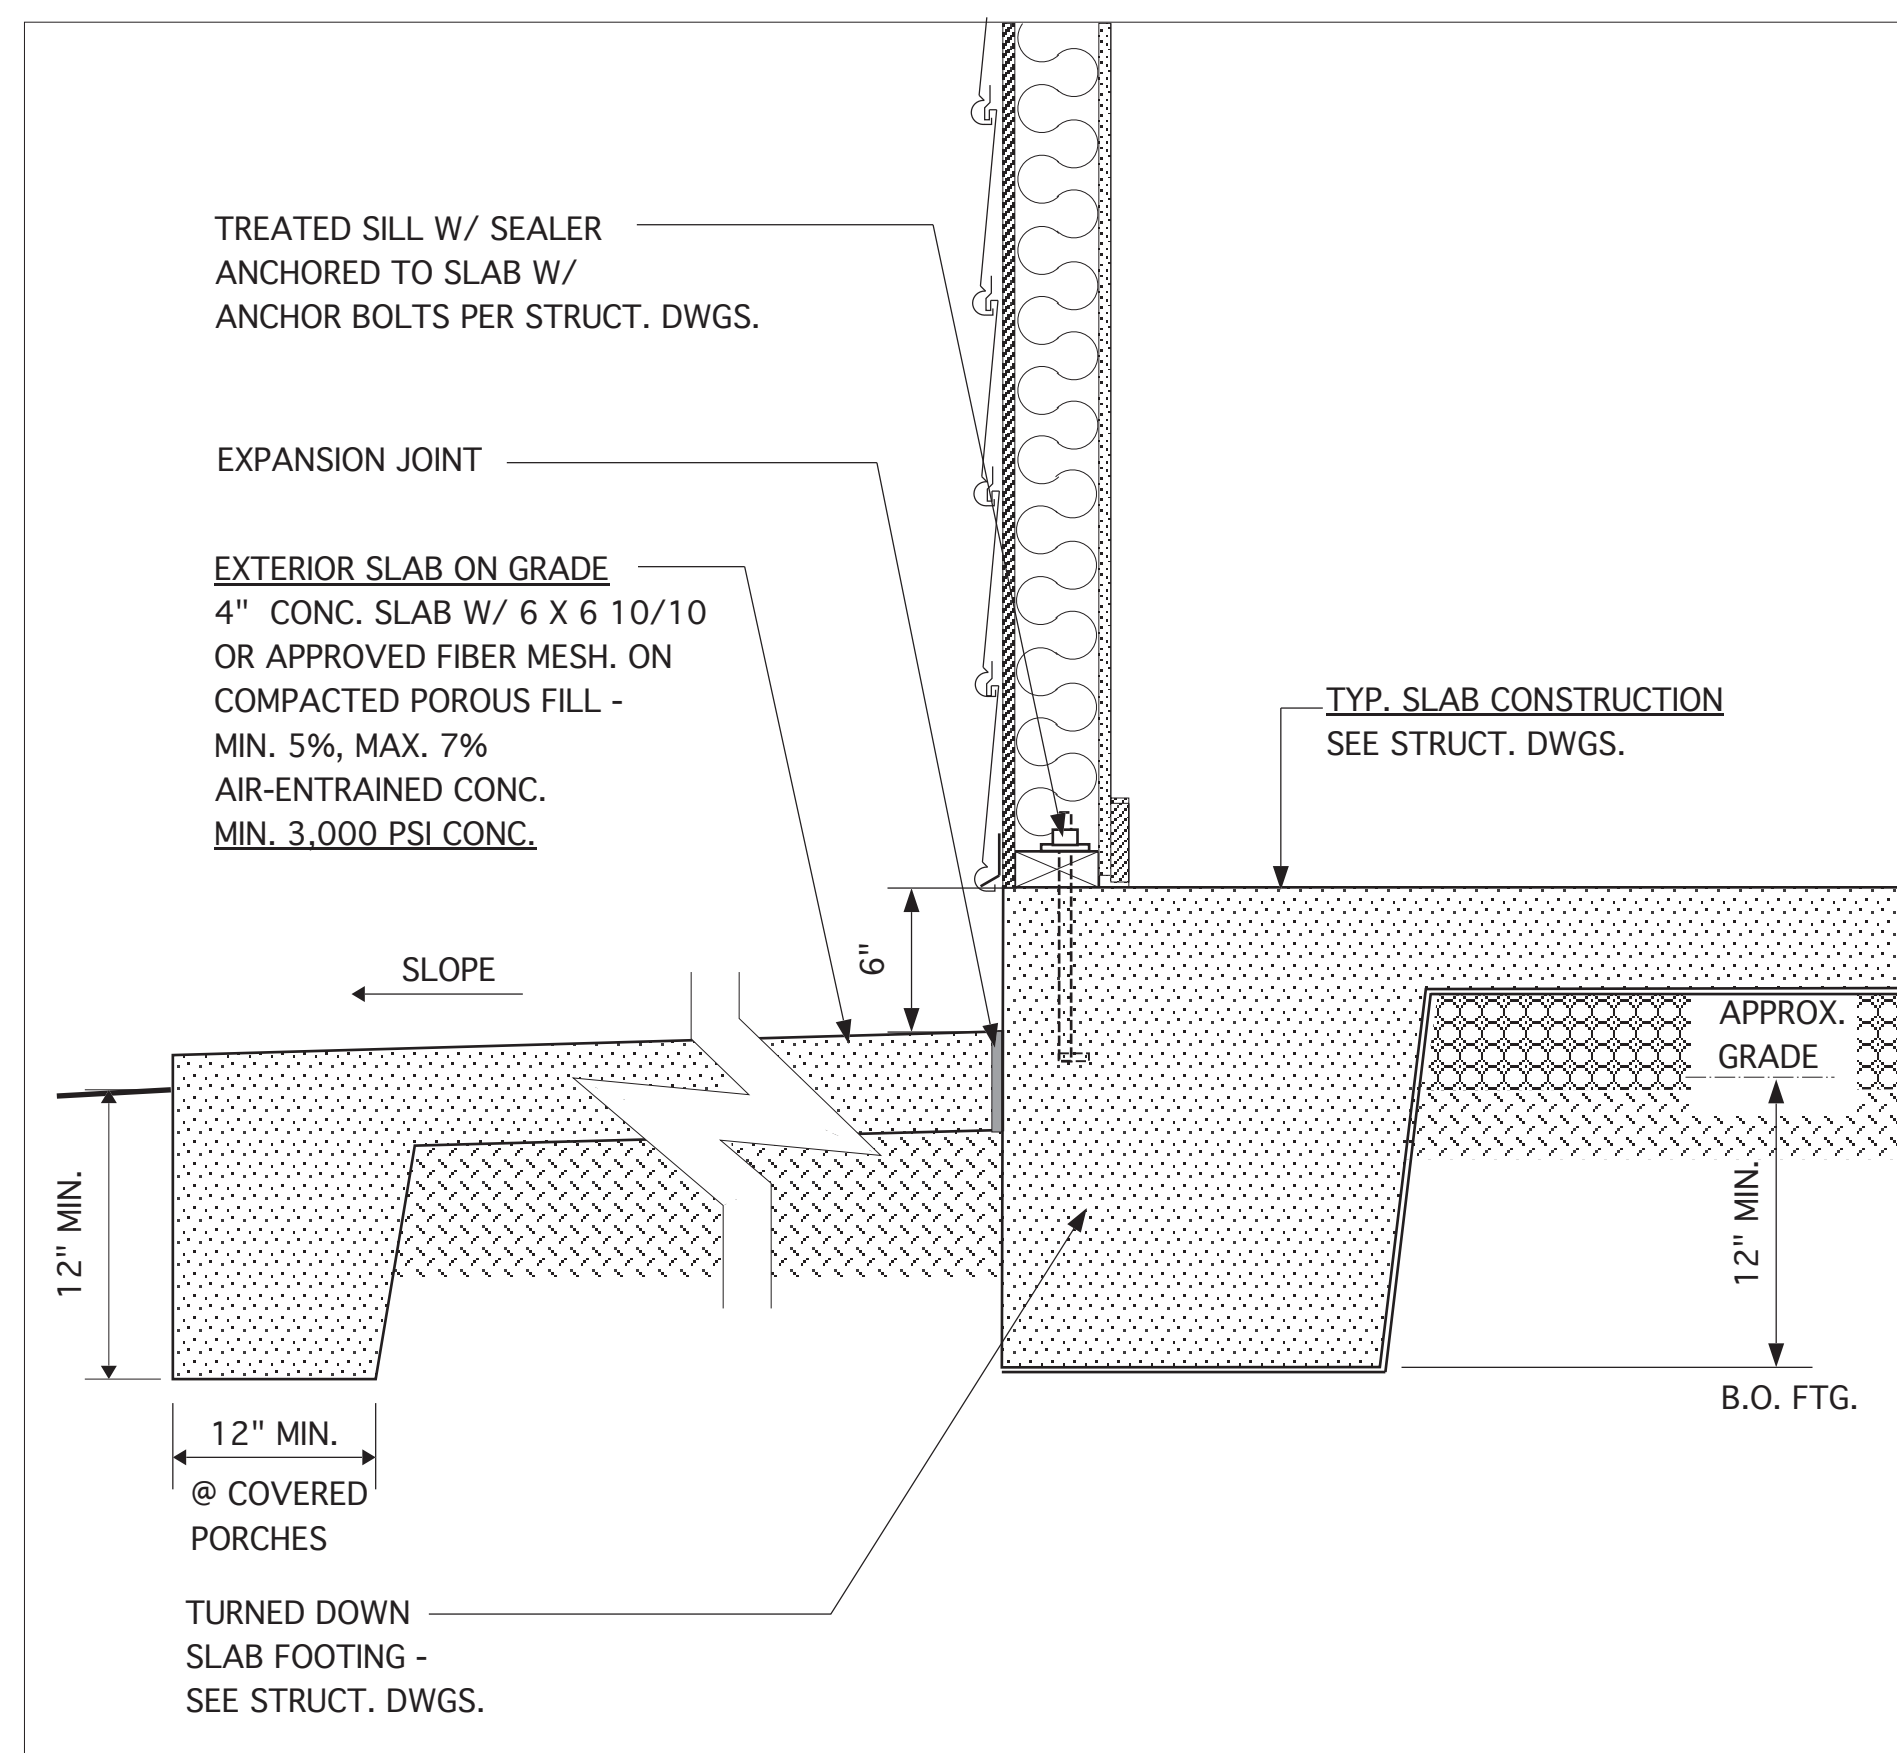

2A FOUND. DETAIL @ PATIO OR REAR COVERED PORCH

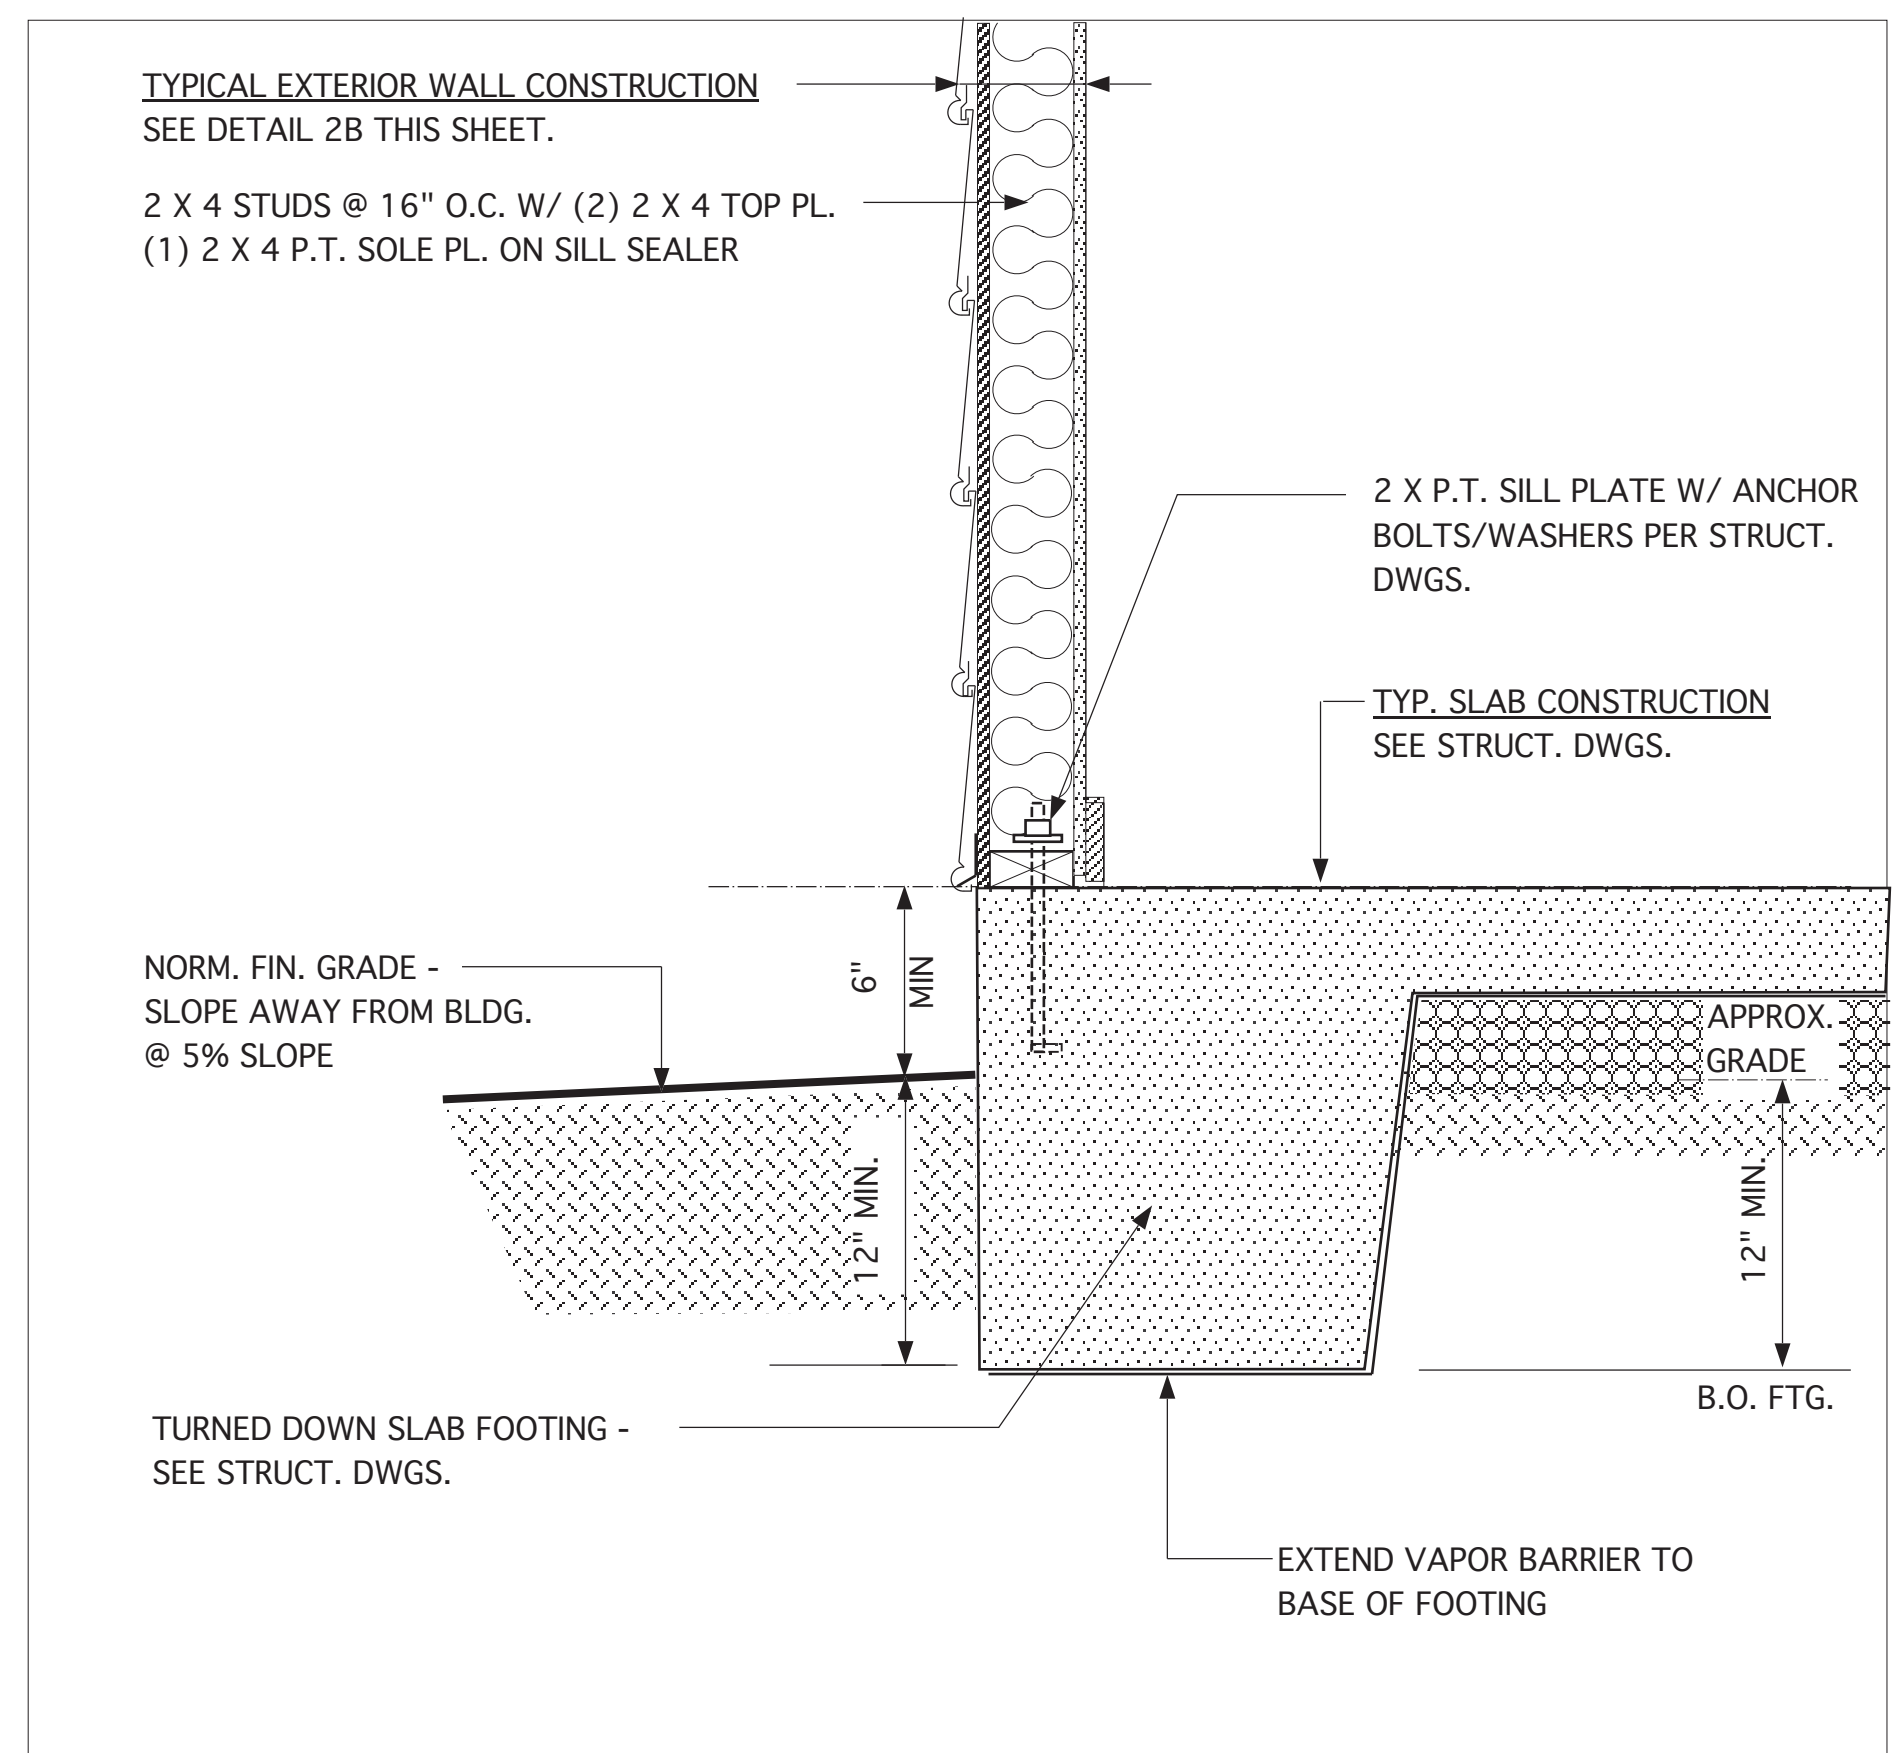

1A FOUND. DETAIL @ EXTERIOR WALL

**JAMES WENTLING/  
ARCHITECT**

LAND TITLE BUILDING  
100 SOUTH BROAD STREET,  
SUITE 1524  
PHILADELPHIA, PA 19110

(215) 568-2551  
email: information@  
wentlinghouseplans.com

ARCHITECTURE  
LAND PLANNING  
GRAPHICS

THESE PLANS ARE COPYRIGHTED AND ARE SUBJECT TO COPYRIGHT PROTECTION AS AN "ARCHITECTURAL WORK" UNDER SECTION 102 OF THE COPYRIGHT ACT, 17 U.S.C. AS AMENDED DECEMBER 1, 1990 AND KNOWN AS THE "ARCHITECTURAL WORKS COPYRIGHT PROTECTION ACT OF 1990". THE PROTECTION INCLUDES BUT IS NOT LIMITED TO, THE OVERALL FORM AS WELL AS THE ARRANGEMENT AND COMPOSITION OF SPACES AND ELEMENTS OF THE DESIGN. UNDER SUCH PROTECTION, UNAUTHORIZED USE OF THESE PLANS, WORKS, OR FORMS REPRESENTED CAN LEGALLY RESULT IN THE CESSATION OF SUCH CONSTRUCTION OR BUILDINGS BEING SEIZED AND/OR RAISED.

© Copyright 2016 James Wentling/ Architect



REVISIONS

MARK	DATE	DESCRIPTION
DN	01-10-19	CONVERT OLAHS
DN	02-14-19	STRUCT. DWGS. REV.
CH	05-18-20	MINOR UPDATE
DN	04-04-24	CONVERT 113-69/ADD OPT. BATH #2 LM

PROJECT NO.	113-88
DATE	01-13-16
SCALE	1-1/2" = 1'-0"
DRAWN BY	DN
CHECKED BY	JW
ISSUED FOR	PERMITS/CONSTRUCTION

PROJECT TITLE  
**MODEL 628 -  
GARAGE LEFT**


CLIENT  
**CHESAPEAKE  
HOMES OF NC**  
3100 Smoketree Court,  
Suite 210  
Raleigh, NC 27604  
(919) 256-3060  
(919) 556-0690 Fax

DRAWING TITLE  
**MONOLITHIC SLAB  
FOUNDATION, WALL  
AND SOFFIT DETAILS**

SHEET

6



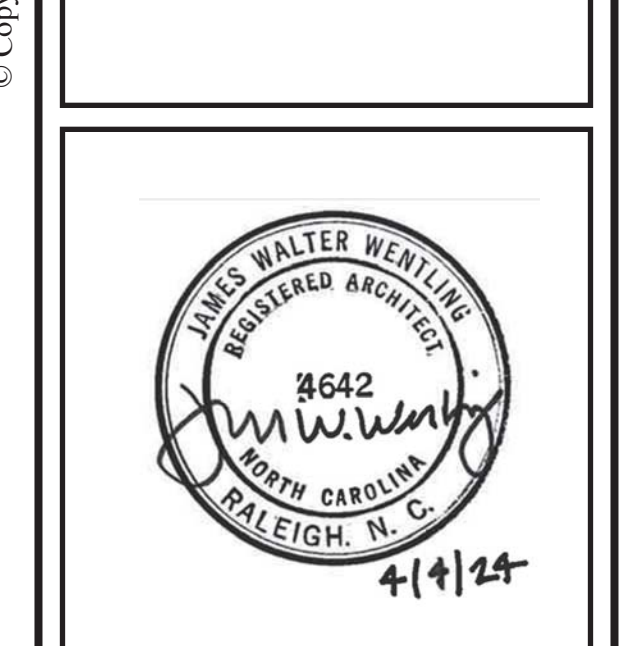


REVISIONS

MARK	DATE	DESCRIPTION
DN	01-10-19	CONVERT OLASH
DN	02-14-19	STRUCT. DWGS. REV.
CH	05-18-20	MINOR UPDATE
DN	04-04-24	CONVERT 113-69/ADD OPT. BATH #2 LM


PROJECT NO. 113-88  
DATE 01-13-16  
SCALE 1-1/2" = 1'-0" U.N.O.  
DRAWN BY DN  
CHECKED BY JW  
ISSUED FOR PERMITS/CONSTRUCTION

PROJECT TITLE  
**MODEL 628 - GARAGE LEFT**  
  
CLIENT  
**CHESAPEAKE HOMES OF NC**  
3100 Smoketree Court,  
Suite 210  
Raleigh, NC 27604  
(919) 256-3060  
(919) 556-0690 Fax


DRAWING TITLE  
**MONOLITHIC SLAB FOUNDATION AND WALL DETAILS**

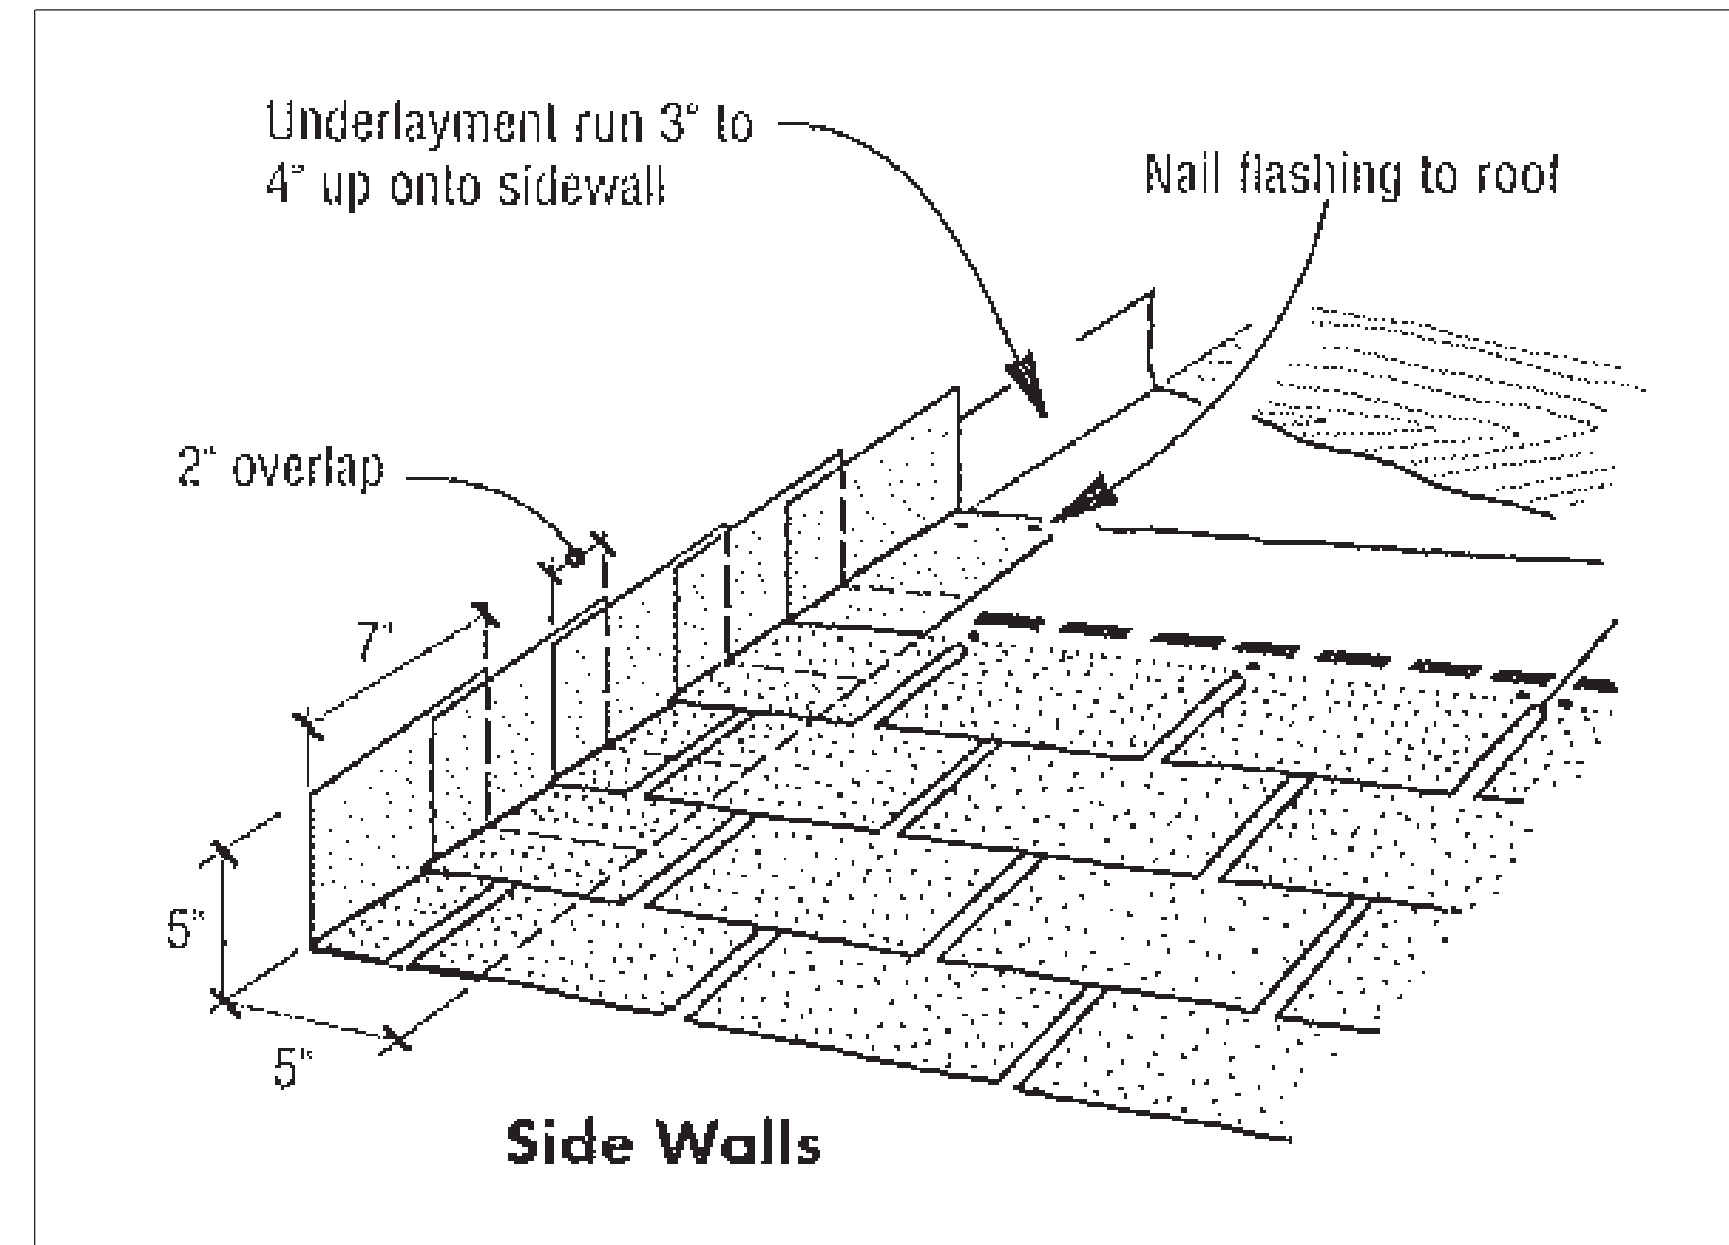


**3B** ROOF FLASHING AGAINST SIDE WALL DETAIL  
N.T.S.

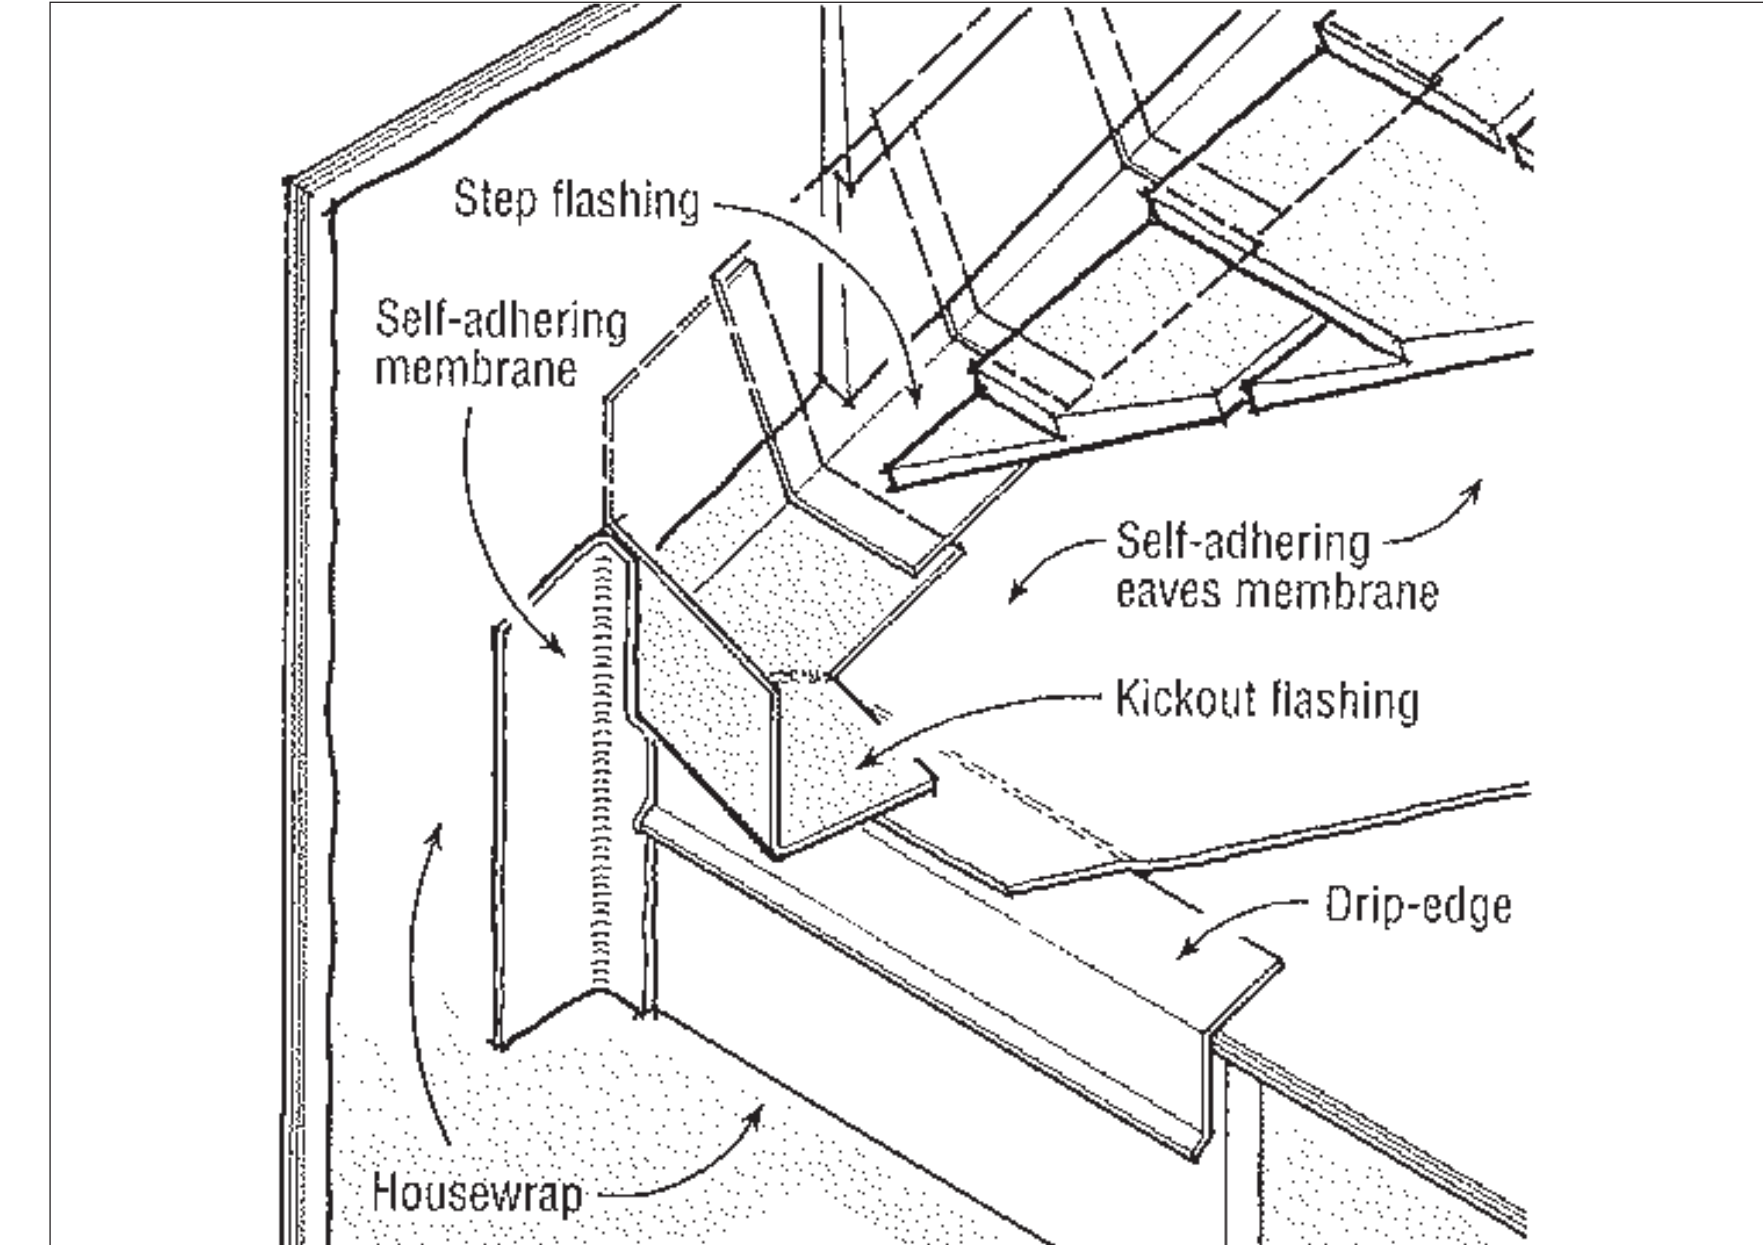


**2B** KICK-OUT FLASHING DETAIL AT ROOF FASCIA/WALL INTERSECTION  
N.T.S.

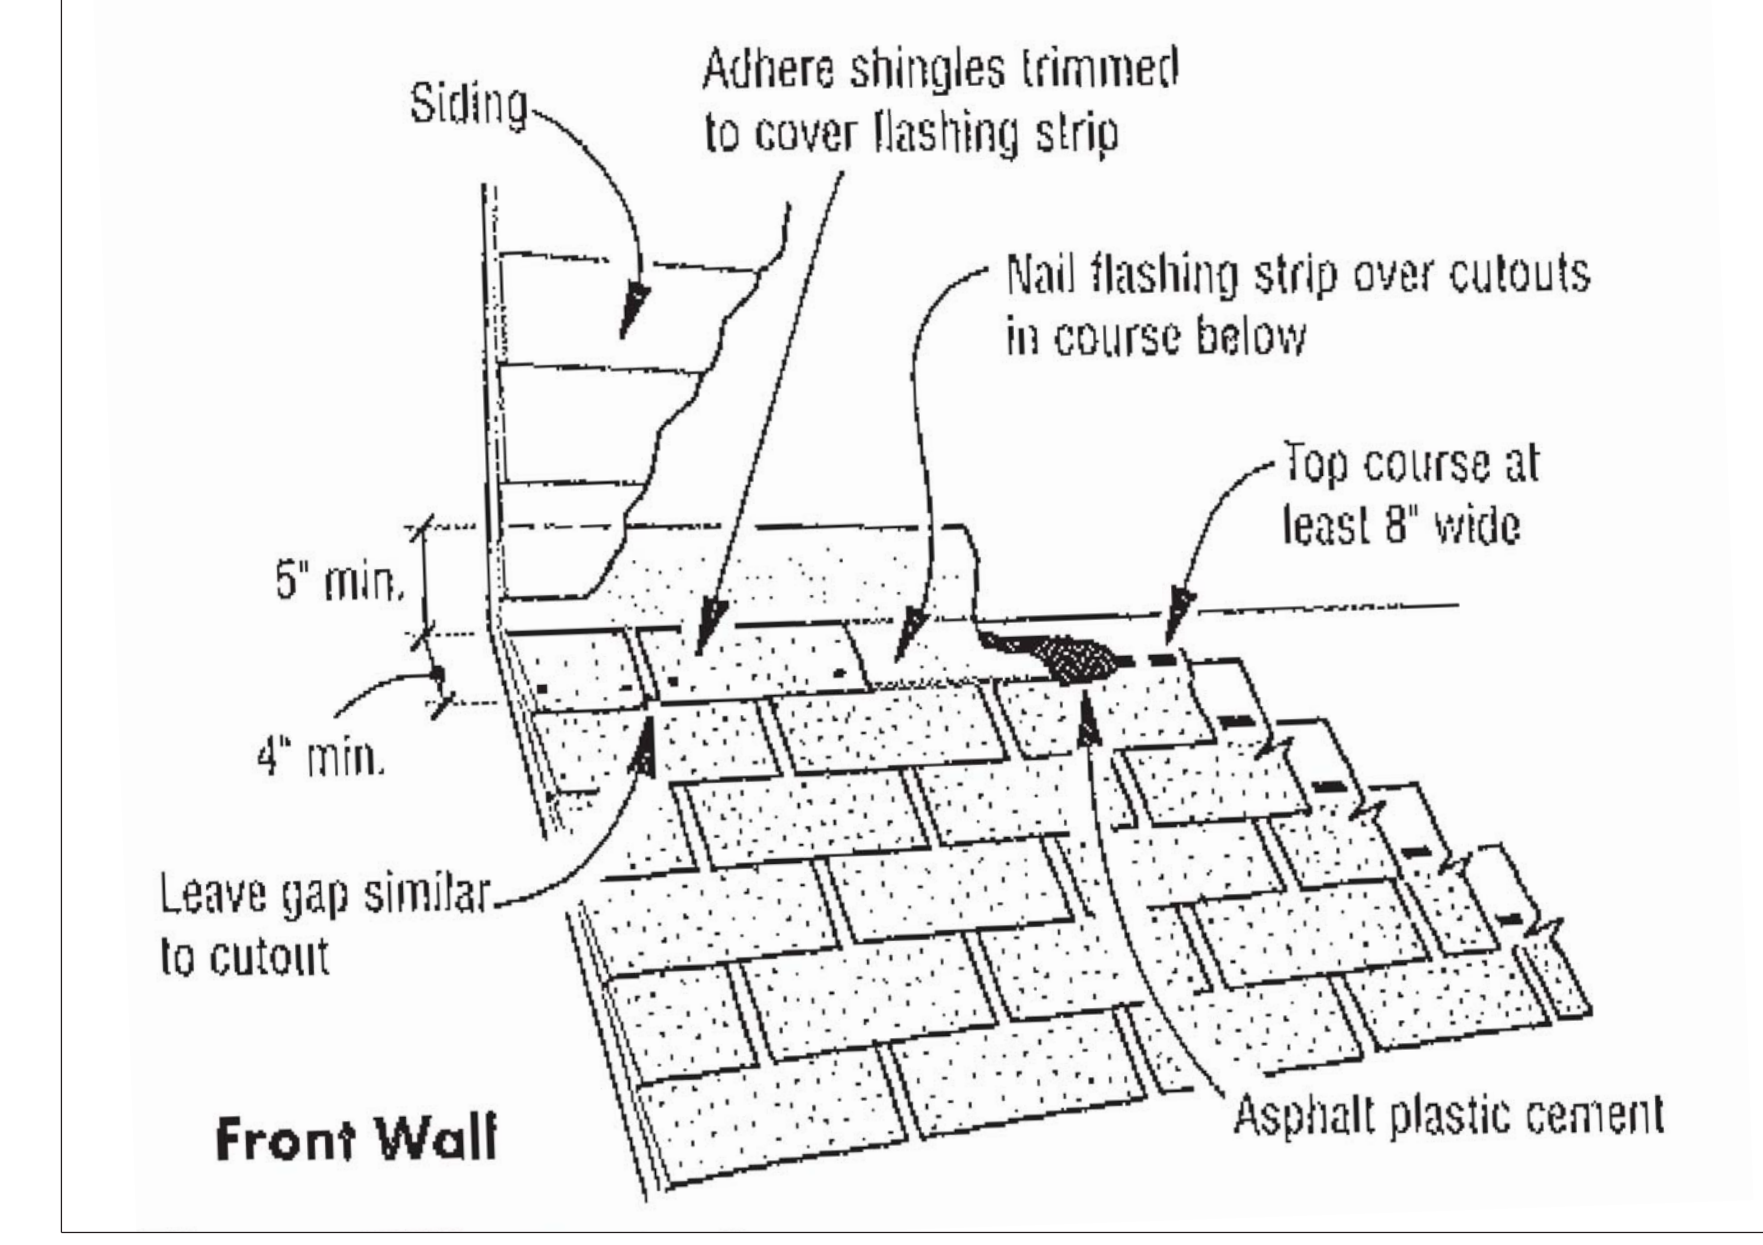


**1B** ROOF FLASHING AGAINST FRONT WALL DETAIL  
N.T.S.

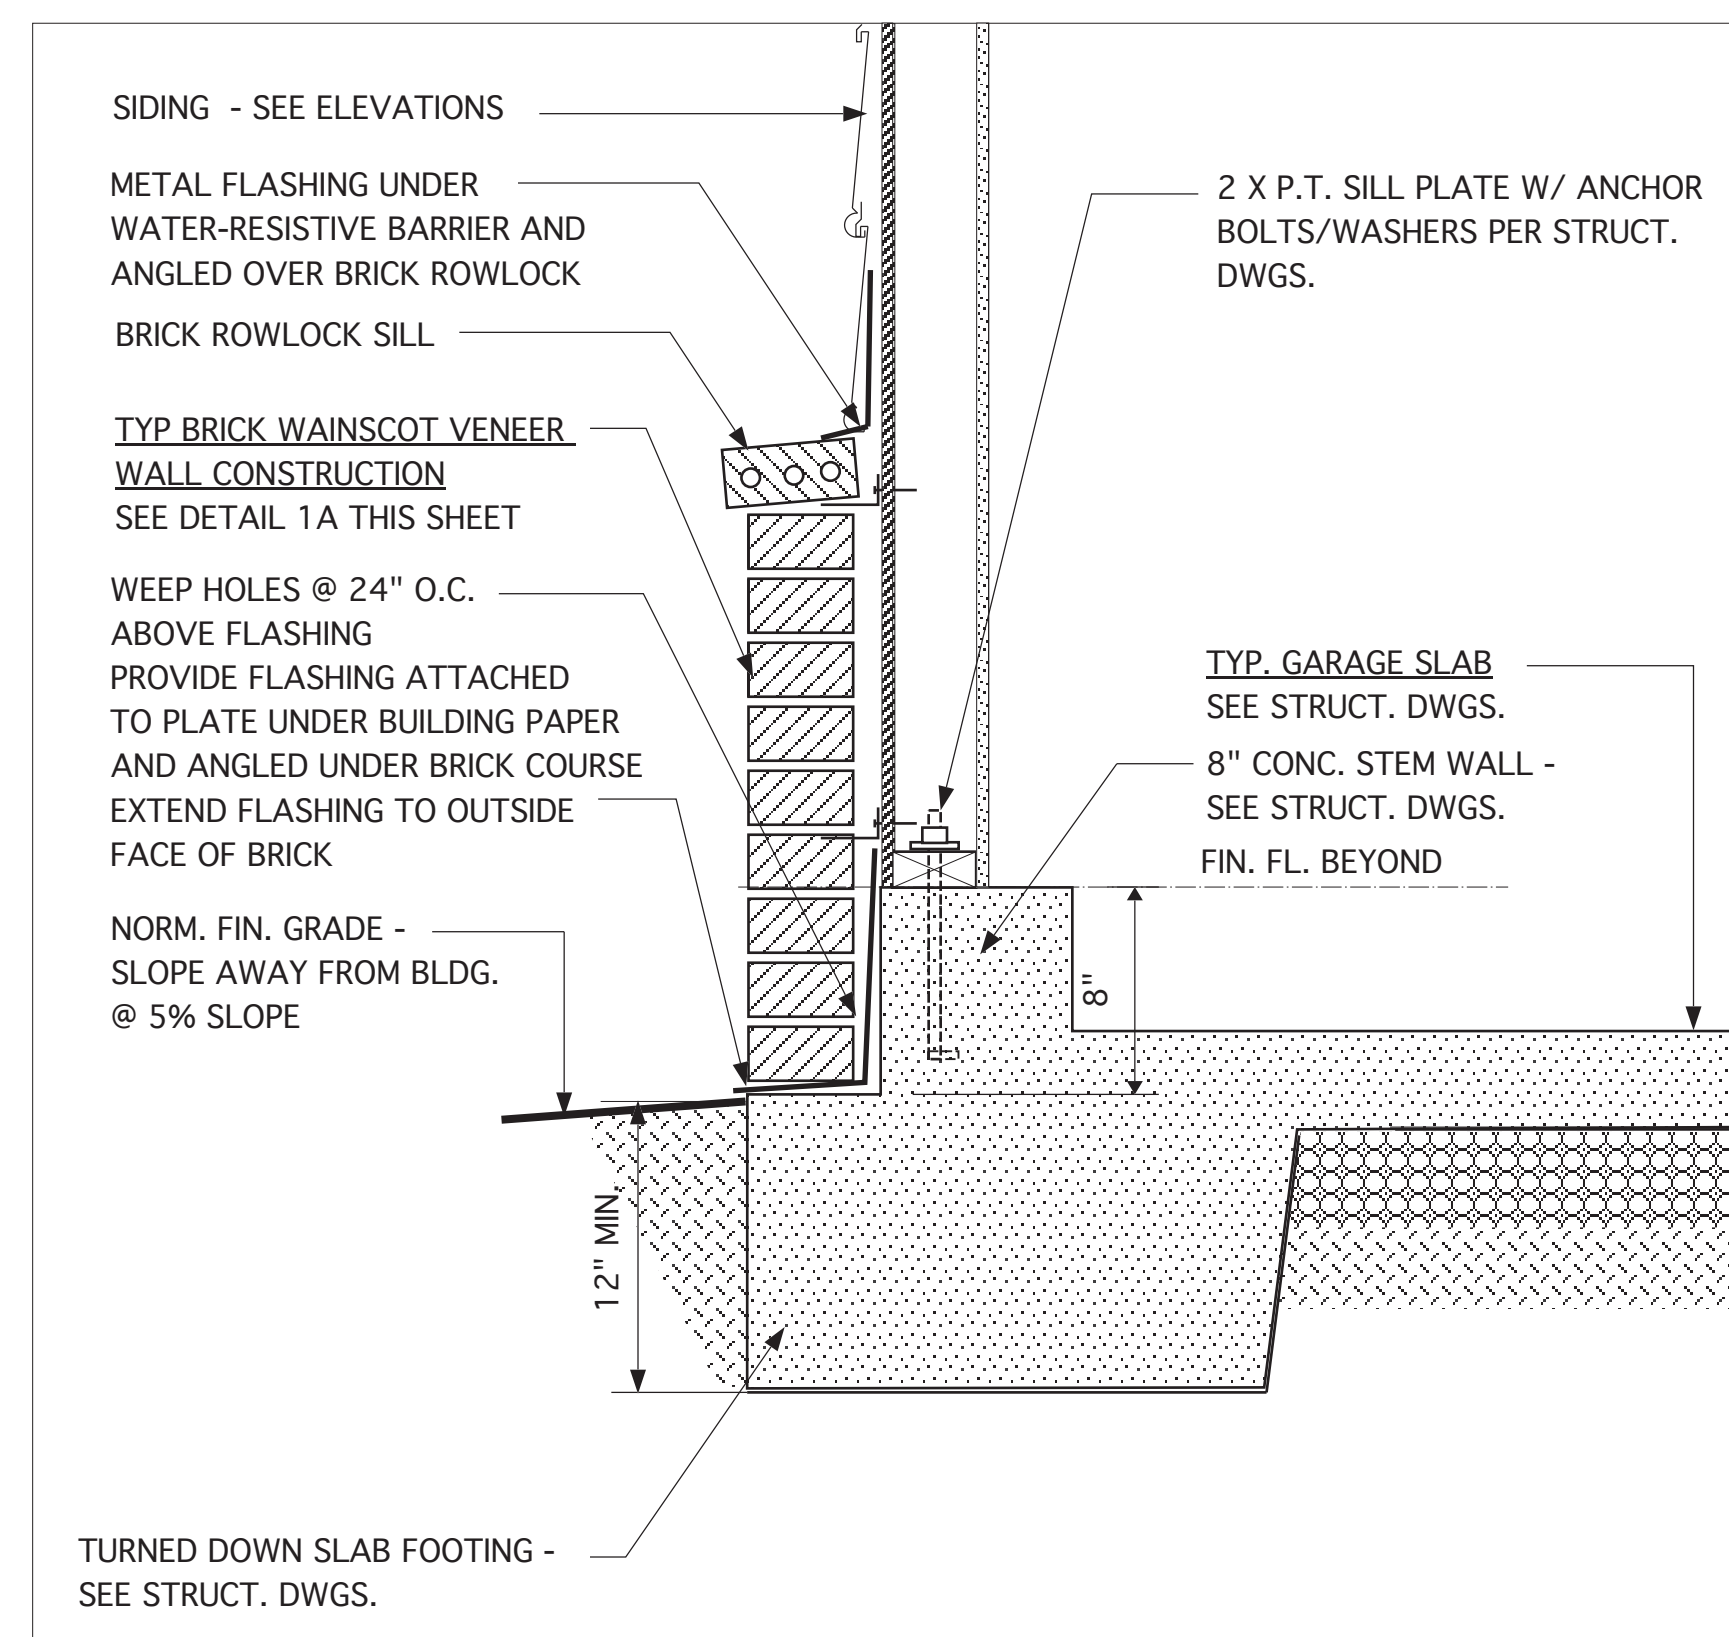

**3A** EXT. GARAGE FRONT WALL W/ BRICK WAINSCOT VENEER






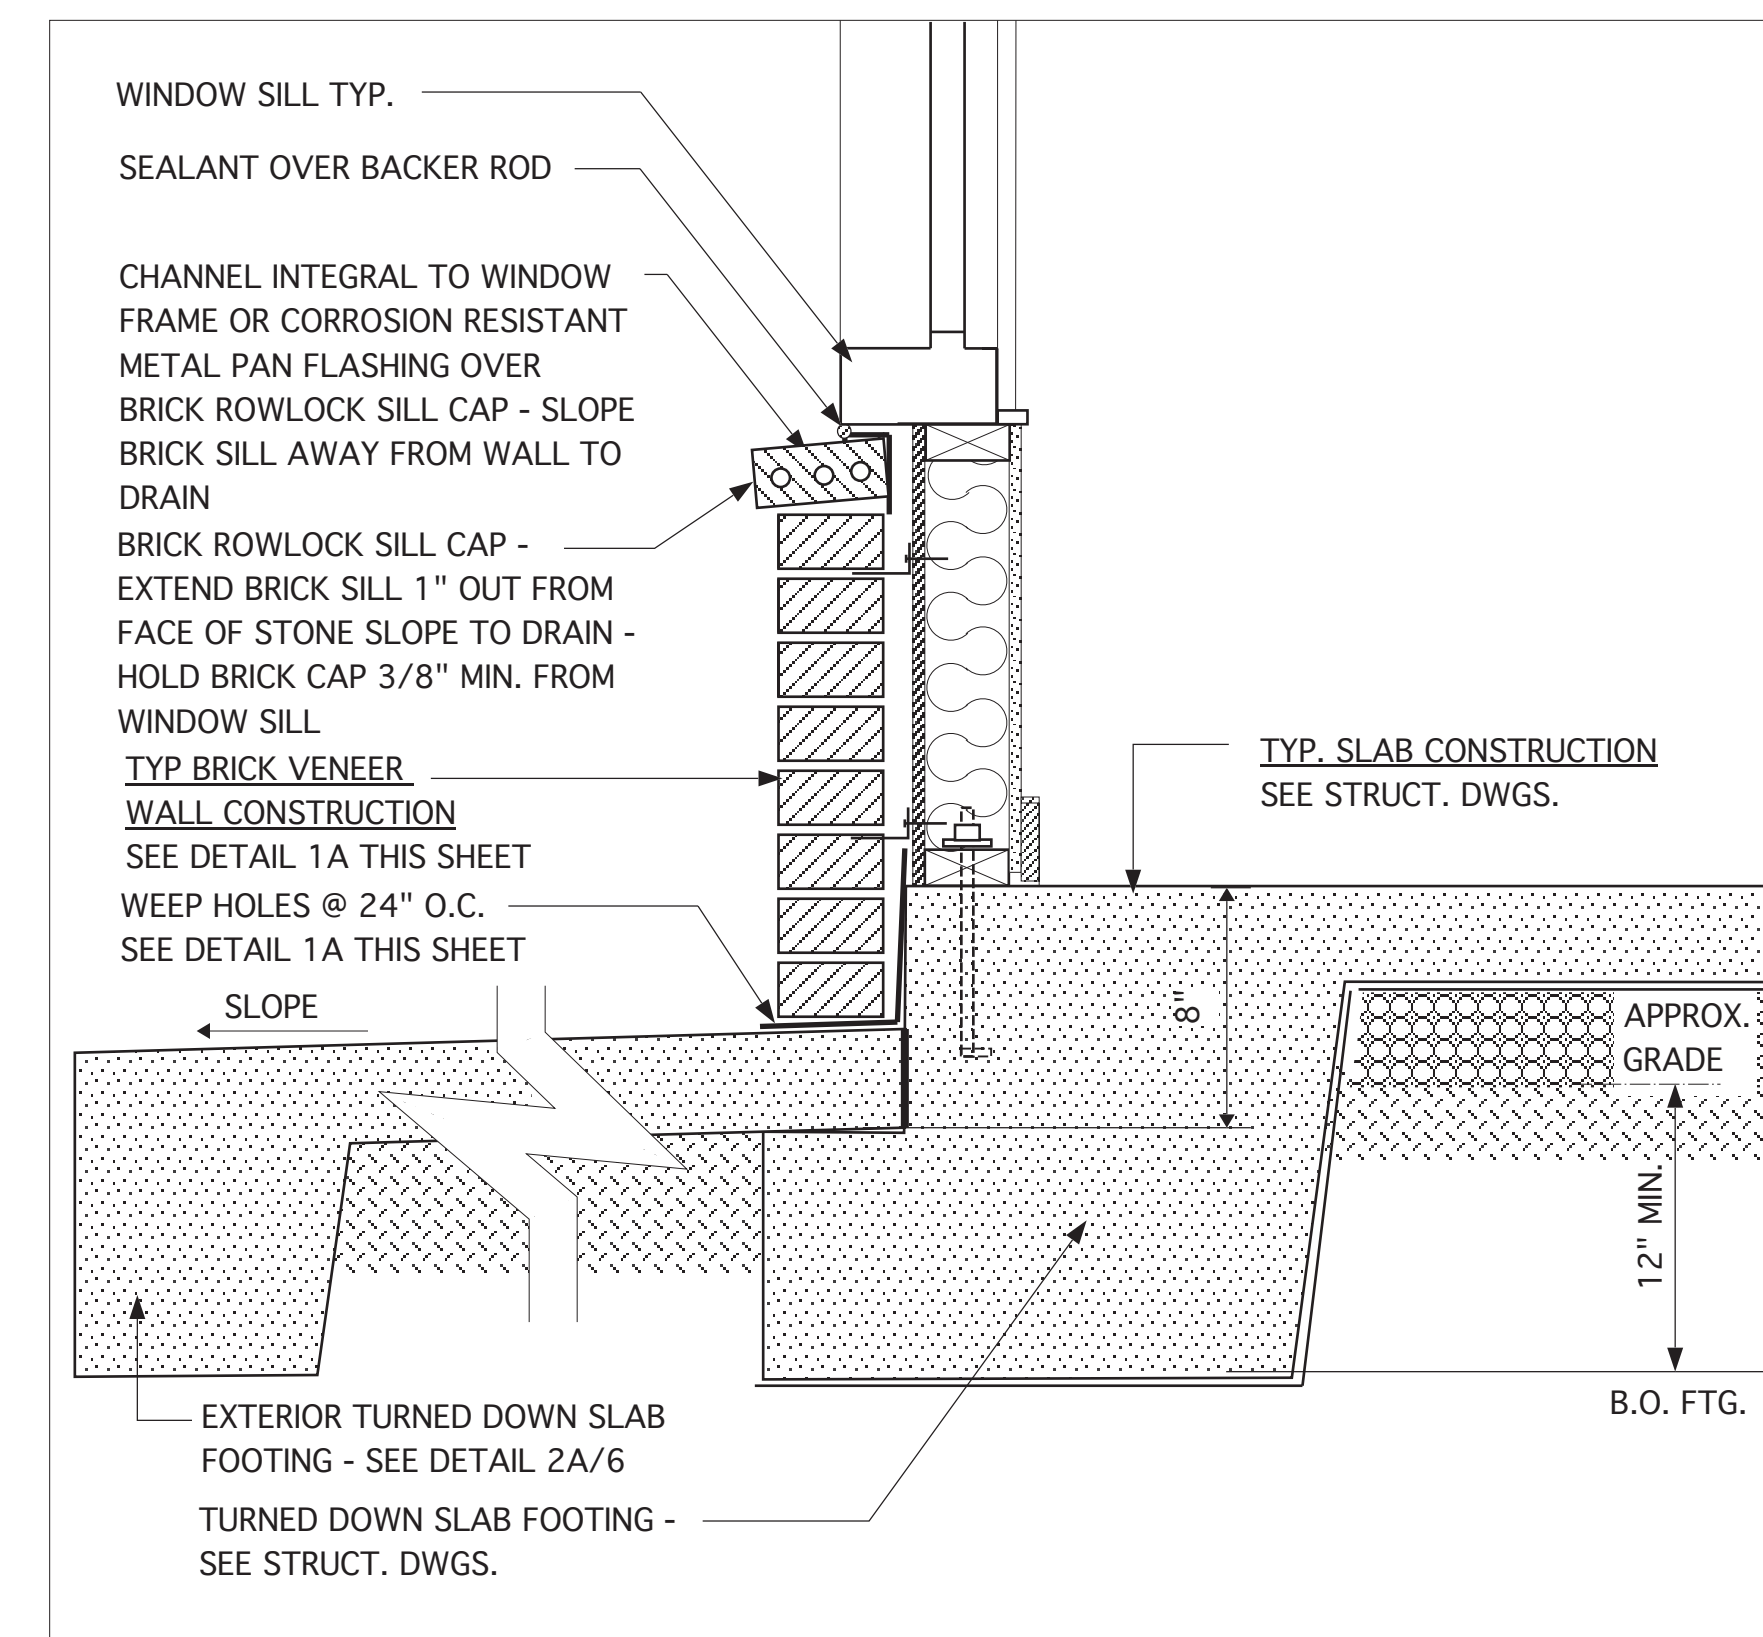


**2A** FOUND. DETAIL FRONT @ PORCH W/ BRICK WAINSCOT VENEER

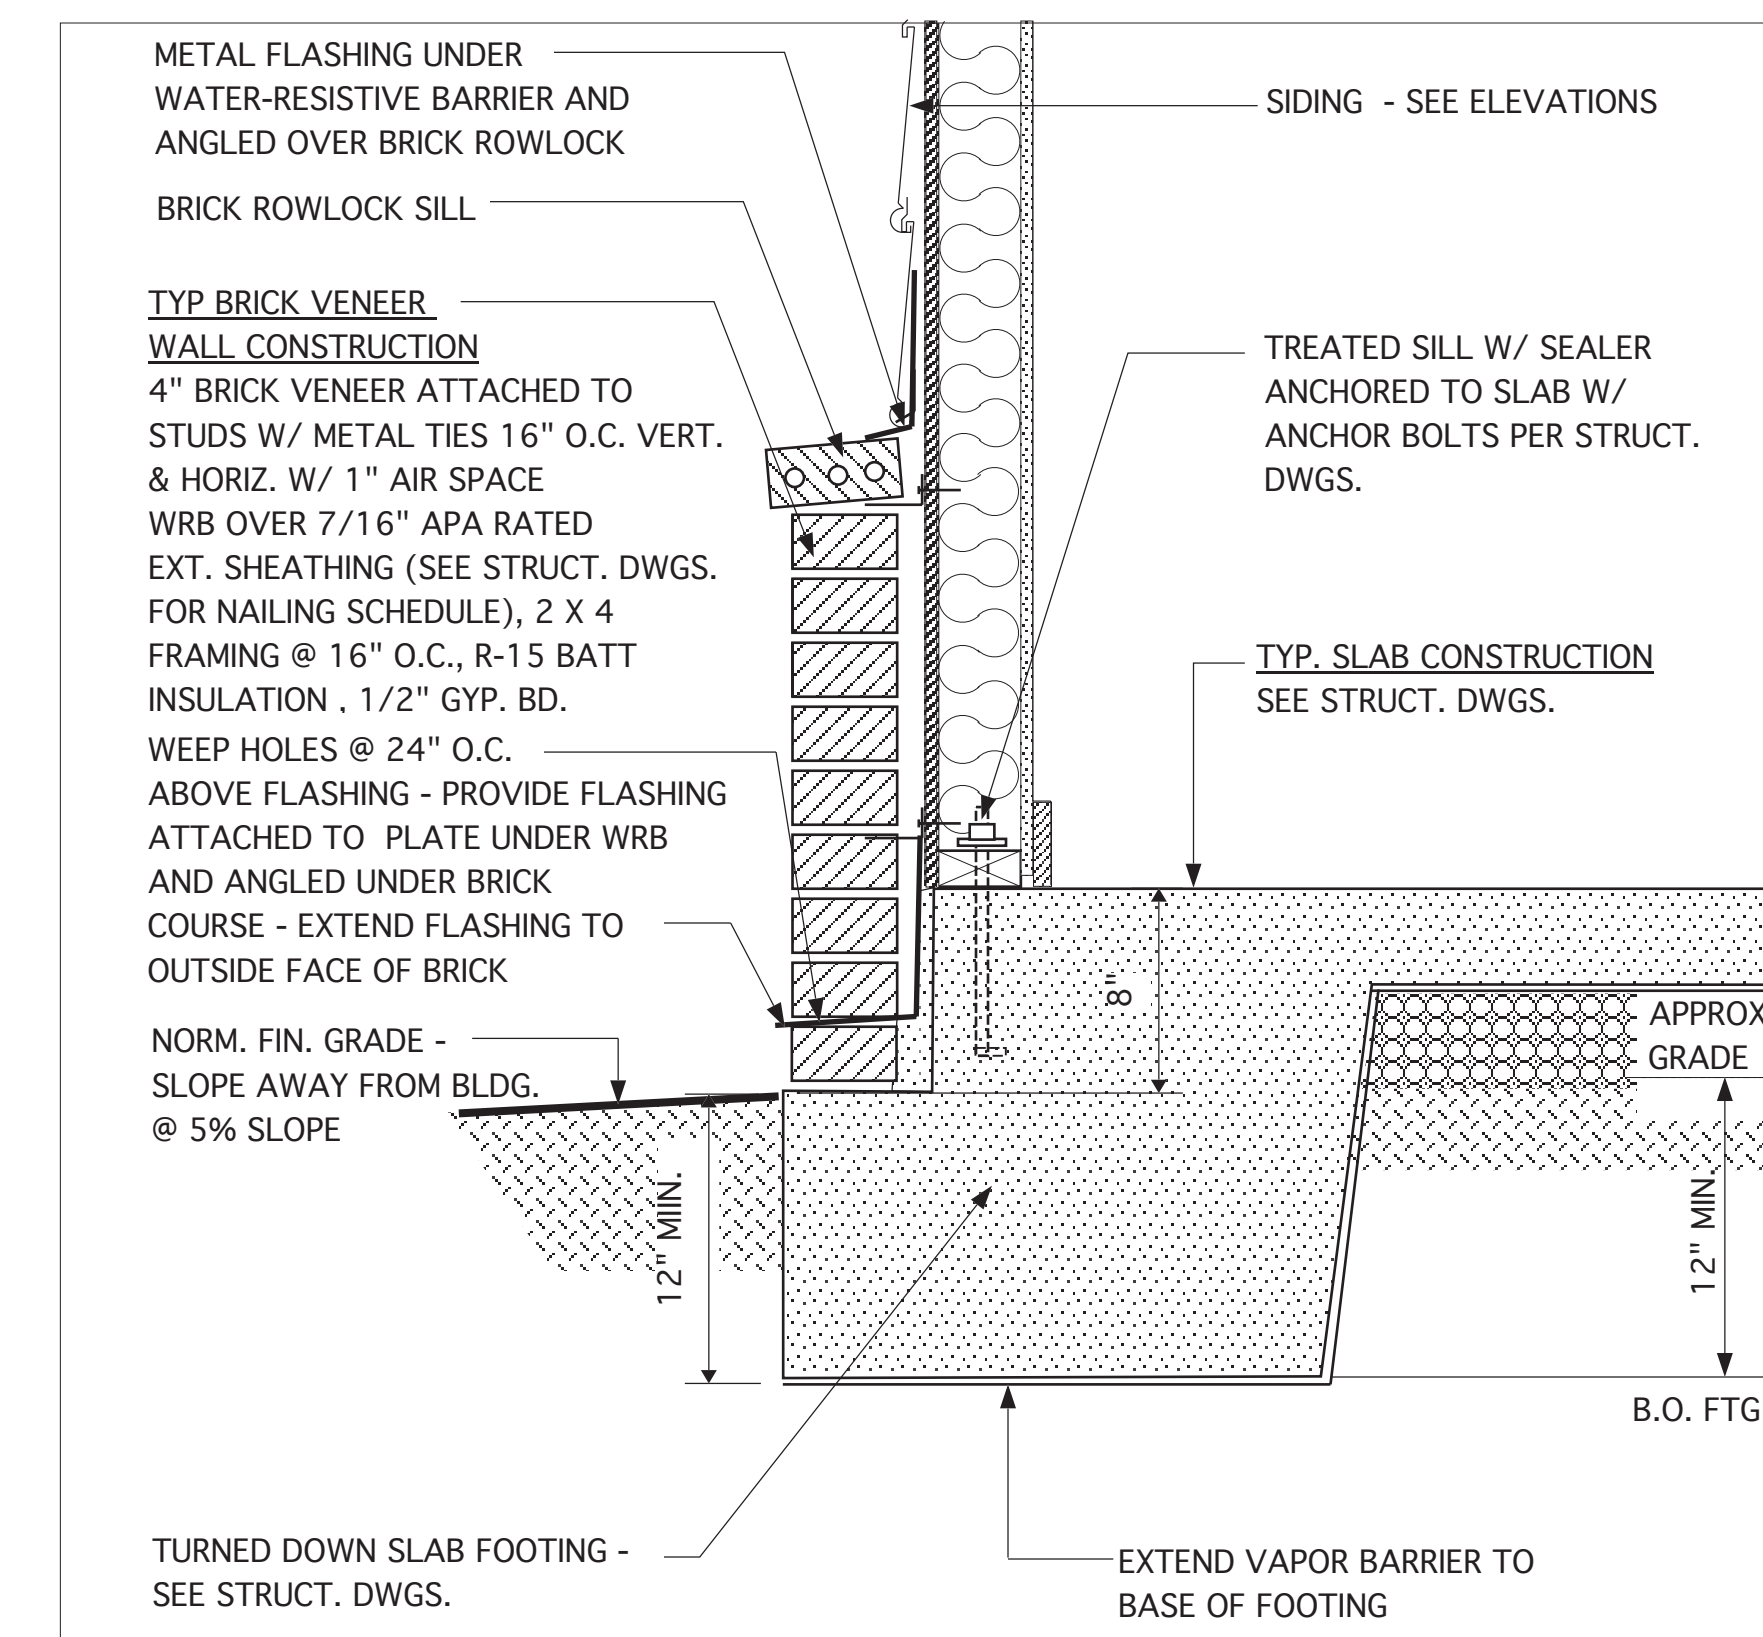

**1A** FOUND. DETAIL @ FRONT WALL W/ BRICK WAINSCOT VENEER



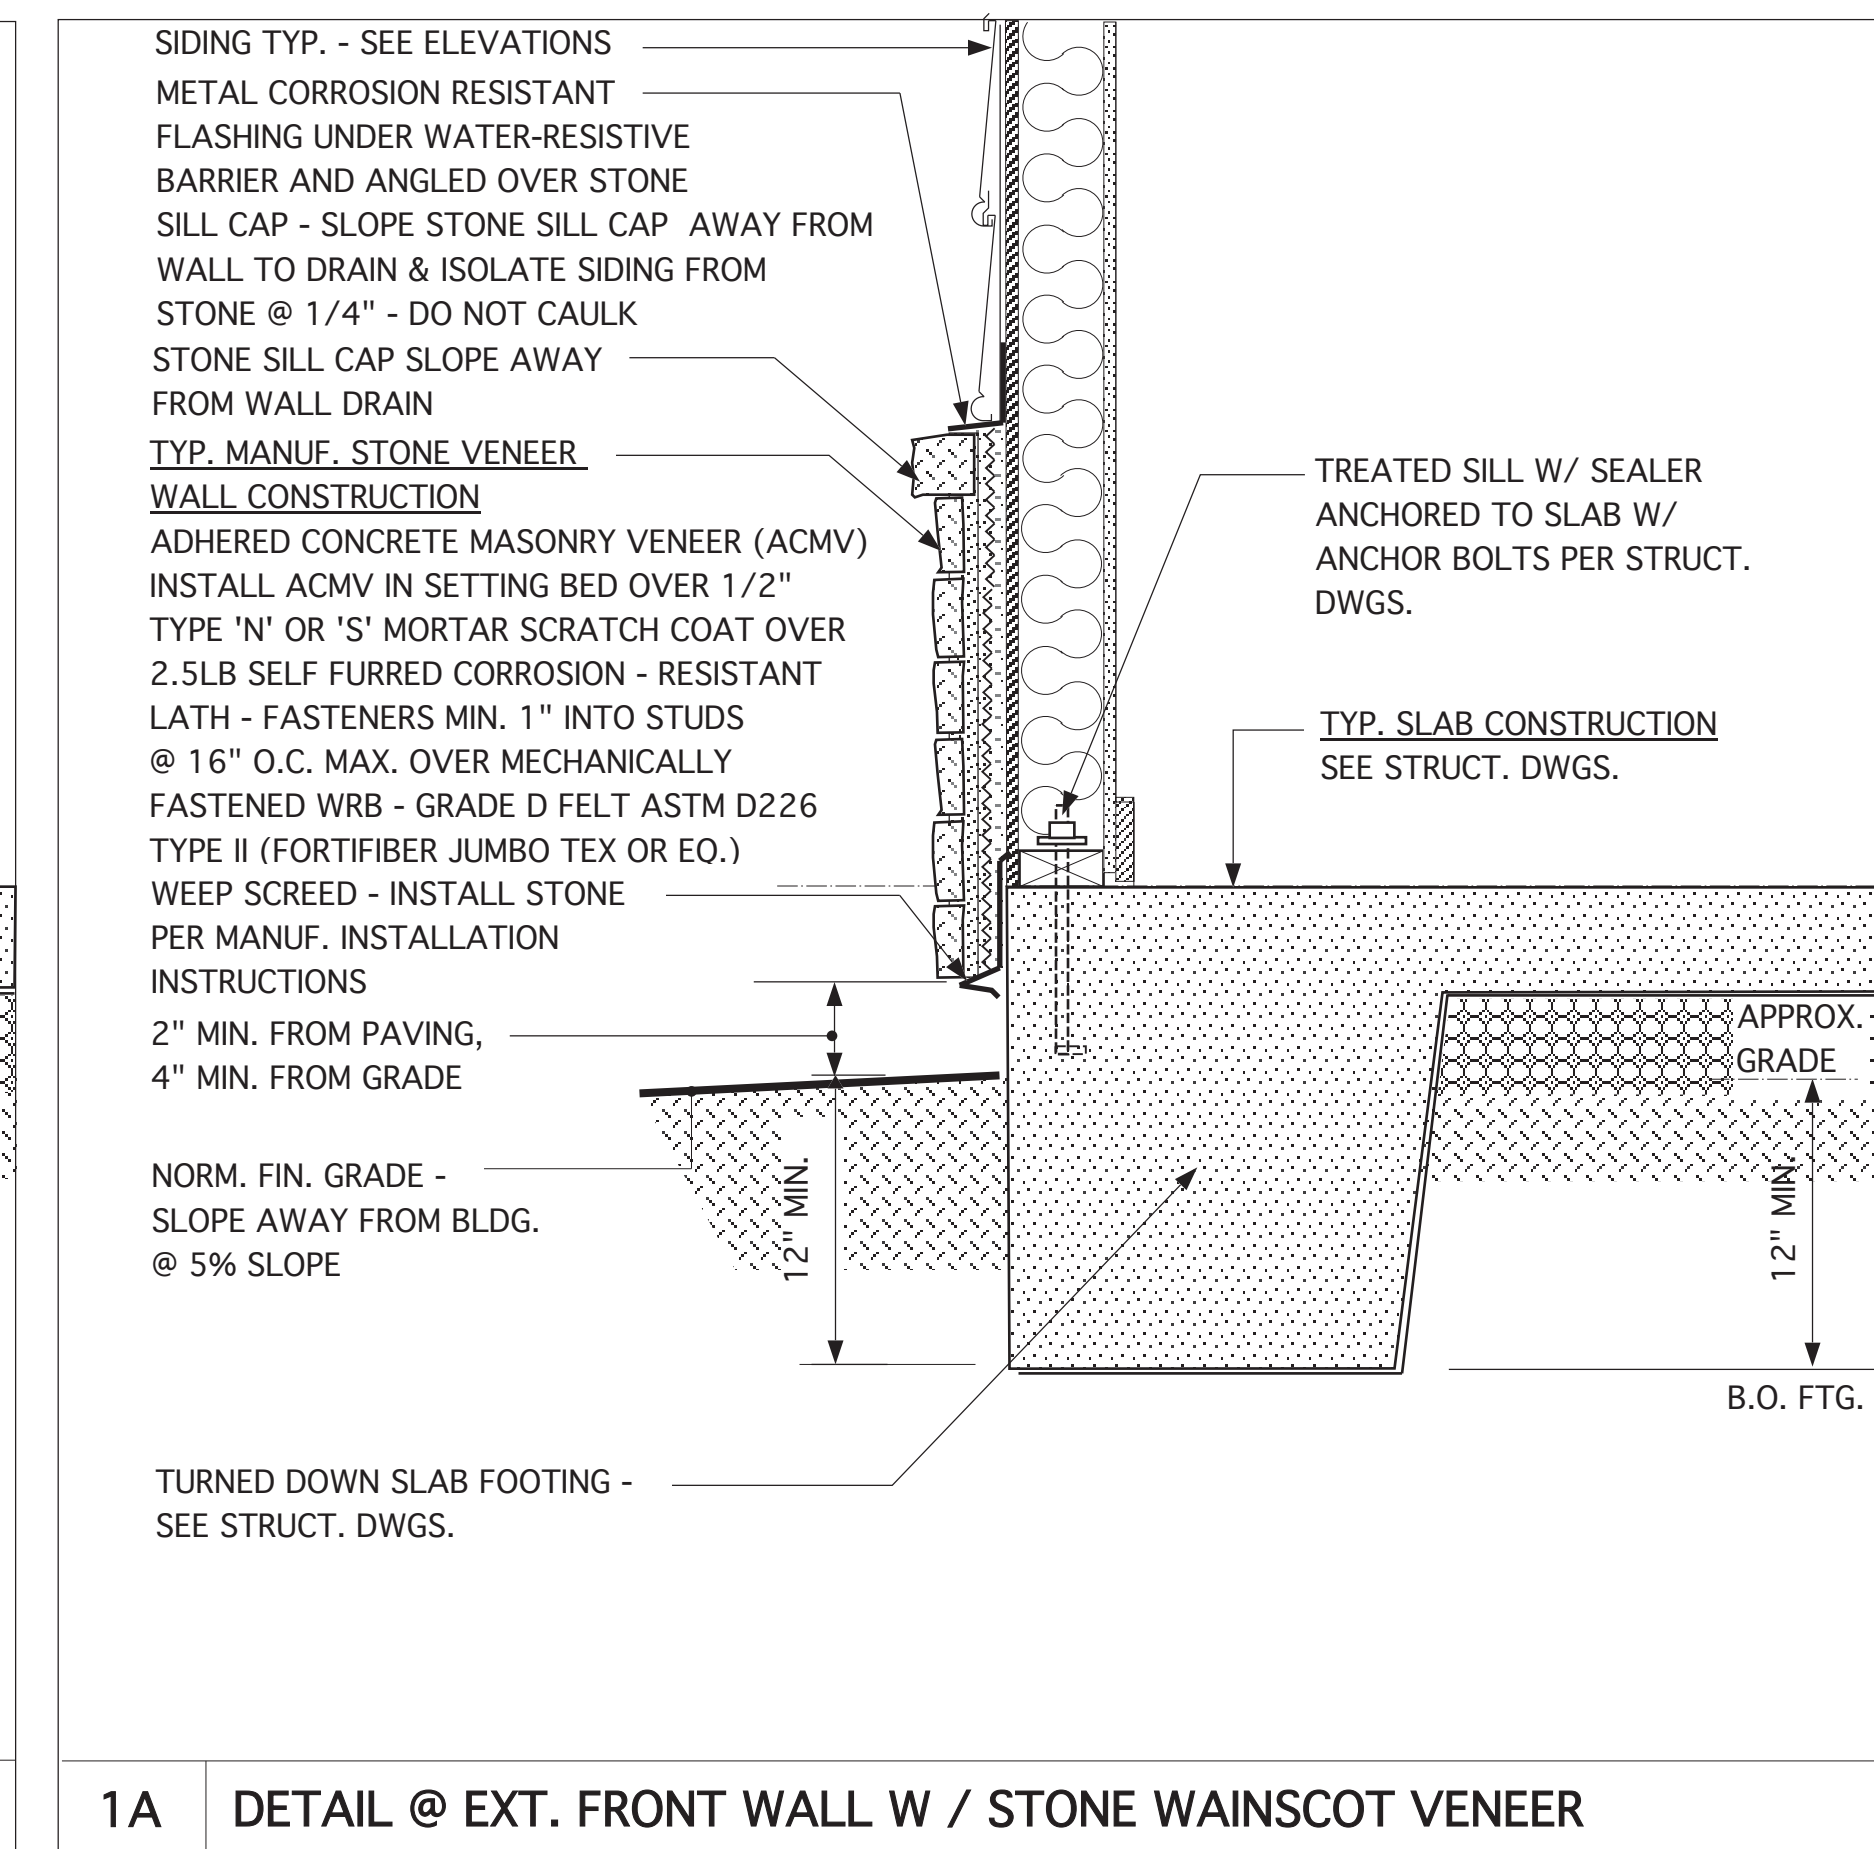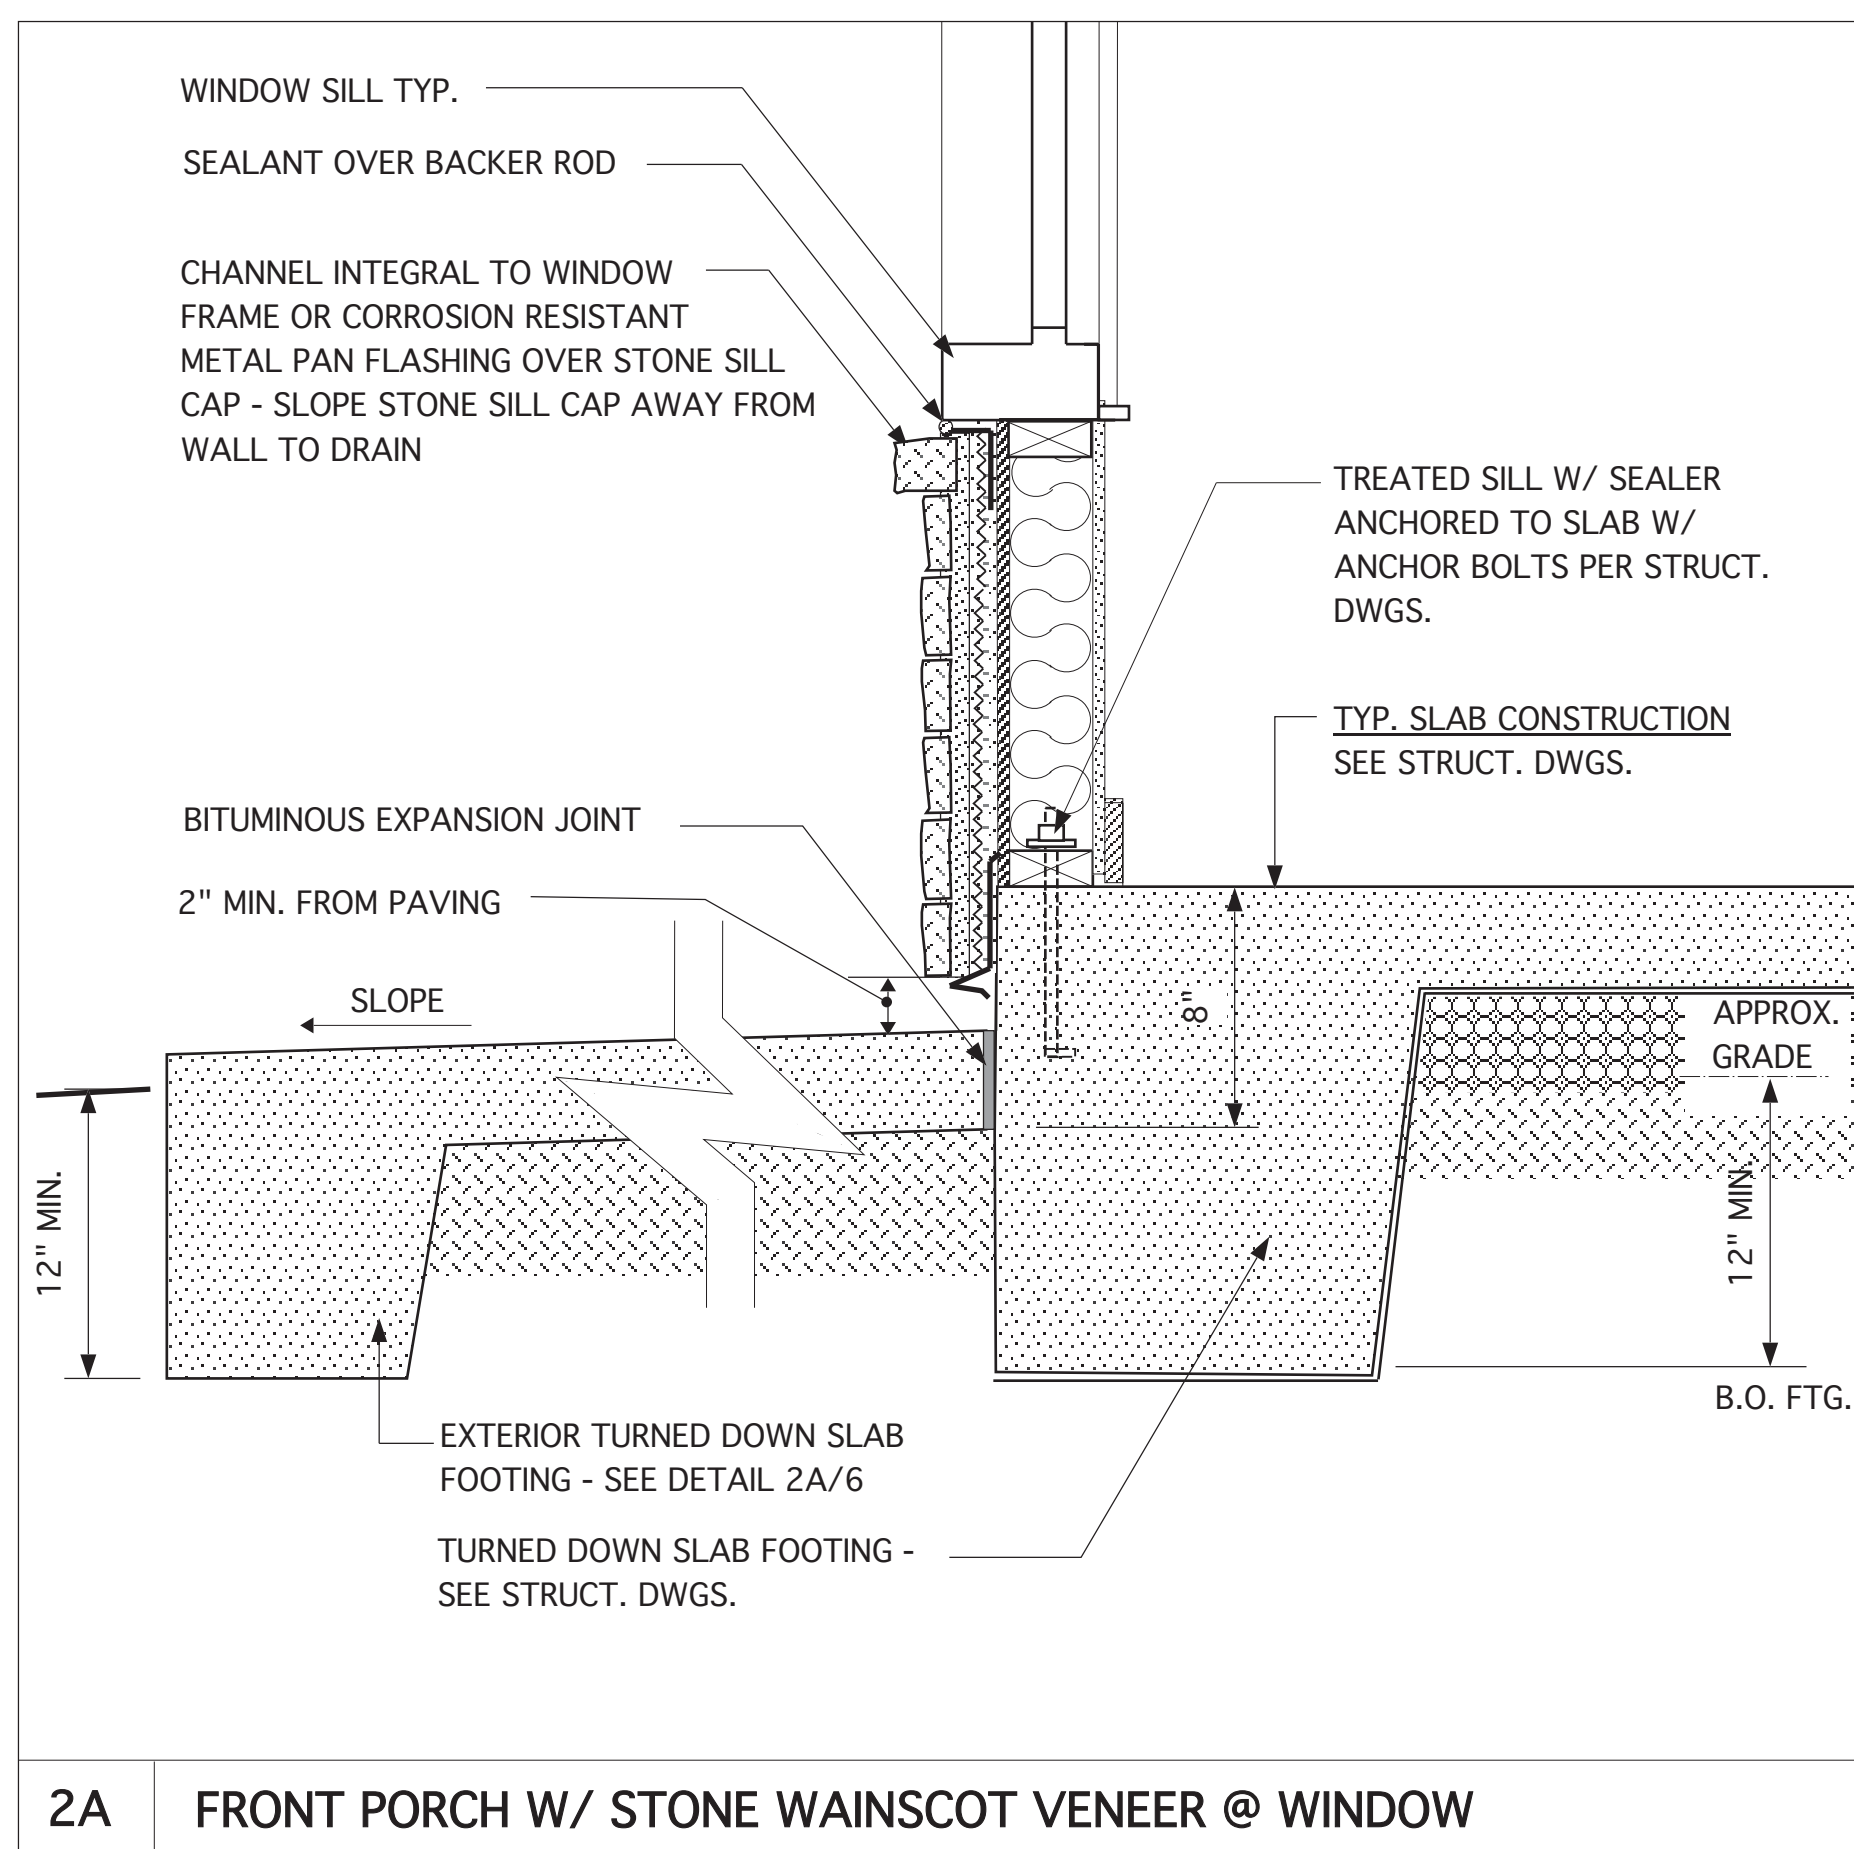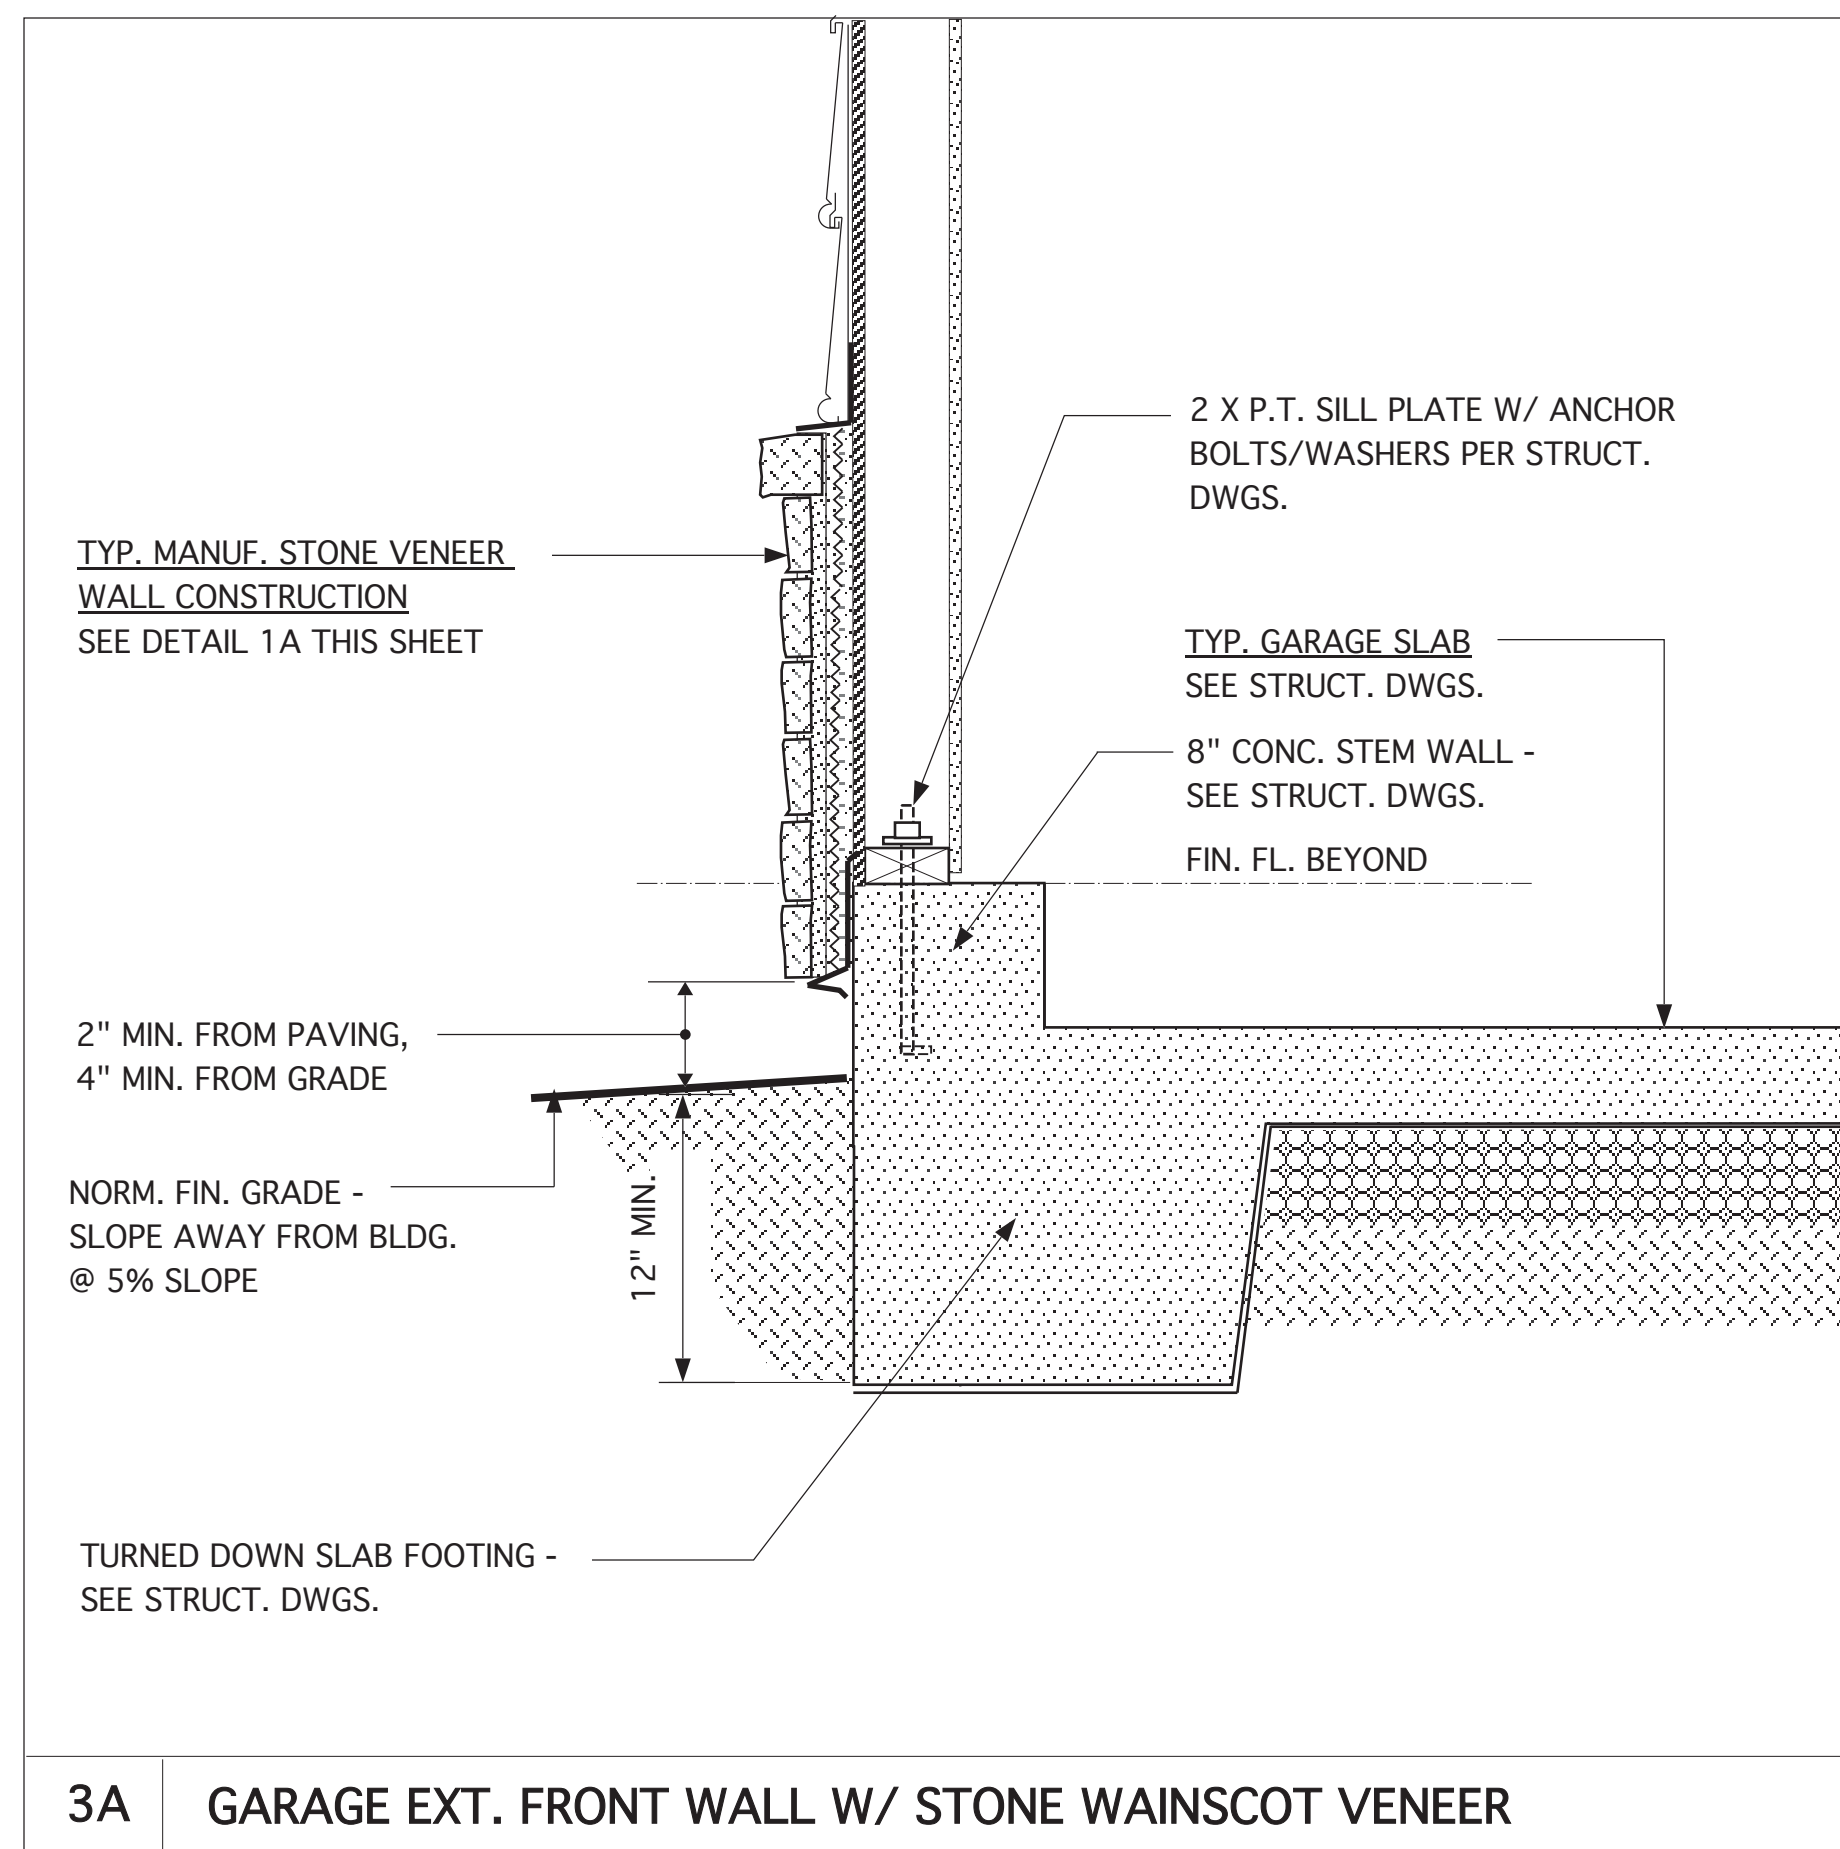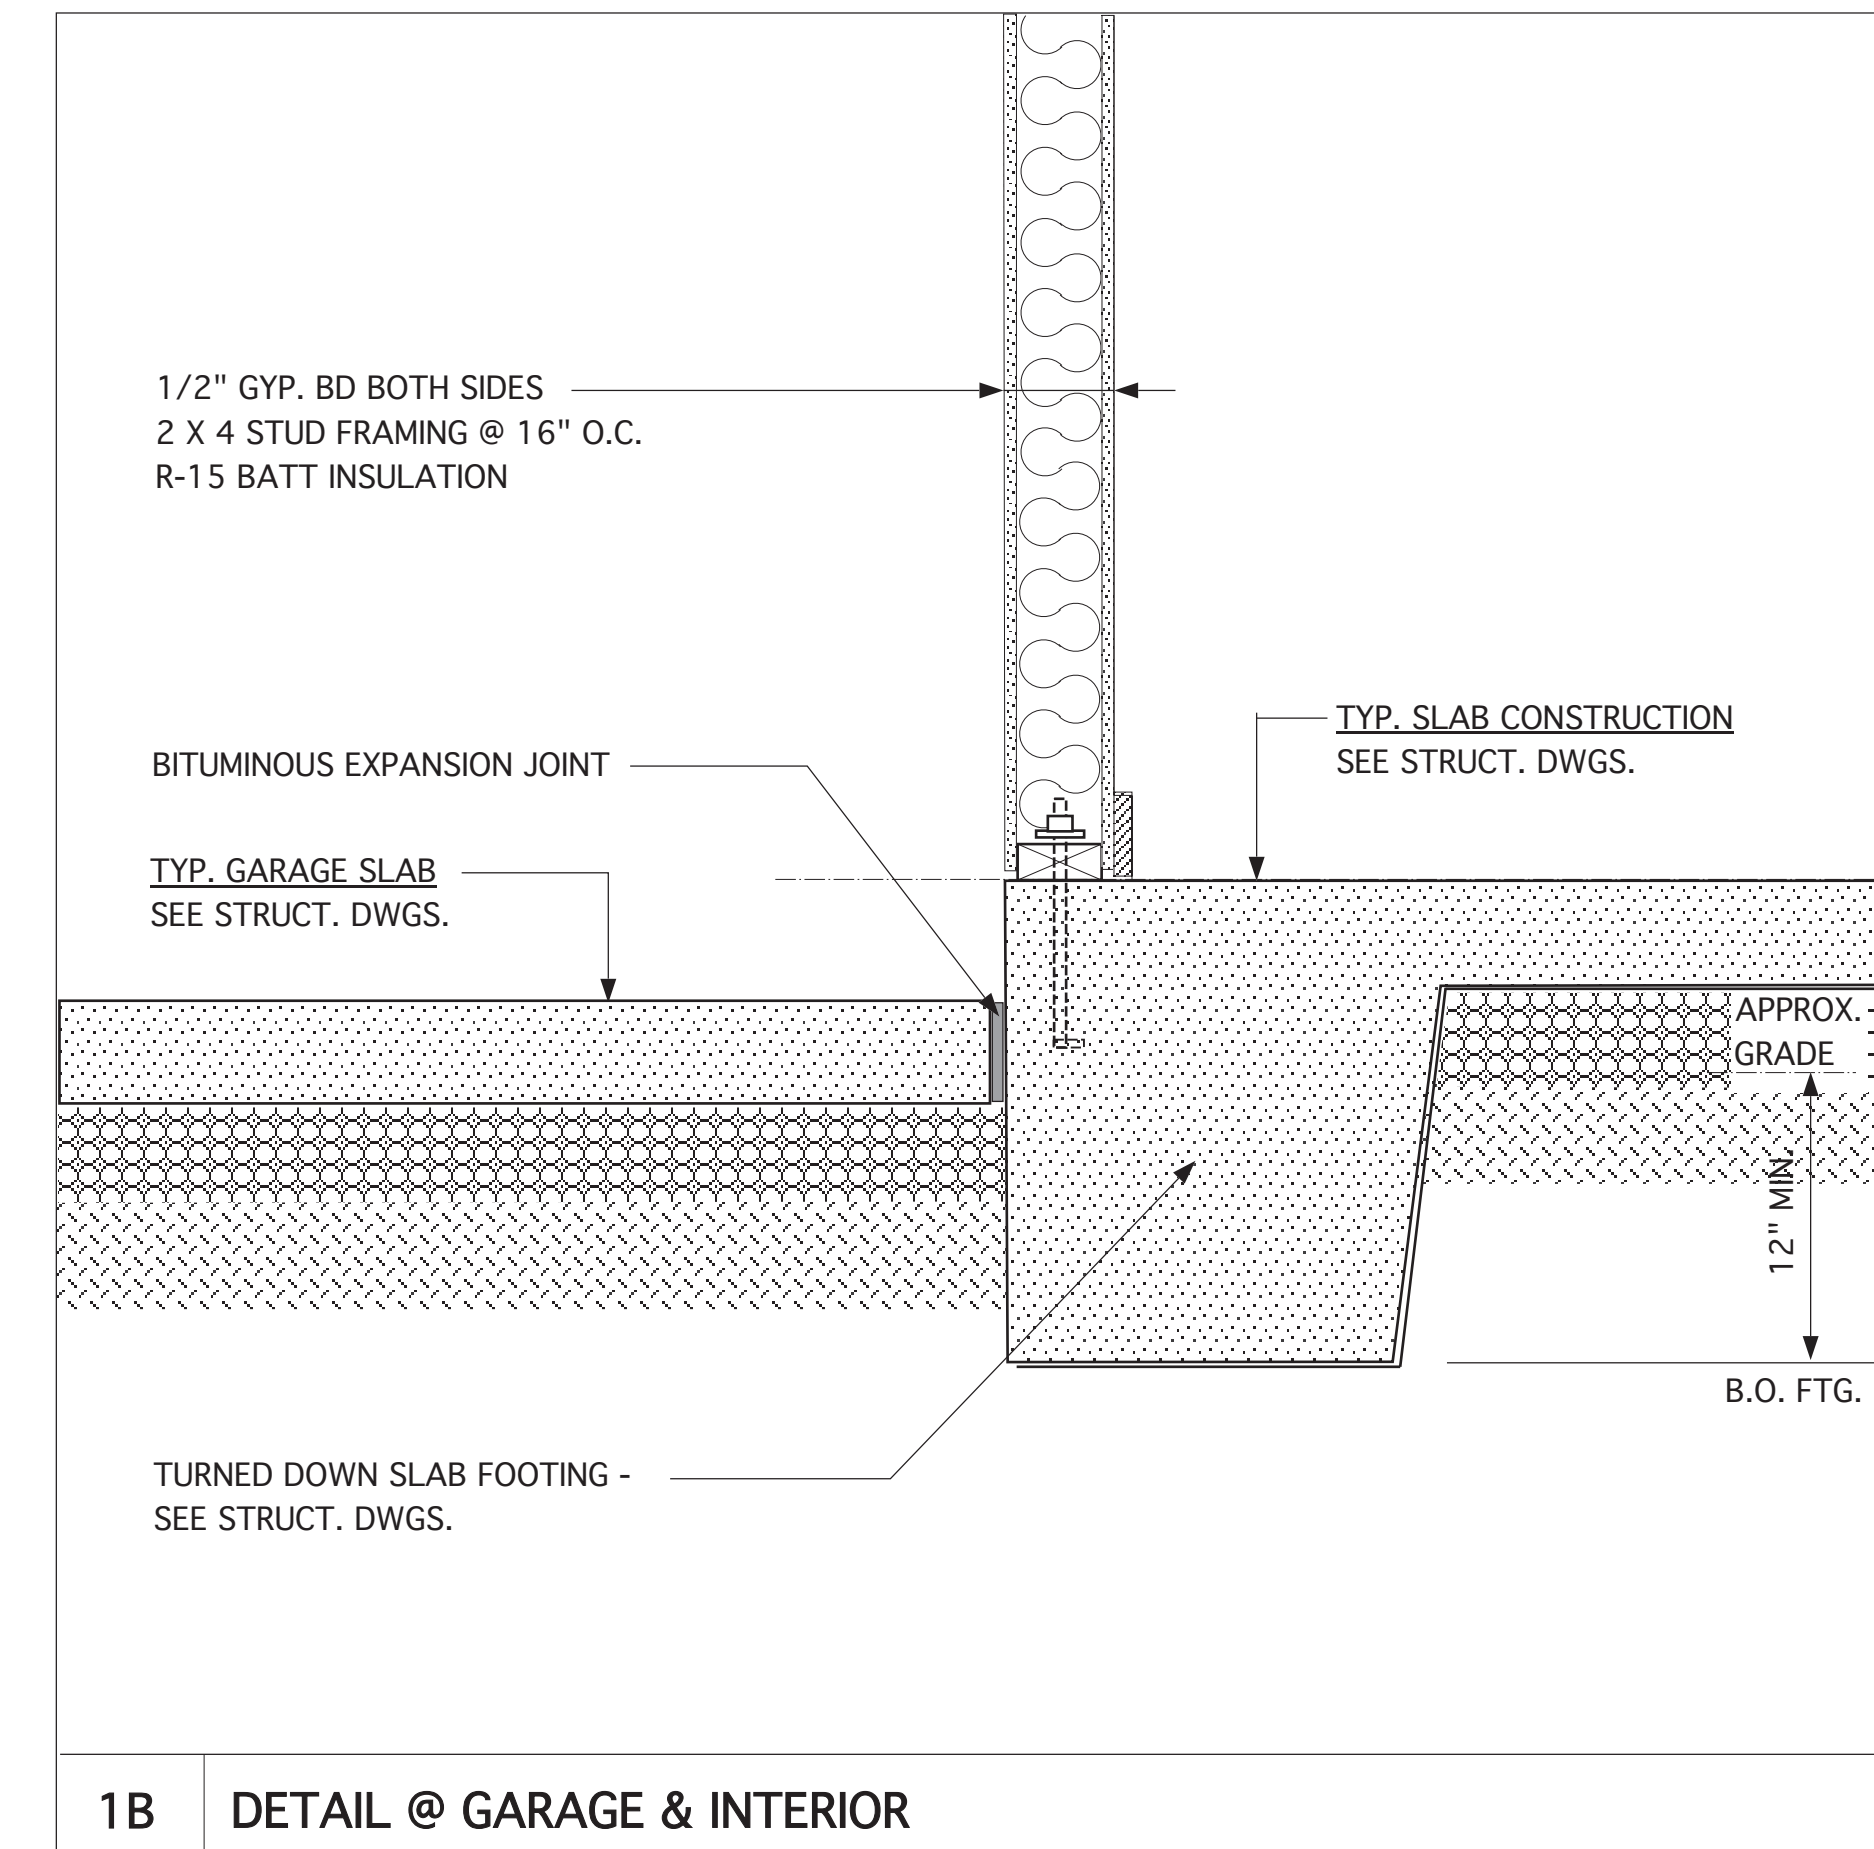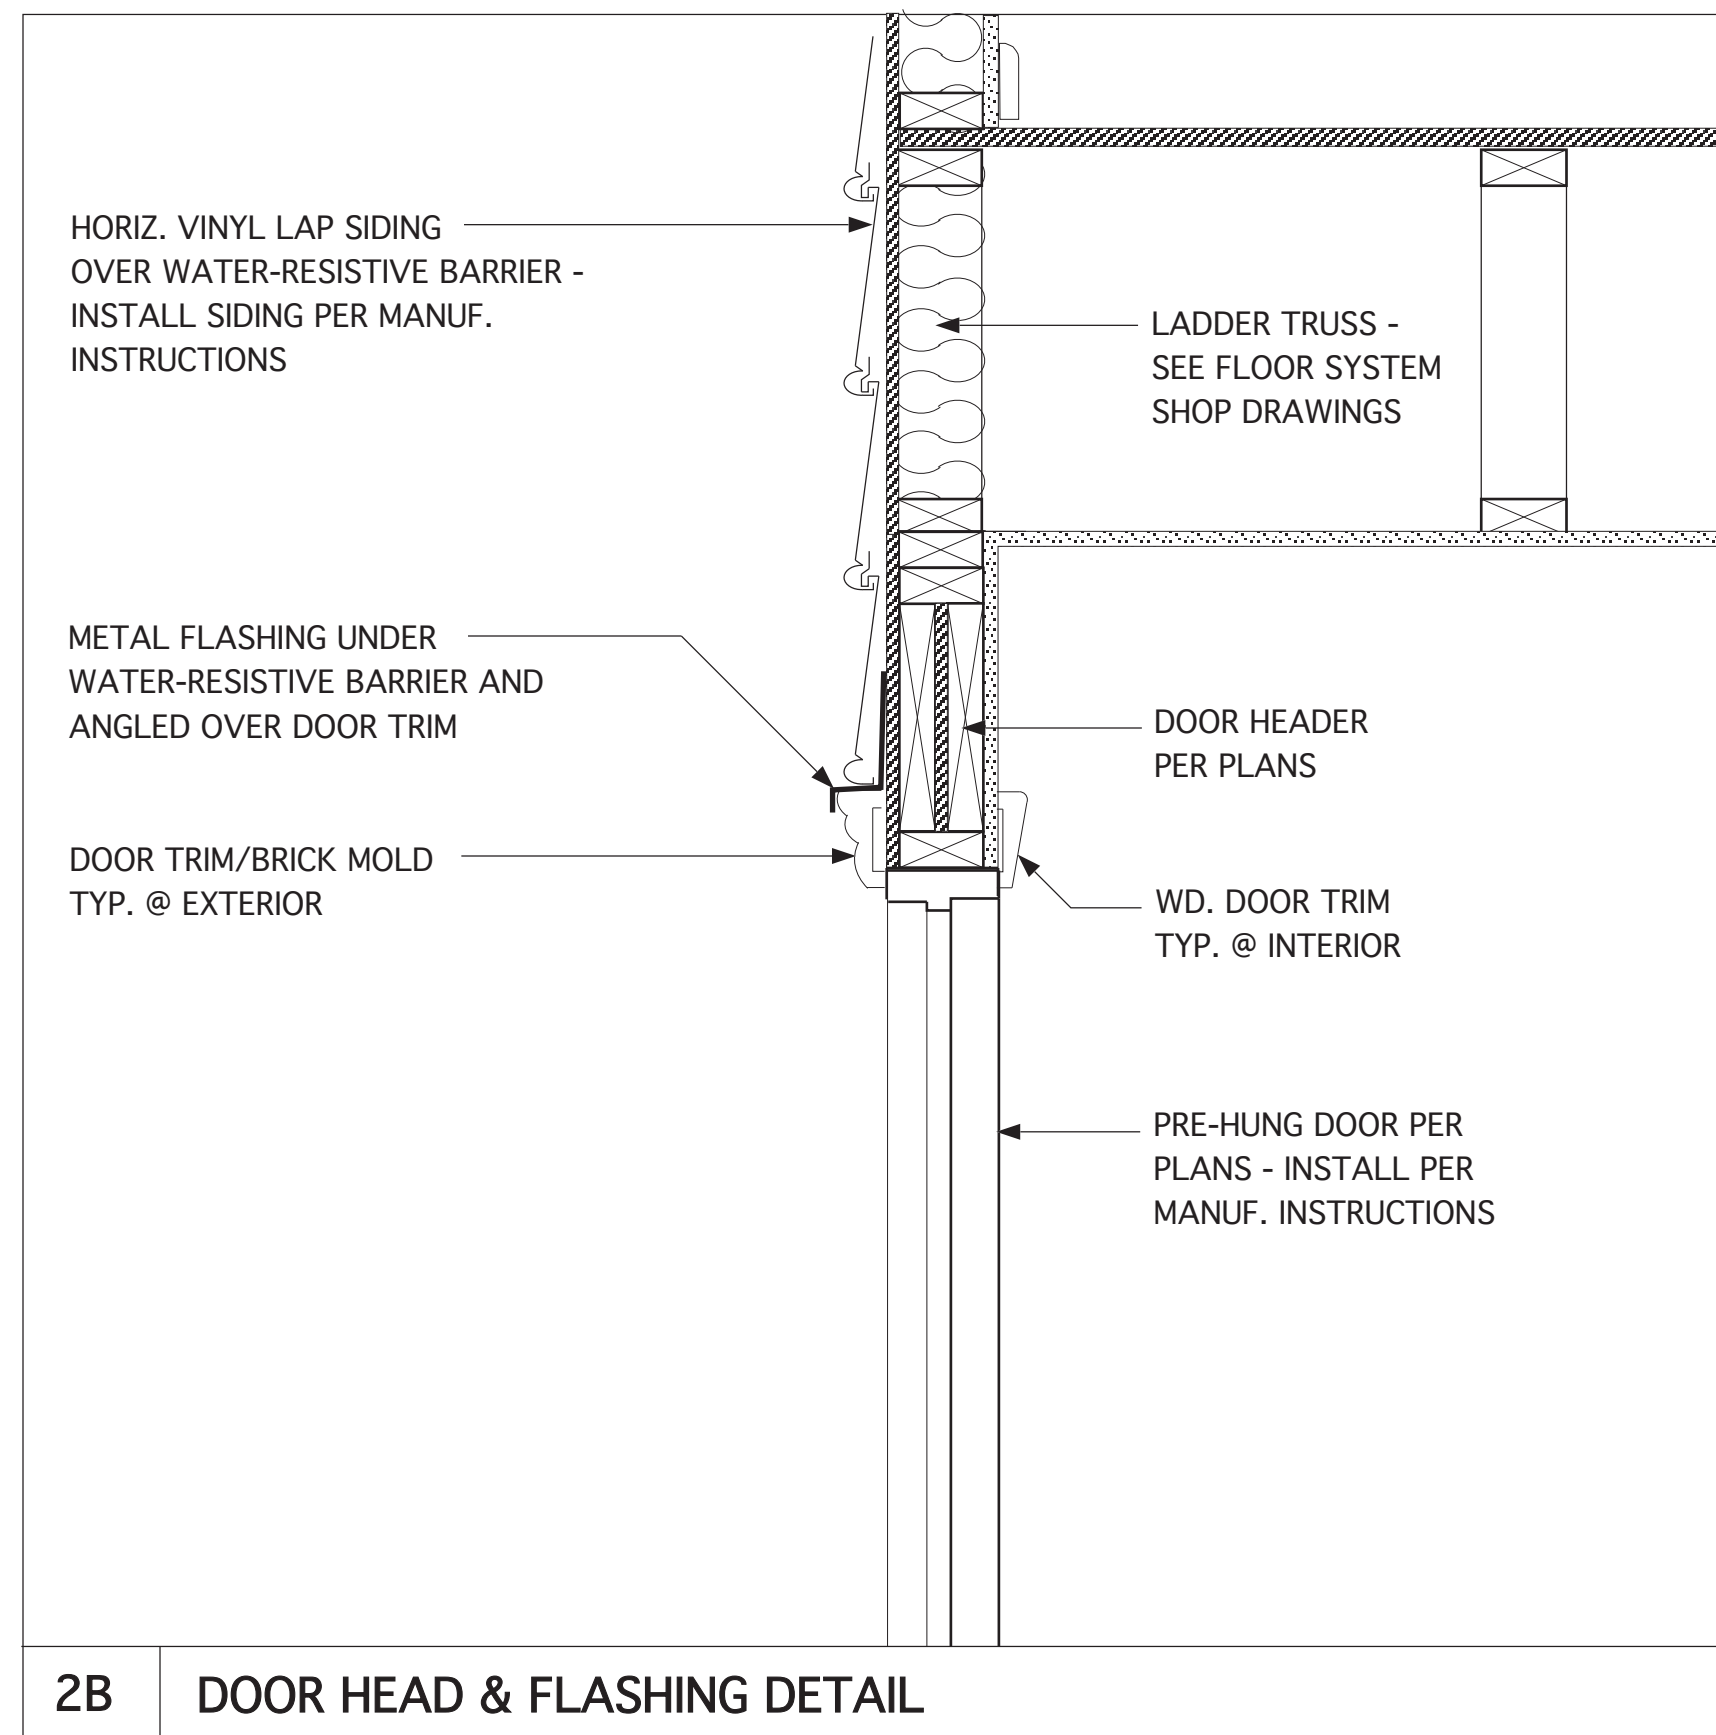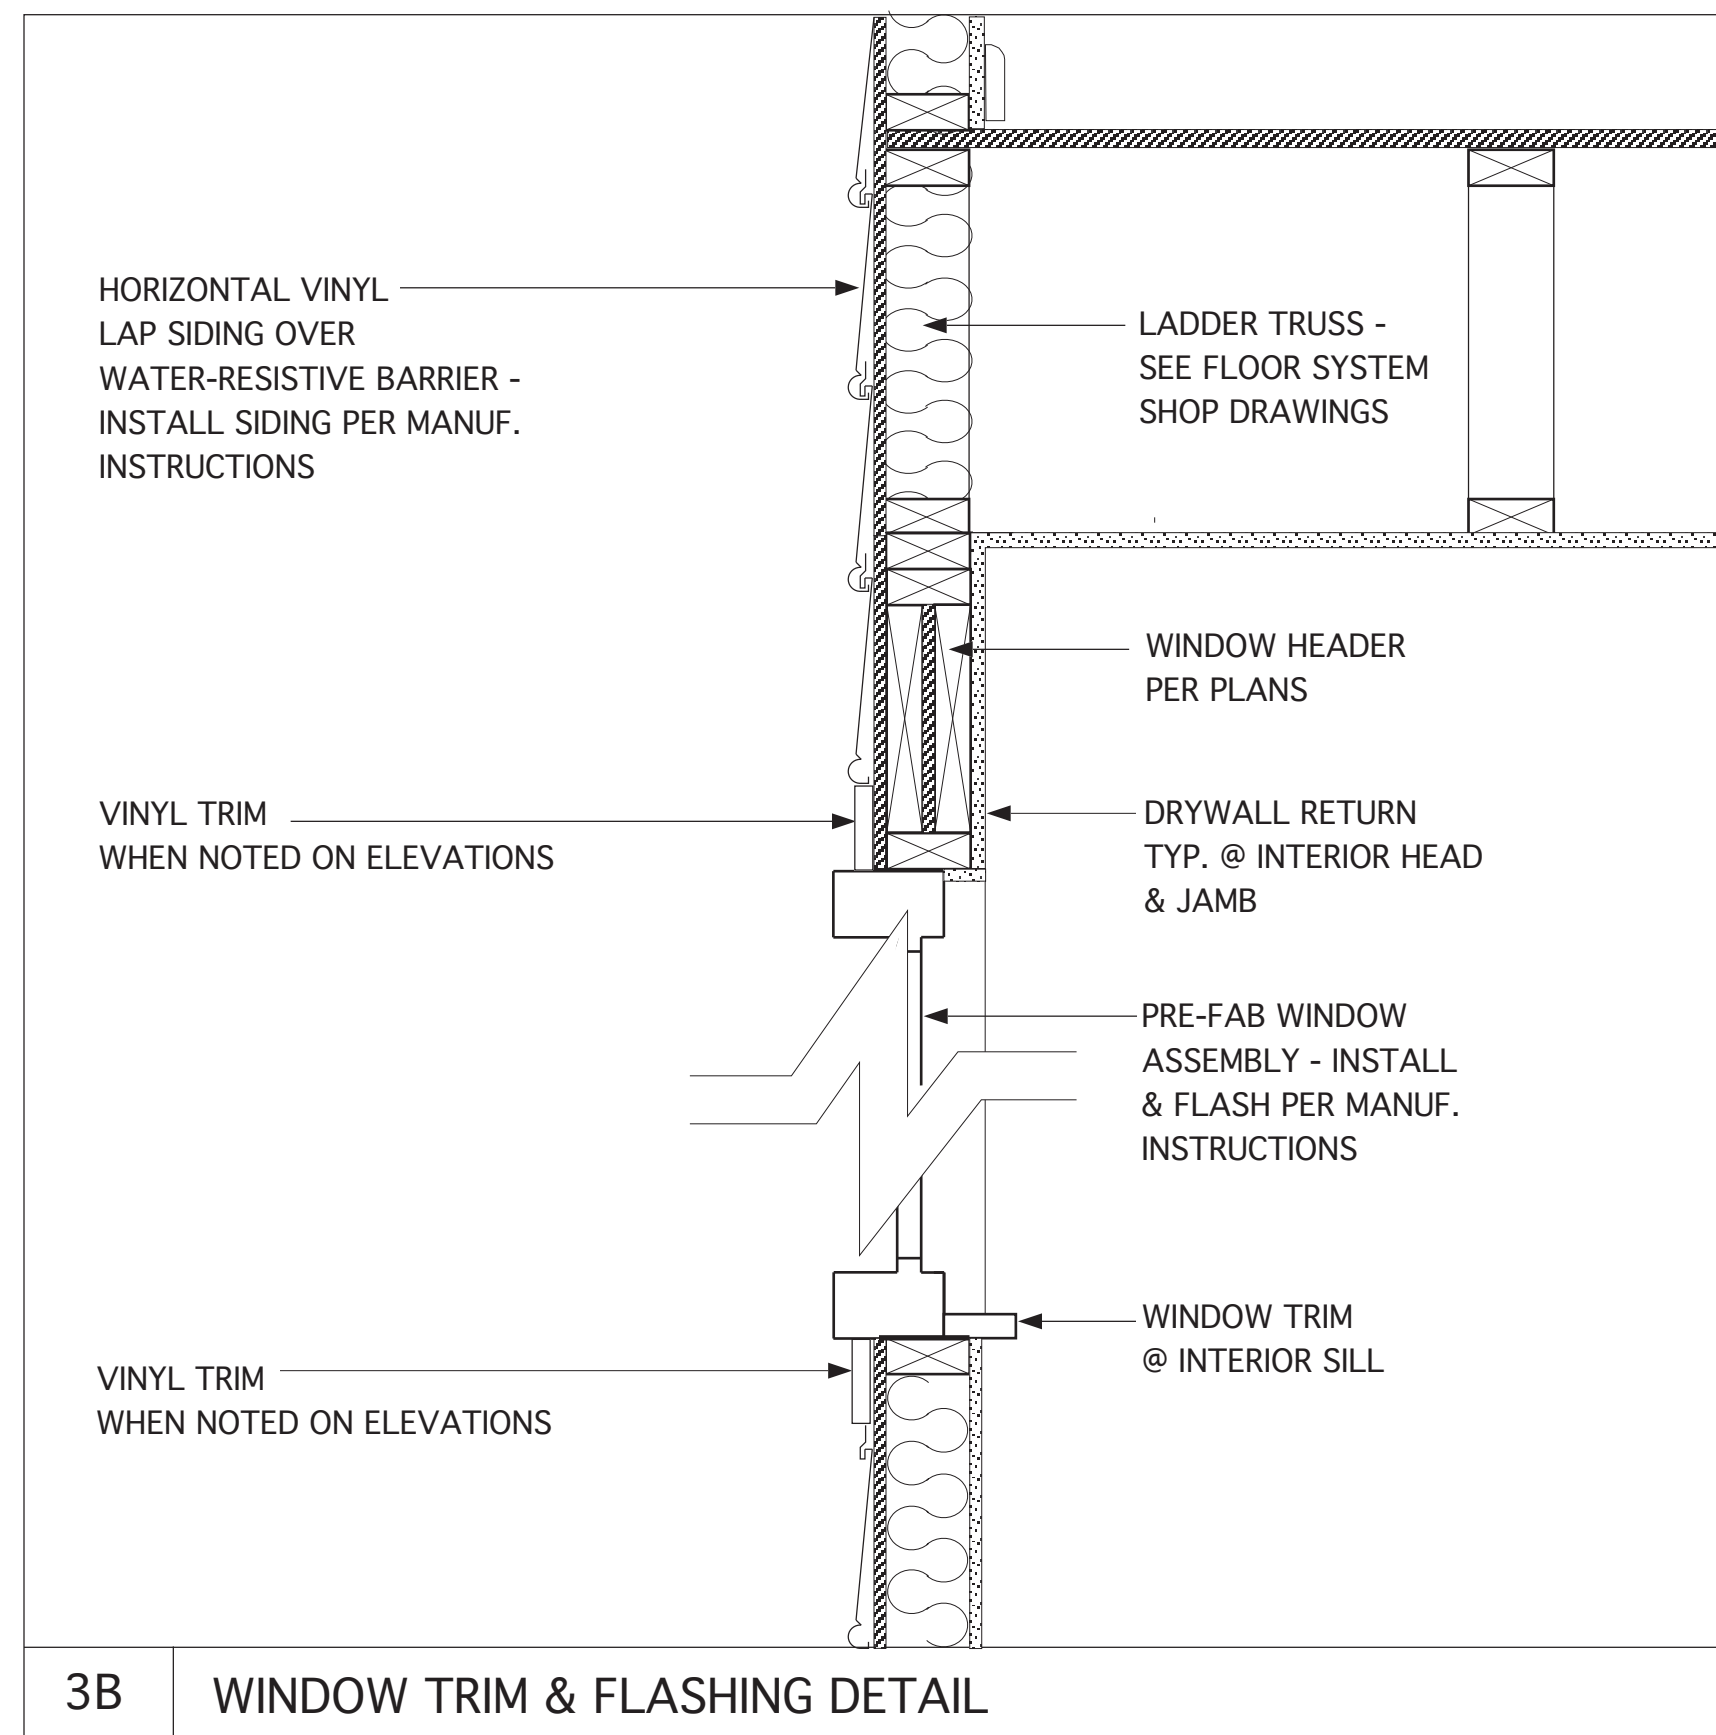

**JAMES WENTLING/ ARCHITECT**  
 LAND TITLE BUILDING  
 100 SOUTH BROAD STREET,  
 SUITE 1524  
 PHILADELPHIA, PA 19110

(215) 568-2551  
 email - information@  
 wentlinghouseplans.com

ARCHITECTURE  
 LAND PLANNING  
 GRAPHICS

THESE PLANS ARE COPYRIGHTED AND ARE SUBJECT TO COPYRIGHT PROTECTION AS AN "ARCHITECTURAL WORK" UNDER SECTION 102 OF THE COPYRIGHT ACT OF 1976, AS AMENDED DECEMBER 1, 1990 AND KNOWN AS THE "ARCHITECTURAL WORKS COPYRIGHT PROTECTION ACT OF 1990." THE PROTECTION INCLUDES BUT IS NOT LIMITED TO THE OVERALL FORM AS WELL AS THE ARRANGEMENT AND COMPOSITION OF SPACES AND ELEMENTS OF THE DESIGN. UNDER SUCH PROTECTION, UNAUTHORIZED USE OF THESE PLANS, WORKS, OR FORMS REPRESENTED CAN LEGALLY RESULT IN THE CESSATION OF SUCH CONSTRUCTION OR BUILDINGS BEING SEIZED AND/OR RAISED.

© Copyright 2016 James Wentling/ Architect

REVISIONS		
MARK	DATE	DESCRIPTION
DN	01-10-19	CONVERT OLAHS
DN	02-14-19	STRUCT. DWGS. REV.
CH	05-18-20	MINOR UPDATE
DN	04-04-24	CONVERT 113-69/ADD OPT. BATH #2 LM

PROJECT NO. 113-88  
 DATE 01-13-16  
 SCALE 1-1/2" = 1'-0"  
 DRAWN BY DN  
 CHECKED BY JW  
 ISSUED FOR PERMITS/CONSTRUCTION


PROJECT TITLE  
**MODEL 628 - GARAGE LEFT**

CLIENT  
**CHESAPEAKE HOMES OF NC**  
 3100 Smoketree Court,  
 Suite 210  
 Raleigh, NC 27604  
 (919) 256-3060  
 (919) 556-0690 Fax


DRAWING TITLE  
**MONOLITHIC SLAB FOUNDATION AND WALL DETAILS**

SHEET  
**6.2**



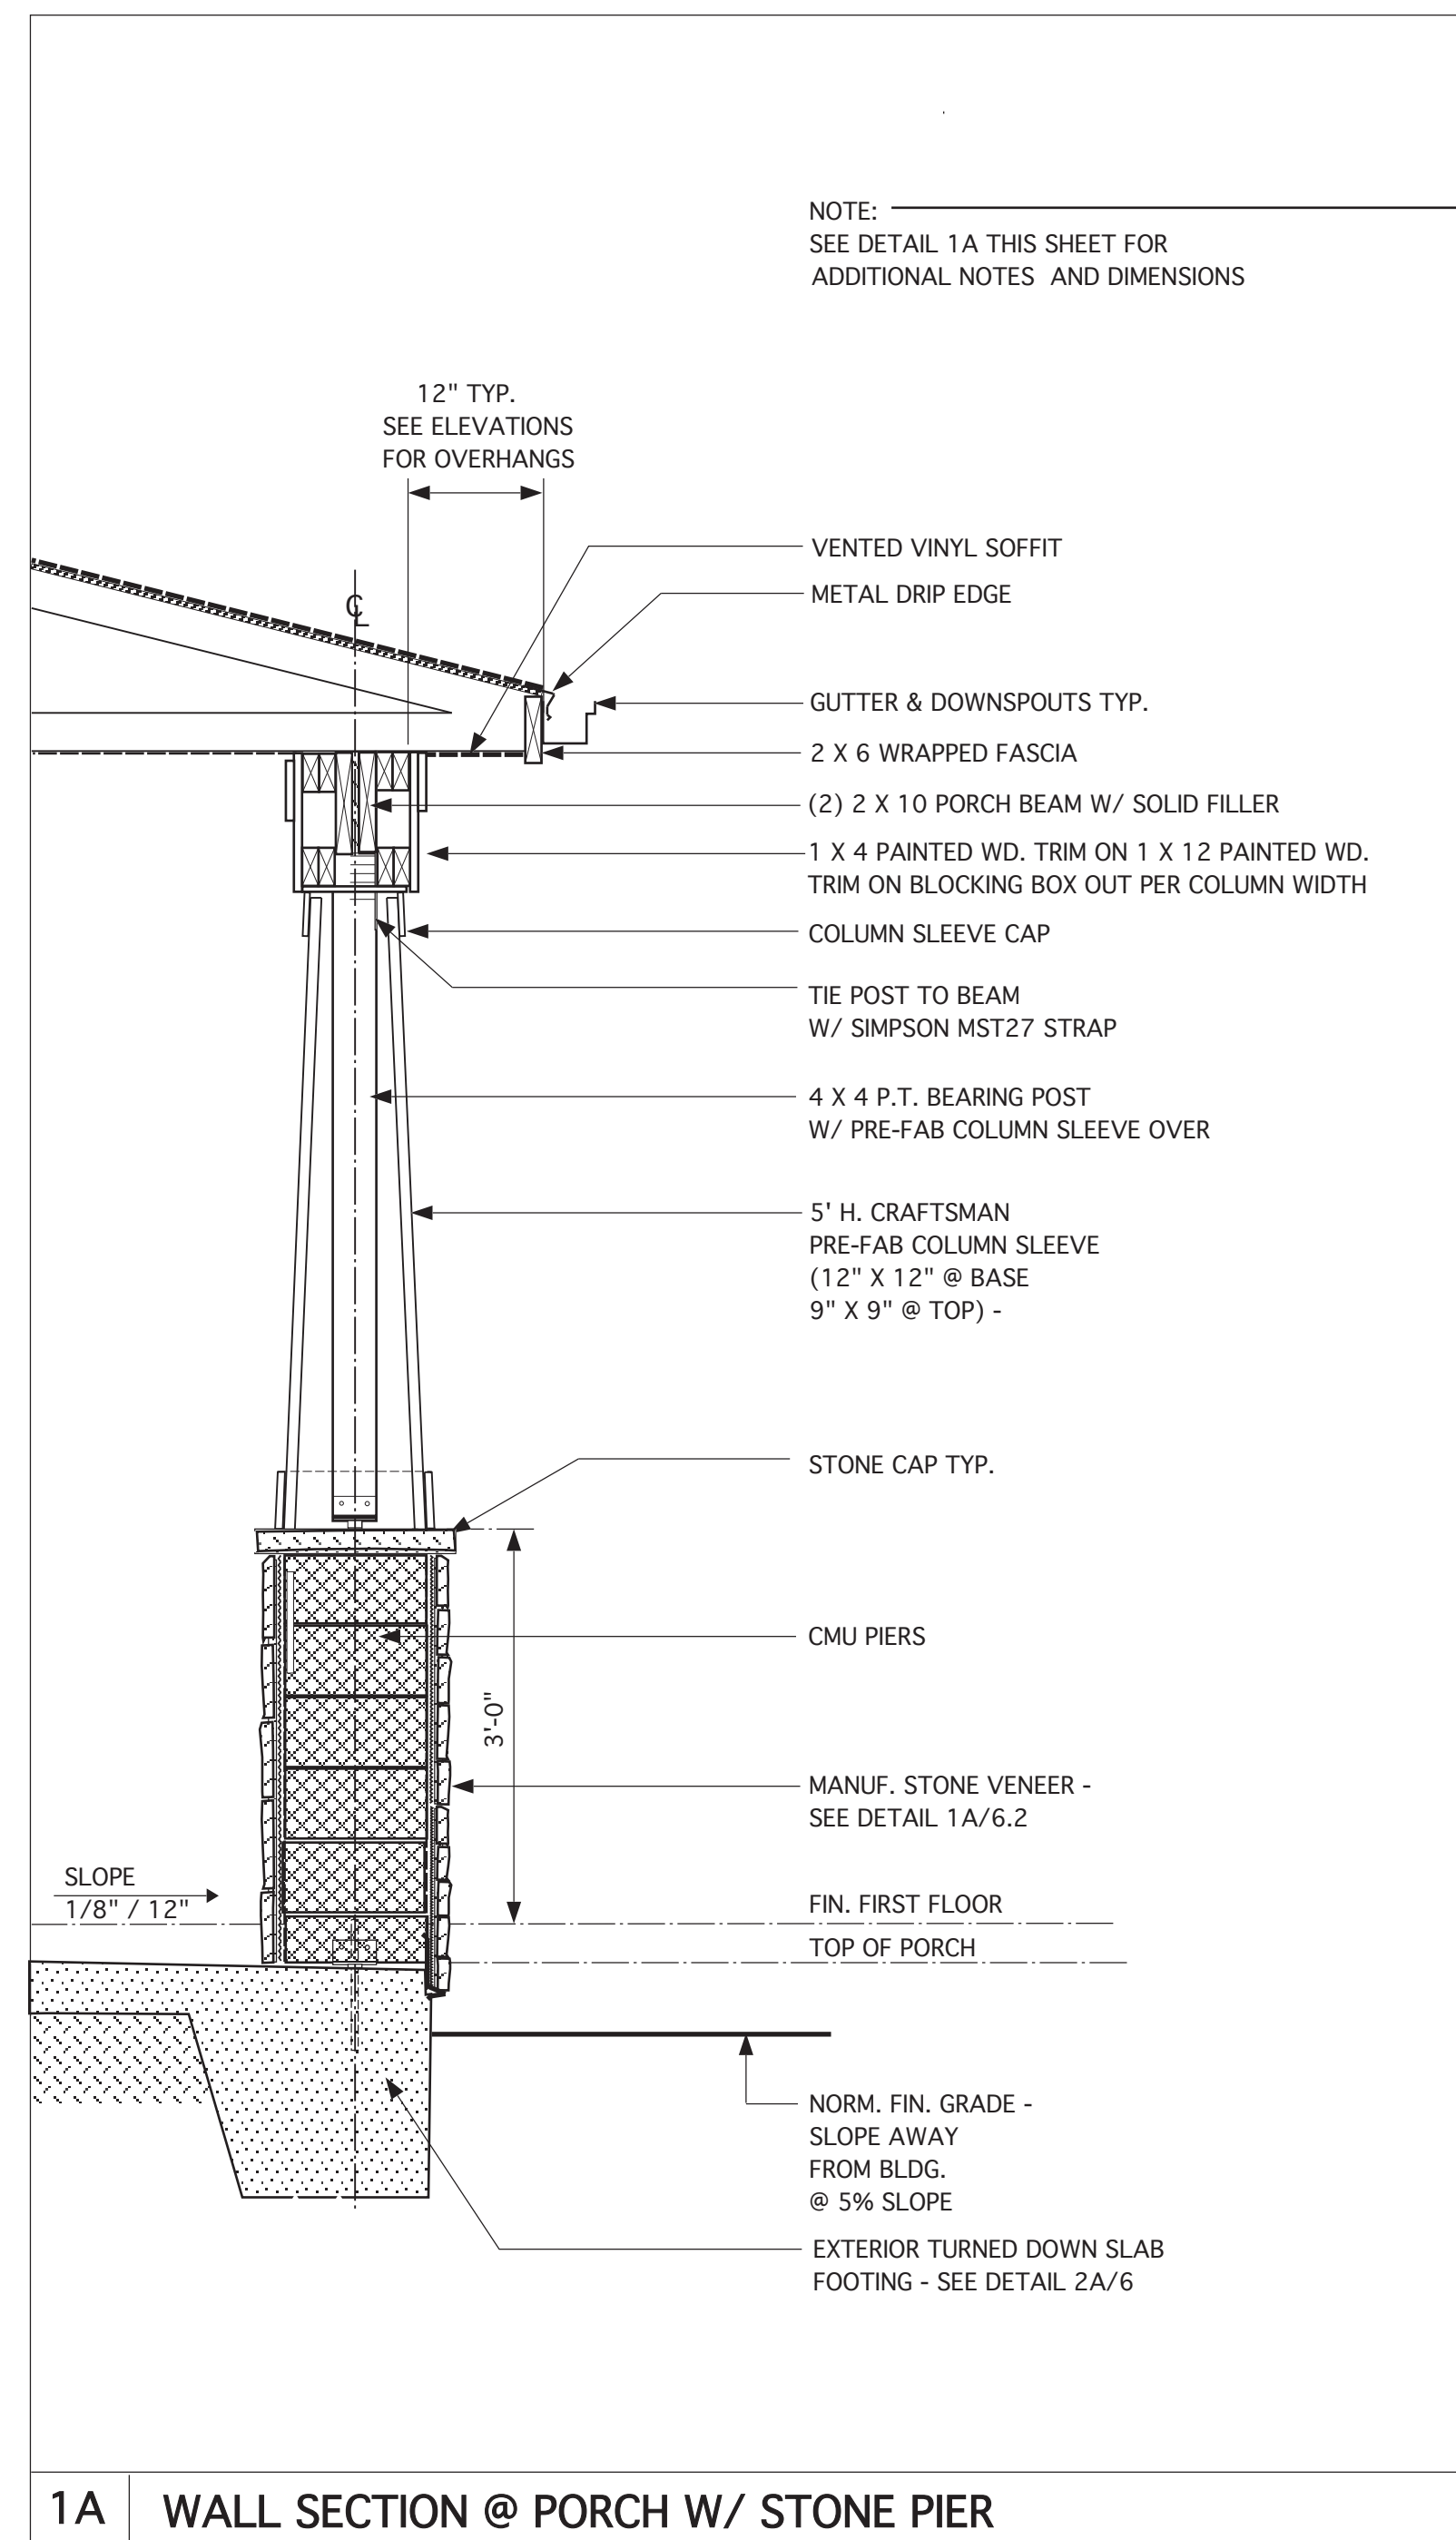

1A WALL SECTION @ PORCH W/ STONE PIER

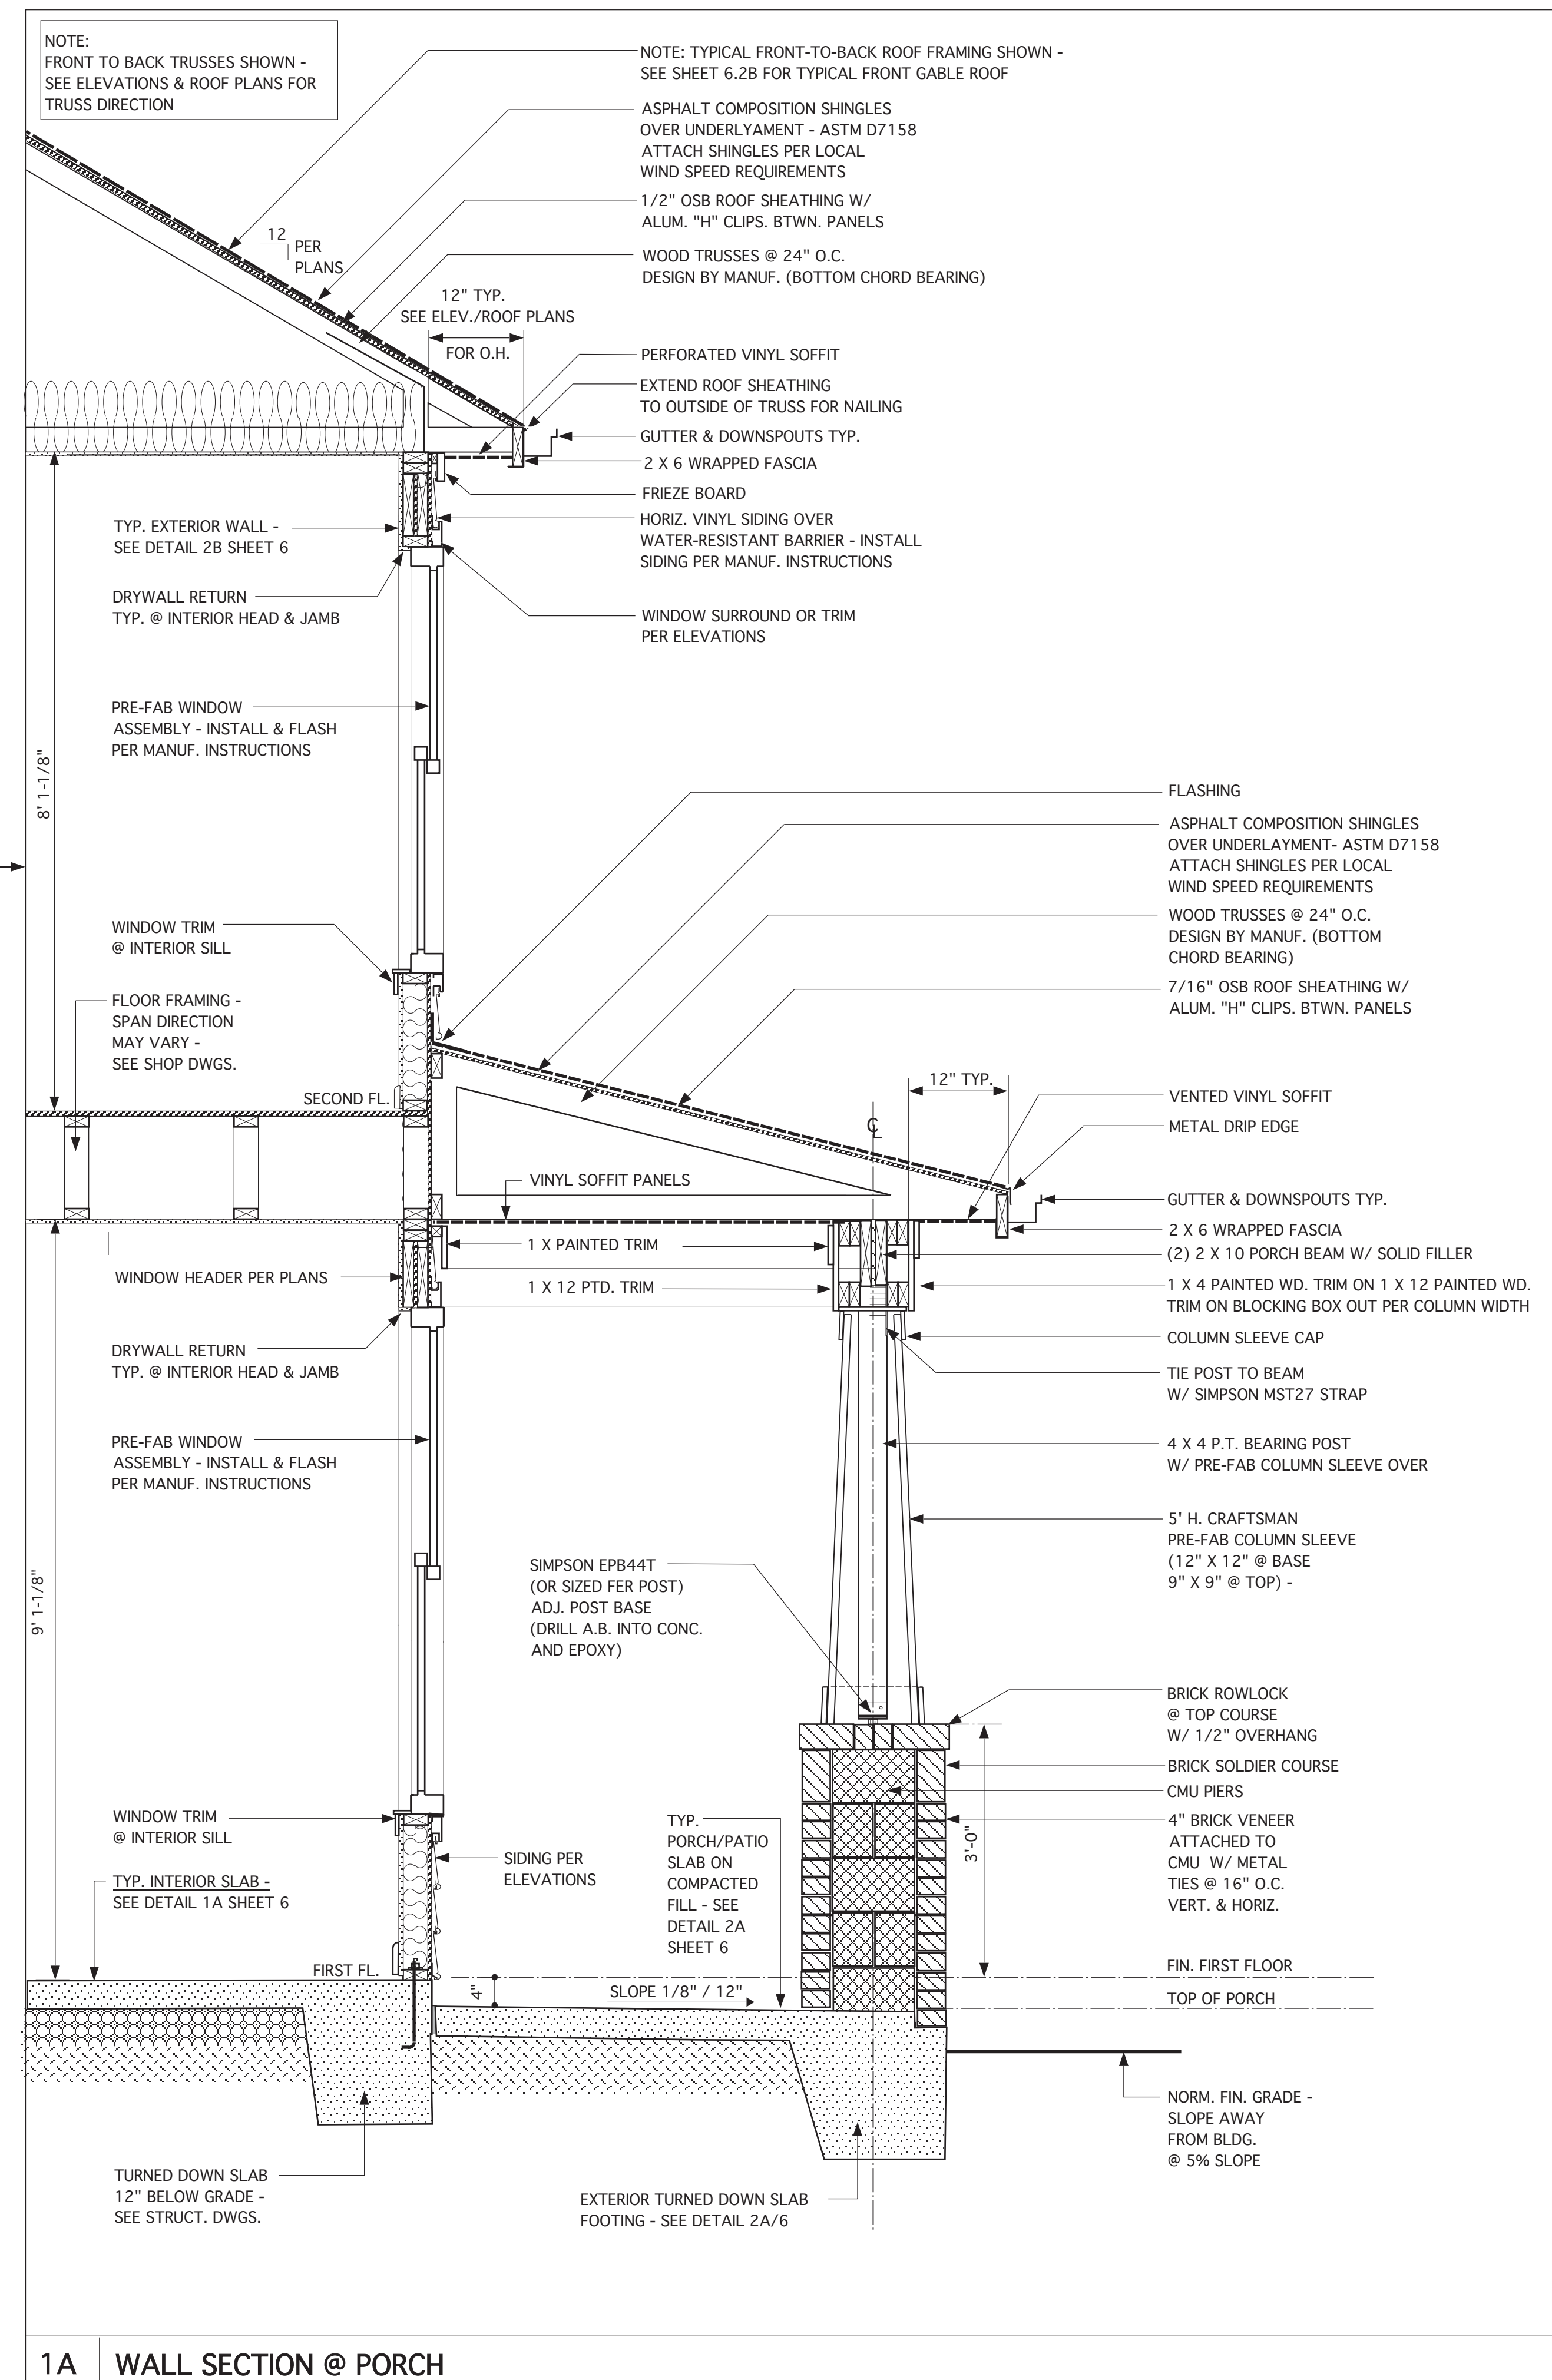

1A WALL SECTION @ PORCH

JAMES WENTLING/  
ARCHITECT

LAND TITLE BUILDING  
100 SOUTH BROAD STREET,  
SUITE 1524  
PHILADELPHIA, PA 19110

(215) 568-2551  
email - information@  
wentlinghouseplans.com

ARCHITECTURE  
LAND PLANNING  
GRAPHICS

THESE PLANS ARE COPYRIGHTED AND ARE SUBJECT TO COPYRIGHT PROTECTION AS AN "ARCHITECTURAL WORK" UNDER SECTION 102 OF THE COPYRIGHT ACT OF 1976, AS AMENDED DECEMBER 1, 1990 AND KNOWN AS THE "ARCHITECTURAL WORKS COPYRIGHT PROTECTION ACT OF 1990." THE PROTECTION INCLUDES BUT IS NOT LIMITED TO, THE OVERALL FORM AS WELL AS THE ARRANGEMENT AND COMPOSITION OF SPACES AND ELEMENTS OF THE DESIGN. UNDER SUCH PROTECTION, UNAUTHORIZED USE OF THESE PLANS, WORKS, OR FORMS REPRESENTED CAN LEGALLY RESULT IN THE CESSATION OF SUCH CONSTRUCTION OR BUILDINGS BEING SEIZED AND/OR RAISED.



REVISIONS		
MARK	DATE	DESCRIPTION
DN	01-10-19	CONVERT OLAHS
DN	02-14-19	STRUCT. DWGS. REV.
CH	05-18-20	MINOR UPDATE
DN	04-04-24	CONVERT 113-69/ADD OPT. BATH #2 LM

PROJECT NO.	113-88
DATE	01-13-16
SCALE	3/4" = 1'-0"
DRAWN BY	DN
CHECKED BY	JW
ISSUED FOR	PERMITS/CONSTRUCTION

PROJECT TITLE  
**MODEL 628 - GARAGE LEFT**




CLIENT  
**CHESAPEAKE HOMES OF NC**  
3100 Smoketree Court,  
Suite 210  
Raleigh, NC 27604  
(919) 256-3060  
(919) 556-0690 Fax

DRAWING TITLE  
**ELEVATION A - DETAILS**

SHEET  
**6.2A**

© Copyright 2016 James Wentling/Architect



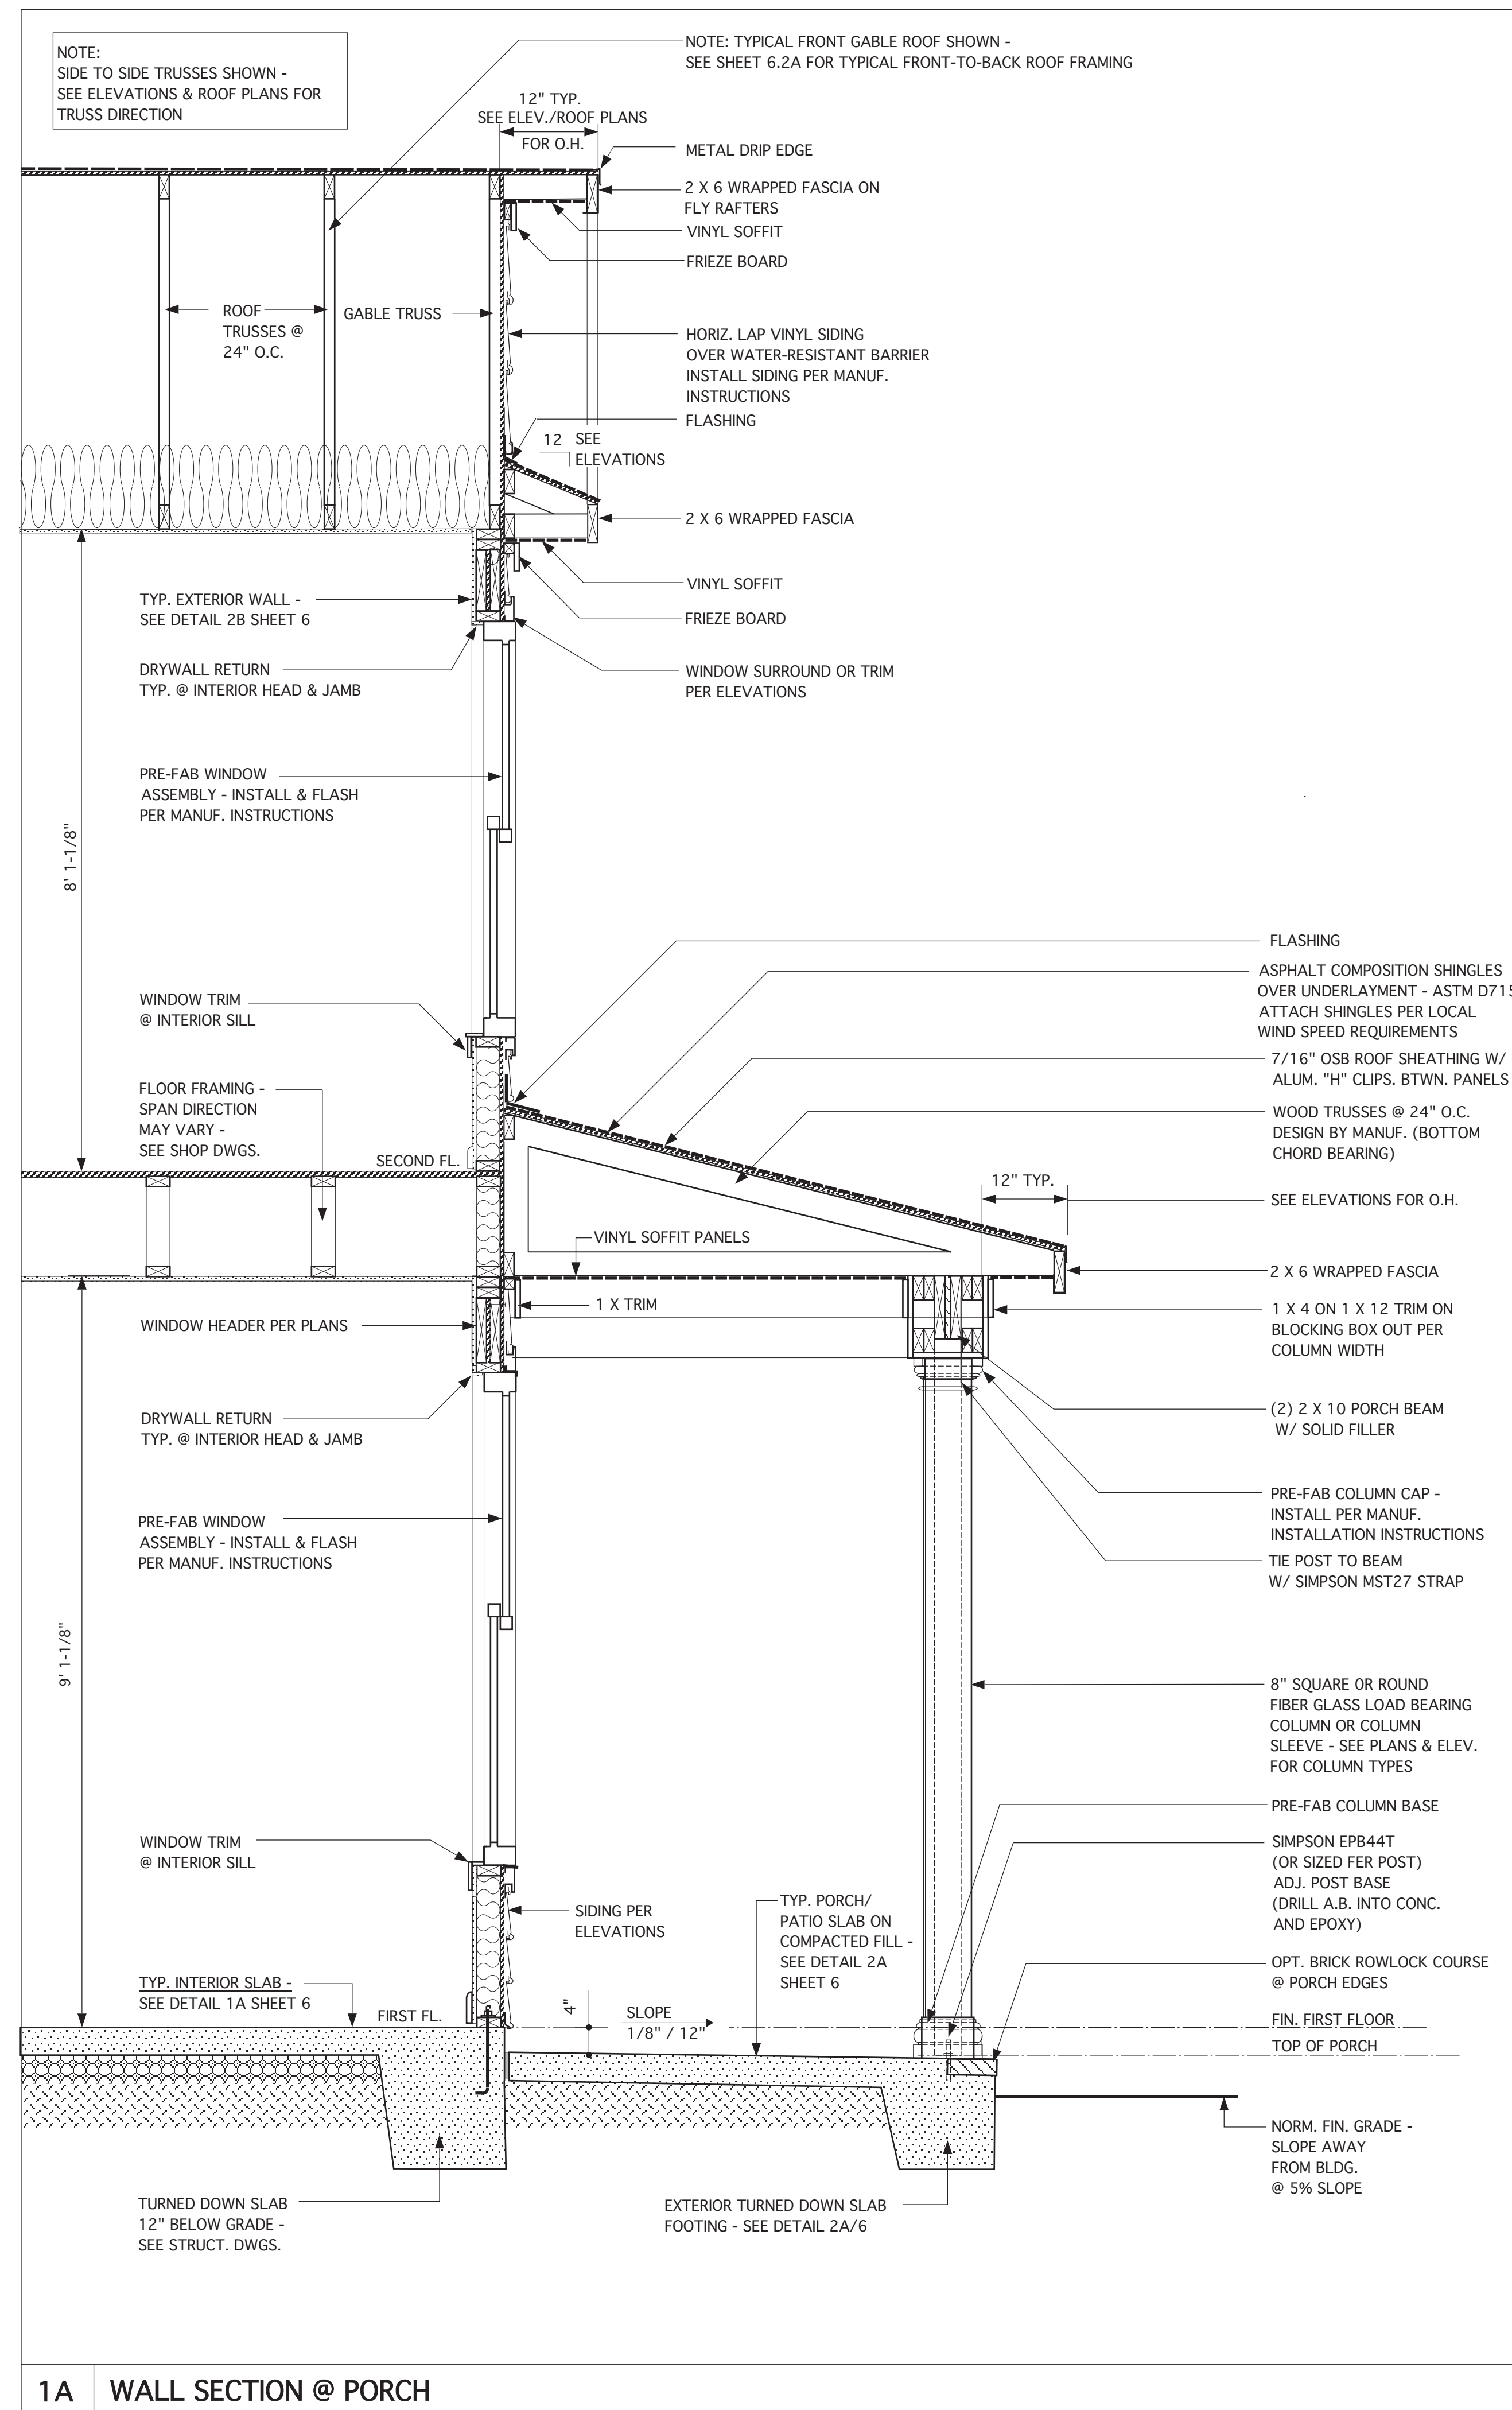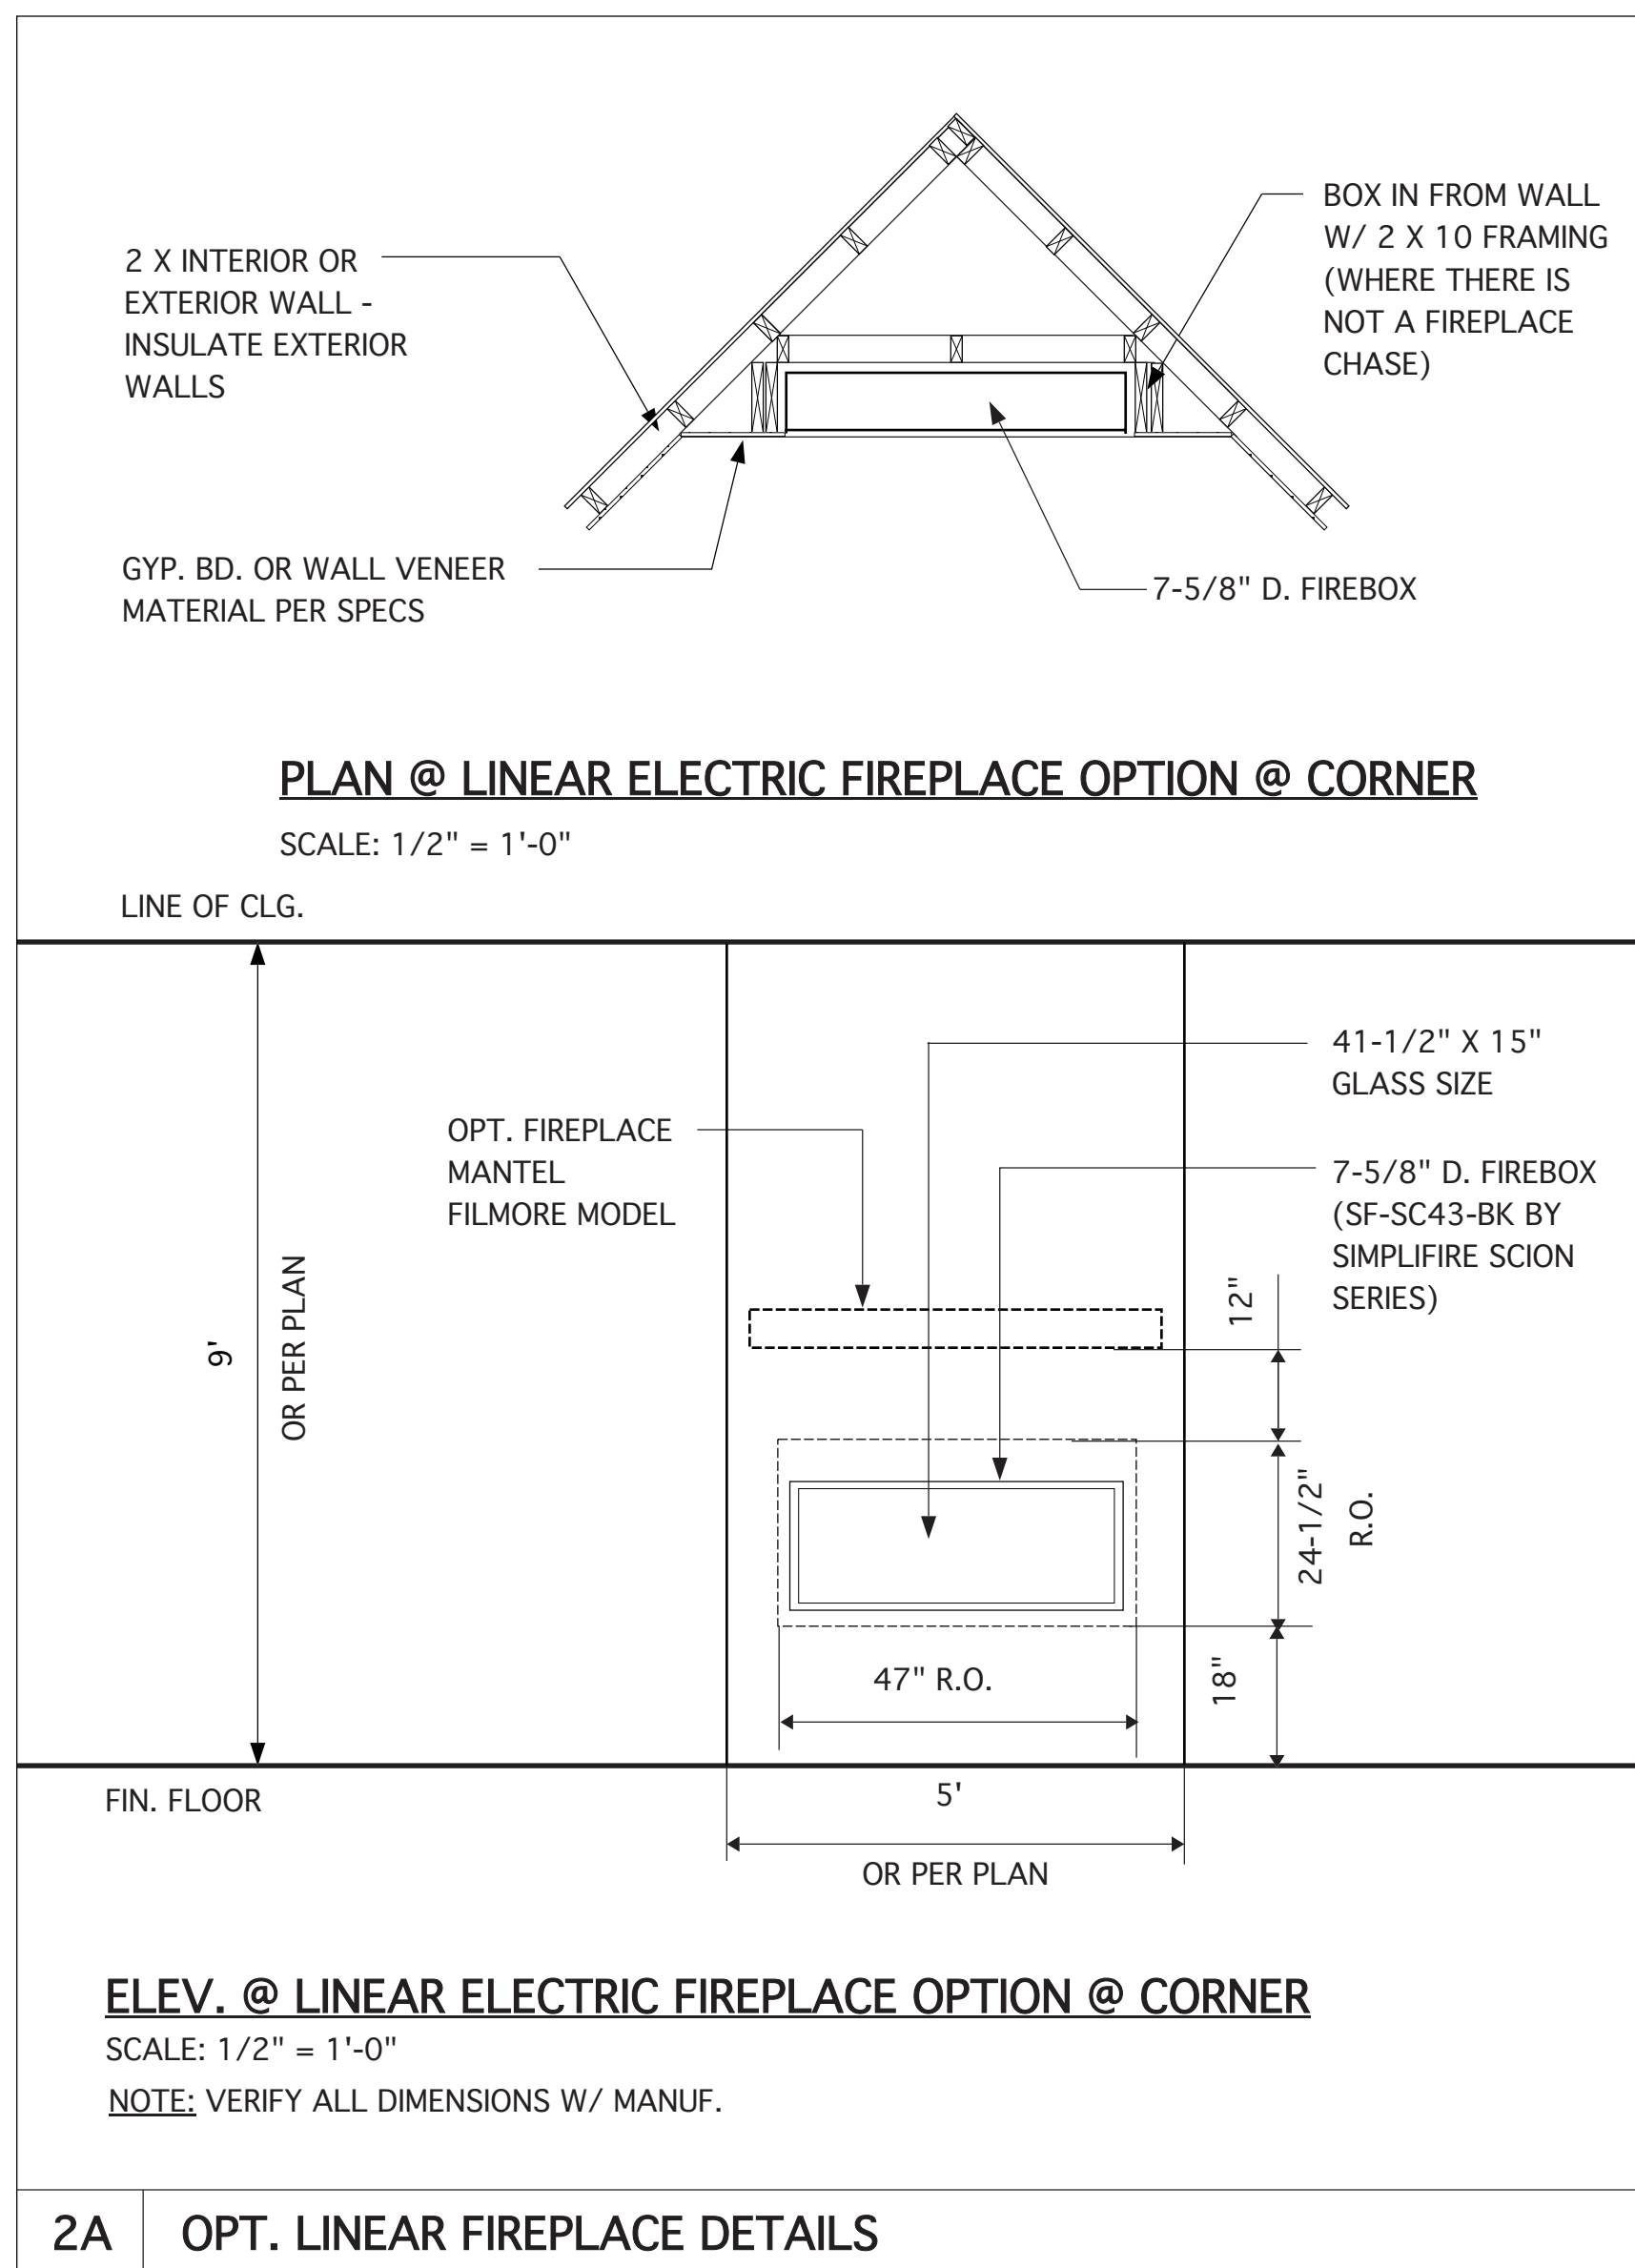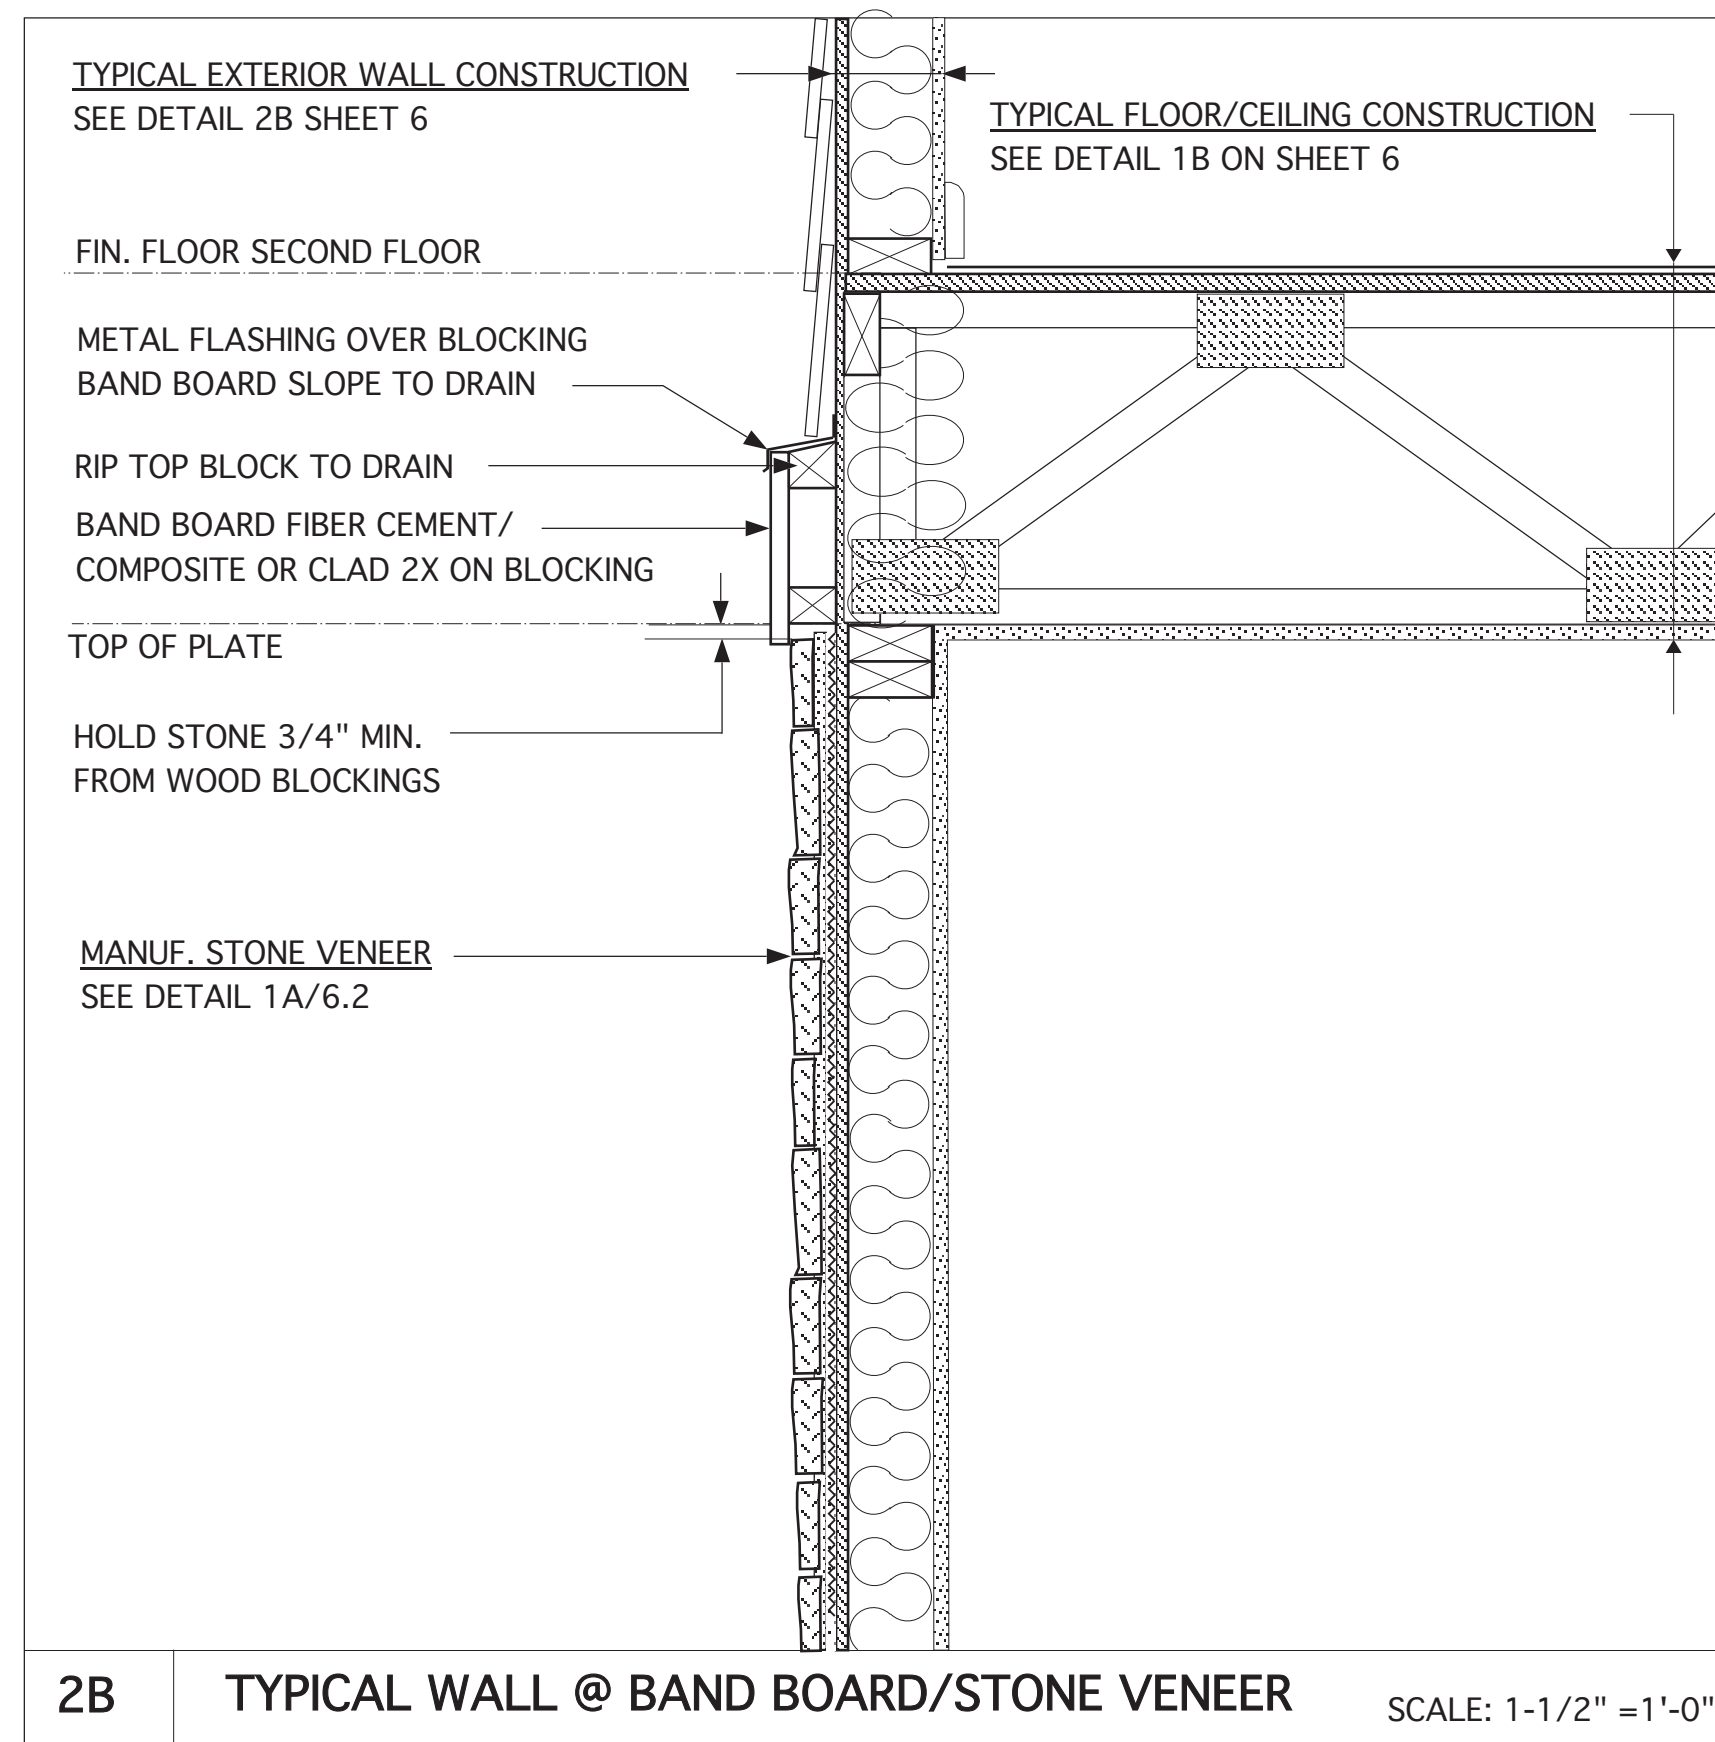

**JAMES WENTLING/  
ARCHITECT**

LAND TITLE BUILDING  
100 SOUTH BROAD STREET,  
SUITE 1524  
PHILADELPHIA, PA 19110

(215) 568-2551  
email - information@  
wentlinghouseplans.com

ARCHITECTURE  
LAND PLANNING  
GRAPHICS

THESE PLANS ARE COPYRIGHTED AND ARE  
SUBJECT TO COPYRIGHT PROTECTION AS AN  
"ARCHITECTURAL WORK" UNDER SECTION  
102 OF THE COPYRIGHT ACT, 17 U.S.C. AS  
AMENDED DECEMBER 1, 1990 AND KNOWN  
AS THE "ARCHITECTURAL WORKS  
COPYRIGHT PROTECTION ACT OF 1990." THE  
PROTECTION INCLUDES BUT IS NOT LIMITED  
TO THE OVERALL FORM AS WELL AS THE  
ARRANGEMENT AND COMPOSITION OF  
SPACES AND ELEMENTS OF THE DESIGN.  
UNDER SUCH PROTECTION, UNAUTHORIZED  
USE OF THESE PLANS, WORKS, OR FORMS  
REPRESENTED CAN LEGALLY RESULT  
IN THE CESSION OF SUCH CONSTRUCTION  
OR BUILDINGS BEING SEIZED AND/OR RAISED.

© Copyright 2016 James Wentling/ Architect

**JAMES WALTER WENTLING**  
REGISTERED ARCHITECT  
#642  
W. W. Wentling  
NORTH CAROLINA  
RALEIGH, N. C.  
4/1/24

REVISIONS		
MARK	DATE	DESCRIPTION
DN	01-10-19	CONVERT OLAHS
DN	02-14-19	STRUCT. DWGS. REV.
CH	05-18-20	MINOR UPDATE
DN	04-04-24	CONVERT 113-69/ADD OPT. BATH #2 LM

PROJECT NO. 113-88  
DATE 01-13-16  
SCALE 3/4" = 1'-0" U.N.O.  
DRAWN BY DN  
CHECKED BY JW  
ISSUED FOR PERMITS/CONSTRUCTION


PROJECT TITLE  
**MODEL 628 -  
GARAGE LEFT**

CLIENT  
**CHESAPEAKE  
HOMES OF NC**  
3100 Smoketree Court,  
Suite 210  
Raleigh, NC 27604  
(919) 256-3060  
(919) 556-0690 Fax


DRAWING TITLE  
**ELEVATION B/C/D/F -  
DETAILS**

SHEET  
**6.2B**




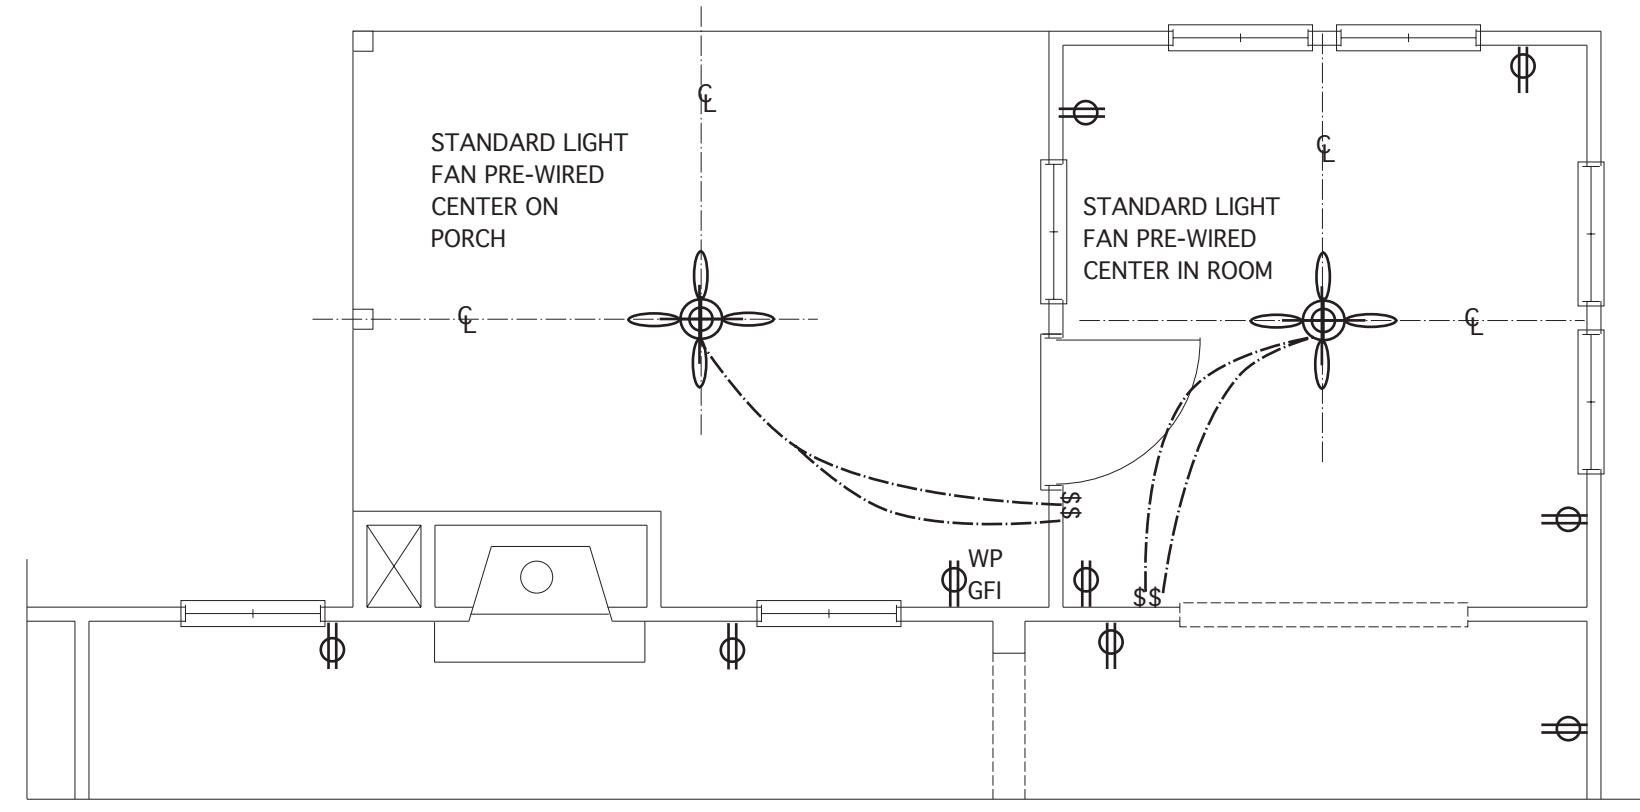


**OPT. SUNROOM W/ OPT. COVERED PORCH**  
SCALE 1/4" = 1'-0" - 9'-0" CLG. U.N.O.

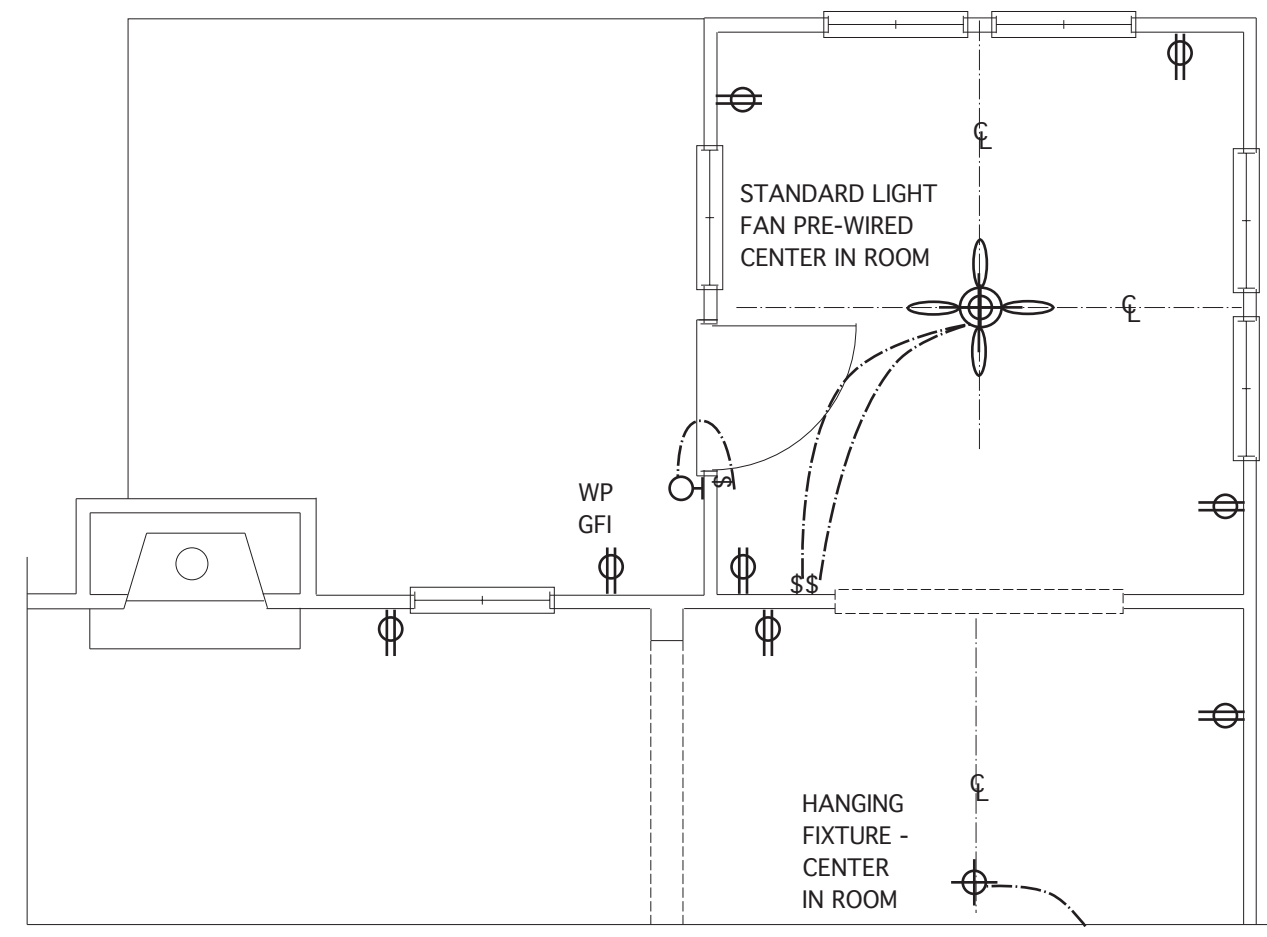

**OPT. SUNROOM**  
SCALE 1/4" = 1'-0"

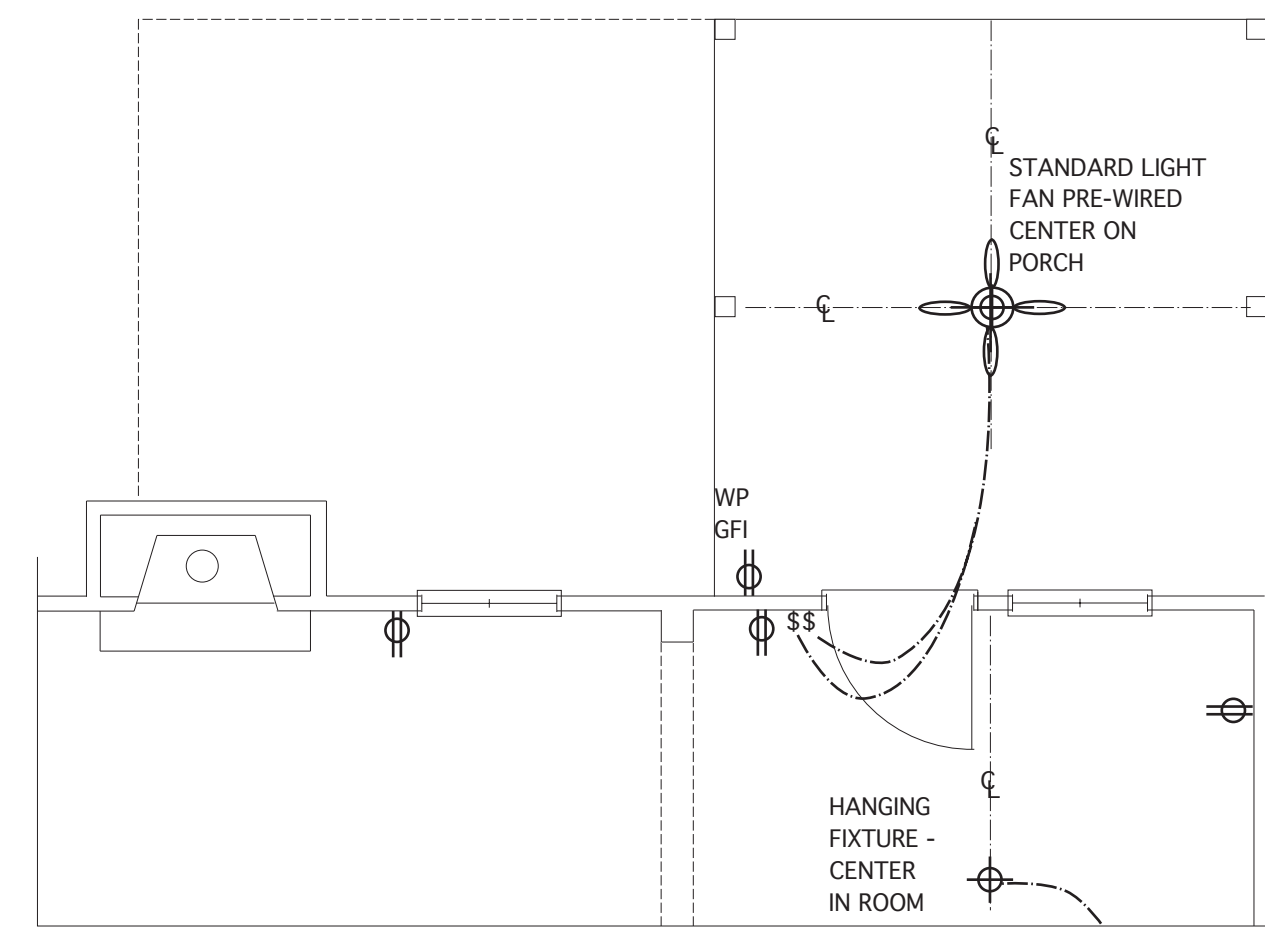


**OPT. COVERED PORCH**  
SCALE 1/4" = 1'-0"

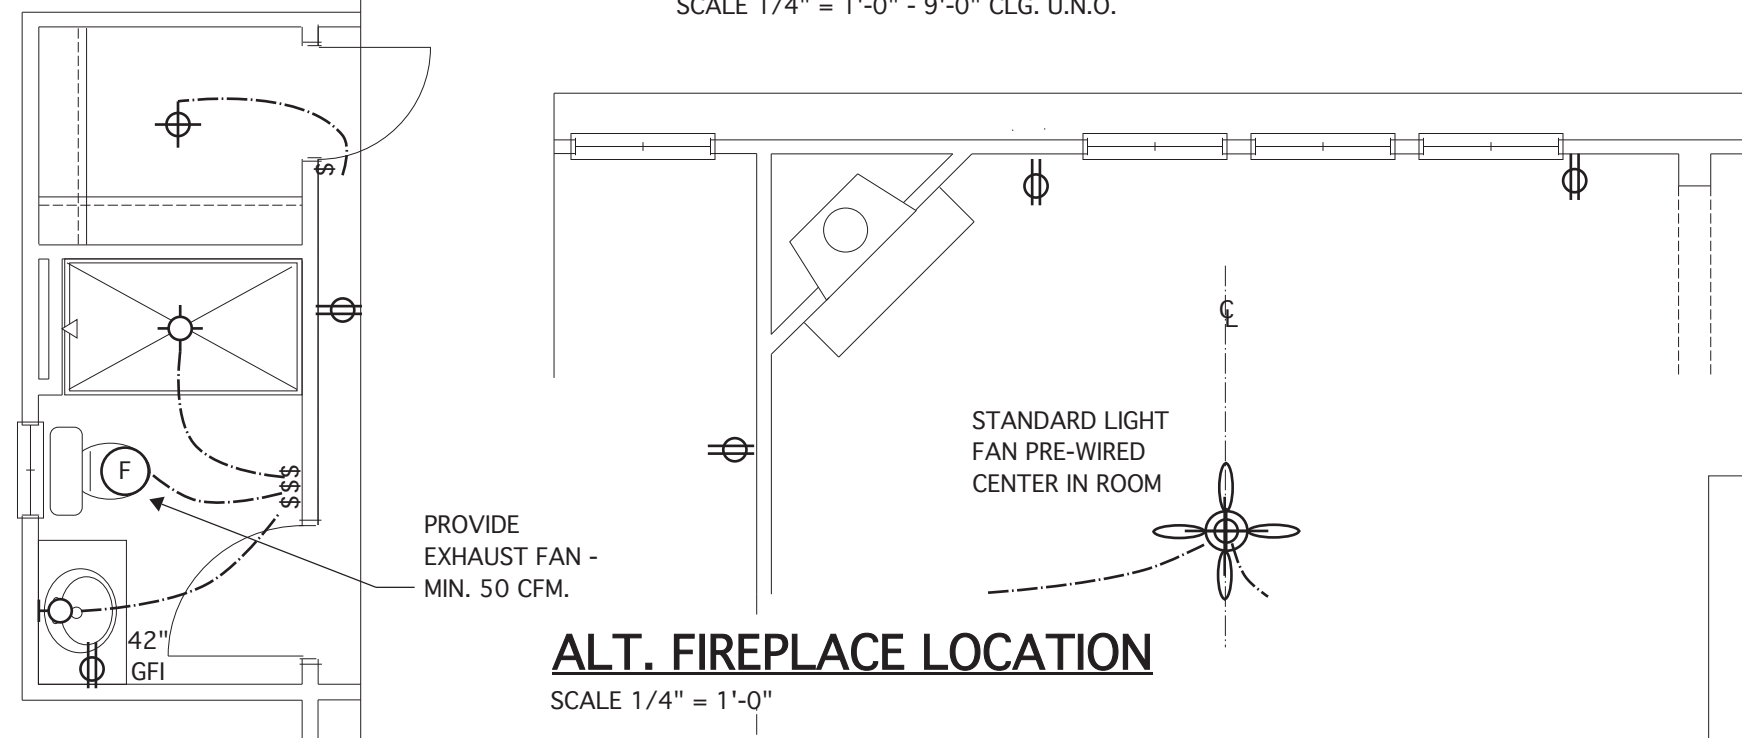


**ALT. FIREPLACE LOCATION**  
SCALE 1/4" = 1'-0"


**OPT. BATH #1**  
SCALE 1/4" = 1'-0"

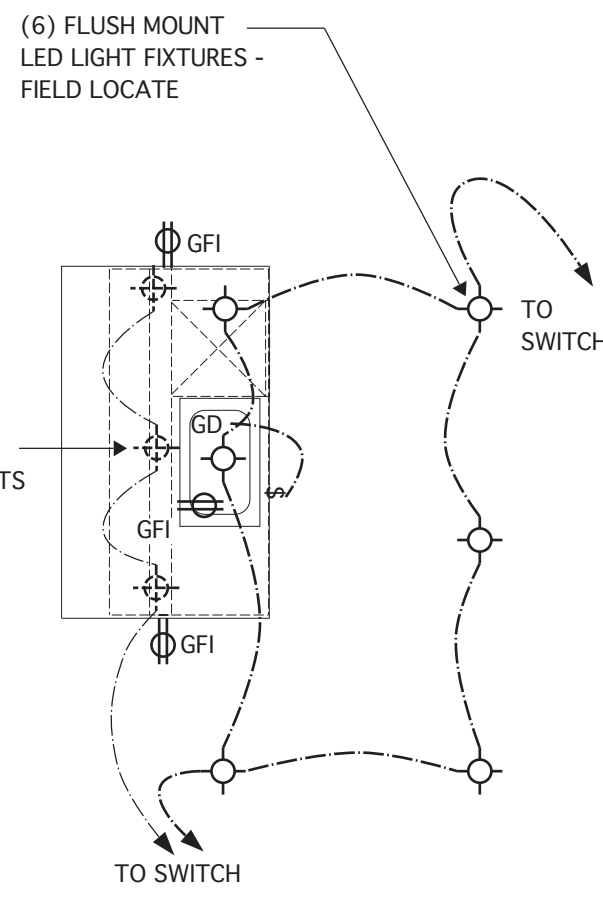


**GOURMET ISLAND**

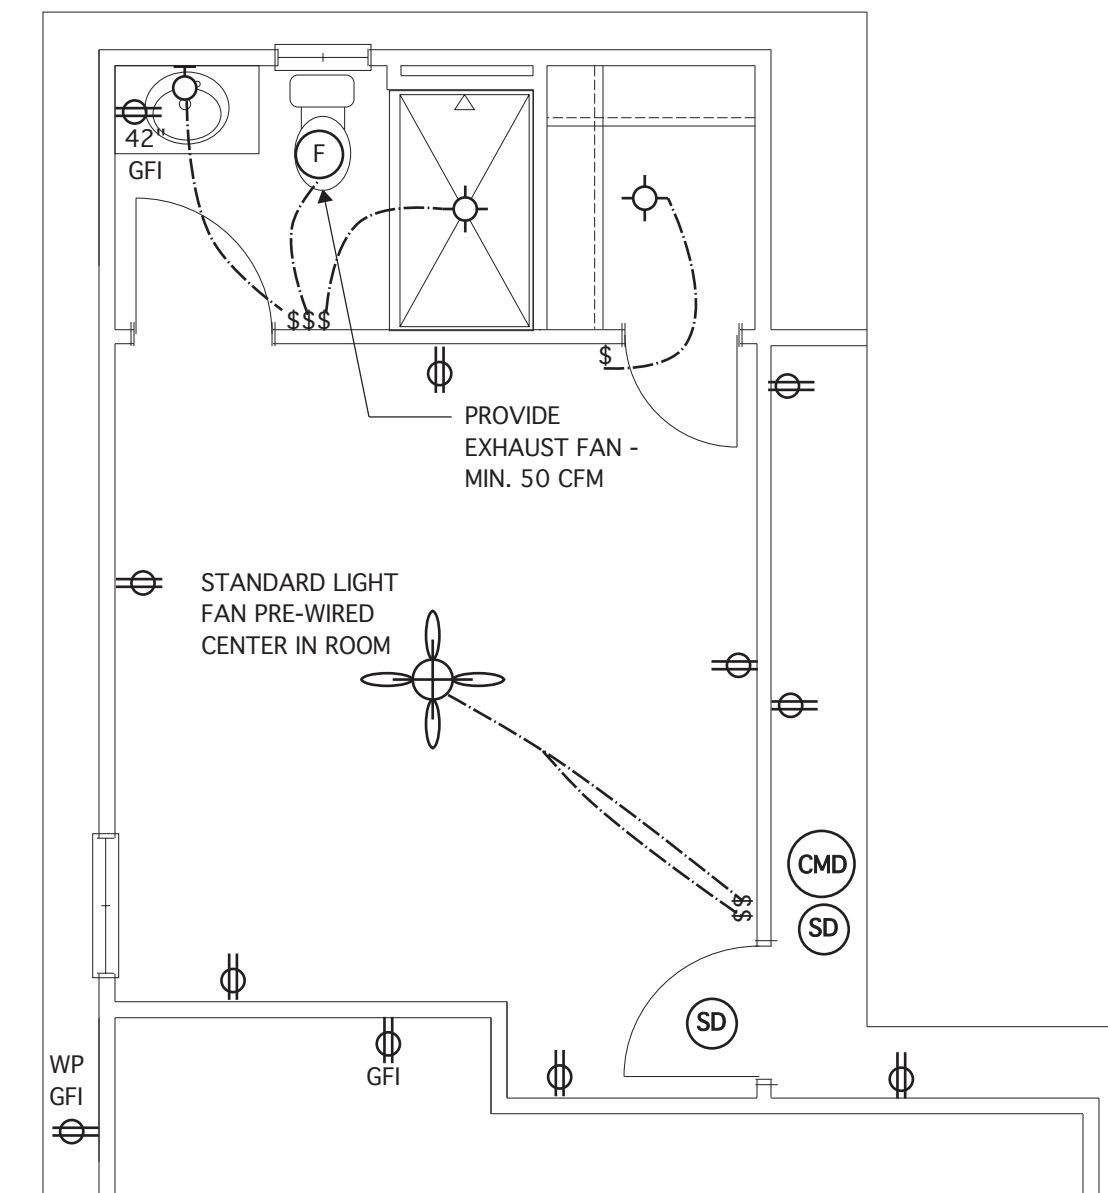


**OPT. BATH #2**  
SCALE 1/4" = 1'-0"

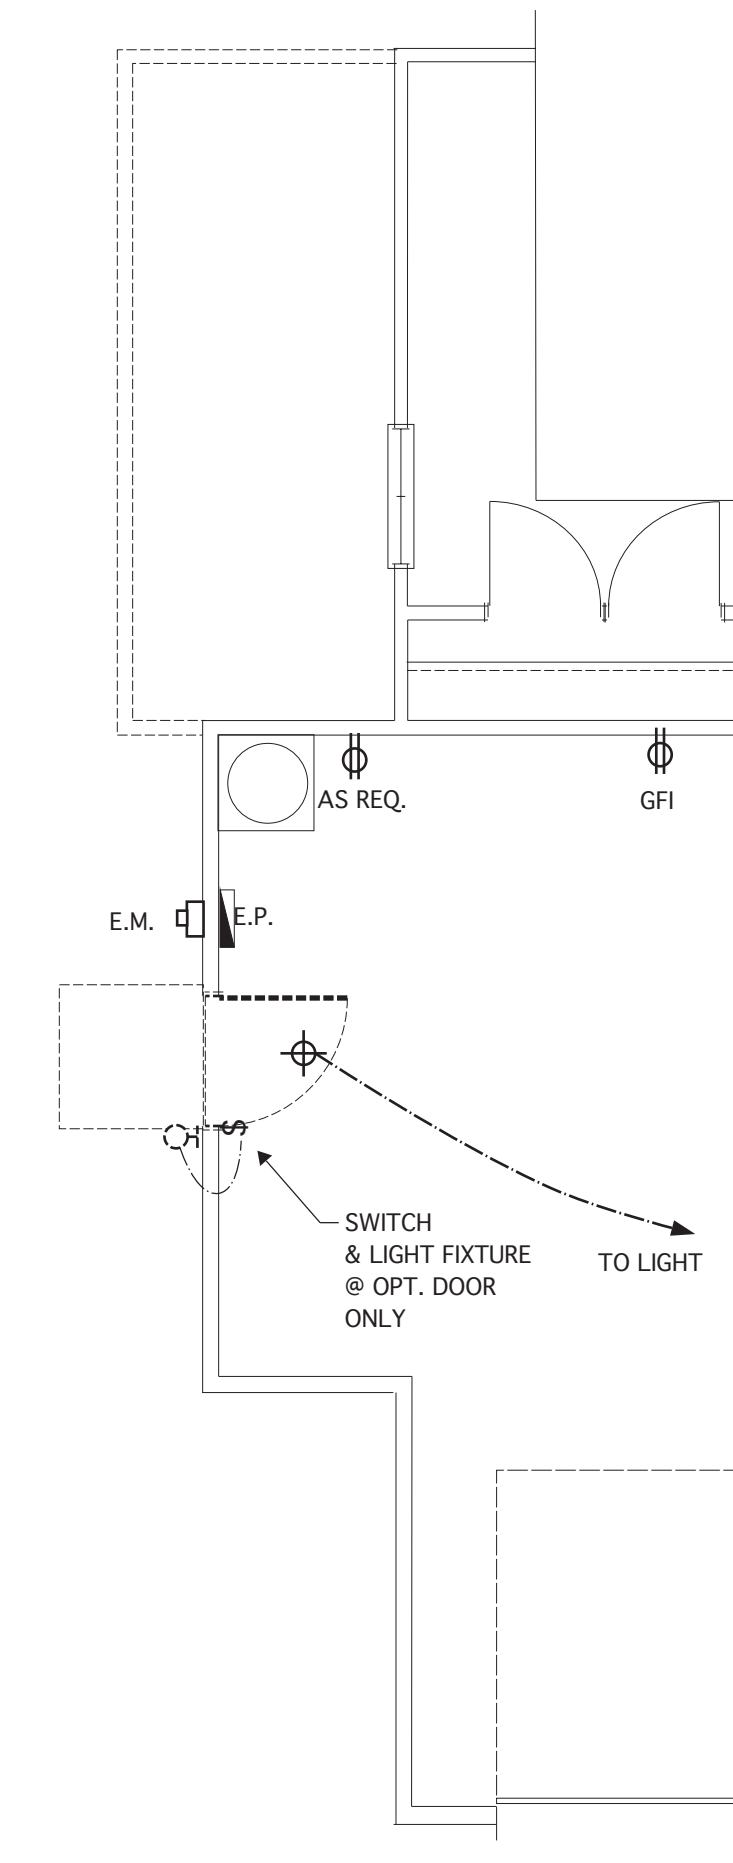


**OPT. GARAGE STORAGE EXTENSION**  
SCALE 1/4" = 1'-0"

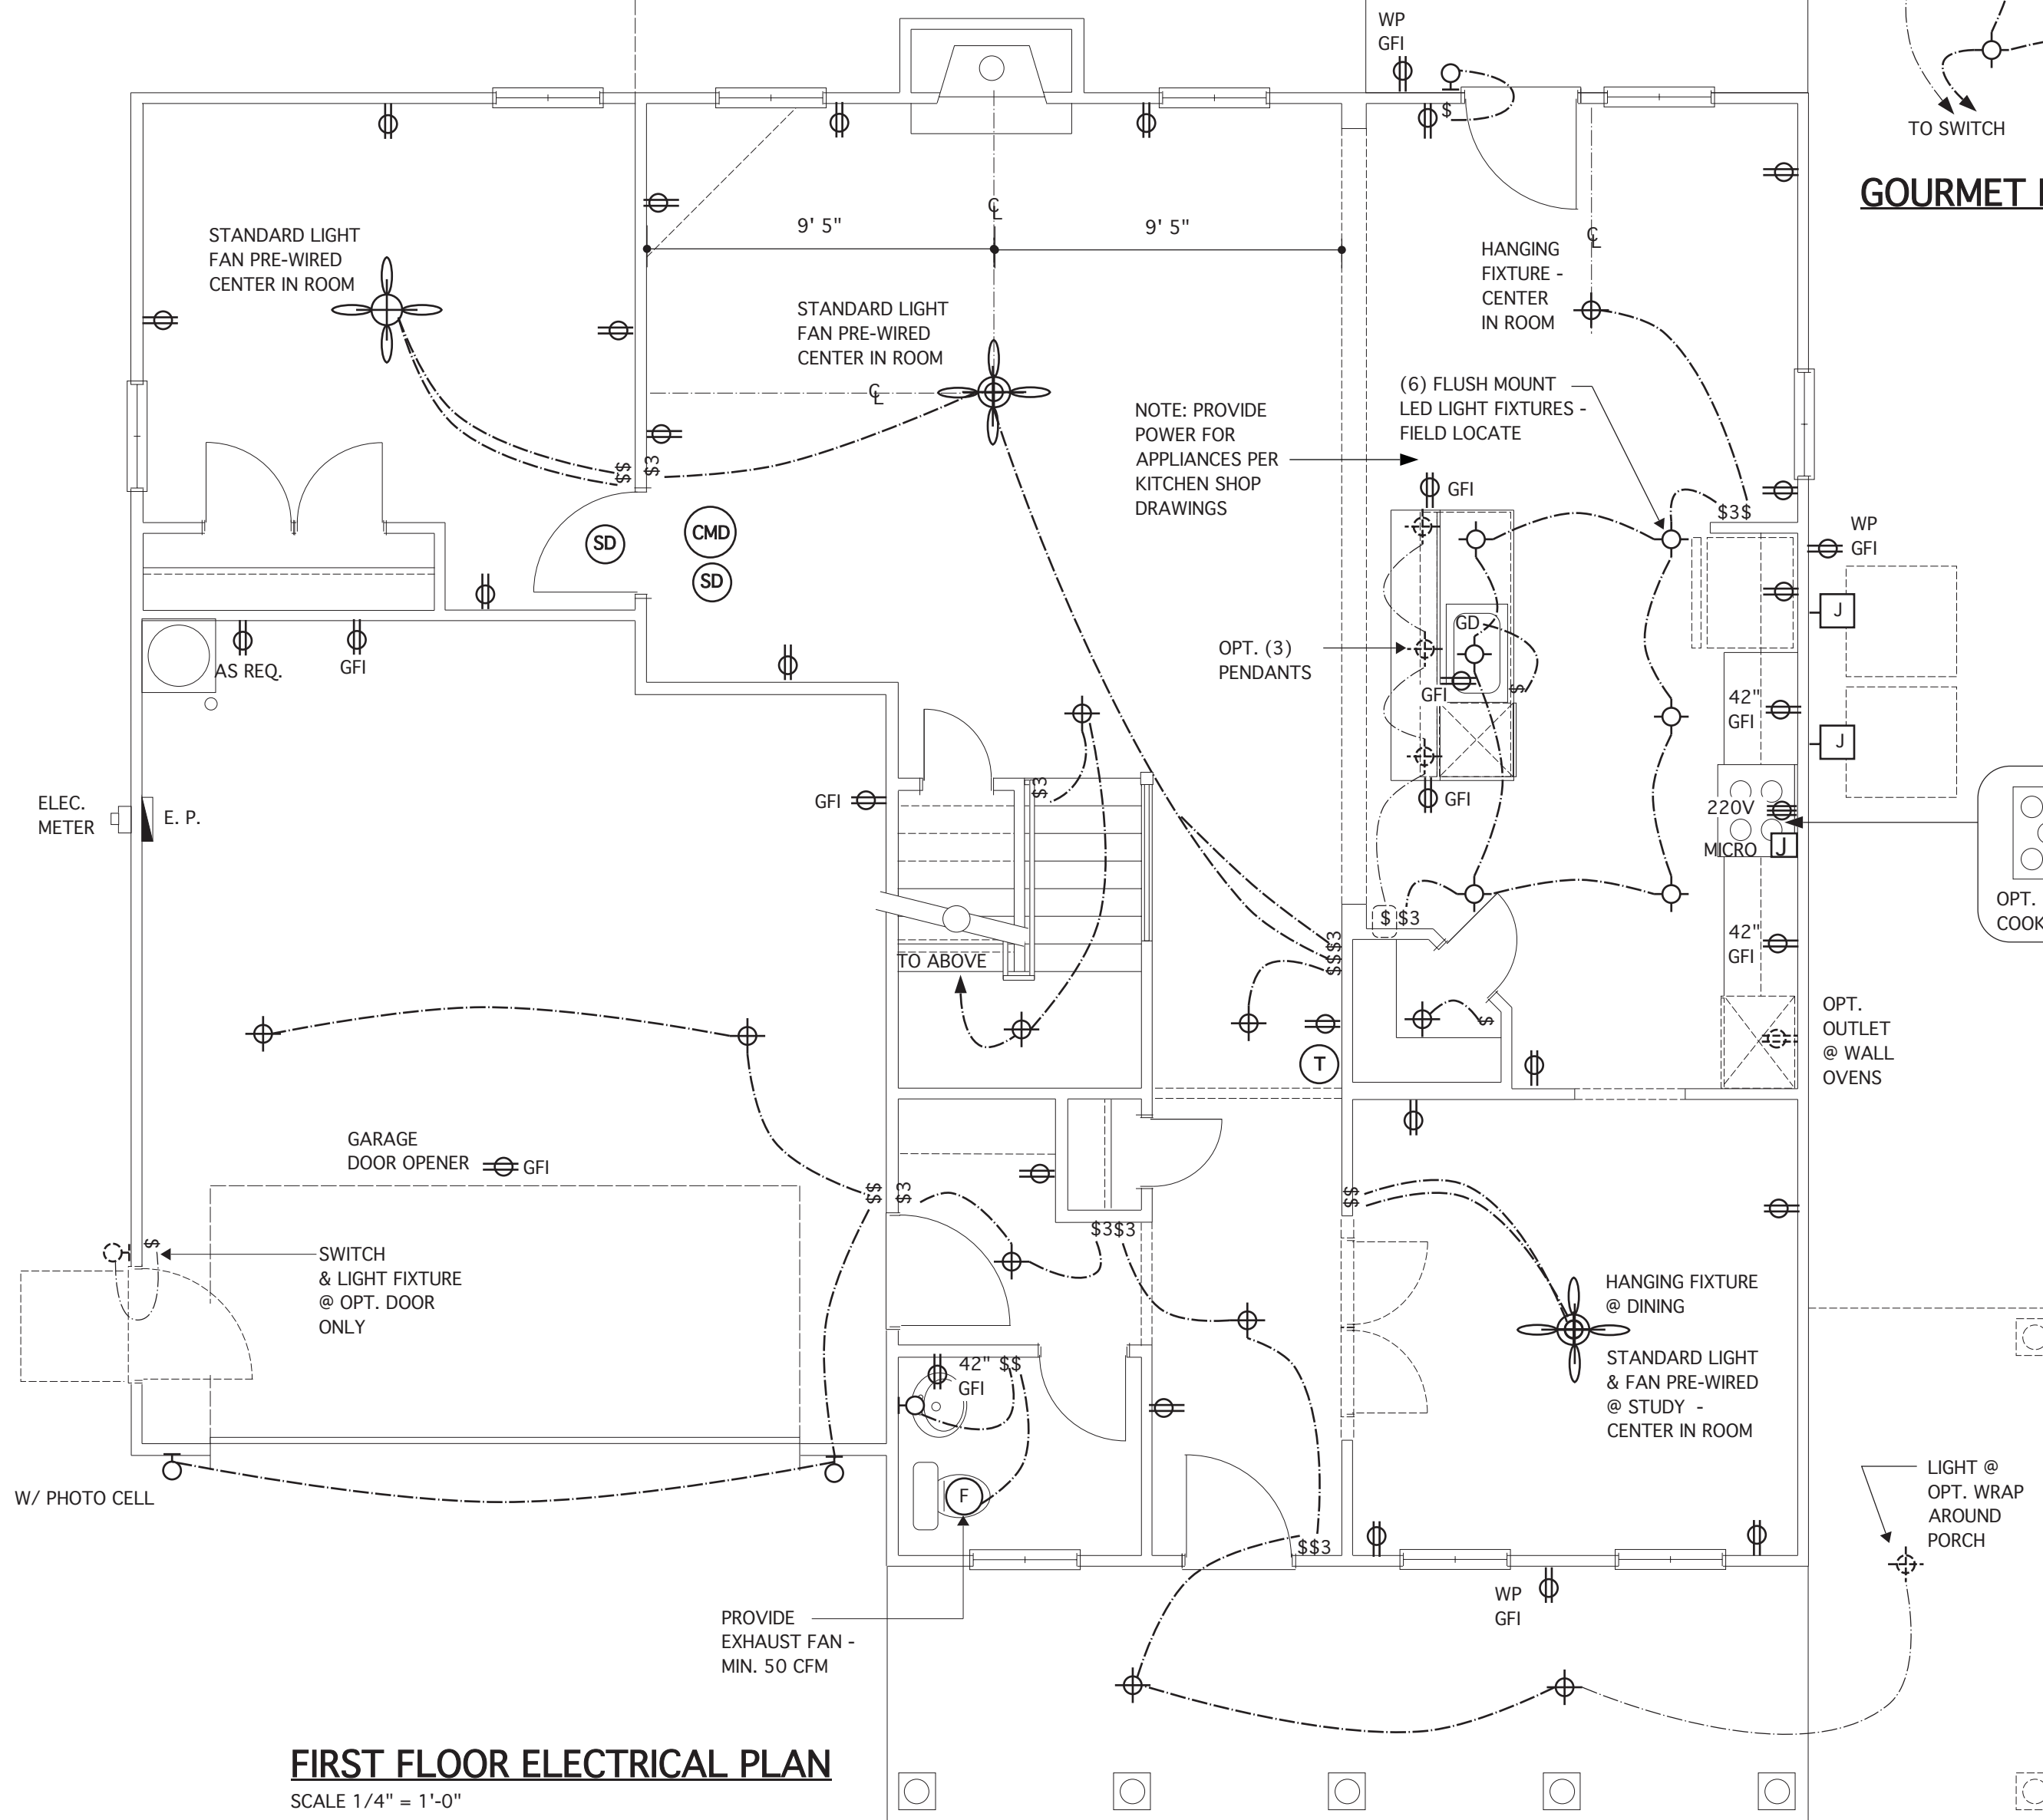

**FIRST FLOOR ELECTRICAL PLAN**  
SCALE 1/4" = 1'-0"  
NOTE: SEE SHEET 7.1 FOR ELECTRICAL LEGEND

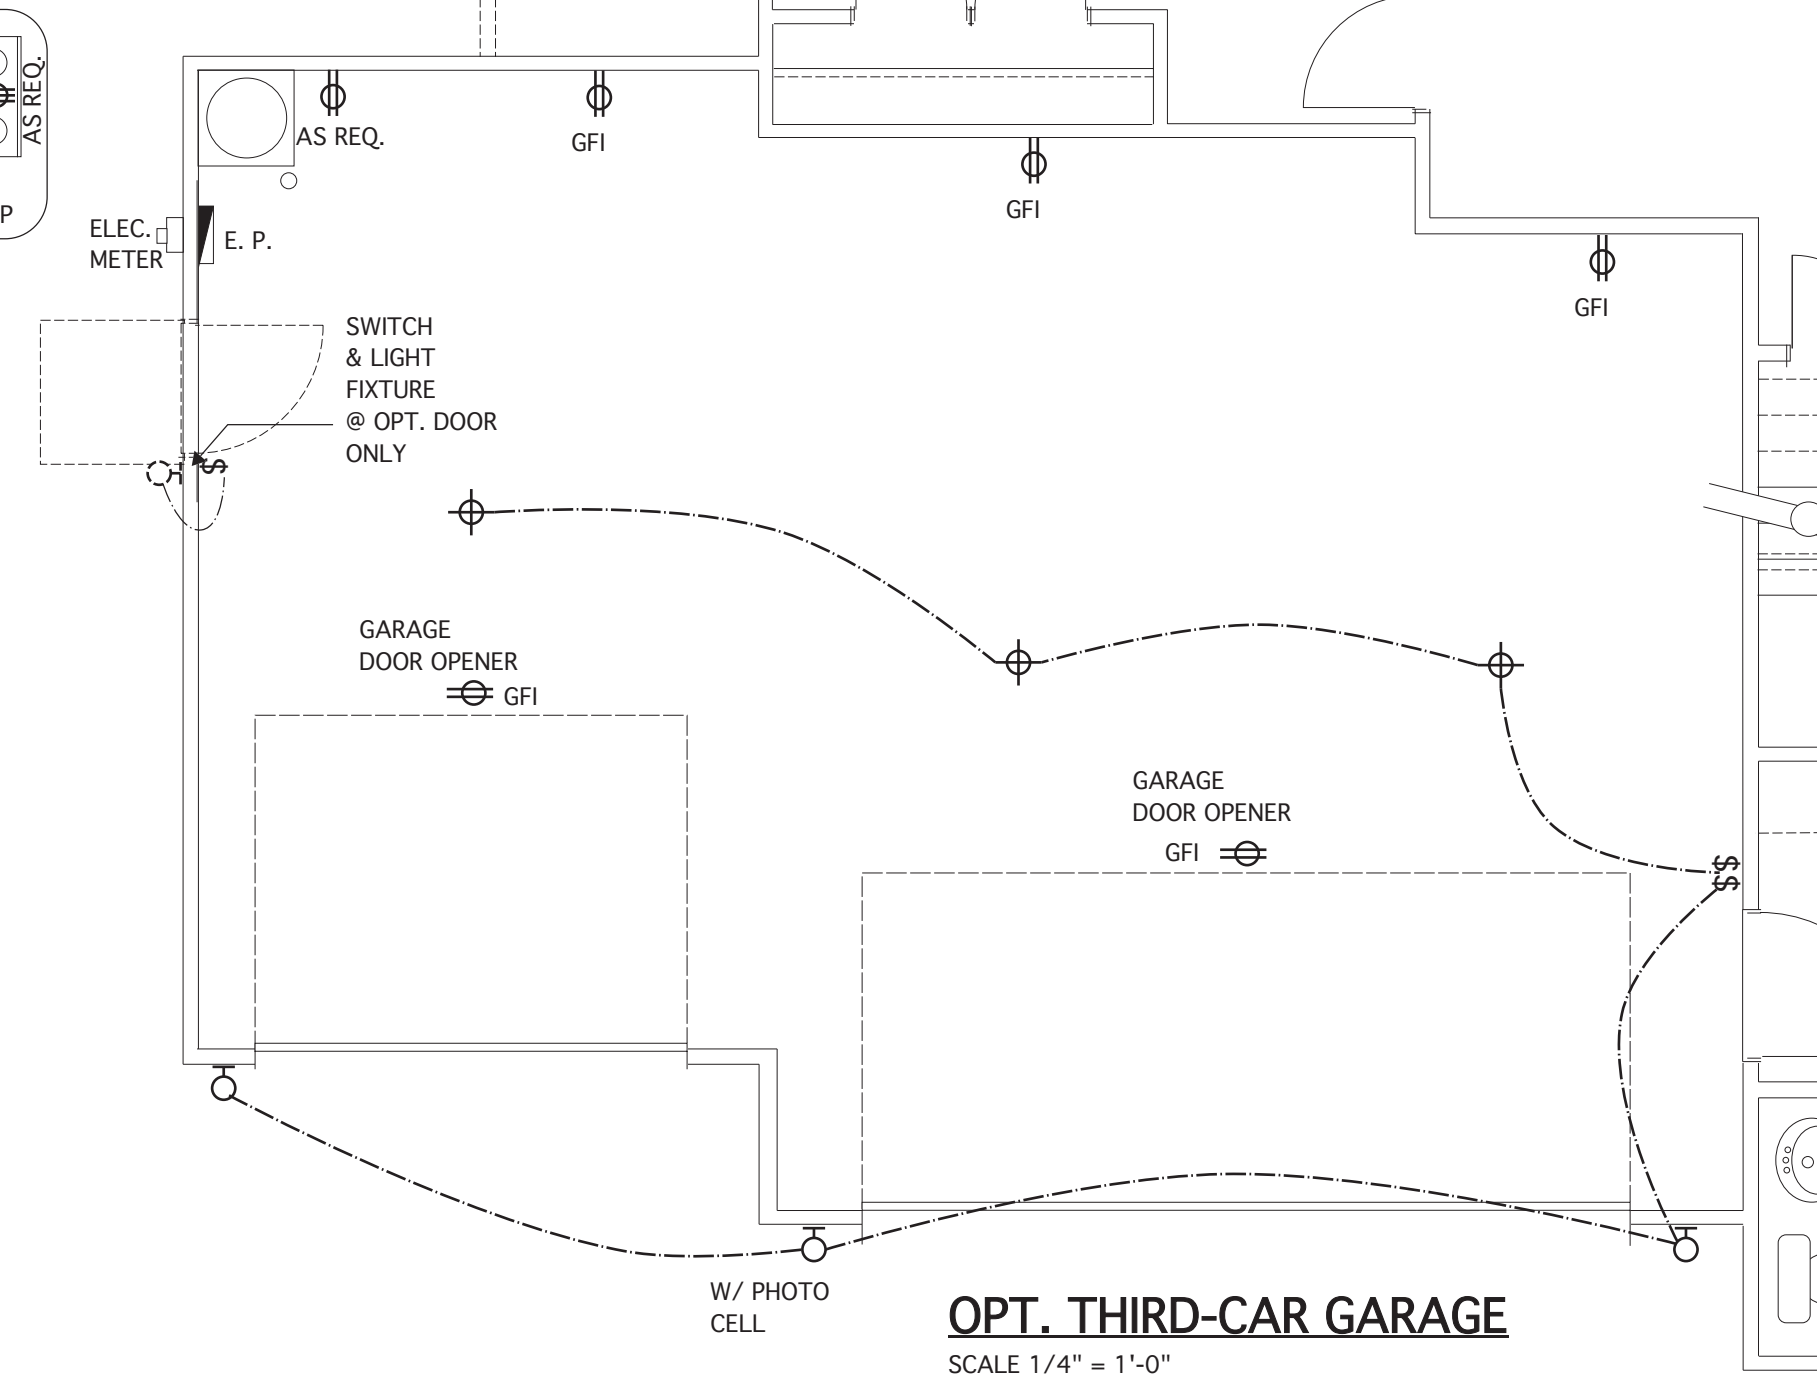

**OPT. THIRD-CAR GARAGE**  
SCALE 1/4" = 1'-0"

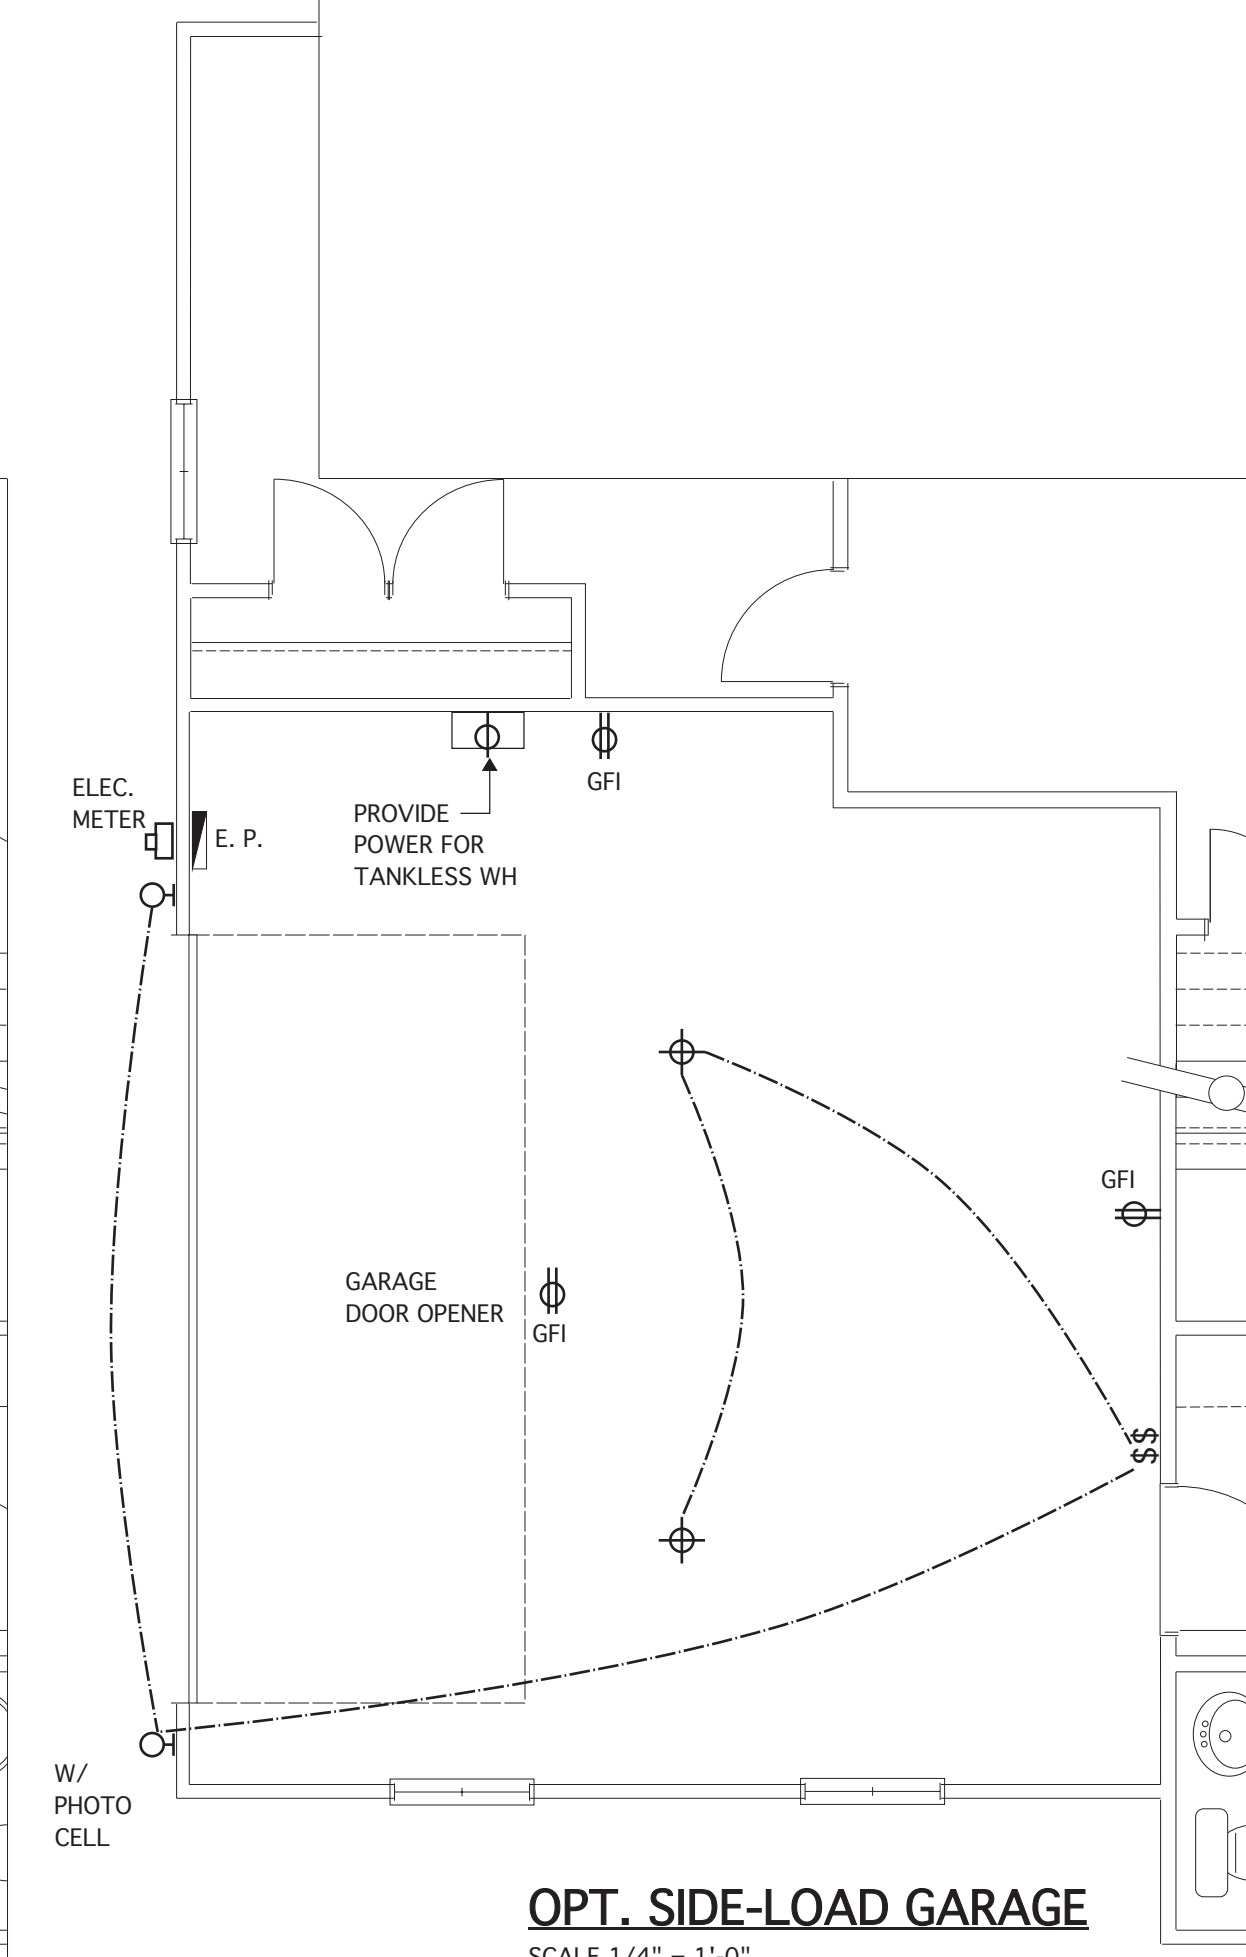

**OPT. SIDE-LOAD GARAGE**  
SCALE 1/4" = 1'-0"

**JAMES WENTLING/  
ARCHITECT**

LAND TITLE BUILDING  
100 SOUTH BROAD STREET,  
SUITE 1524  
PHILADELPHIA, PA 19110

(215) 568-2551  
email - information@  
wentlinghouseplans.com

ARCHITECTURE  
LAND PLANNING  
GRAPHICS

THESE PLANS ARE COPYRIGHTED AND ARE SUBJECT TO COPYRIGHT PROTECTION AS AN "ARCHITECTURAL WORK" UNDER SECTION 102 OF THE COPYRIGHT ACT, 17 U.S.C. AS AMENDED DECEMBER 1, 1990 AND KNOWN AS THE "ARCHITECTURAL WORKS COPYRIGHT PROTECTION ACT OF 1990". THE PROTECTION INCLUDES BUT IS NOT LIMITED TO, THE OVERALL FORM AS WELL AS THE ARRANGEMENT AND COMPOSITION OF SPACES AND ELEMENTS OF THE DESIGN. UNDER SUCH PROTECTION, UNAUTHORIZED USE OF THESE PLANS, WORKS, OR FORMS REPRESENTED CAN LEGALLY RESULT IN THE CESSION OF SUCH CONSTRUCTION OR BUILDINGS BEING SEIZED AND/OR RAISED.



**REVISIONS**

MARK	DATE	DESCRIPTION
DN	01-10-19	CONVERT OLAHS
DN	02-14-19	STRUCT. DWGS. REV.
CH	12-10-19	ADD ELEV. D & E
CH	05-18-20	UPDATE + SNRM. W/ COV. P.
DN	04-04-24	CONVERT 113-69/ADD OPT. BATH #2 LM

**PROJECT NO.**

113-88

**DATE**

01-13-16

**SCALE**

AS NOTED

**DRAWN BY**

JB

**CHECKED BY**

JW

**ISSUED FOR**

PERMITS/CONSTRUCTION

**PROJECT TITLE**

**MODEL 628 -**

**GARAGE LEFT**

**CLIENT**

**CHESAPEAKE**

**HOMES OF NC**

3100 Smoketree Court,

Suite 210

Raleigh, NC 27604

(919) 256-3060

(919) 556-0690 Fax

**DRAWING TITLE**

**FIRST FLOOR**


**ELECTRICAL PLANS**

**SHEET**


**7**

© Copyright 2016 James Wentling/Architect




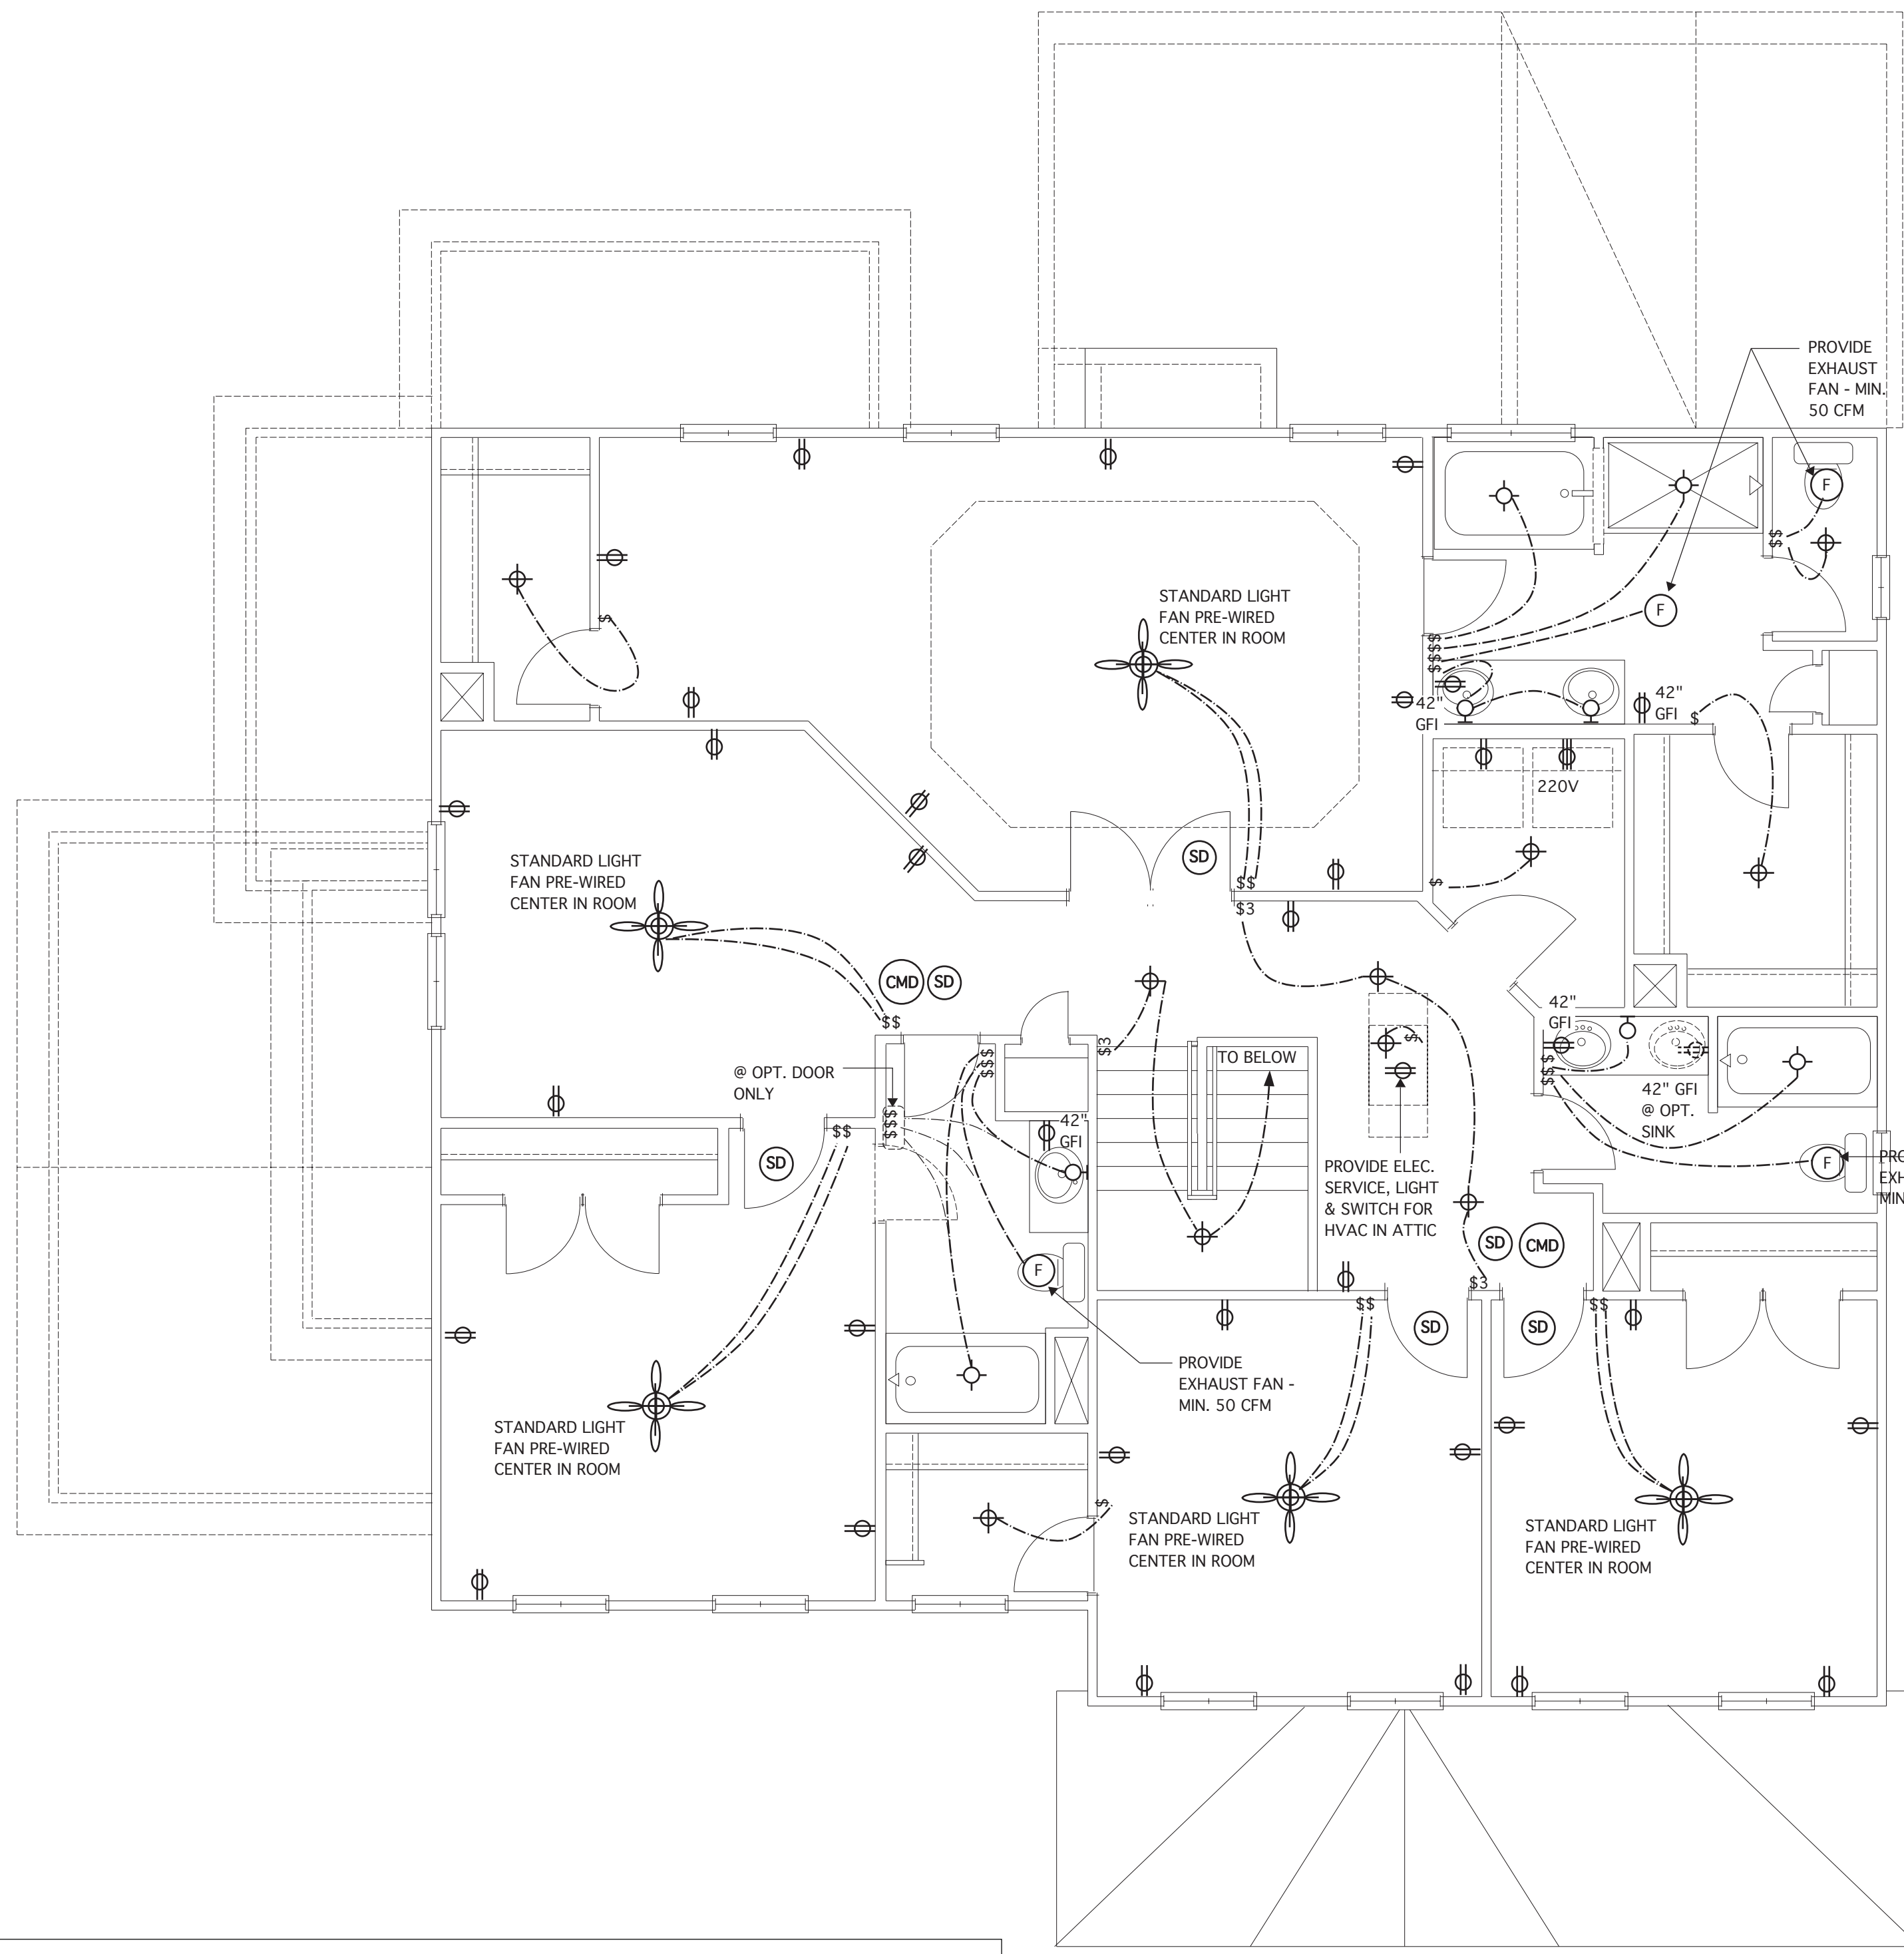

**SECOND FLOOR ELECTRICAL PLAN**  
SCALE 1/4" = 1'-0"

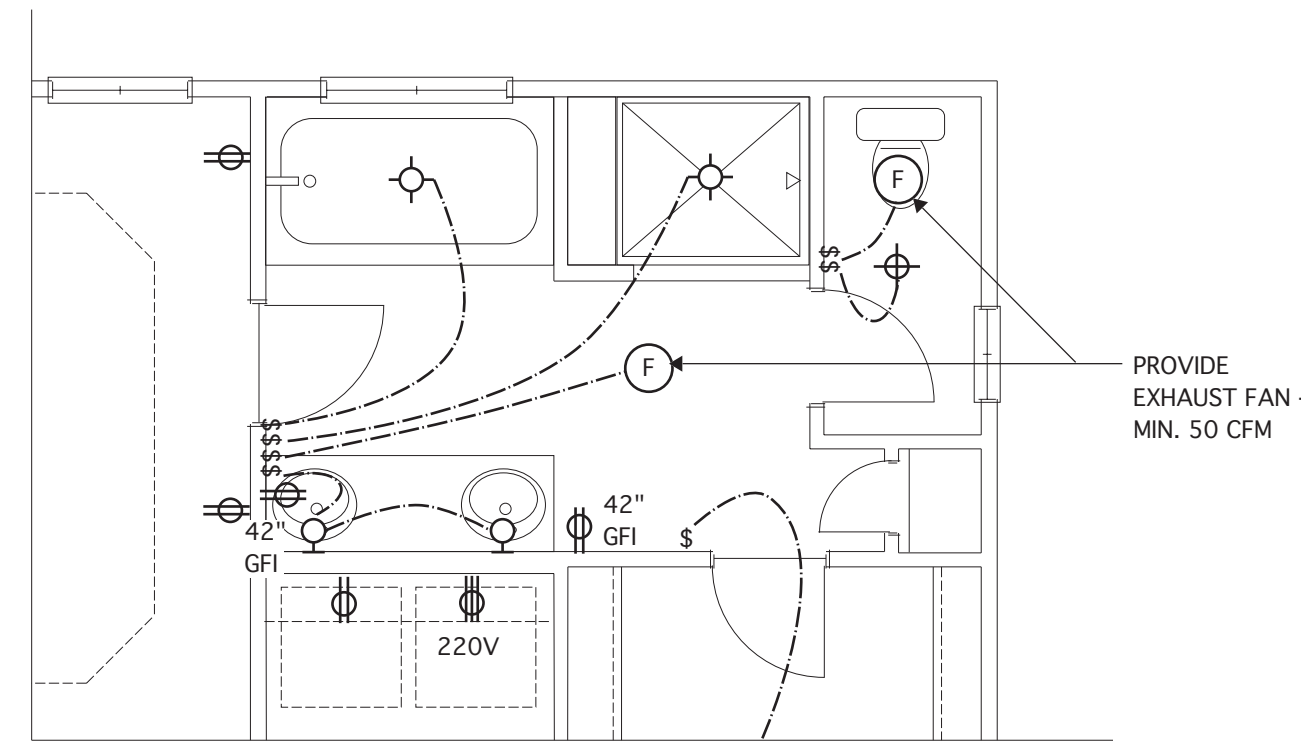

**@ OPT. DELUXE OWNER'S BATH #1**  
SCALE 1/4" = 1'-0"

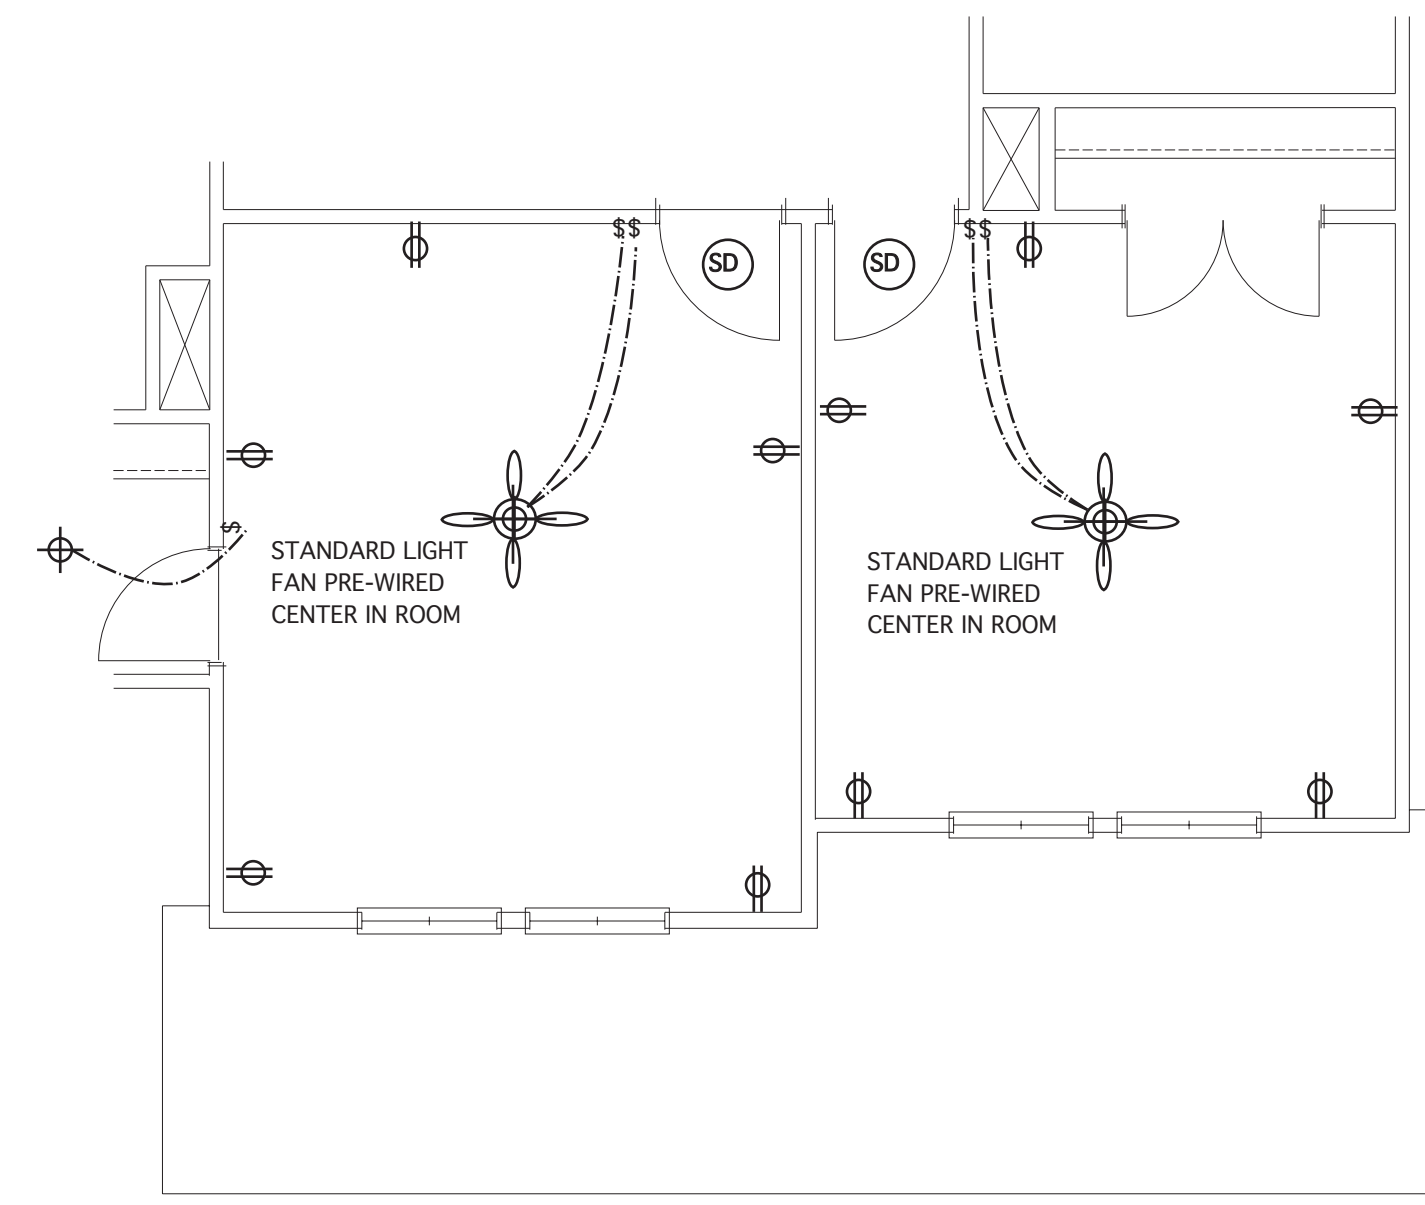

**@ ELEV. D**  
SCALE: 1/4" = 1'-0"

	SINGLE RECEPTACLE OUTLET		FLUORESCENT LIGHT FIXTURE; MULTI-TUBE
	DUPLEX RECEPTACLE OUTLET		CEILING MOUNTED LIGHT FIXTURE
	DUPLEX RECEPTACLE OUTLET-GROUND FAULT INTERRUPTER		FLUSH-MOUNT LED LIGHT FIXTURE
	DUPLEX RECEPTACLE OUTLET-SPLIT WIRED		WALL MOUNTED LIGHT FIXTURE
	220V OUTLET		PREWIRE CEILING FAN
	WEATHER-PROTECTED EXTERIOR OUTLET WITH IN-USE COVER & GFI PROTECTED		EXHAUST FAN - 50 CFM.
	SWITCH		CEILING LIGHT/FAN COMBO
	THREE WAY SWITCH		SMOKE DETECTOR - HARDWIRED & INTERCONNECTED
	48 CIRCUIT BREAK PANEL W/ 200 AMP. EL. SERVICE LINE		CARBON MONOXIDE DETECTOR HARDWIRED/PLUG-IN/ BATTERY TYPE
	JUNCTION BOX W/ SHUT-OFF SWITCH		

**JAMES WENTLING/ ARCHITECT**  
 LAND TITLE BUILDING  
 100 SOUTH BROAD STREET,  
 SUITE 1524  
 PHILADELPHIA, PA 19110  
 (215) 568-2551  
 email -information@wentlinghouseplans.com

ARCHITECTURE  
 LAND PLANNING  
 GRAPHICS

THESE PLANS ARE COPYRIGHTED AND ARE SUBJECT TO COPYRIGHT PROTECTION AS AN "ARCHITECTURAL WORK" UNDER SECTION 102 OF THE COPYRIGHT ACT, 17 U.S.C. AS AMENDED DECEMBER 1, 1990 AND KNOWN AS THE "ARCHITECTURAL WORKS" COPYRIGHT PROTECTION ACT OF 1990. THE PROTECTION INCLUDES BUT IS NOT LIMITED TO: THE OVERALL FORM AS WELL AS THE ARRANGEMENT AND COMPOSITION OF SPACES AND ELEMENTS OF THE DESIGN. UNDER SUCH PROTECTION, UNAUTHORIZED USE OF THESE PLANS, WORKS, OR FORMS REPRESENTED CAN LEGALLY RESULT IN THE CESSATION OF SUCH CONSTRUCTION OR BUILDINGS BEING SEIZED AND/OR RAISED.

© Copyright 2016 James Wentling/ Architect

**JAMES WALTER WENTLING**  
 REGISTERED ARCHITECT  
 #642  
 W. W. Wentling  
 NORTH CAROLINA  
 RALEIGH, N. C.  
 4/1/24

REVISIONS		
MARK	DATE	DESCRIPTION
DN	01-10-19	CONVERT OLAHS
DN	02-14-19	STRUCT. DWGS. REV.
CH	12-10-19	ADD ELEV. D & E
CH	05-18-20	MINOR UPDATE
DN	04-04-24	CONVERT 113-69/ADD OPT. BATH #2 LM

PROJECT NO. 113-88  
 DATE 01-13-16  
 SCALE AS NOTED  
 DRAWN BY JB  
 CHECKED BY JW  
 ISSUED FOR PERMITS/CONSTRUCTION

PROJECT TITLE  
**MODEL 628 - GARAGE LEFT**

CLIENT  
**CHESAPEAKE HOMES OF NC**  
 3100 Smoketree Court,  
 Suite 210  
 Raleigh, NC 27604  
 (919) 256-3060  
 (919) 556-0690 Fax

DRAWING TITLE  
**SECOND FLOOR ELECTRICAL PLANS**

SHEET  
**7.1**