



Front & Rear Elevations

THE JUDY - Elevation A

County:

Address:

Job #:

Plan Version Date:

6/18/20

Job Version Date:

Sheet #:

ElevA-Pg1

Elevation A - Sheet List

Sheet Number	Sheet Name
ElevA-Pg1	Front & Rear Elevations
ElevA-Pg2	Side Elevations
ElevA-Pg3	1st Floor Plan
ElevA-Pg4	Roof Plan
Pg5	Building Section
Pg6	Details

DocuSigned by:

*Maria S. H...* 7/18/2024 | 9:13 AM EDT | 5:02 PM EDT  
40D3EE3B12E3420...


DocuSigned by:

*Danny Stora* 7/1/2024 | 10:23 AM EDT  
744956A4B39A4ED...


DocuSigned by:

*Abigail Evelyn O'Quinn*  
9FBEBDF57AAB480...

Area Schedule (Elevation A)	
Name	Area
Heated	1075 SF
1st Floor	1075 SF
Unheated	27 SF
Front Porch	27 SF
Under Roof	1102 SF

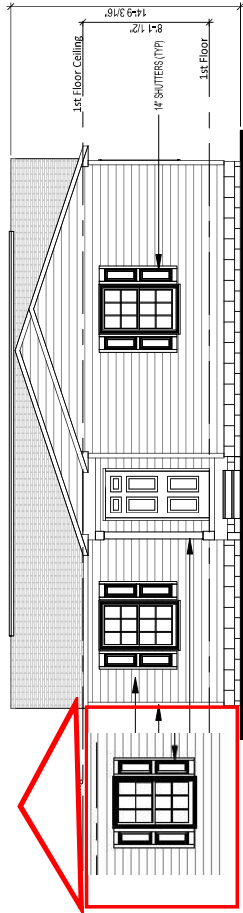

1 Front - Elev A  
1/8" = 1'-0"

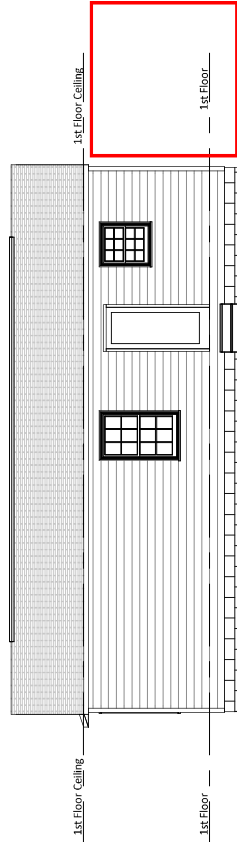

2 Rear - Elev A  
1/8" = 1'-0"



THE JUDY - Elevation A  
Side Elevations

Job #:  
Address:  
County:

Plan Version Date:  
6/18/20

Job Version Date:

Sheet #:  
ElevA-Pg2

DocuSigned by:


*Matt Smith* 6/18/2024 | 9:13 AM EDT  
40D3EE3B12E3420...

DocuSigned by:


*Danny Stone* 7/2024 | 10:23 AM EDT  
744956A4B39A4ED...

DocuSigned by:

*Abigail Evelyn O'Quinn*  
9FBEBDF57AAB480...

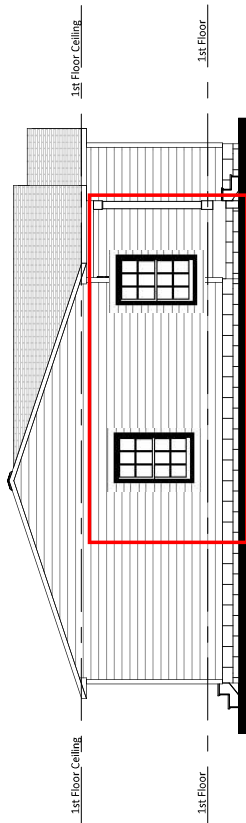

① Left - Elev A  
1/8" = 1'-0"

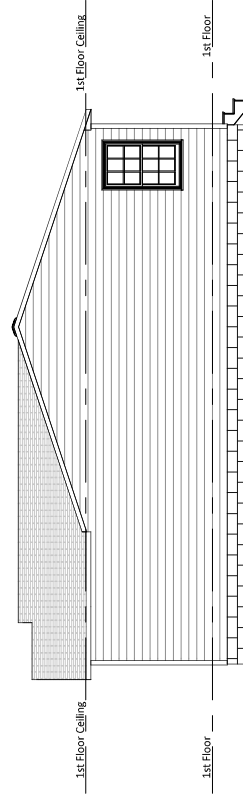

② Right - Elev A  
1/8" = 1'-0"



THE JUDY - Elevation A  
1st Floor Plan

Job #:  
Address:  
County:

Plan Version Date:  
6/18/20

Job Version Date:

Sheet #:  
ElevA-Pg3

DocuSigned by:

*Matt Stone* 7/18/2024 | 9:13:52 EDT | 5:02 PM EDT  
40D3EE3B12E3420...


DocuSigned by:

*Danny Stone*  
744956A4B39A4ED...

7/17/2024 | 10:23 AM EDT

DocuSigned by:

*Abigail Evelyn O'Quinn*  
9FBEBDF57AAB480...

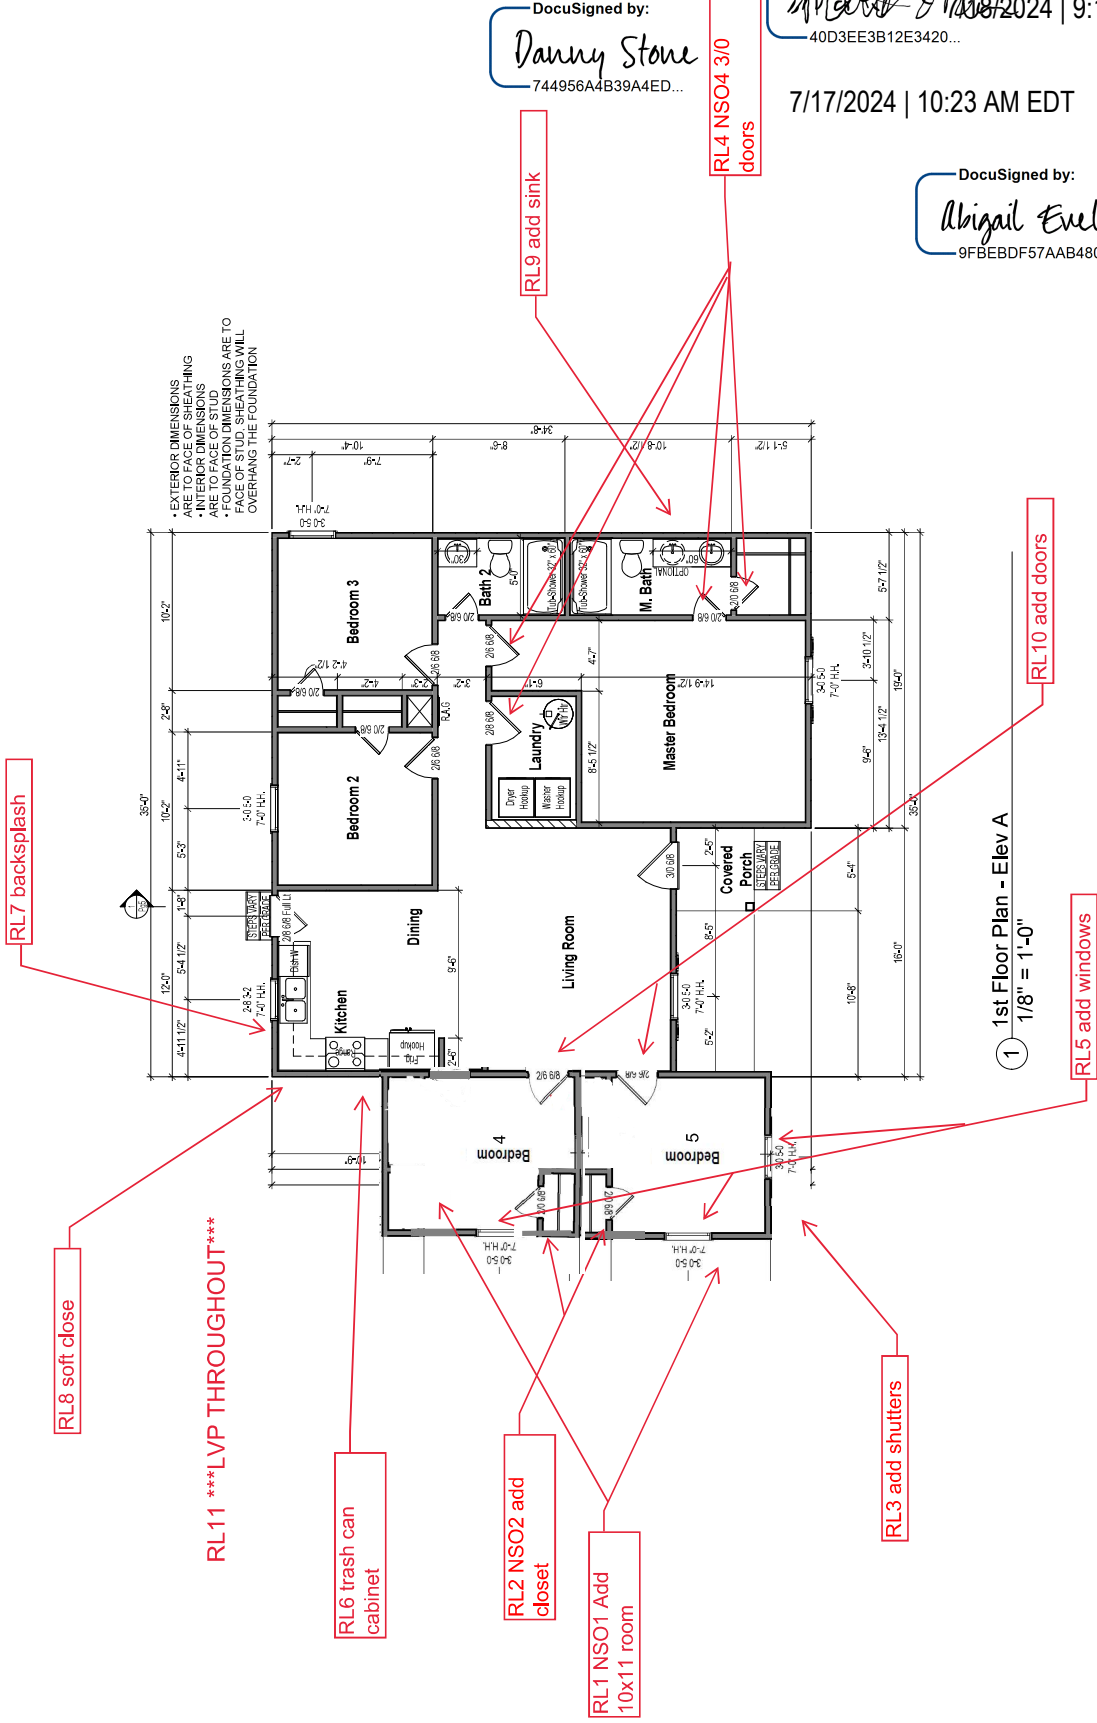

1 1st Floor Plan - Elev A  
1/8" = 1'-0"



THE JUDY - Elevation A  
Roof Plan

Job #:  
Address:  
County:

Plan Version Date:  
6/18/20

Job Version Date:

Sheet #:  
ElevA-Pg4

DocuSigned by:


*Matt* 6/18/2024 | 9:13 AM EDT | 5:02 PM EDT  
40D3EE3B12E3420...

DocuSigned by:

*Danny Stone* 6/17/2024 | 10:23 AM EDT  
744956A4B39A4ED...

DocuSigned by:

*Abigail Evelyn O'Quinn*  
9FBEBDF57AAB480...

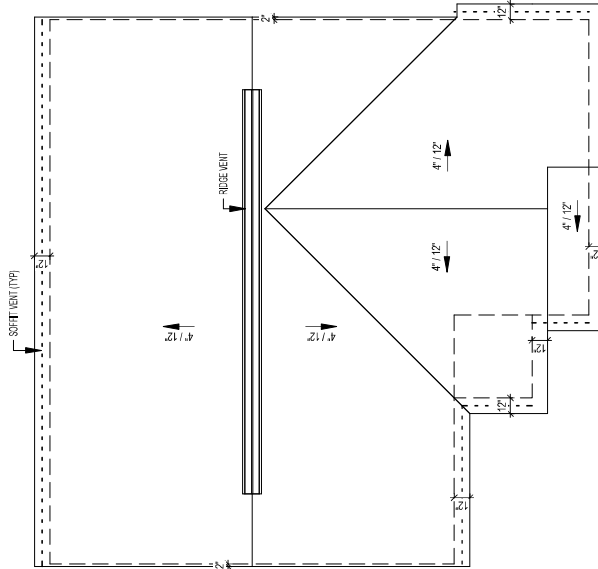

① Roof Plan - Elev A  
1/8" = 1'-0"

Attic Ventilation Calcs 1/300 (sq.in.)

Name	Area	Ventilation Required (sq.in.)	Max Upper (sq.in.)	Min Upper (sq.in.)	Upper Ventilation (sq.in.)	Lower Ventilation (sq.in.)	Total Ventilation (sq.in.)	Ridge Vent (sq.in.)	Roof Vents (sq.in.)	Soffit Vents (sq.in.)
Main Roof	1075 SF	516	413	258	390	372	762	26	0	62

CALCS BASED ON THE FOLLOWING VALUES:

- Ridge Vents = 15 in<sup>2</sup> of net free area per linear foot
- Roof Vents = 50 in<sup>2</sup> of net free area per unit
- Soffit Vents = 6 in<sup>2</sup> of net free area per square foot